
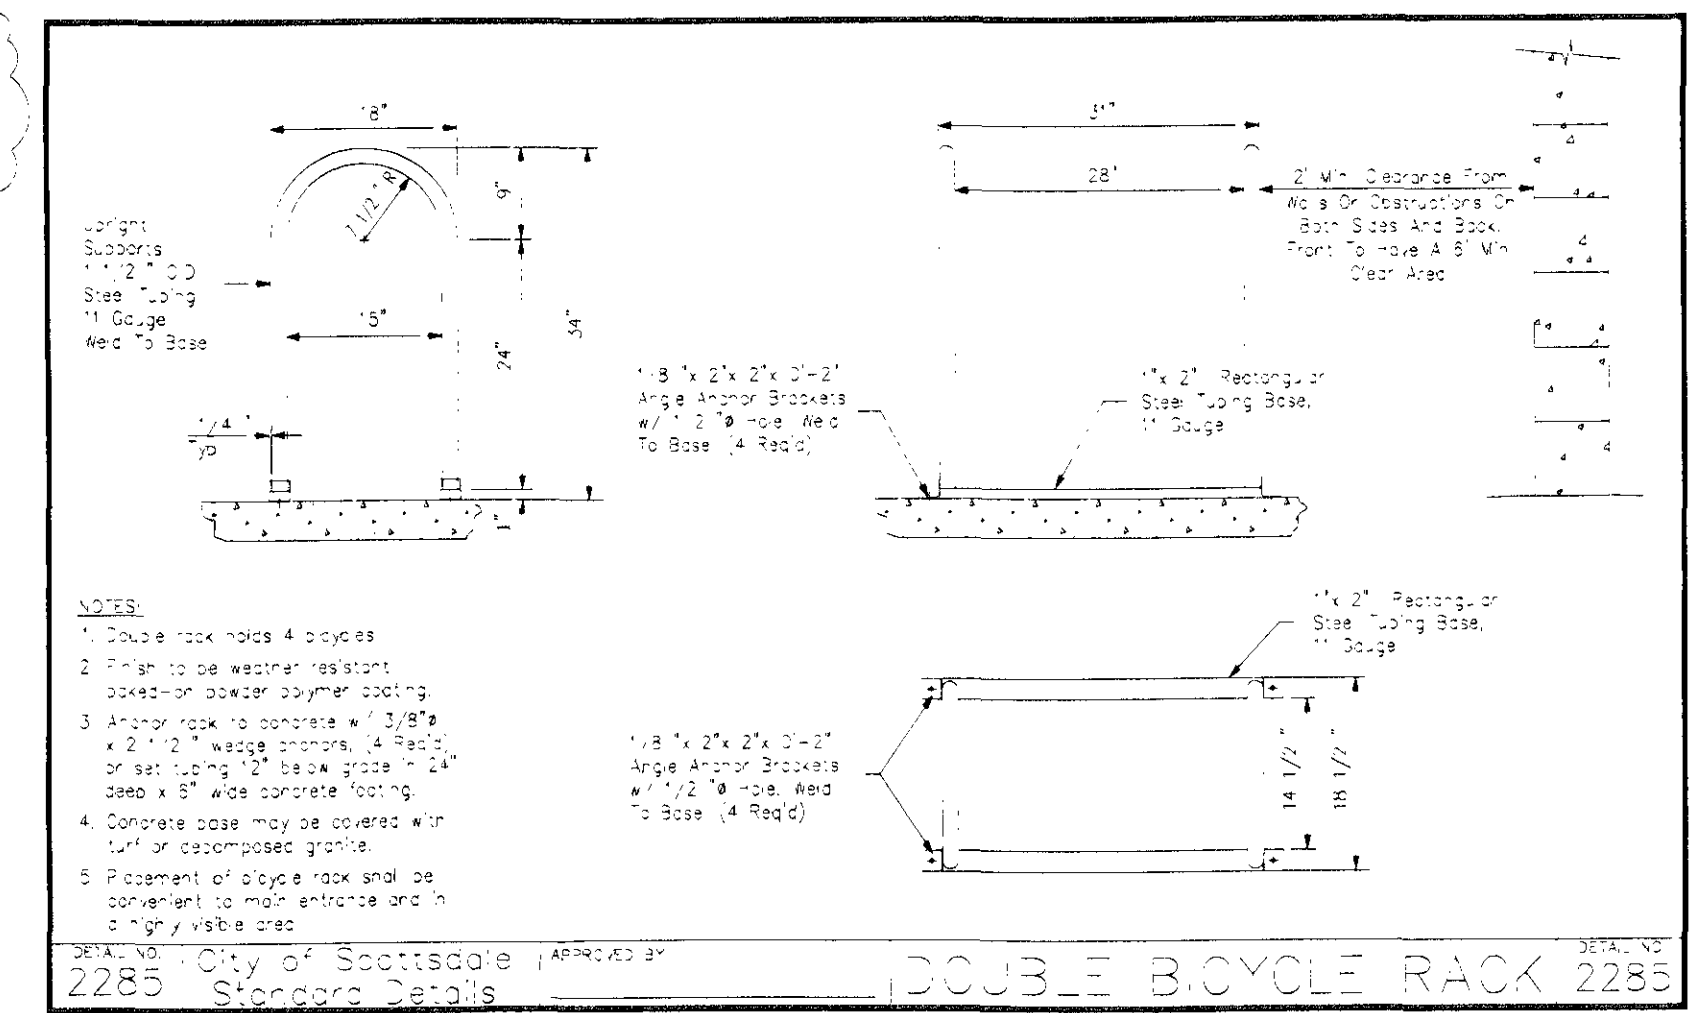
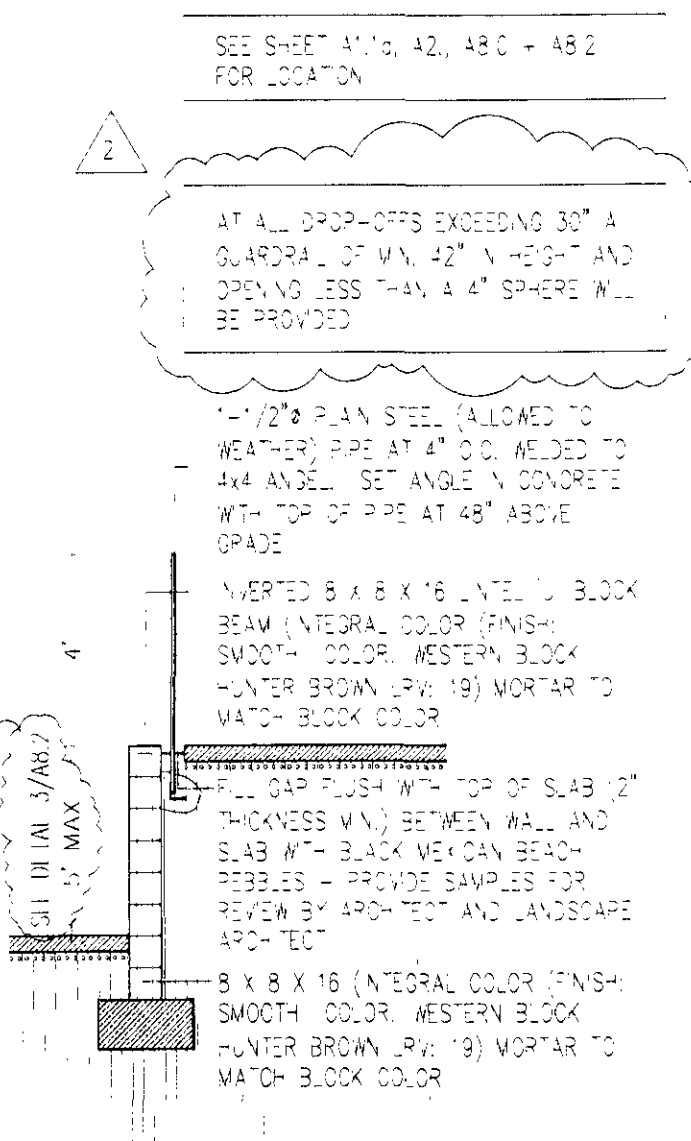


IF SURF IS GREATER THAN 35 AT THE TIME OF REQUEST FOR TEMPORARY / PERMANENT CERTIFICATE OF OCCUPANCY - MATERIALS ALLOWED TO WEATHER WILL BE ACCELERATED TO OBTAIN AN SURF OF 35 OR LESS. MATERIALS ALLOWED TO WEATHER AND ACHIEVING A SURF OF LESS THAN 35 WILL NOT BE SEIZED OR ALTERED FROM THEIR NATURAL CONDITION.

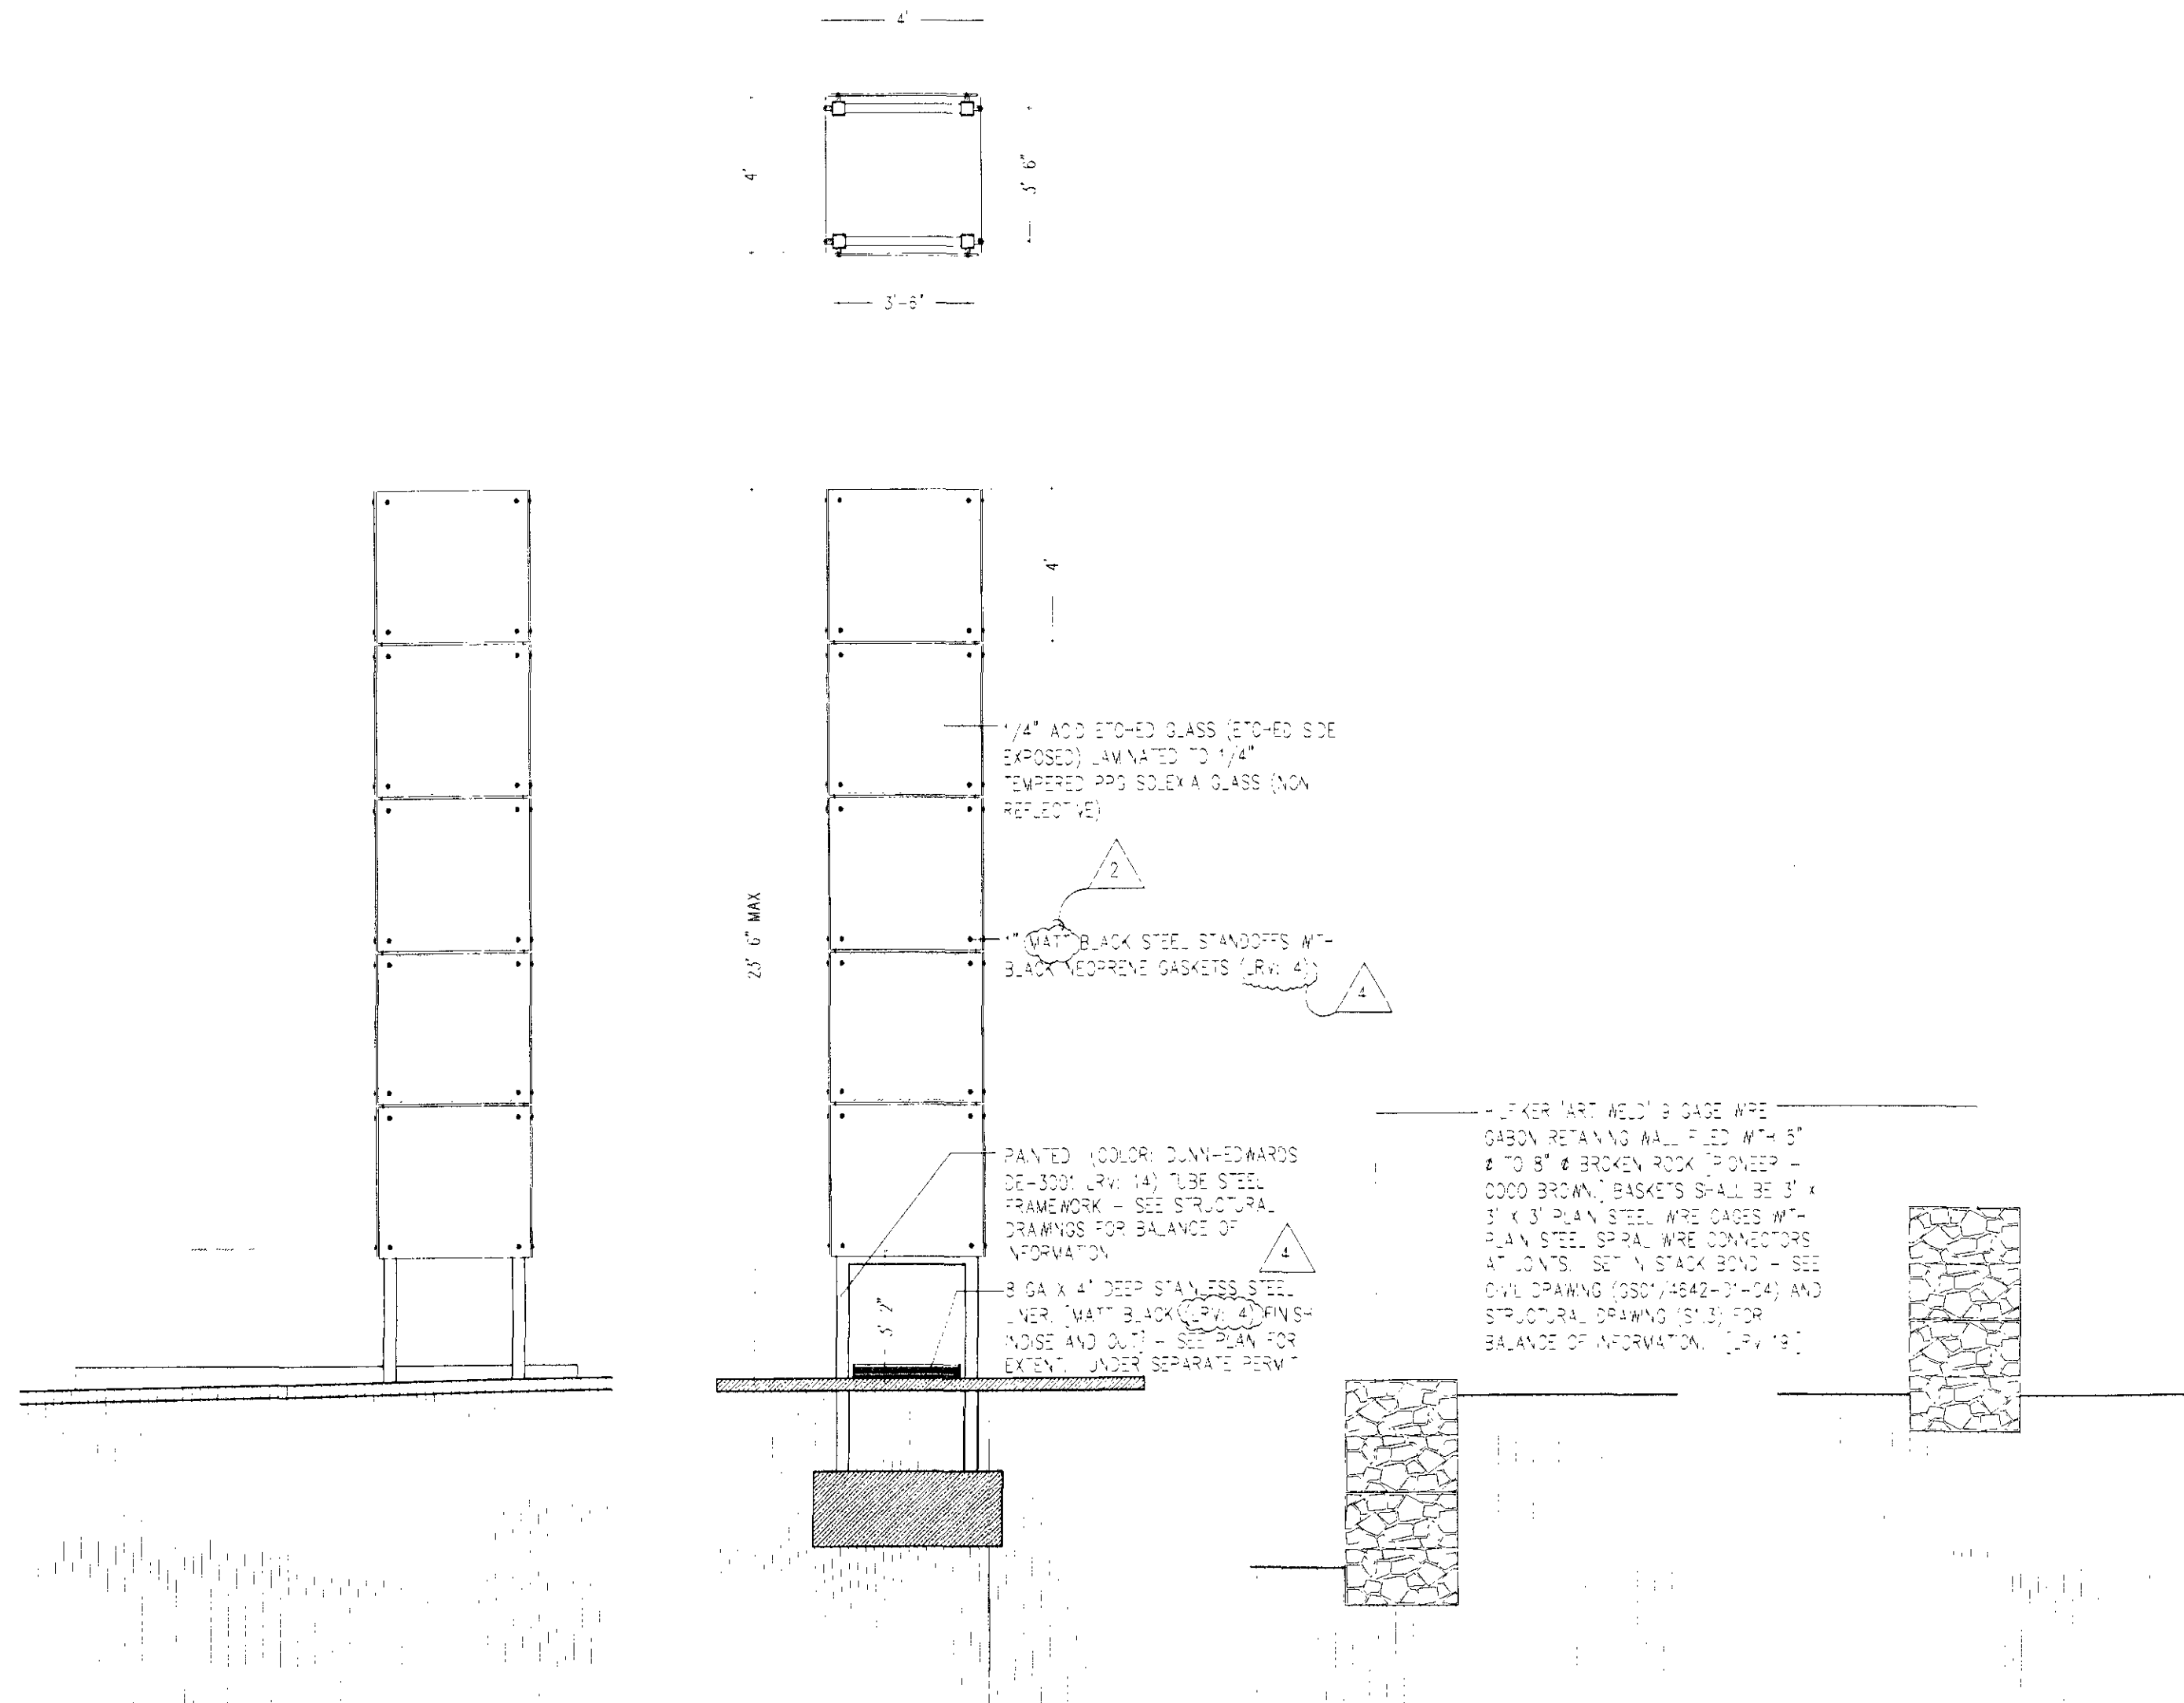




1 steeple / tower plan and elevations
A1.2 SCALE: 1/4" = 1'-0"

2 gabion retaining wall
A1.2 SCALE: 1/4" = 1'-0"

3 gabion wall
A1.2 SCALE: 1/4" = 1'-0"

4 block wall and pipe fence
A1.2 SCALE: 1/4" = 1'-0"

5 CoS bicycle rack
A1.2 SCALE: N.T.S.

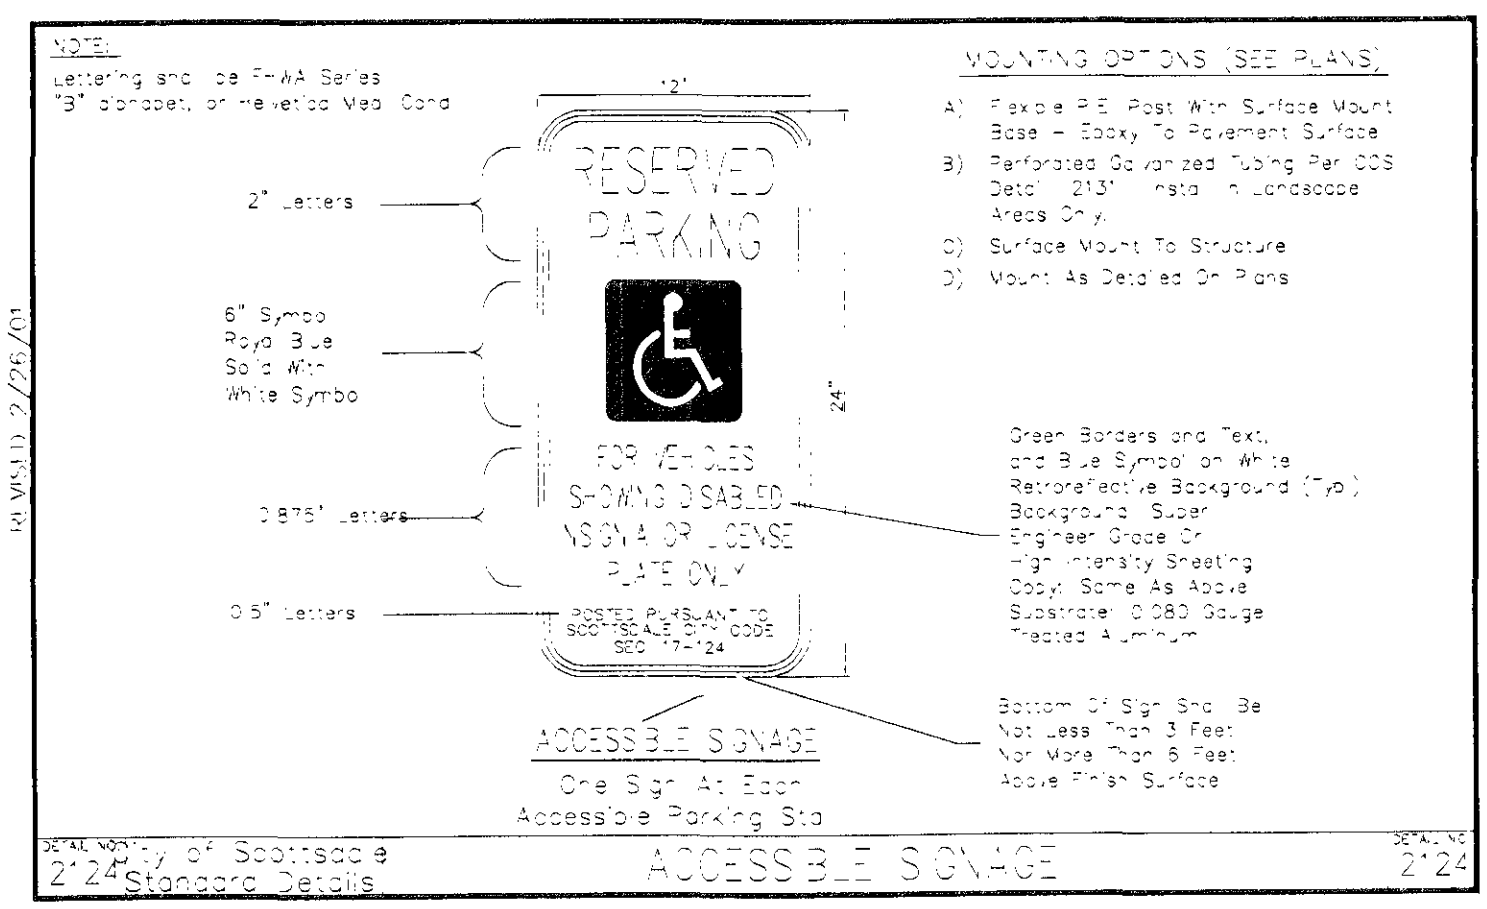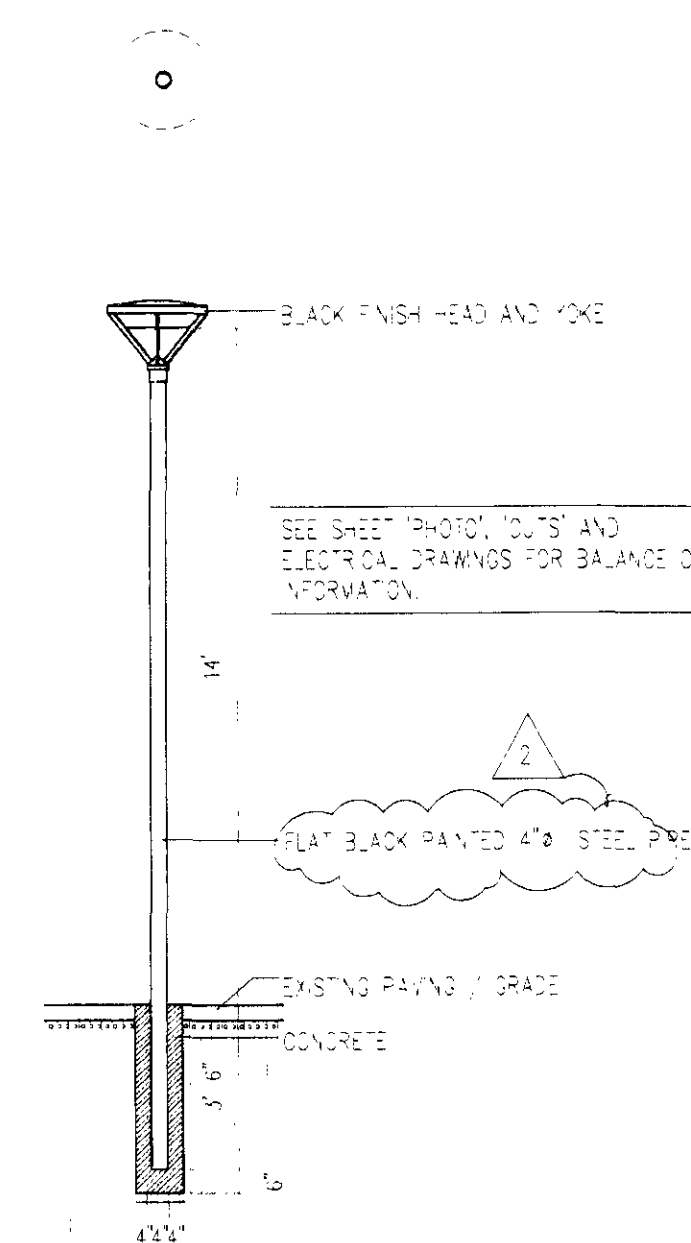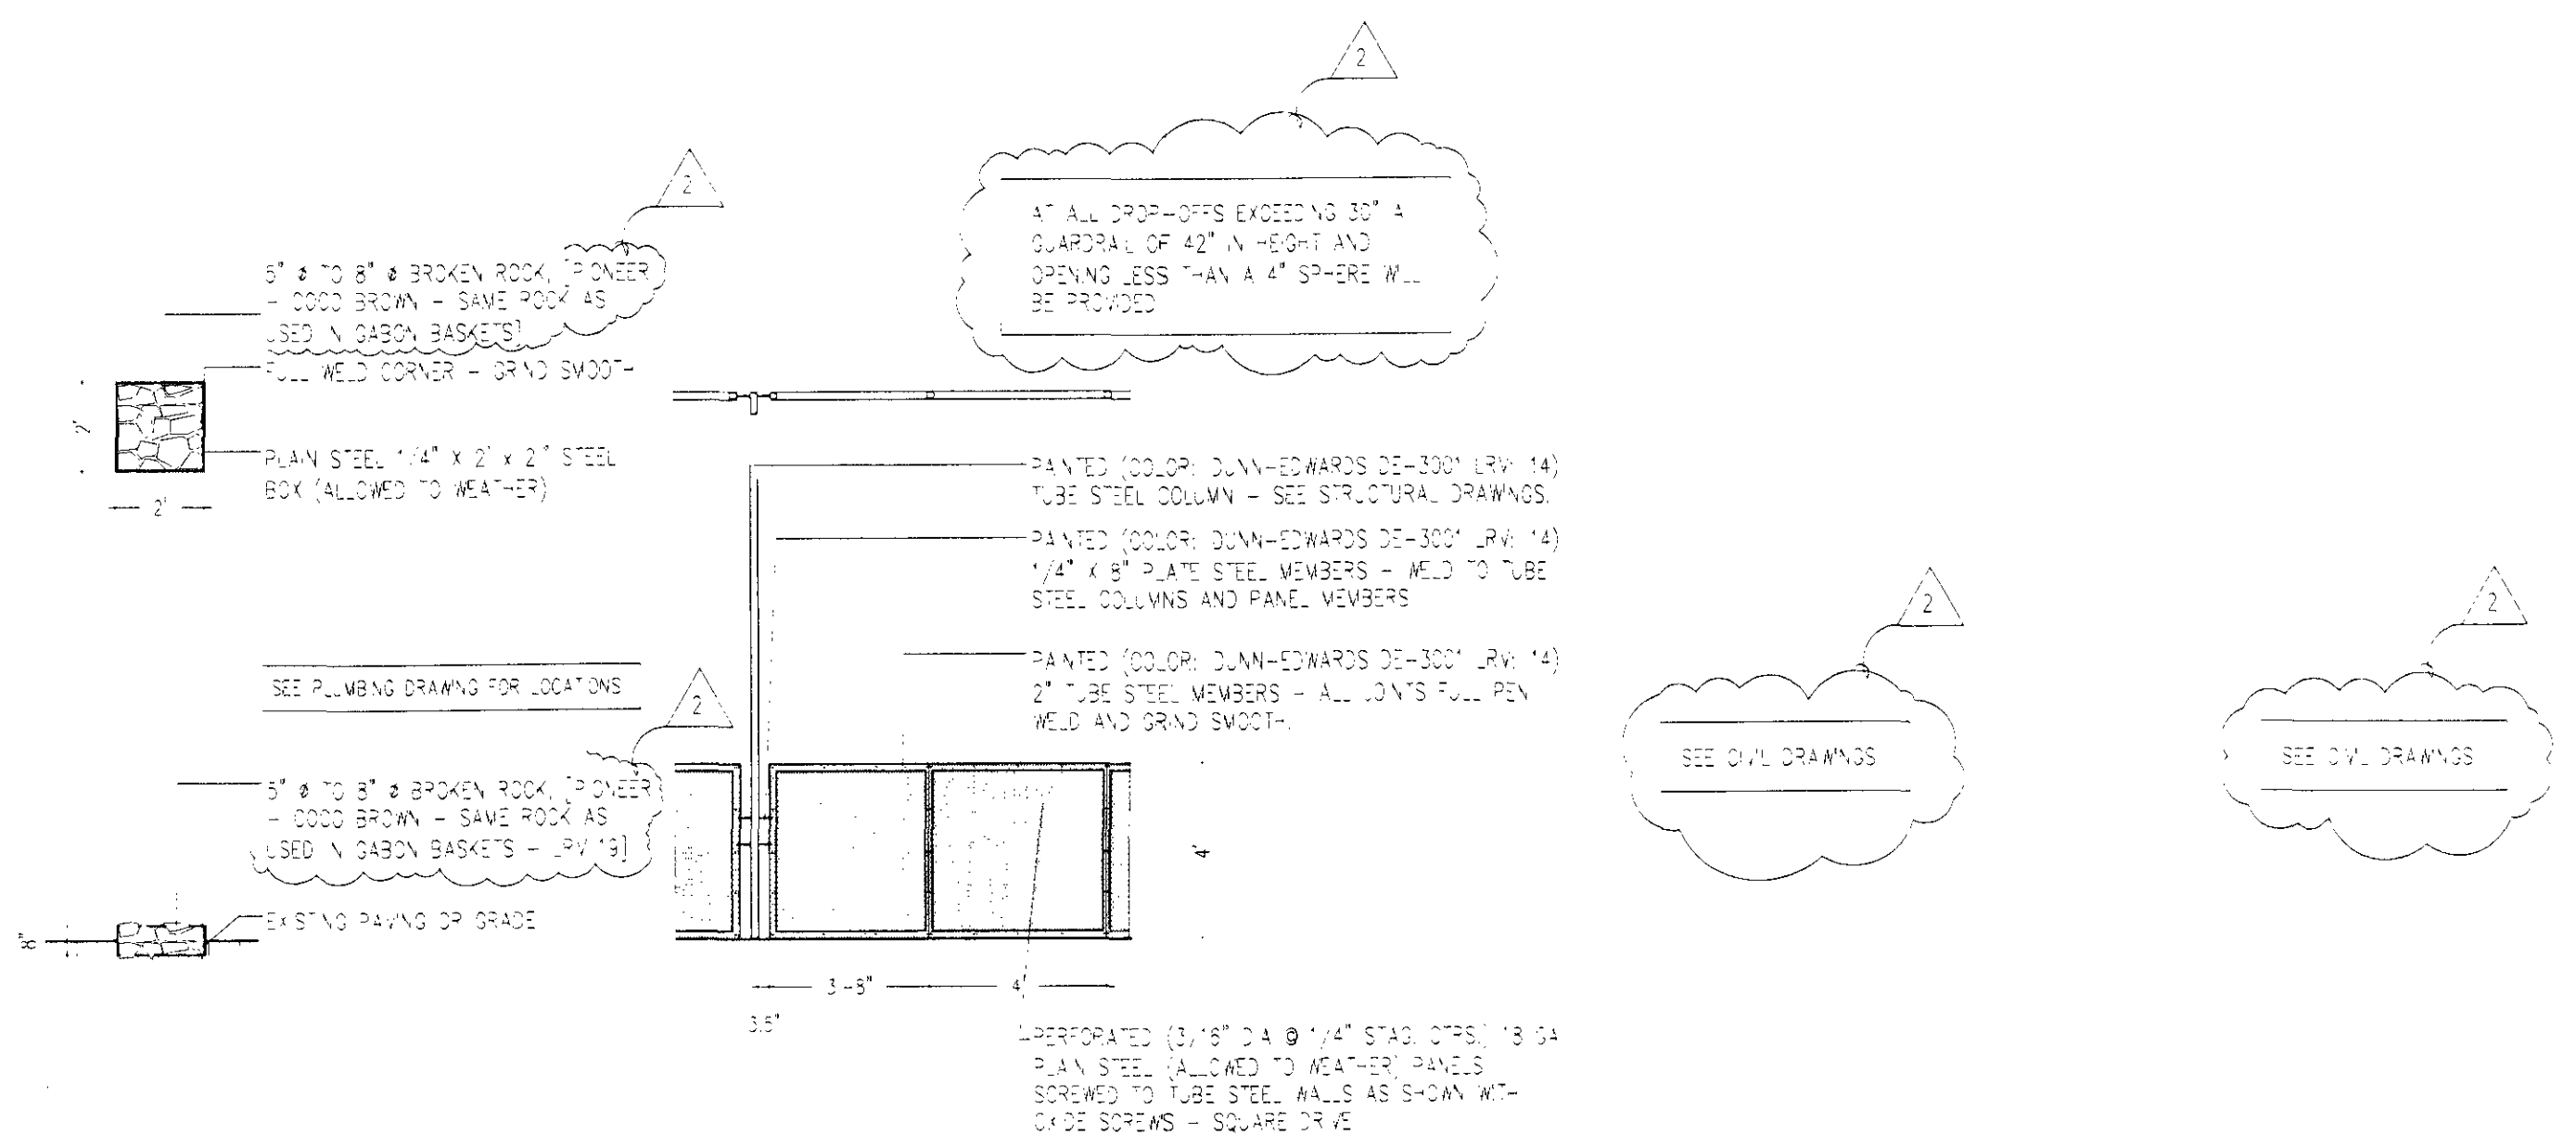

6 splash block
A1.2 SCALE: 1/4" = 1'-0"

7 safety railing
A1.2 SCALE: 1/4" = 1'-0"

8 sign post
A1.2 SCALE: 1/4" = 1'-0"

9 safety post
A1.2 SCALE: 1/4" = 1'-0"

10 pole mounted light fixture
A1.2 SCALE: 1/4" = 1'-0"

11 CoS standard ADA signage
A1.2 SCALE: N.T.S.

11 JUNE 2004
OWNER CHANGES

19 JULY 2004
FIRST REVIEW

03 SEP 2004
OWNER CHANGES

17 SEP 2004
SECOND REVIEW

A1.2

site details

scottsdale first assembly

DREAM CENTER

28700 north pima road
scottsdale, arizona 85262
APN: 216-70-008

25 june 2004
copyright 2004
0142


DeBARTOLO architects

4450 north twelfth street
number 268
phoenix, arizona 85014
tel 602.264.6617
fax 602.264.0891



map of dedication
615-04
native plant plan
195-04

DRB case
38.DR.2003



civil plan check
4642.01.4
plan check
4642.01.3

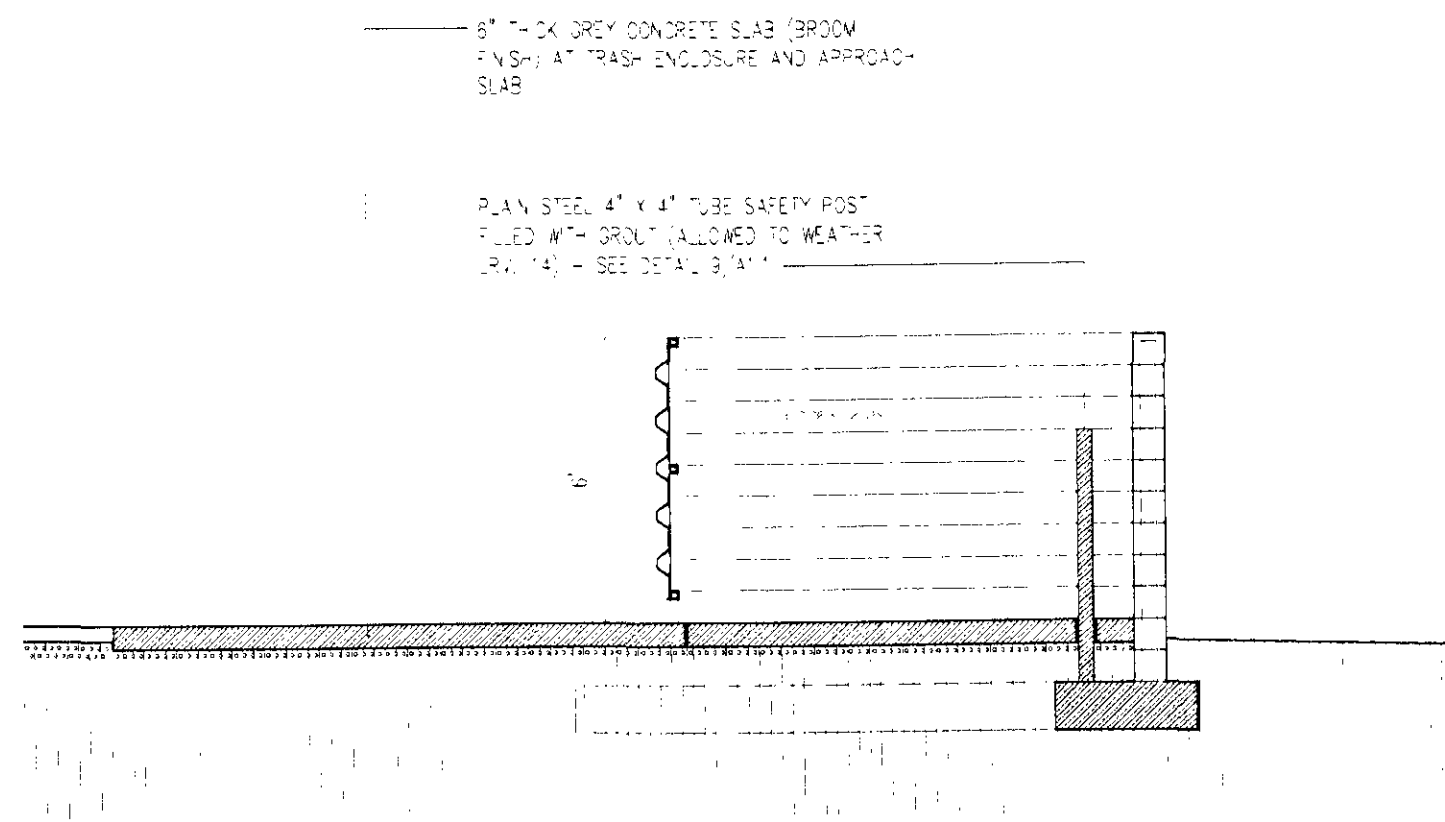


3 refuse enclosure section
A1.3 SCALE: 1/4" = 1'-0"

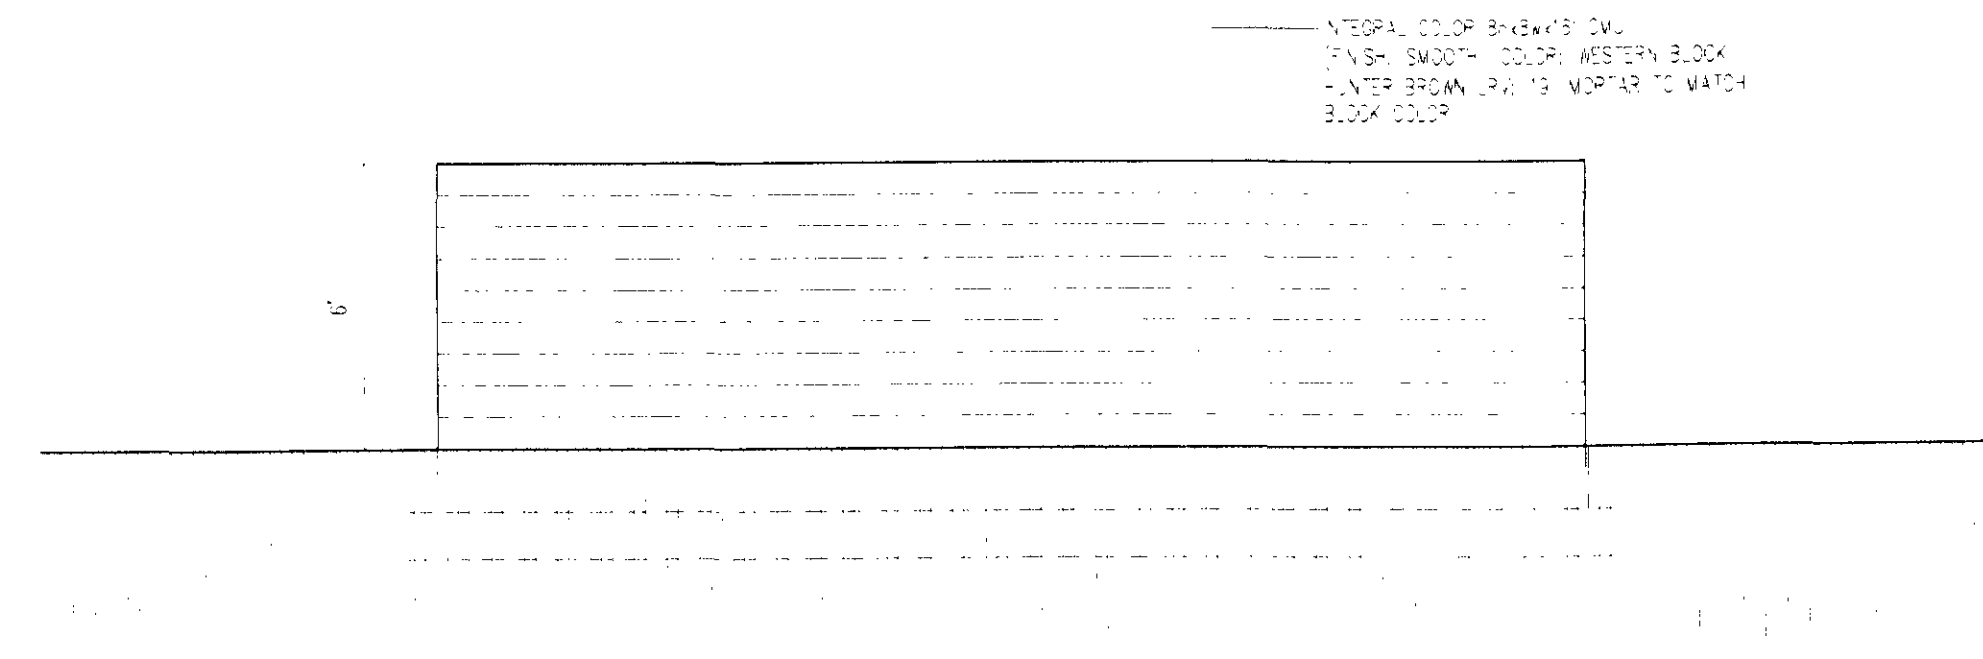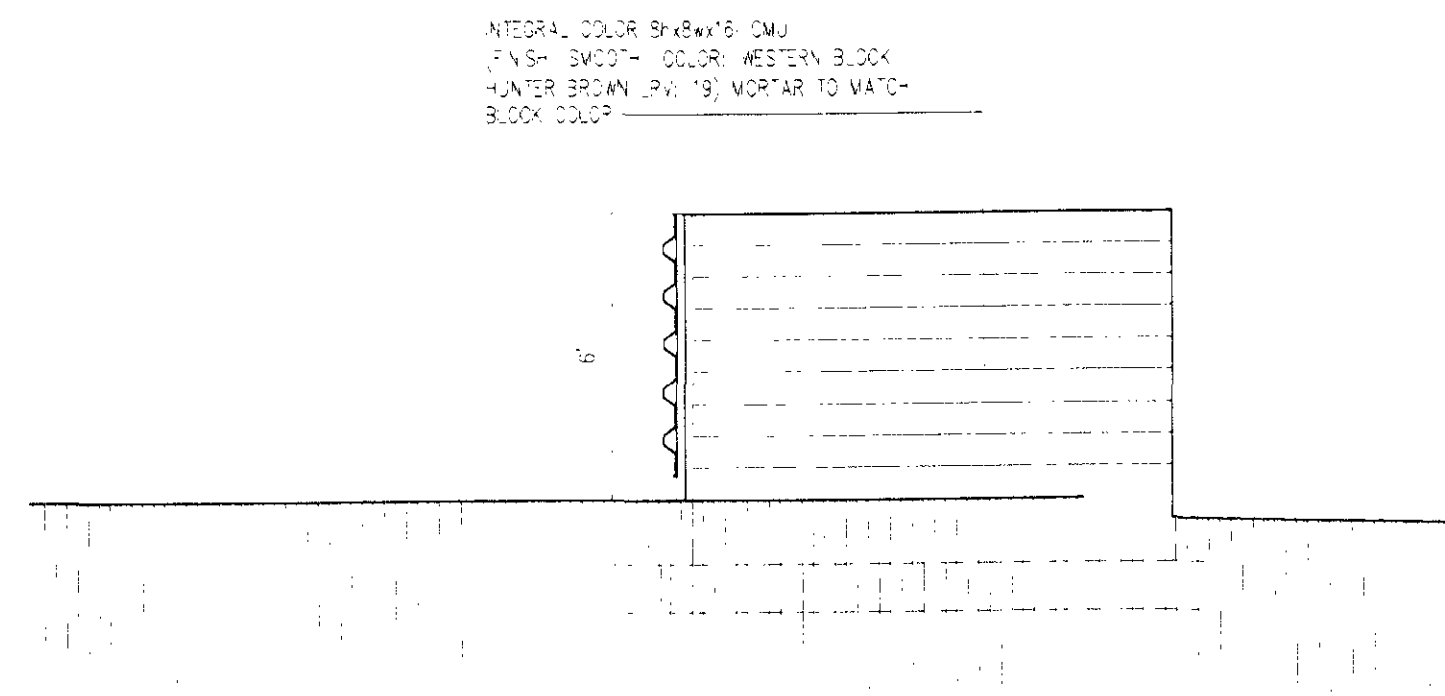



4 refuse enclosure south elevation
A1.3 SCALE: 1/4" = 1'-0"

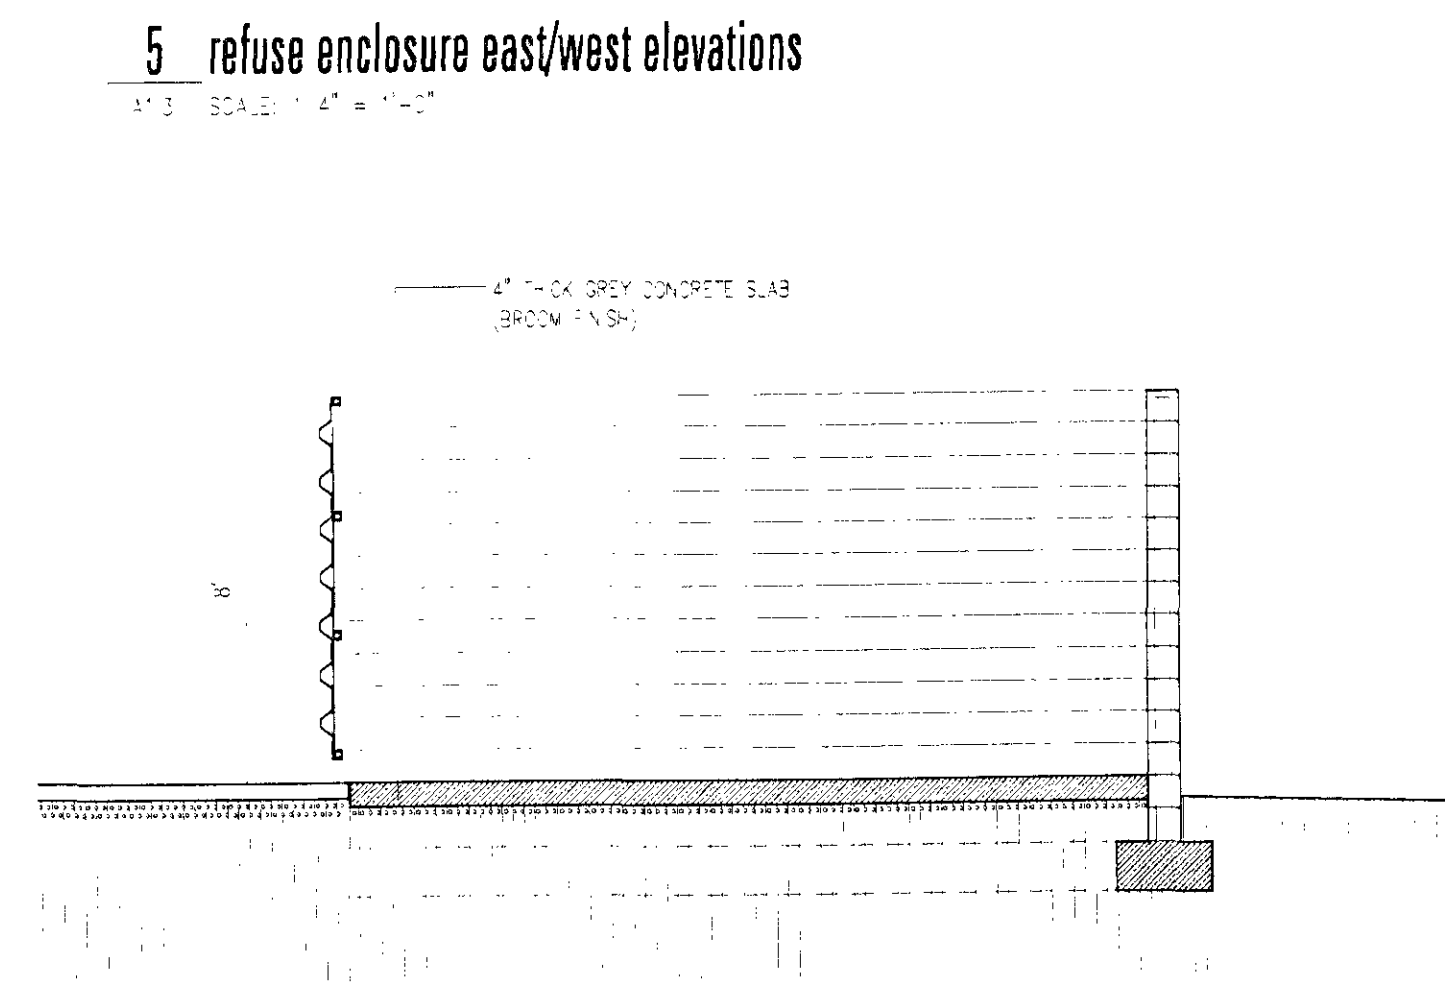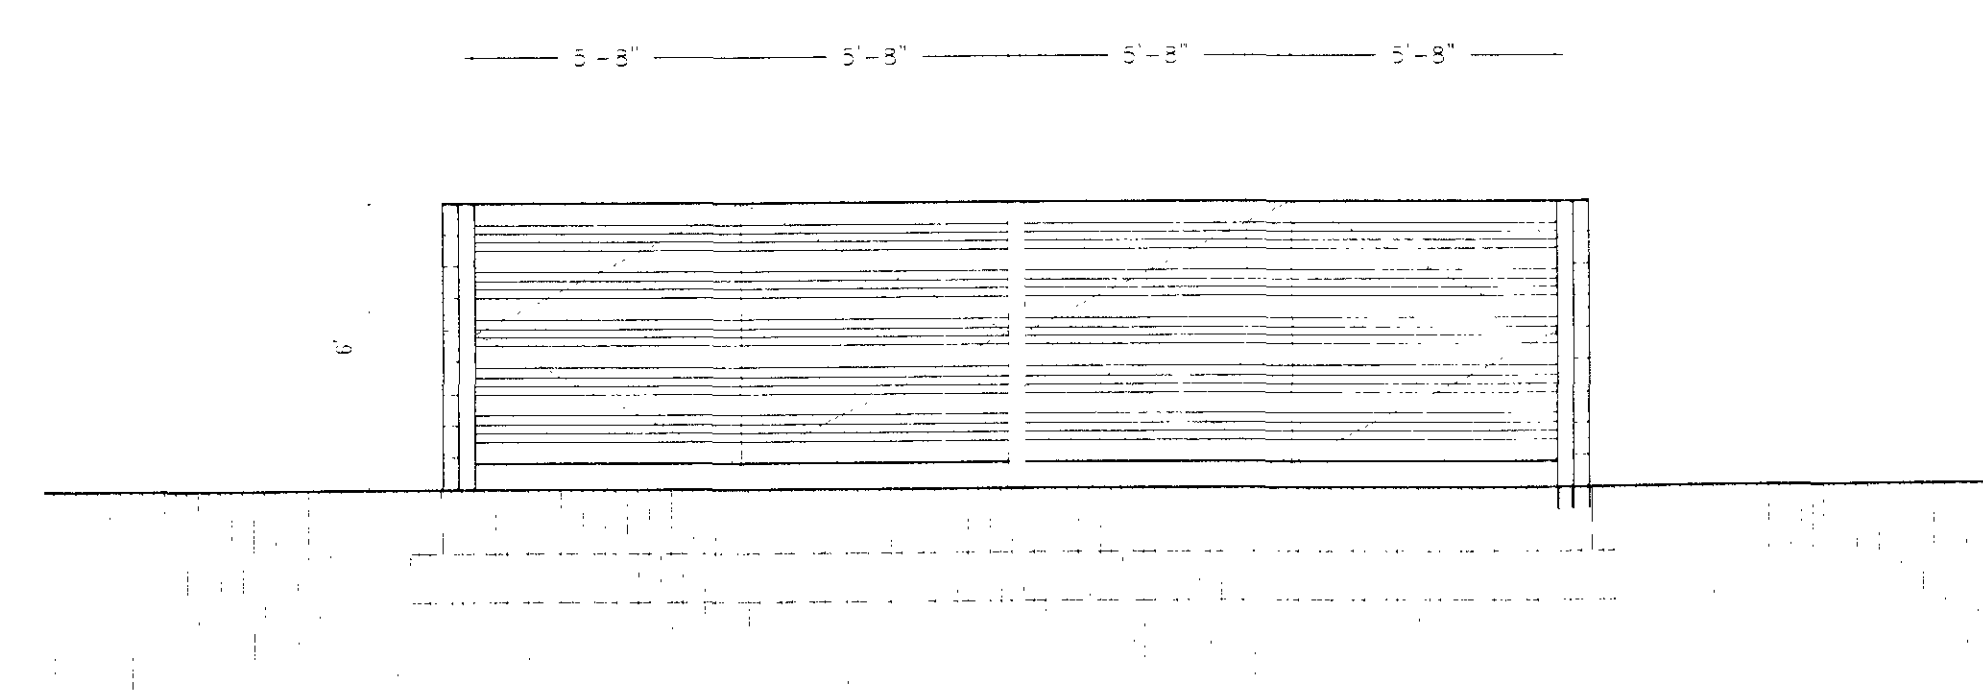


5 refuse enclosure east/west elevations
A1.3 SCALE: 1/4" = 1'-0"

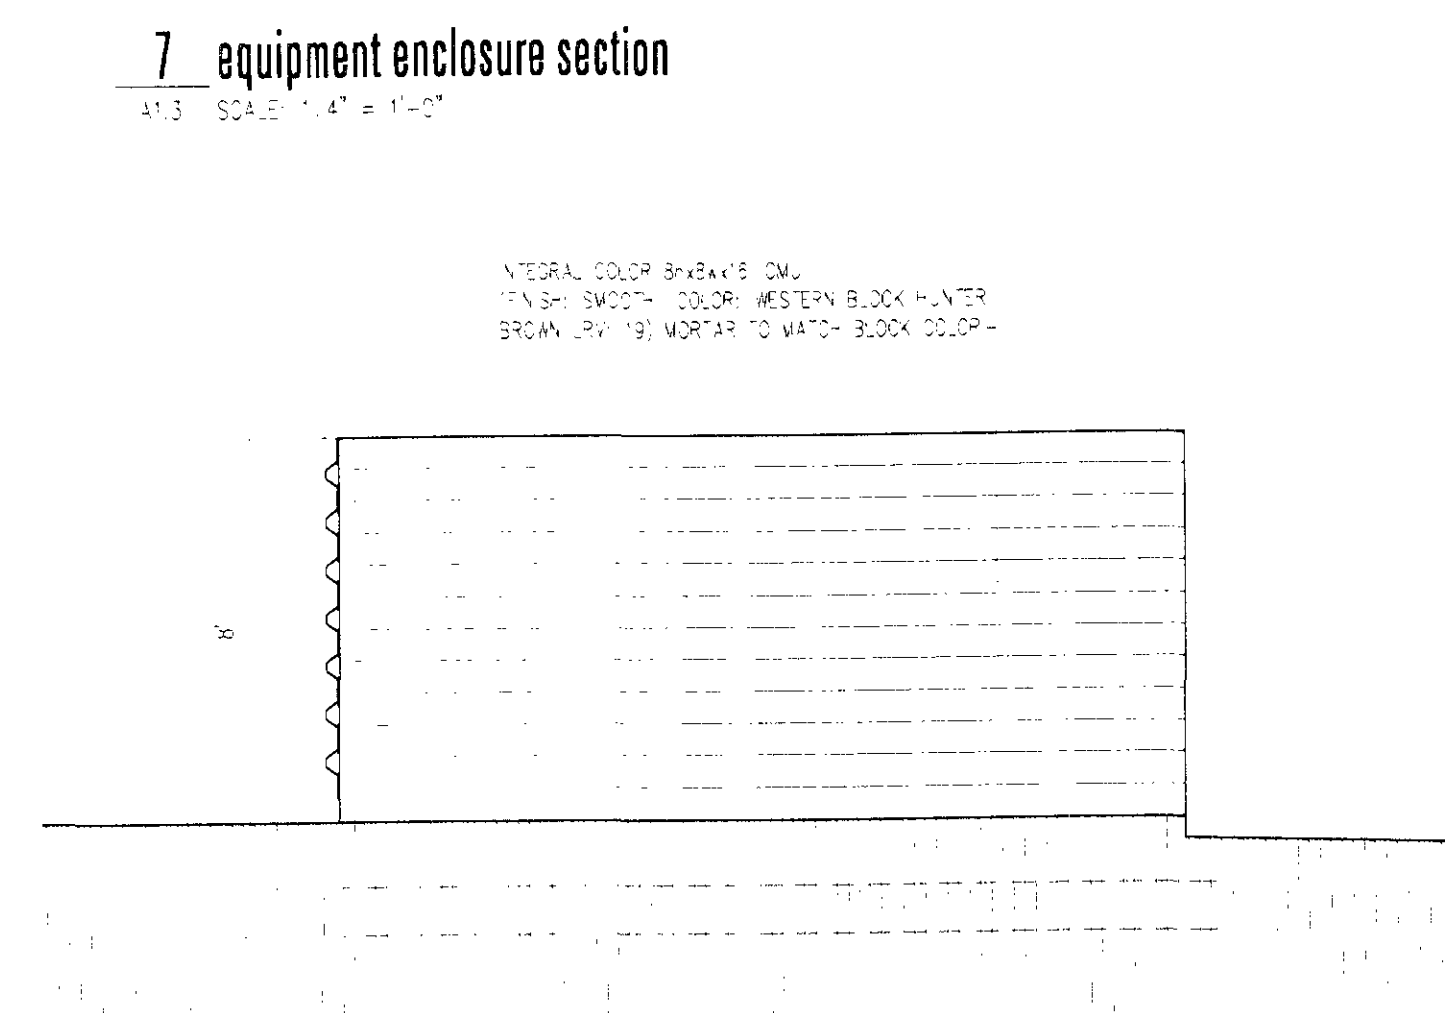


7 equipment enclosure section
A1.3 SCALE: 1/4" = 1'-0"

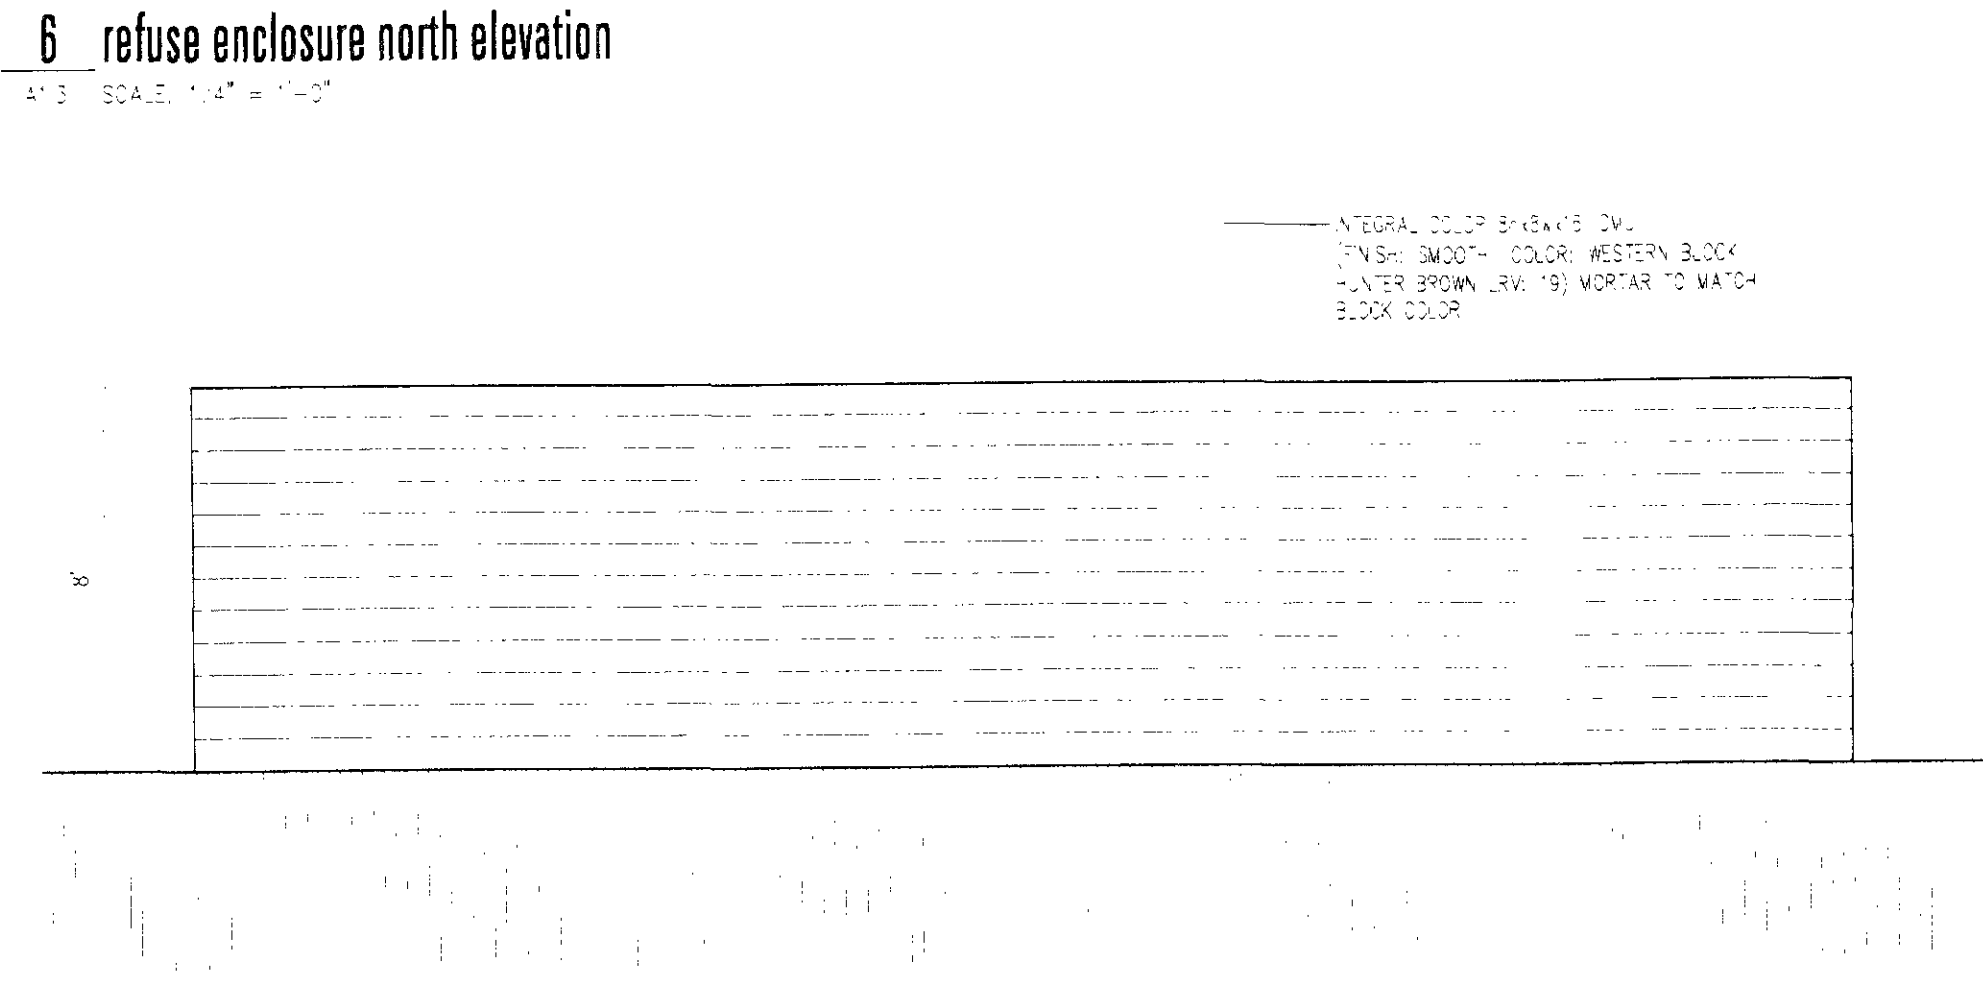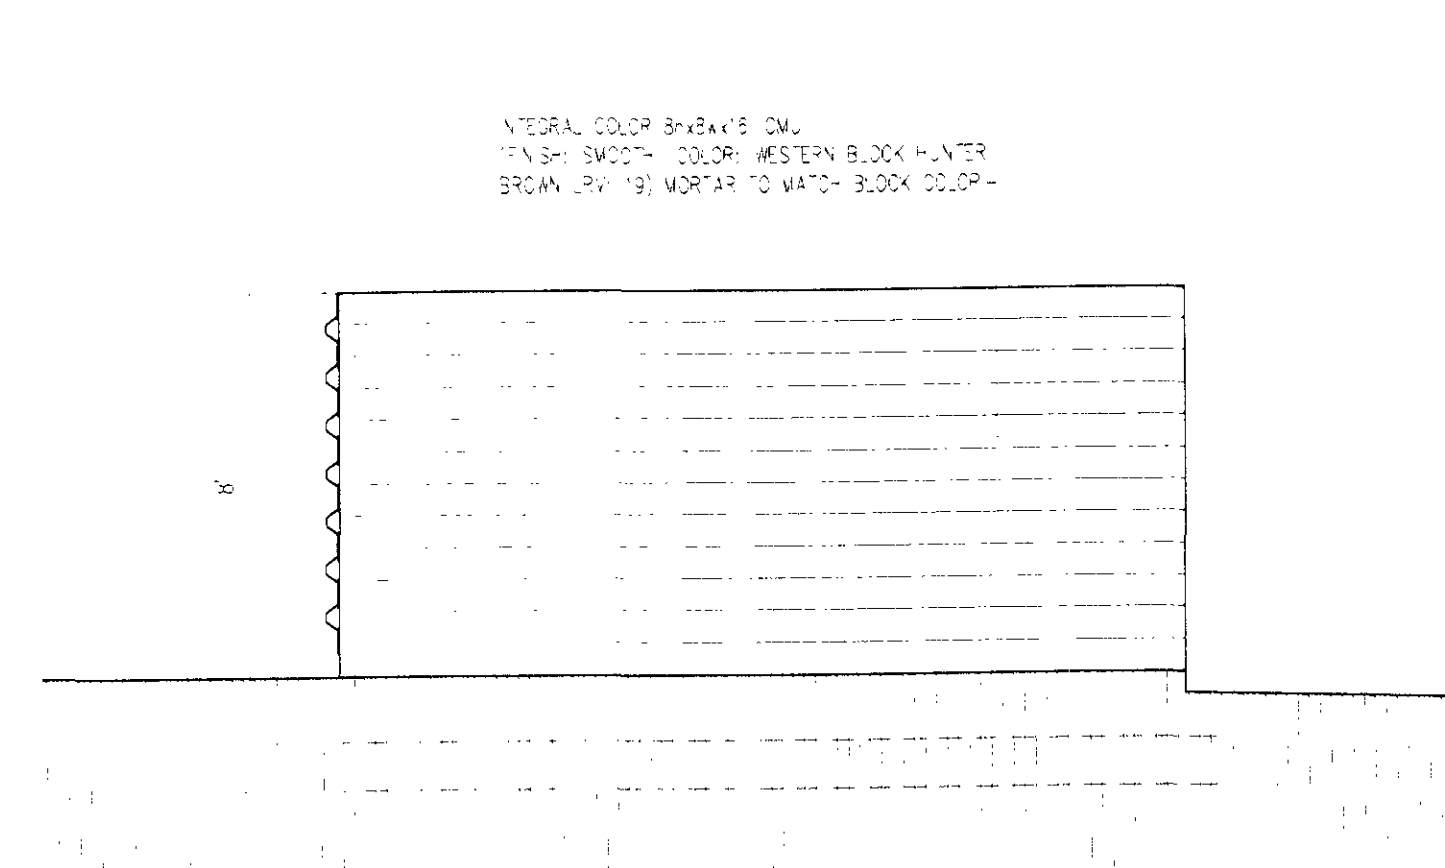

6 refuse enclosure north elevation
A1.3 SCALE: 1/4" = 1'-0"

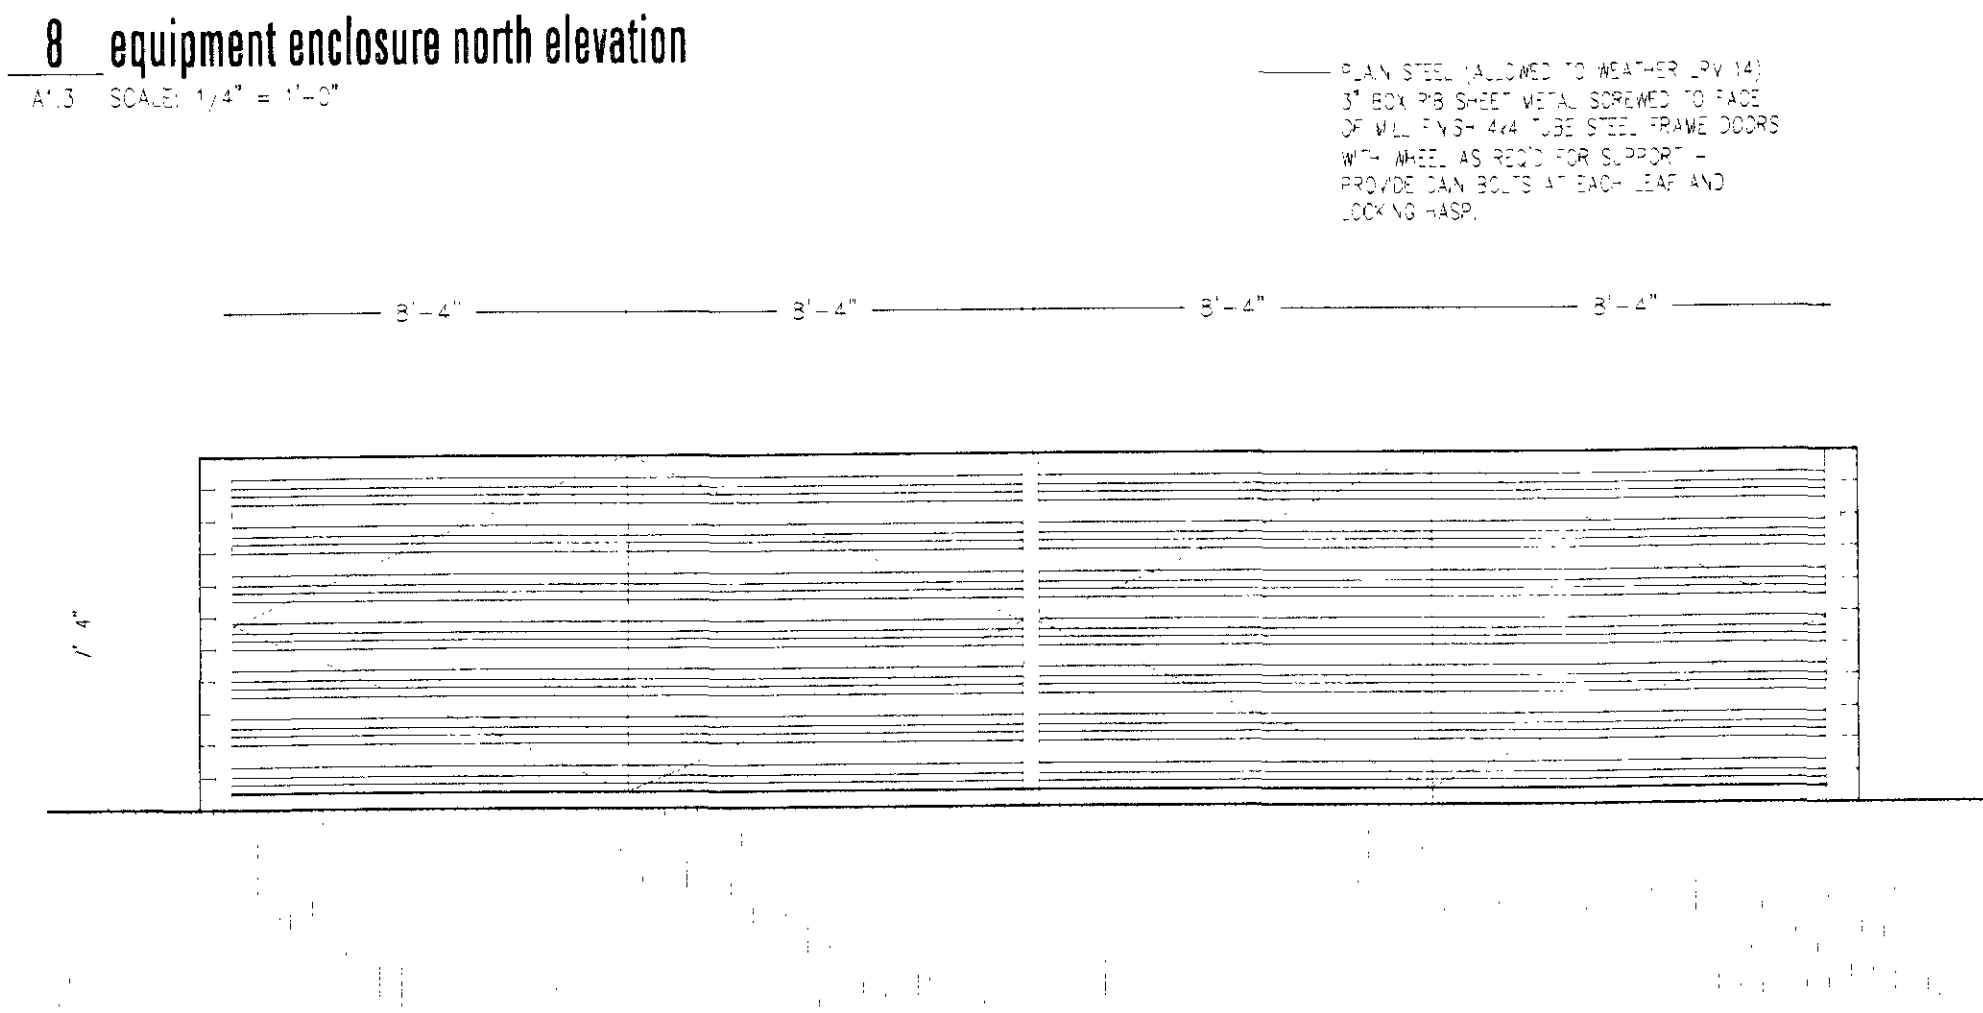

8 equipment enclosure north elevation
A1.3 SCALE: 1/4" = 1'-0"

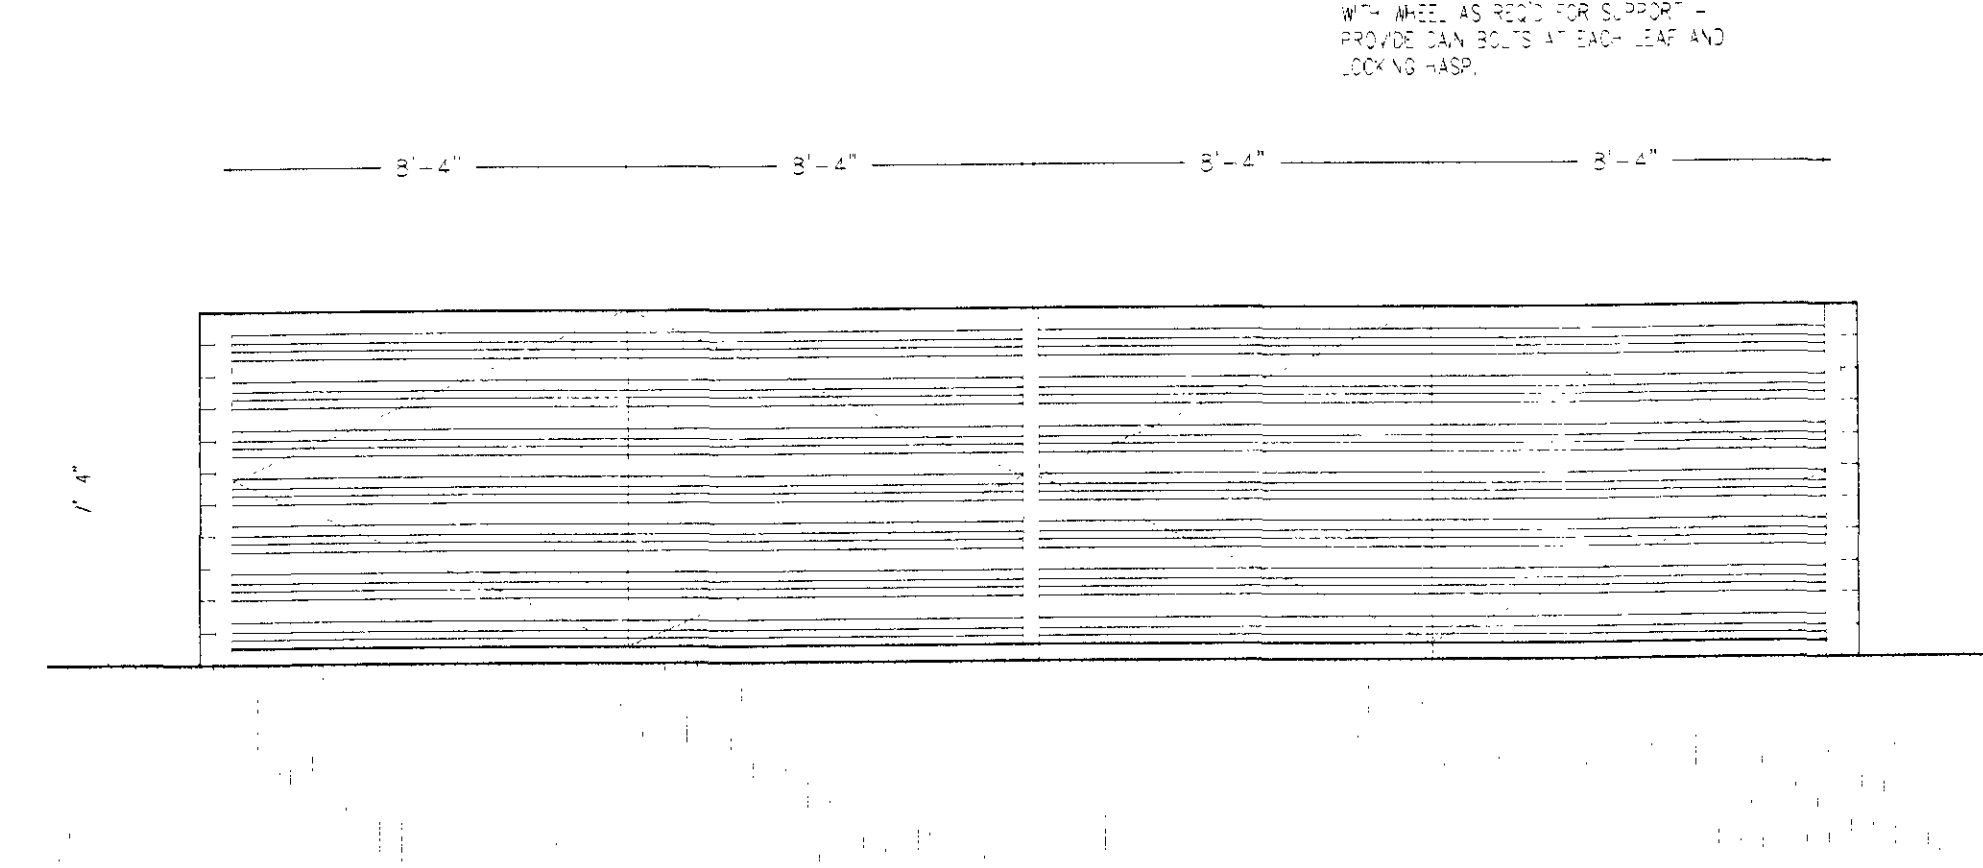


9 equipment enclosure east/west elevation
A1.3 SCALE: 1/4" = 1'-0"



10 equipment enclosure south elevation
A1.3 SCALE: 1/4" = 1'-0"



1 refuse enclosure
A1.3 SCALE: 1/4" = 1'-0"

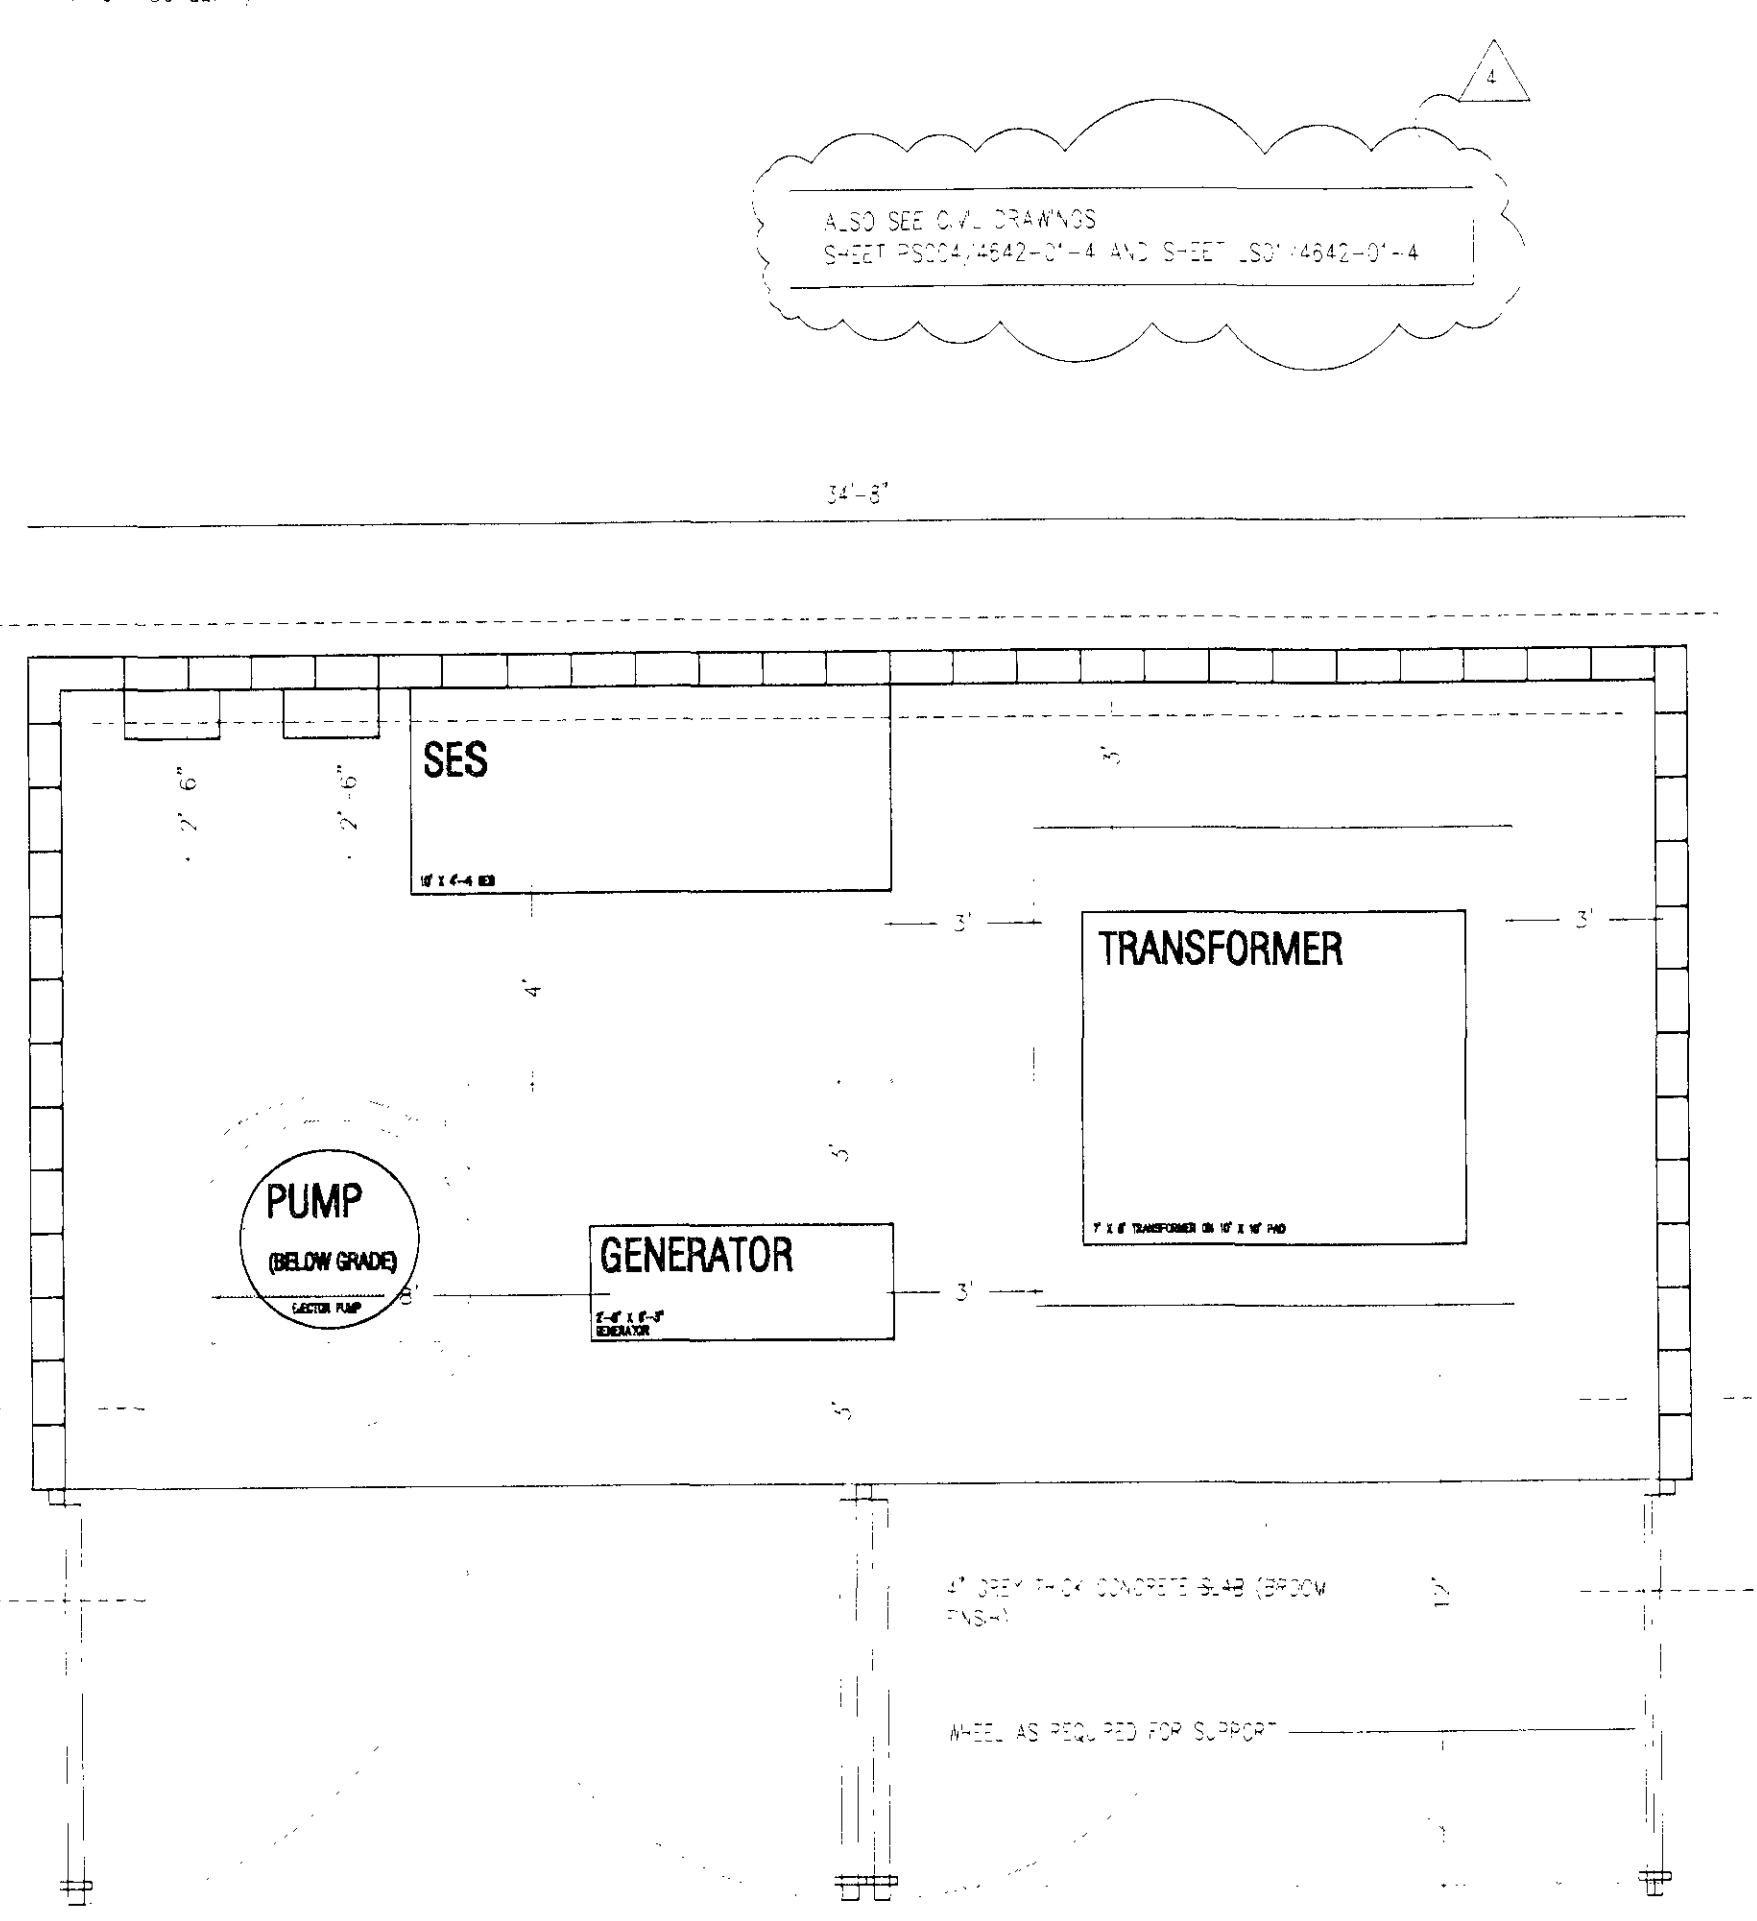

2 equipment enclosure
A1.3 SCALE: 1/4" = 1'-0"



general notes

1. LRV IS GREATER THAN 35 AT THE TIME OF REQUEST FOR TEMPORARY / PERMANENT CERTIFICATE OF OCCUPANCY - MATERIALS ALLOWED TO WEATHER WILL BE ACCELERATED TO OBTAIN AN LRV OF 35 OR LESS. MATERIALS ALLOWED TO WEATHER AND NOT EXCEED A LRV OF LESS THAN 35 - WILL NOT BE SEALED OR ALTERED FROM THEIR NATURAL CONDITION.

- 11 JUNE 2004 OWNER CHANGES
- 13 JULY 2004 FIRST REVIEW
- 03 SEP 2004 OWNER CHANGES
- 17 SEP 2004 SECOND REVIEW

A1.3

site details

scottsdale first assembly
DREAM CENTER

28700 north pima road
scottsdale, arizona 85262
APN: 216-70-008

25 june 2004
copyright 2004
0142

DeBARTOLO architects
4450 north twelfth street
number 268
phoenix, arizona 85014
tel 602.264.6617
fax 602.264.0891

map of dedication
615-04
native plant plan
195-04

DRB case
36.DR.2003

civil plan check
4642.01.4
plan check
4642.01.3