

MASTER DRAINAGE REPORT

FOR THE

SCOTTSDALE WATERFRONT

SOUTHWEST CORNER OF CAMELBACK ROAD
AND SCOTTSDALE ROAD

Prepared for:

Scottsdale Waterfront Partners, L.L.C.
C/o Golub and Company
625 North Michigan Avenue, 20th Floor
Chicago, IL 60611
(312) 440-8763

Prepared by:

Brooks, Engineers & Surveyors, Inc.
4602 East Elwood Street #16
Phoenix, Arizona 85040
(602) 437-3733
Job No. 1149-01FF

September 29, 2003

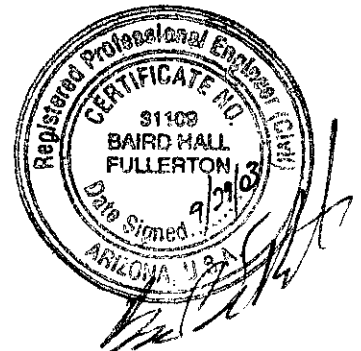


TABLE OF CONTENTS

- I. Introduction
- II. Existing Site Conditions
 - On-site
 - Off-site
- III. Proposed Development
 - Drainage of Perimeter Streets
 - On-site Drainage
- IV. Special Conditions
 - Arizona Canal Side Channel Inlets
- V. Conclusions
- VI. Appendix
 - Vicinity Map
 - Aerial Photo
 - Existing Conditions Maps
 - Elevation Exhibit
 - FEMA Maps
 - Topographic Map
 - Concept Grading Plan
 - Calculations



I. INTRODUCTION

The Scottsdale Waterfront is located between Camelback Road and the Arizona Canal, and extends from Goldwater Boulevard to Scottsdale Road.

The site is approximately 11.3 acres, divided into two triangular areas of roughly 7 and 4 acres each. Proposed development includes several buildings with underground parking. The parking garages will be two or three levels deep with the 7 and 4-acre areas functioning as separate garages. Approximately 891,000 SF of residential space and 99,000 SF of retail space are included in the current development plan.

The purpose of this report is to define drainage requirements for the entire 11-acre area. This project will be phased. The majority of the required drainage improvements will be constructed as part of phase 1. This report will be revised as each phase of the project proceeds through the plan development and permitting process. The design for each phase will comply with the overall drainage requirements outlined in this report.

Of particular importance is the requirement by the Flood Control District (FCD) to maintain the original design capacity of the inlets to the 84-inch side channel along the Arizona Canal. Before detailed site drainage designs can be undertaken, agreement must be reached with FCD as to the capacity of these inlets and a method of maintaining their function.

II. EXISTING SITE CONDITIONS

On-site

The site is vacant with the exception of two irrigation wells owned by Arcadia Water Company. Previous development included several buildings and parking areas, which were demolished in 1998. Historically, all stormwater was conveyed to the side channel (84-inch storm drain) in the north bank of the Arizona Canal via surface drainage inlets. No on-site stormwater retention is evident from historical aerial photographs of the site.

The site is generally flat, with some southerly slope to the Arizona Canal. The intersection of Marshall Way and Montecito Court is elevated several feet above existing grade in anticipation of a future bridge across the canal. Camelback Road is the north boundary and is fully developed. Marshall Way, Montecito Court, and Goldwater Boulevard bound the west and northwest portion of the site and are fully improved. The Arizona Canal bounds the southeast side of the property.

In 1999 fill was placed and a Letter of Map Revision (LOMR) was filed with the Federal Emergency Management Agency (FEMA) to remove the site from Flood Hazard Zone 'A'. Current Flood Insurance Rate Maps (FIRM) show that this site is classified as Flood Zone 'X' and Flood Zone 'X' shaded (FIRM panels 04013C1695G and 04013C2160E are included in the Appendix).

Off-site

The site is within the Camelback Road Watershed. The Camelback Road storm drain was designed to intercept the 25-year storm event. Runoff in excess of this is stored along the north side of the Arizona Canal near 64th Street. Eventually this drains to the side channel constructed along the canal and back into the Camelback Road storm drain, or west to the City of Phoenix at 64th Street and the Arizona Canal.

When the Nordstrom site was developed in 1997, a 42-inch storm drain was constructed to convey on-site flows for the site and those portions of Marshall Way south of Camelback Road, and Montecito Court east of Goldwater Boulevard, to the 84-inch diameter side channel along the Arizona Canal. This storm drain was sized to intercept the 100-year event. No on-site retention was provided.

There are four inlets in the side channel adjacent to the project site. Previous development allowed on-site runoff to sheet flow across paved areas into these inlets. Additionally, off-site flows could reach these inlets. When the property was raised out of the FEMA flood hazard zone in 1999, the likelihood of overland flows reaching some of these inlets was reduced.

The City of Scottsdale and the Flood Control District of Maricopa County have stipulated that the proposed development maintain the original capacity of these inlets. This is the basis of design for off-site flows. Additionally, the City of Scottsdale has stated that no on-site retention will be required and additional connections may be permitted to convey on-site runoff directly to the existing 84-inch side drain.

III. PROPOSED DEVELOPMENT

Drainage for Perimeter Streets

Marshall Way and Montecito Court will be partially reconstructed to provide vehicular turning movements and surface parking. The existing storm drain inlets will also be reconstructed, however, it is anticipated that drainage patterns and capacities will remain unchanged.

Camelback Road will be widened by one lane on the south side, and the median will be reconfigured. There is one existing storm drain inlet (MAG 535 type) approximately 150 feet east of Scottsdale Road. This is in line with the proposed south curb alignment and will be replaced with a curb opening inlet catch basin of similar capacity.

On-site Drainage

This project is not required to provide on-site retention. The open space areas, driveways, building roof drains, and loop road through the larger 7-acre site will be designed to convey stormwater directly to the existing side channel. This will be accomplished in a variety of ways including trench drains, area drains, sheet flow, and building roof drain connections.

Specific calculations and drainage component designs cannot be provided at this time as the site plan and underground garage configurations are still being developed.

Proposed finish floor elevations are shown on the conceptual grading plan included in this report. This grading scheme assumes the garage is all at one elevation, which forces the building floors to be at one elevation also. This creates some issues with pedestrian access along Camelback Road.

However, if the underground parking garage is stepped down or sloped, the finish floor elevations will be set as shown on the Elevation Exhibit (see Appendix). This provides a much better transition for pedestrians to the perimeter of the site. The lowest finish floor is shown at 1279.00, which is 1.5 feet above the high gutter of Scottsdale Road as it crosses the Arizona Canal.

IV. SPECIAL CONDITIONS

Inlets to the 84-inch Side Drain

The primary intent of this section of the report is to establish design parameters for the inlets to the 84-inch side drain. This project is required by FCD to maintain the original design intent of these inlets by providing equivalent inlet capacity.

There are four existing inlets to the side channel along the projects canal frontage. The southwesterly inlet will remain in place. Recent construction activity, including the placement of fill in conjunction with the LOMR application, has not impacted this inlet.

The as-built plans for the 84-inch side drain have been reviewed in order to calculate the capacity of the remaining inlets as they were originally intended to function. A design report for this facility is not available. The plans indicate a swale was graded along the north bank of the canal to a depth of approximately 1.5 feet, with a flow line sloping to the southwest varying from 0.0015 ft/ft to 0.0082 ft/ft. This swale was intended to capture overland flow before it entered the canal and direct it to the side drain inlets. Two sections through the swale near inlet #3 (see calculations in the Appendix) were evaluated to determine approximate flow capacity. Results of this analysis indicate the swale capacity varies from 25 to 92 cfs.

The existing inlet capacities are approximately 129 cfs each based on the depth of the swale and surface area of the grates. The orifice equation was used assuming a flow depth of 1.5 feet. This is based on the minimum dimensions shown on the original design plans. This figure neglects any clogging factor, which would have been applied in standard design practice. Actual design values would have been approximately 65 cfs per inlet, assuming a 50% clogging factor for the grates. Any reconfiguration of the inlets should duplicate this capacity. Please refer to the appendix for calculations and copies of selected portions of the referenced plan set.

It is likely that the design intent was for overland flows intercepted by the swale to be distributed between the inlets. A similar conveyance between proposed inlets should be provided.

There are three inlets affected by recent and proposed development. It is proposed that two of these be replaced by similar inlets behind the southerly curb of Camelback Road. A storm drain could be constructed connecting these to the 84-inch side drain near the intersection of Scottsdale Road and Camelback

Road. These inlets should provide a similar net surface area and water depth in order to duplicate the original capacity of the existing inlets. It may be necessary to construct several smaller inlets to achieve this within the landscape setback of the proposed development.

The inlets should be constructed with a grate elevation of 1276.00. This will provide the required 1.5 feet of water over the inlets as calculated in the Appendix, and is based on the existing high gutter of the Scottsdale Road bridge at 1277.50. Ponding in Camelback Road is unlikely to occur above this elevation. The hydraulic grade line for the existing side drain is unknown. However, the proposed inlet elevations are higher than the existing inlets.

If the proposed inlets are set higher, the grate area should be increased and the assumed water surface elevation should remain at 1277.50. A typical grading section through Camelback Road to the proposed finish floor is shown in the Appendix.


Finally, the northeasterly inlet will be relocated closer to Scottsdale Road. A swale will be constructed in the landscape area to convey stormwater overtopping the curb near the street intersection to this inlet.

This solution allows the existing storm drain systems in Camelback Road, Marshall Way, and Montecito Court to function essentially as they were originally designed, while preserving the original inlet capacity of the side drain.



V. CONCLUSIONS

The existing inlet capacities are approximately 129 cfs each. Therefore, the proposed inlets along the south side of Camelback Road will have a total capacity of 258 cfs (without clogging factor), with a storm drain line of 129 cfs capacity connecting them to the existing 84-inch side channel near Scottsdale Road. The northeast inlet will be relocated and will have a capacity of 134 cfs (without clogging factor).

VI. APPENDIX

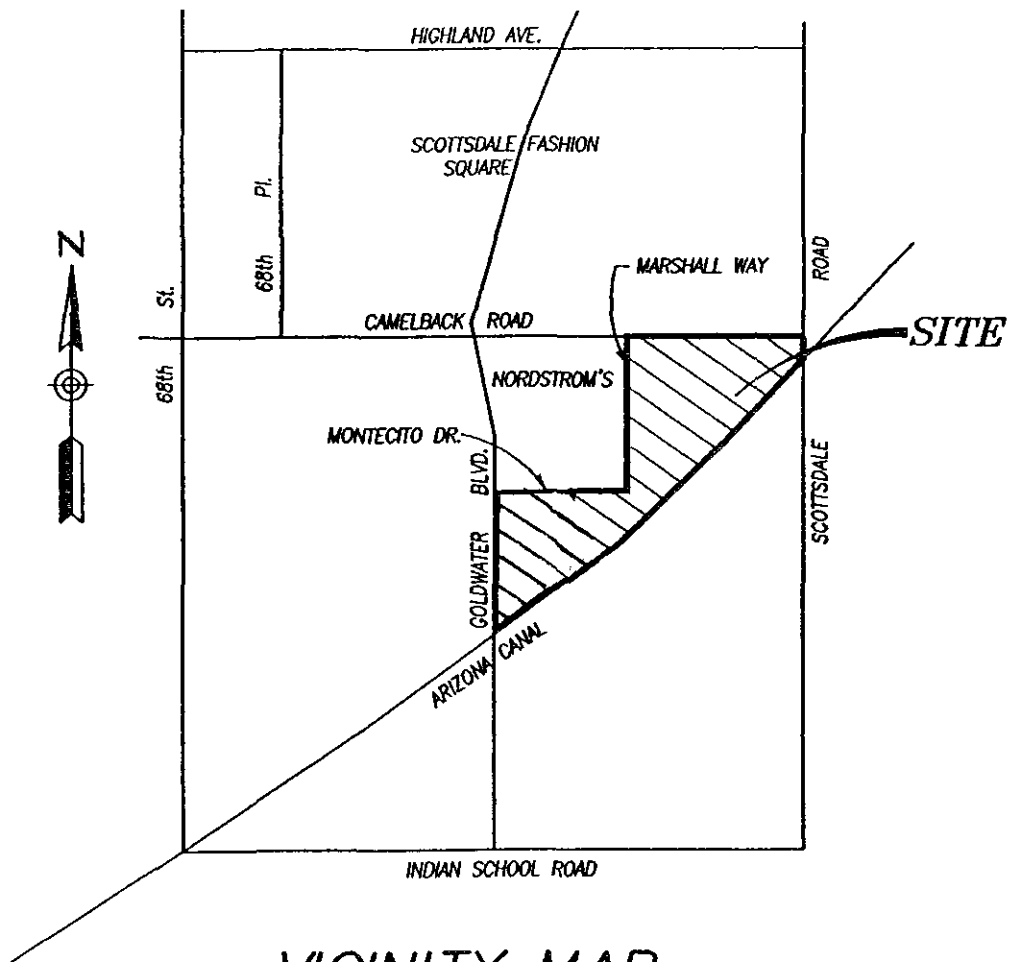

VICINITY MAP
N.T.S.

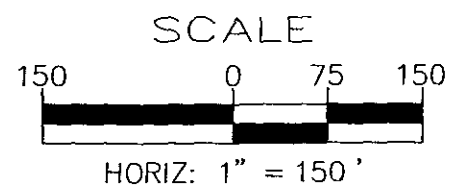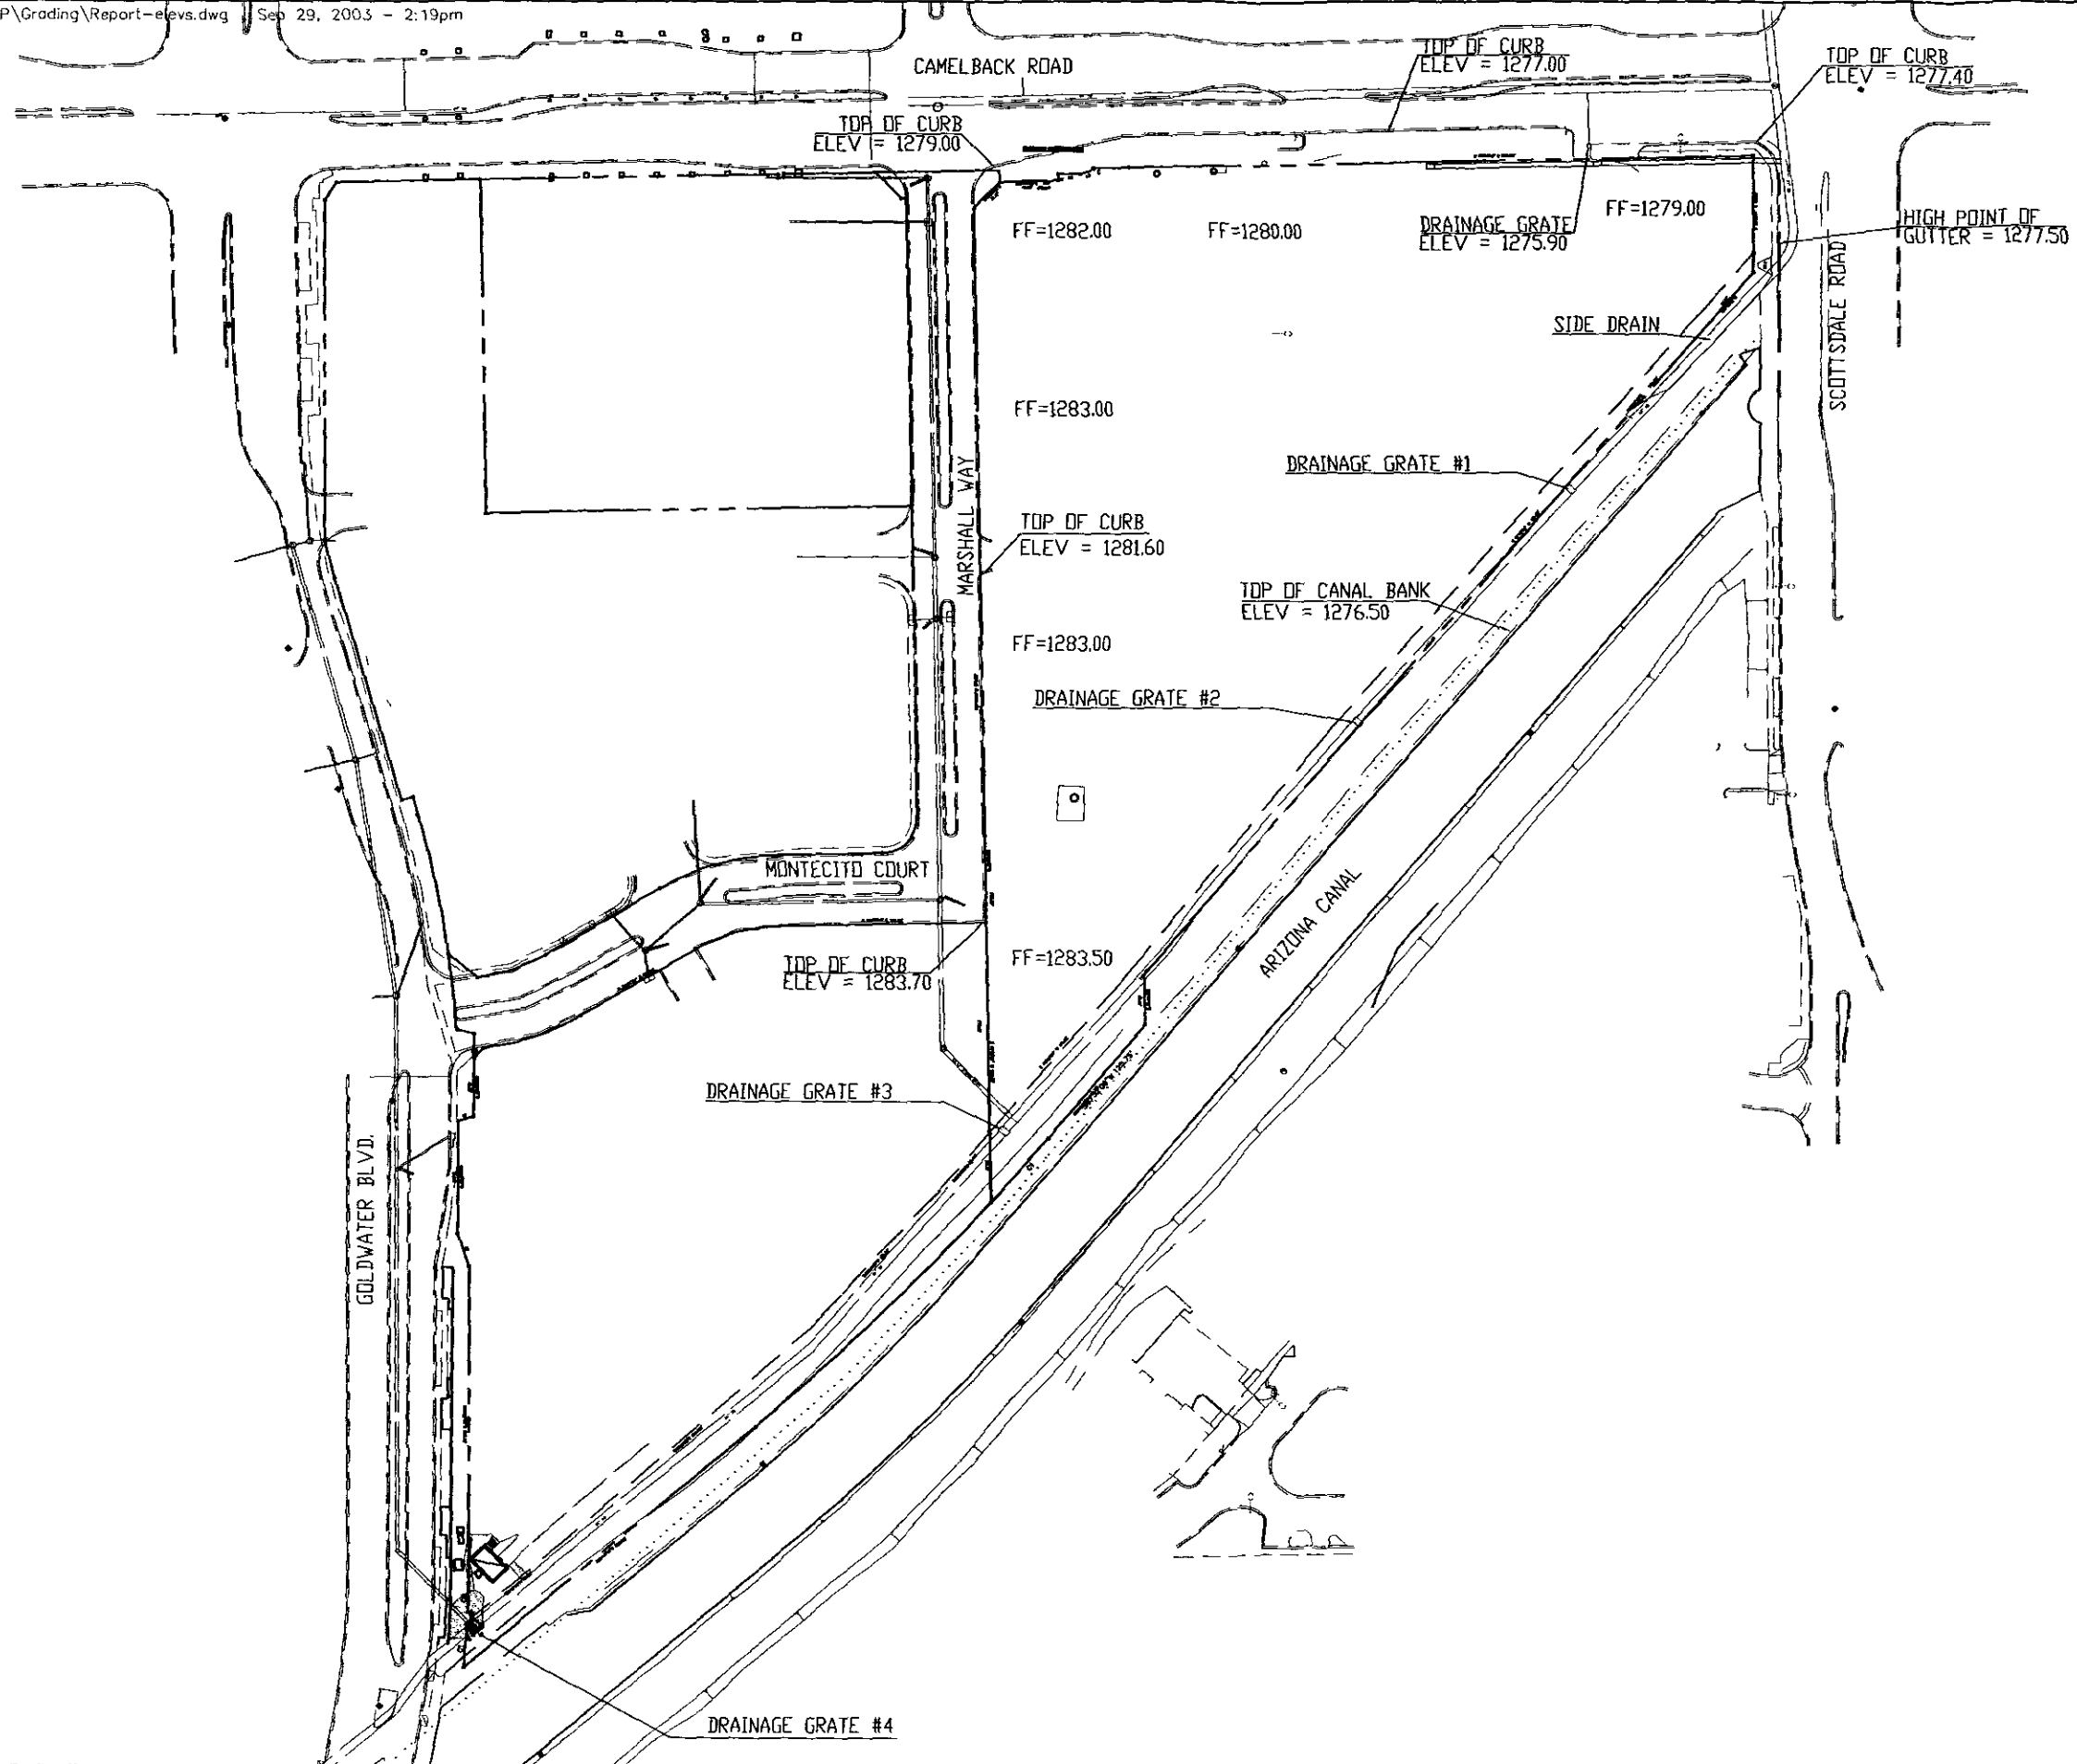


	BY	DATE
DESIGNED	BHF	9/26/03
DRAWN	SAH	9/26/03

SCOTTSDALE WATERFRONT
 ELEVATION EXHIBIT

JOB NUMBER	1149-01FF
SHEET	OF
1	1

REFERENCE MARK (FEET MOVD)	ELEVATION REFERENCE MARK	DESCRIPTION OF LOCATION
RM447 1296.49	A brass cap set flush with pavement on centerline of point of curvature on Gulf Freeway south of Indian Road West, established by Planning Research Corporation.	
RM448 1295.87	A brass cap set flush with pavement on centerline of intersection of Scottsdale Road and Indian Road, established by Planning Research Corporation.	
RM449 1294.73	A brass cap set flush with pavement on centerline of intersection of Scottsdale Road and Indian Road, established by Planning Research Corporation.	
RM450 1288.34	A brass cap set flush with pavement on centerline of intersection of Scottsdale Road and Indian Road, established by Planning Research Corporation.	
RM451 1287.88	A brass cap set flush with pavement on centerline of intersection of Indian Road and Scottsdale Road, established by Planning Research Corporation.	
RM452 1284.27	A brass cap set flush with pavement on centerline of intersection of Indian Road and McDonald Drive, established by Planning Research Corporation.	
RM453 1258.41	A brass cap set flush with pavement on centerline of intersection of Indian Road and McDonald Drive, established by Planning Research Corporation.	
RM454 1243.74	A brass cap set flush with pavement on centerline of intersection of Indian Road and McDonald Drive, established by Planning Research Corporation.	

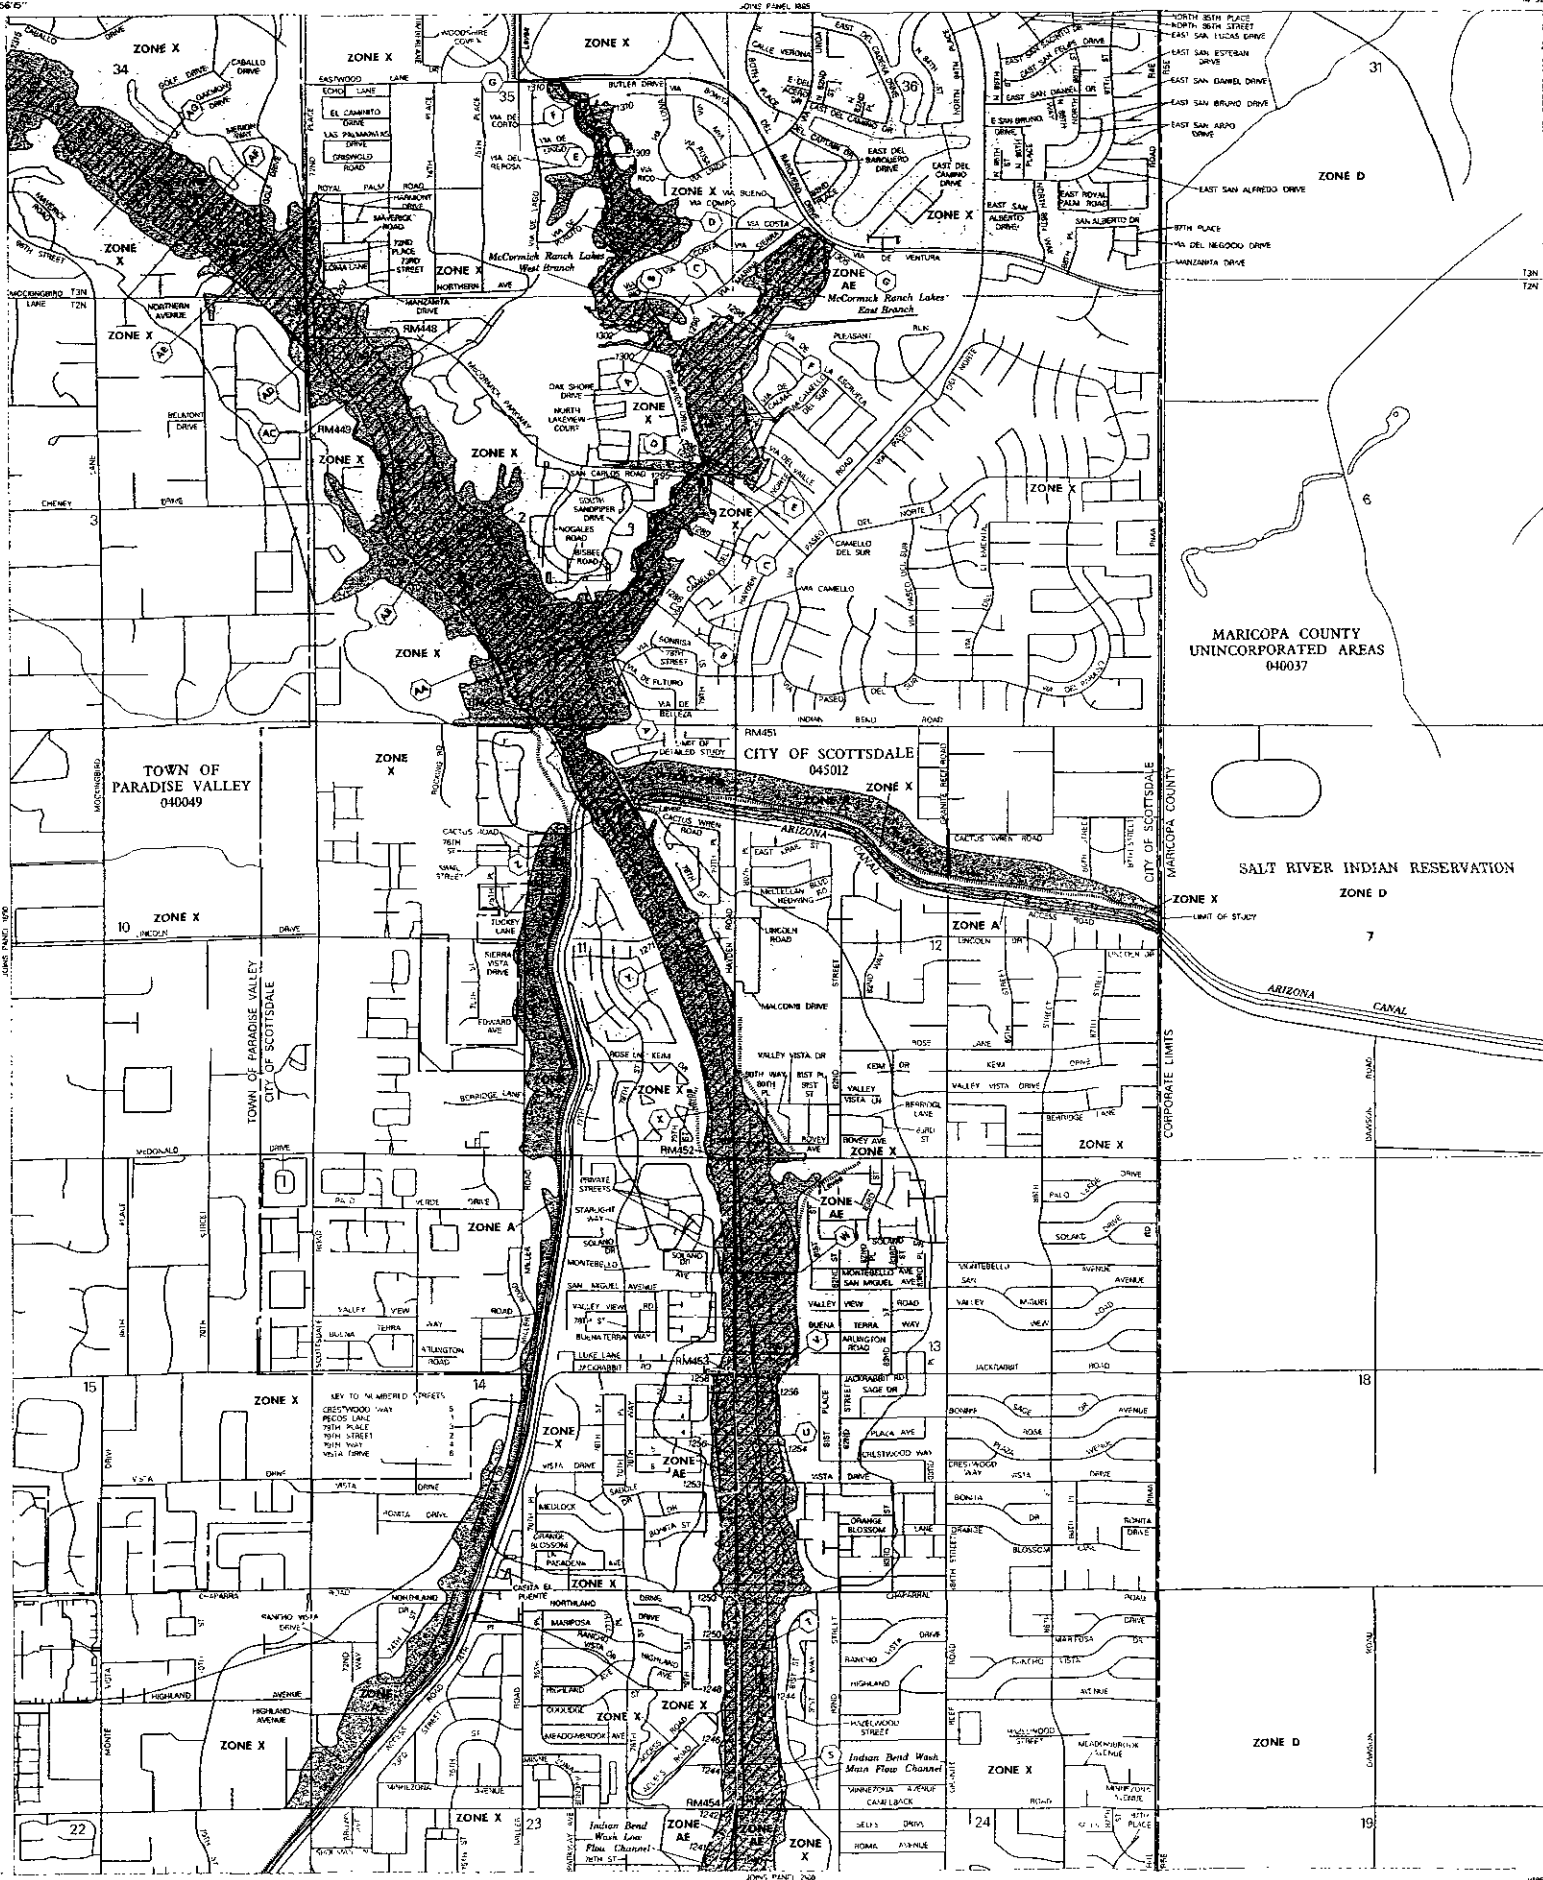

LEGEND

SPECIAL FLOOD HAZARD AREAS INUNDATED BY TYPICAL FLOODS

- ZONE A** Area of Special Flood Hazard Areas Inundated by Typical Floods
- ZONE AE** Area of Special Flood Hazard Areas Inundated by Typical Floods
- ZONE AH** Area of Special Flood Hazard Areas Inundated by Typical Floods
- ZONE AO** Area of Special Flood Hazard Areas Inundated by Typical Floods
- ZONE AP** Area of Special Flood Hazard Areas Inundated by Typical Floods
- ZONE AV** Area of Special Flood Hazard Areas Inundated by Typical Floods
- ZONE VE** Area of Special Flood Hazard Areas Inundated by Typical Floods

FLOODWAY AREAS IN ZONE AE

OTHER FLOOD AREAS

- ZONE X** Area of Special Flood Hazard Areas Inundated by Typical Floods
- ZONE D** Area of Special Flood Hazard Areas Inundated by Typical Floods

UNDESIGNED CHANNELS

NOTES

This map is based on information from the National Flood Insurance Program... (text continues with detailed notes about the map's accuracy and usage)

APPROXIMATE SCALE IN FEET

0 100 200

LEGEND

NOTE: This map is based on information from the National Flood Insurance Program... (text continues with detailed notes about the map's accuracy and usage)

NATIONAL FLOOD INSURANCE PROGRAM

FIRM

FLOOD INSURANCE RATE MAP

MARICOPA COUNTY, ARIZONA AND INCORPORATED AREAS

PANEL 1695 OF 4350

DATE MAP MADE FOR PANEL: NOT PRINTED

CONTAINS:


NO.	DESCRIPTION	DATE
1	ADDITIONAL FIRM PANELS	1998
2	ADDITIONAL FIRM PANELS	1998
3	ADDITIONAL FIRM PANELS	1998

MAP NUMBER: 0401261695 G

MAP REVISED: JULY 19, 2001

Federal Emergency Management Agency

SCOTTSDALE WATERFRONT S/W COR. CAMELBACK RD. & SCOTTSDALE RD SCOTTSDALE, ARIZONA CONCEPTUAL GRADING & DRAINAGE PLAN

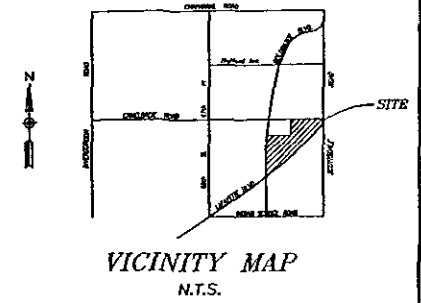

CITY OF SCOTTSDALE GENERAL CONSTRUCTION NOTES FOR PUBLIC WORKS CONSTRUCTION

- ALL CONSTRUCTION IN THE PUBLIC RIGHTS-OF-WAY OR IN EASEMENTS GRANTED FOR PUBLIC USE MUST CONFORM TO THE LATEST MARICOPA ASSOCIATION OF GOVERNMENTS (MAG) UNIFORM STANDARD SPECIFICATIONS AND UNIFORM STANDARD DETAILS FOR PUBLIC WORKS CONSTRUCTION AS AMENDED BY THE LATEST VERSION OF THE CITY OF SCOTTSDALE (COS) SUPPLEMENTAL STANDARD SPECIFICATIONS AND SUPPLEMENTAL STANDARD DETAILS. IF THERE IS A CONFLICT, THE LATTER SHALL GOVERN.
- THE ENGINEERING DESIGNS ON THESE PLANS ARE ONLY APPROVED BY THE CITY IN SCOPE AND NOT IN DETAIL. IF CONSTRUCTION QUANTITIES ARE SHOWN ON THESE PLANS, THEY ARE NOT VERIFIED BY THE CITY.
- APPROVAL OF PLANS IS VALID FOR SIX (6) MONTHS. IF AN ENCROACHMENT PERMIT FOR THE CONSTRUCTION HAS NOT BEEN ISSUED WITHIN SIX MONTHS, THE PLANS SHALL BE RESUBMITTED TO THE CITY FOR REAPPROVAL.
- A PUBLIC WORKS INSPECTOR WILL INSPECT ALL WORK WITHIN THE CITY OF SCOTTSDALE RIGHTS-OF-WAY AND IN EASEMENTS. NOTIFY INSPECTION SERVICES 24 HOURS PRIOR TO STARTING OF CONSTRUCTION (TELEPHONE 480-312-5750).
- WHenever excavation is to be done, call "BLUE STAKE CENTER," 263-1100 TWO WORKING DAYS BEFORE EXCAVATION IS TO BEGIN. THE CENTER WILL SEE THAT THE LOCATION OF THE UNDERGROUND UTILITY LINES ARE IDENTIFIED FOR THE PROJECT. CALL "COLLECT" IF NECESSARY.
- ENCROACHMENT PERMITS ARE REQUIRED FOR ALL WORK IN PUBLIC RIGHTS-OF-WAY AND EASEMENTS GRANTED FOR PUBLIC PURPOSES. AN ENCROACHMENT PERMIT WILL BE ISSUED BY THE CITY UPON RECEIPT OF PAYMENT OF A FEE FOR INSPECTION SERVICES TO BE PROVIDED BY THE CITY. COPIES OF ALL PAYMENTS SHALL BE RETAINED ON-SITE AND AVAILABLE FOR INSPECTION AT ALL TIMES. FAILURE TO PRODUCE THE REQUIRED PERMITS WILL RESULT IN IMMEDIATE WORK STOPPAGE UNTIL THE PROPER PERMIT DOCUMENTATION IS OBTAINED.
- ALL EXCAVATION AND GRADING WHICH IS NOT IN THE PUBLIC RIGHTS-OF-WAY OR NOT IN EASEMENTS GRANTED FOR PUBLIC USE MUST CONFORM TO CHAPTER 70, EXCAVATION AND GRADING, OF THE LATEST EDITION OF THE UNIFORM BUILDING CODE PREPARED BY THE INTERNATIONAL CONFERENCE OF BUILDING OFFICIALS. A PERMIT OF THIS GRADING MUST BE SECURED FROM THE CITY FOR A FEE ESTABLISHED BY THE UNIFORM BUILDING CODE.

GENERAL CONSTRUCTION NOTES

- INSTALLATION OF INJECTION WELL(S) FOR THE DISPOSAL OF RAINFALL RUNOFF WATER REQUIRES APPROVAL OF THE CITY FLOOD PLAIN ADMINISTRATOR. IF APPROVED, THE INJECTION WELL(S) MUST BE REGISTERED WITH THE "ARIZONA DEPARTMENT FOR ENVIRONMENTAL QUALITY" AND MEET ALL THE CITY OF SCOTTSDALE'S REQUIREMENTS.
- DURING CONSTRUCTION, MEASURES SUCH AS SEDIMENT TRAPS OR TERRACING SHALL BE USED AROUND GRADED AREAS TO MINIMIZE EROSION.
- ALL AREAS THAT HAVE BEEN IDENTIFIED AS NATURAL AREA OPEN SPACE SHALL BE STAKED AND FLAGGED PRIOR TO ANY GRADING ACTIVITY. INADVERTENTLY DISTURBED AREAS SHALL BE REVEGETATED WITH INDIGENOUS MATERIAL IN NATURAL DENSITIES.
- NATIVE PLANT MATERIAL PROTECTED BY ORDINANCE 7.500 SHALL NOT BE DISTURBED WITHOUT PROPER FLAGGING. SEPARATE PERMIT AND APPROVAL IS REQUIRED. MATERIAL MARKED FOR PROTECTION SHALL NOT BE DISTURBED.
- PRIOR TO BEGINNING CONSTRUCTION OF NEW WATER, FIRELINE OR SEWER THE CONTRACTOR SHALL UNearth THE EXISTING UTILITY AND VERIFY THE EXACT DEPTH AND LOCATION.
- ALL GRADING, EXCAVATION AND BACKFILL SHALL FOLLOW THE RECOMMENDATIONS OF "GEO-TECHNICAL INVESTIGATION REPORT FOR AIRPARK AUTO PLAZA A REPORT PREPARED BY SPEEDIE & ASSOCIATES DATED 10/31/96 AND MAG STANDARD SPECIFICATIONS.
- SIGNAGE TO BE OBTAINED UNDER SEPARATE PERMIT.
- DUST CONTROL PERMIT MUST BE OBTAINED FROM MARICOPA COUNTY DIVISION OF AIR POLLUTION CONTROL (507-6727).

FLOOD INSURANCE RATE MAP (FIRM) INFORMATION

COMMUNITY NUMBER	PANEL NO. PANEL DATE	SUFFIX	DATE OF FIRM (INDEX DATE)	FIRM ZONE	BASE FLOOD ELEVATION (IN AD ZONE USE DEPTH)
045013	1695F & 2160G JULY 1, 2001	C	JULY 1, 2001	X	N/A

BHA GENERAL NOTES

BROOKS HERSEY AND ASSOCIATES, INC., (BHA) STANDARD NOTES:

- THE CONTRACTOR SHALL OBTAIN ALL NECESSARY PERMITS PRIOR TO BEGINNING CONSTRUCTION.
- THE CONTRACTOR IS RESPONSIBLE FOR VERIFICATION OF EXISTING PERMITS AND RENEWAL OF LAPSED PERMITS.
- THE CONTRACTOR IS RESPONSIBLE FOR MAKING ARRANGEMENTS FOR INSPECTION AND TESTING.
- THE CONTRACTOR SHALL NOTIFY THE INSPECTING AGENCY(S) 24 HOURS PRIOR TO CONSTRUCTION. CONSTRUCTION CONCEALED WITHOUT THE REQUIRED INSPECTION SHALL BE SUBJECT TO EXPOSURE AT THE CONTRACTOR'S EXPENSE.
- THE CONTRACTOR IS RESPONSIBLE FOR THE LOCATION OF EXISTING UNDERGROUND UTILITIES PRIOR TO CONSTRUCTION. CALL BLUE STAKE AT (602) 263-1100 AT LEAST 48 HOURS BEFORE ANY CONSTRUCTION BEGINS.
- THE CONTRACTOR WILL FOLLOW GUIDELINES AND REGULATIONS SET FORTH BY O.S.H.A. BHA WILL NOT BE RESPONSIBLE FOR JOB-SITE SAFETY PROCEDURES OR CONDITIONS.
- THE CONTRACTOR IS RESPONSIBLE FOR HIS OWN TAKEOFF QUANTITIES. QUANTITIES SHOWN HEREON ARE ESTIMATES ONLY AND AS SUCH ARE NOT TO BE USED FOR BID PURPOSES.
- THE CONTRACTOR IS RESPONSIBLE FOR THE NOTIFICATION OF THE PROPER AUTHORITY(S) IF THERE ARE OBSTRUCTIONS TO PROPOSED IMPROVEMENTS AS SHOWN ON THE CONSTRUCTION DRAWINGS. ANY EXISTING ITEM REMOVED TO FACILITATE CONSTRUCTION SHALL BE REPLACED IN THE SAME OR BETTER CONDITION AT THE CONTRACTOR'S EXPENSE.
- THE CONTRACTOR IS RESPONSIBLE FOR TRAFFIC CONTROL ON AND AROUND THE CONSTRUCTION SITE.
- IN THE EVENT BHA PROVIDES CONSTRUCTION STAKING, THE FOLLOWING NOTES SHALL APPLY:
 - THE CONTRACTOR'S AUTHORIZED REPRESENTATIVE SHALL REQUEST STAKING SERVICES TWO WORKING DAYS IN ADVANCE. RESTAKING WILL BE PROVIDED ON A TIME & MATERIALS BASIS AT THE CURRENT CREW RATES.
 - THE CONTRACTOR IS RESPONSIBLE FOR VERIFICATION OF ALL CONSTRUCTION STAKES PRIOR TO START OF CONSTRUCTION.
 - THE CONTRACTOR SHALL PROTECT AND PRESERVE THE ORIGINAL SURVEY STAKES. NO CLAIM AGAINST BHA WILL BE ALLOWED WHERE SUCH STAKES ARE NOT PRESENT AND VERIFIED AS TO THEIR ORIGIN.
- RELEASE AND USE OF THESE PLANS CONFERS UPON THE USER A DUTY OF FURTHER, CONTINUED COOPERATION AMONG THE OWNER(S), CONTRACTOR(S) AND BHA. ALL CONSTRUCTION DOCUMENTS ARE INSTRUMENTS OF SERVICE AND MAY REQUIRE FURTHER DECISIONS, JUDGMENT AND CLARIFICATION BY BHA. ANY PROBLEMS ALLEGED WITH THESE PLANS SHOULD BE REPORTED IMMEDIATELY TO BHA SO THAT BHA CAN PARTICIPATE IN THE INVESTIGATION AND SOLUTION. WITHOUT SUCH INVOLVEMENT, BHA IS RELIEVED FROM RESPONSIBILITY FOR SUBSEQUENT DAMAGES.
- ANY REESTABLISHMENT OF SURVEY STAKES OR MONUMENTS DESTROYED BY CONSTRUCTION SHALL BE REPLACED AT THE CONTRACTOR'S EXPENSE.
- BROOKS, HERSEY AND ASSOCIATES AND THE REGISTRANT SEALING THESE DOCUMENTS HAVE MADE REFERENCE TO MAG STANDARD DETAILS, SPECIFICATIONS, AND SUPPLEMENTS AS REQUIRED BY THE LOCAL AGENCY. SINCE THE DEVELOPMENT OF THE REFERENCED DETAILS AND SPECIFICATIONS WAS NOT UNDER THE DIRECT SUPERVISION OF BROOKS, HERSEY AND ASSOCIATES OR THE REGISTRANT, WE CANNOT ASSUME ANY LIABILITY FOR THE ACCURACY OR COMPLETENESS OF THE MAG STANDARD DETAILS, SPECIFICATIONS, AND SUPPLEMENTS.

SPECIFICATIONS

ALL CONSTRUCTION AND MATERIALS SHALL CONFORM TO THE LATEST MARICOPA ASSOCIATION OF GOVERNMENTS UNIFORM STANDARD SPECIFICATIONS AND STANDARD DRAWINGS.

LEGAL DESCRIPTION

SCOTTSDALE WATERFRONT

A PORTION OF THE NORTHEAST QUARTER OF THE SOUTHEAST QUARTER OF SECTION 22, TOWNSHIP 2 NORTH, RANGE 4 EAST OF THE GILA AND SALT RIVER BASE AND MERIDIAN, MARICOPA COUNTY, ARIZONA, BEING MORE PARTICULARLY DESCRIBED AS FOLLOWS:

COMMENCING AT THE NORTHEAST CORNER OF SAID NORTHEAST QUARTER OF THE SOUTHEAST QUARTER OF SECTION 22;

THENCE SOUTH 88°54'09" WEST, ALONG THE NORTH LINE OF SAID NORTHEAST QUARTER OF THE SOUTHEAST QUARTER, 93.04 FEET;
 THENCE SOUTH 01°05'51" EAST, 55.00 FEET TO A POINT ON THE SOUTHERLY RIGHT-OF-WAY LINE OF CAMELBACK ROAD, SAID POINT ALSO BEING ON THE WESTERLY RIGHT-OF-WAY LINE OF SCOTTSDALE ROAD MARKING THE POINT OF BEGINNING;
 THENCE SOUTH 00°01'51" EAST, ALONG SAID WESTERLY RIGHT-OF-WAY LINE OF SCOTTSDALE ROAD, 98.83 FEET TO A POINT ON THE NORTHERLY RIGHT-OF-WAY LINE OF THE ARIZONA CANAL;
 THENCE SOUTH 41°07'13" WEST, ALONG SAID NORTHERLY RIGHT-OF-WAY LINE, 788.90 FEET TO THE SOUTHWEST CORNER OF PARADISE PALMS, A SUBDIVISION RECORDED IN BOOK 54 OF MAPS, PAGE 13, MARICOPA COUNTY RECORDS;
 THENCE CONTINUING ALONG SAID NORTHERLY RIGHT-OF-WAY LINE SOUTH 01°07'51" EAST, 42.31 FEET TO A POINT ON THE NORTHERLY RIGHT-OF-WAY LINE OF THE ARIZONA CANAL;
 THENCE CONTINUING ALONG SAID NORTHERLY RIGHT-OF-WAY LINE SOUTH 40°32'09" WEST, 125.25 FEET TO THE BEGINNING OF A CURVE CONCAVE NORTHWESTERLY AND HAVING A RADIUS OF 1941.88 FEET;
 THENCE SOUTHWESTERLY ALONG SAID CURVE THROUGH A CENTRAL ANGLE OF 02°07'26", AN ARC DISTANCE OF 71.99 FEET;
 THENCE LEAVING SAID NORTH RIGHT-OF-WAY LINE, NORTH 01°05'51" WEST, 840.27 FEET;
 THENCE NORTH 43°54'09" EAST, 31.11 FEET TO THE SOUTHERLY RIGHT-OF-WAY LINE OF CAMELBACK
 THENCE NORTH 88°54'09" EAST, ALONG SAID SOUTHERLY RIGHT-OF-WAY LINE, 49.50 FEET;
 THENCE NORTH 01°05'51" WEST, ALONG SAID SOUTHERLY RIGHT-OF-WAY LINE, 5.50 FEET;
 THENCE NORTH 88°54'09" EAST, ALONG SAID SOUTHERLY RIGHT-OF-WAY LINE, 18.53 FEET;
 THENCE NORTH 72°05'59" EAST, ALONG SAID SOUTHERLY RIGHT-OF-WAY LINE, 12.21 FEET;
 THENCE NORTH 01°23'06" WEST, ALONG SAID SOUTHERLY RIGHT-OF-WAY LINE, 0.97 FEET;
 THENCE NORTH 88°54'09" EAST, ALONG SAID SOUTHERLY RIGHT-OF-WAY LINE, 562.56 FEET TO THE TRUE POINT OF BEGINNING.

PARCEL CONTAINS 312,068 SQUARE FEET, 7.16 ACRES, MORE OR LESS.

ARCHITECT

SCOTTSDALE WATERFRONT PROPERTIES, L.L.C.
C/O GOLUB & COMPANY
625 N. MICHIGAN AVENUE
2ND FLOOR
CHICAGO, IL 60611
(312) 440-8763

ENGINEER

BROOKS, HERSEY AND ASSOCIATES, INC.
4602 EAST ELWOOD STREET, STE. 16
PHOENIX, ARIZONA 85040
(602) 437-3733

UTILITIES

WATER CITY OF SCOTTSDALE
SEWER CITY OF SCOTTSDALE
ELECTRIC SALT RIVER PROJECT
TELEPHONE US WEST COMMUNICATIONS
GAS SOUTHWEST GAS COMPANY
IRRIGATION ARCADIA WATER COMPANY

AREA

492,228 SQUARE FEET OR
11.30 ACRES MORE OR LESS.

BENCH MARK

FOUND BRASS CAP IN HANDHOLE
EAST QUARTER CORNER OF SECTION 22,
T2N, R4E,
CSO DATUM ELEV = 1277.62 NAVD '88
STATION 4223

SHEET INDEX

- COVER SHEET
- GRADING & DRAINAGE PLAN
- GRADING & DRAINAGE PLAN

RETENTION

LOT AREA = 492,228 SQ. FT.
W = 0.95 (2,82/12) 492,228 = 109,890 CU. FT.
RETENTION PROVIDED = 110,000 CU. FT.

AS-BUILT CERTIFICATION


I HEREBY CERTIFY THAT THE "AS BUILT" MEASUREMENTS AS SHOWN HEREON WERE MADE UNDER MY SUPERVISION OR AS NOTED AND ARE CORRECT TO THE BEST OF MY KNOWLEDGE AND BELIEF.

REGISTERED LAND SURVEYOR/ENGINEER _____ DATE _____

REGISTRATION NUMBER _____



ENGINEER'S CERTIFICATION

THE LOWEST FLOOR ELEVATIONS(S) AND/OR FLOODPROOFING ELEVATION(S) ON THIS PLAN ARE SUFFICIENTLY HIGH TO PROVIDE PROTECTION FROM FLOODING CAUSED BY A ONE-HUNDRED YEAR STORM, AND ARE IN ACCORDANCE WITH CITY OF SCOTTSDALE REVISED CODE, CHAPTER 37 - FLOODWAYS & FLOODPLAINS ORDINANCE.

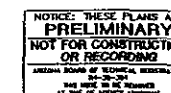

SCOTTSDALE WATERFRONT S/W COR CAMELBACK & SCOTTSDALE RD's SCOTTSDALE, ARIZONA			
		BY	DATE
DESIGNED	RCJ		5/26/03
DRAWN	RCJ		6/26/03
CHECKED	BHF		
		BROOKS, HERSEY & ASSOCIATES, INC. ENGINEERING/SURVEYORS 4602 EAST ELWOOD STREET, STE. 16 PHOENIX, ARIZONA 85040 PHONE (602) 437-3733 FAX (602) 437-3734	
JOB NUMBER 1137-D1FP	GRADING & DRAINAGE PLAN		SHEET 1 OF 3

MATCH LINE SEE SHEET J

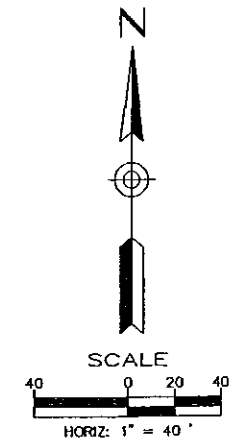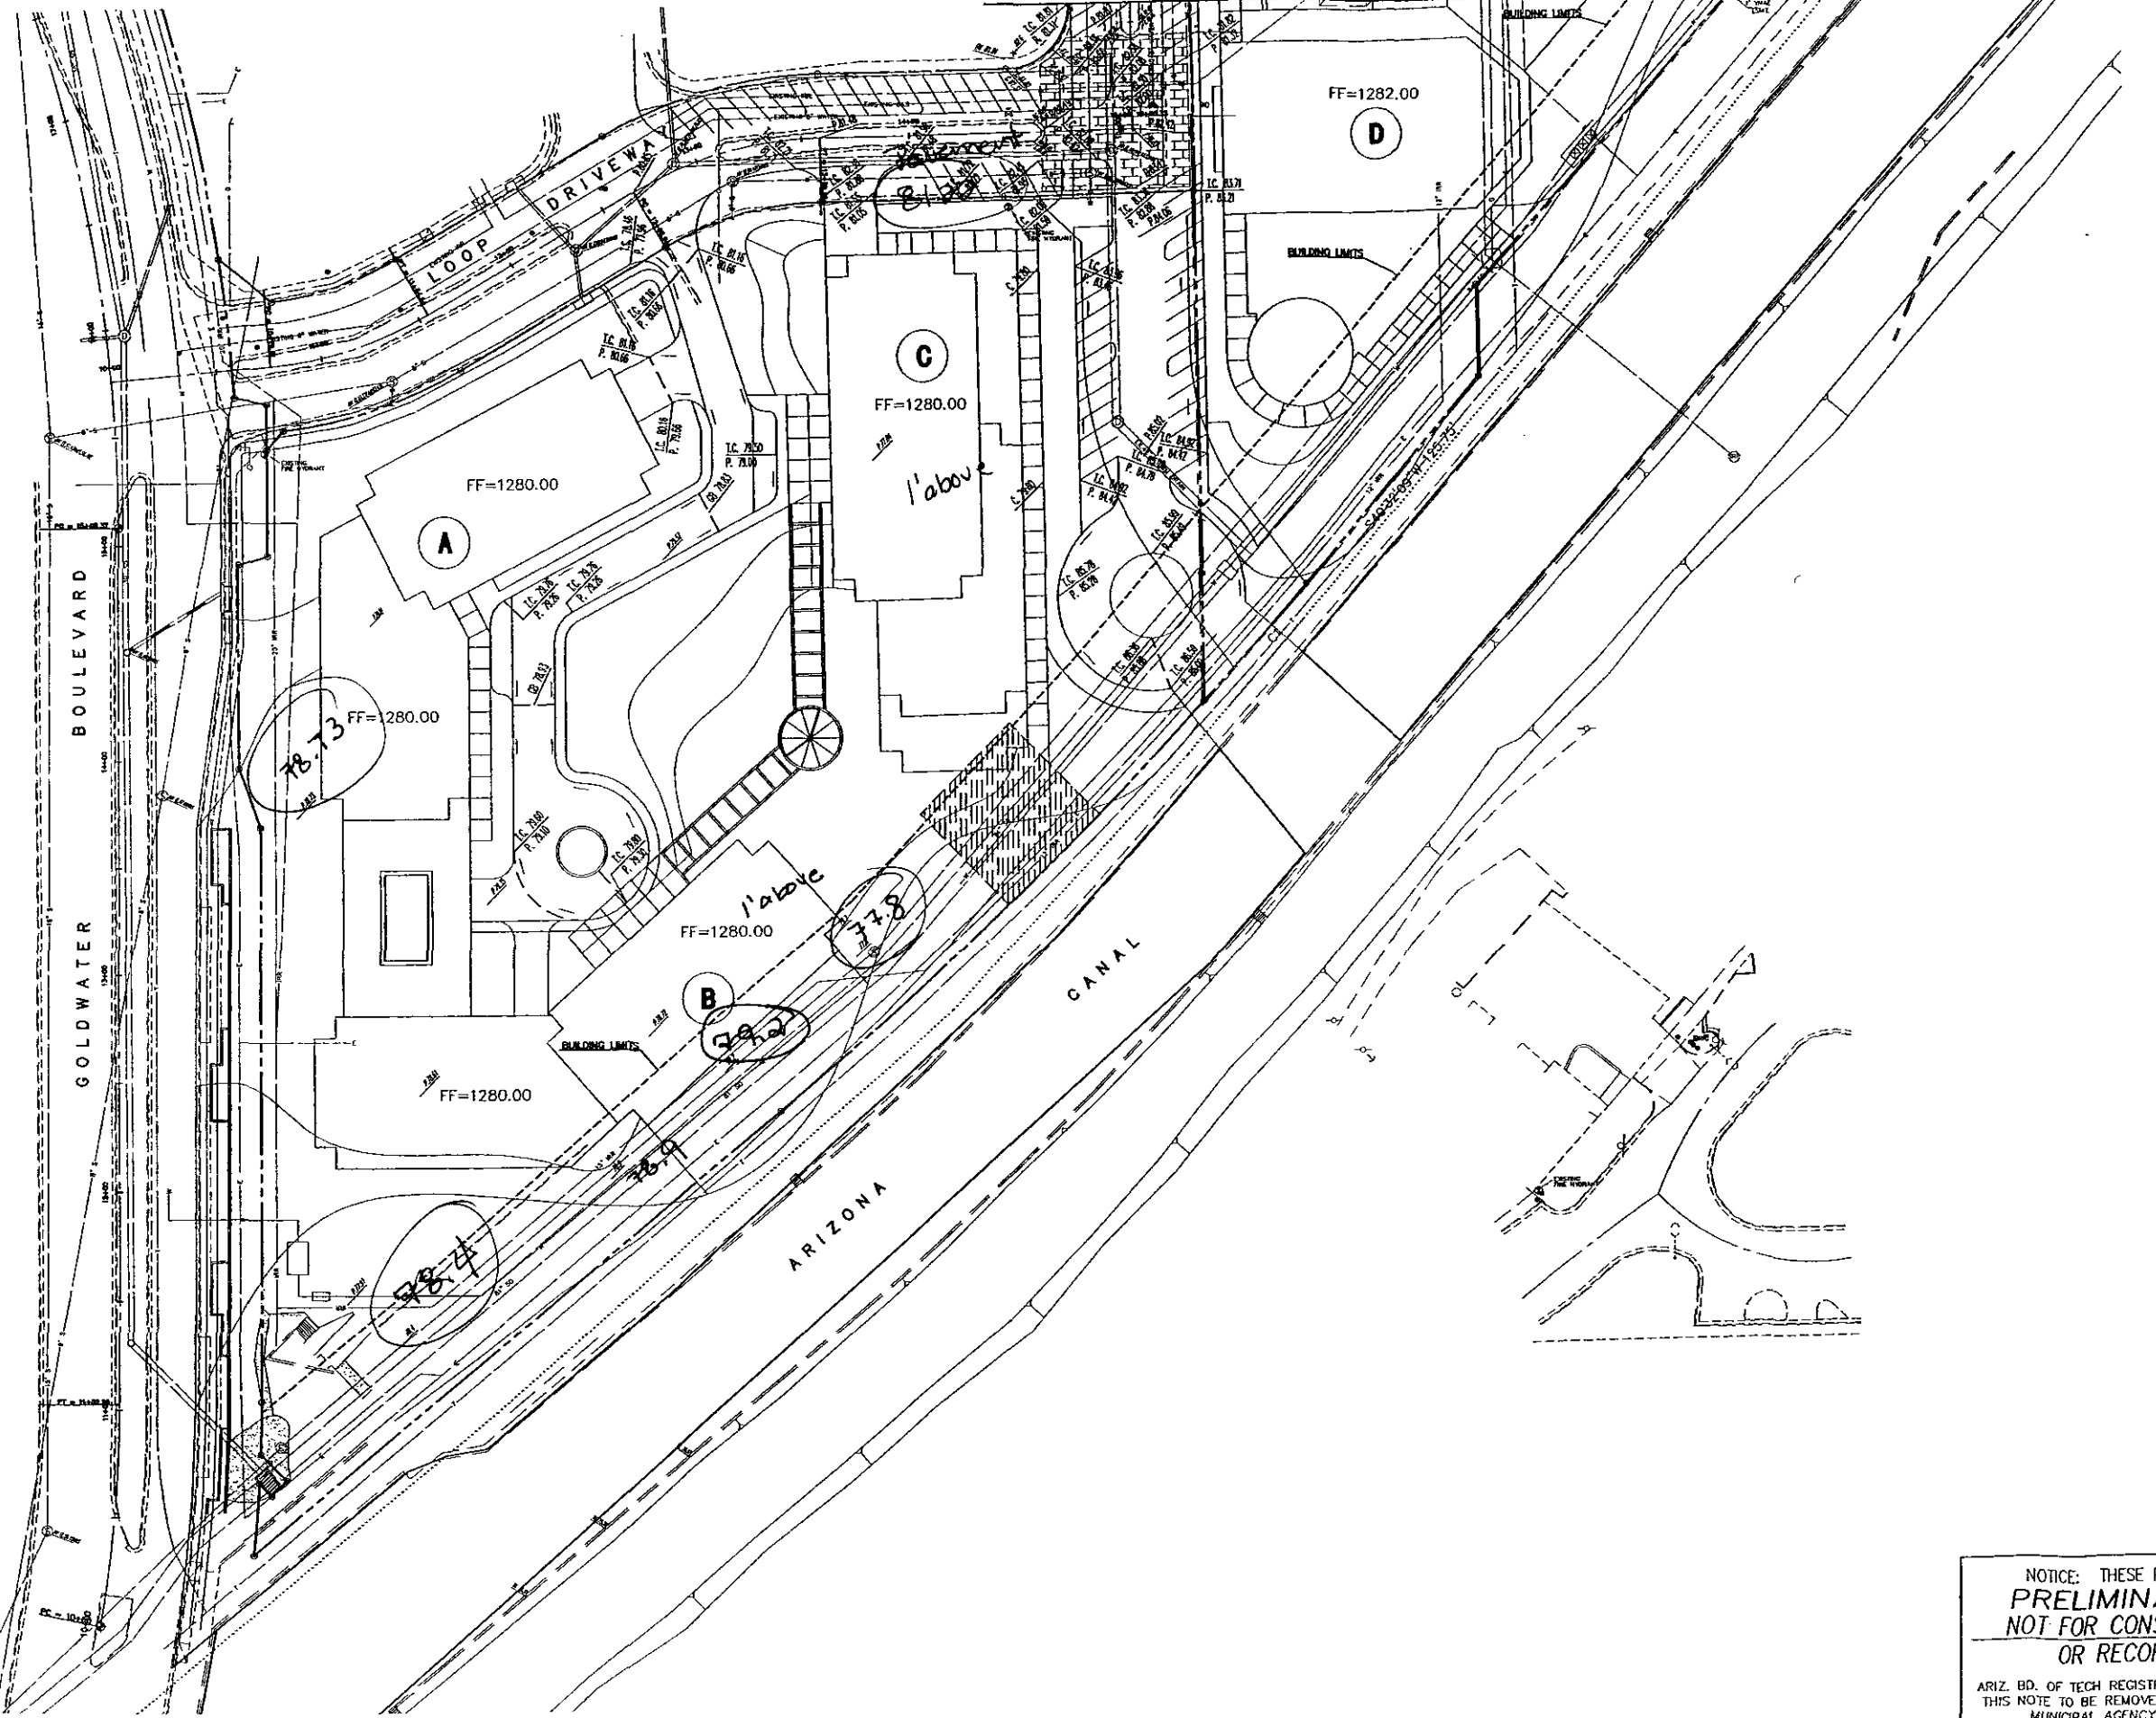

CALL TWO WORKING DAYS BEFORE YOU DIE
(602) 263-1100
1-800-STAKE-IT
(OUTSIDE MARICOPA COUNTY)

XREFS
113701FP-X-IM
6-19-03-SITE PLAN
Bhf-pe

SCOTTSDALE WATERFRONT
PLAN SHEET
GRADING PLAN



DATE	6-25-03
DESIGNED	RCJ
DRAWN	RCJ
CHECKED	BHF



B BROOKS, HERSEY & ASSOCIATES INC.
ENGINEERS SURVEYORS
CONSTRUCTION ADMINISTRATORS
4808 E. ELWOOD STREET #90
PHOENIX, ARIZONA 85040
(PHONE) (602) 487-8753
(FAX) (602) 888-0204

NOTICE: THESE PLANS ARE
PRELIMINARY —
NOT FOR CONSTRUCTION
OR RECORDING
ARIZ. BD. OF TECH REGISTRATION R4-30-304
THIS NOTE TO BE REMOVED AT THE TIME OF
MUNICIPAL AGENCY APPROVAL

JOB NUMBER	1137-01FP
SHEET	2 OF 3

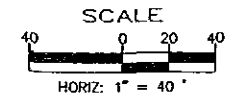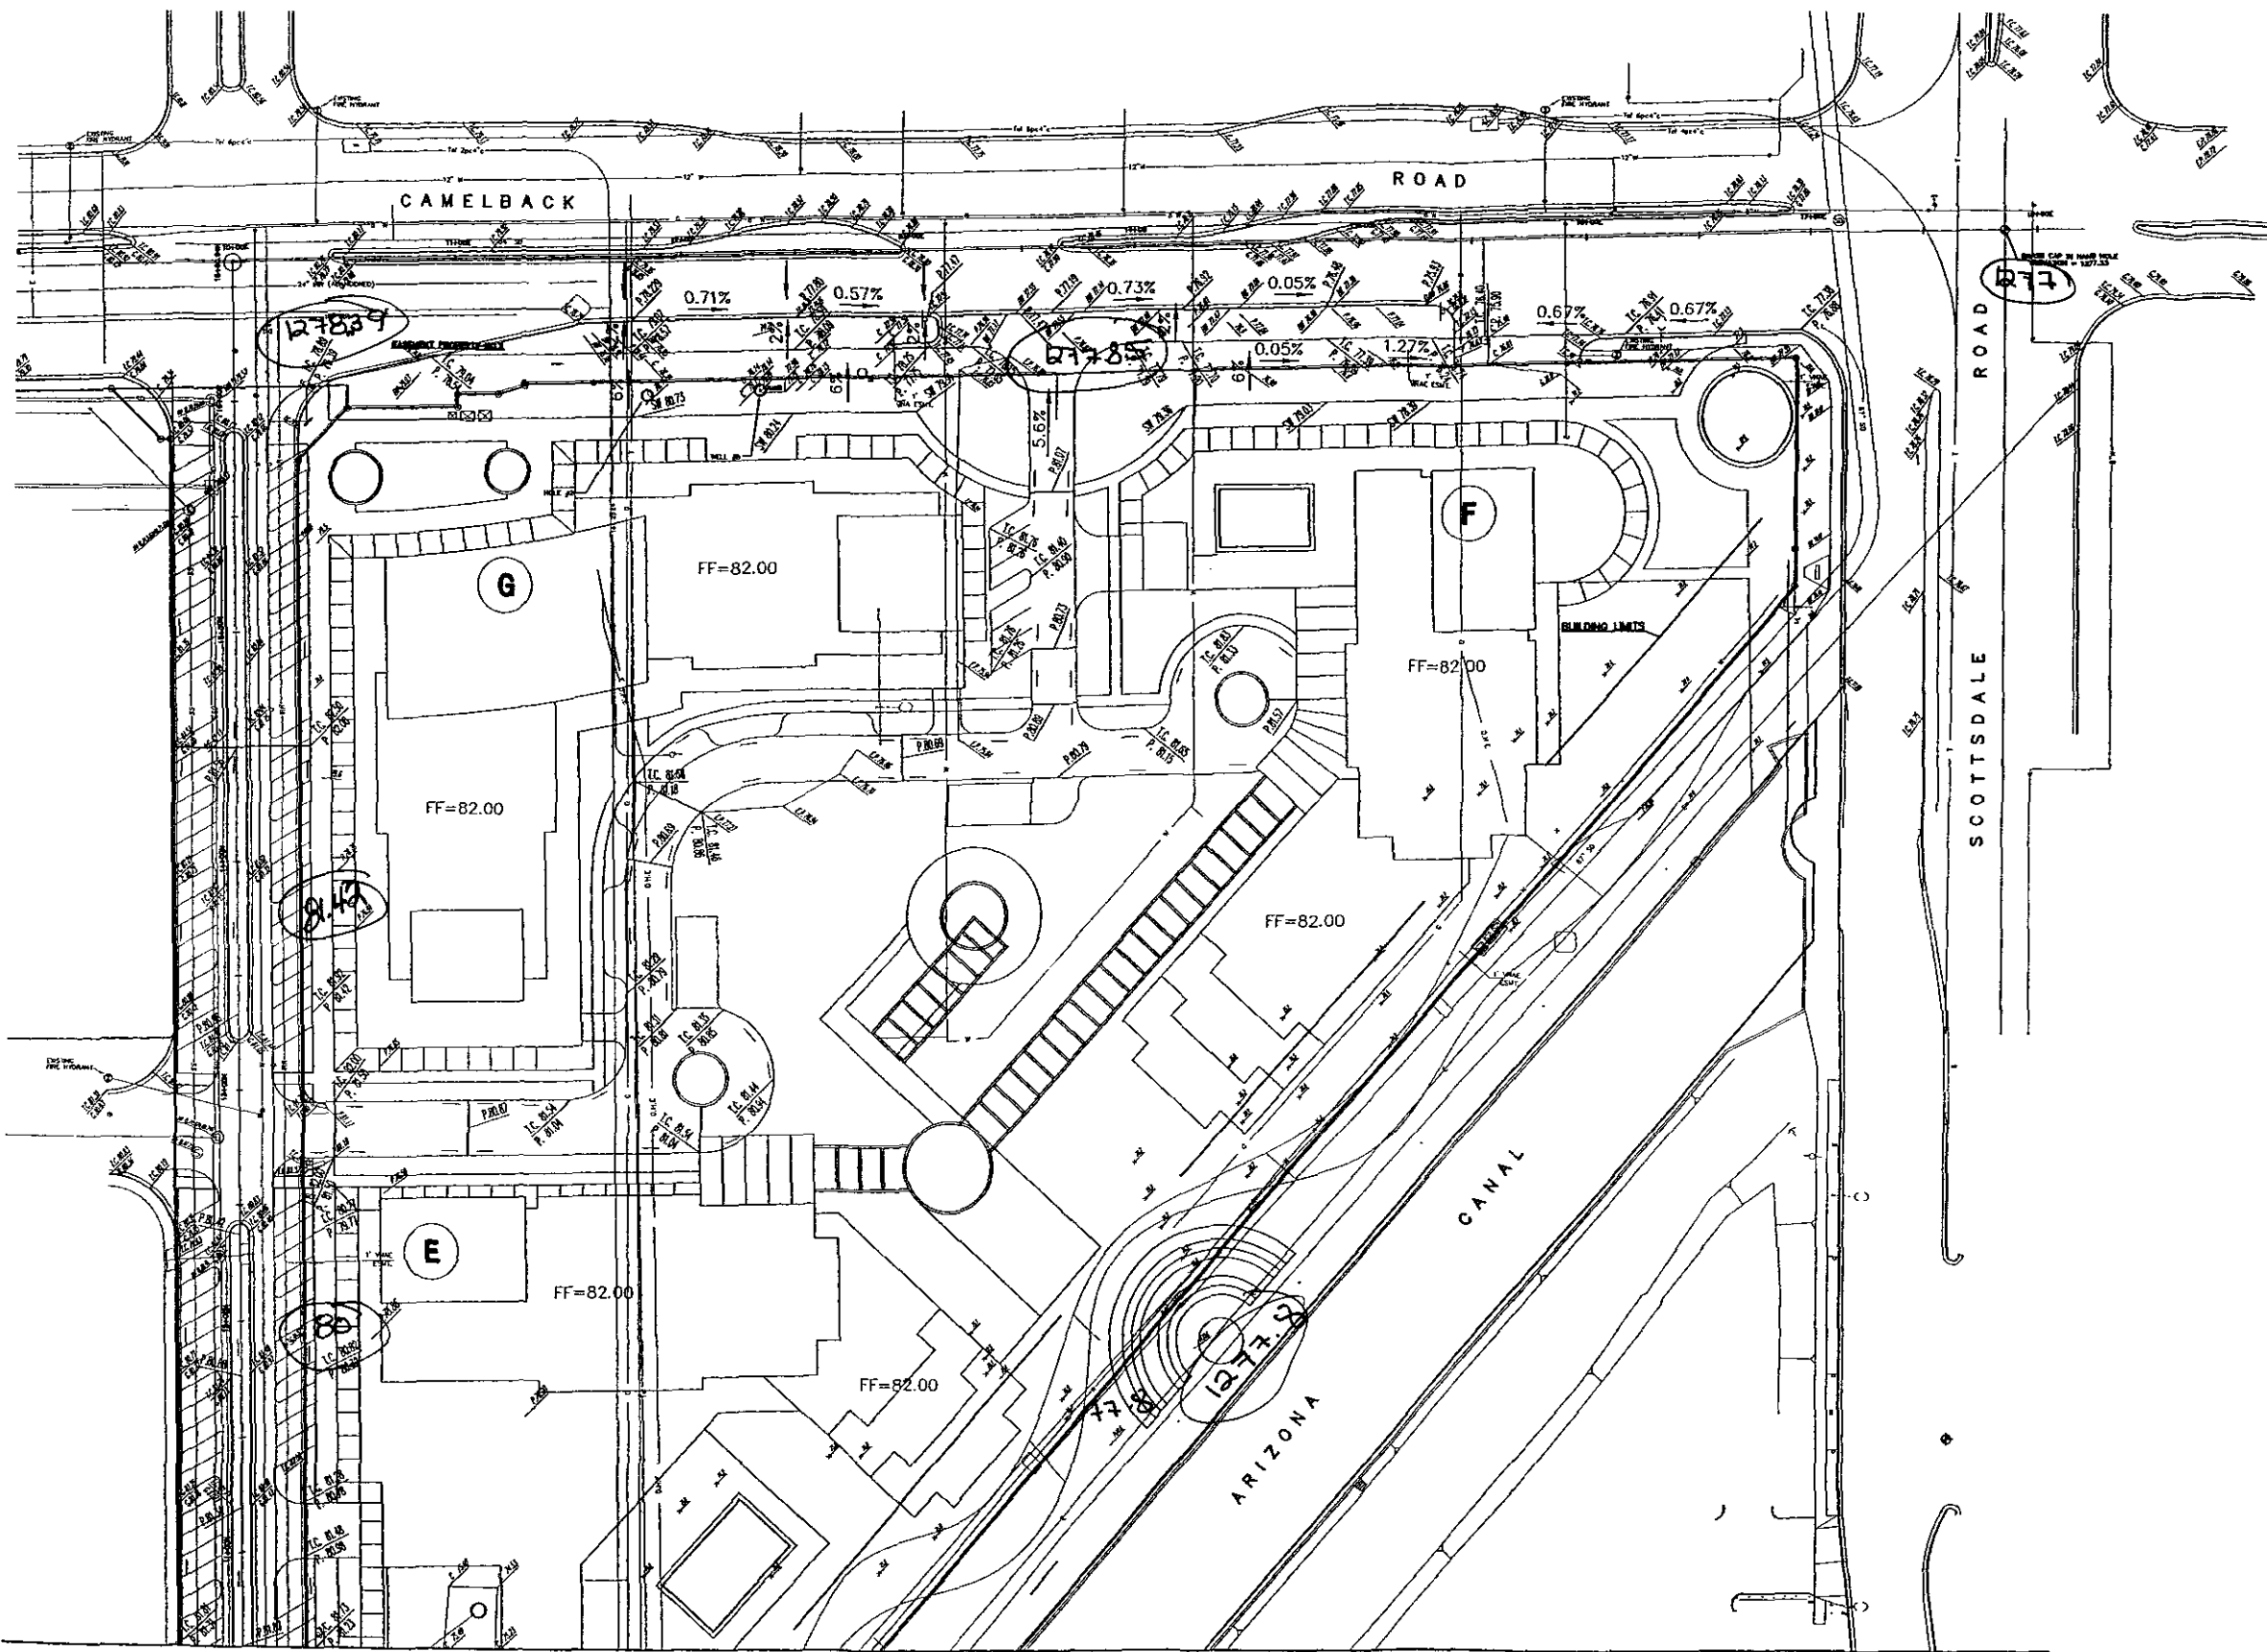


CALL TWO WORKING DAYS BEFORE YOU DIG
 (602) 263-1100
 1-800-STAKE-IT
(OUTSIDE MARICOPA COUNTY)

XREFS
 113701FP-X-JM
 6-19-03-SITE PLAN
 Bhf-pe

**WATER FRONT
 PLAN SHEET
 GRADING PLAN**

DATE	6-25-03
DESIGNED	RCJ
DRAWN	RCJ
CHECKED	BHF

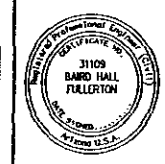

**BROOKS, HERSEY &
 ASSOCIATES INC.**
ENGINEERS
 SURVEYORS
 CONSTRUCTION
 ADMINISTRATORS
 4802 E. ELWOOD STREET #4
 PHOENIX, ARIZONA 85046
 PHONE: (602) 437-3729
 FAX: (602) 437-0204

JOB NUMBER 1137-01FP SHEET 3 OF 3

NOTICE: THESE PLANS ARE
PRELIMINARY -
NOT FOR CONSTRUCTION
OR RECORDING
 ARIZ. BO. OF TECH REGISTRATION R4-30-304
 THIS NOTE TO BE REMOVED AT THE TIME OF
 MUNICIPAL AGENCY APPROVAL

MATCH LINE SEE SHEET 2

G:\projects2000\1137-01FP\Grading\113701FP-G03.dwg, 08/21/03 05:44:27 PM, 1:2

BROOKS ENGINEERS & SURVEYORS, INC.

4602 East Elwood Street #16
 PHOENIX, AZ 85040-1960
 (602) 437-3733
 FAX (480) 858-0204

JOB SCOTTSDALE WATERFRONT
 SHEET NO. 1 OF 2
 CALCULATED BY _____ DATE 1/24/03
 CHECKED BY _____ DATE _____
 SCALE _____


FGD SLOPE DRAIN INLETS:

	STATION	GRATE	*ELEV.	INVERT	**WSFL
1	431+25	87"x42"	1273.50	1252.40	-
2	428+61	84"x42"	1272.84	1253.25	1274.94 (SEE SWALE 'A')
3	424+00	84"x42"	1270.50	1254.91	1272.00 (SEE SWALE 'B')
4	417+84	84"x72"	1270.00	1257.05	-

*FCO DATUM

SWALE 'A'

STA 423+0.9

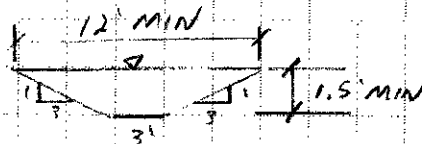

** THIS SECTION IS SHOWN TWICE ON DESIGN PLANS AND APPEARS TO INDICATE MINIMUM SWALE DEPTH.

FLOWLINE @ 0.0015 FT/FT : Q_{SWALE} 25 CFS

SWALE 'B'

STA 426+4.3



FLOWLINE @ 0.0015 FT/FT

0.0028 FT/FT : Q = 34 CFS

0.0050 FT/FT : Q = 92 CFS

GRATE CAPACITIES

ORIFICE EQUATION

HEC 12, 1984

$$Q_{INLET} = C_o A (2gd)^{0.5}$$

$$Q_{[2]3} = 0.67 (19.6) [2(32.16) 1.5]^{0.5}$$

$$Q_{[2]3} = 129 \text{ CFS. } \leftarrow$$

$$Q_{[1]1} = 0.67 (20.3) [2(32.16) 1.5]^{0.5}$$

$$Q_{[1]1} = 134 \text{ CFS } \leftarrow$$


C_o = 0.67 ORIFICE COEFF.

A = CLEAR OPENING OF GRATE (FT²)

g = 32.16 FT/11²

d = WATER DEPTH = 1.5'

A = 0.8 A_{gross}

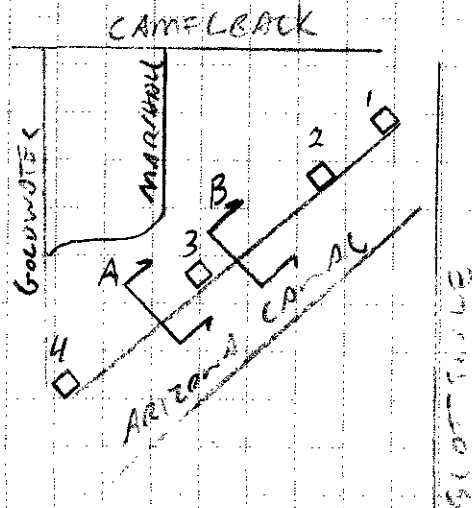

FRATE CAPACITIES - CONTINUED.

STANDARD PRACTICE ASSUME 50% CLOGGING FACTOR, ∴ CAPACITY OF PIPE FROM INLETS = $0.5 \sum Q_{INLET}$

DESIGN

INLET 2 3 = 134 CFS EACH ∴ $Q_{PIPE} = 67 \text{ CFS} + 134 \text{ CFS}$


AT 0.005 FT/FT 48" PIPE Q = 82 CFS ← ONE INLET

60" PIPE Q = 134 CFS ← 10 INLETS

INLET 1 RELOCATE TO THE NORTH EAST WITH SIMILAR DIMENSIONS TO PROVIDE 134 CFS CAPACITY (100 CLOGGING FACTOR).

TYP. SECTION FOR INLET 2 3

1279
 1278
 1277
 1276
 1275
 1274
 .
 .
 .
 .
 1264

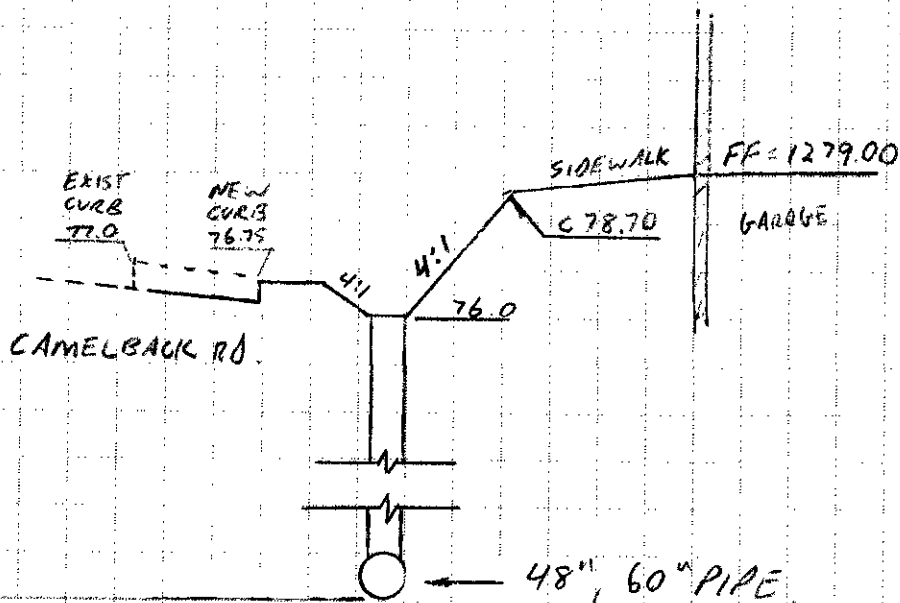


Cross Section

Cross Section for Trapezoidal Channel

Project Description	
Worksheet	Trapezoidal Channel - 1
Flow Element	Trapezoidal Channel
Method	Manning's Formula
Solve For	Discharge

Section Data	
Mannings Coefficient	0.024
Slope	0.001500 ft/ft
Depth	1.50 ft
Left Side Slope	0.33 V : H
Right Side Slope	0.33 V : H
Bottom Width	3.00 ft
Discharge	25.30 cfs

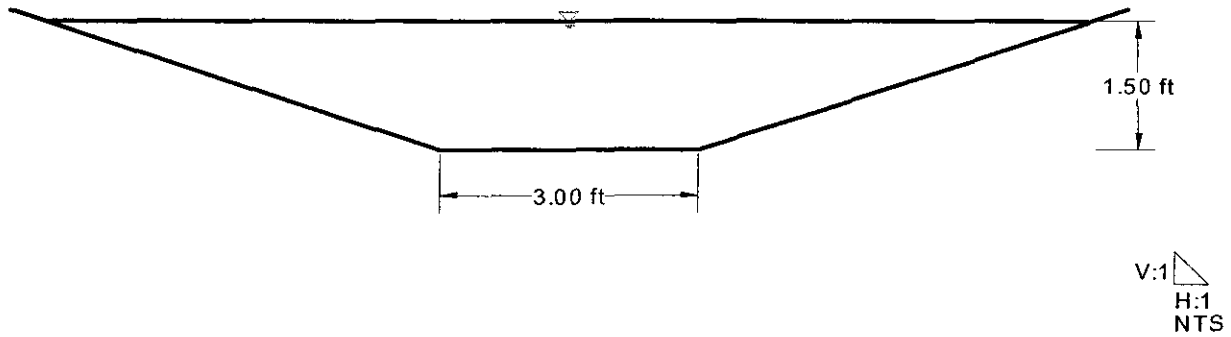


Cross Section

Cross Section for Triangular Channel

Project Description	
Worksheet	Triangular Channel - 1
Flow Element	Triangular Channel
Method	Manning's Formula
Solve For	Discharge

Section Data	
Mannings Coefficient	0.024
Slope	0.002800 ft/ft
Depth	1.60 ft
Left Side Slope	0.10 V : H
Right Side Slope	0.20 V : H
Discharge	53.85 cfs

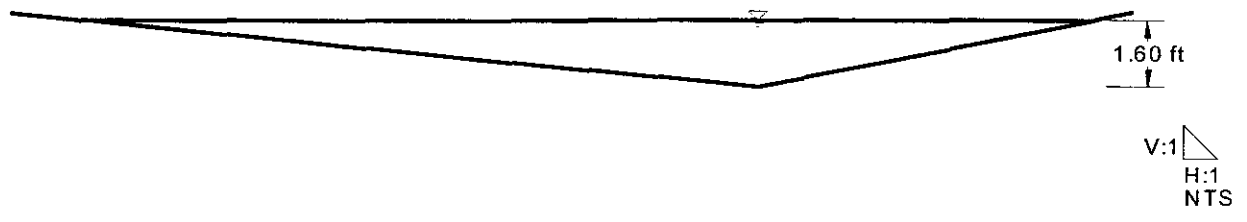


Cross Section

Cross Section for Triangular Channel

Project Description	
Worksheet	Triangular Channel - 1
Flow Element	Triangular Channel
Method	Manning's Formula
Solve For	Discharge

Section Data	
Mannings Coefficient	0.024
Slope	0.008200 ft/ft
Depth	1.60 ft
Left Side Slope	0.10 V : H
Right Side Slope	0.20 V : H
Discharge	92.16 cfs

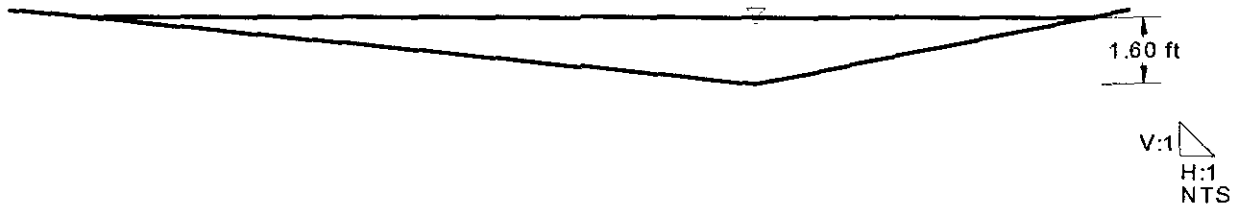


Cross Section

Cross Section for Circular Channel

Project Description	
Worksheet	Circular Channel - 1
Flow Element	Circular Channel
Method	Manning's Formula
Solve For	Full Flow Capacity

Section Data	
Mannings Coefficient	0.016
Slope	0.005000 ft/ft
Depth	4.00 ft
Diameter	48 in
Discharge	82.52 cfs

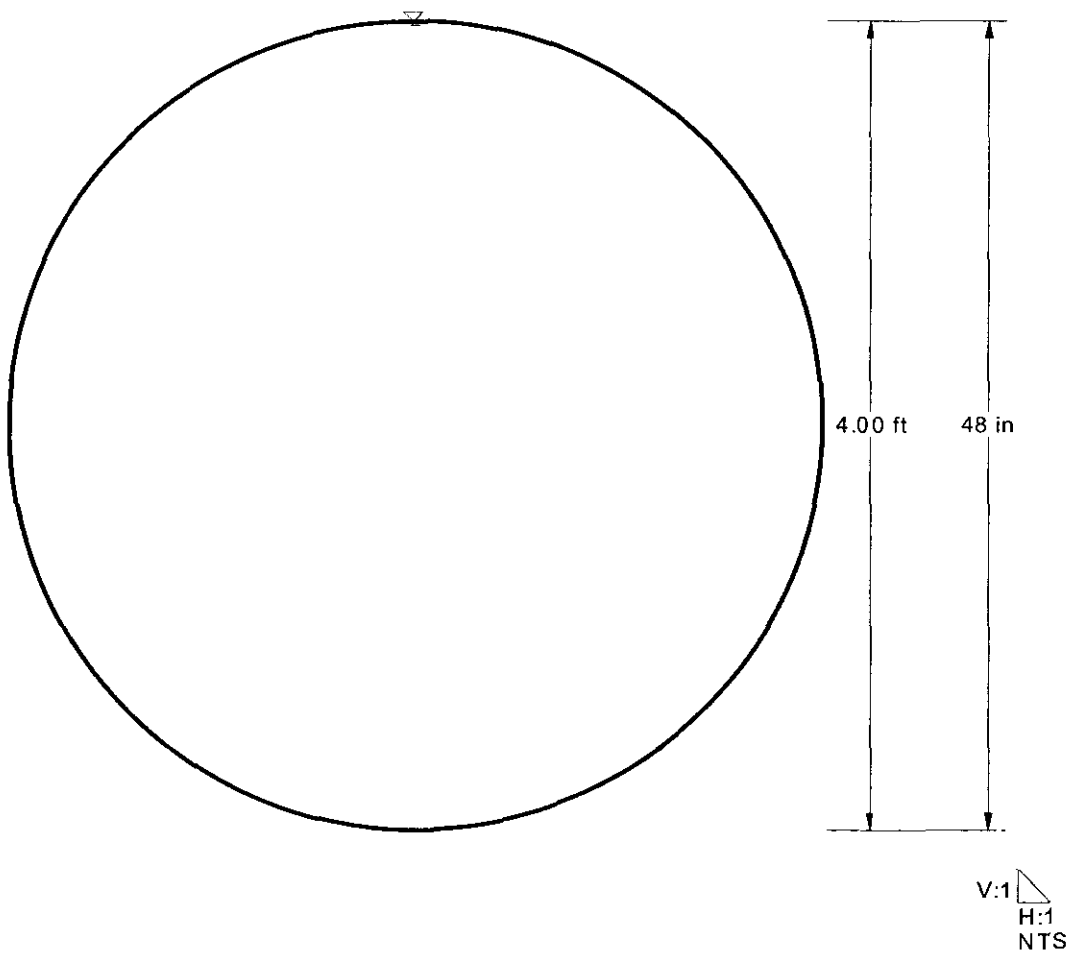


Cross Section

Cross Section for Circular Channel

Project Description	
Worksheet	Circular Channel - 1
Flow Element	Circular Channel
Method	Manning's Formula
Solve For	Full Flow Capacity

Section Data	
Mannings Coefficient	0.016
Slope	0.005000 ft/ft
Depth	5.00 ft
Diameter	60 in
Discharge	149.62 cfs

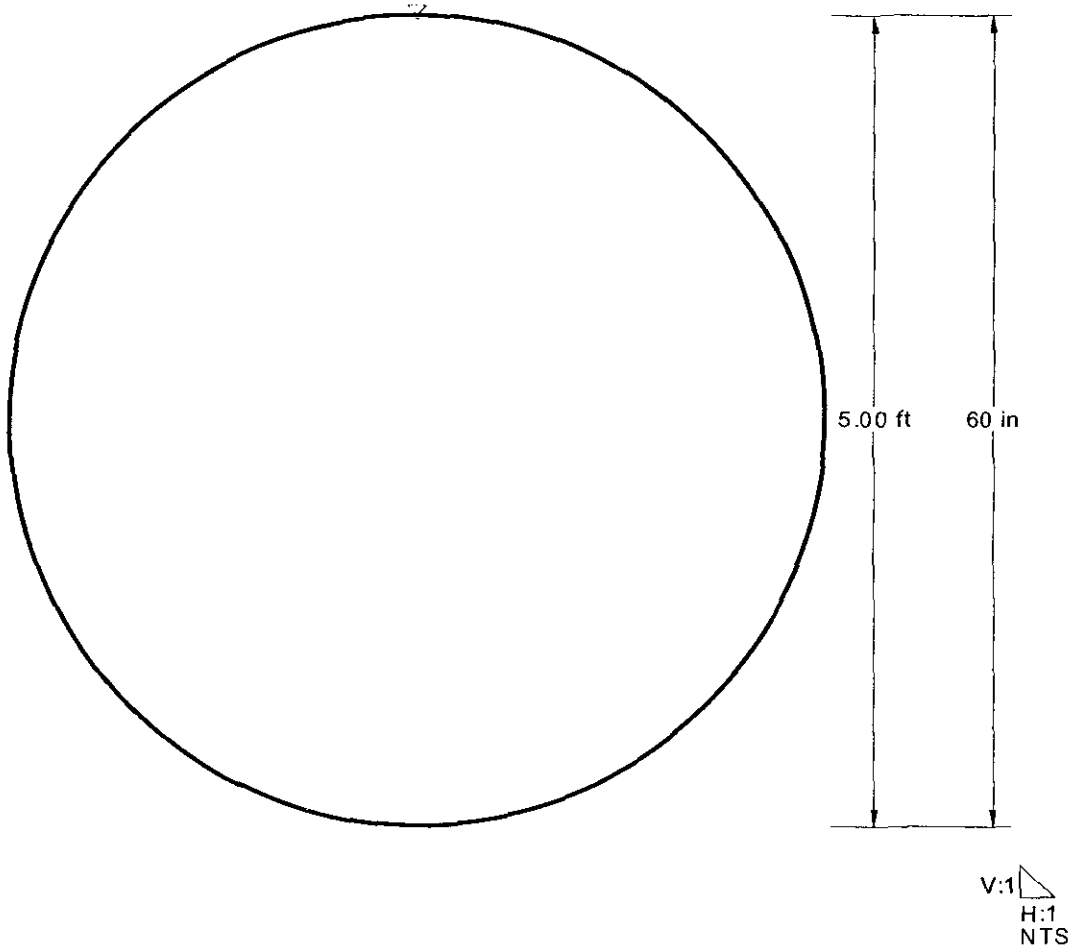



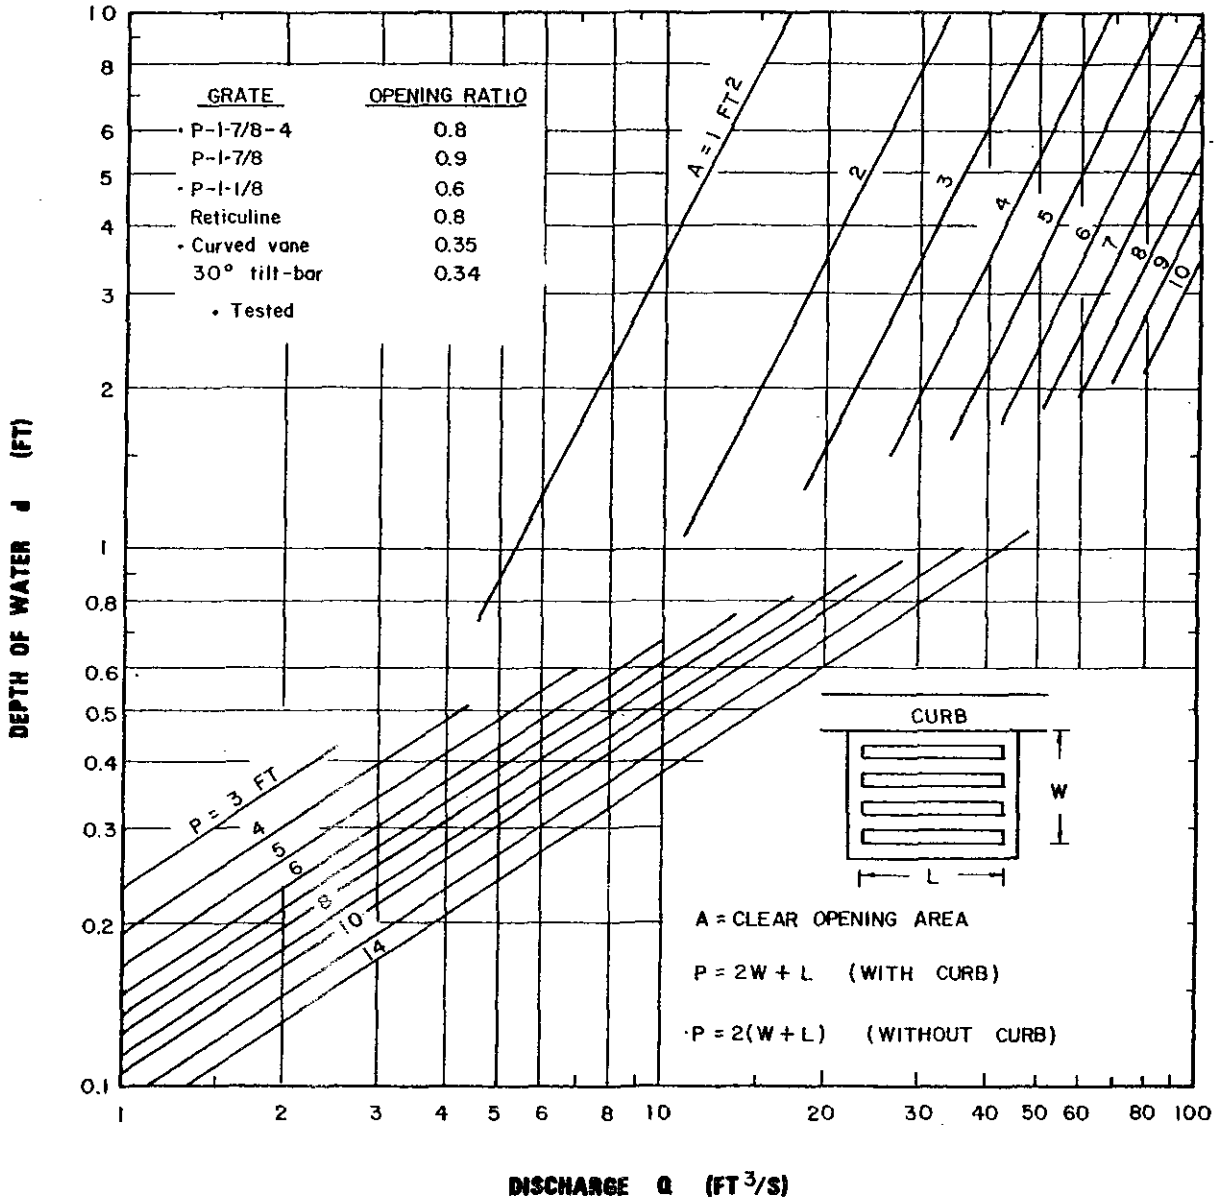



CHART 11. Grate inlet capacity in sump conditions.

VALUE ENGINEERING PAYS

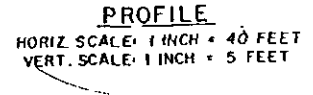
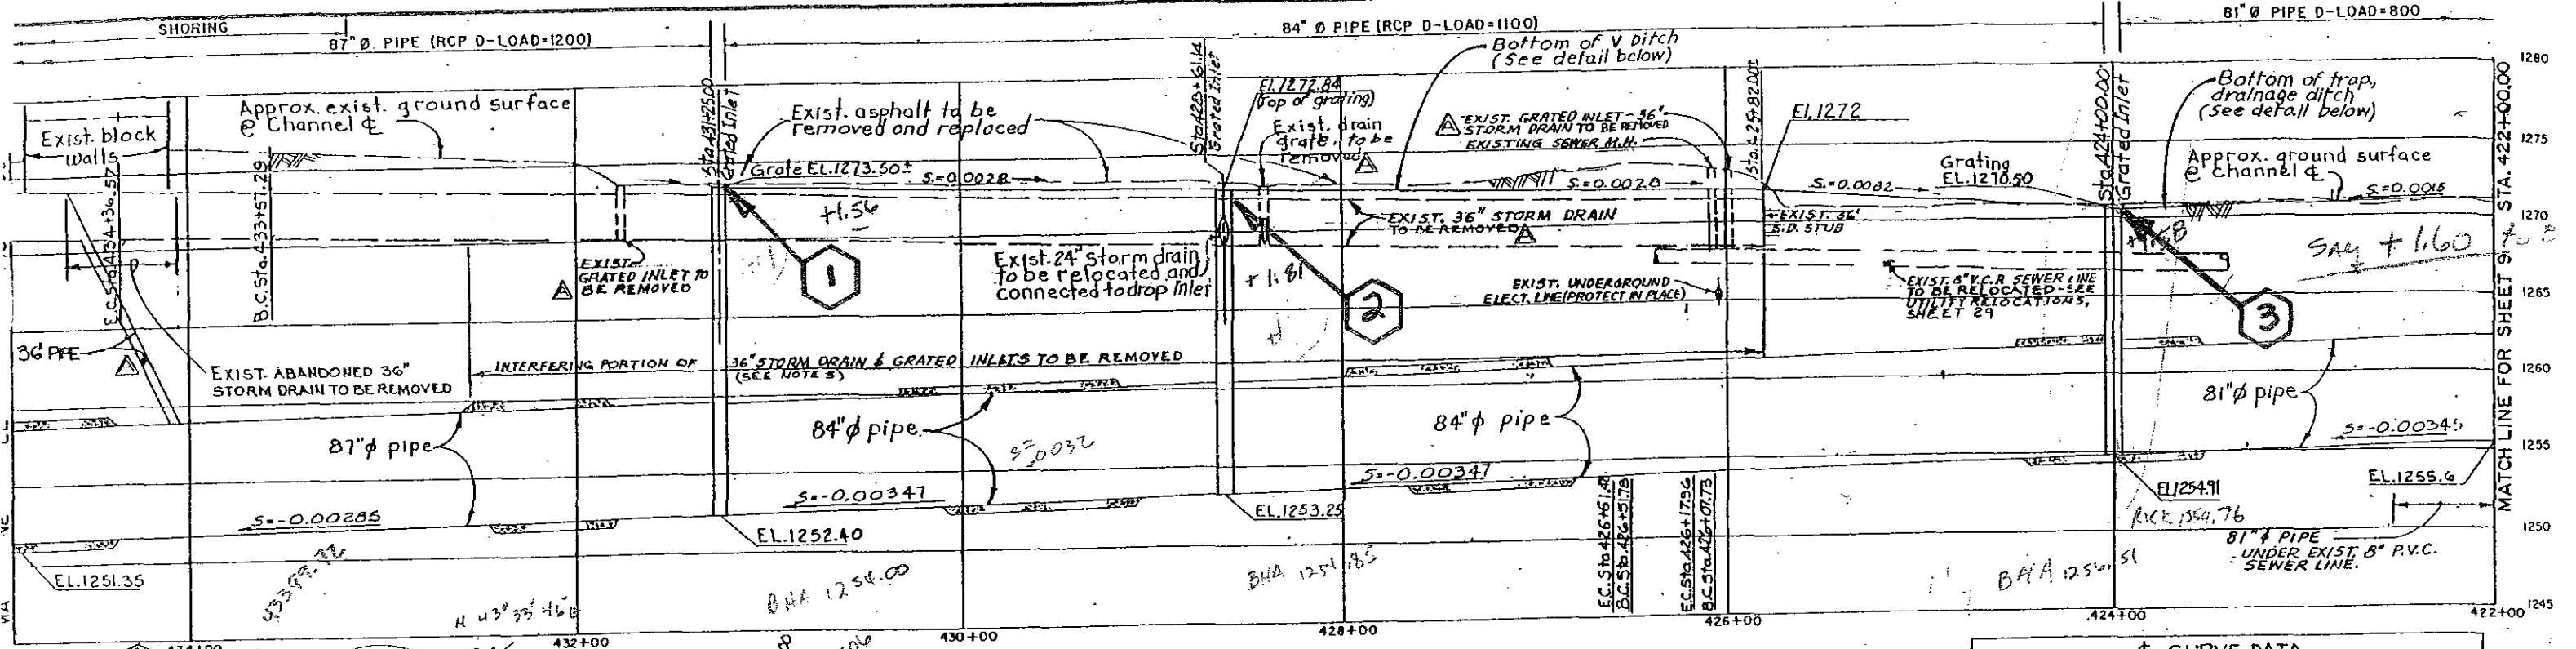



C CURVE DATA				
PI	Δ	R (FT)	L (FT)	T (FT)
17	50° 28' 33"	90.00	79.28	42.42
15	06° 31' 08"	90.00	10.23	5.12
15	06° 08' 16"	90.00	9.64	4.82
16	01° 15' 20"	∠ PT		
16	0° 45' 39"	∠ PT		

- NOTES:
1. FOR STRUCT. DETAILS SEE
 2. FOR TYP. CROSS SECTIONS
 3. PROTECT IN PLACE ALL UT EXCEPT AS NOTED.
 4. FOR UTILITY RELOCATION SHEET 29.
 5. OPEN ENDS OF ABANDONED B& BRICKED-UP-SEE DETAIL
 6. REMOVE AND REPLACE PAVEN STA 421.61 TO STA 42

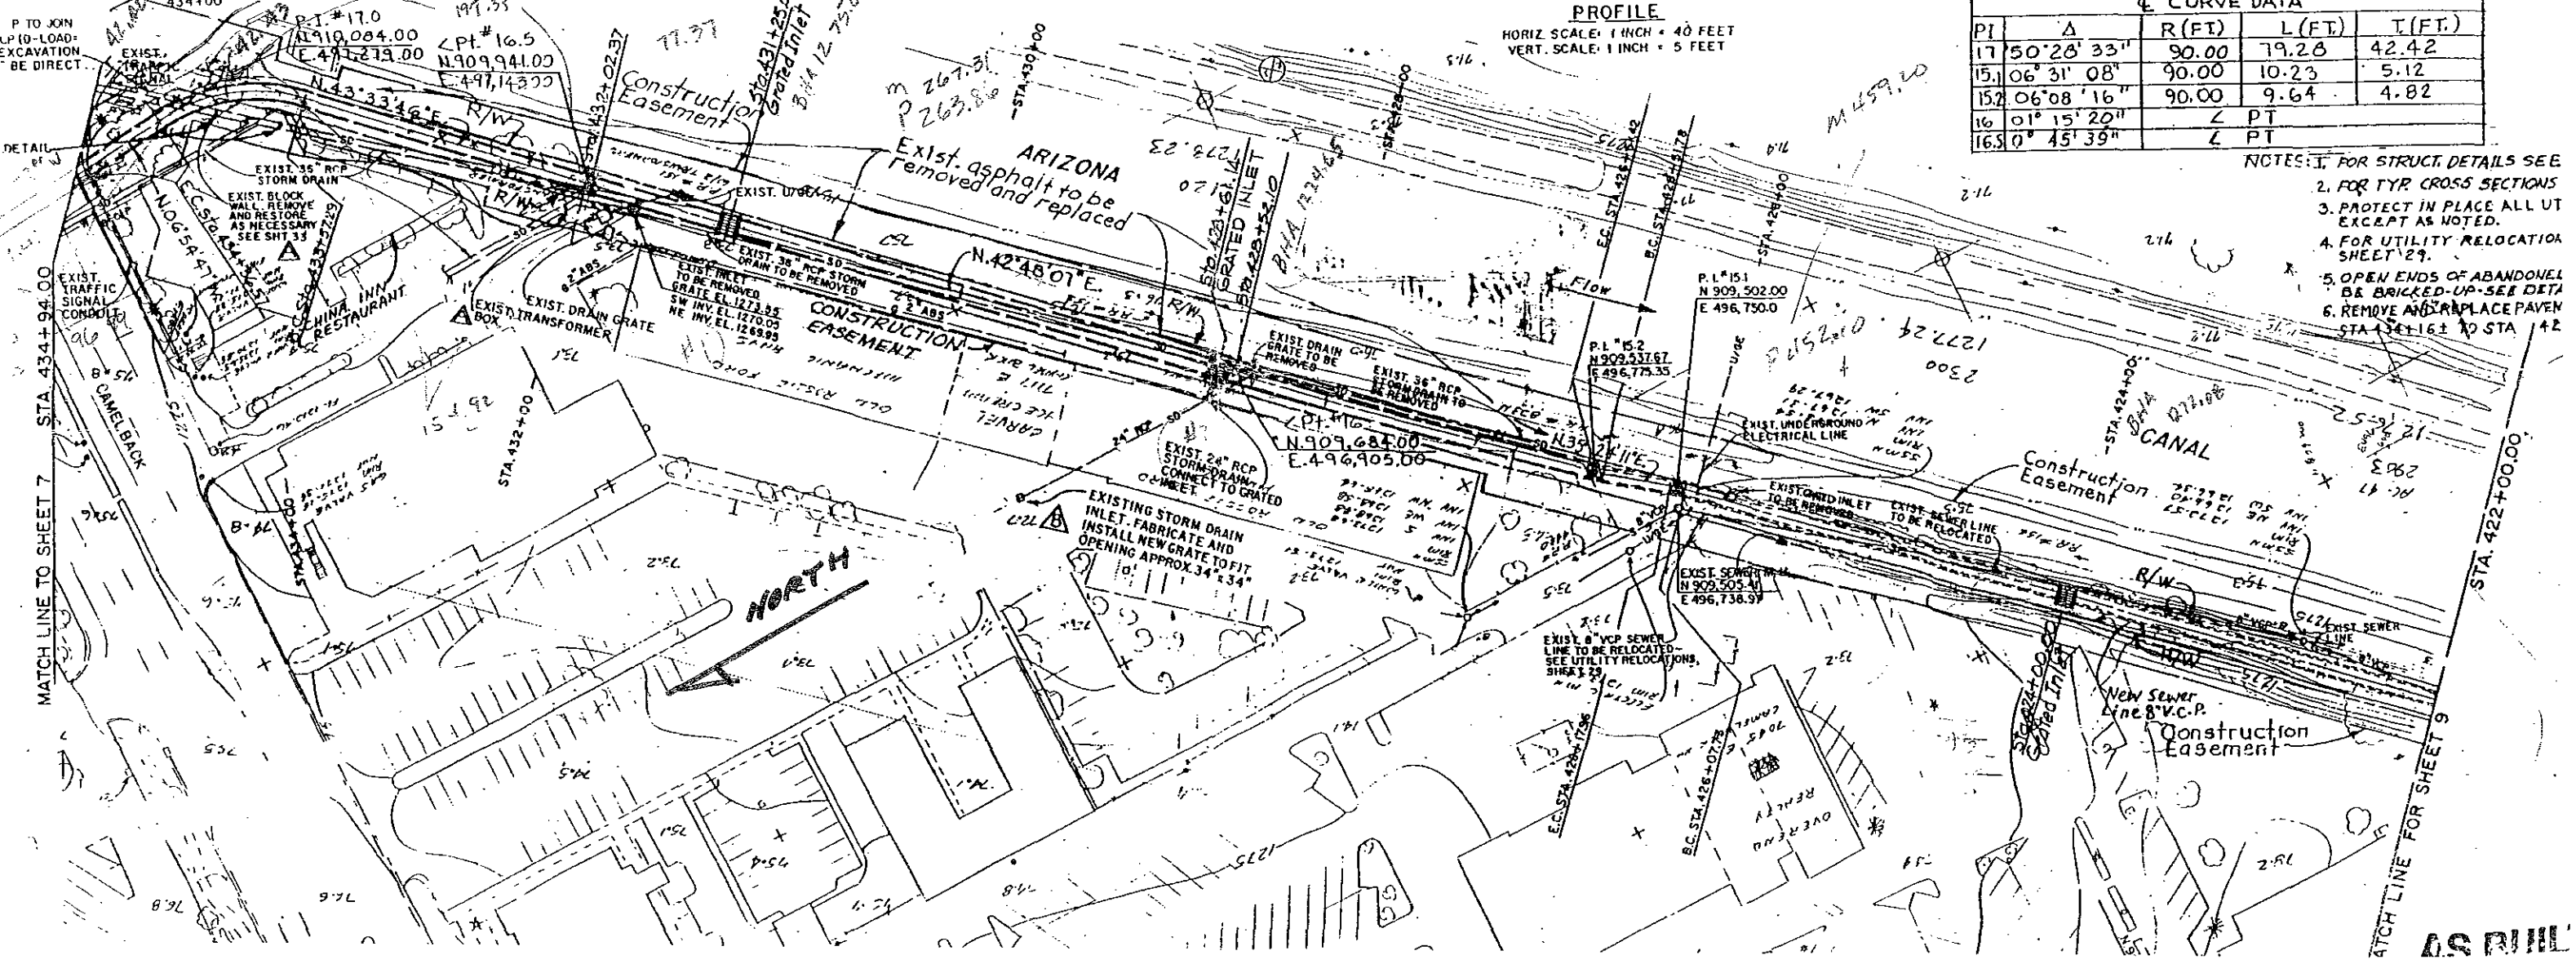


AS BUILT

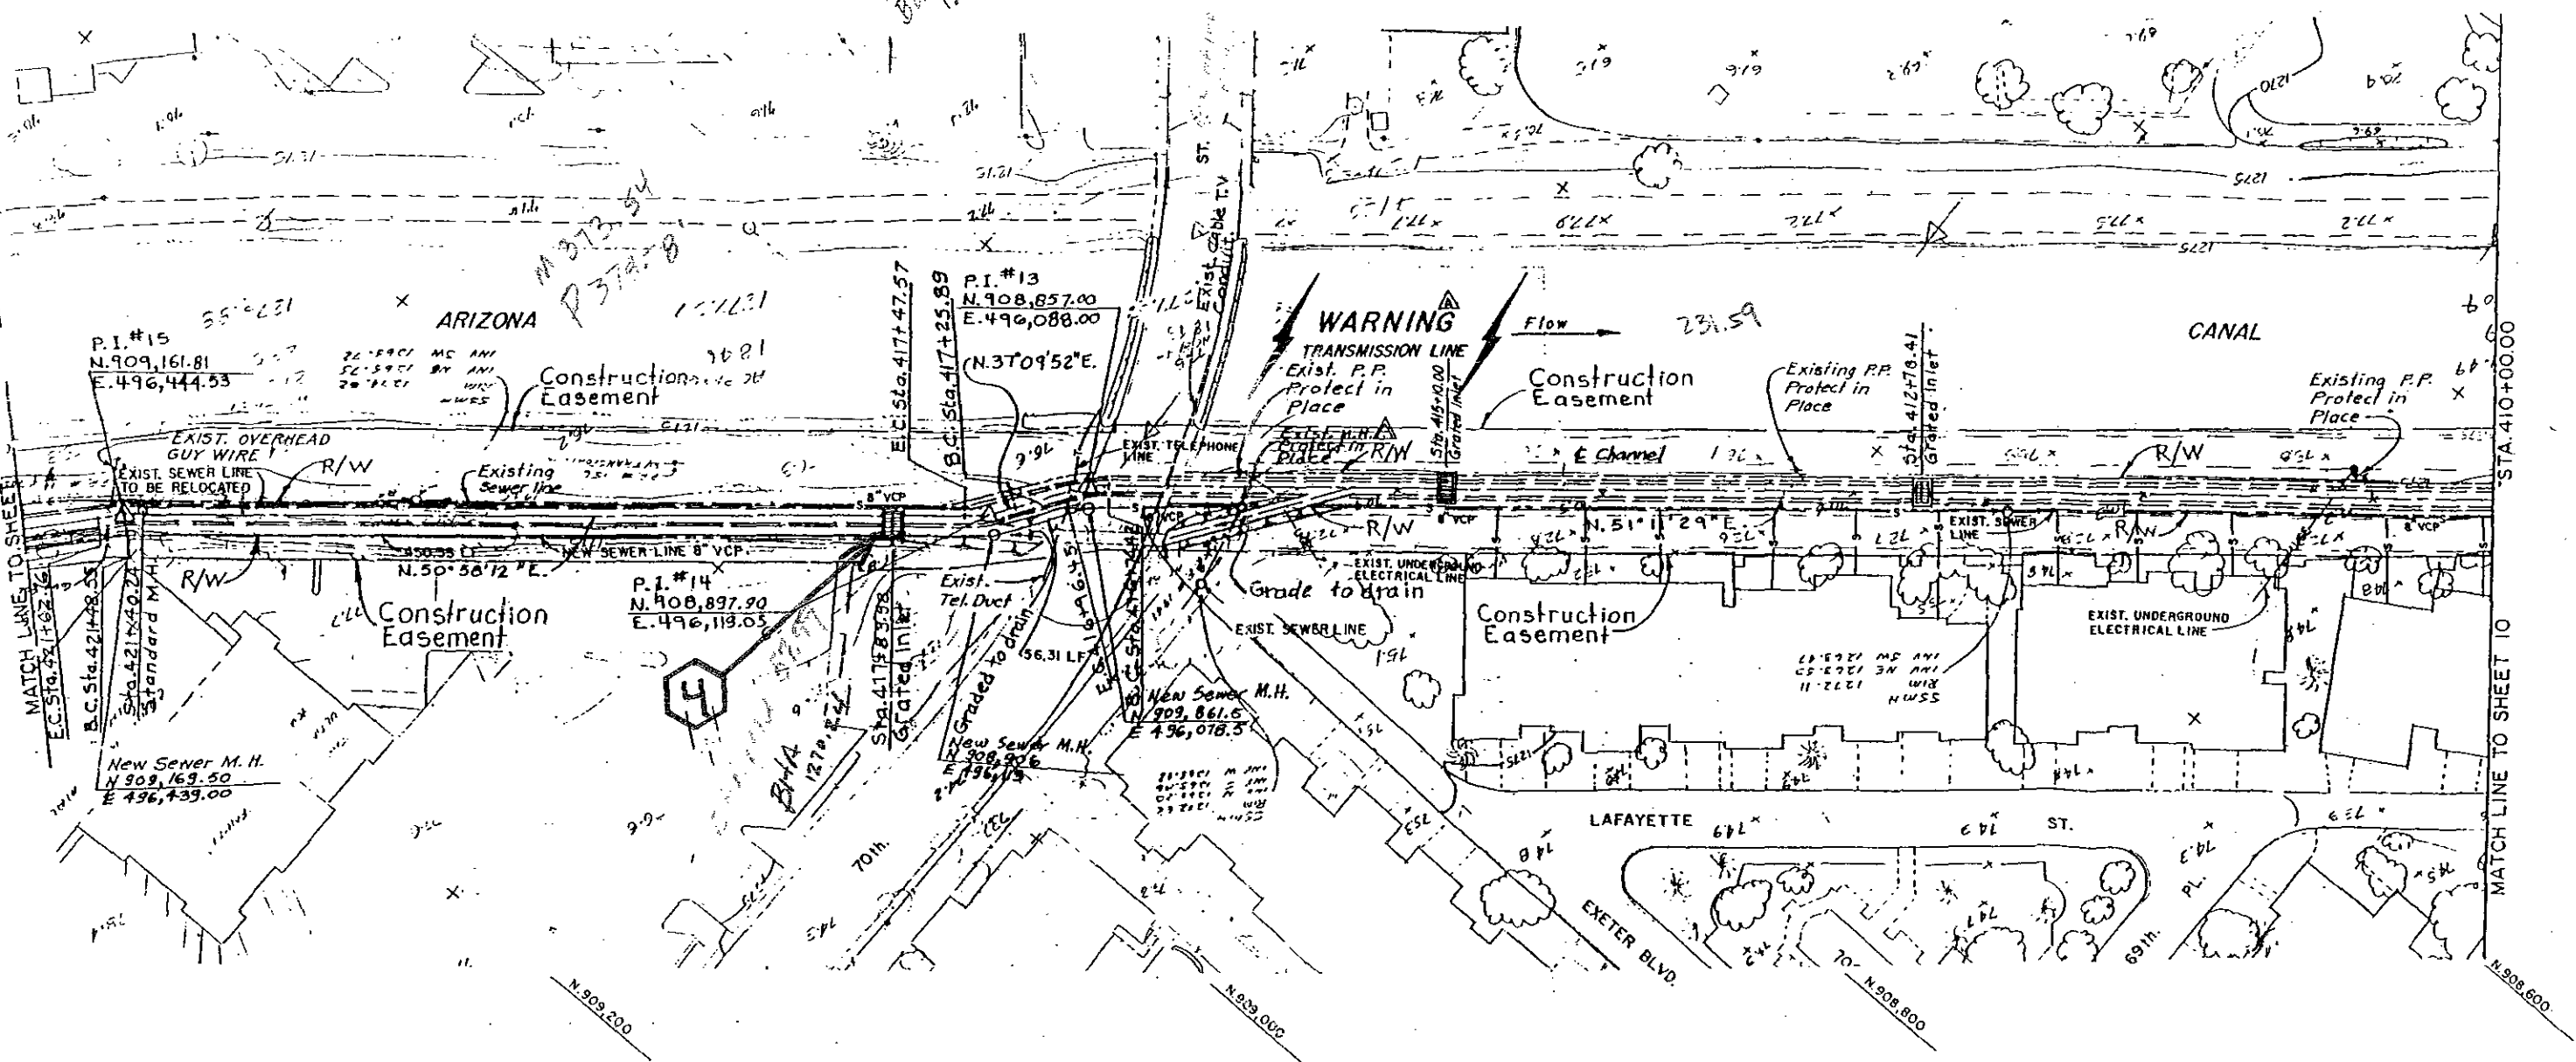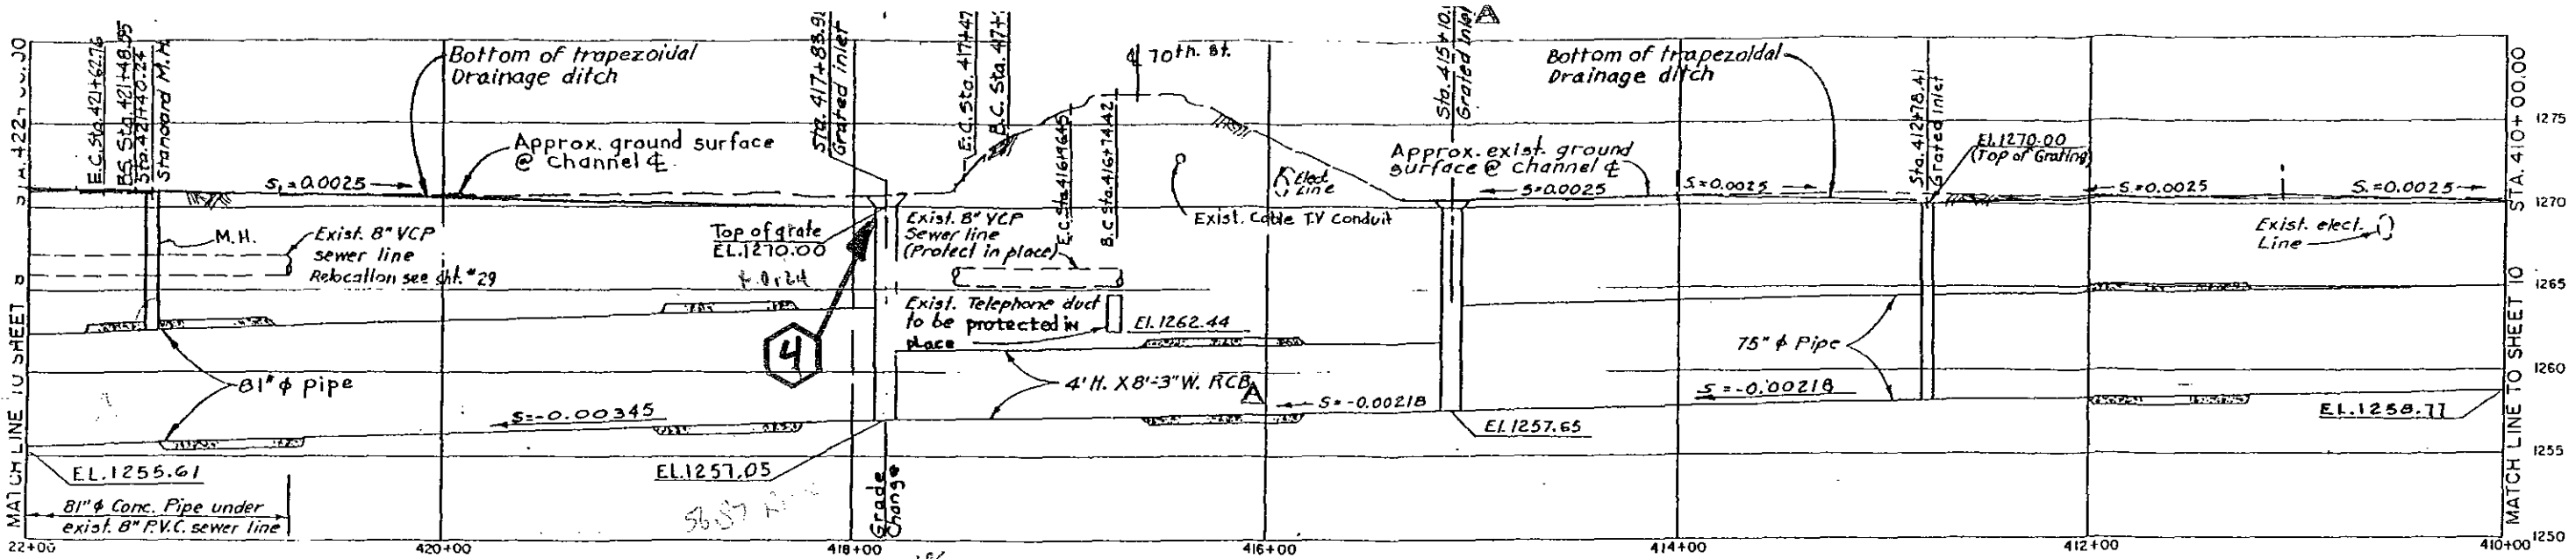


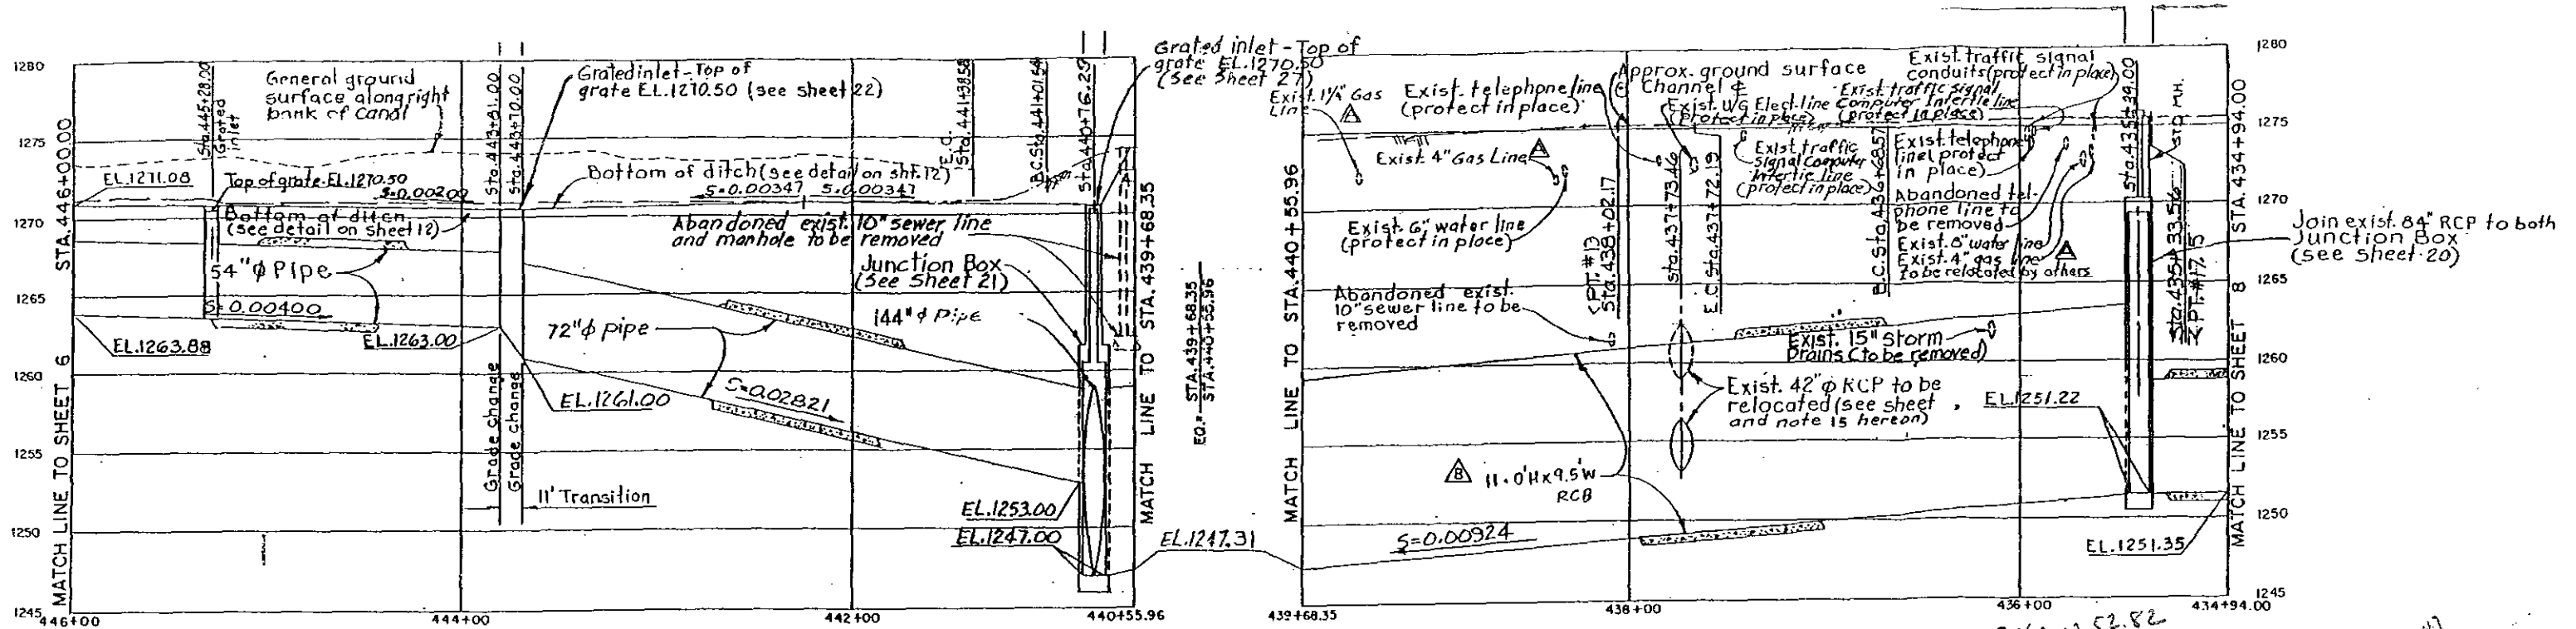

PROFILE
 HORIZ. SCALE: 1 INCH = 40 FEET
 VERT. SCALE: 1 INCH = 5 FEET

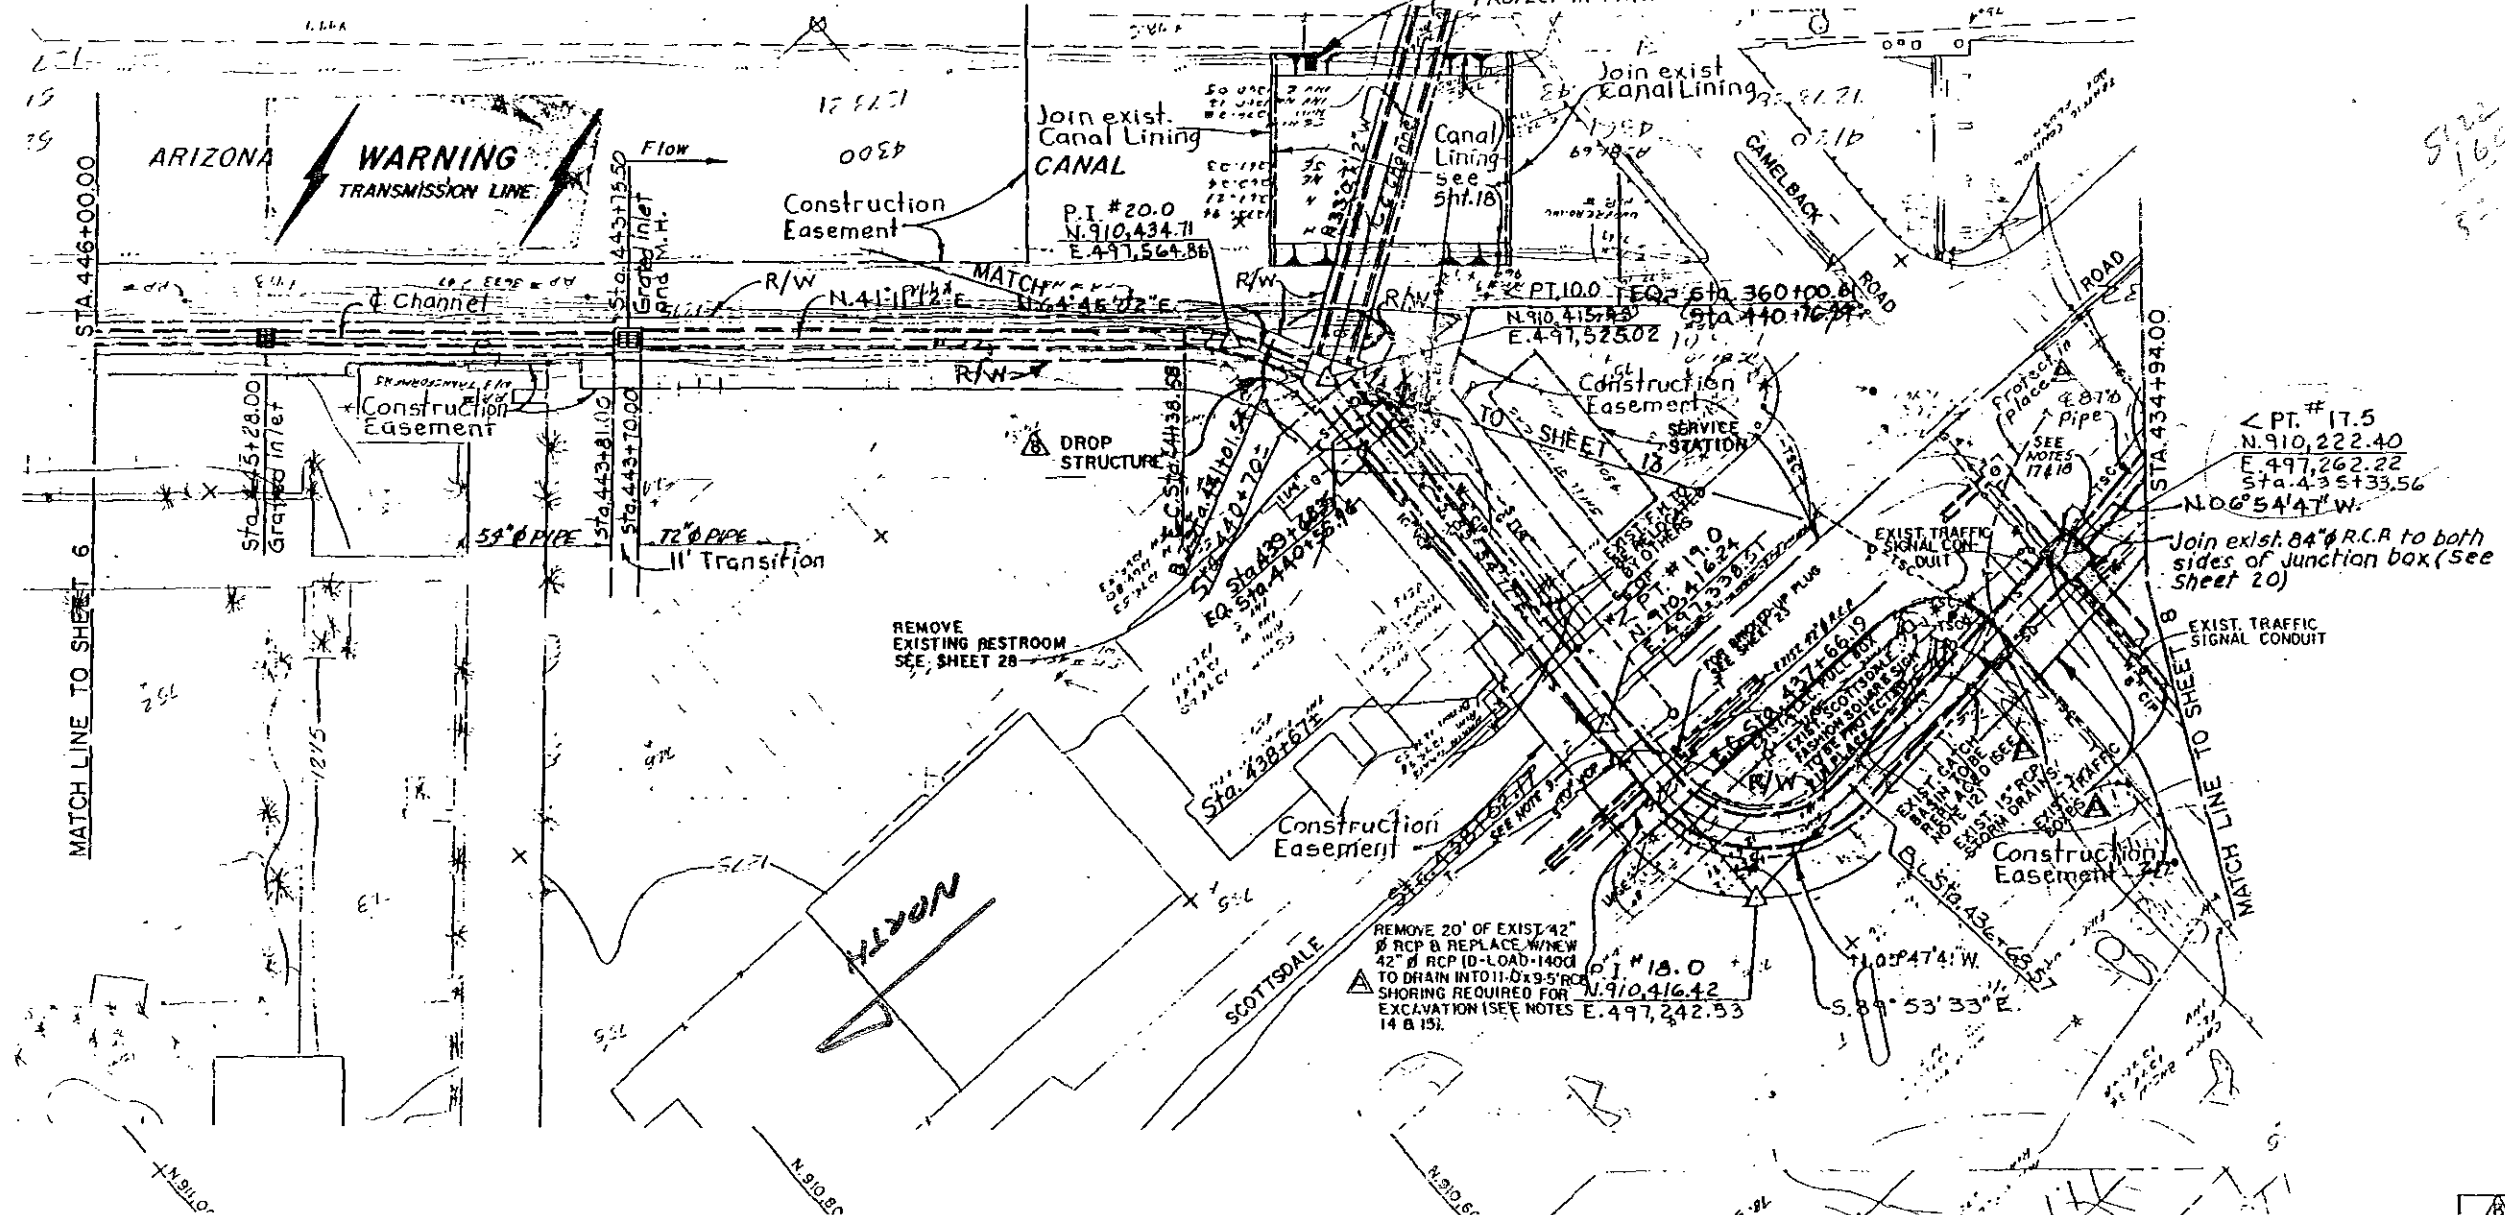

- NOTES:**
- FOR STRUCTURAL DETAILS, SEE SHEETS 20, 21, 22, 23 & 2
 - FOR TYPICAL CROSS SECTIONS, SEE SHEETS 11 & 12.
 - FOR TYPICAL ROAD REPLACEMENT DETAILS, SEE SHEET 13.
 - PROTECT IN PLACE ALL UTILITY LINES, EXCEPT AS NOTED.
 - MEDIAN STREET ISLANDS TO BE RESTORED.
 - REPLACE WITH 2" A.C. & 10" A.B.C. OVER 144" PIPE BETWEEN STA. 440+70 & STA. 438+37.
 - REMOVE AND RESTORE STORM DRAIN SYSTEMS WITHIN THE CONSTRUCTION AREA AS REQUIRED.
 - FOR LANDSCAPE, SEE SHEETS 33, 34, 35 AND 36.
 - PROTECT IN PLACE, TRAFFIC SIGNAL TIE LINE.
 - REMOVE RESTROOM.
 - REMOVE AND RESTORE SPRINKLER AND ELECTRICAL SYSTEMS WITHIN THE CONSTRUCTION AREA AS REQUIRED.
 - REMOVE AND RESTORE CATCH BASINS AND CONNECT 11'-0" X 9'-5" RCB.
 - FOR UTILITY RELOCATIONS SEE SHEET 28.
 - OPEN ENDS OF ABANDONED PIPE SHALL BE BRICKED UP. SEE DETAIL ON SHEET 23.
 - CONNECTION TO BE DIRECT TAP INTO RCB.
 - REPLACE GUNITE IN KIND AS NEEDED BETWEEN STA. 440+00 TO STA. 440+70.
 - TRAFFIC SIGNAL POLE TO BE REMOVED AND REPLACED TO PIPE INSTALLATION.
 - CITY OF SCOTTSDALE SHALL REWIRE & RESTORE OPERATION COMPLETION.

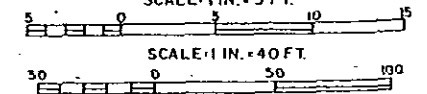

AS BUILT

DATUM IS MEAN SEA LEVEL

AS BUILT REVISIONS

BHA 12.52.82
 06 07 06
 05 07 06


72"Ø (RCP D-LOAD=800)

grated inlet - Top of


Approx. ground surface Channel Elev. 1.6' VG Elev. 1.2'

VALUE ENGINEER


ENVIRONMENTAL ENHANCEMENT THRU ENGINEERING

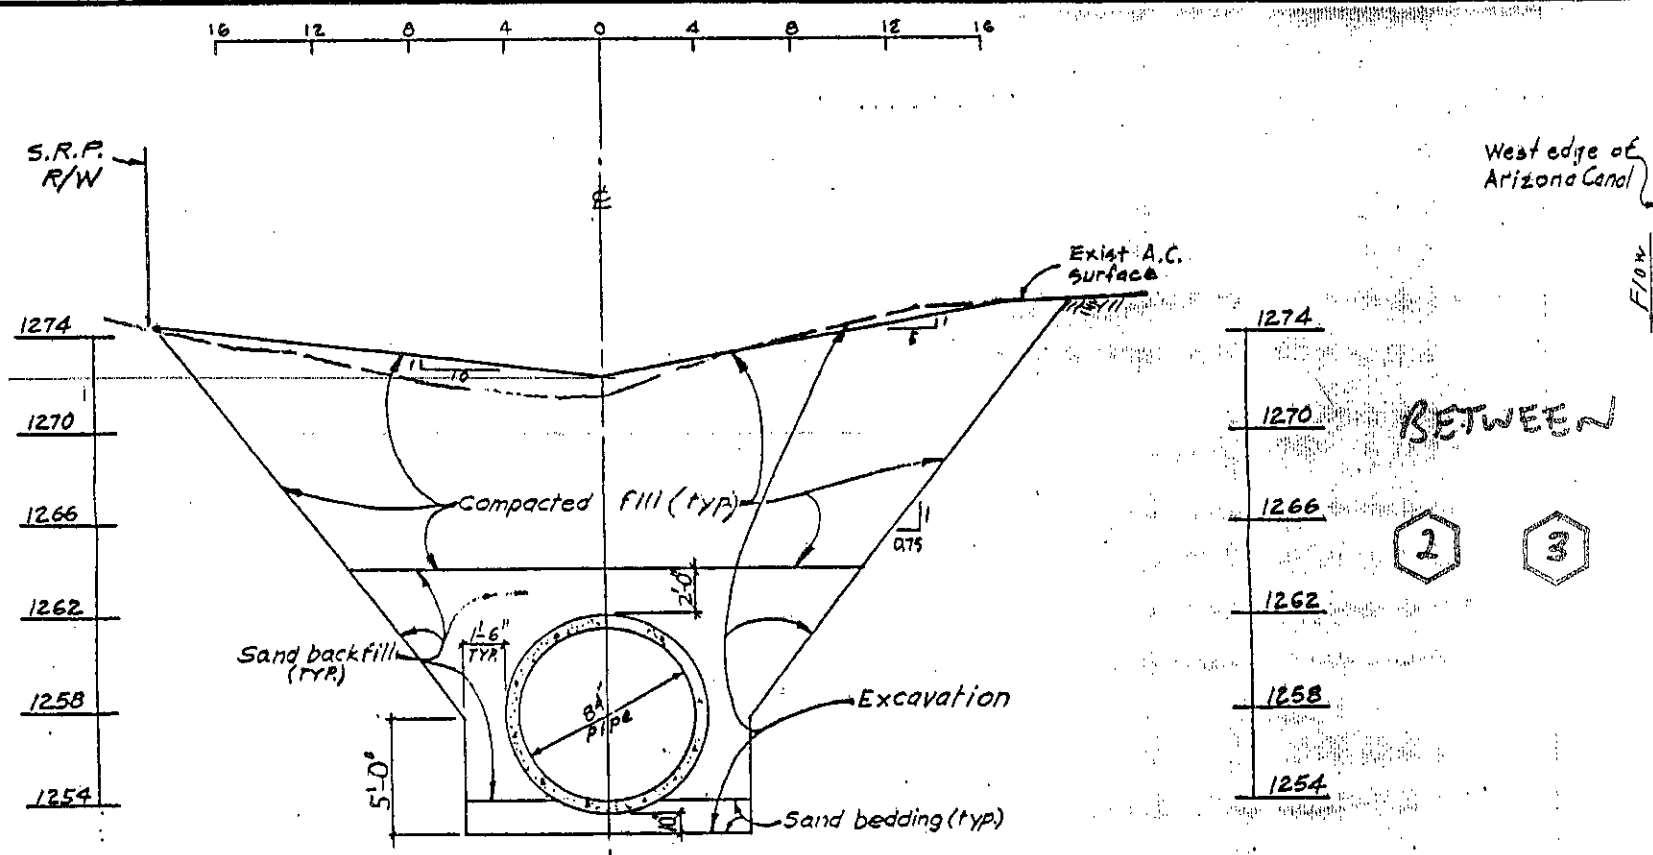

STA. 426+43

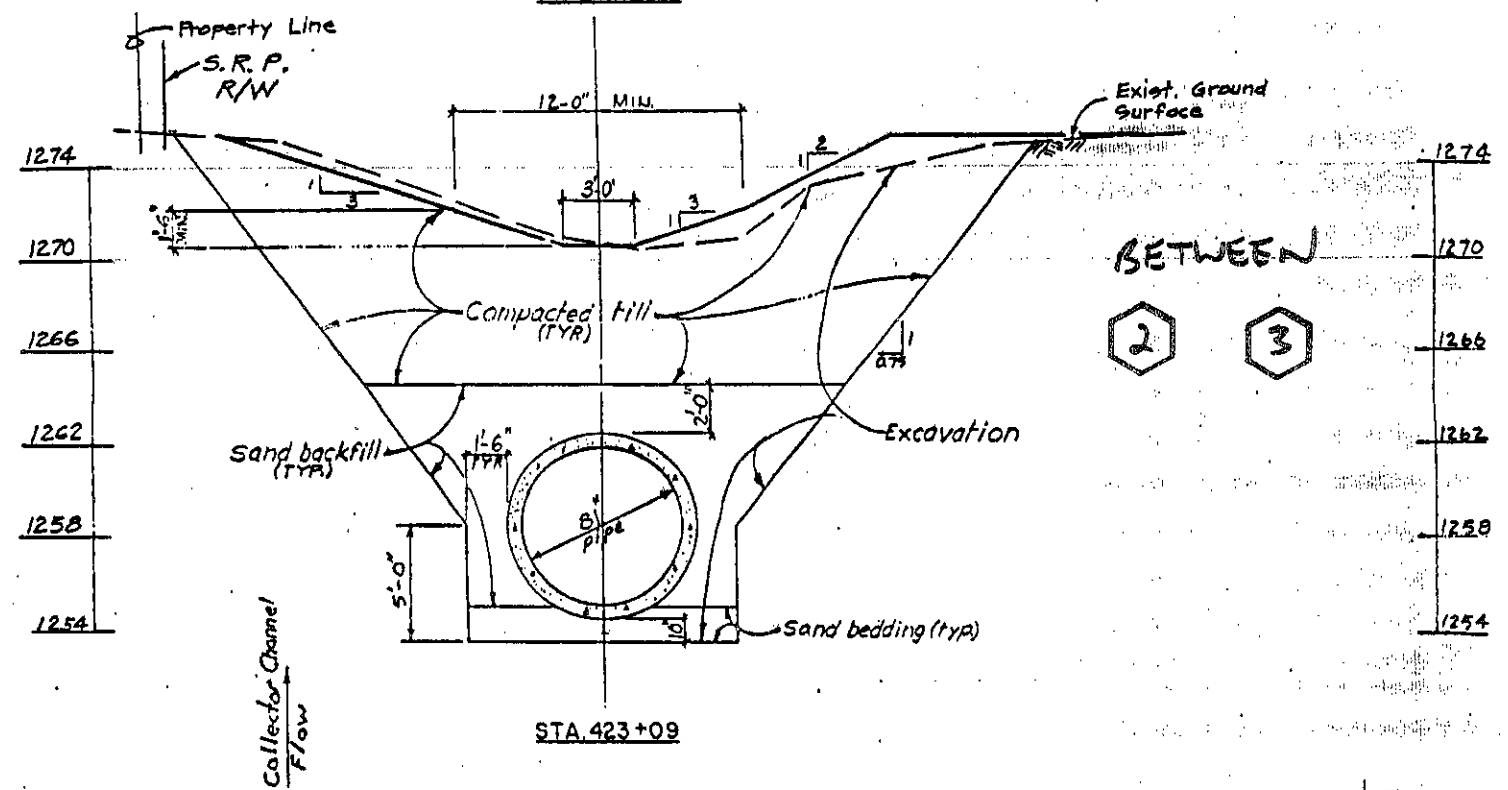

STA. 423+09

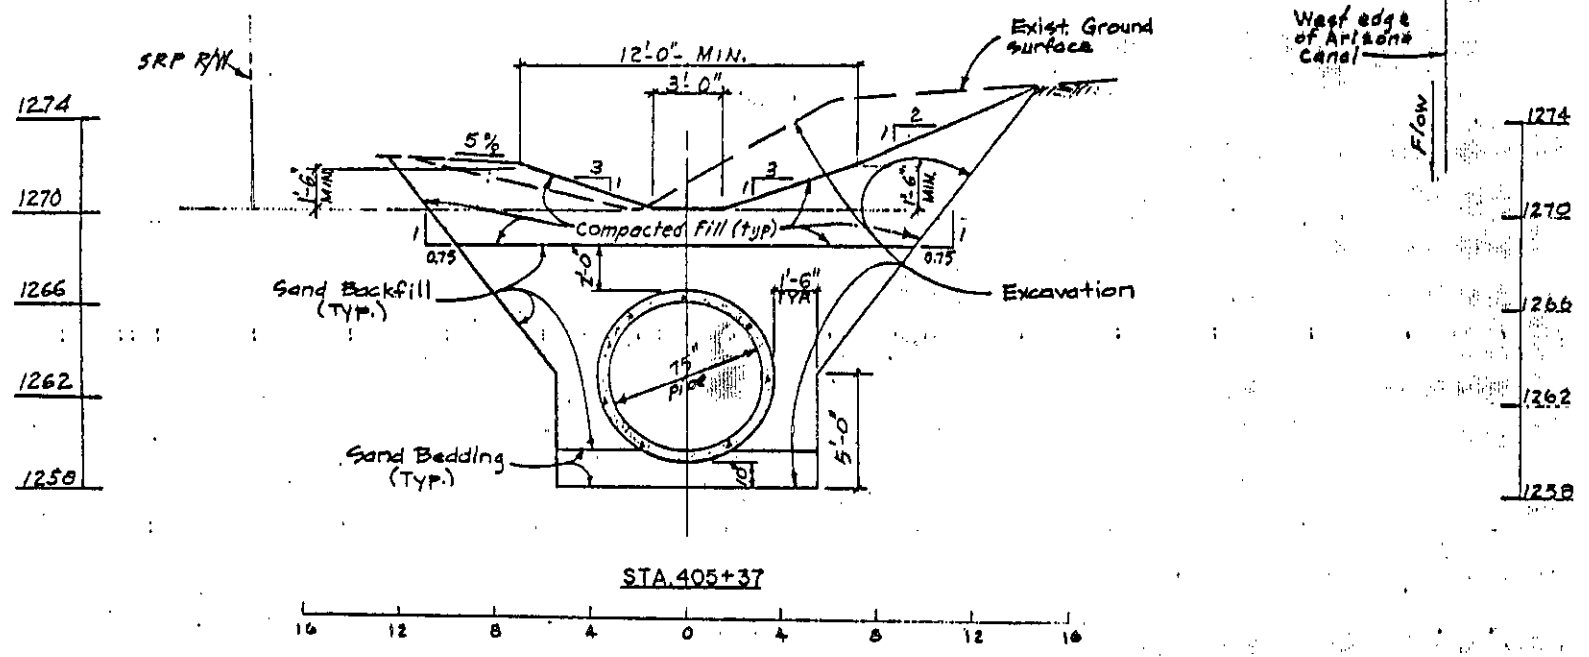

STA. 405+37

SAFETY