
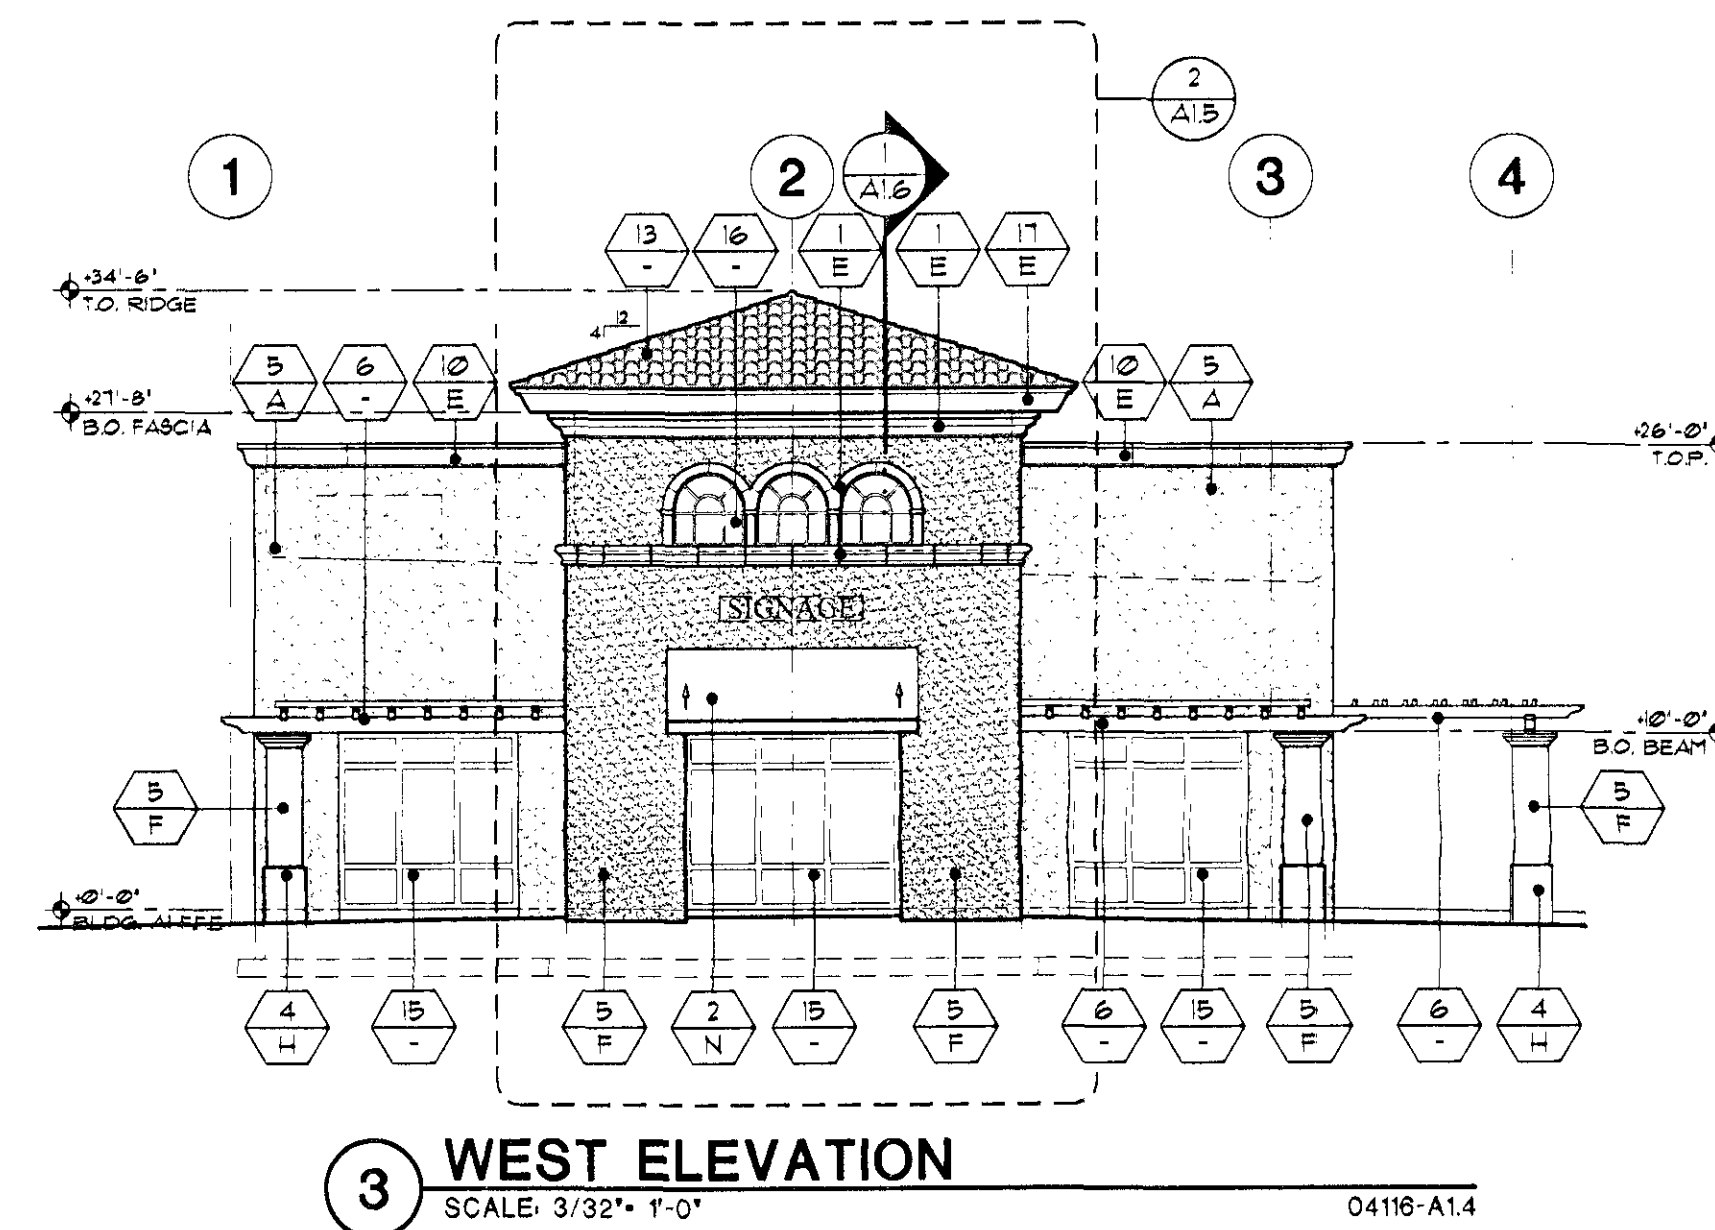
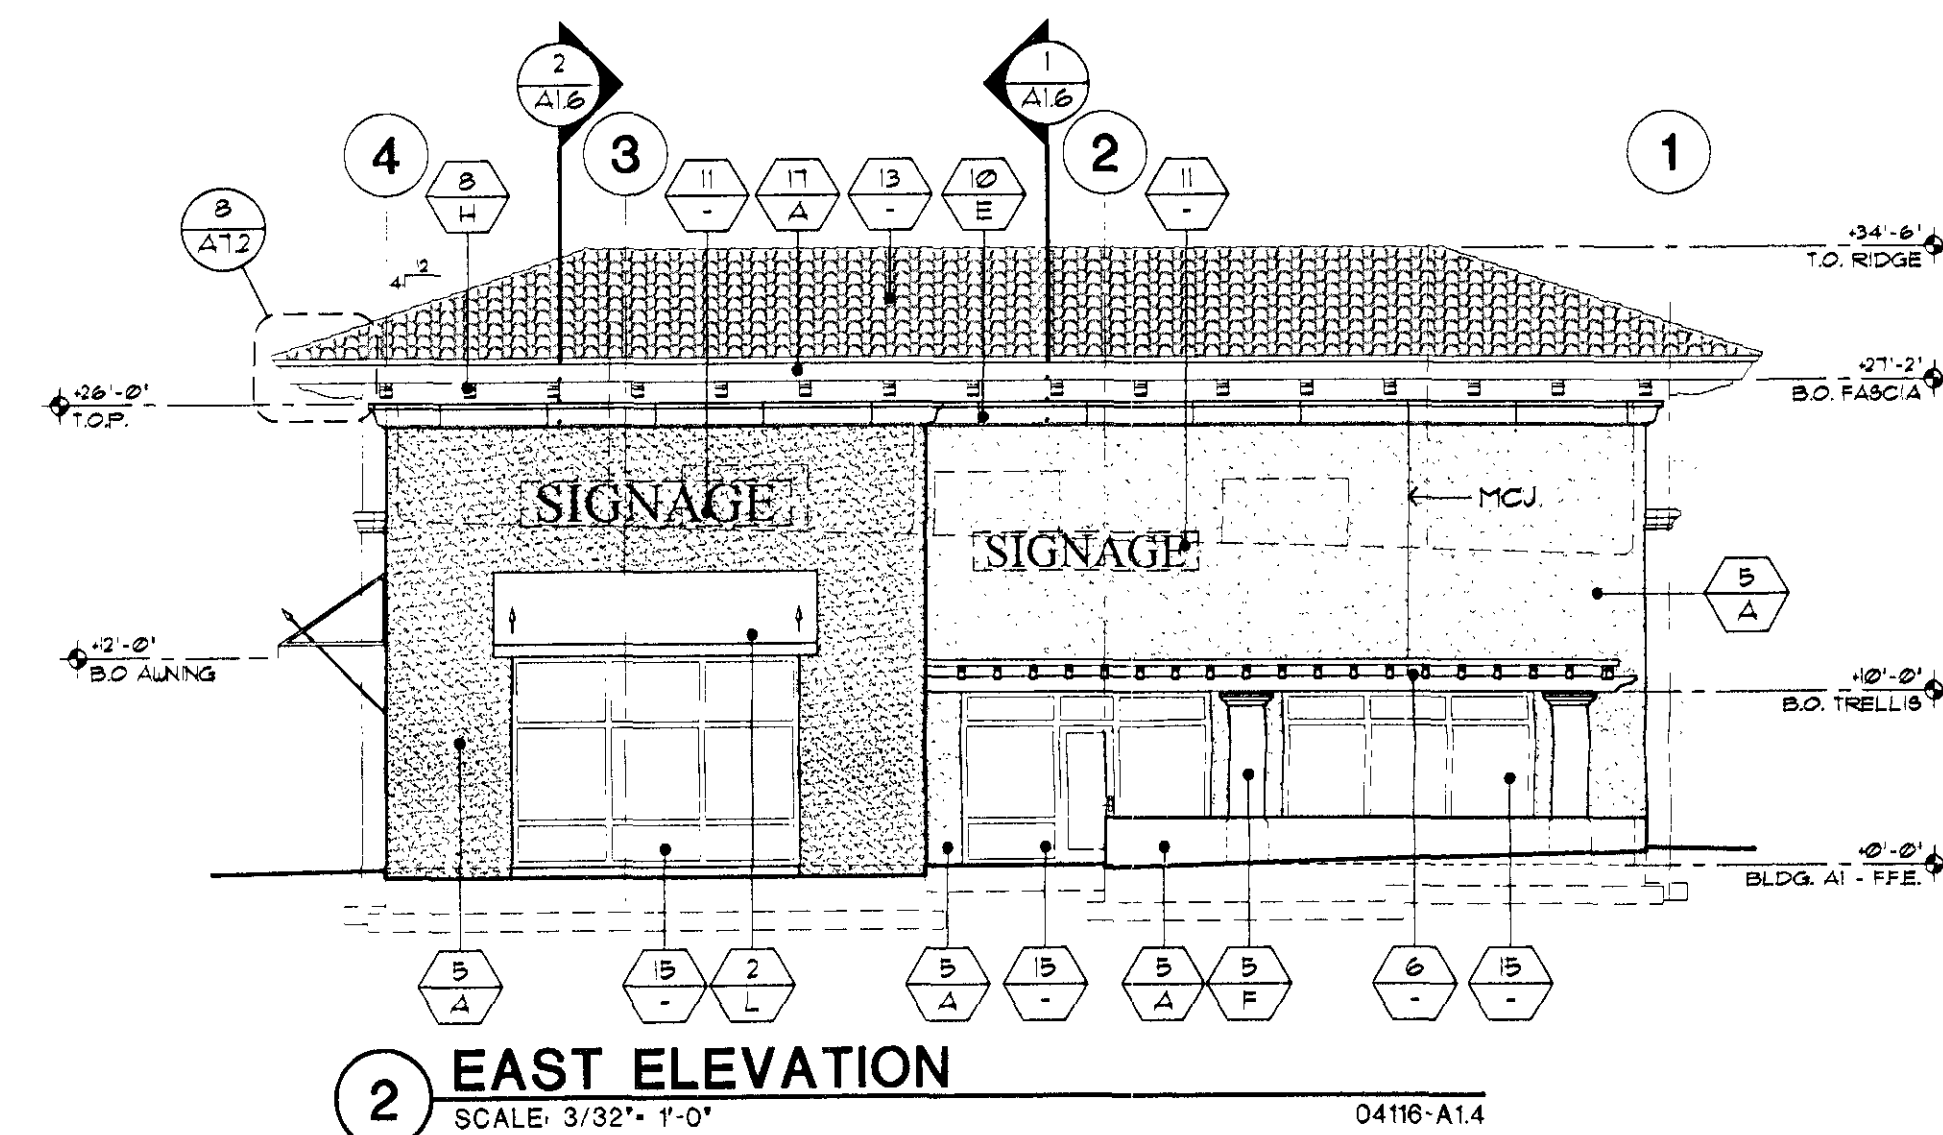


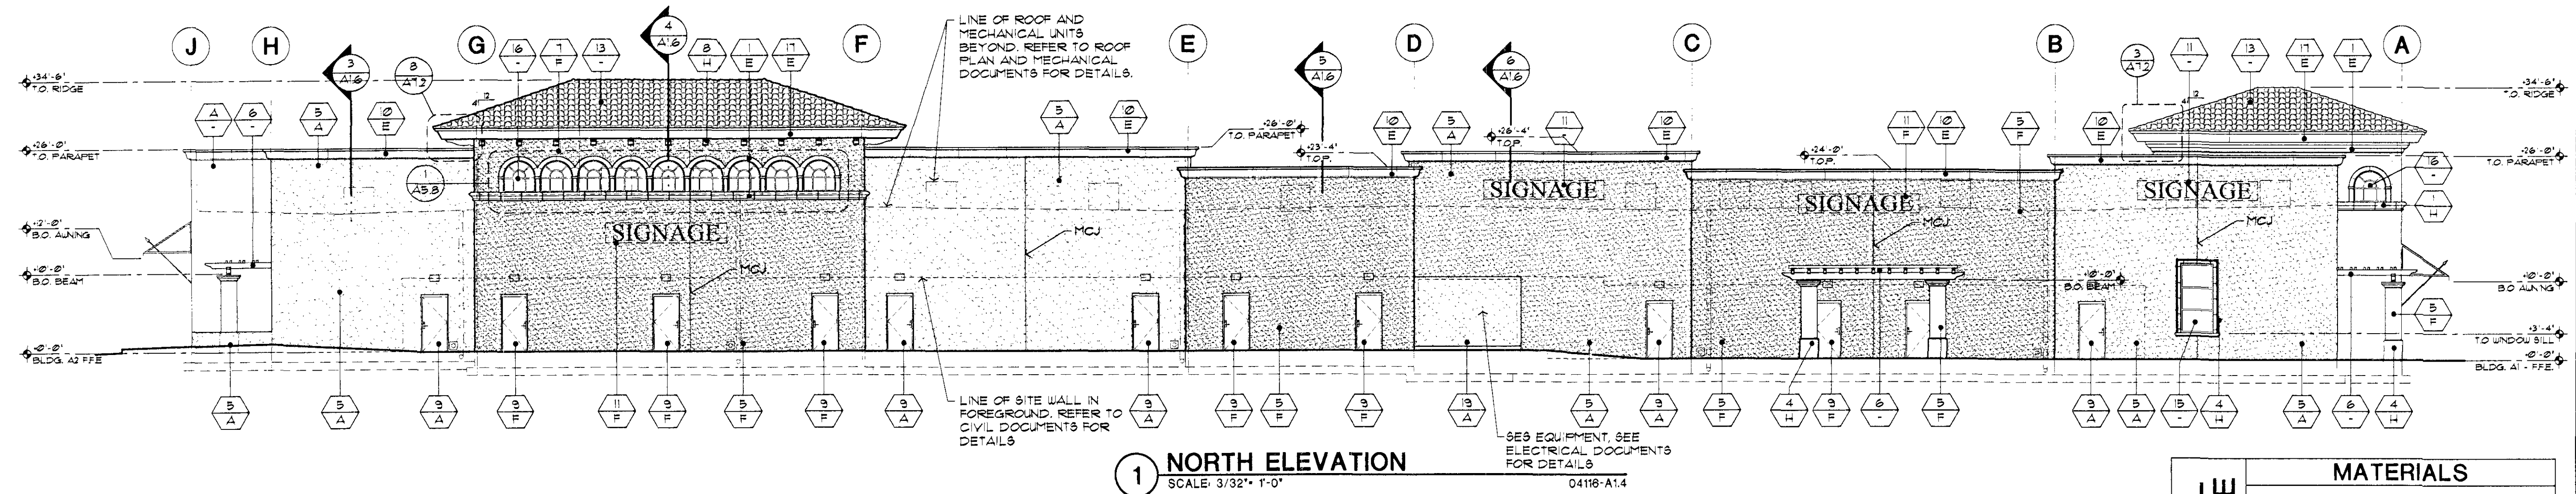



ARCHITECTURAL ELEVATIONS
APPROVED

BY THE CITY OF SCOTTSDALE PLANNING DEPARTMENT
91-DR-2006-4 8/14/07
7330-06-4
CONSTRUCTION AND INSTALLATION SHALL BE IN ACCORDANCE WITH THE CITY OF SCOTTSDALE PLANNING DEPARTMENT'S STANDARD SPECIFICATIONS FOR CONSTRUCTION AND INSTALLATION OF SIGNS AND MARKERS.

NOTE: OPENING HEIGHTS, CANOPIES AND SOFFITS ARE FROM FINISH FLOOR Varies 1'-0" EITHER SIDE OF COLUMN LINE "D".

MATERIAL SCHEDULE	MATERIALS
1. E.I.F.S. POPOUT	1. E.I.F.S. POPOUT
2. FABRIC AWNING W/ SPEAR	2. FABRIC AWNING W/ SPEAR
3. TENSION FABRIC SHADE STRUCTURE	3. TENSION FABRIC SHADE STRUCTURE
4. PRECAST CONCRETE	4. PRECAST CONCRETE
5. SYNTHETIC STUCCO OVER MASONRY	5. SYNTHETIC STUCCO OVER MASONRY
6. STEEL TRELLIS	6. STEEL TRELLIS
7. E.I.F.S. OVER WOOD FRAMING	7. E.I.F.S. OVER WOOD FRAMING
8. E.I.F.S. CORBEL	8. E.I.F.S. CORBEL
9. H.M. DOOR	9. H.M. DOOR
10. E.I.F.S. CORNICE	10. E.I.F.S. CORNICE
11. TENANT SIGNAGE TO MEET DEV. GUIDELINES (UNDER SEPARATE APPROVAL & PERMIT)	11. TENANT SIGNAGE TO MEET DEV. GUIDELINES (UNDER SEPARATE APPROVAL & PERMIT)
12. BUILDING ADDRESS TO BE PLAINLY LEGIBLE AND VISIBLE FROM THE STREET. THEY SHALL CONTRAST WITH THEIR BACKGROUND AND SHALL BE A MIN. OF 4" HIGH WITH A MIN. STROKE WIDTH OF 0.5"	12. BUILDING ADDRESS TO BE PLAINLY LEGIBLE AND VISIBLE FROM THE STREET. THEY SHALL CONTRAST WITH THEIR BACKGROUND AND SHALL BE A MIN. OF 4" HIGH WITH A MIN. STROKE WIDTH OF 0.5"
13. CLAY ROOF TILE - OLD BEDONA & CAPE ANTONIA BY REDLAND TILE	13. CLAY ROOF TILE - OLD BEDONA & CAPE ANTONIA BY REDLAND TILE
14. ORNAMENTAL LIGHT FIXTURE	14. ORNAMENTAL LIGHT FIXTURE
15. ALUMINUM STOREFRONT SYSTEM	15. ALUMINUM STOREFRONT SYSTEM
16. ALUMINUM FRAME WINDOW	16. ALUMINUM FRAME WINDOW
17. BREAK METAL WRAPPED FASCIA	17. BREAK METAL WRAPPED FASCIA
18. CENTER LOGO - T.B.D.	18. CENTER LOGO - T.B.D.
19. E.E.S. - PAINTED TO MATCH BUILDING	19. E.E.S. - PAINTED TO MATCH BUILDING


COLORS
A. (C) PAINTS - 229 ROBEDOWN
B. (C) PAINTS - 469 ENGLISH COTTAGE
C. (C) PAINTS - 476 GOLDEN WHEAT
D. (C) PAINTS - 1400 SPA BLUE
E. (C) PAINTS - 480 SHADOWBOX
F. (C) PAINTS - 382 KENYA CORREL
G. 1/4" CLEAR GLAZING
H. (C) PRECAST CONCRETE COLOR - 'GRAY'
J. (C) PRECAST CONCRETE COLOR - 'SP30'
K. (C) PRECAST CONCRETE COLOR - 'W030'
L. SUNBRELLA - 'SAPHIRE BLUE' WITH 'SKY BLUE' TRIM
M. SUNBRELLA - 'FLUM'
N. SUNBRELLA - 'TERRA COTTA' WITH 'TAUPE' TRIM
P. DUNN EDWARDS - DE 3/91 S DEUNDER

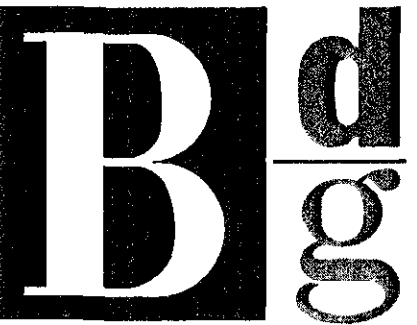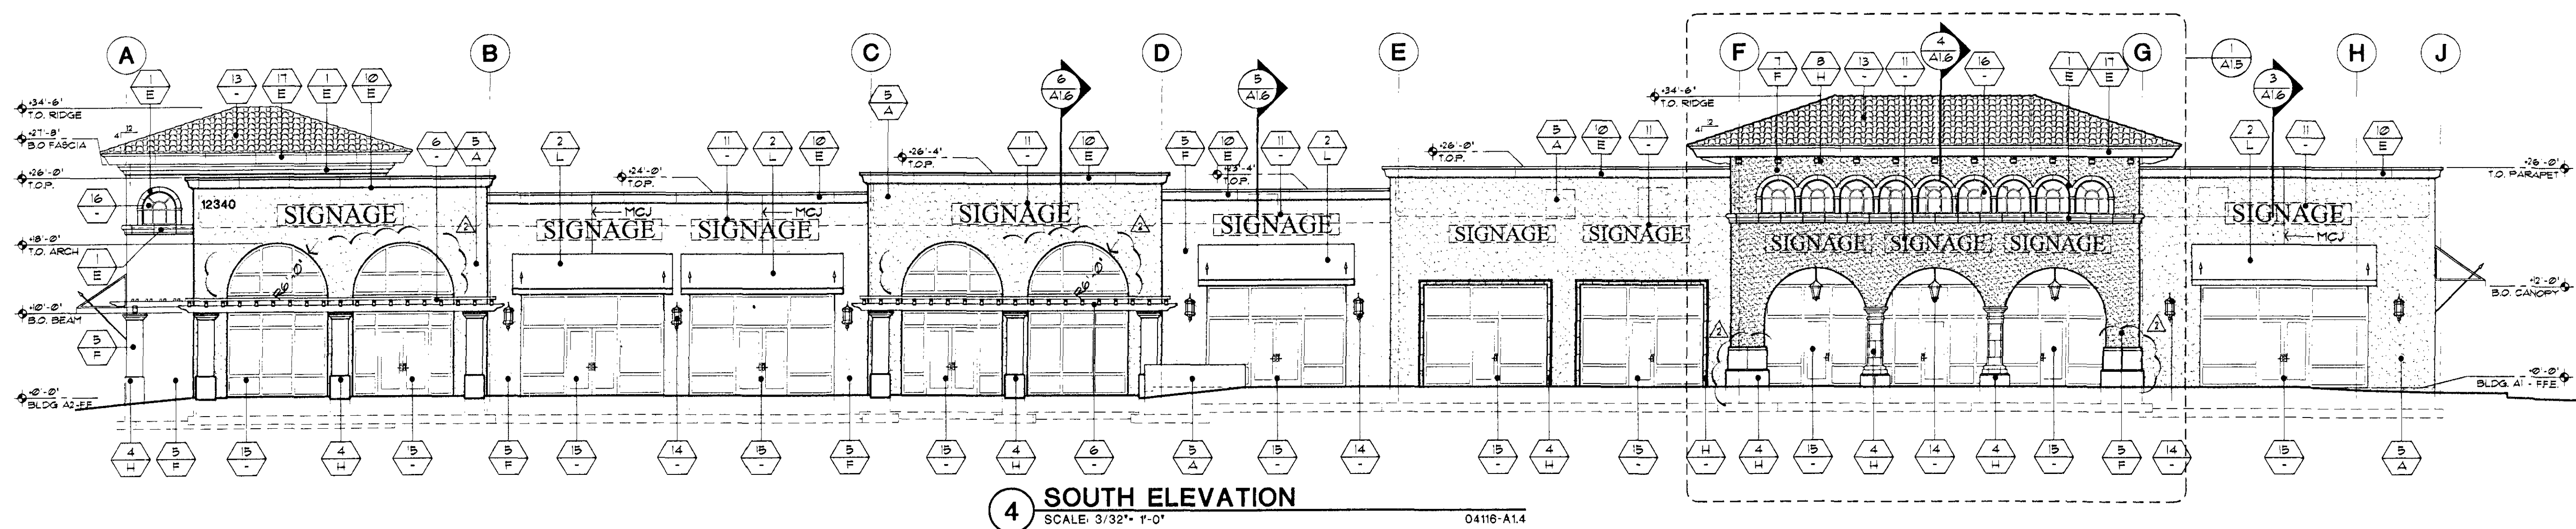


Butler Design Group Inc.
Architects & Planners

5555 East Van Buren St.
Suite 215
Phoenix, Arizona 85008

phone 602-957-1800
fax 602-957-7722

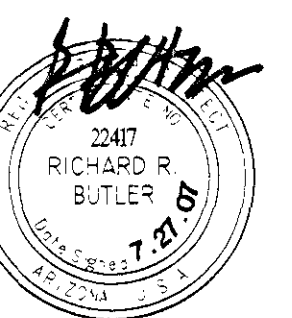

OWNERSHIP OF INSTRUMENTS OF SERVICE
All reports, plans, specifications, computer files, notes, and other documents and instruments created by the design professional in the course of service shall remain the property of the design professional. The design professional shall retain all copyright and other reserved rights, including the copyright, in these instruments.

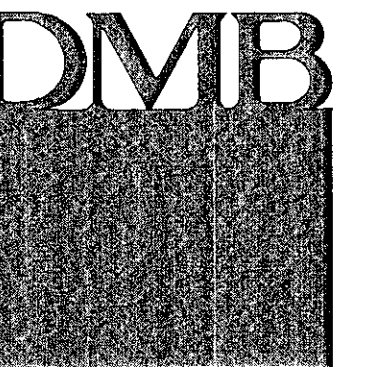

Ranch Crossing
18201-18291 N. PIMA ROAD
SCOTTSDALE, AZ
91-DR-2006 246-SA-2007 42-SA-2007

Revisions:

- COORDINATION 07.8.07
- CITY COMMENTS 07.8.07

Title: SHOPS A
ELEVATIONS

Date: 5/7/2007

Project number: 04116

Drawn by: RAH

Checked by: PH

CAD file: 04116-A1.4

☐ Design Development

☐ Progress Const. Docs.

☒ City Submittal

☐ Bid Package




☐ Construction Issue

☐ Record Drawings

Sheet Number:

A1.4

7330-06-04 15-PP-2006 91-DR-2006 246-SA-2007 42-SA-2007

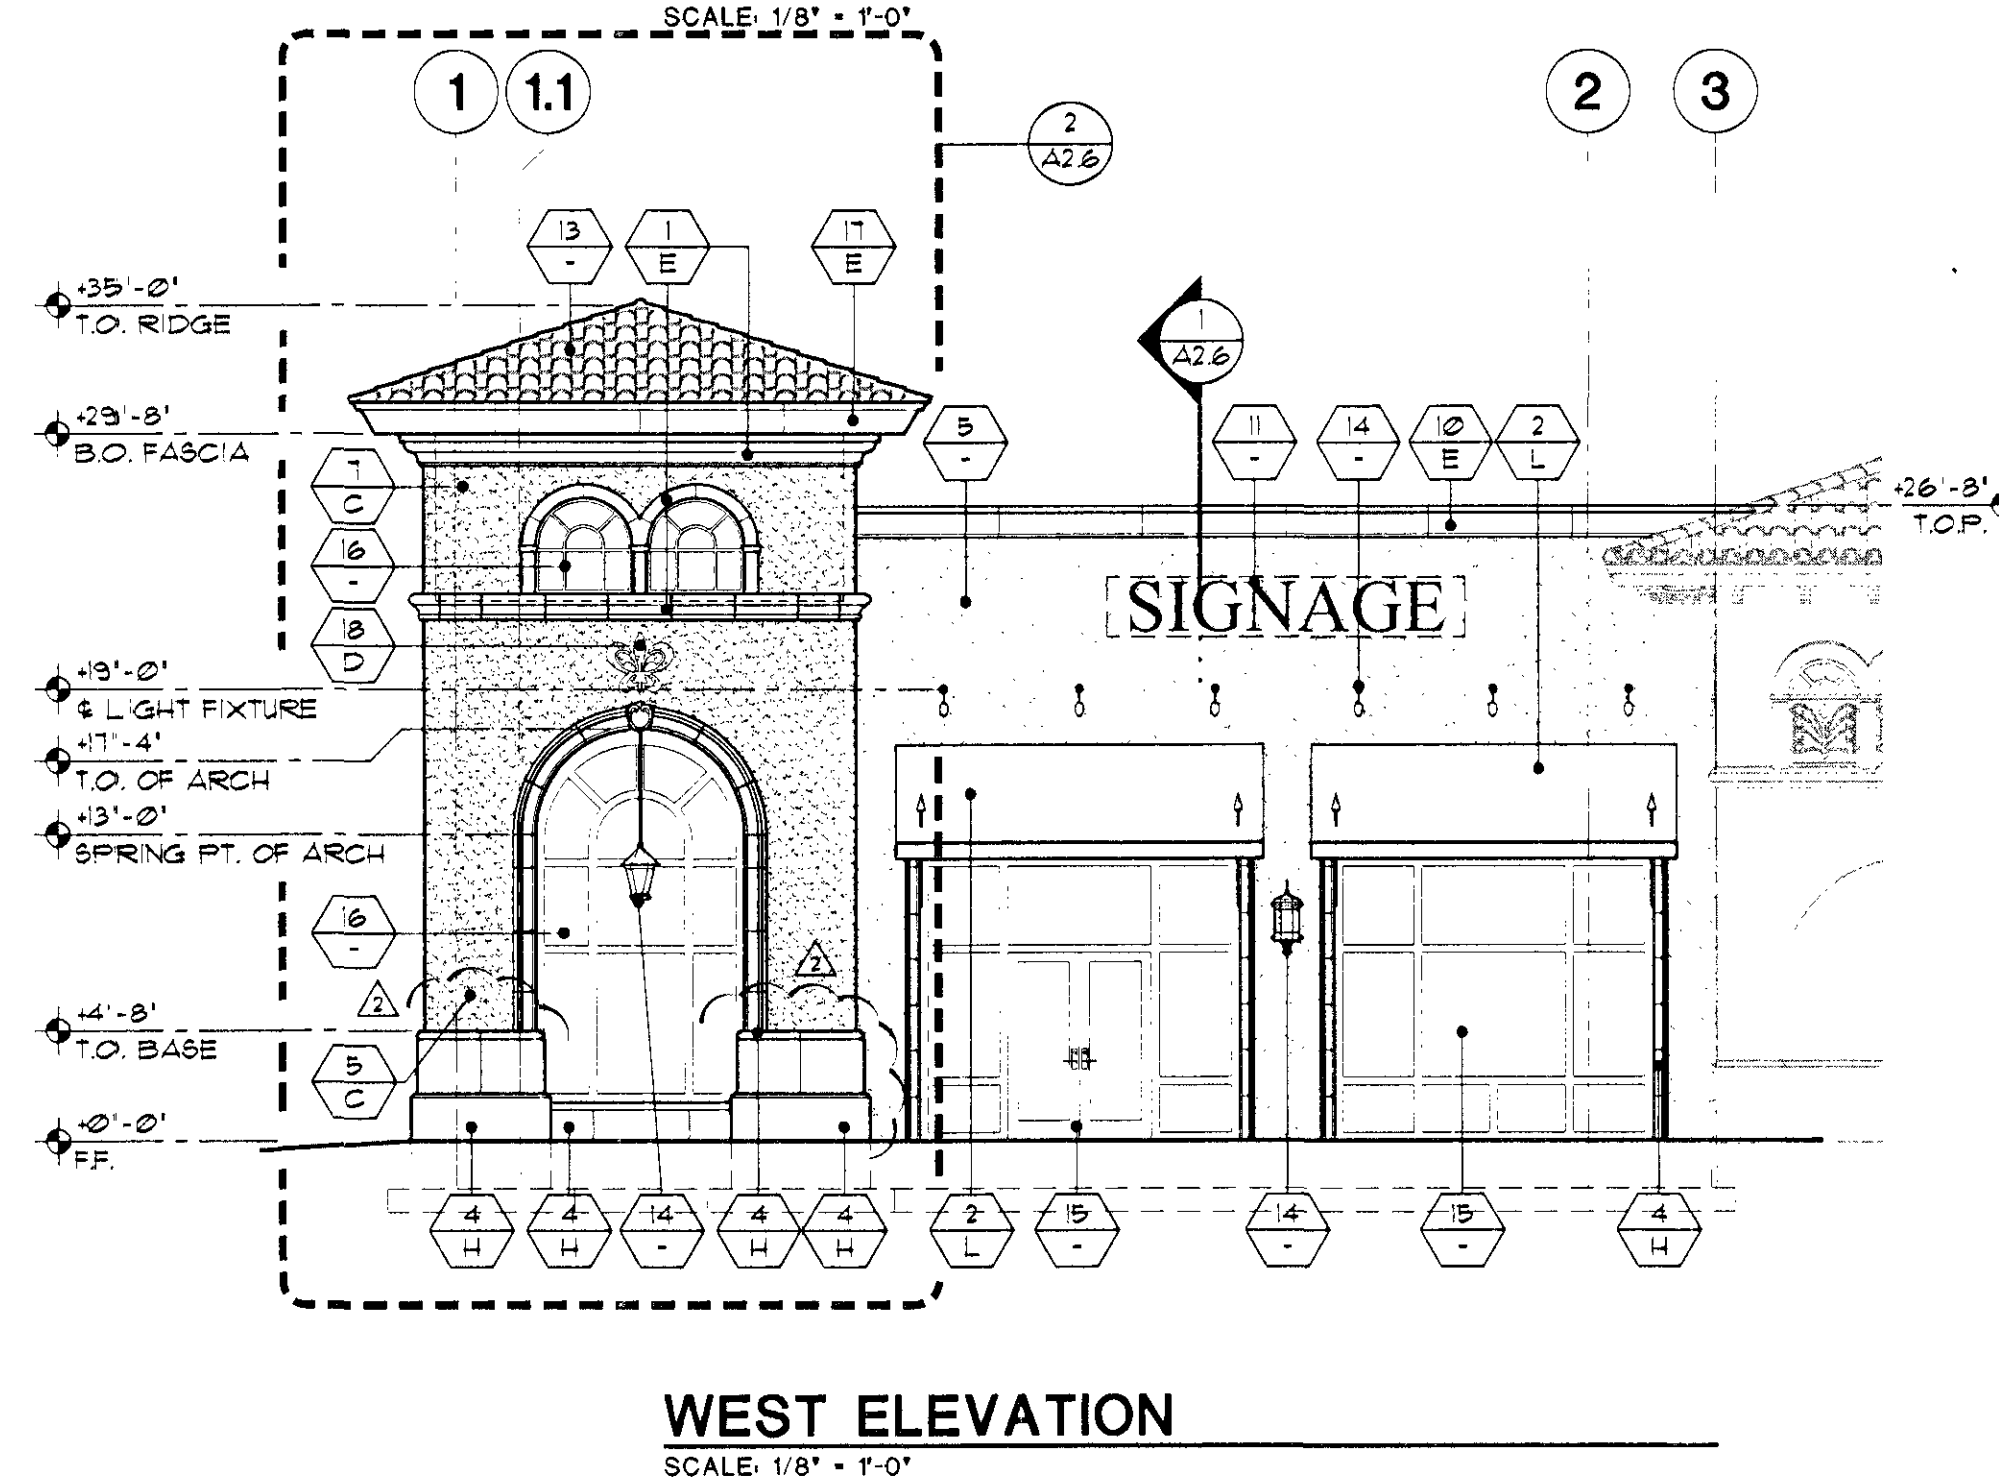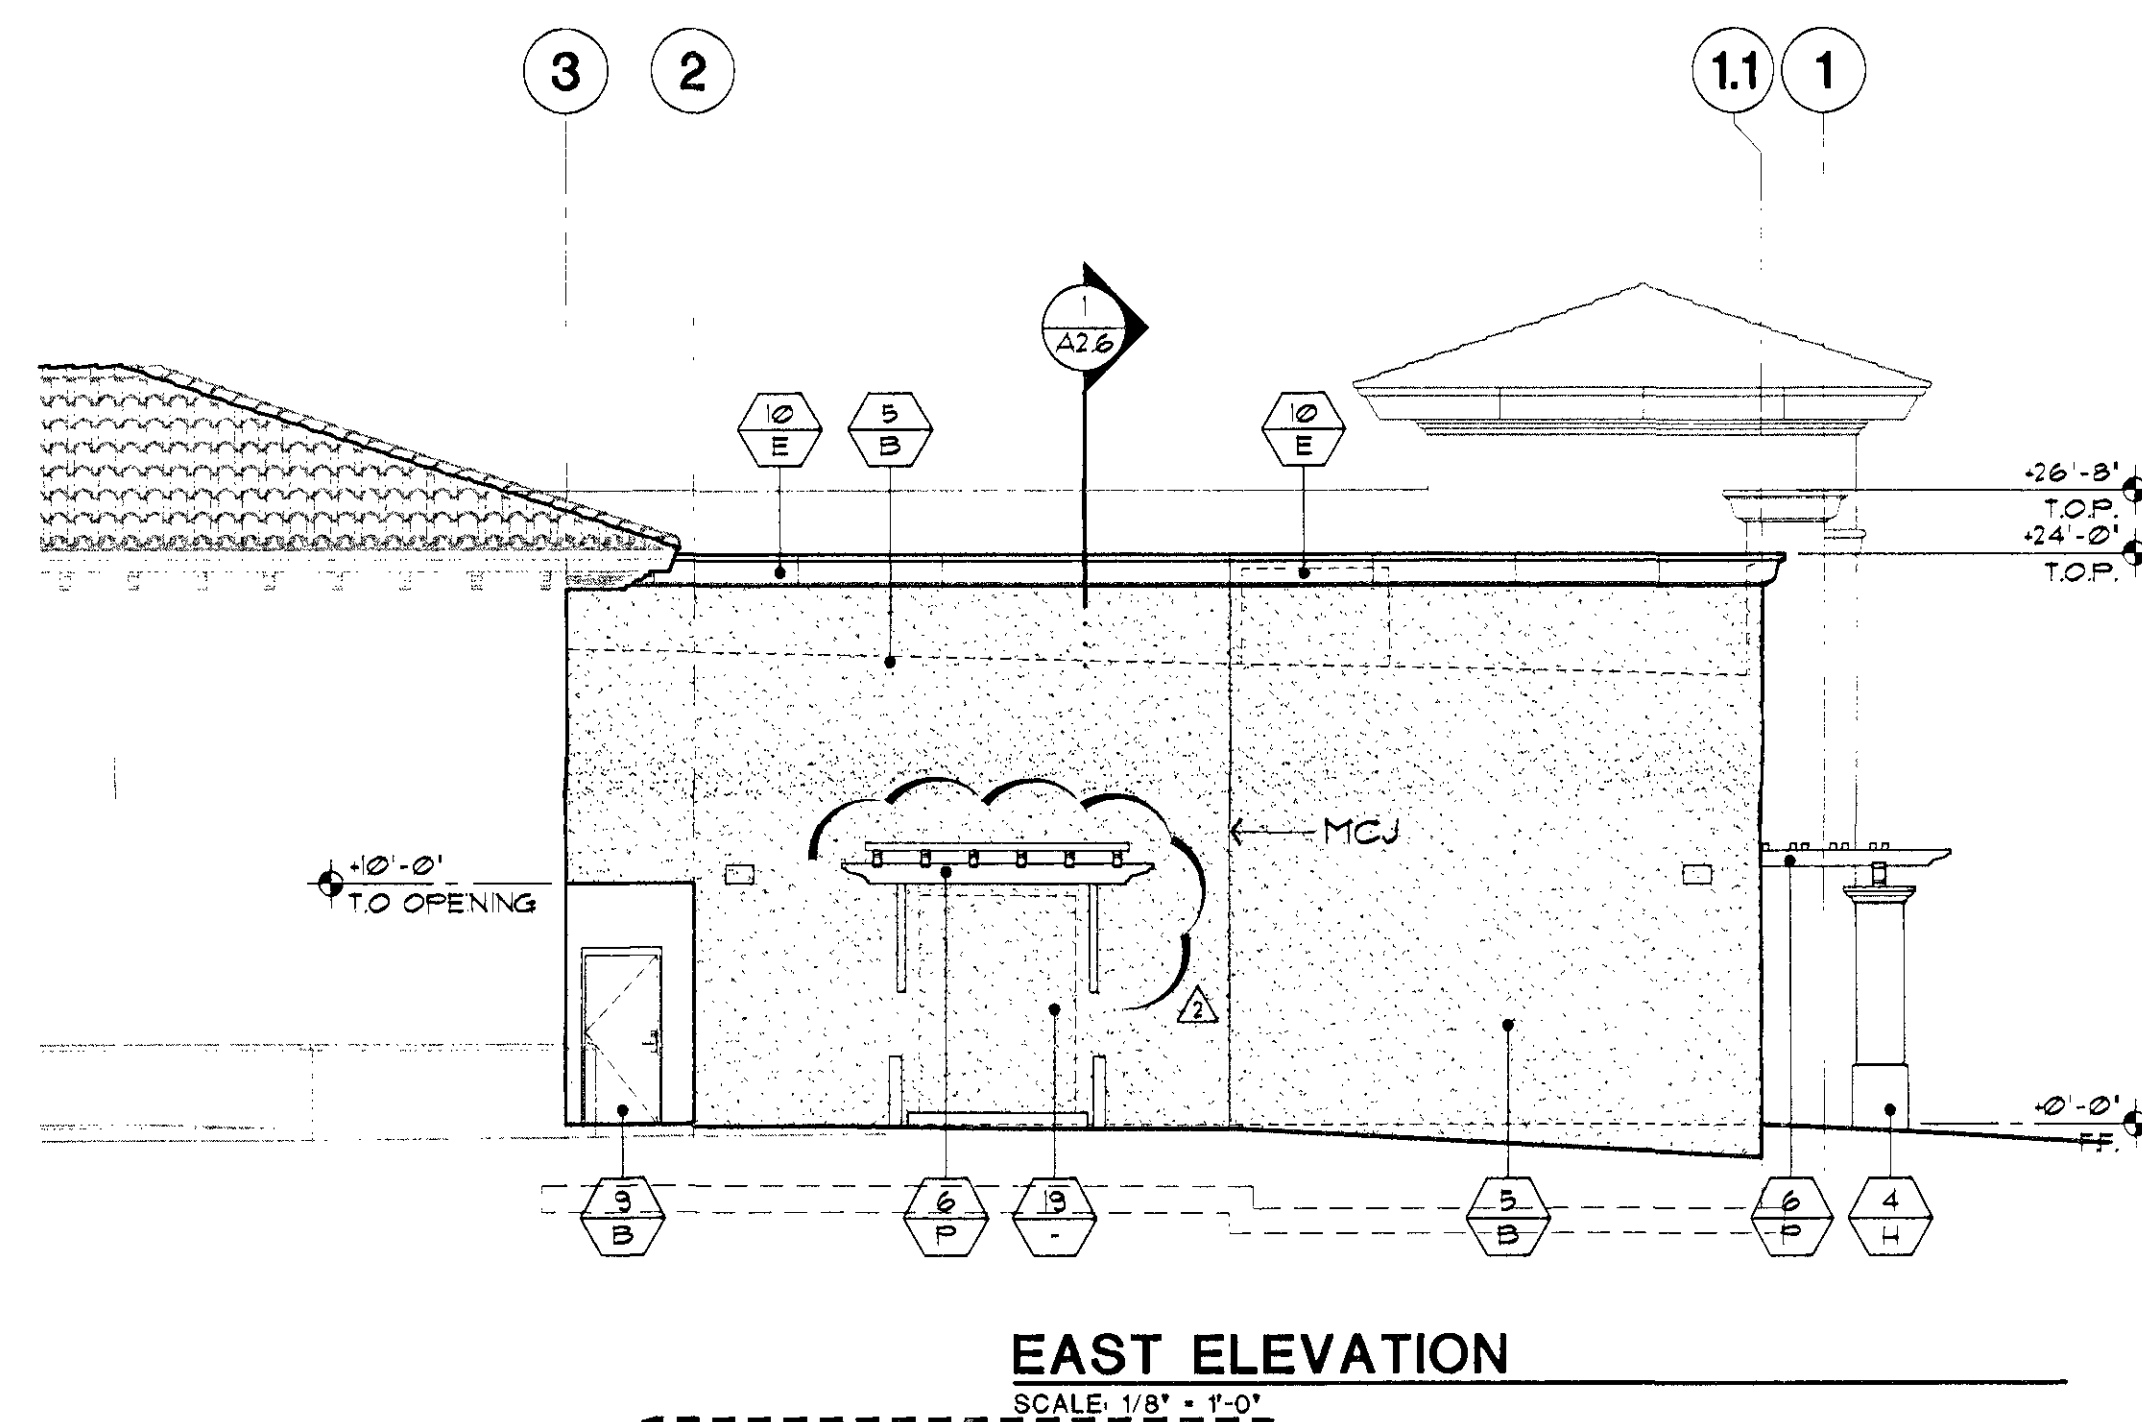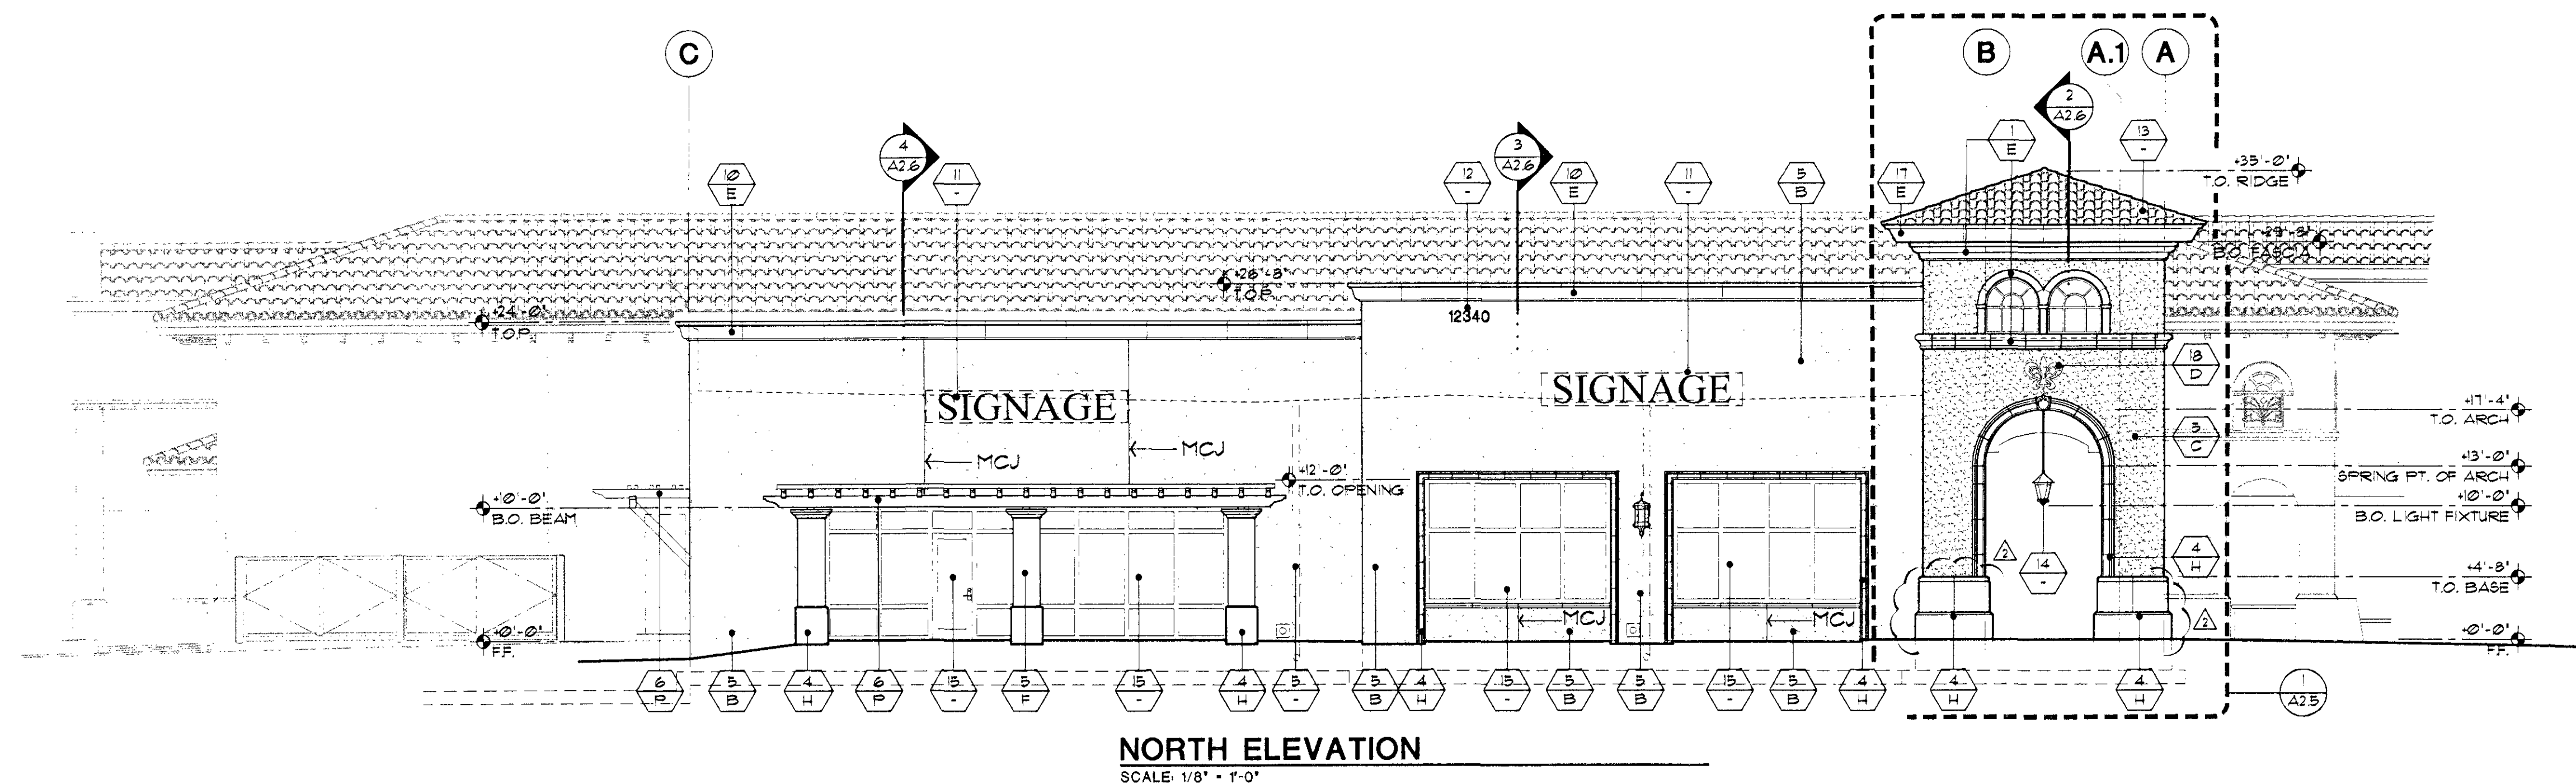


MATERIAL SCHEDULE

1. E.I.F.S. POPOUT
2. FABRIC AWNING W/ SPEAR
3. CAST IN PLACE CONCRETE BASE
4. PRECAST CONCRETE
5. SYNTHETIC STUCCO OVER MASONRY
6. STEEL TRELLIS
7. E.I.F.S. OVER WOOD FRAMING
8. E.I.F.S. CORBEL
9. H.M. DOOR
10. E.I.F.S. CORNICE
11. TENANT SIGNAGE TO MEET DEV. GUIDELINES
(UNDER SEPARATE APPROVAL & PERMIT)
12. BUILDING ADDRESS TO BE PLAINLY
LEGIBLE AND VISIBLE FROM THE STREET.
THEY SHALL CONTRAST WITH THEIR
BACKGROUND AND SHALL BE A MIN. OF
4" HIGH WITH A MIN. STROKE WIDTH OF 3/8".
13. CLAY ROOF TILE - OLD BEDONA' & CAFE
ANTIGUA' BY REDLAND TILE
14. ORNAMENTAL LIGHT FIXTURE
15. ALUMINUM STOREFRONT SYSTEM
16. ALUMINUM FRAME WINDOW
17. BREAK METAL WRAPPED FASCIA
18. CANTER LOGO - T.B.D.
19. S.E.S. - PAINTED TO MATCH BUILDING


COLORS

- A. ICI PAINTS - 229 'ROSEDOWN'
- B. ICI PAINTS - 469 'ENGLISH COTTAGE'
- C. ICI PAINTS - 416 'GOLDEN WHEAT'
- D. ICI PAINTS - 1400 'SPA BLUE'
- E. ICI PAINTS - 480 'SHADOWBOX'
- F. ICI PAINTS - 382 'KENYA CORAL'
- G. 1/4" CLEAR GLAZING
- H. CD1 PRECAST CONCRETE COLOR - 'GRAY'
- J. CD1 PRECAST CONCRETE COLOR - 'GF30'
- K. CD1 PRECAST CONCRETE COLOR - '1030'
- L. SUNBRELLA - 'SAPPHIRE BLUE' WITH 'SKY BLUE' TRIM
- M. SUNBRELLA - 'PLUM'
- N. SUNBRELLA - 'TERRA COTTA' WITH 'TAUPE' TRIM
- P. DUNN EDWARDS - DE 391 'SDEWINDER'

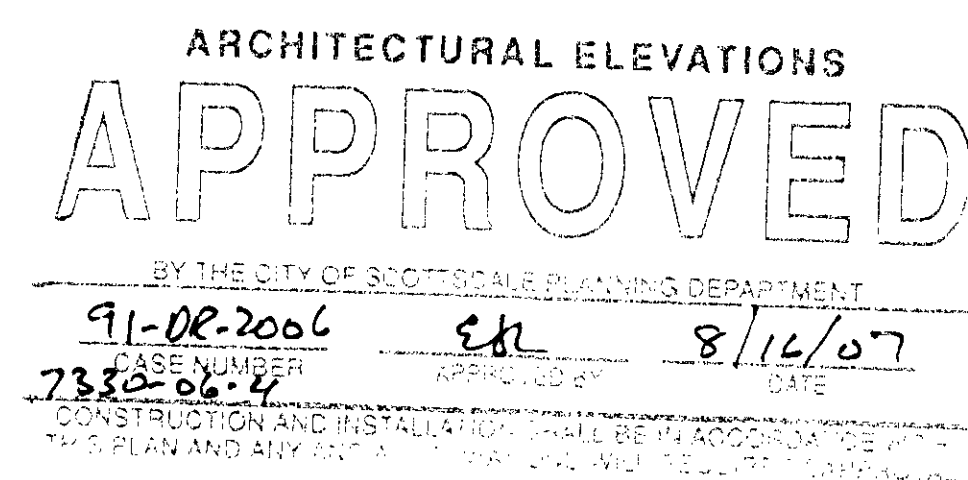


Butler Design Group Inc.
Architects & Planners
5555 East Van Buren St.
Suite 215
Phoenix, Arizona 85008

phone 602-957-1800
fax 602-957-7722

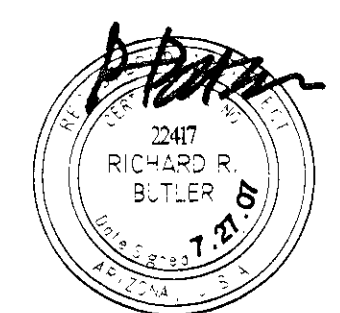

OWNERSHIP OF INSTRUMENTS OF SERVICE
All reports, plans, specifications, computer files, field data, notes and other documents and instruments prepared by the design professional, as instruments of service shall remain the property of the design professional. The design professional shall retain all control in relation and other reserved rights, including the copyright therein.



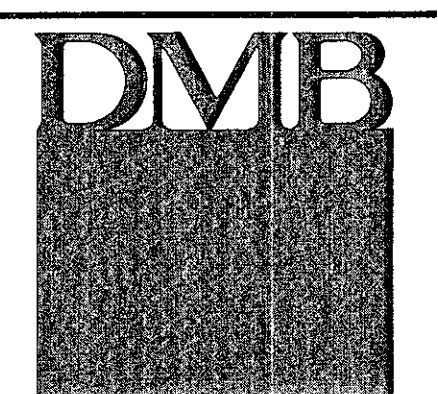


Ranch Crossing
18201-18291 N. PIMA ROAD
SCOTTSDALE, AZ
91-DR-2006 246-SA-2007 42-SA-2007

Revisions:
A CITY COMMENTS 07/18/07

Title: SHOPS C ELEVATIONS
Date: 5/7/2007
Project number: 04116
Drawn by: RAH
Checked by: PH
CAD file: 04116-A2.4
☐ Design Development
☐ Progress Const. Docs.
☒ City Submittal
☐ Bid Package
☐ Construction Issue
☐ Record Drawings
Sheet Number:

A2.4

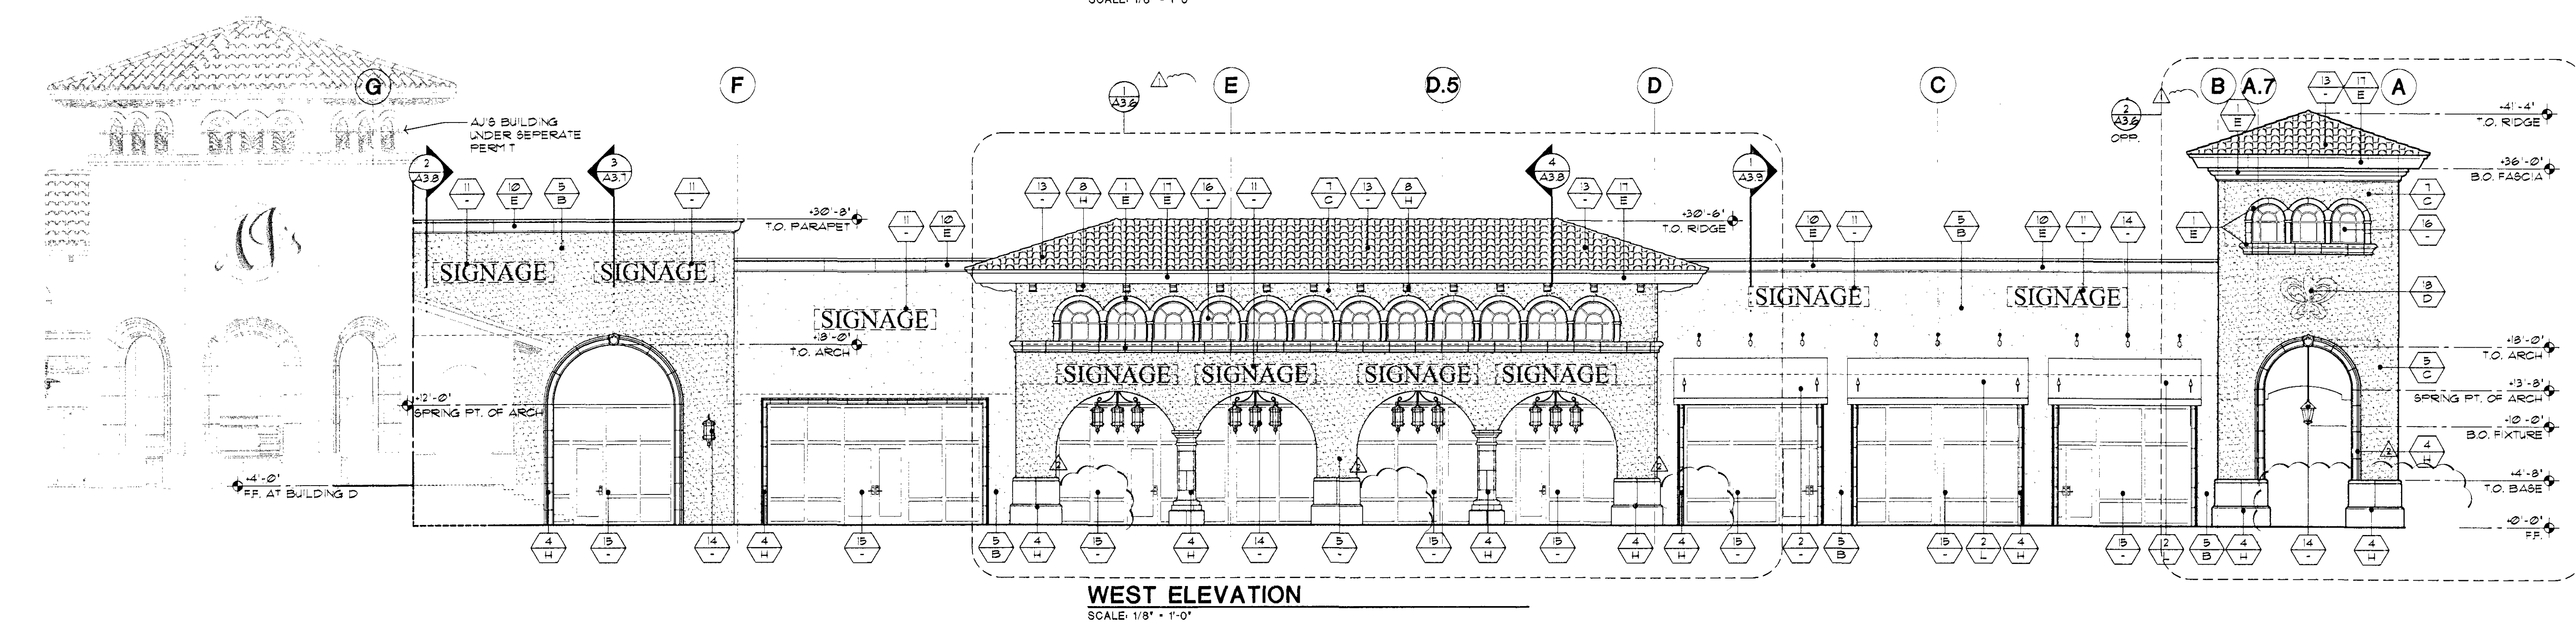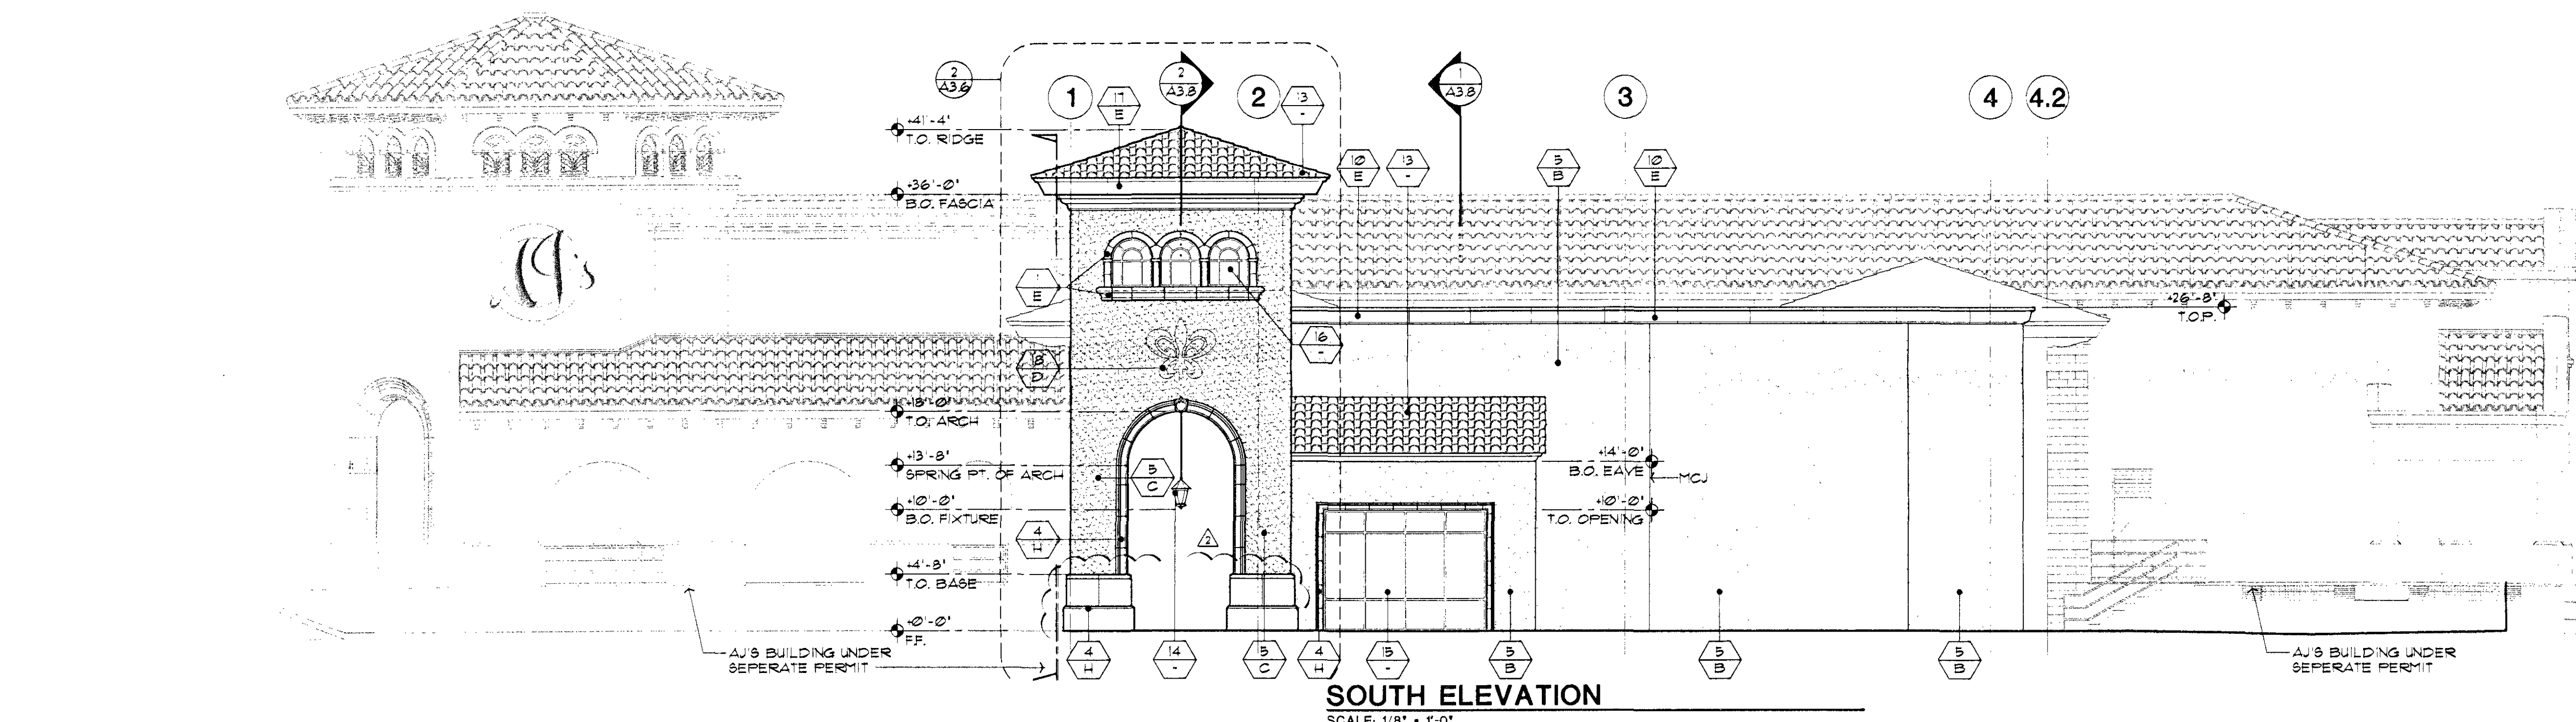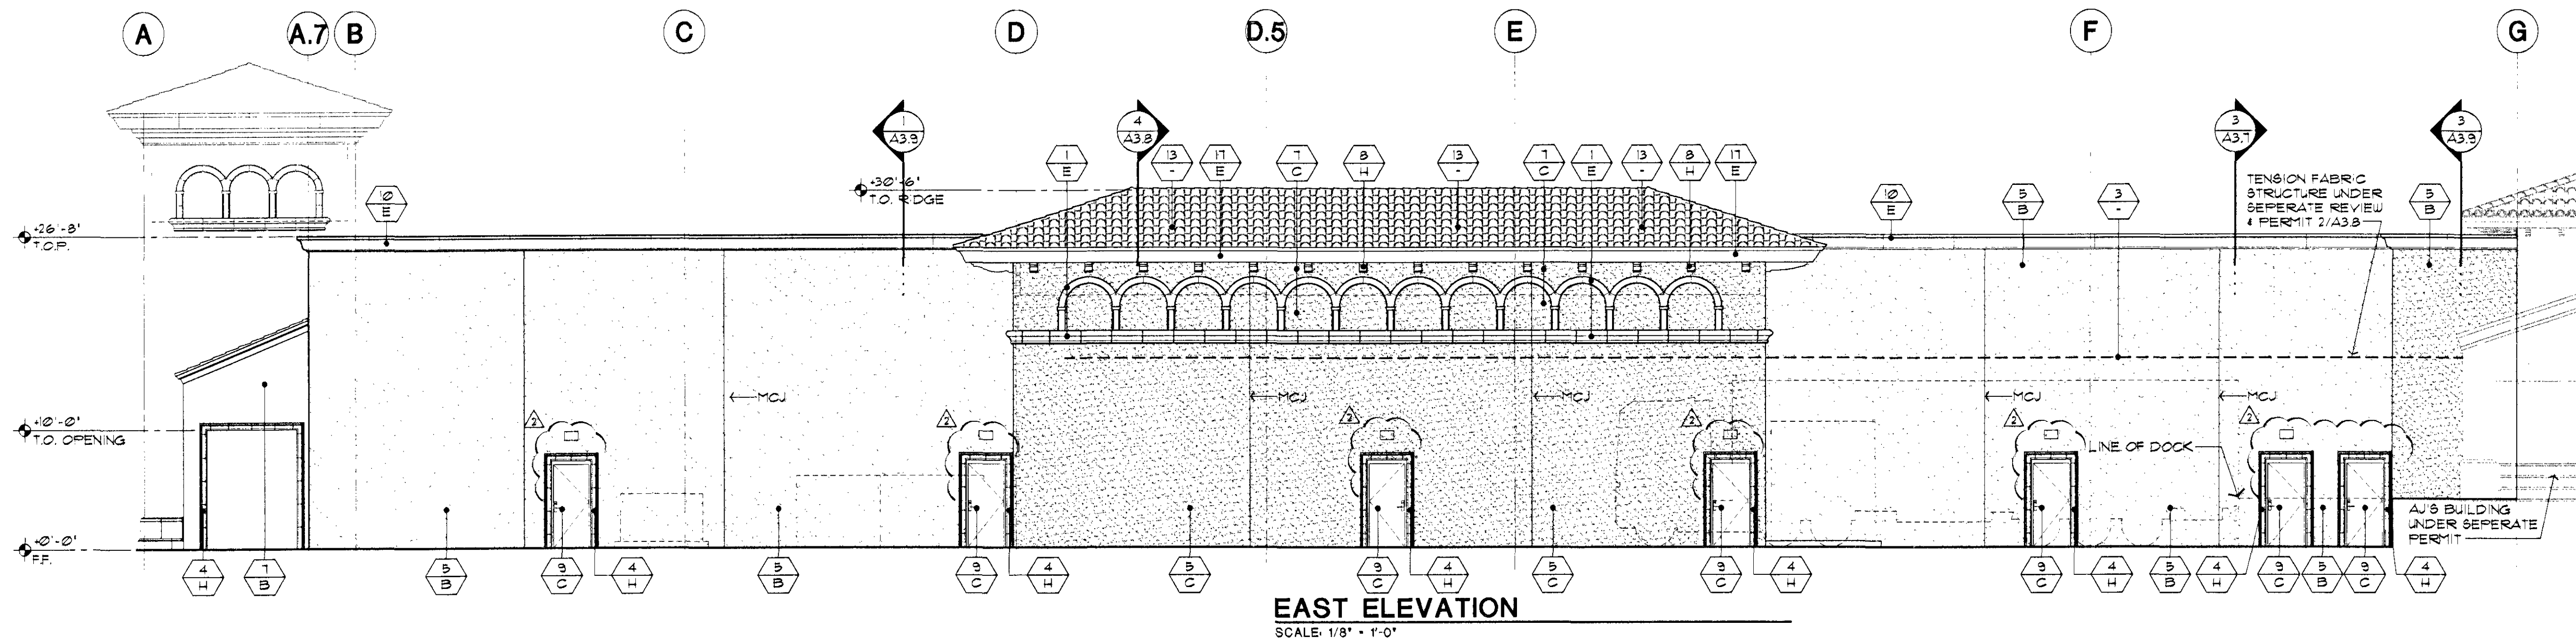

MATERIALS	
1.	EIFS, POPOUT
2.	FABRIC AWNING W/ SPEAR
3.	CAST IN PLACE CONCRETE BASE
4.	PRECAST CONCRETE
5.	SYNTHETIC STUCCO OVER MASONRY
6.	STEEL TRELLIS
7.	EIFS OVER WOOD FRAMING
8.	EIFS CORBEL
9.	H.M. DOOR
10.	EIFS CORNICE
11.	TENANT SIGNAGE TO MEET DEV. GUIDELINES (UNDER SEPARATE APPROVAL & PERMIT)
12.	BUILDING ADDRESS TO BE PLAINLY LEGIBLE AND VISIBLE FROM THE STREET. THEY SHALL CONTRAST WITH THEIR BACKGROUND AND SHALL BE A MIN. OF 4" HIGH WITH A MIN. STROKE WIDTH OF 0.3".
13.	CLAY ROOF TILE - OLD SEDONA & CAPE ANTEQUA BY REDLAND TILE
14.	ORNAMENTAL LIGHT FIXTURE
15.	ALUMINUM STOREFRONT SYSTEM
16.	ALUMINUM FRAME WINDOW
17.	BREAK METAL WRAPPED FASCIA
18.	CENTER LOGO - T.B.D.
19.	SE.S. - PAINTED TO MATCH BUILDING

COLORS	
A.	ICI PAINTS - 223 ROSEDOWN
B.	ICI PAINTS - 463 ENGLISH COTTAGE
C.	ICI PAINTS - 476 'GOLDEN WHEAT'
D.	ICI PAINTS - 1400 'SPA BLUE'
E.	ICI PAINTS - 480 SHADOWBOX
F.	ICI PAINTS - 382 KENYA CORREL
G.	1/4" CLEAR GLAZING
H.	CDI PRECAST CONCRETE COLOR - 'GRAY'
J.	CDI PRECAST CONCRETE COLOR - 'GP30'
K.	CDI PRECAST CONCRETE COLOR - 'W030'
L.	SUNBRELLA - 'SAPPHIRE BLUE' WITH 'SKY' BLUE TRIM
M.	SUNBRELLA - 'PLUM'
N.	SUNBRELLA - 'TERRA COTTA' WITH 'TAUPE' TRIM
P.	DANN EDWARDS - DE 3191 SIDEWINDER

ARCHITECTURAL ELEVATIONS
APPROVED
 BY THE CITY OF SCOTTSDALE PLANNING DEPARTMENT
 91-DR-2006 SAL 8/14/07
 7330-06-04
 CONSTRUCTION AND INSTALLATION OF THE PROJECT
 THIS PLAN AND ANY

Butler Design Group Inc.
 Architects & Planners
 5555 East Van Buren St.
 Suite 215
 Phoenix, Arizona 85008
 phone 602-957-1800
 fax 602-957-7722

Richard P. Supler & Associates
 2417
 1001 N. 1st St.
 Phoenix, AZ 85004

DMB


Ranch Crossing
 18201-18291 N. PIMA ROAD
 SCOTTSDALE, AZ
 91-DR-2006 246-SA-2007 42-SA-2007

Revisions:
 1. COORDINATION 07-18-07


Title: SHOPS E ELEVATIONS
 Date: 5/7/2007
 Project number: 04118
 Drawn by: RAH
 Checked by: PH
 CAD file: 04118-A3.5

☐ Design Development
☐ Progress Const. Docs.
☒ City Submittal
☐ Bid Package
☐ Construction Issue
☐ Record Drawings


Sheet Number:
A3.5

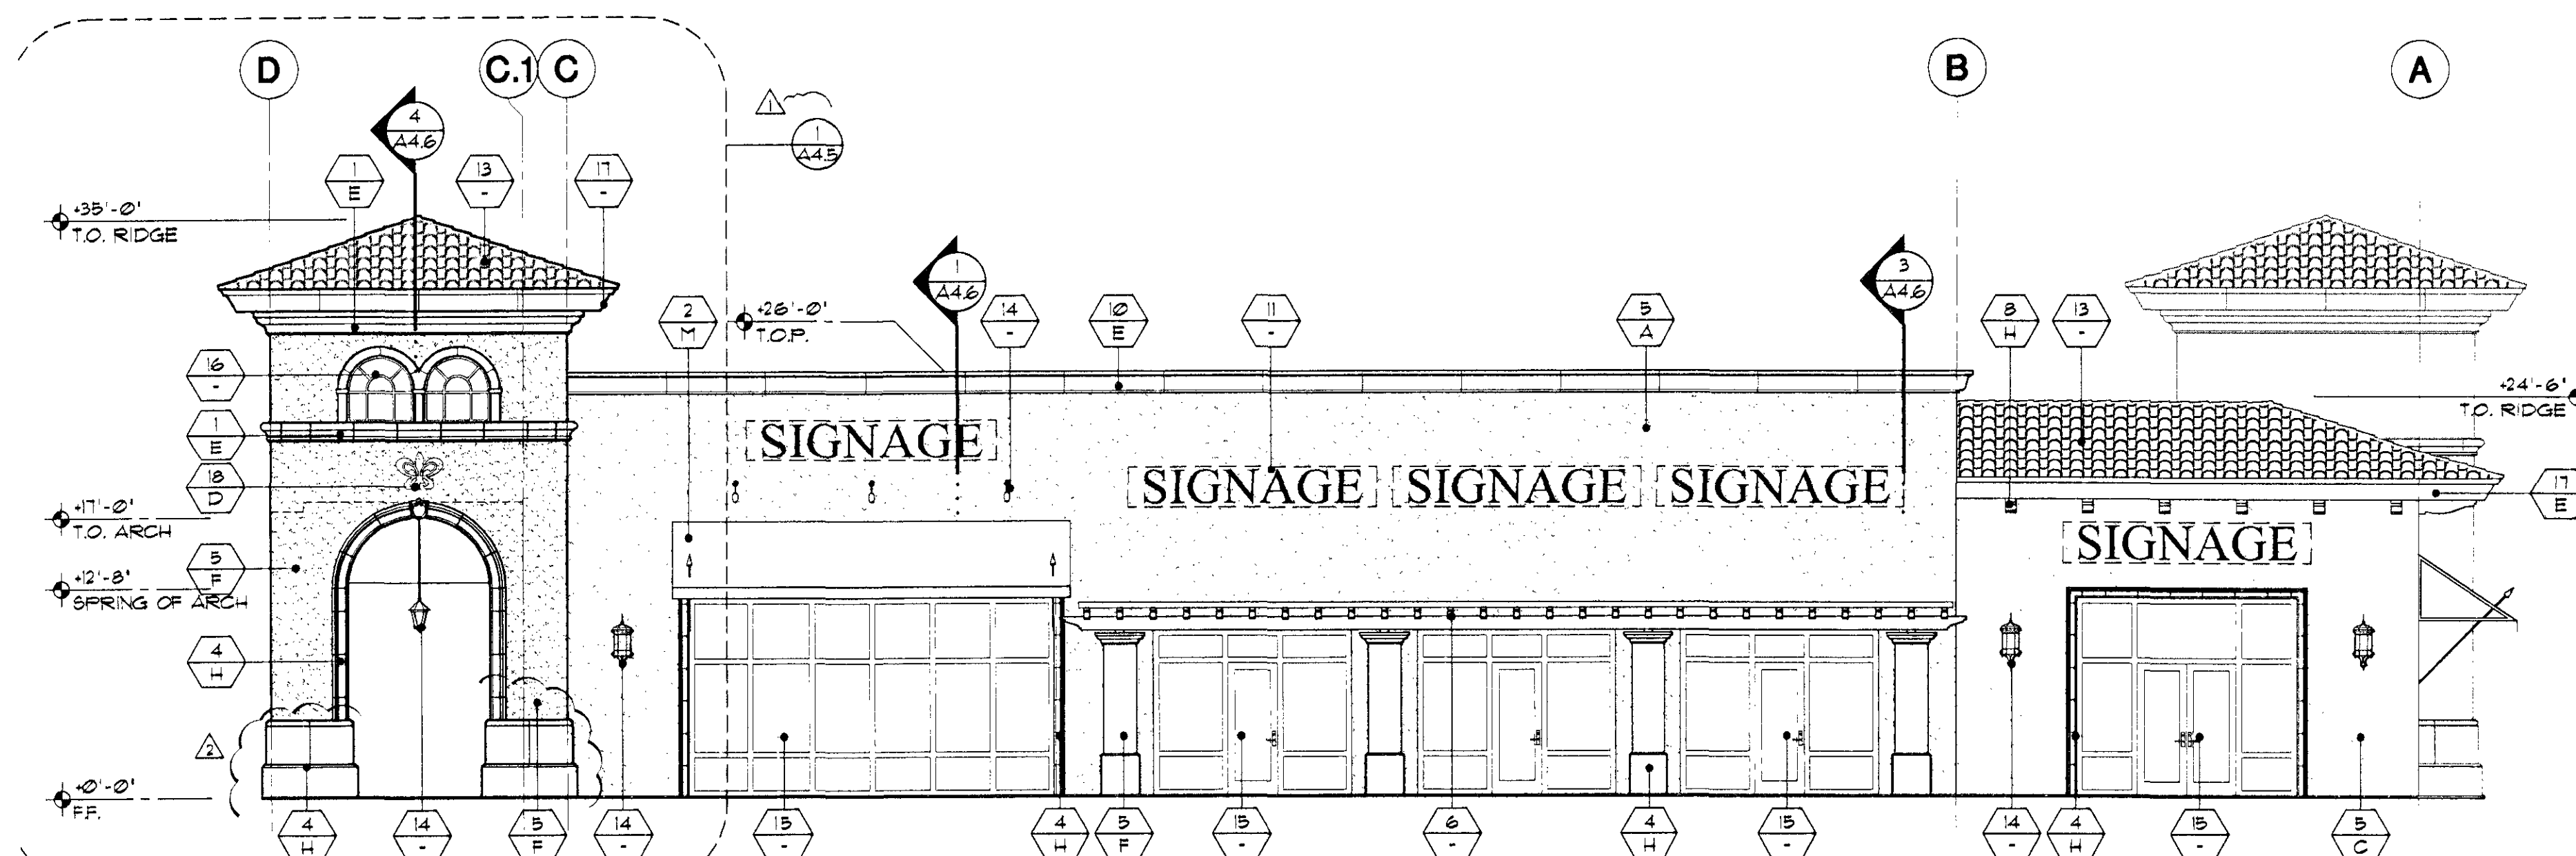


NORTH ELEVATION
SCALE: 1/8" = 1'-0"

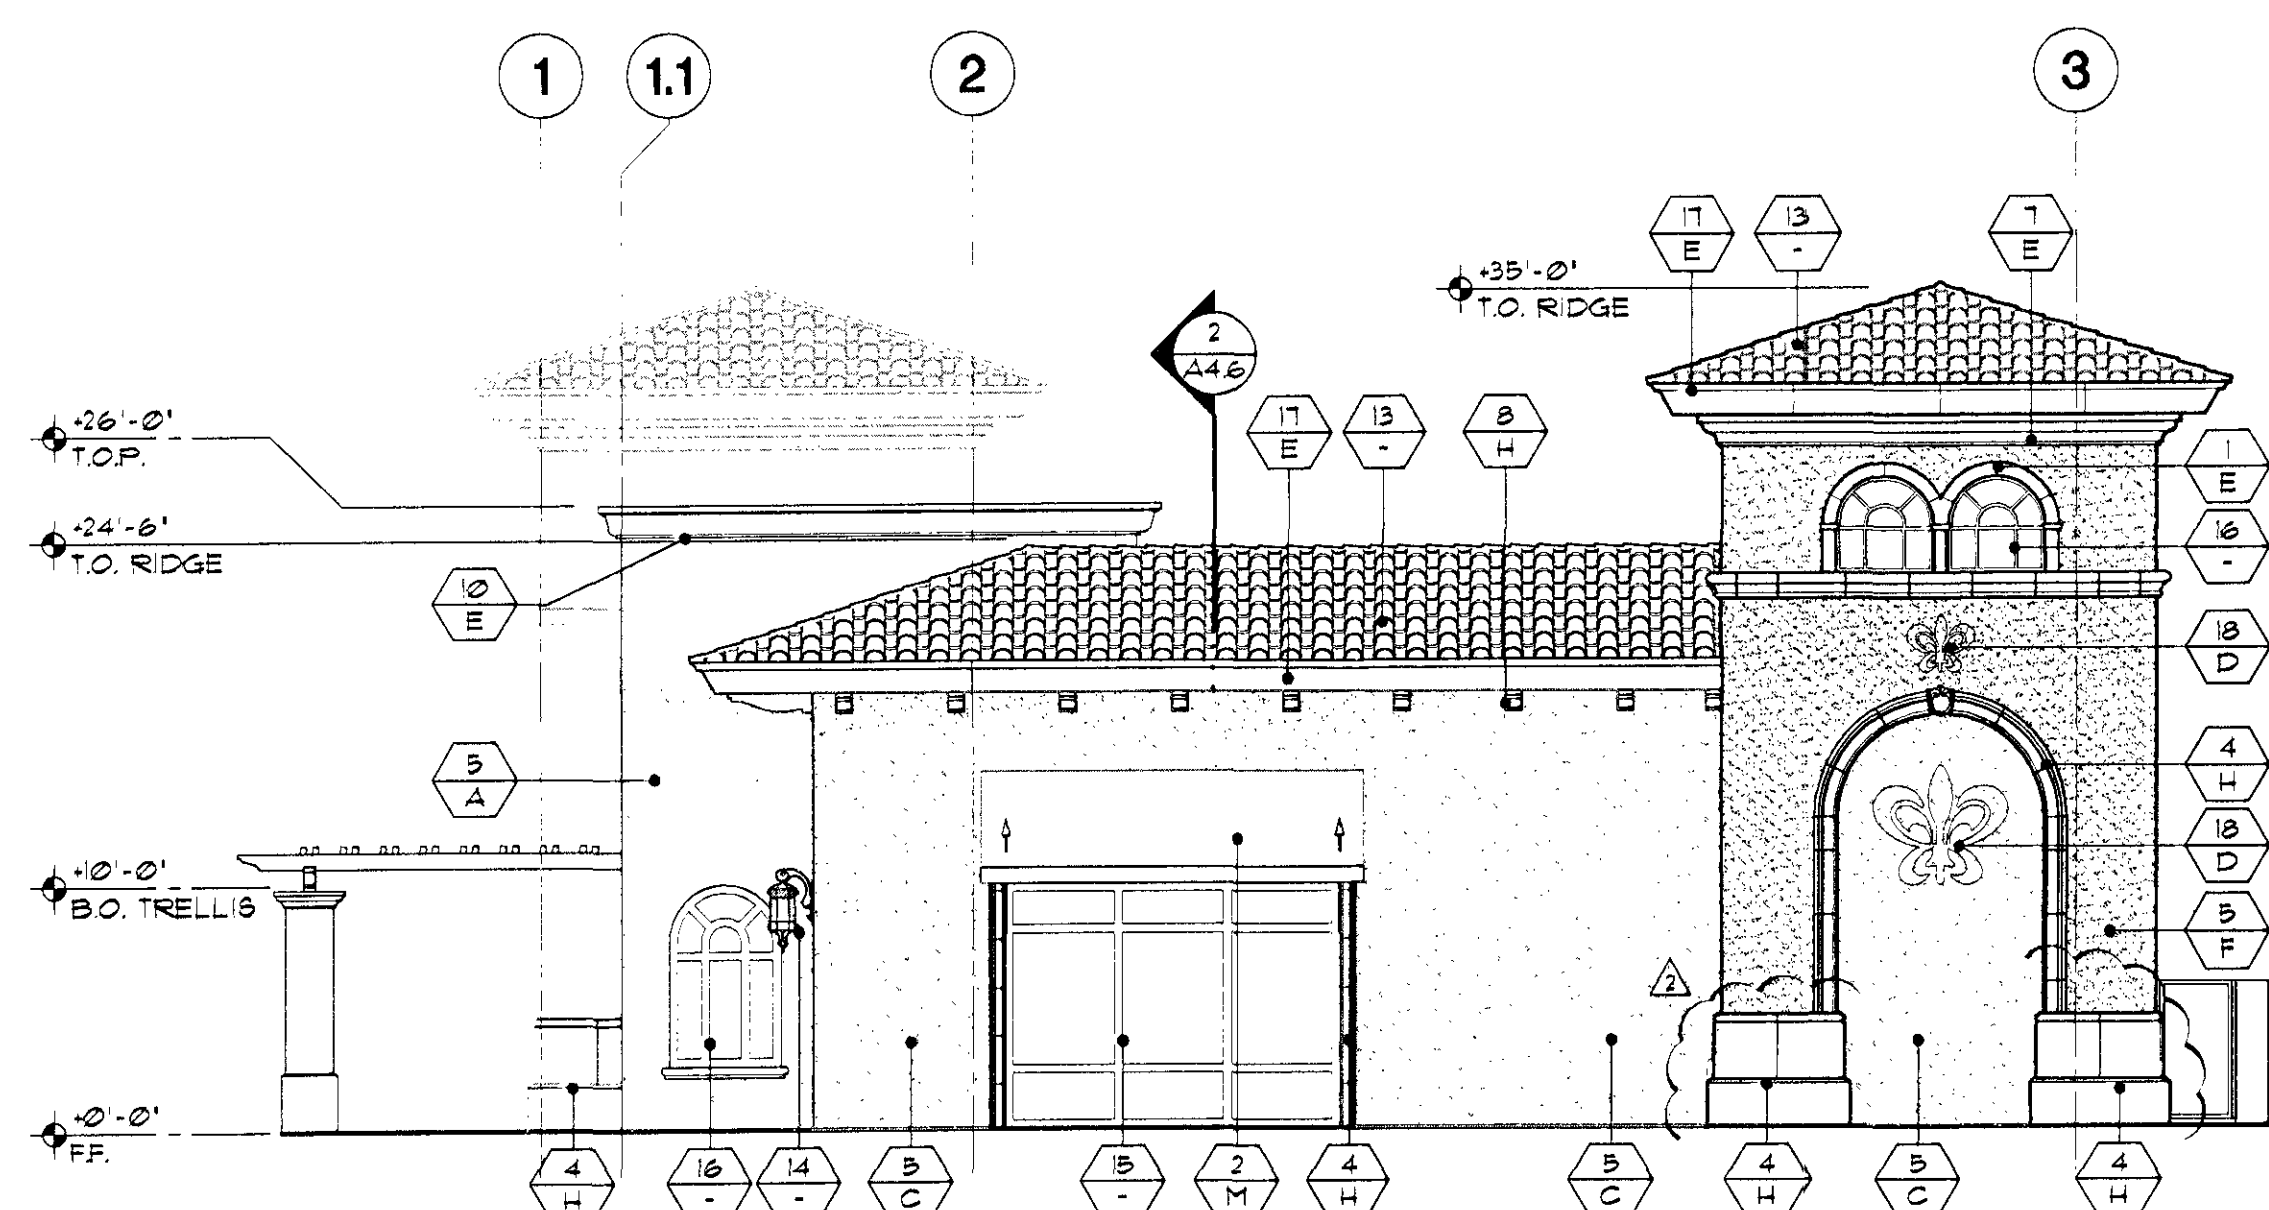

WEST ELEVATION
SCALE: 1/8" = 1'-0"

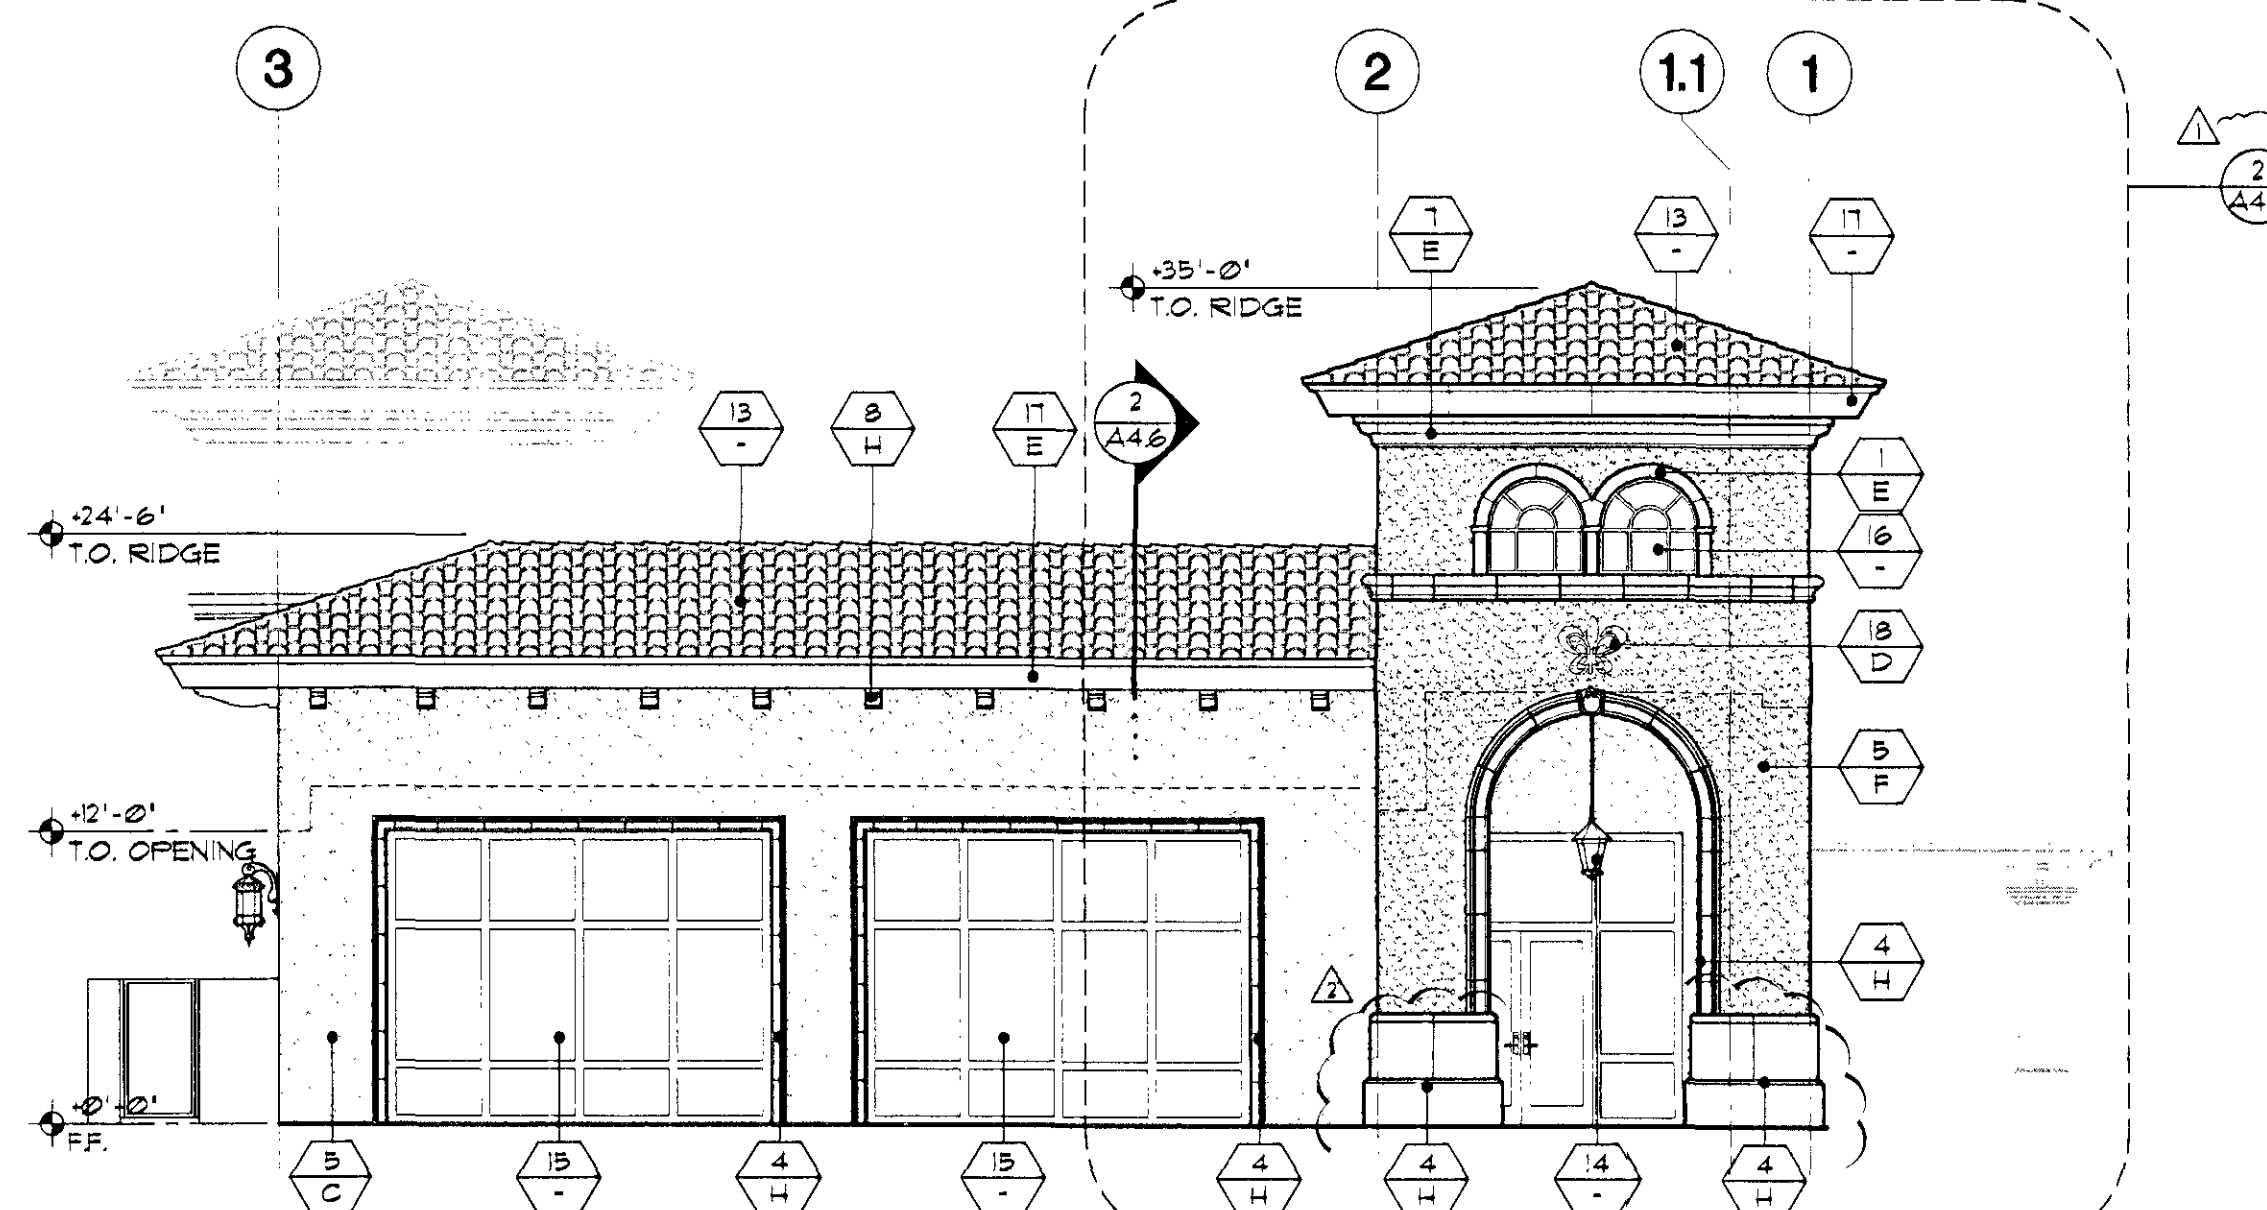

EAST ELEVATION
SCALE: 1/8" = 1'-0"

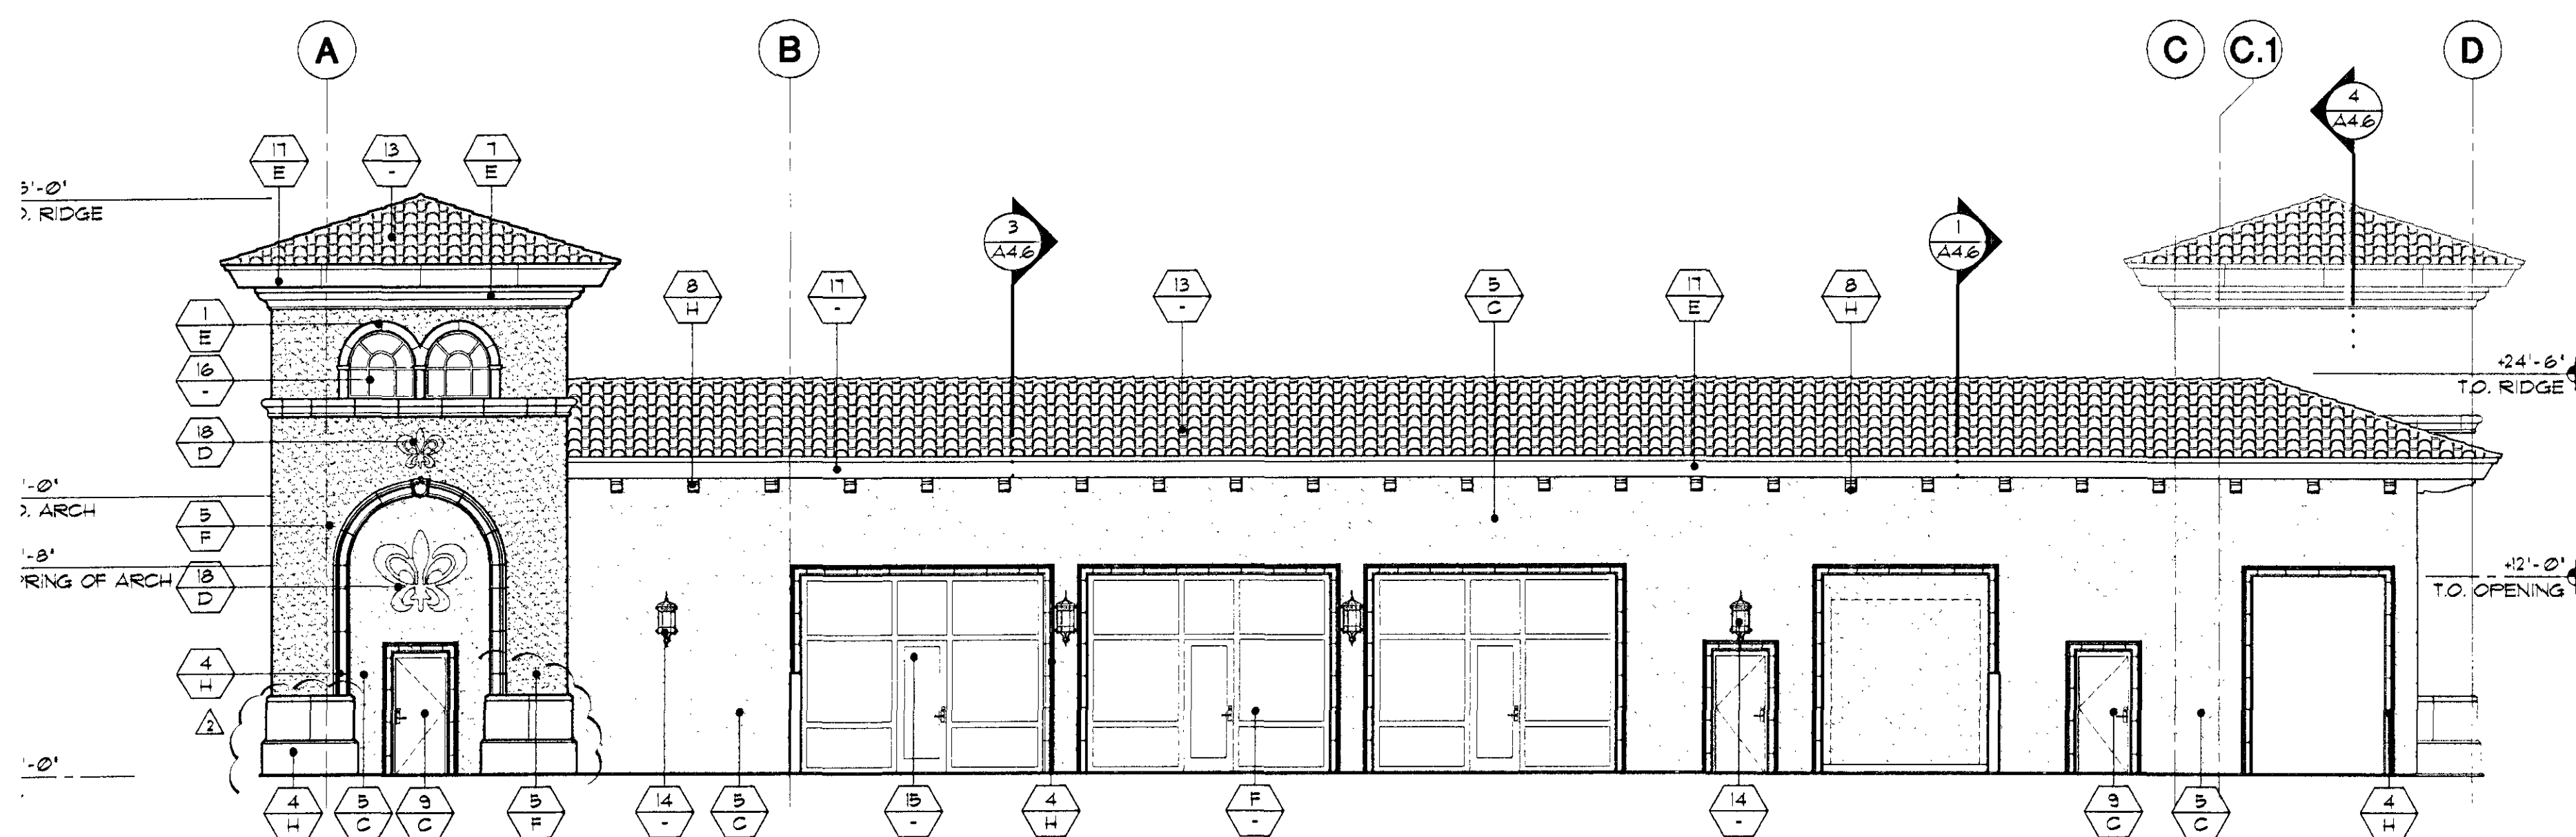

SOUTH ELEVATION
SCALE: 1/8" = 1'-0"


MATERIALS	
1.	EIFS. POPOUT
2.	FABRIC AWNING W/ SPEAR
3.	CAST IN PLACE CONCRETE BASE
4.	PRECAST CONCRETE
5.	SYNTHETIC STUCCO OVER MASONRY
6.	STEEL TRELLIS
7.	EIFS. OVER WOOD FRAMING
8.	EIFS. CORBEL
9.	H.M. DOOR
10.	EIFS CORNICE
11.	TENANT SIGNAGE TO MEET DEV. GUIDELINES (UNDER SEPARATE APPROVAL & PERMIT)
12.	BUILDING ADDRESS TO BE PLAINLY LEGIBLE AND VISIBLE FROM THE STREET. THEY SHALL CONTRAST WITH THE BACKGROUND AND SHALL BE A MIN. OF 4" HIGH WITH A MIN. STROKE WIDTH OF 0.5".
13.	CLAY ROOF TILE - OLD SEDONA 4 CAFE ANTQUA BY REDLAND TILE
14.	ORNAMENTAL LIGHT FIXTURE
15.	ALUMINUM STOREFRONT SYSTEM
16.	ALUMINUM FRAME WINDOW
17.	BREAK METAL WRAPPED FASCIA
18.	CENTER LOGO - T.B.D.
19.	SES. - PAINTED TO MATCH BUILDING

COLORS	
A.	CI PAINTS - 229 ROSEDOWN
B.	CI PAINTS - 469 ENGL SH COTTAGE
C.	CI PAINTS - 476 GOLDEN WHEAT
D.	CI PAINTS - 1400 SPA BLUE
E.	CI PAINTS - 480 SHADOWBOX
F.	CI PAINTS - 382 KENYA CORREL
G.	1/4" CLEAR GLAZING
H.	CDI PRECAST CONCRETE COLOR - 'GRAY'
J.	CDI PRECAST CONCRETE COLOR - 'GF30'
K.	CDI PRECAST CONCRETE COLOR - 'LO30'
L.	SUNBRELLA - 'SAPPHIRE BLUE' WITH 'SKY BLUE' TRIM
M.	SUNBRELLA - 'PLUM'
N.	SUNBRELLA - 'TERRA COTTA' WITH 'TAUPE' TRIM
P.	DUNN EDWARDS - DE 391 SIDEUNDER


ARCHITECTURAL ELEVATIONS
APPROVED
BY THE CITY OF SCOTTSDALE PLANNING DEPARTMENT
91-DR-2006 8/16/07
7330-06-4
CONSTRUCTION AND INSTALLATION SHALL BE IN ACCORD WITH THE CITY OF SCOTTSDALE PLANNING DEPARTMENT
THIS PLAN AND ANY INFORMATION IS FOR THE CITY OF SCOTTSDALE PLANNING DEPARTMENT



Butler Design Group Inc.
Architects & Planners
5555 East Van Buren St.
Suite 215
Phoenix, Arizona 85008
phone 602-957-1800
fax 602-957-7722

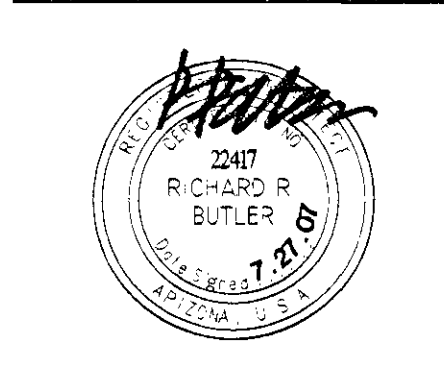

OWNERSHIP OF INSTRUMENTS OF SERVICE
All reports, plans, specifications, computer files, data, notes and other documents and materials prepared by the design professional for the owner of a project shall remain the property of the design professional. The design professional shall retain all copyright and other intellectual rights, including the copyright, in any work product created by the design professional.

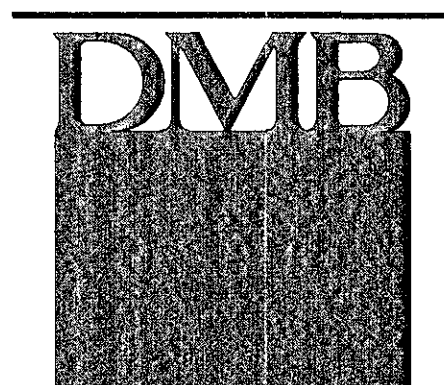


Ranch Crossing
18201-18291 N. PIMA ROAD
SCOTTSDALE, AZ
91-DR-2006 246-SA-2007 42-SA-2007


Revisions:	
COORDINATION 07-18-07	
CITY COMMENTS 07-18-07	
Title:	SHOPS F ELEVATIONS
Date:	5/7/2007
Project number:	04116
Drawn by:	RAH
Checked by:	PH
CAD file:	04116-A4.4
☐ Design Development	
☐ Progress Const. Docs.	
☒ City Submittal	
☐ Bid Package	
☐ Construction Issue	
☐ Record Drawings	
Sheet Number:	

A4.4


7330-06-04 15-PP-2006 91-DR-2006 246-SA-2007 42-SA-2007

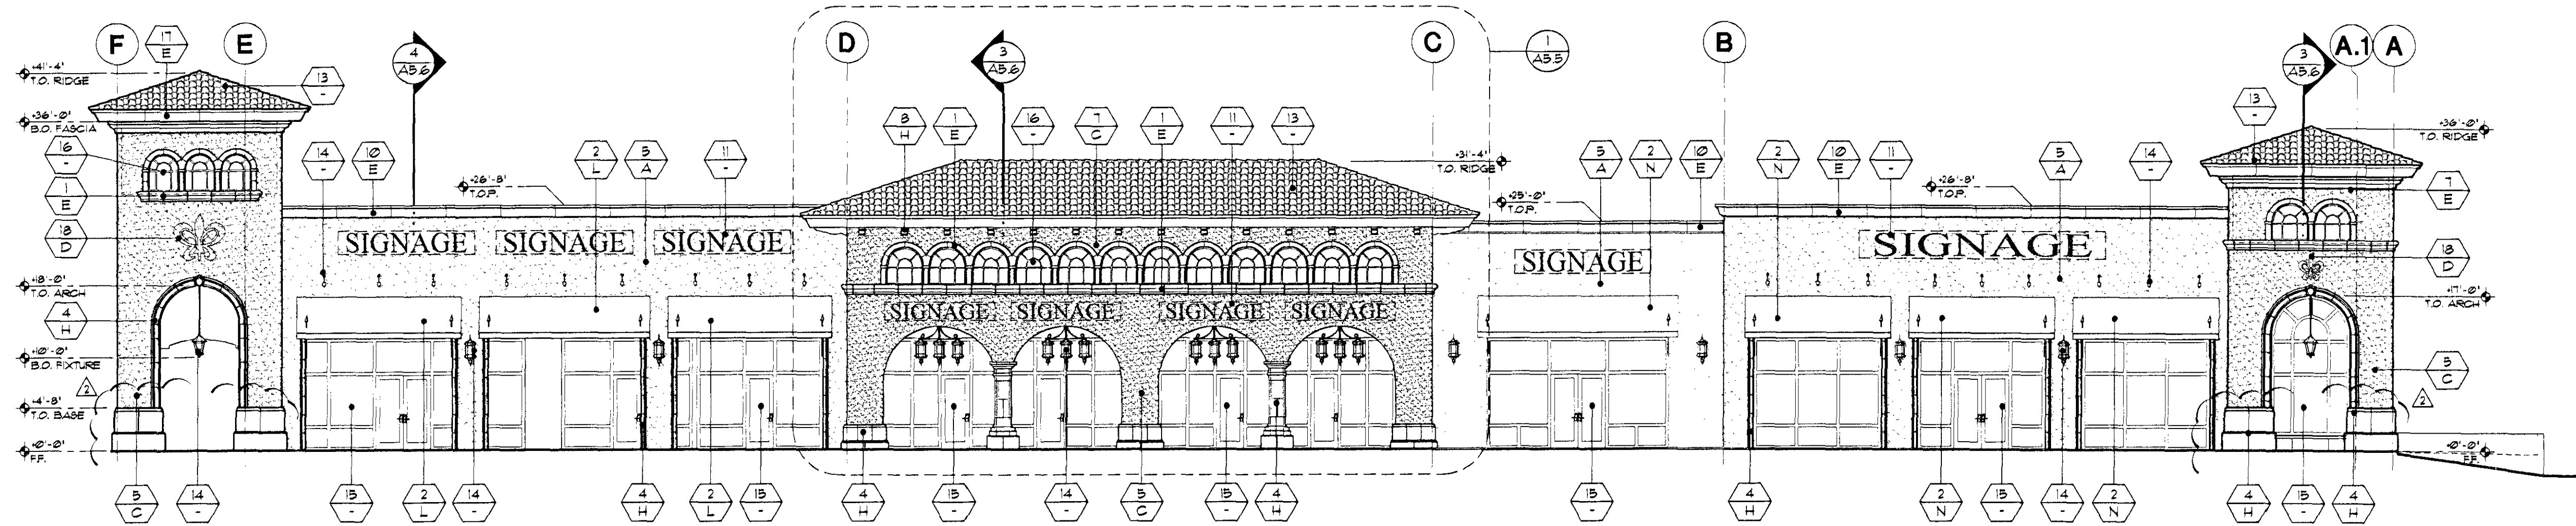


WEST ELEVATION
SCALE: 3/32" = 1'-0"

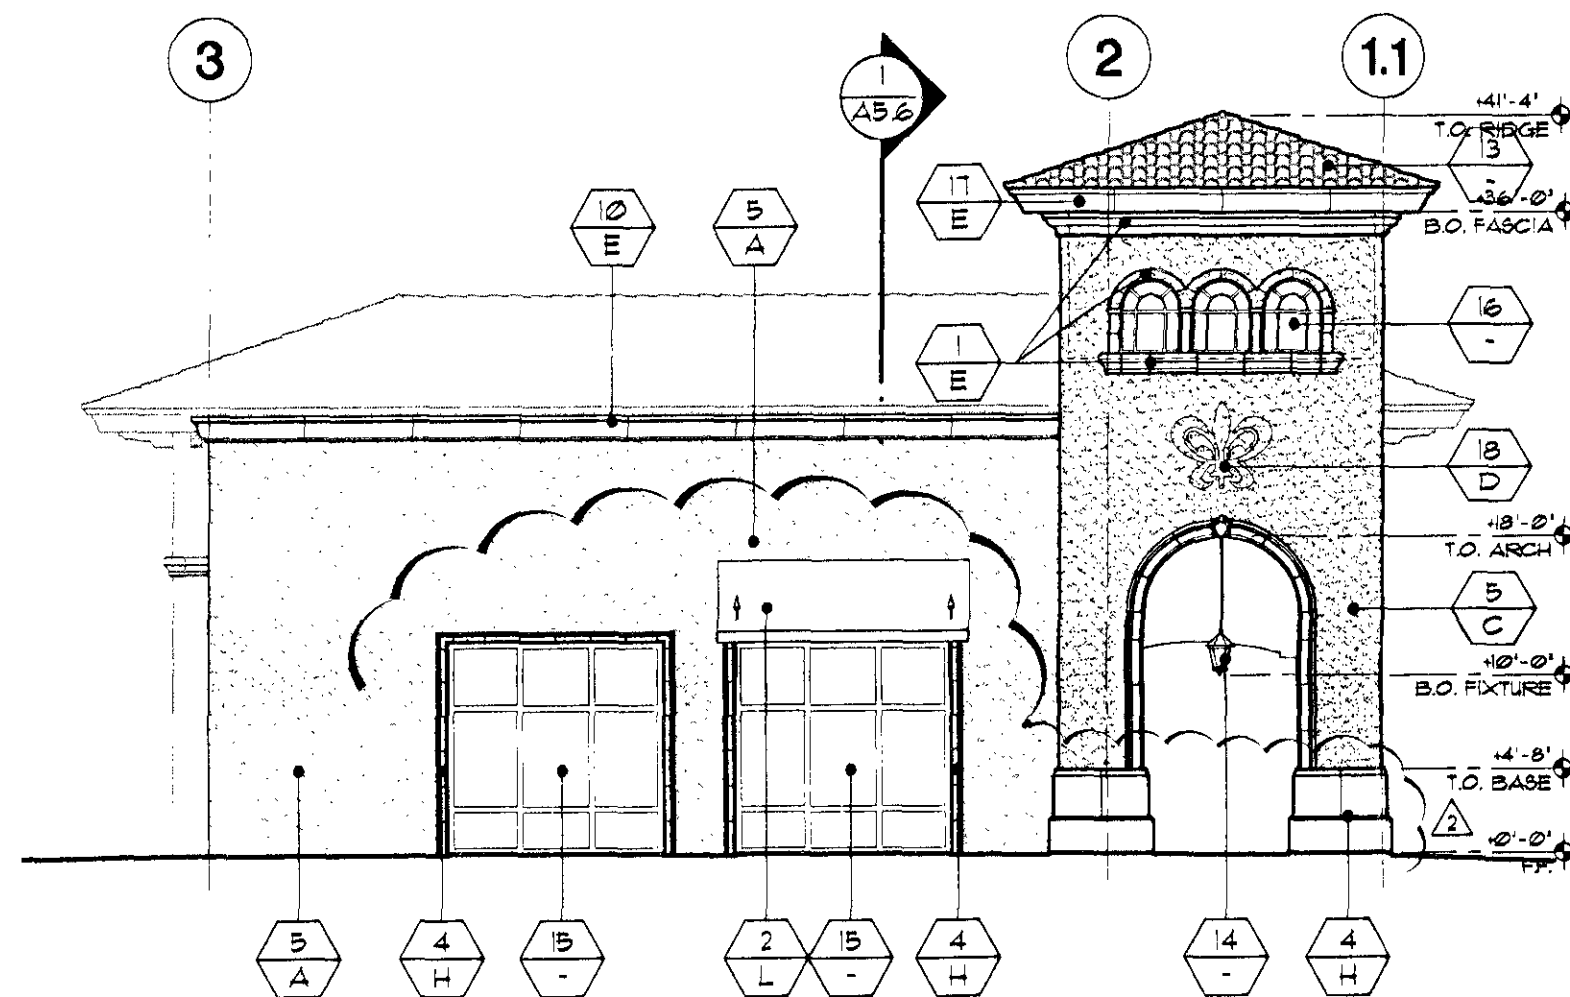

NORTH ELEVATION
SCALE: 3/32" = 1'-0"

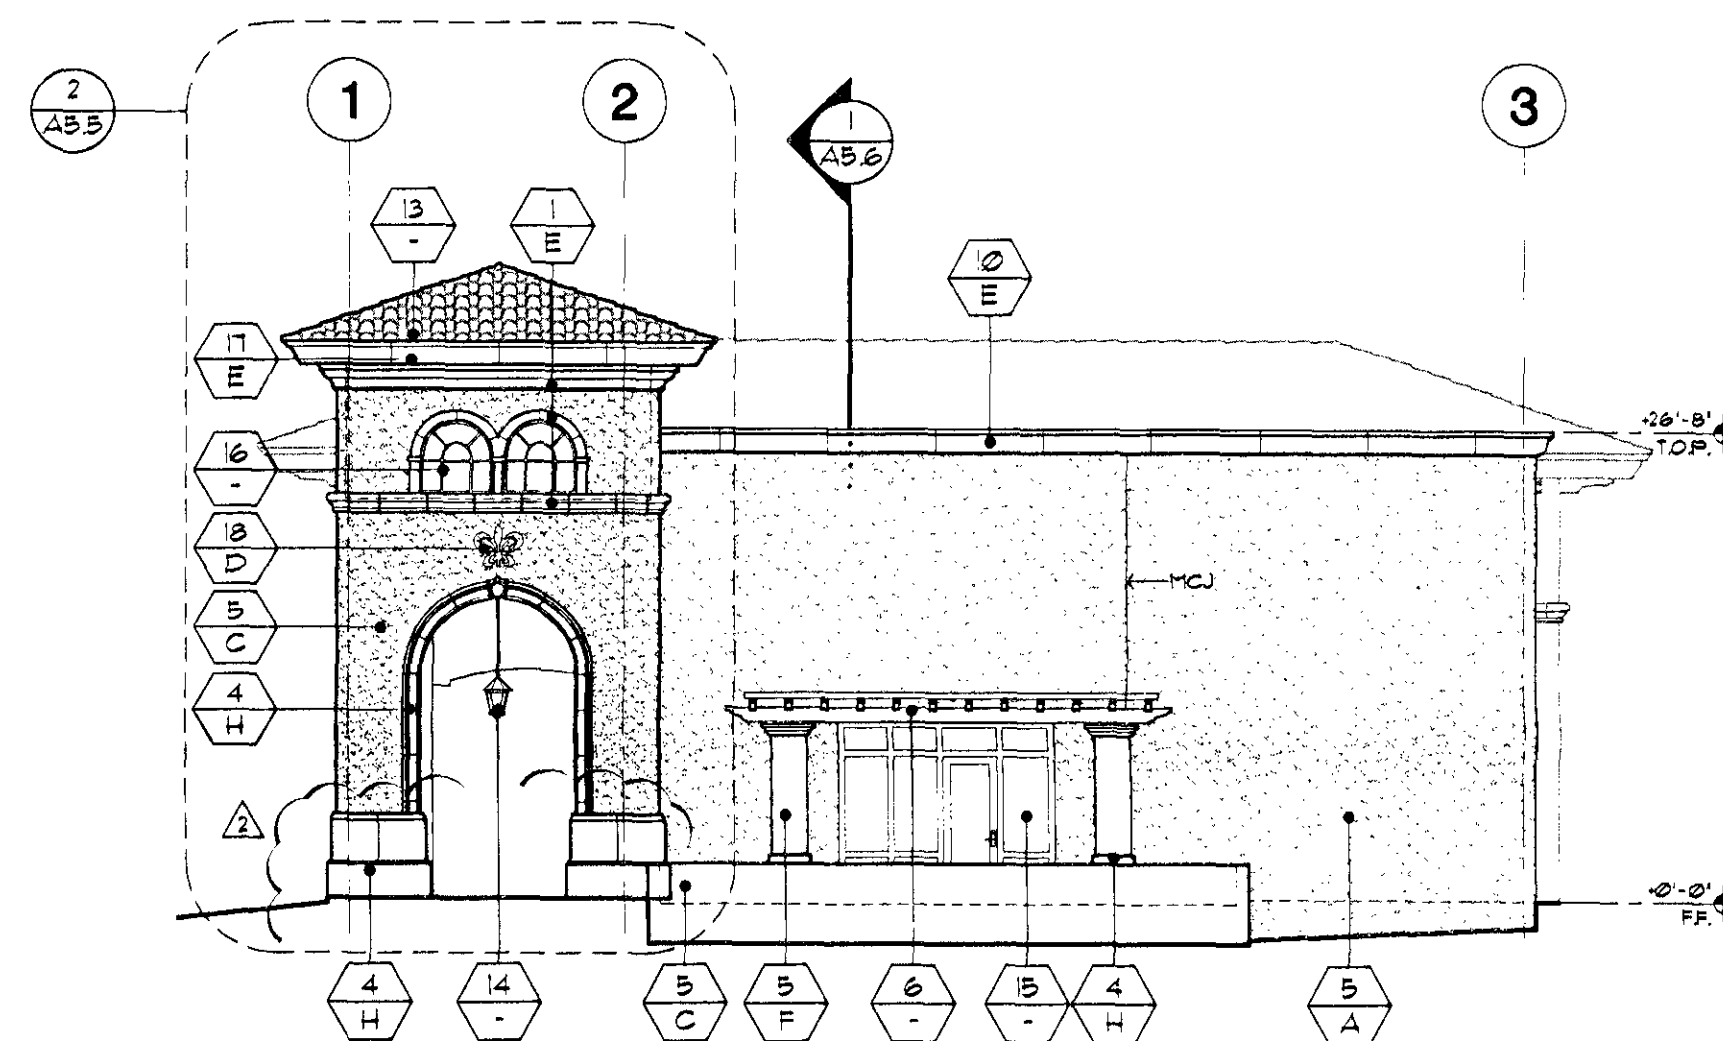

SOUTH ELEVATION
SCALE: 3/32" = 1'-0"

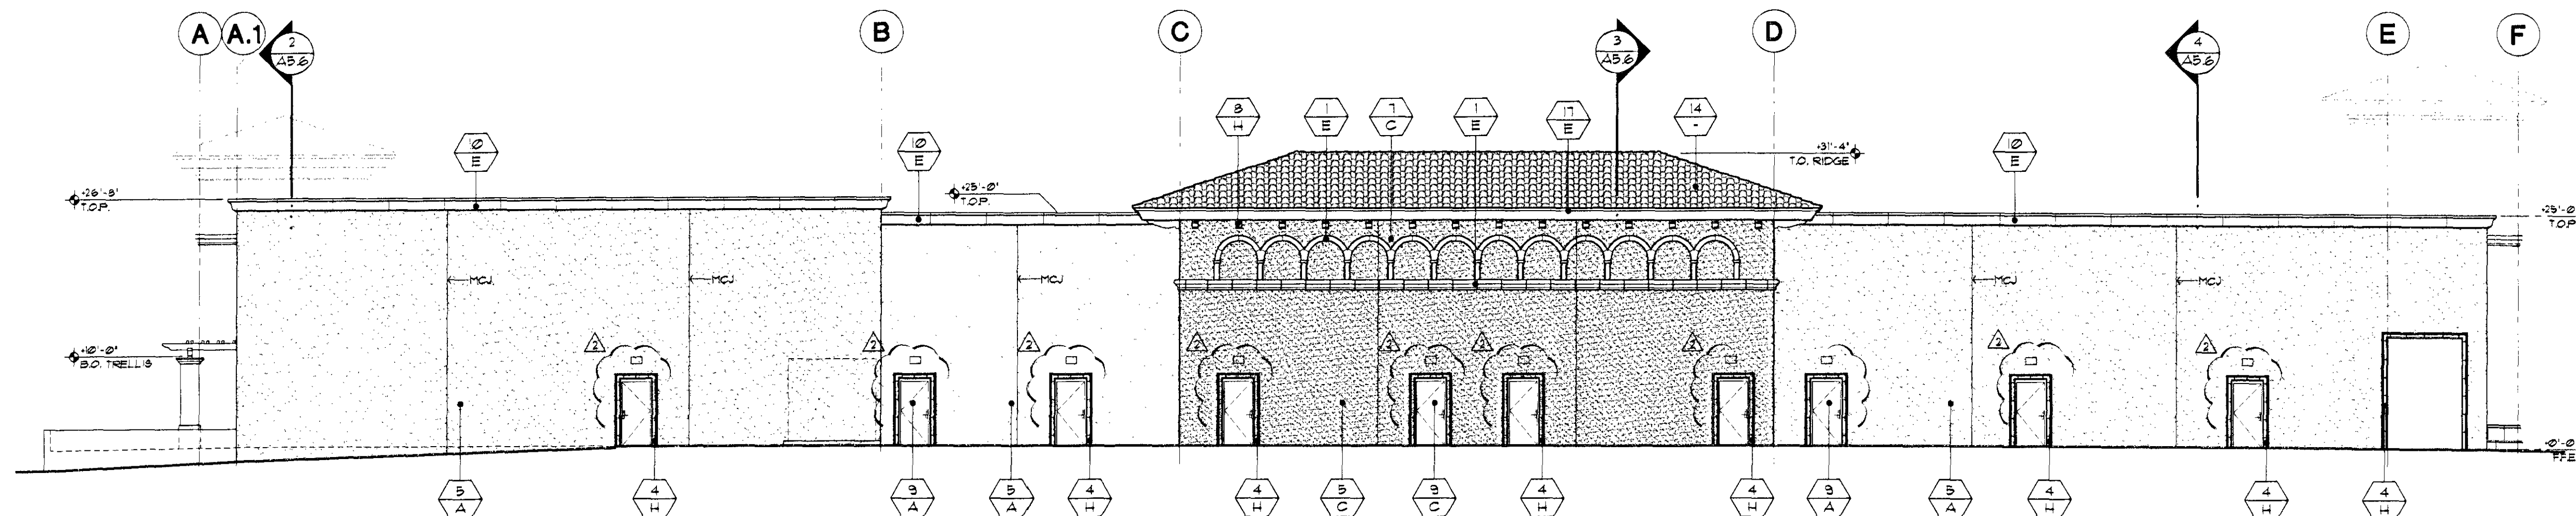

EAST ELEVATION
SCALE: 3/32" = 1'-0"

MATERIALS	
1. EIFS POPOUT	
2. FABRIC AWNING W/ SPEAR	
3. CAST IN PLACE CONCRETE BASE	
4. PRECAST CONCRETE	
5. SYNTHETIC STUCCO OVER MASONRY	
6. STEEL TRELLIS	
7. EIFS OVER WOOD FRAMING	
8. EIFS CORBEL	
9. H.M. DOOR	
10. EIFS CORNICE	
11. TENANT SIGNAGE TO MEET DEV. GUIDELINES (UNDER SEPARATE APPROVAL & PERMIT)	
12. BUILDING ADDRESS TO BE PLAINLY LEGIBLE AND VISIBLE FROM THE STREET. THEY SHALL CONTRAST WITH THEIR BACKGROUND AND SHALL BE A MIN. OF 4" HIGH WITH A MIN. STROKE WIDTH OF 0.5".	
13. CLAY ROOF TILE - 'OLD SEDONA' 4" CAPE ANTIGUA BY REDLAND TILE	
14. ORNAMENTAL LIGHT FIXTURE	
15. ALUMINUM STOREFRONT SYSTEM	
16. ALUMINUM FRAME WINDOW	
17. BREAK METAL WRAPPED FASCIA	
18. CENTER LOGO - T.B.D.	
19. S.E.S. - PAINTED TO MATCH BUILDING	


COLORS	
A. ICI PAINTS - 229 'ROSEDOWN'	
B. ICI PAINTS - 469 'ENGLISH COTTAGE'	
C. ICI PAINTS - 476 'GOLDEN WHEAT'	
D. ICI PAINTS - 1400 'SPA BLUE'	
E. ICI PAINTS - 480 'SHADOWBOX'	
F. ICI PAINTS - 382 'KENYA CORAL'	
G. 1/4" CLEAR GLAZING	
H. CDI PRECAST CONCRETE COLOR - 'GRAY'	
J. CDI PRECAST CONCRETE COLOR - 'GF30'	
K. CDI PRECAST CONCRETE COLOR - 'W030'	
L. SUNBRELLA - 'SAPPHIRE BLUE' WITH 'SKY BLUE' TRIM	
M. SUNBRELLA - 'PLUM'	
N. SUNBRELLA - 'TERRA COTTA' WITH 'TAUPE' TRIM	
P. DUNN EDWARDS - DE 3'9" SIDEWINDER	

ARCHITECTURAL ELEVATIONS
APPROVED
BY THE CITY OF SCOTTSDALE PLANNING DEPARTMENT
DATE: 9/1-02-2006 BY: [Signature] DATE: 8/16/07
CASE NUMBER: 7332-06-04
CONSTRUCTION AND INSTALLATION SHALL BE IN ACCORDANCE WITH THE CITY OF SCOTTSDALE PLANNING DEPARTMENT
THIS PLAN AND ANY AND ALL REV. THIS PLAN WILL REQUIRE SEPARATE APPROVAL




Butler Design Group Inc.
Architects & Planners
5555 East Van Buren St.
Suite 215
Phoenix, Arizona 85008

phone 602-957-1800
fax 602-957-7722

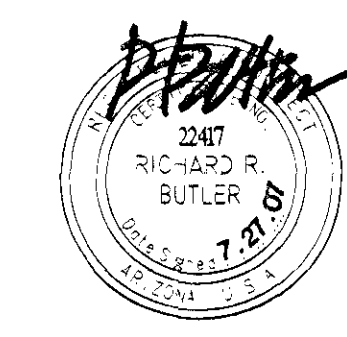

OWNERSHIP OF INSTRUMENTS OF SERVICE
All reports, plans, specifications, contracts, and other documents prepared by the design professional shall be the property of the design professional. The design professional shall retain all copies of the instrument and shall not be responsible for the loss or destruction of the instrument.

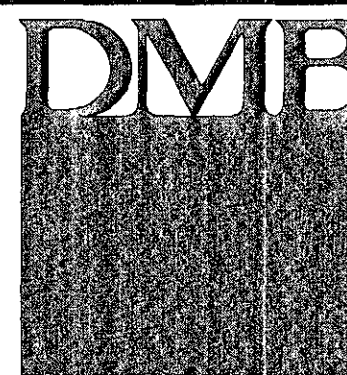

Ranch Crossing
18201-18291 N. PIMA ROAD
SCOTTSDALE, AZ
7330-06-04 15-PP-2006 91-DR-2006 246-SA-2007 42-SA-2007

Revisions:	
1. CITY COMMENTS 07/10/07	
Title:	SHOPS H ELEVATIONS
Date:	5/7/2007
Project number:	04118
Drawn by:	RAH
Checked by:	PH
CAD file:	04118-A5.4
☐ Design Development	
☐ Progress Const. Docs.	
☒ City Submittal	
☐ Bid Package	
☐ Construction Issue	
☐ Record Drawings	
Sheet Number:	

A5.4