




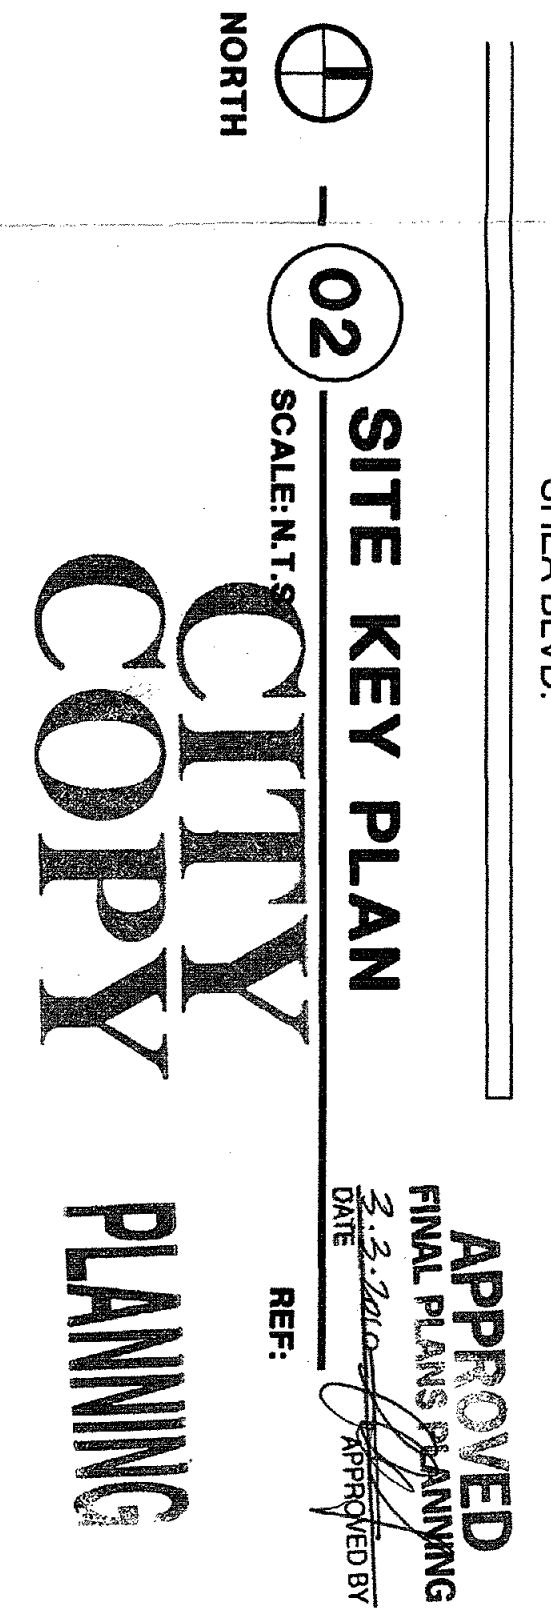

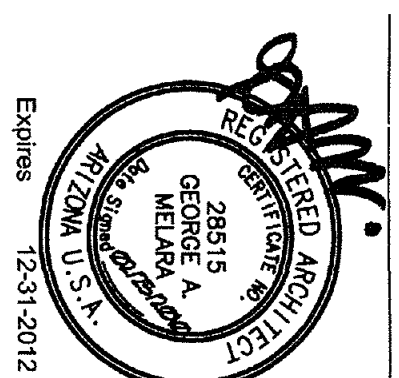


BIG DADDY'S BBQ


PIMA CROSSING - 8608 PIMA
SCOTTSDALE, AZ

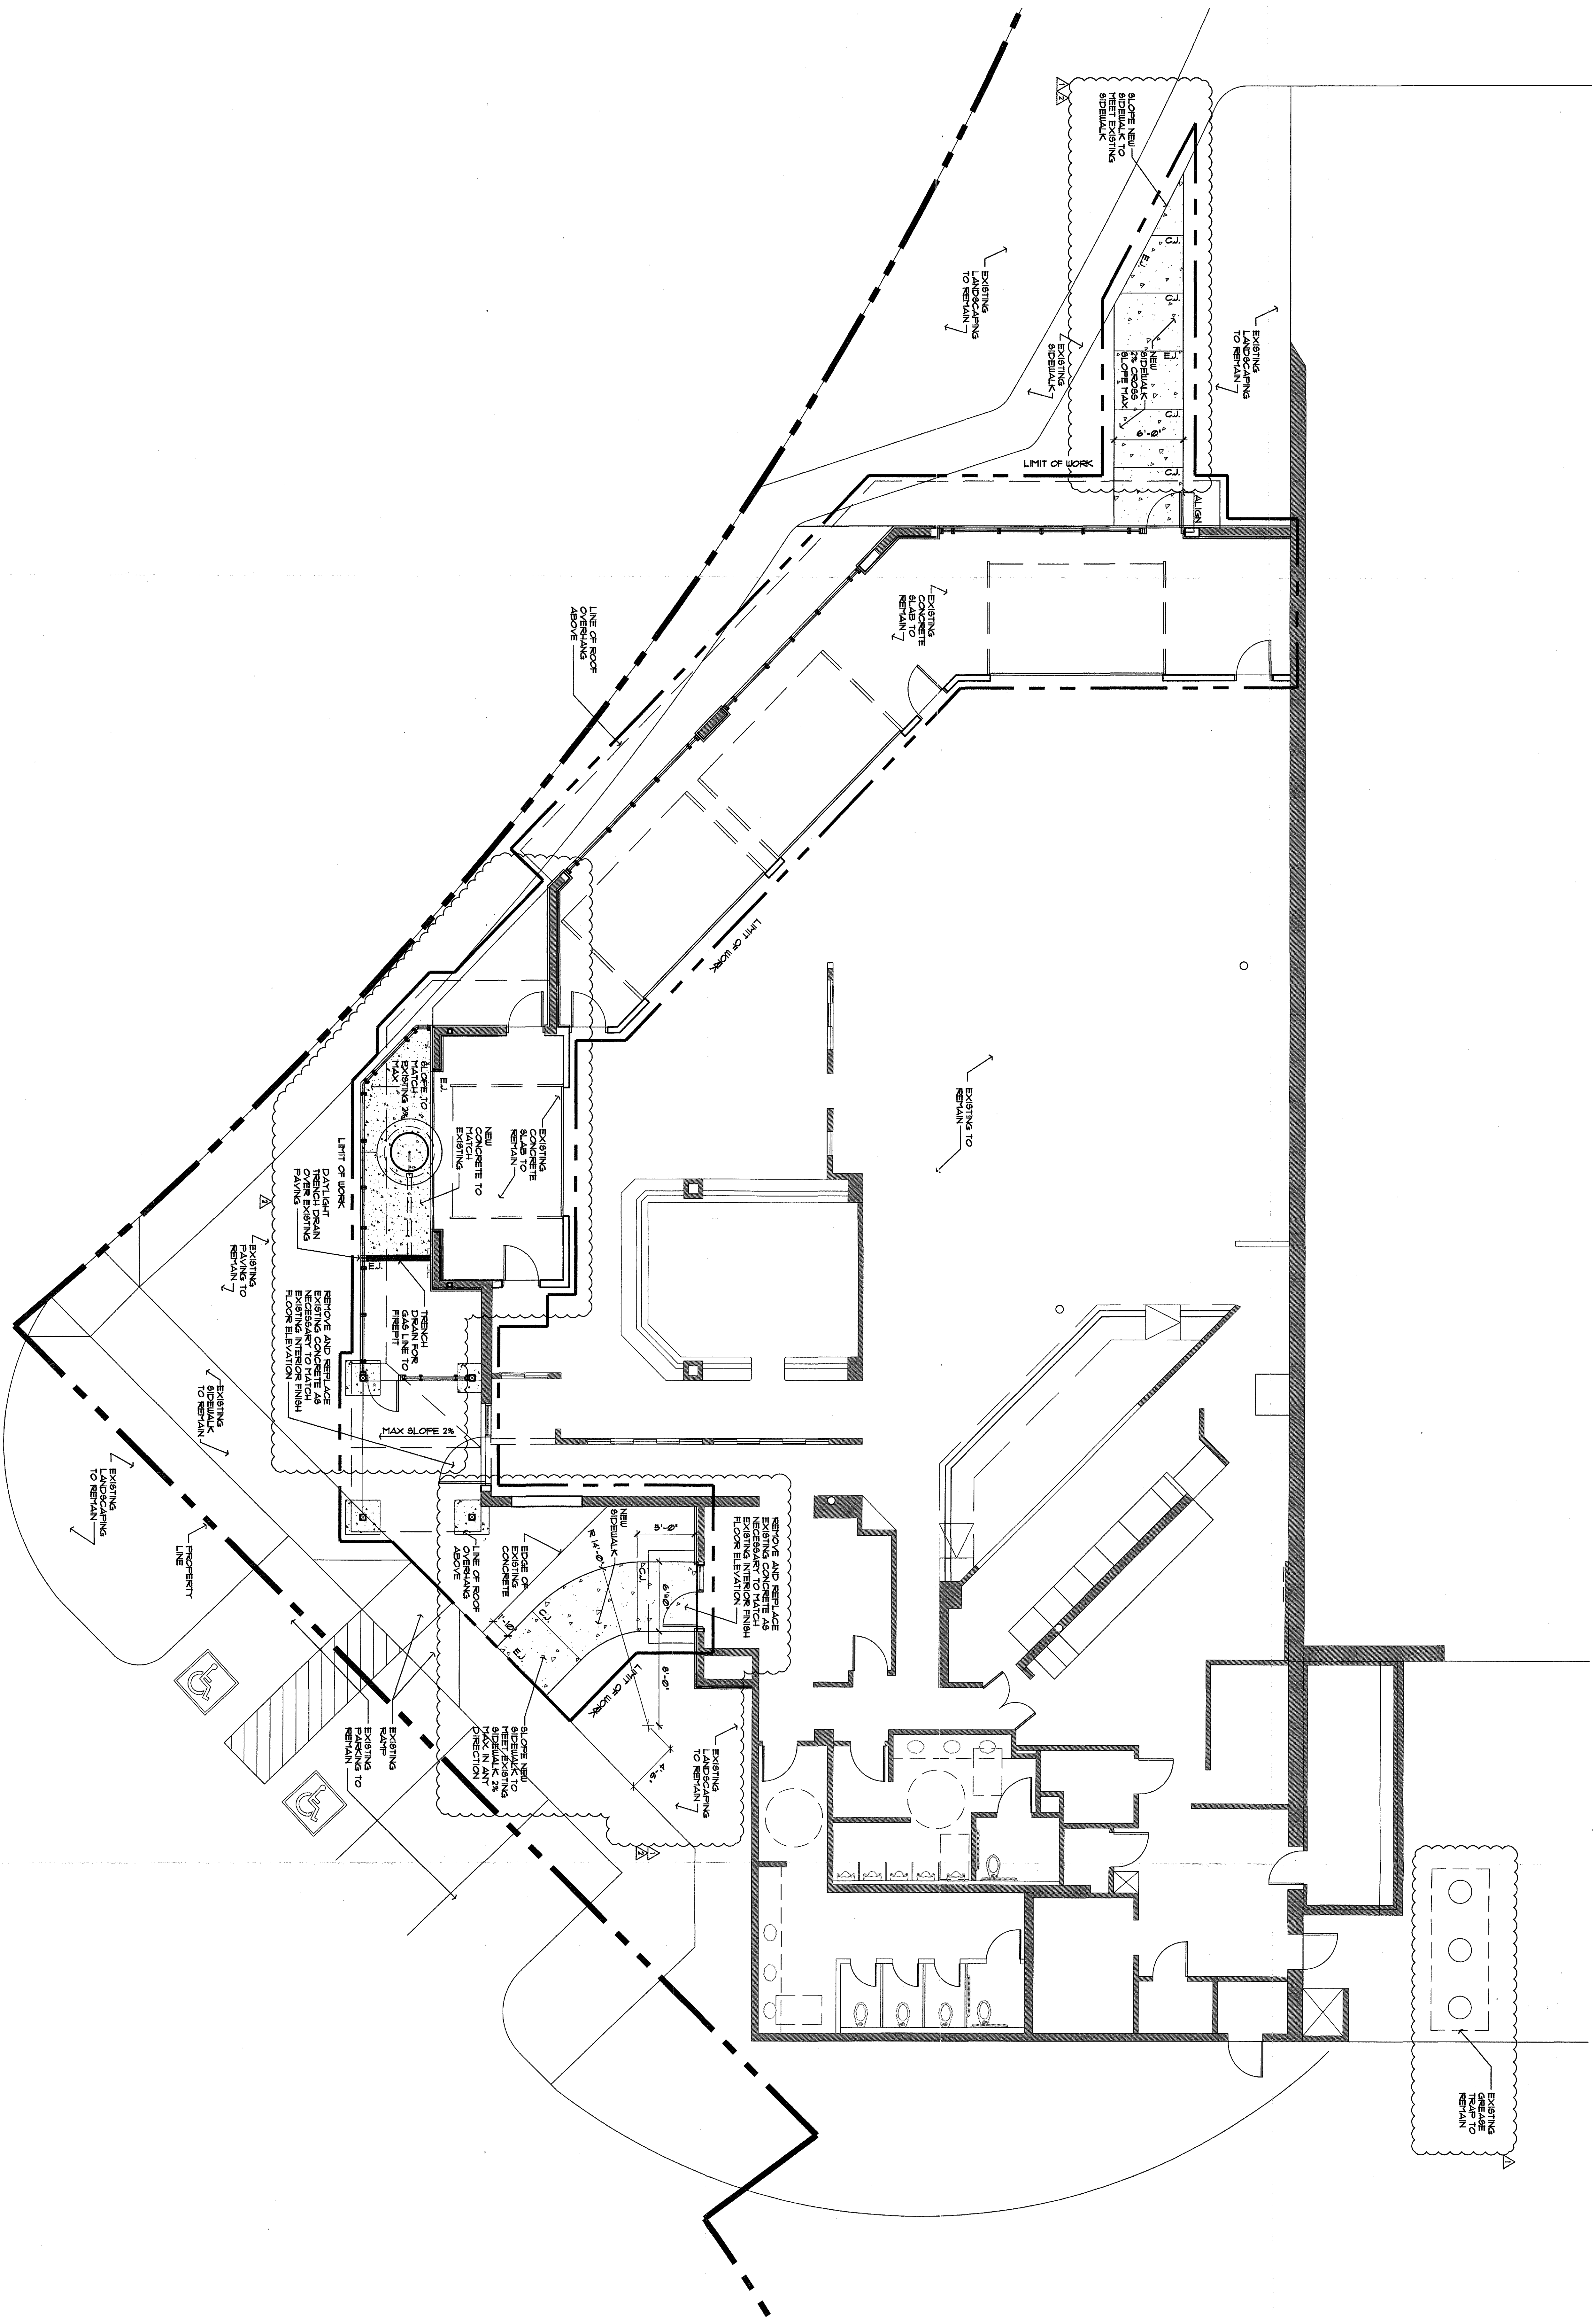


Date	Revisions
FEBRUARY 11, 2010	REVISIONS
FEBRUARY 25, 2010	PLAN REVIEW COMMENTS
FEBRUARY 25, 2010	COORDINATION

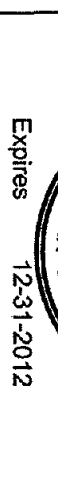

PIMA CROSSING - 8608 PIMA
SCOTTSDALE, AZ

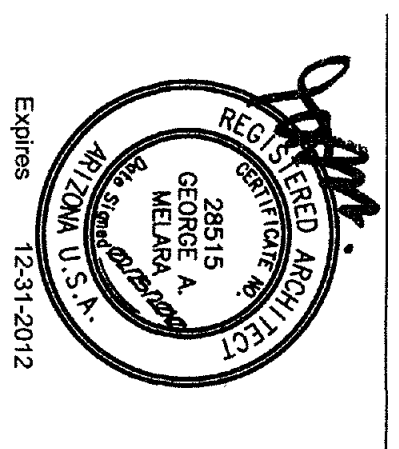


Expires 12-31-2012

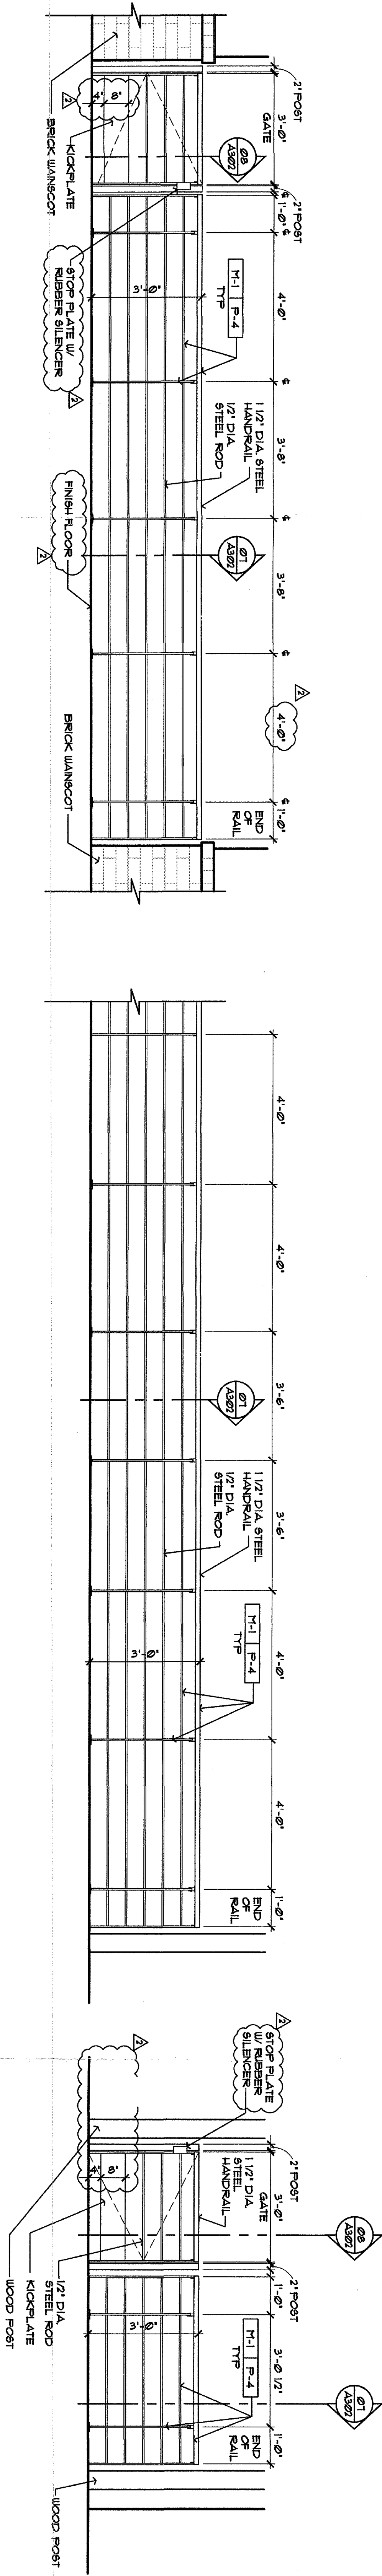


- 12 GATE/RAIL ELEVATION
SCALE: 1/2"=1'-0"

- 11 RAIL ELEVATION
SCALE: 1/2"=1'-0"


- 10 GATE/RAIL ELEVATION
SCALE: 1/2"=1'-0"

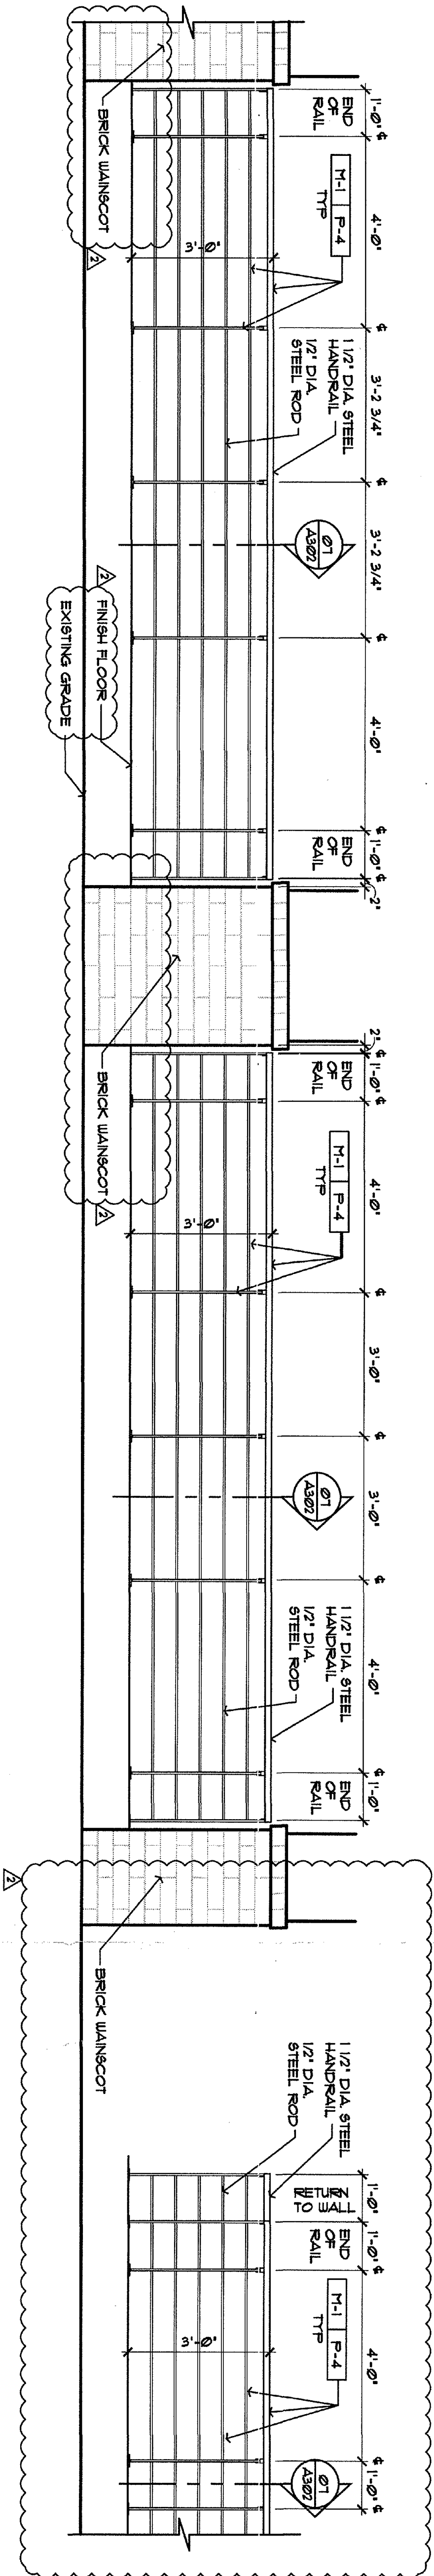

- 09 RAIL ELEVATION
SCALE: 1/2"=1'-0"

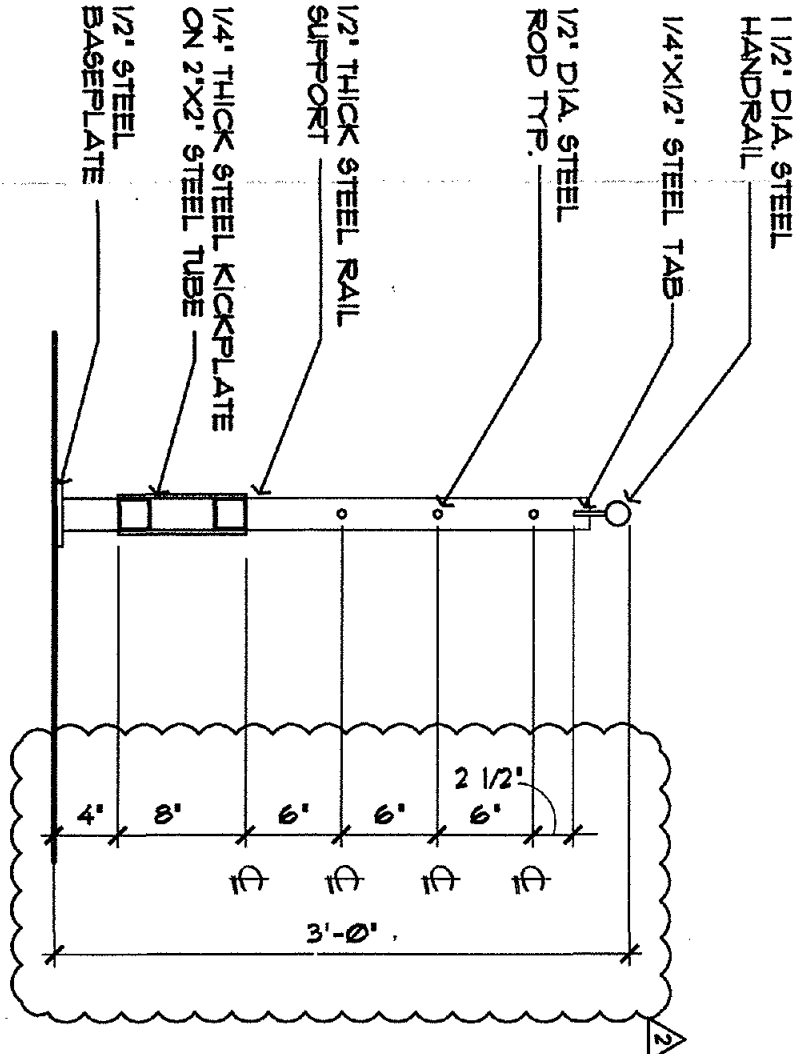


- 08 PATIO RAILING GATE SECTION
SCALE: 1"=1'-0"

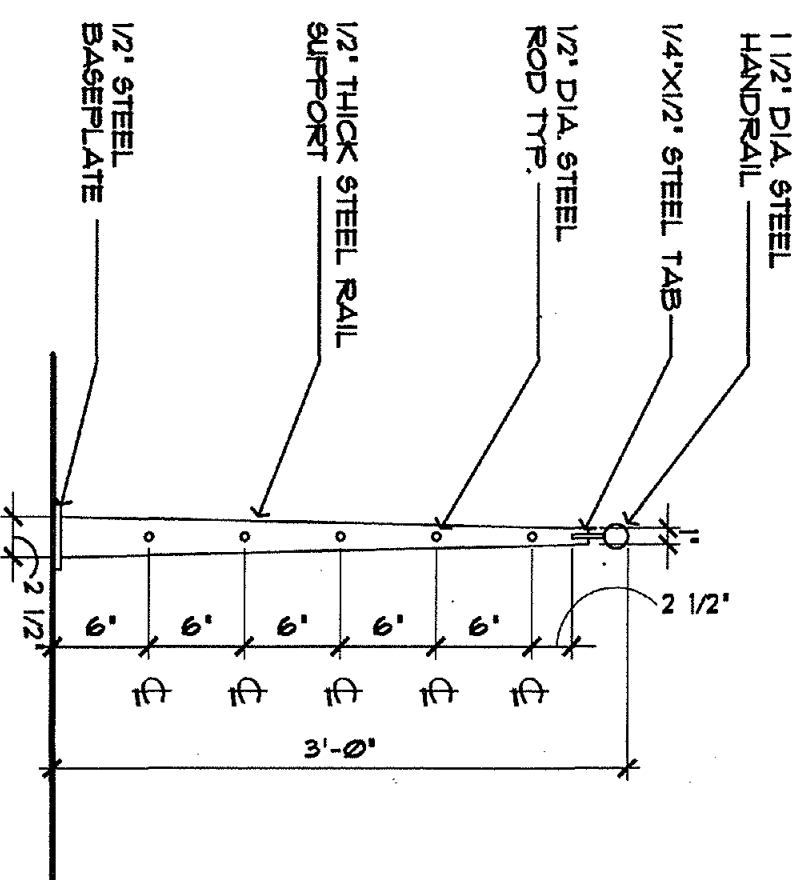


- 07 PATIO RAILING SECTION
SCALE: 1"=1'-0"


NOT USED

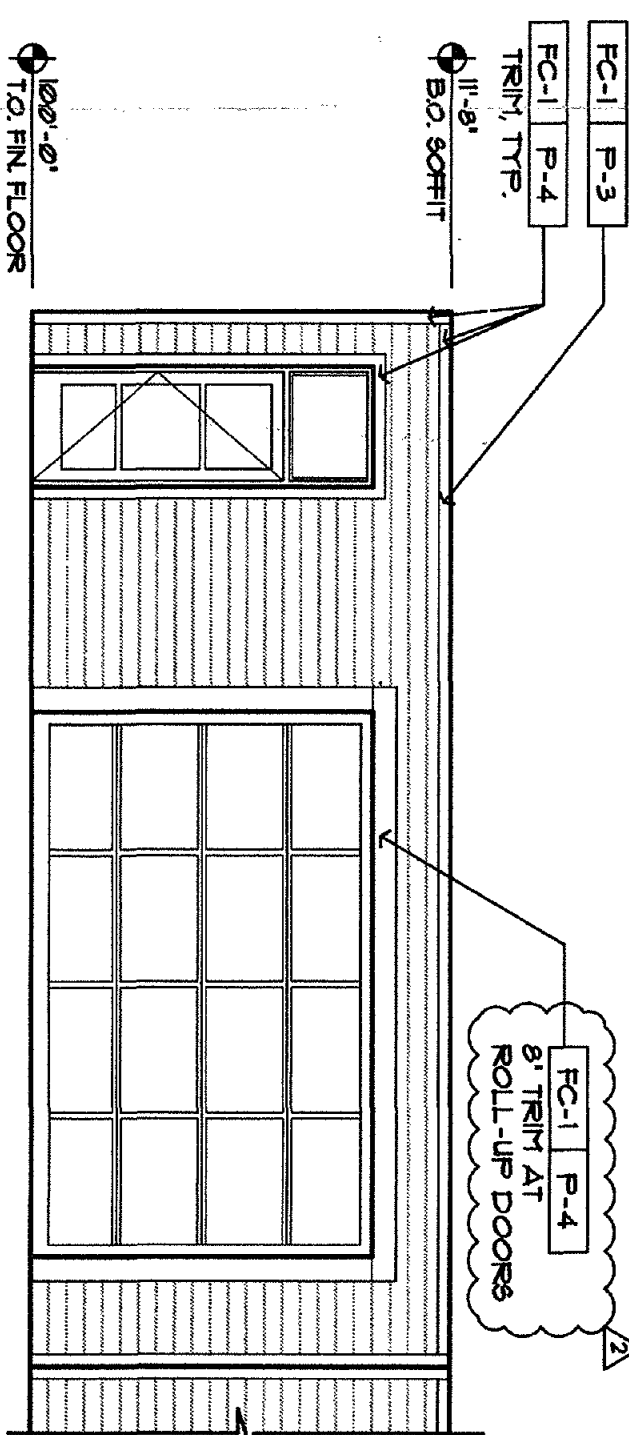


- 05 SOUTH PATIO ELEVATION
SCALE: 3/8"=1'-0"

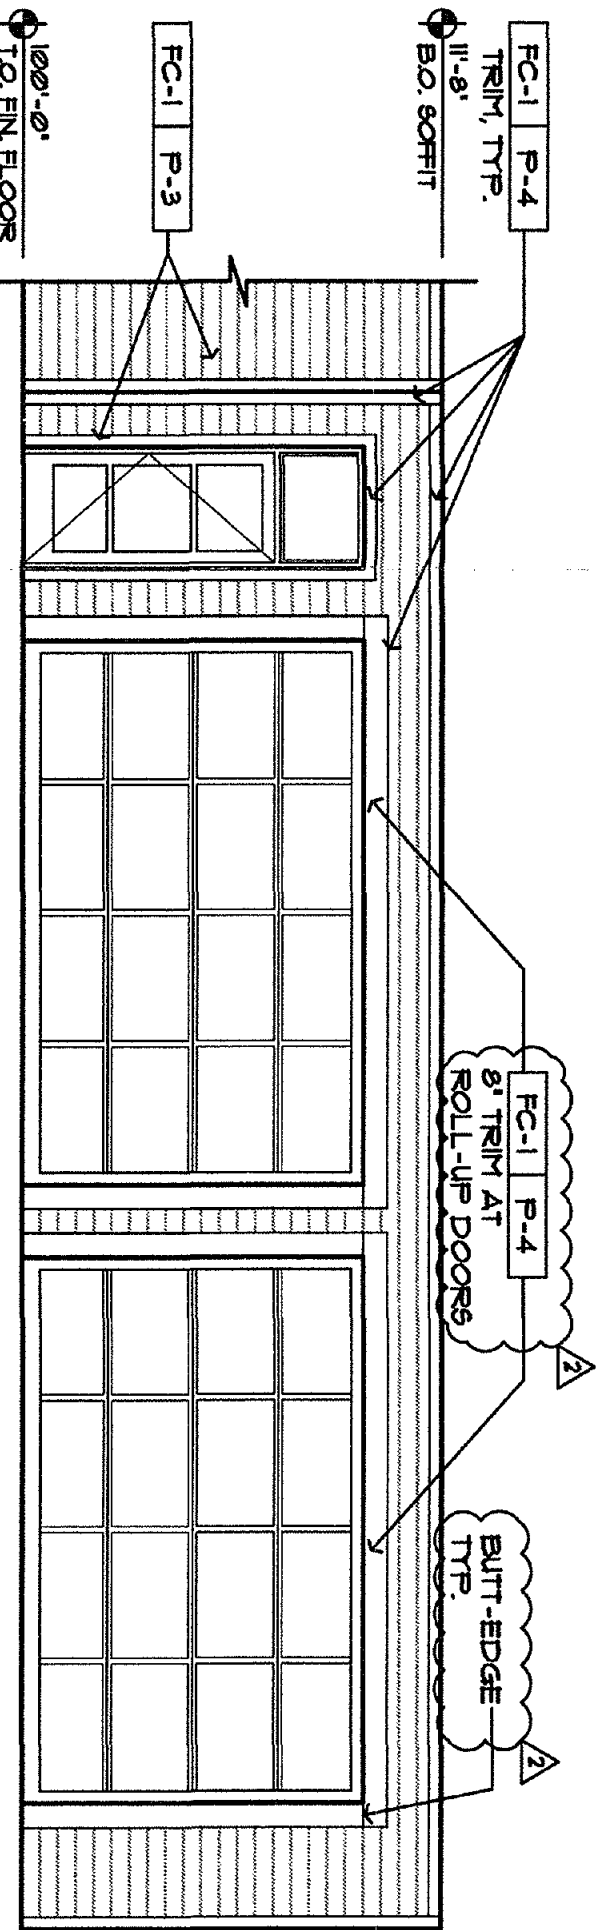


- 04 SOUTHEAST PATIO ELEVATION
SCALE: 3/8"=1'-0"

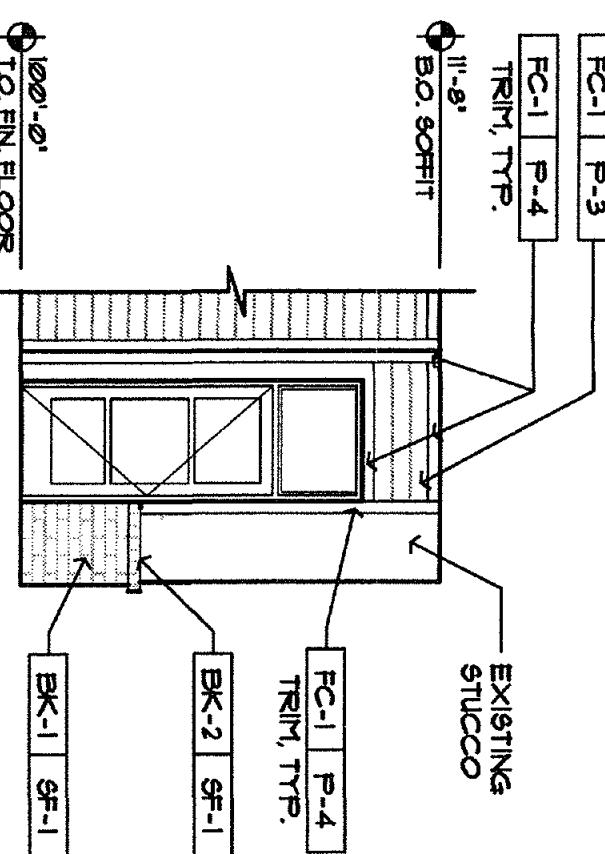

- 03 SOUTH PATIO ELEVATION
SCALE: 3/8"=1'-0"

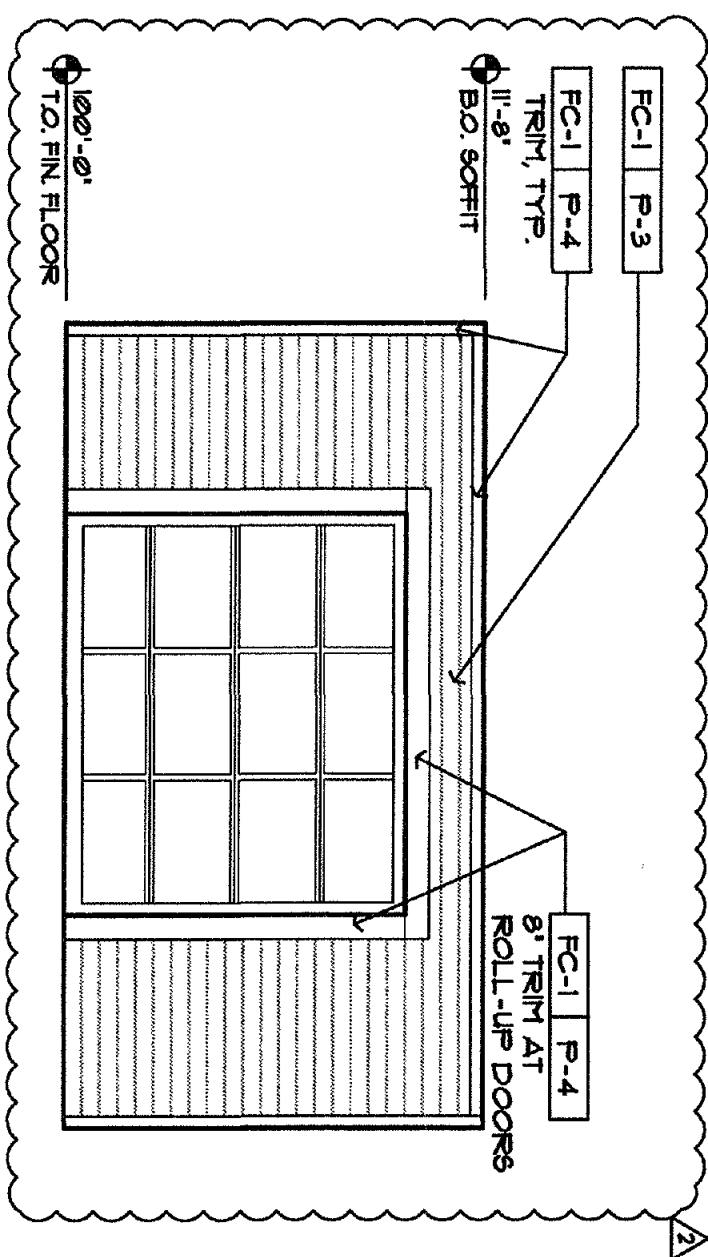

- 02 EAST PATIO ELEVATION
SCALE: 3/8"=1'-0"

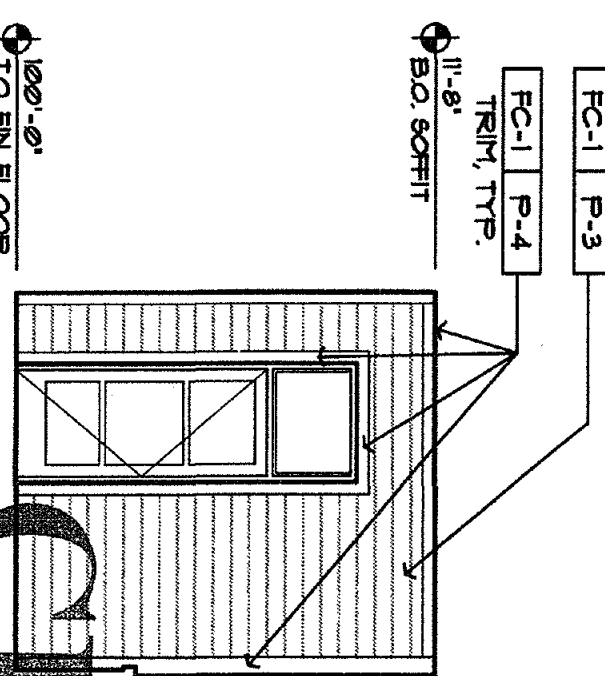

- 01 SOUTH PATIO ELEVATION
SCALE: 3/8"=1'-0"



BIG DADDY'S BBQ

PIMA CROSSING - 8608 PIMA
SCOTTSDALE, AZ

Date
FEBRUARY 14, 2010
Revisions
February 25, 2010
A
Coversheet

Drawings and other material appearing herein constitute original and unpublished information of NeisenPartners, Inc. and shall not be reproduced, stored in a retrieval system, or transmitted in any form or by any means, electronic, mechanical, photocopying, recording, or by any information storage and retrieval system, without the prior written consent of the architect.
© 2008 NEISEN PARTNERS, INC.
Project No.
39650
A302
PATIO & RAILING
ELEVATIONS