



SITE NAME: PHO\_CINCO SOLES

- SEPARATE FIRE DEPT PERMIT REQUIRED FOR FUEL STORAGE
- Deferred submittal by installing contractor.
- Provide manufactures specifications sheets for Gen-Set and fuel storage.
- Provide required run time.
- Provide size of DOUBLE WALLED tank.
- Show tank protection.
- Show gen-set screening.

2-16-2012  
 Fire Plan Review by:  
 John Armstrong (480) 312-7127  
 email: jarmstrong@scottsdaleaz.gov

**SITE ACQUISITION**  
 SHAW & ASSOCIATES, P.L.C.  
 6501 E. GREENWAY PKWY 103-643  
 SCOTTSDALE, ARIZONA, 85254  
 PHONE: (480) 204-1843  
 CONTACT: RICHARD SHAW

**ARCHITECT**  
 YOUNG DESIGN CORP.  
 10245 E. VIA LINDA, SUITE 211  
 SCOTTSDALE, ARIZONA, 85258  
 PHONE: (480) 451-9609  
 FAX: (480) 451-9608  
 CONTACT: MATTHEW YOUNG

**SURVEYOR**  
 RLF CONSULTING, LLC  
 PO BOX 11657  
 CHANDLER, ARIZONA, 85248  
 PHONE: (480) 510-3668  
 FAX: (480) 584-5824  
 CONTACT: RYAN FIDLER


**LESSOR / OWNER**  
 CONROY SCOTTSDALE RANCH FAMILY L.L.P.  
 12051 N. 96th STREET  
 SCOTTSDALE, ARIZONA, 85260  
 PHONE: (480) 206-3568  
 FAX: (T.B.D.)  
 CONTACT: JERRY RHEM

**LESSEE / COMPANY**  
 VERIZON WIRELESS  
 126 W. GEMINI DRIVE  
 TEMPE, ARIZONA, 85283  
 PHONE: (602) 390-9999  
 CONTACT: EARLENE SEXTON

SITE PHOTO:



VICINITY MAP:

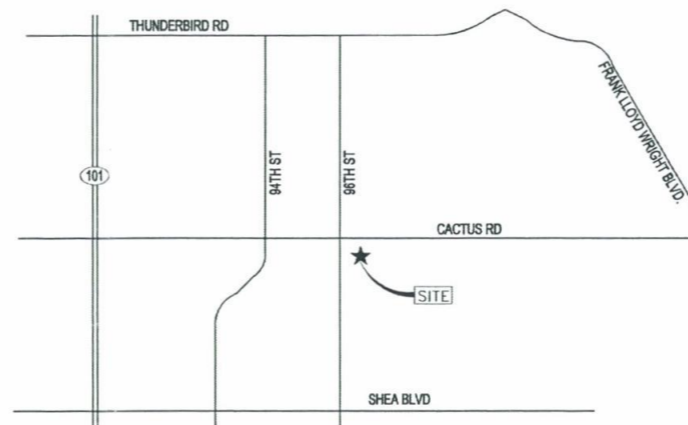

**SITE COORDINATES:**

LATITUDE : 33° 35' 45.679" N  
 LONGITUDE : 111° 52' 20.895" W  
 ELEVATION : 1410.3' A.M.S.L.



**DRIVING DIRECTIONS:**

TAKE US-60 EAST TO LOOP-101. TAKE LOOP 101 NORTH TO CACTUS ROAD. TURN RIGHT (EAST) ONTO CACTUS RD. THEN TURN RIGHT (SOUTH) ONTO 96th STREET, THEN TURN LEFT (EAST) INTO ACCESS DRIVEWAY TO THE SITE.

**ZONING COMPLIANCE:**

LOCAL JURISDICTION : CITY OF SCOTTSDALE  
 ASSESSORS PARCEL : 217-26-008-D  
 ZONING : R1-35 PRD  
 USE : TELECOMMUNICATION FACILITY  
 PARENT PARCEL AREA : 387,261.3885 S.F.  
 PROPOSED LEASE AREA : 900 S.F.  
 PARKING REQD : 1  
 PARKING PROVIDED : 1

CITY OF SCOTTSDALE  
 : 217-26-008-D  
 : R1-35 PRD  
 TELECOMMUNICATION FACILITY  
 : 387,261.3885 S.F.  
 : 900 S.F.  
 : 1  
 : 1

**GENERAL COMPLIANCE:**

HVAC USED ON THIS STRUCTURE IS NOT INTENDED FOR HUMAN COMFORT ITS USE IS SOLELY FOR ELECTRONIC EQUIPMENT COOLING.  
 DEVELOPMENT AND USE OF THIS SITE WILL CONFORM TO ALL APPLICABLE CODES AND ORDINANCES.  
 PROVIDE STREET ADDRESS IDENTIFICATION PER MUNICIPAL REQUIREMENTS.  
 THE USE OF THIS SITE WILL GENERATE NO TRASH. THIS PROJECT DOES NOT REQUIRE WATER OR SEWER. THIS PROJECT REQUIRES PERMANENT POWER & TELEPHONE CONNECTION.

**A.D.A. COMPLIANCE:**

FACILITY IS UNMANNED AND NOT FOR HUMAN HABITATION. LANDINGS AND EXITS SHALL COMPLY WITH THE APPLICABLE BUILDING CODE.

**F.C.C. COMPLIANCE:**

ALL PROPOSED ANTENNAS SHALL BE IN COMPLIANCE WITH ALL FEDERAL COMMUNICATIONS COMMISSION (FCC) REGULATIONS, INCLUDING THOSE PROTECTING THE PUBLIC HEALTH AND THOSE PROTECTING HISTORIC DISTRICTS.

**COLLOCATION:**

POLE SHALL BE DESIGNED IN A MANNER THAT WILL ALLOW FOR THE COLLOCATION OF AT LEAST ONE ADDITIONAL ARRAY ON THE FACILITY.

**PROJECT DESCRIPTION:**

THE PROJECT CONSISTS OF THE INSTALLATION AND OPERATION OF ANTENNAS AND ASSOCIATED EQUIPMENT FOR COMPANY'S WIRELESS TELECOMMUNICATIONS NETWORK. FACILITY IS UNMANNED AND NOT FOR HUMAN HABITATION.

THIS FACILITY IS A STATE APPROVED, PREFABRICATED EQUIPMENT SHELTER, TO HOUSE RADIO EQUIPMENT. NO HAZARDOUS MATERIAL WILL BE STORED WITHIN THE FACILITY.

ALL EXITS SHALL BE OPEN ABLE FROM THE INSIDE WITHOUT THE USE OF KEYS OR SPECIAL KNOWLEDGE. MANUALLY OPERATED EDGE OR SURFACE MOUNTED FLUSH BOLTS ARE PROHIBITED.

NEW ANTENNAS AND ASSOCIATED COAXIAL CABLES  
 NEW ELECTRICAL SERVICE  
 NEW MONOPALM  
 NEW PREFABRICATED EQUIPMENT SHELTER  
 NEW MASONRY SCREEN WALL.

**SHEET INDEX:**

T1	TITLE SHEET, PROJECT INFO
C-1	SITE SURVEY, LEASE AREA
Z1	OVERALL SITE PLAN
Z2	ENLARGED SITE PLAN
Z3	SITE ELEVATION

CLIENT




INTERNAL REVIEW	DATE
CONSTRUCTION SIGNATURE	
RF SIGNATURE	
REAL ESTATE SIGNATURE	

PLANS PREPARED BY

architecture / project management  
 10245 E. Via Linda, Scottsdale, AZ 85258  
 ph: 480 451 9609 fax: 480 451 9608  
 e-mail: corporate@ydcollc.com

SEAL  
 This drawing is copyrighted and the property of Young Design Corporation (YDC) & produced solely by YDC and affiliates. reproduction or use of this drawing and/or the information contained hereon is forbidden without written permission by Young Design Corporation.

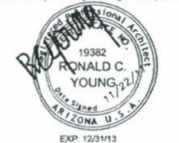

THIS DOCUMENT CONTAINS AN ELECTRONIC SIGNATURE PURSUANT TO A.P.S. TITLE 18 AND TITLE 44. IT IS A VIOLATION FOR ANY PERSON, UNLESS UNDER THE DIRECT SUPERVISION OF THE REGISTRANT, TO MODIFY THIS DOCUMENT IN ANY WAY.

NO.	DATE	DESCRIPTION
1	11/22/11	FINAL ISSUE

ARCHITECTS JOB NO.  
 YDC-3035

PROJECT INFORMATION  
 PHO\_CINCO SOLES  
 12051 N 96th STREET  
 SCOTTSDALE, ARIZONA, 85260

SHEET TITLE  
 TITLE SHEET

JURISDICTION APPROVAL

SHEET NUMBER  
 T-1

**verizon wireless**  
 126 W. GEMINI DR.  
 TEMPE, AZ 85283

**Young design corp**  
 architecture / project management  
 10245 E. Via Linda, Scottsdale, AZ 85258  
 ph: 480 451 9609 fax: 480 451 9608  
 e-mail: corp@ydcoffice.com

THE INFORMATION CONTAINED IN THIS SET OF DOCUMENTS IS PROPRIETARY BY NATURE. ANY USE OR DISCLOSURE OTHER THAN THAT WHICH RELATES TO THE CLIENT IS STRICTLY PROHIBITED.

FIELD BY: RF  
 DRAWN BY: MJG  
 CHECKED BY: RLF



SUBMITTALS		
NO.	DATE	DESCRIPTION
1	09/16/11	PRELIM SUBMITTAL
2	09/27/11	FINAL SUBMITTAL

**rlf**  
 Consulting, llc  
 Land Survey & Mapping Solutions  
 6197 South Rural Road, Suite 101  
 Tempe, AZ 85283  
 p. 480.310.3468 f. 480.339.0200  
 www.rlfconsulting.com

PROJECT NO:  
**09006266**  
 SITE NAME:  
**PHO CINCO SOLES**  
 SITE NUMBER:  
**2011670704**  
 SITE ADDRESS:  
**12051 N. 96TH ST.  
 SCOTTSDALE, AZ 85260**

SHEET TITLE:  
**TOPOGRAPHIC SURVEY**

SHEET NO. REVISION:  
**C-1**

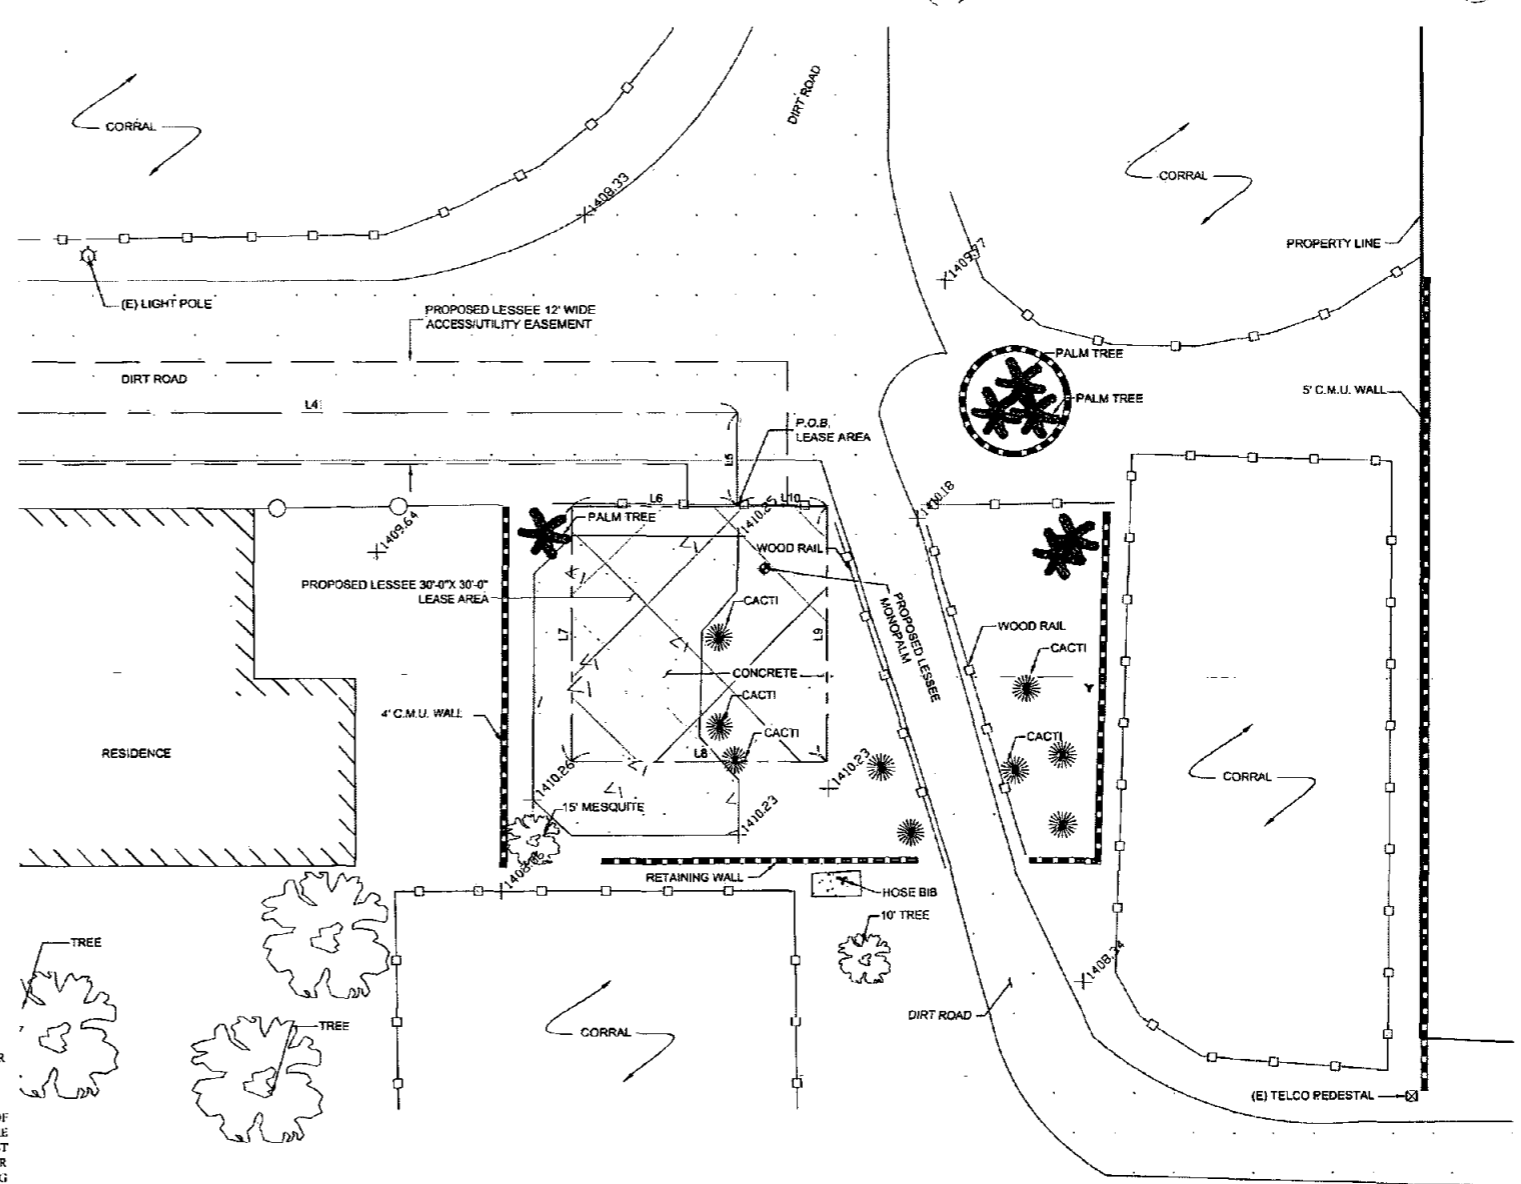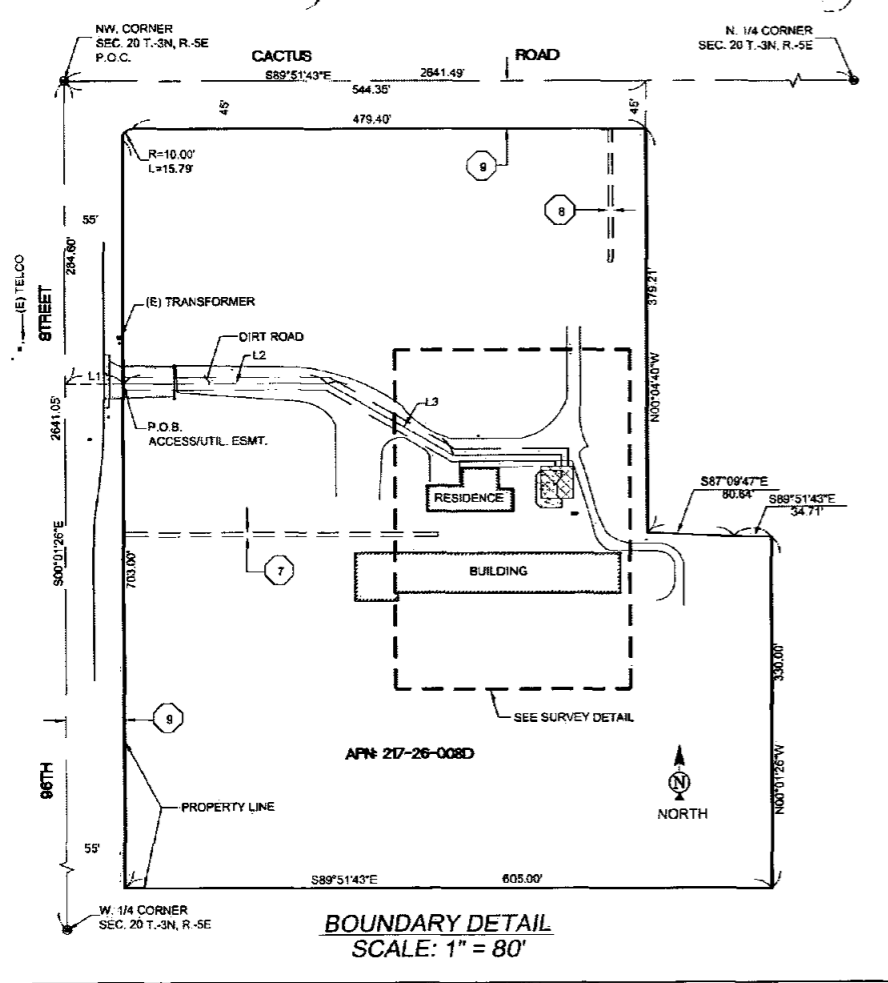

**SURVEYOR'S NOTES**

- ALL TITLE INFORMATION IS BASED UPON A COMMITMENT FOR TITLE INSURANCE PREPARED BY GREAT AMERICAN TITLE AGENCY, INC., ORDER NO: 21110002 EFFECTIVE DATE: 08/17/2011.
- SURVEYOR HAS NOT PERFORMED A SEARCH OF PUBLIC RECORDS TO DETERMINE ANY DEFECT IN TITLE.
- THE BOUNDARY SHOWN HEREON IS PLOTTED FROM RECORD INFORMATION AND DOES NOT CONSTITUTE A BOUNDARY SURVEY OF THE PROPERTY.
- SURVEYOR DOES NOT GUARANTEE THAT ALL UTILITIES ARE SHOWN OR THEIR LOCATIONS. IT IS THE RESPONSIBILITY OF THE CONTRACTOR AND DEVELOPER TO CONTACT BLUE STAKE AND ANY OTHER INVOLVED AGENCIES TO LOCATE ALL UTILITIES PRIOR TO CONSTRUCTION. REMOVAL, RELOCATION AND/OR REPLACEMENT IS THE RESPONSIBILITY OF THE CONTRACTOR.

**PROJECT META DATA**

- ELEVATIONS SHOWN HEREON ARE REPRESENTED IN NORTH AMERICAN VERTICAL DATUM OF 1988 (NAVD88) ESTABLISHED FROM GPS DERIVED ELLIPSOID HEIGHTS, APPLYING GEOID 09 SEPARATIONS CONSTRAINING TO NGS CORS STATIONS PROVIDED IN THE "ONLINE POSITIONING USER SERVICE" (OPUS) SOLUTION FOR THIS SPECIFIC SITE.
- BEARINGS SHOWN HEREON ARE BASED UPON U.S. STATE PLANE NAD83 COORDINATE SYSTEM ARIZONA STATE PLANE COORDINATE ZONE CENTRAL. DETERMINED BY GPS OBSERVATIONS.
- FIELD WORK FOR THIS PROJECT WAS PERFORMED ON 09/14/11.

**LEGEND**

NG	NATURAL GRADE	CLF	CHAIN LINK FENCE
BLDG	TOP OF BUILDING	W	WATER CONTROL VALVE
FC	FACE OF CURB	FH	FIRE HYDRANT
RW	RIGHT OF WAY	GW	GUY WIRE
AP	ASPHALT	GN	FOUND AS NOTED
DW	ACCESS DRIVEWAY	PP	POWER POLE
TOP	TOP OF SLOPE	LP	LIGHT POLE
TOE	TOE OF SLOPE	ET	ELECTRICAL TRANSFORMER
WIF	WROUGHT IRON FENCE	EP	ELECTRICAL PEDESTAL
SW	SIDEWALK	GV	GAS VALVE
TP	TOP OF PARAPET	BK	BREAKLINE
TW	TOP OF WALL	BL	BOLLARD
B	BENCHMARK	SC	SEWER CLEANOUT
OR	OR POSITION OF GEODETIC COORDINATES		
SPOT ELEVATION	PROPERTY LINE		
DISH ANTENNA	CENTERLINE		
MICROWAVE ANTENNA	EASEMENT LINE		
	LEASE LINE		

**LESSOR'S LEGAL DESCRIPTION**


PARCEL NO. 1:  
 THAT PORTION OF THE NORTHWEST QUARTER OF THE NORTHWEST QUARTER OF SECTION 20, TOWNSHIP 3 NORTH, RANGE 5 EAST OF THE GILA AND SALT RIVER BASE AND MERIDIAN, MARICOPA COUNTY, ARIZONA, DESCRIBED AS FOLLOWS:  
 BEGINNING AT A POINT ON THE WEST LINE OF THE NORTHWEST QUARTER OF THE NORTHWEST QUARTER WHICH POINT IS 428 FEET SOUTH OF THE NORTHWEST CORNER OF SAID NORTHWEST QUARTER OF THE NORTHWEST QUARTER OF SECTION 20, SAID POINT ALSO BEING THE SOUTHWEST CORNER OF THAT CERTAIN PARCEL OF LAND CONVEYED TO TANNER CONTRACTING AND EQUIPMENT CO., AN ARIZONA CORPORATION BY DEED RECORDED IN DOCKET 182, PAGE 332; THENCE CONTINUING SOUTH ALONG THE WEST LINE OF SAID NORTHWEST QUARTER OF THE NORTHWEST QUARTER OF SAID SECTION 20 A DISTANCE OF 330 FEET; THENCE EAST PARALLEL WITH THE SOUTH LINE OF THE AFORESAID TANNER CONTRACTING EQUIPMENT CO. PARCEL A DISTANCE OF 660 FEET; THENCE NORTH 330 FEET TO A POINT ON THE SOUTH LINE OF SAID TANNER CONTRACTING EQUIPMENT CO. PARCEL; THENCE WEST ALONG SAID SOUTH LINE 660 FEET TO THE POINT OF BEGINNING.

PARCEL NO. 2:  
 THE WEST 599 FEET OF THE NORTH 428 FEET OF THE WEST THREE-QUARTERS OF THE NORTHWEST QUARTER OF THE NORTHWEST QUARTER AND THE EAST 40 FEET OF THE WEST 549 FEET OF THE NORTH 428 FEET OF THE WEST THREE-QUARTERS OF THE NORTHWEST QUARTER OF THE NORTHWEST QUARTER OF SECTION 20, TOWNSHIP 3 NORTH, RANGE 5 EAST OF THE GILA AND SALT RIVER BASE AND MERIDIAN, MARICOPA COUNTY, ARIZONA, EXCEPT THE FOLLOWING DESCRIBED PARCEL:

BEGINNING AT THE INTERSECTION POINT OF THE NORTH LINE OF SAID SECTION 20 WITH A LINE 549.00 FEET EAST AND PARALLEL WITH THE WEST LINE OF SAID SECTION 20, SAID POINT BEING THE TRUE POINT OF BEGINNING OF THE PARCEL HEREIN DESCRIBED; THENCE SOUTH ALONG THE LINE 549.00 FEET EAST AND PARALLEL WITH THE WEST LINE OF SECTION 20, A DISTANCE OF 424.45 FEET; THENCE NORTH 87 DEGREES 20 MINUTES 08 SECONDS WEST A DISTANCE OF 4.26 FEET TO AN INTERSECTION POINT OF A LINE 545.75 FEET EAST AND PARALLEL TO THE WEST LINE OF SECTION 20 WITH A LINE 424.25 FEET SOUTH AND PARALLEL TO THE NORTH LINE OF SECTION 20; THENCE NORTH 00 DEGREES 12 MINUTES 44 SECONDS WEST, A DISTANCE OF 424.25 FEET TO AN INTERSECTION POINT OF A LINE 545.35 FEET EAST AND PARALLEL TO THE WEST LINE OF SECTION 20 WITH THE NORTH LINE OF SECTION 20; THENCE EAST ALONG THE NORTH LINE OF SECTION 20, A DISTANCE OF 4.65 FEET TO THE TRUE POINT OF BEGINNING OF THE PARCEL HEREIN DESCRIBED.

PARCEL NO. 3:  
 A PORTION OF THE NORTHWEST QUARTER OF THE NORTHWEST QUARTER OF THE NORTHWEST QUARTER OF SECTION 20, TOWNSHIP 3 NORTH, RANGE 5 EAST OF THE GILA AND SALT RIVER BASE AND MERIDIAN, MARICOPA COUNTY, ARIZONA, DESCRIBED MORE PARTICULARLY AS FOLLOWS:  
 BEGINNING AT THE INTERSECTION POINT OF A LINE 428.00 FEET SOUTH AND PARALLEL TO THE NORTH LINE OF SAID SECTION 20 WITH A LINE 549.00 FEET EAST AND PARALLEL TO THE WEST LINE OF SAID SECTION 20, SAID POINT BEING THE TRUE POINT OF BEGINNING OF THE PARCEL HEREIN DESCRIBED; THENCE NORTH 00 DEGREES 09 MINUTES 39 SECONDS WEST ALONG A LINE 549.00 FEET EAST AND PARALLEL TO THE WEST LINE OF SECTION 20, A DISTANCE OF 3.55 FEET TO A POINT; THENCE SOUTH 87 DEGREES 20 MINUTES 08 SECONDS EAST, A DISTANCE OF 76.28 FEET TO A POINT ON A LINE 428.00 FEET SOUTH AND PARALLEL TO THE NORTH LINE OF SECTION 20; THENCE WEST ALONG THE LINE 428.00 FEET SOUTH AND PARALLEL TO THE NORTH LINE OF SECTION 20, A DISTANCE OF 76.29 FEET TO THE TRUE POINT OF BEGINNING OF THE PARCEL HEREIN DESCRIBED.

LINE	LENGTH	BEARING
L1	55.00'	N90°00'00"E
L2	192.49'	N90°00'00"E
L3	135.00'	S60°00'00"E
L4	100.00'	N90°00'00"E
L5	11.00'	S00°00'00"E
L6	19.33'	N90°00'00"W
L7	30.00'	S00°00'00"E
L8	30.00'	N90°00'00"E
L9	30.00'	N00°00'00"E
L10	10.67'	N90°00'00"W

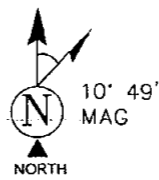

**SCHEDULE B EXCEPTIONS**

- AN EASEMENT FOR ELECTRICAL LINES AND INCIDENTAL PURPOSES RECORDED AS DOCKET 6967, PAGE 572 OFFICIAL RECORDS (REFERENCED)
- AN EASEMENT FOR ELECTRIC LINES AND INCIDENTAL PURPOSES RECORDED IN DOCKET 6142, PAGE 194 OFFICIAL RECORDS. (REFERENCED)
- AN EASEMENT FOR ROAD, PUBLIC UTILITIES AND INCIDENTAL PURPOSES RECORDED AS 83-500036 OF OFFICIAL RECORDS. (REFERENCED)

**PROPOSED LESSEE ACCESS/UTILITY EASEMENT LEGAL DESCRIPTION**

A 12.00' WIDE STRIP OF LAND SITUATED WITHIN THE NORTHWEST QUARTER OF SECTION 20, TOWNSHIP 3 NORTH, RANGE 5 EAST OF THE GILA AND SALT RIVER BASE AND MERIDIAN, MARICOPA COUNTY, ARIZONA, LYING 6.00 FEET ON EITHER SIDE OF THE FOLLOWING DESCRIBED CENTERLINE:

COMMENCING AT THE NORTHWEST CORNER OF SAID SECTION 20; THENCE SOUTH 00°01'28" EAST, ALONG THE WEST LINE OF THE NORTHWEST QUARTER OF SAID SECTION 20, 284.60 FEET; THENCE NORTH 90°00'00" EAST, 55.00 FEET; THENCE CONTINUING NORTH 90°00'00" EAST, 192.49 FEET; THENCE SOUTH 60°00'00" EAST, 135.00 FEET; THENCE NORTH 90°00'00" EAST, 100.00 FEET; THENCE SOUTH 00°00'00" EAST, 11.00 FEET TO THE POINT OF BEGINNING; THENCE NORTH 90°00'00" WEST, 19.33 FEET; THENCE SOUTH 00°00'00" EAST, 30.00 FEET; THENCE NORTH 90°00'00" EAST, 30.00 FEET; THENCE NORTH 90°00'00" WEST, 10.67 FEET TO THE POINT OF BEGINNING.


**PROPOSED LESSEE LEASE AREA LEGAL DESCRIPTION**

A PARCEL OF LAND SITUATED WITHIN THE NORTHWEST QUARTER OF SECTION 20, TOWNSHIP 3 NORTH, RANGE 5 EAST OF THE GILA AND SALT RIVER BASE AND MERIDIAN, MARICOPA COUNTY, ARIZONA, MORE PARTICULARLY DESCRIBED AS FOLLOWS:

COMMENCING AT THE NORTHWEST CORNER OF SAID SECTION 20; THENCE SOUTH 00°01'28" EAST, ALONG THE WEST LINE OF THE NORTHWEST QUARTER OF SAID SECTION 20, 284.60 FEET; THENCE NORTH 90°00'00" EAST, 55.00 FEET; THENCE CONTINUING NORTH 90°00'00" EAST, 192.49 FEET; THENCE SOUTH 60°00'00" EAST, 135.00 FEET; THENCE NORTH 90°00'00" EAST, 100.00 FEET; THENCE SOUTH 00°00'00" EAST, 11.00 FEET TO THE POINT OF BEGINNING; THENCE NORTH 90°00'00" WEST, 19.33 FEET; THENCE SOUTH 00°00'00" EAST, 30.00 FEET; THENCE NORTH 90°00'00" EAST, 30.00 FEET; THENCE NORTH 90°00'00" WEST, 10.67 FEET TO THE POINT OF BEGINNING.

**POSITION OF GEODETIC COORDINATES**


LATITUDE 33° 35' 46.678" NORTH (NAD83)  
 LONGITUDE 111° 52' 20.895" WEST (NAD83)  
 ELEVATION @ GROUND= 1410.3' (NAVD83)

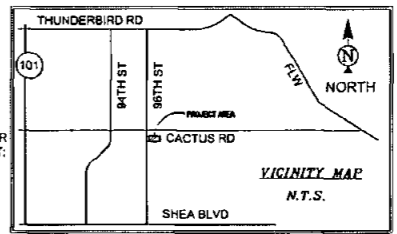


**DRIVING DIRECTIONS**

TAKE US80 EAST TO LOOP 101. TAKE LOOP 101 NORTH TO CACTUS ROAD. TURN RIGHT ONTO CACTUS RD AND HEAD EAST TO 96TH STREET. TURN RIGHT ONTO 96TH STREET AND HEAD SOUTH TO DRIVEWAY ON THE LEFT AND SITE.

**GRAPHIC SCALE**

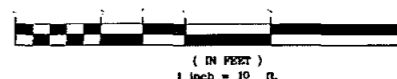

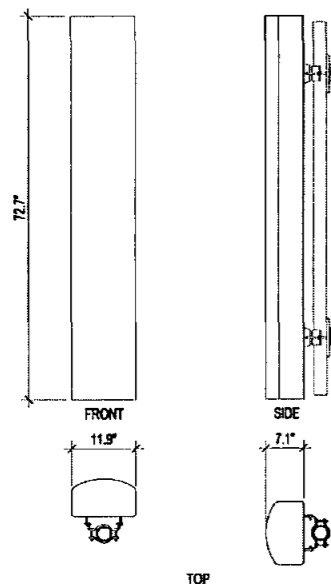

PROPOSED ANTENNA INFORMATION

4


COAXIAL CABLE TABLE					
SECTOR	AZIMUTH	CENTERLINE	QTY.	SIZE	TYPE
ALPHA	90°	23'-0"	8	7/8"	AVAS-50
BETA	180°	23'-0"	8	7/8"	AVAS-50
GAMMA	300°	23'-0"	8	7/8"	AVAS-50

NOTE:  
ALL AZIMUTHS SHOWN ARE RELATIVE TO TRUE NORTH,  
UNLESS NOTED OTHERWISE

IT SHALL BE THE CONTRACTORS RESPONSIBILITY TO VERIFY  
AZIMUTHS DEPICTED HEREIN WITH RF DEPARTMENT PRIOR  
TO INSTALLING ANTENNAS.


COAX CABLE INFORMATION

3

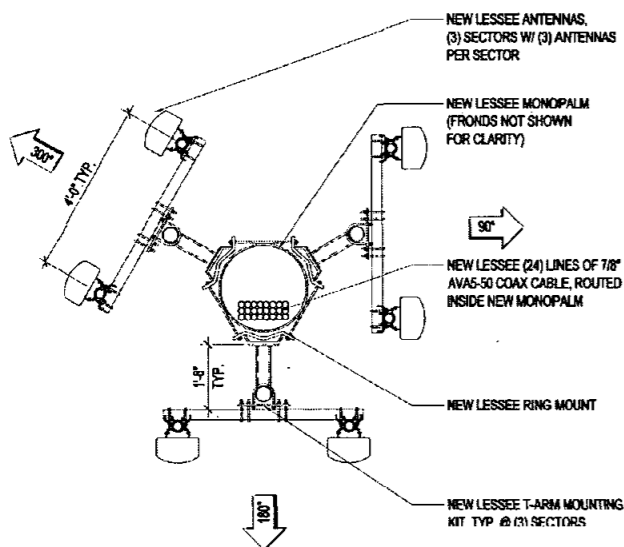

NEW ANTENNA CONFIGURATION


2

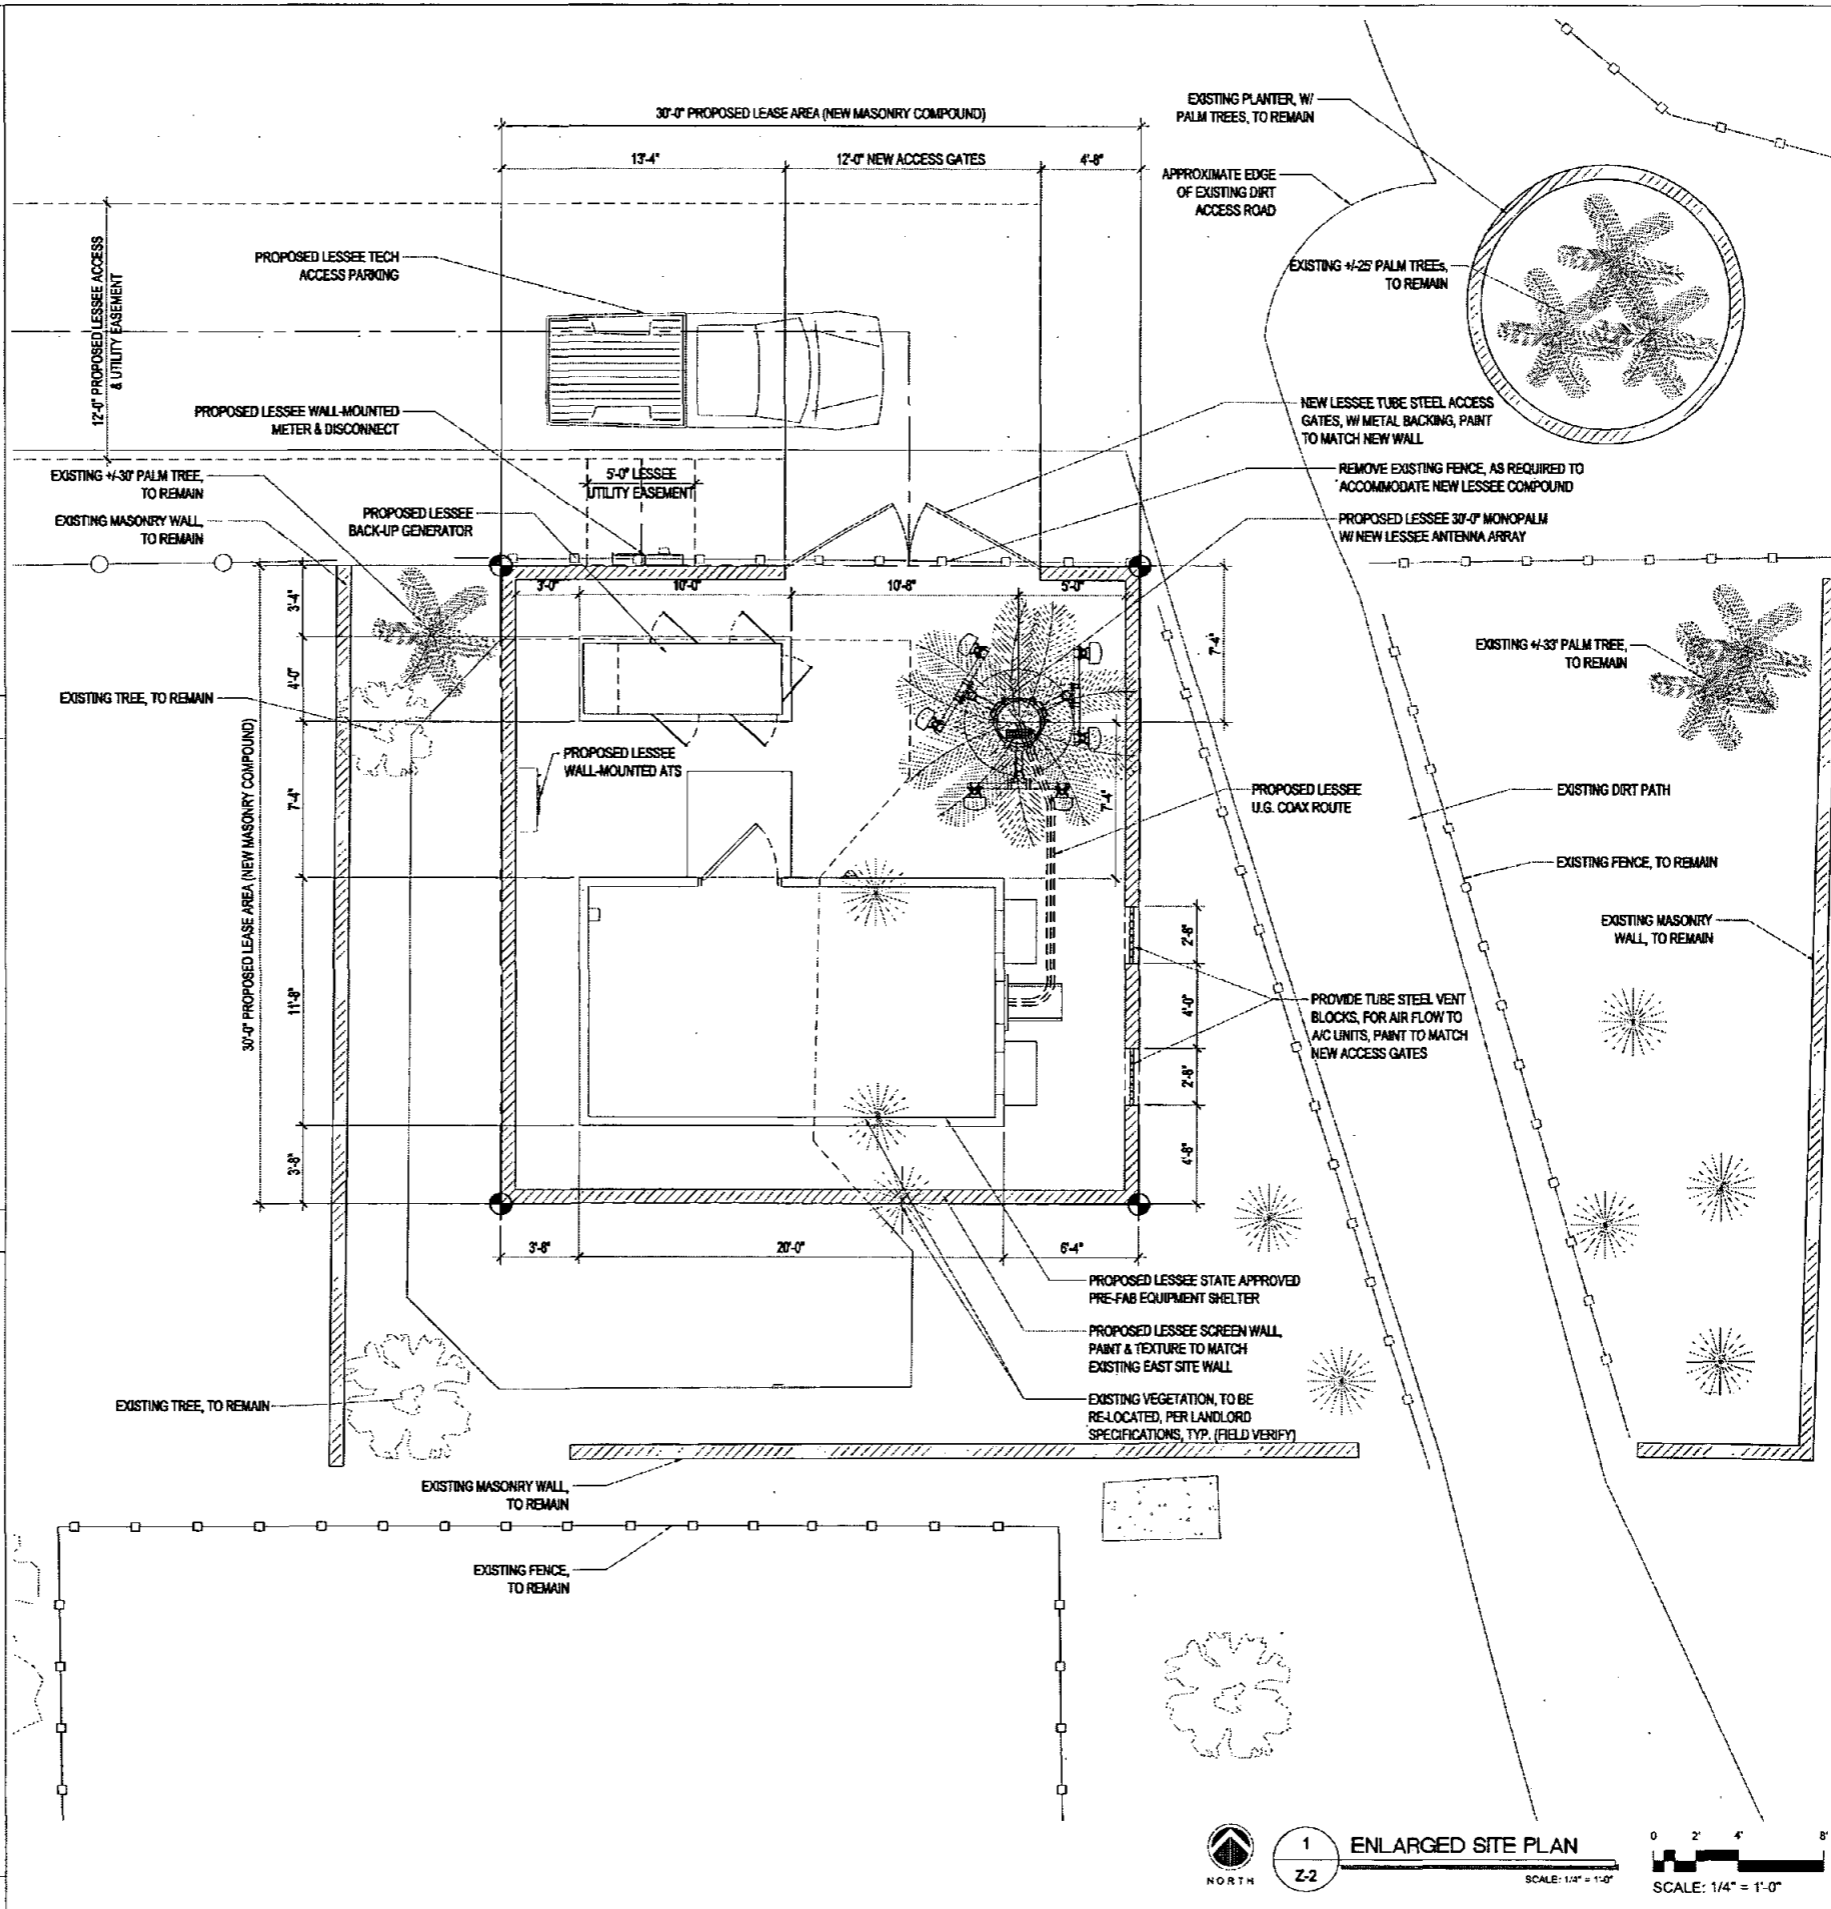

1  
Z-2

ENLARGED SITE PLAN

SCALE: 1/4" = 1'-0"

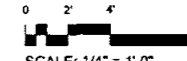

SCALE: 1/4" = 1'-0"

CLIENT  
**verizon wireless**  
126 W. GEMINI DR.  
TEMPE, AZ 85283

INTERNAL REVIEW \_\_\_\_\_ DATE \_\_\_\_\_  
CONSTRUCTION SIGNATURE \_\_\_\_\_  
RF SIGNATURE \_\_\_\_\_  
REAL ESTATE SIGNATURE \_\_\_\_\_

PLANS PREPARED BY  
**Young design corp**  
architecture / project management  
10245 E. Via Linda, Scottsdale, AZ 85258  
ph: 480 451 9609 fax: 480 451 9608  
e-mail: corporate@ydcollc.com

SEAL  
This drawing is copyrighted and the property of Young Design Corporation (YDC) & produced solely by YDC and affiliates. reproduction or use of this drawing and/or the information contained hereon is forbidden without written permission by Young Design Corporation.



PRELIMINARY UNLESS NOTED  
NO. \_\_\_\_\_ DATE \_\_\_\_\_ DESCRIPTION \_\_\_\_\_  
1 11/22/11 FINAL ISSUE

NO.	DATE	DESCRIPTION
1	11/22/11	FINAL ISSUE


ARCHITECTS JOB NO.  
YDC-3035

PROJECT INFORMATION  
**PHO\_CINCO SOLES**  
12051 N 98th STREET  
SCOTTSDALE, ARIZONA, 85260


SHEET TITLE  
**ENLARGED SITE PLAN  
SITE DETAILS**

JURISDICTION APPROVAL \_\_\_\_\_

SHEET NUMBER  
**Z-2**

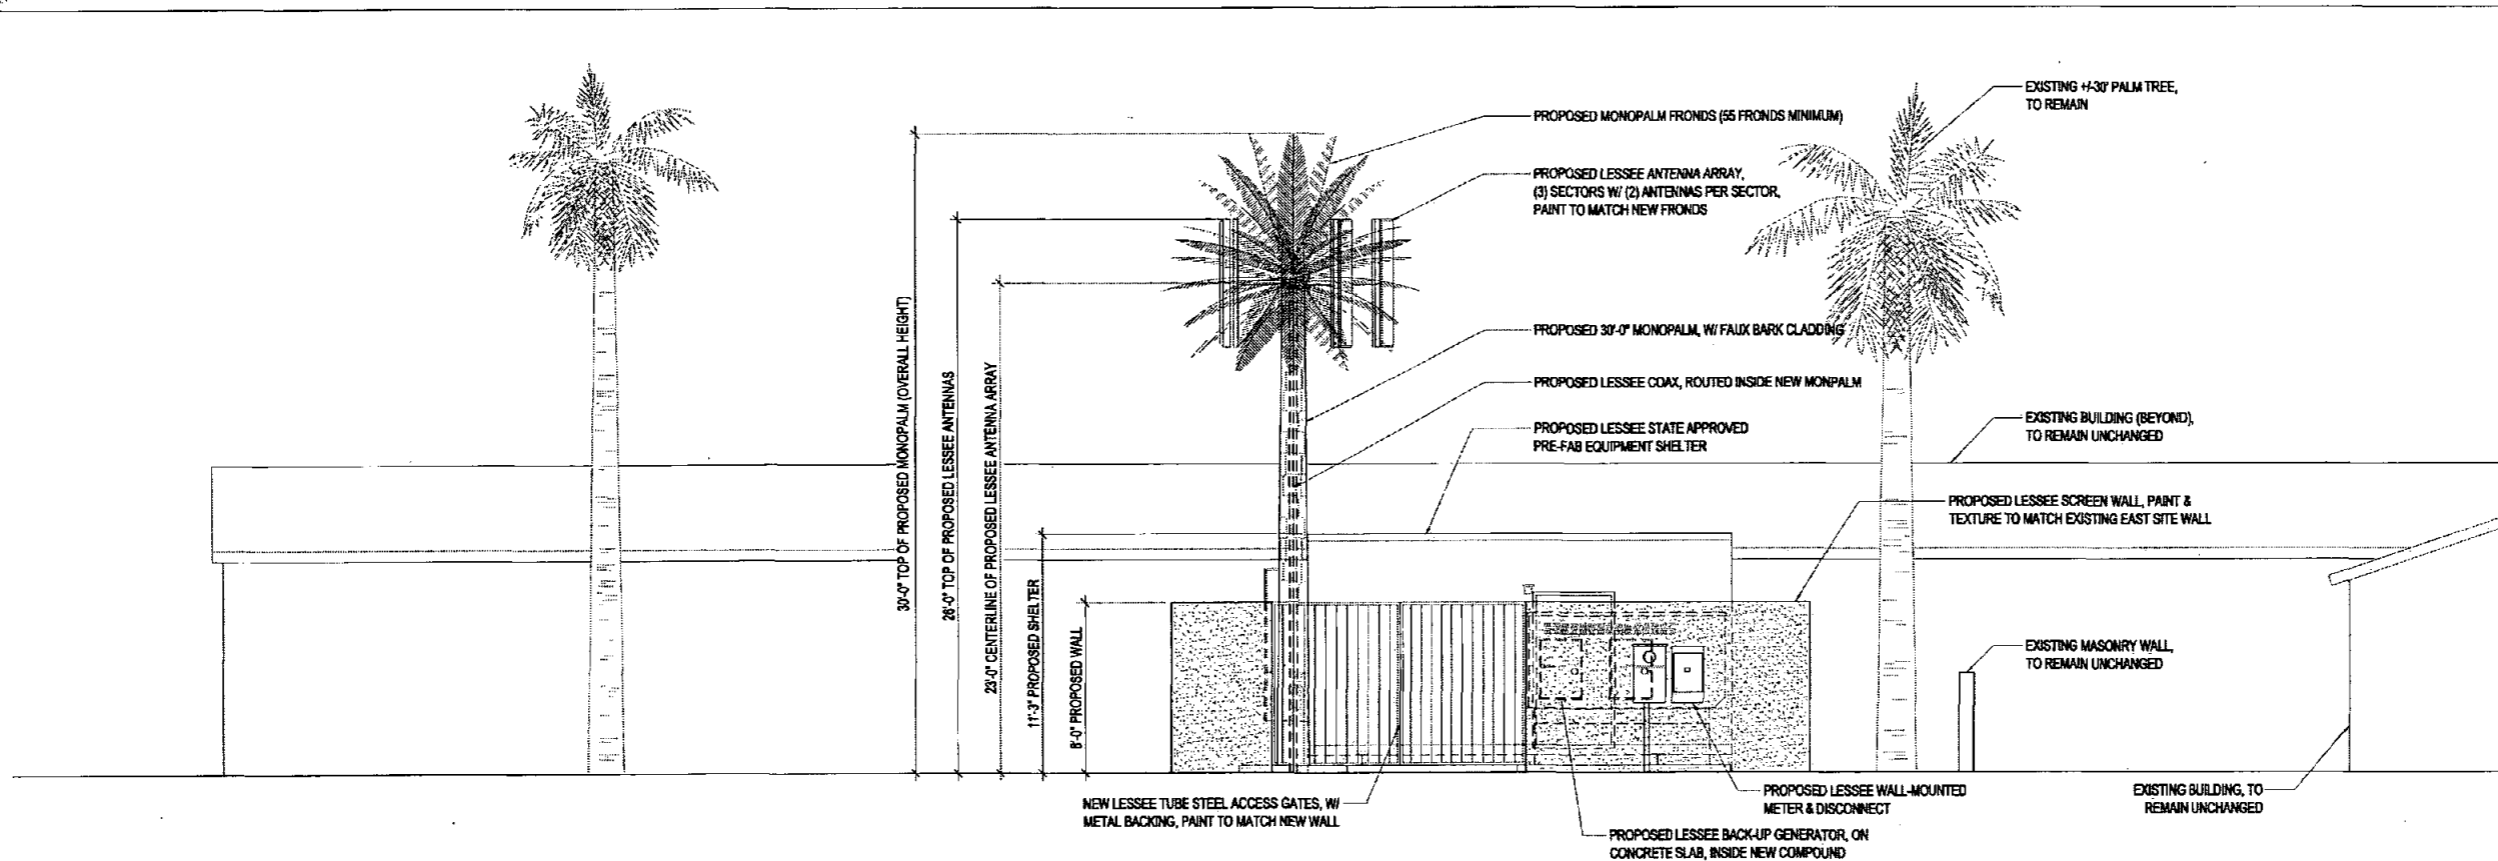

2 NORTH ELEVATION  
 Z-3  
 SCALE: 1/4" = 1'-0"  
 0 2 4 8  
 SCALE: 1/4" = 1'-0"

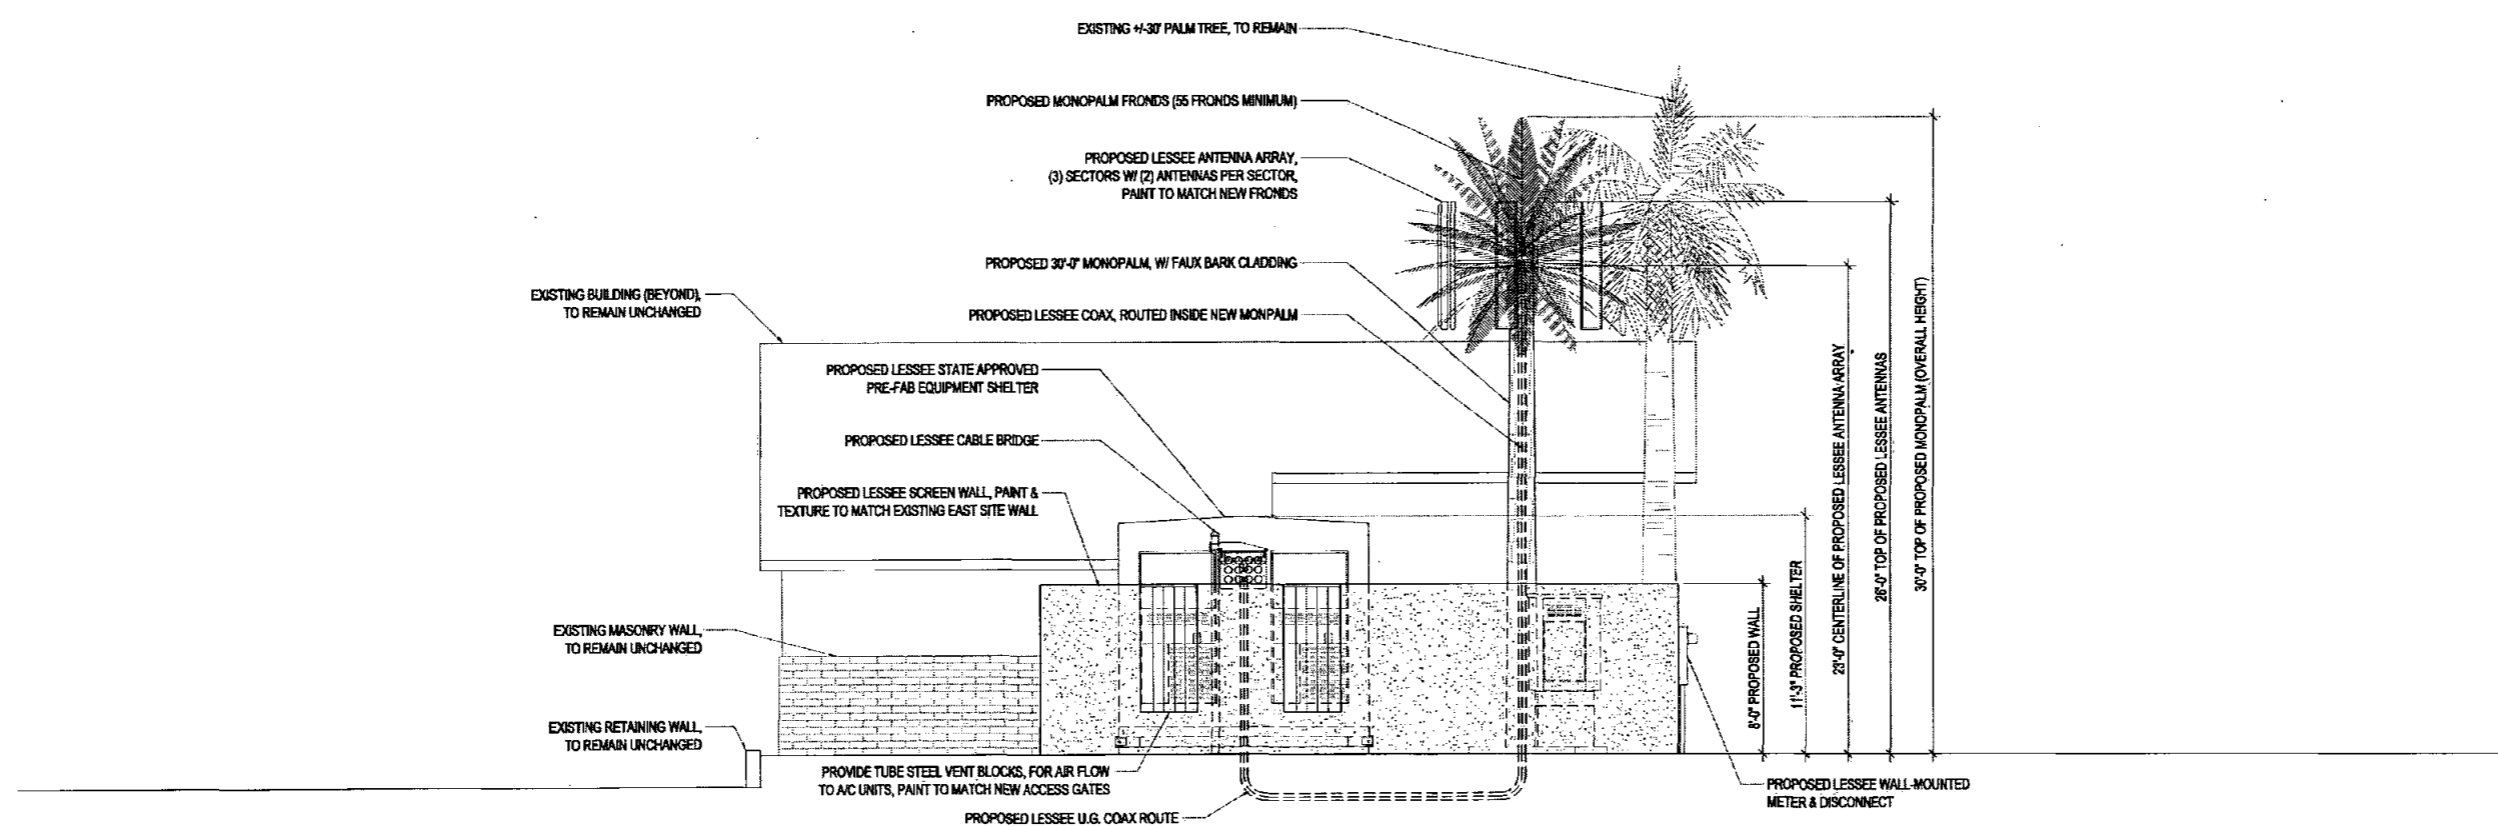

1 EAST ELEVATION  
 Z-3  
 SCALE: 1/4" = 1'-0"  
 0 2 4 8  
 SCALE: 1/4" = 1'-0"

CLIENT  
**verizon wireless**  
 126 W. GEMINI DR.  
 TEMPE, AZ 85283

INTERNAL REVIEW \_\_\_\_\_ DATE \_\_\_\_\_  
 CONSTRUCTION SIGNATURE \_\_\_\_\_  
 RF SIGNATURE \_\_\_\_\_  
 REAL ESTATE SIGNATURE \_\_\_\_\_

PLANS PREPARED BY  
**young design corp**  
 architecture / project management  
 10245 E. Via Linda, Scottsdale, AZ 85258  
 ph: 480 451 9609 fax: 480 451 9608  
 e-mail: corporate@ydcoffice.com

SEAL  
 This drawing is copyrighted and the property of Young Design Corporation (YDC) & produced solely by YDC and affiliates. reproduction or use of this drawing and/or the information contained herein is forbidden without written permission by Young Design Corporation.  
  
 EXP. 12/31/13  
 THIS DOCUMENT CONTAINS AN ELECTRONIC SIGNATURE. PURSUANT TO A.R.S. TITLE 31 AND TITLE 45, IT IS A VIOLATION FOR ANY PERSON, UNLESS UNDER THE DIRECT SUPERVISION OF THE REGISTRANT, TO MODIFY THIS DOCUMENT IN ANY MANNER.  
 PRELIMINARY UNLESS SIGNED

NO.	DATE	DESCRIPTION
1	11/22/11	FINAL ISSUE

ARCHITECTS JOB NO.  
**YDC-3035**

PROJECT INFORMATION  
**PHO\_CINCO SOLES**  
 12051 N 96th STREET  
 SCOTTSDALE, ARIZONA, 85280

SHEET TITLE  
**ELEVATIONS**

JURISDICTION APPROVAL \_\_\_\_\_

SHEET NUMBER  
**Z-3**