




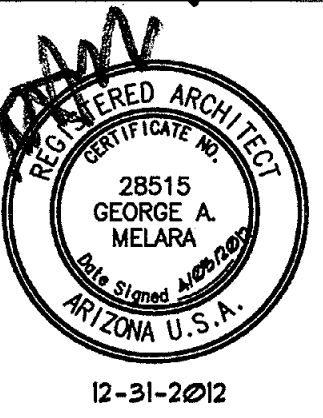

**RESTORATION HARDWARE
at Scottsdale Quarter**
15015 N. Scottsdale Road
SCOTTSDALE, ARIZONA

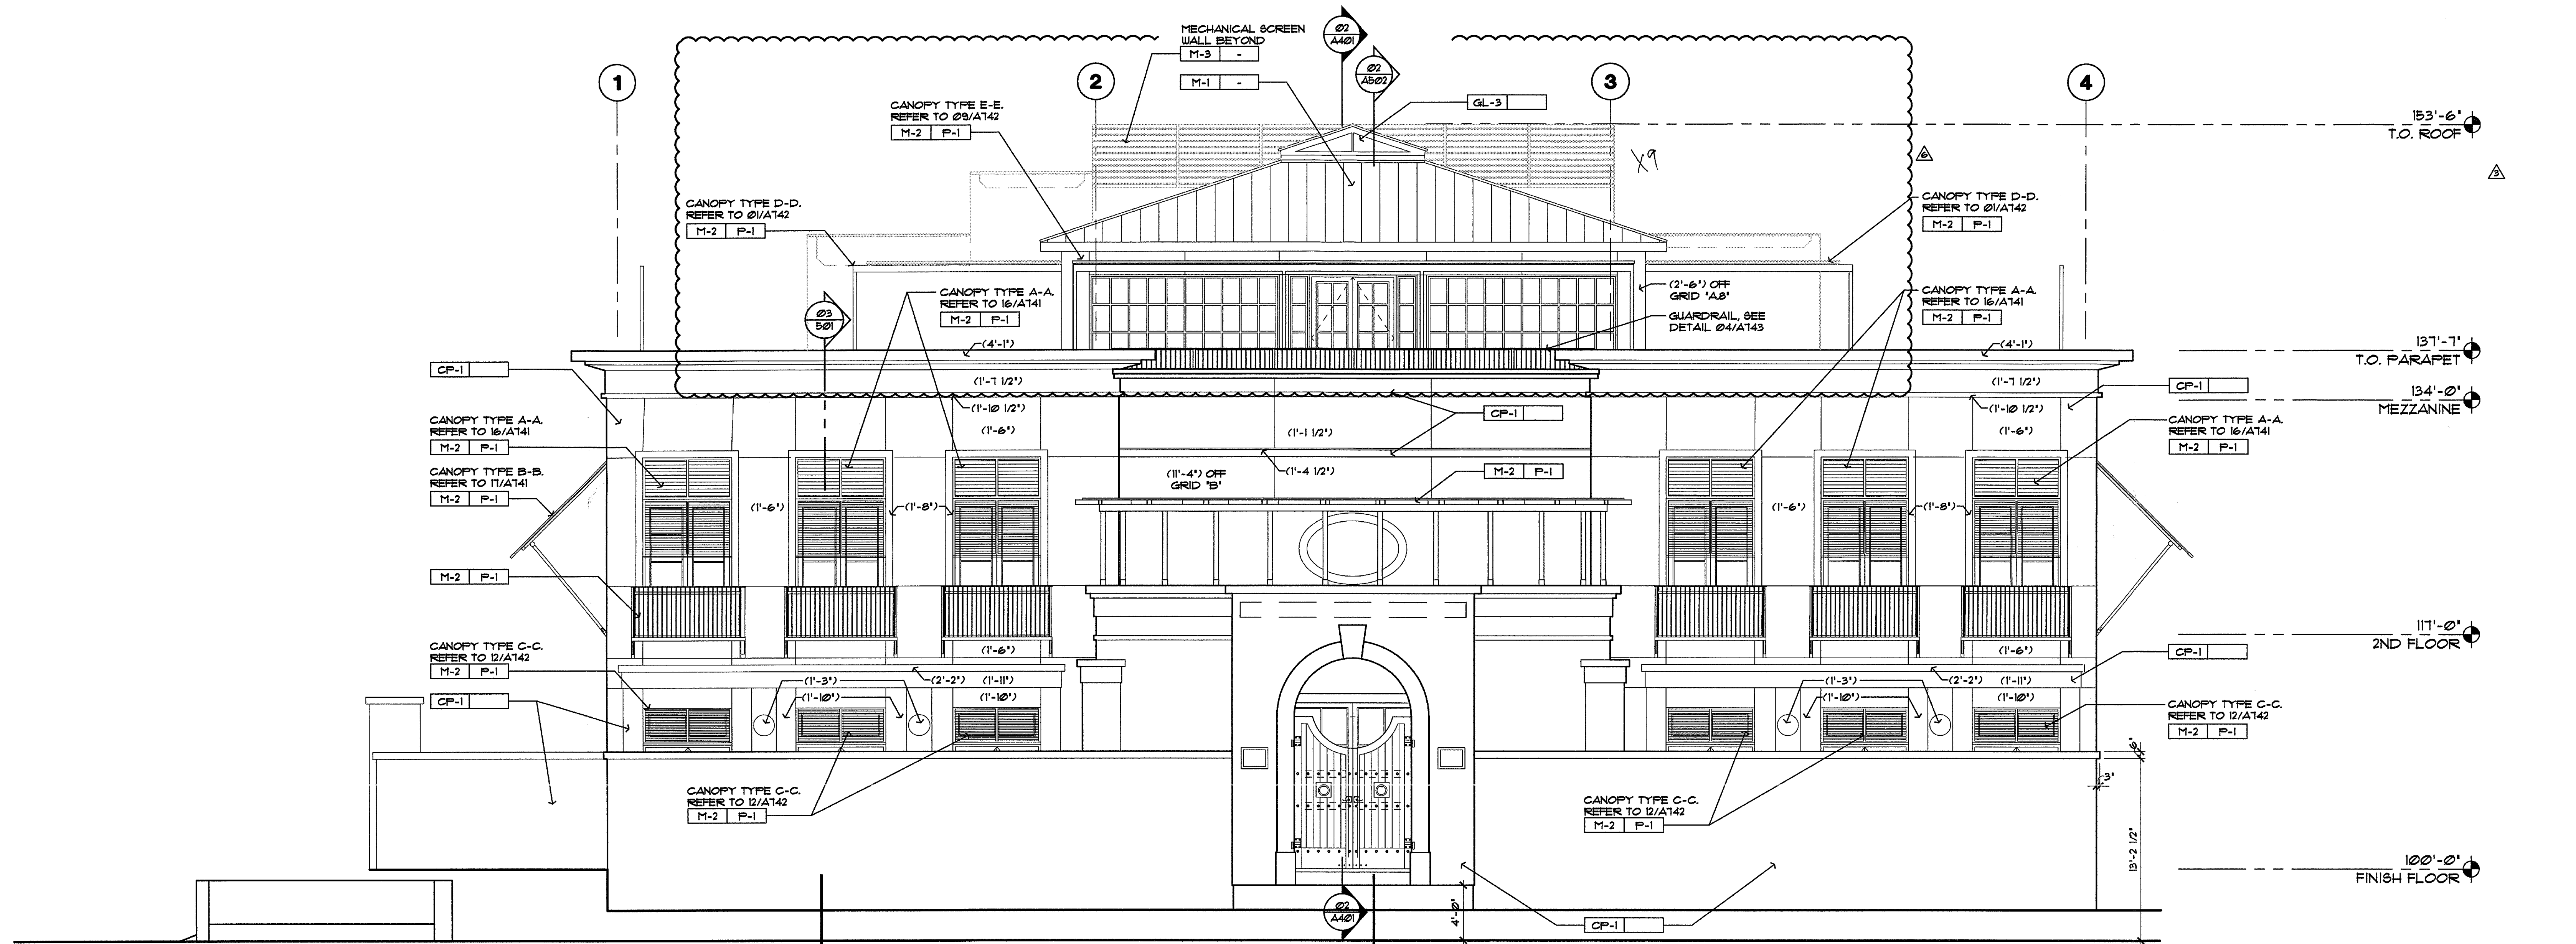


ELEVATION NOTES
1. SITE WALLS ARE NOT PART OF THIS REVIEW.
2. (X'-X') EQUALS THE DISTANCE FROM FACE OF FINISH TO THE NEAREST ADJACENT GRIDLINE, UNO.

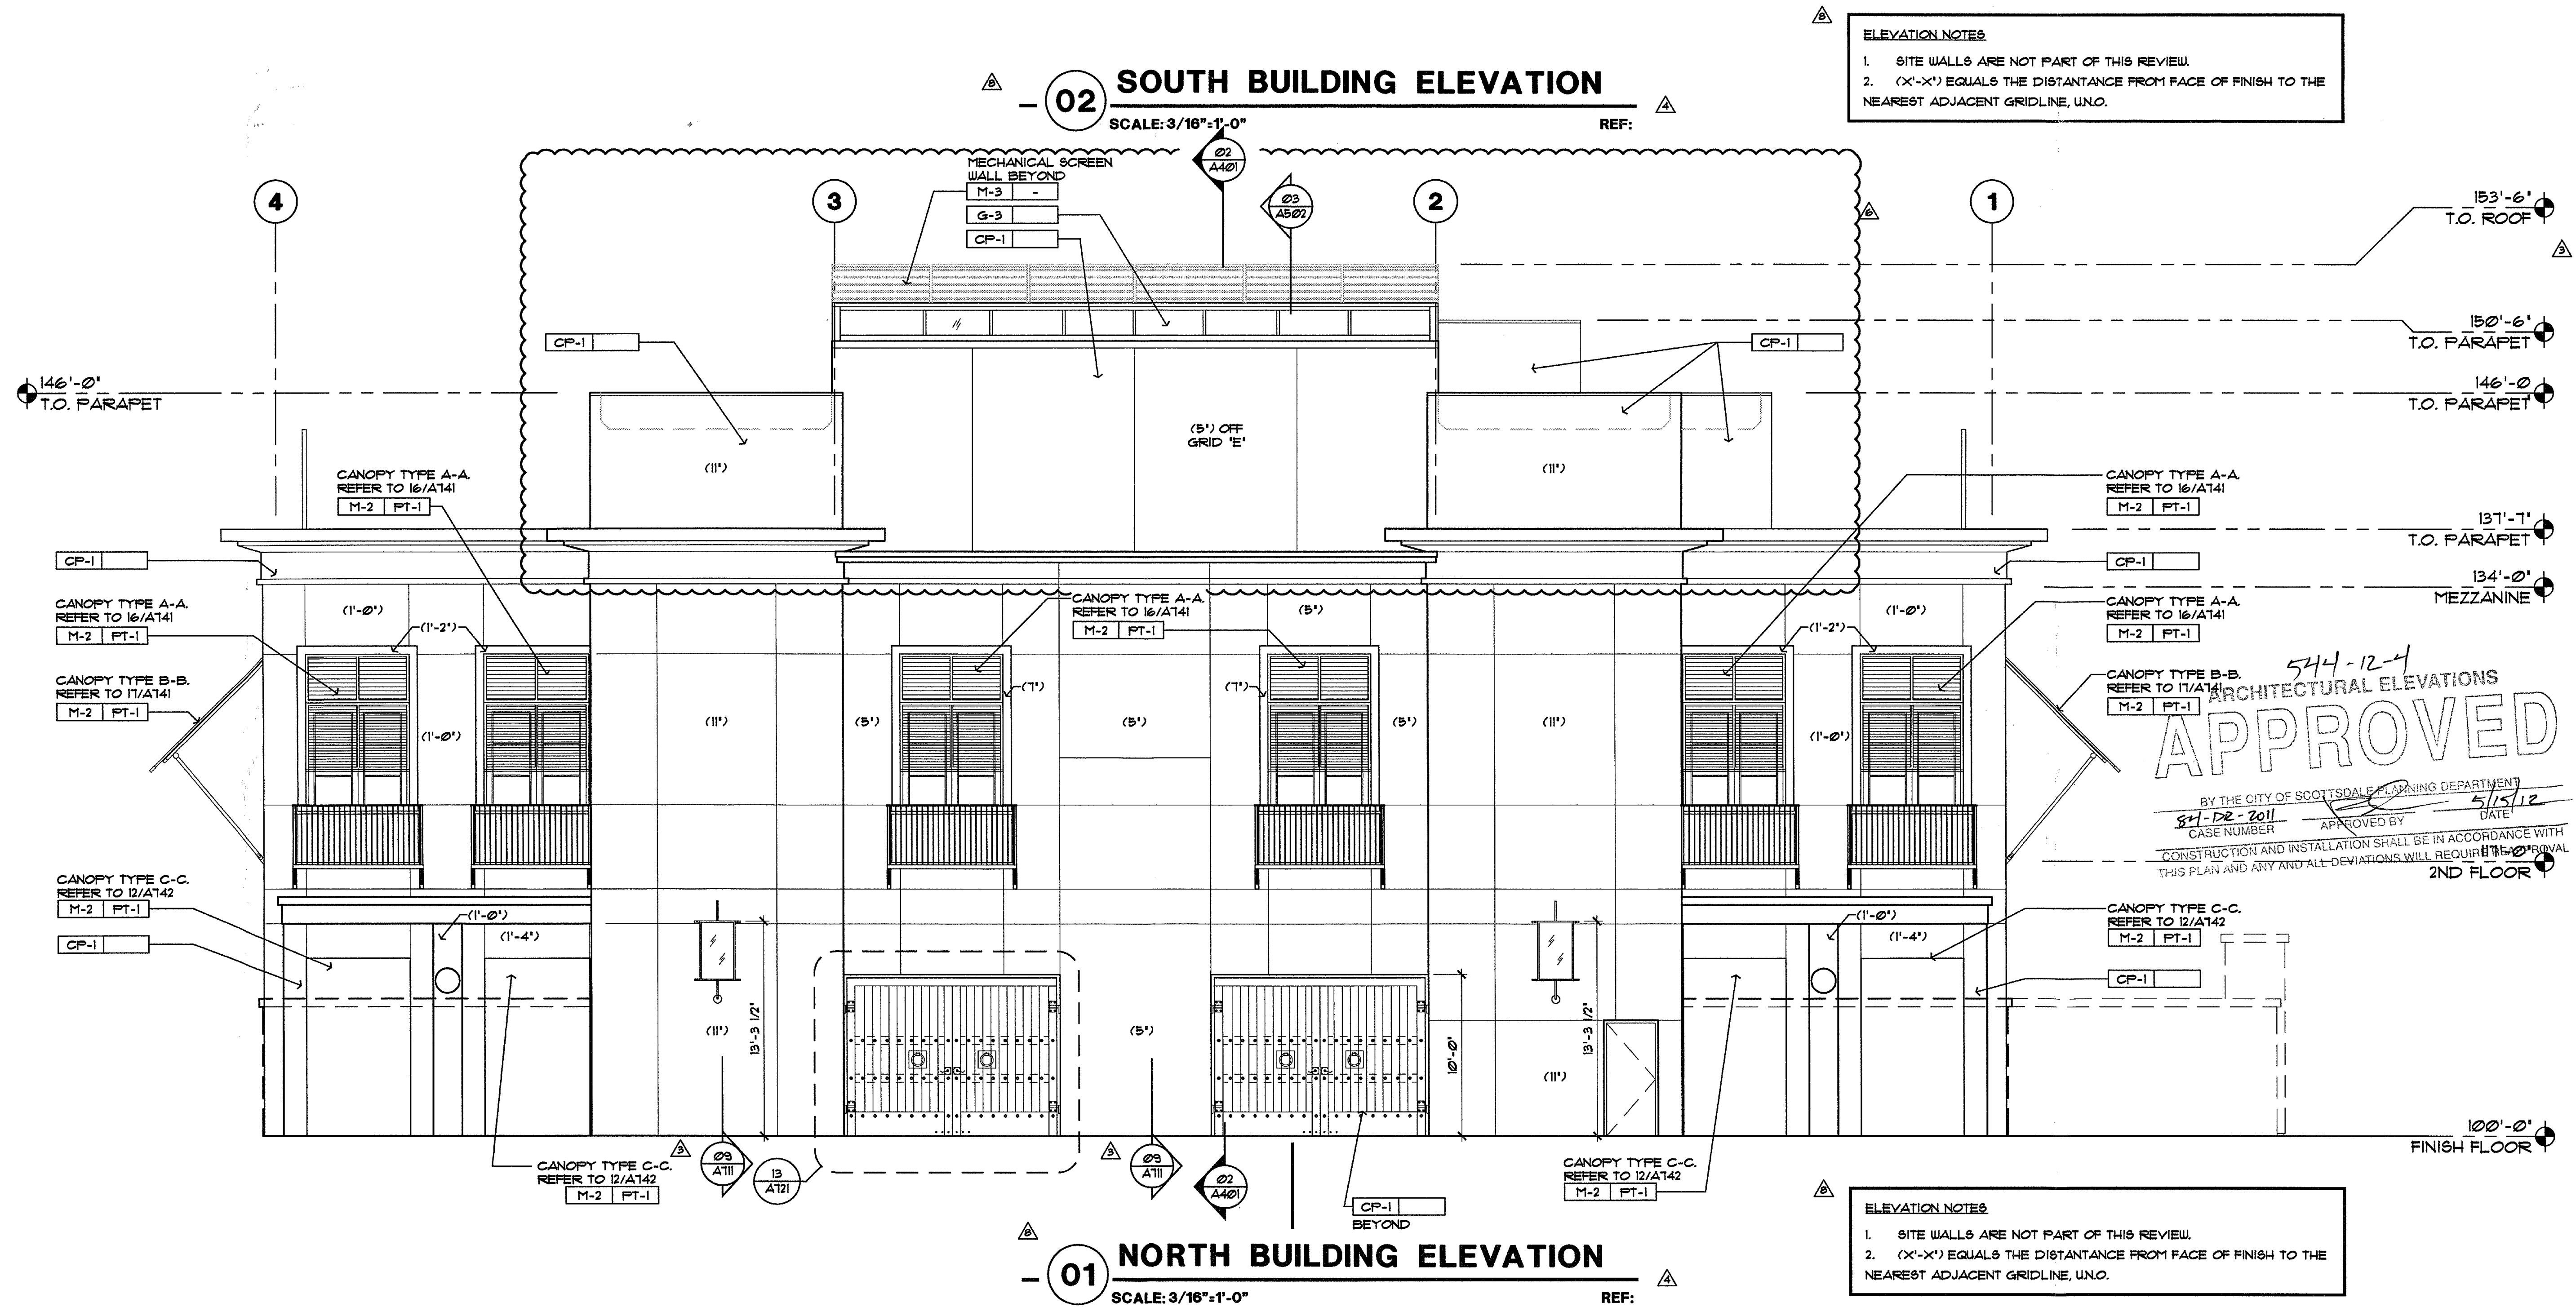


ELEVATION NOTES
1. SITE WALLS ARE NOT PART OF THIS REVIEW.
2. (X'-X') EQUALS THE DISTANCE FROM FACE OF FINISH TO THE NEAREST ADJACENT GRIDLINE, UNO.

544-12-4
APPROVED
ARCHITECTURAL ELEVATIONS
BY THE CITY OF SCOTTSDALE PLANNING DEPARTMENT
DATE 5/15/12
CASE NUMBER 84-DE-2011
CONSTRUCTION AND INSTALLATION SHALL BE IN ACCORDANCE WITH THIS PLAN AND ANY ADJACENT DEVIATIONS WILL REQUIRE APPROVAL


Date
28 FEBRUARY 2012
Revisions
30 MARCH 2012 PLAN REVIEW COMMENTS
30 MARCH 2012 COORDINATION
10 MAY 2012 PLANNING COMMENTS

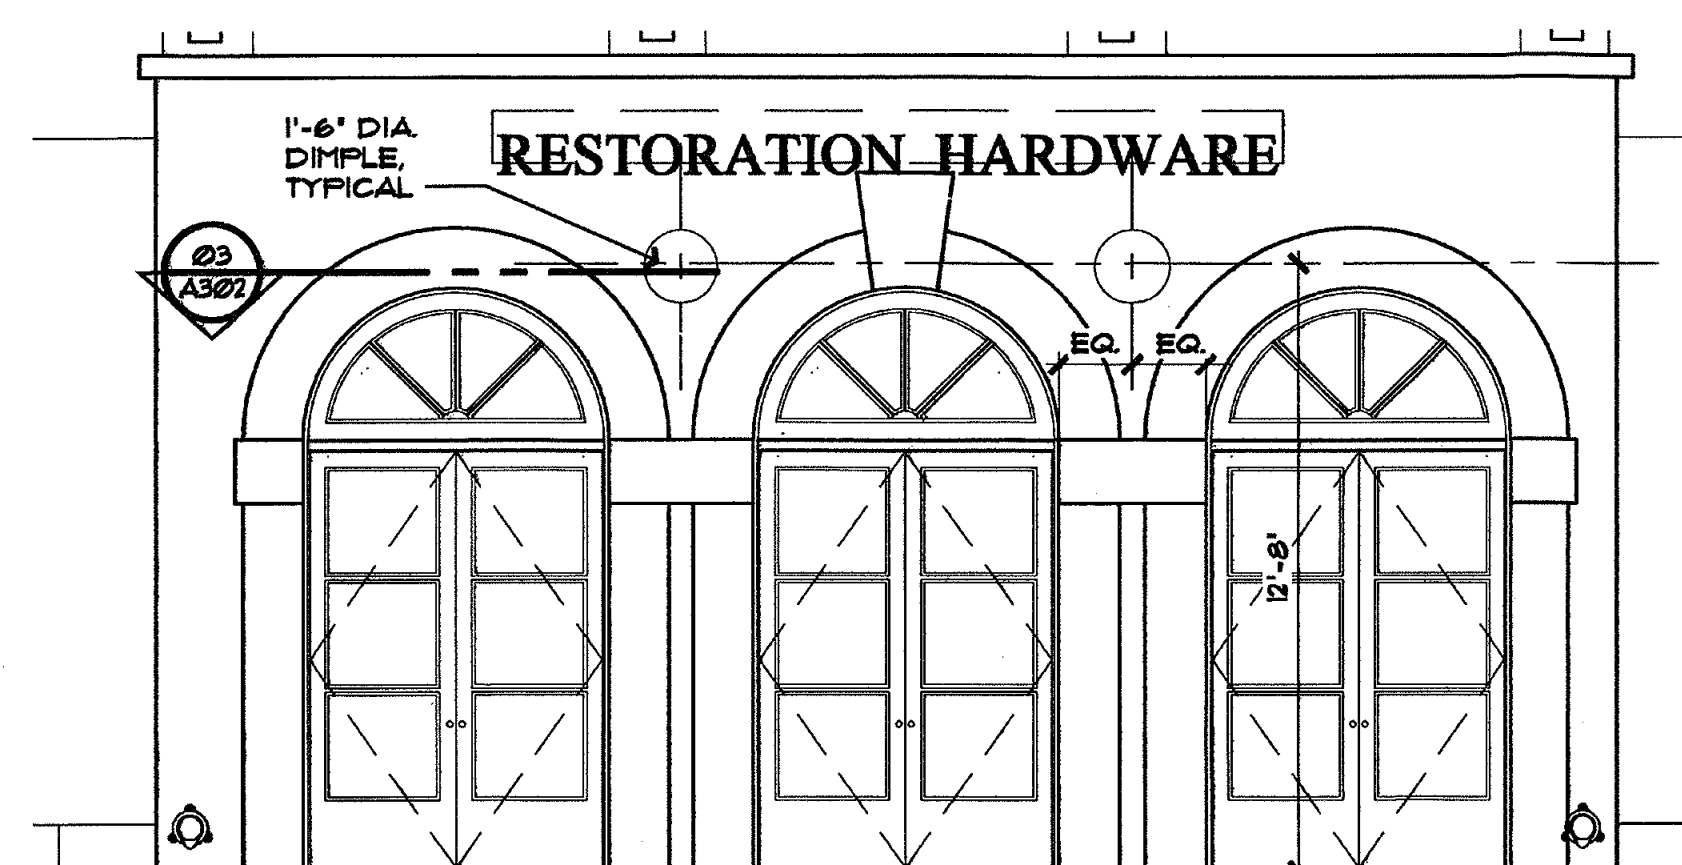


05 PARTIAL ELEVATION
SCALE: 1/4"=1'-0"
REF: 02/A302

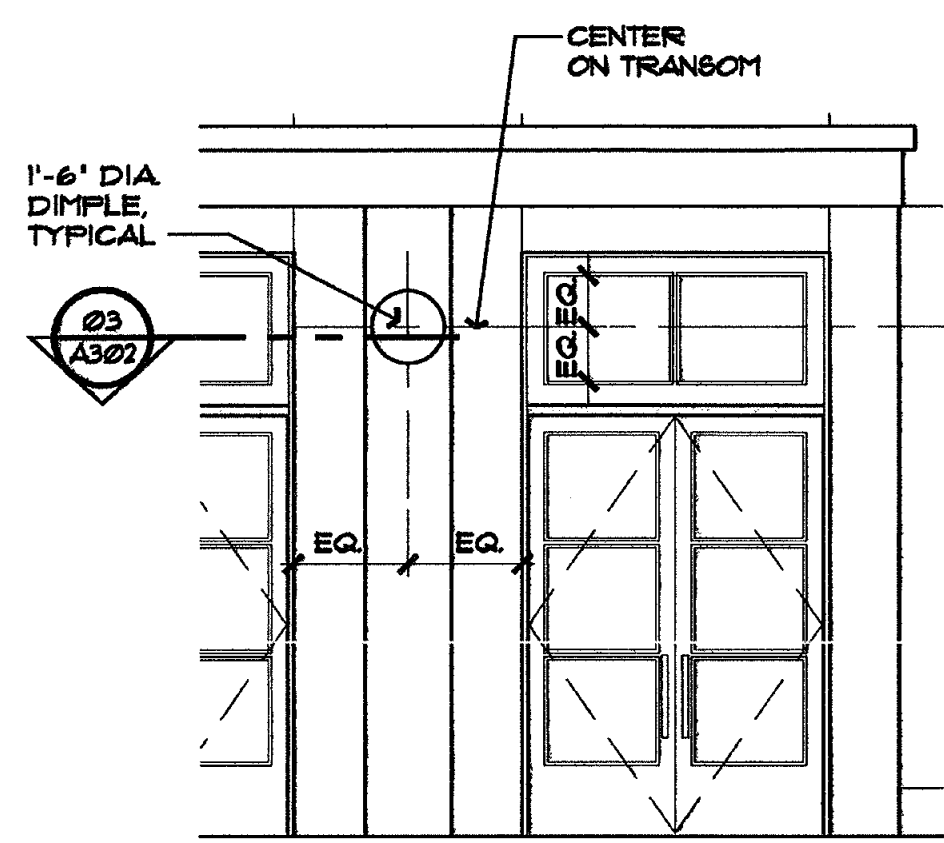

04 PARTIAL ELEVATION
SCALE: 1/4"=1'-0"
REF: 01/A303

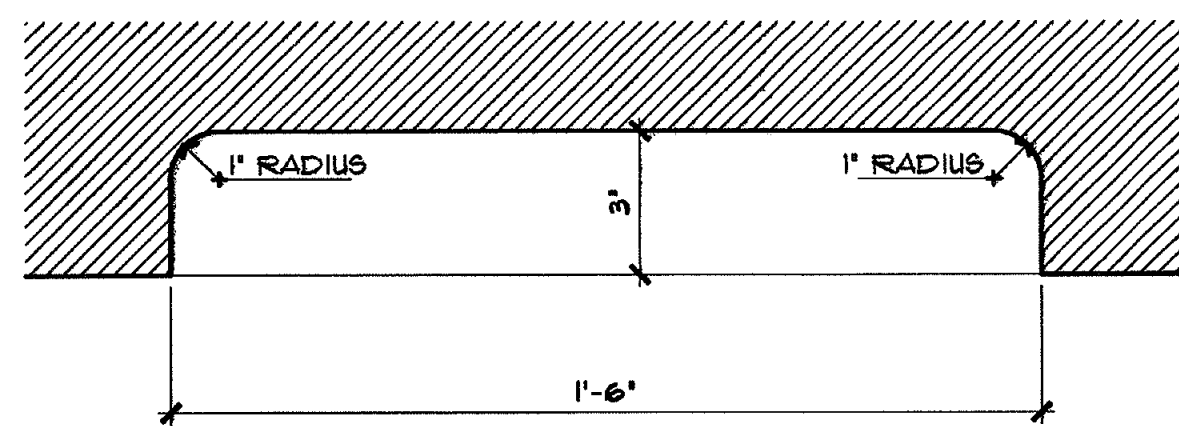


03 DIMPLE DETAIL
SCALE: 3"=1'-0"
REF: 04 & 05/A302

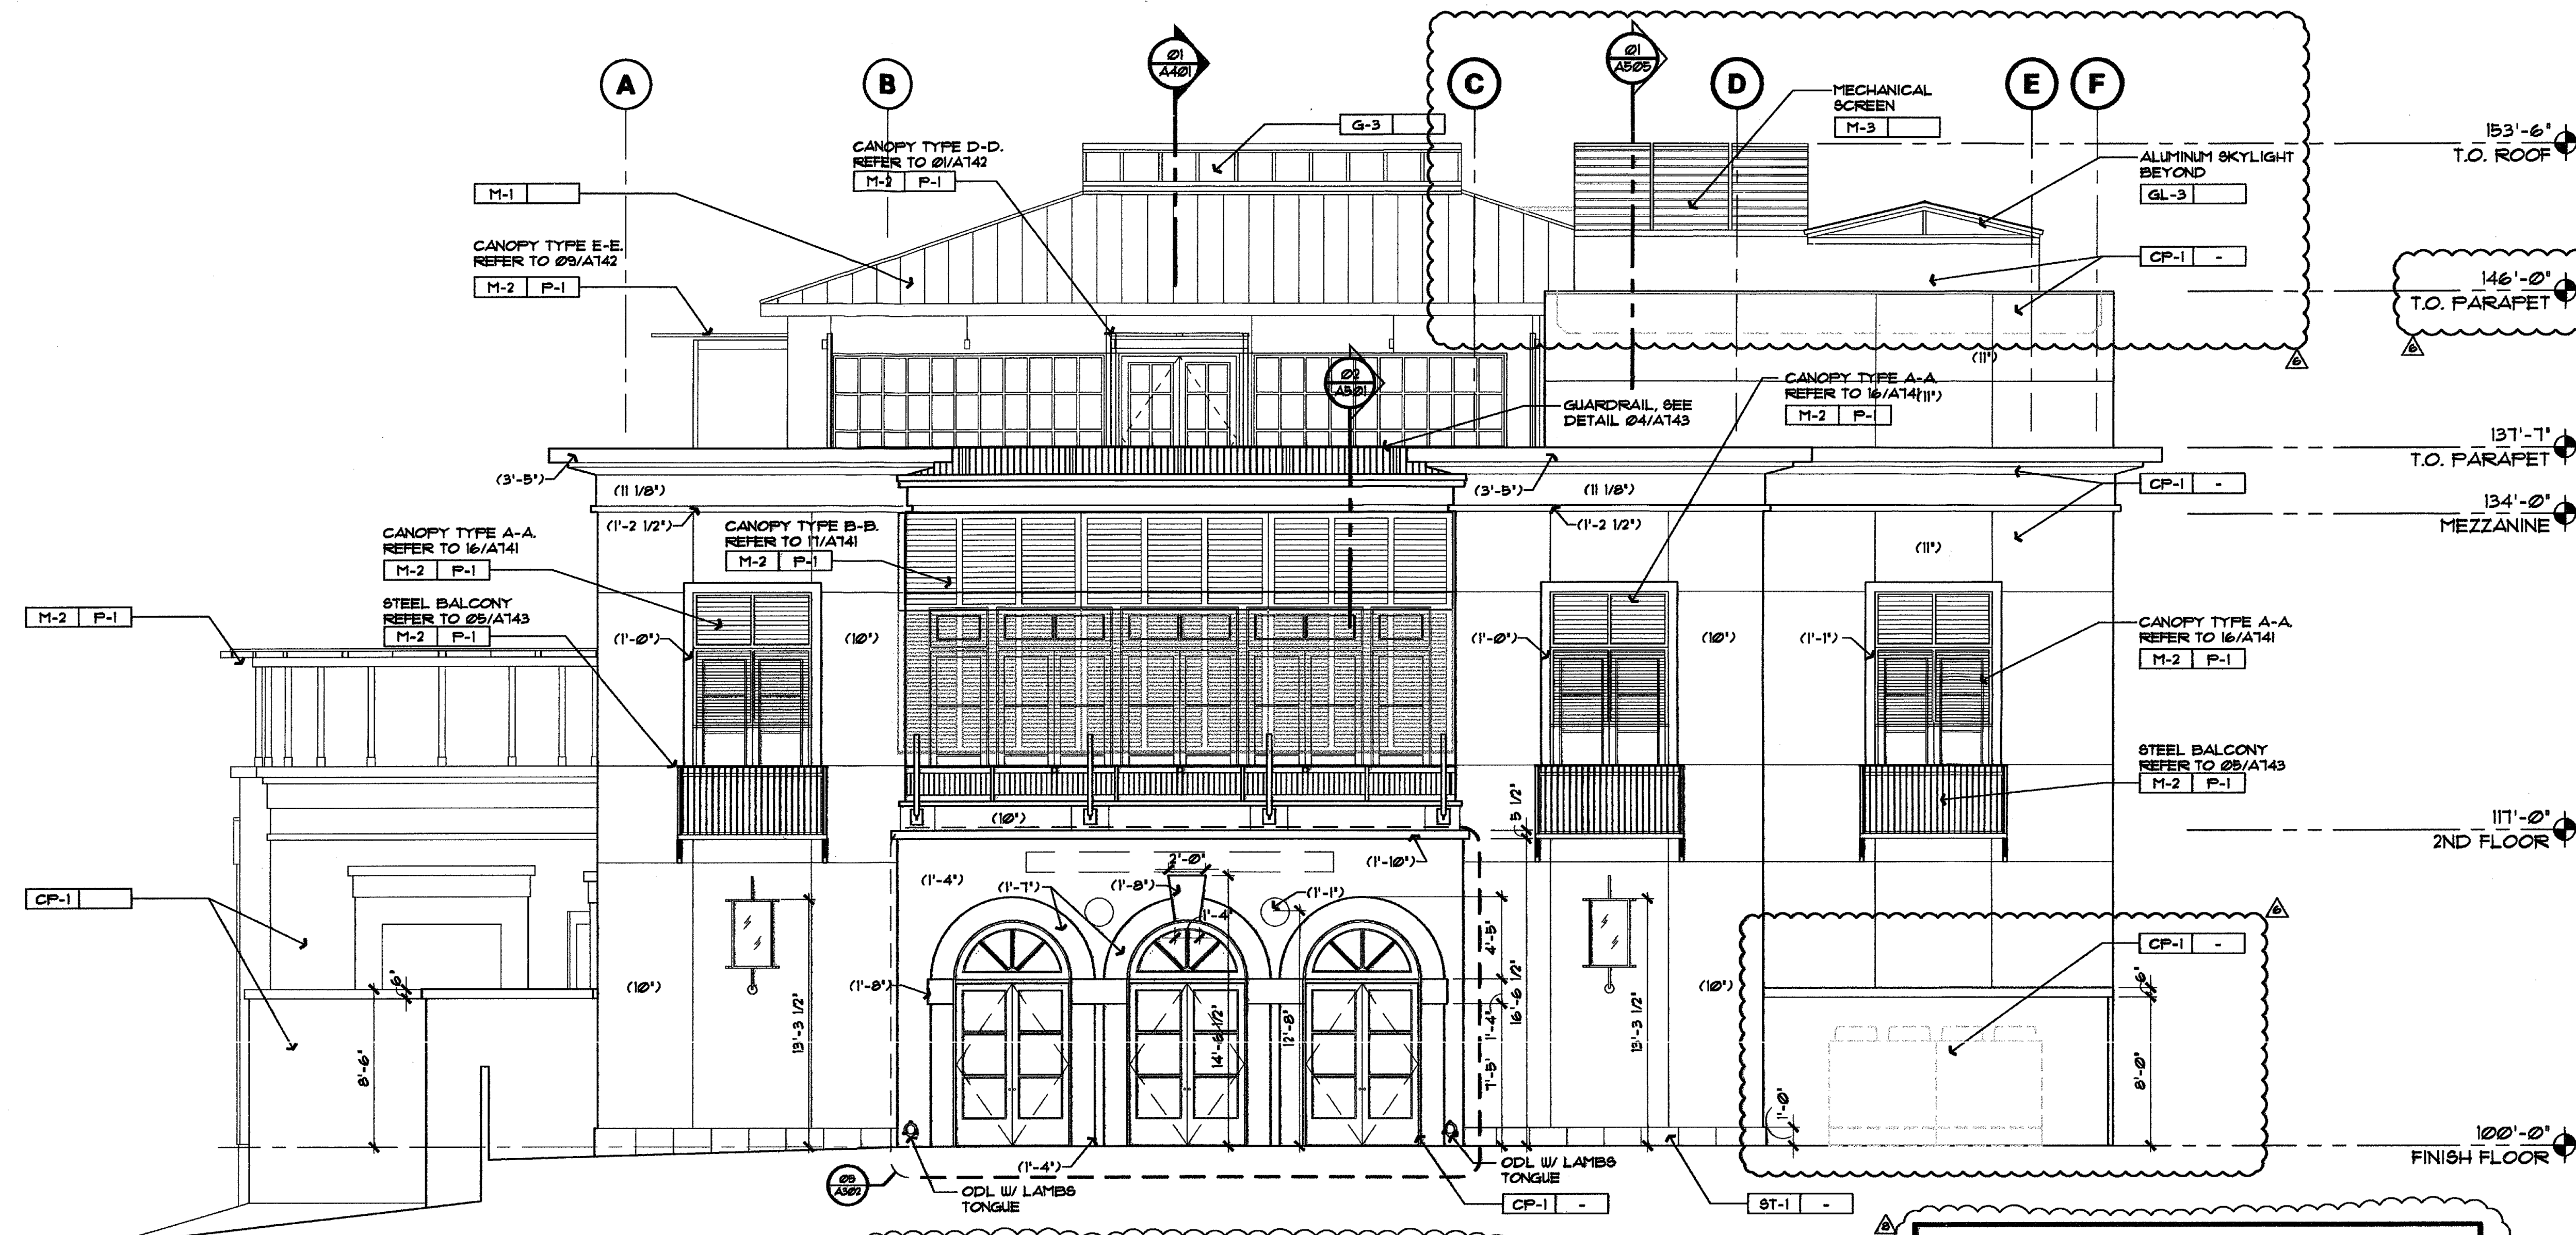

02 EAST BUILDING ELEVATION
SCALE: 3/16"=1'-0"
REF: 01/A201

ELEVATION NOTES
1. SITE WALLS ARE NOT PART OF THIS REVIEW.
2. (X'-X") EQUALS THE DISTANCE FROM FACE OF FINISH TO THE NEAREST ADJACENT GRIDLINE, UNO.

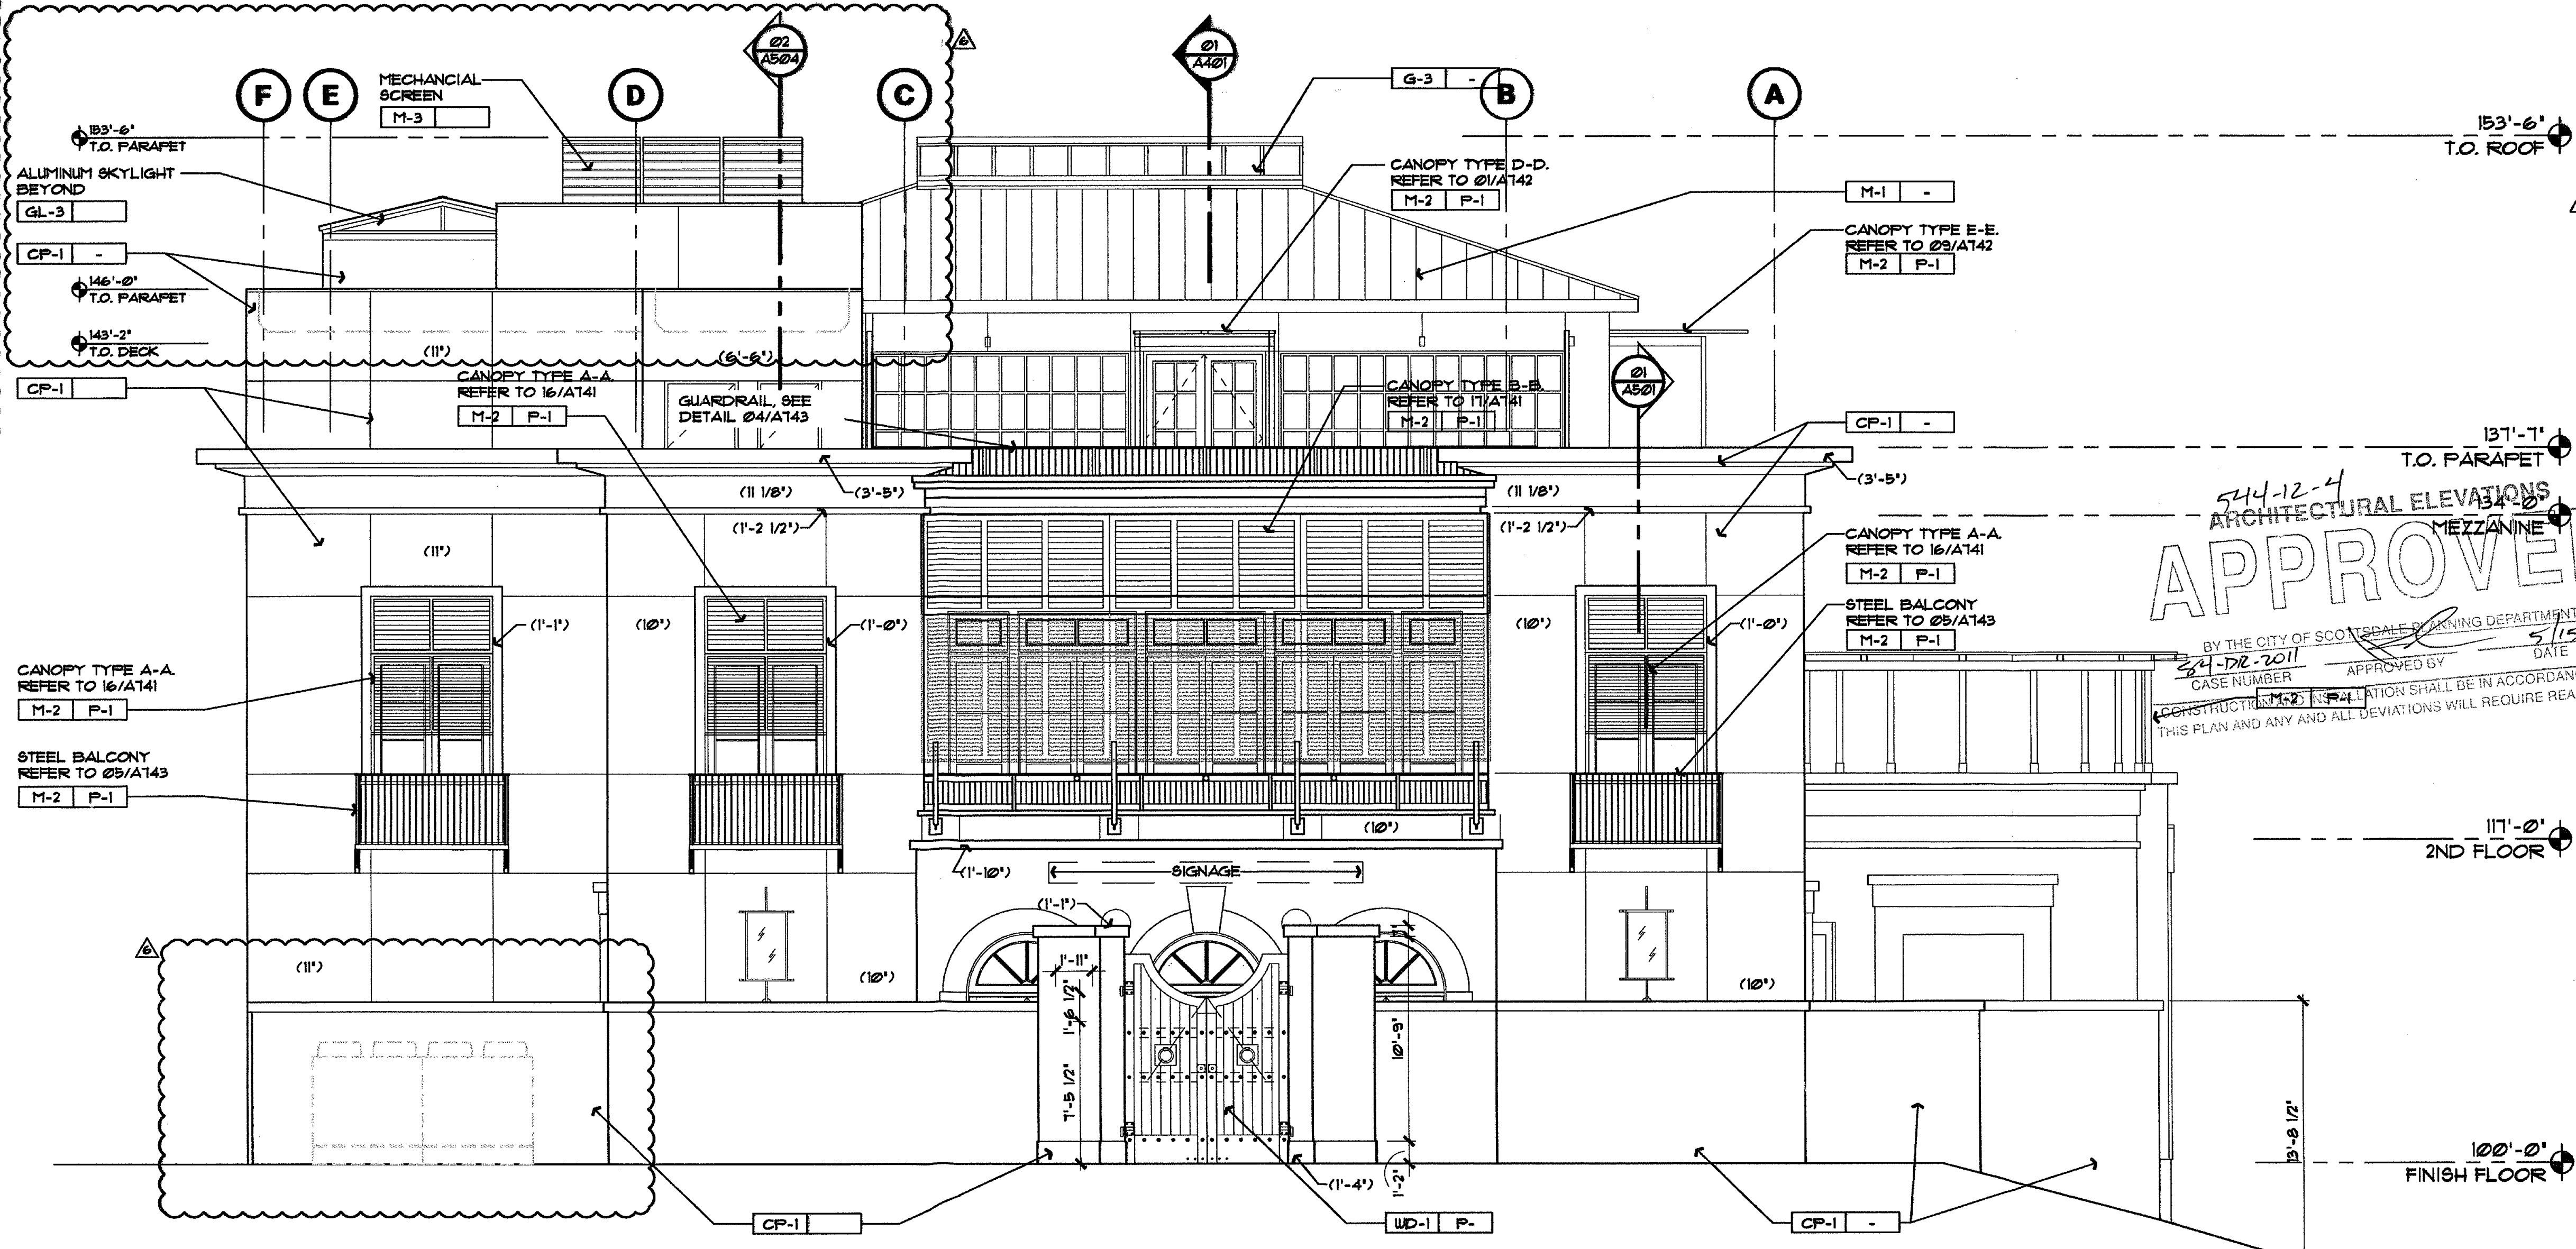


01 WEST BUILDING ELEVATION
SCALE: 3/16"=1'-0"
REF: 01/A201

ELEVATION NOTES
1. SITE WALLS ARE NOT PART OF THIS REVIEW.
2. (X'-X") EQUALS THE DISTANCE FROM FACE OF FINISH TO THE NEAREST ADJACENT GRIDLINE, UNO.

544-12-4
APPROVED
BY THE CITY OF SCOTTSDALE PLANNING DEPARTMENT
DATE 5/15/12
CASE NUMBER 24-172-2011
APPROVED BY
CITY CLERK
THIS PLAN AND ANY AND ALL DEVIATIONS WILL REQUIRE REAPPROVAL




**RESTORATION HARDWARE
at Scottsdale Quarter**
15015 N. Scottsdale Road
SCOTTSDALE, ARIZONA

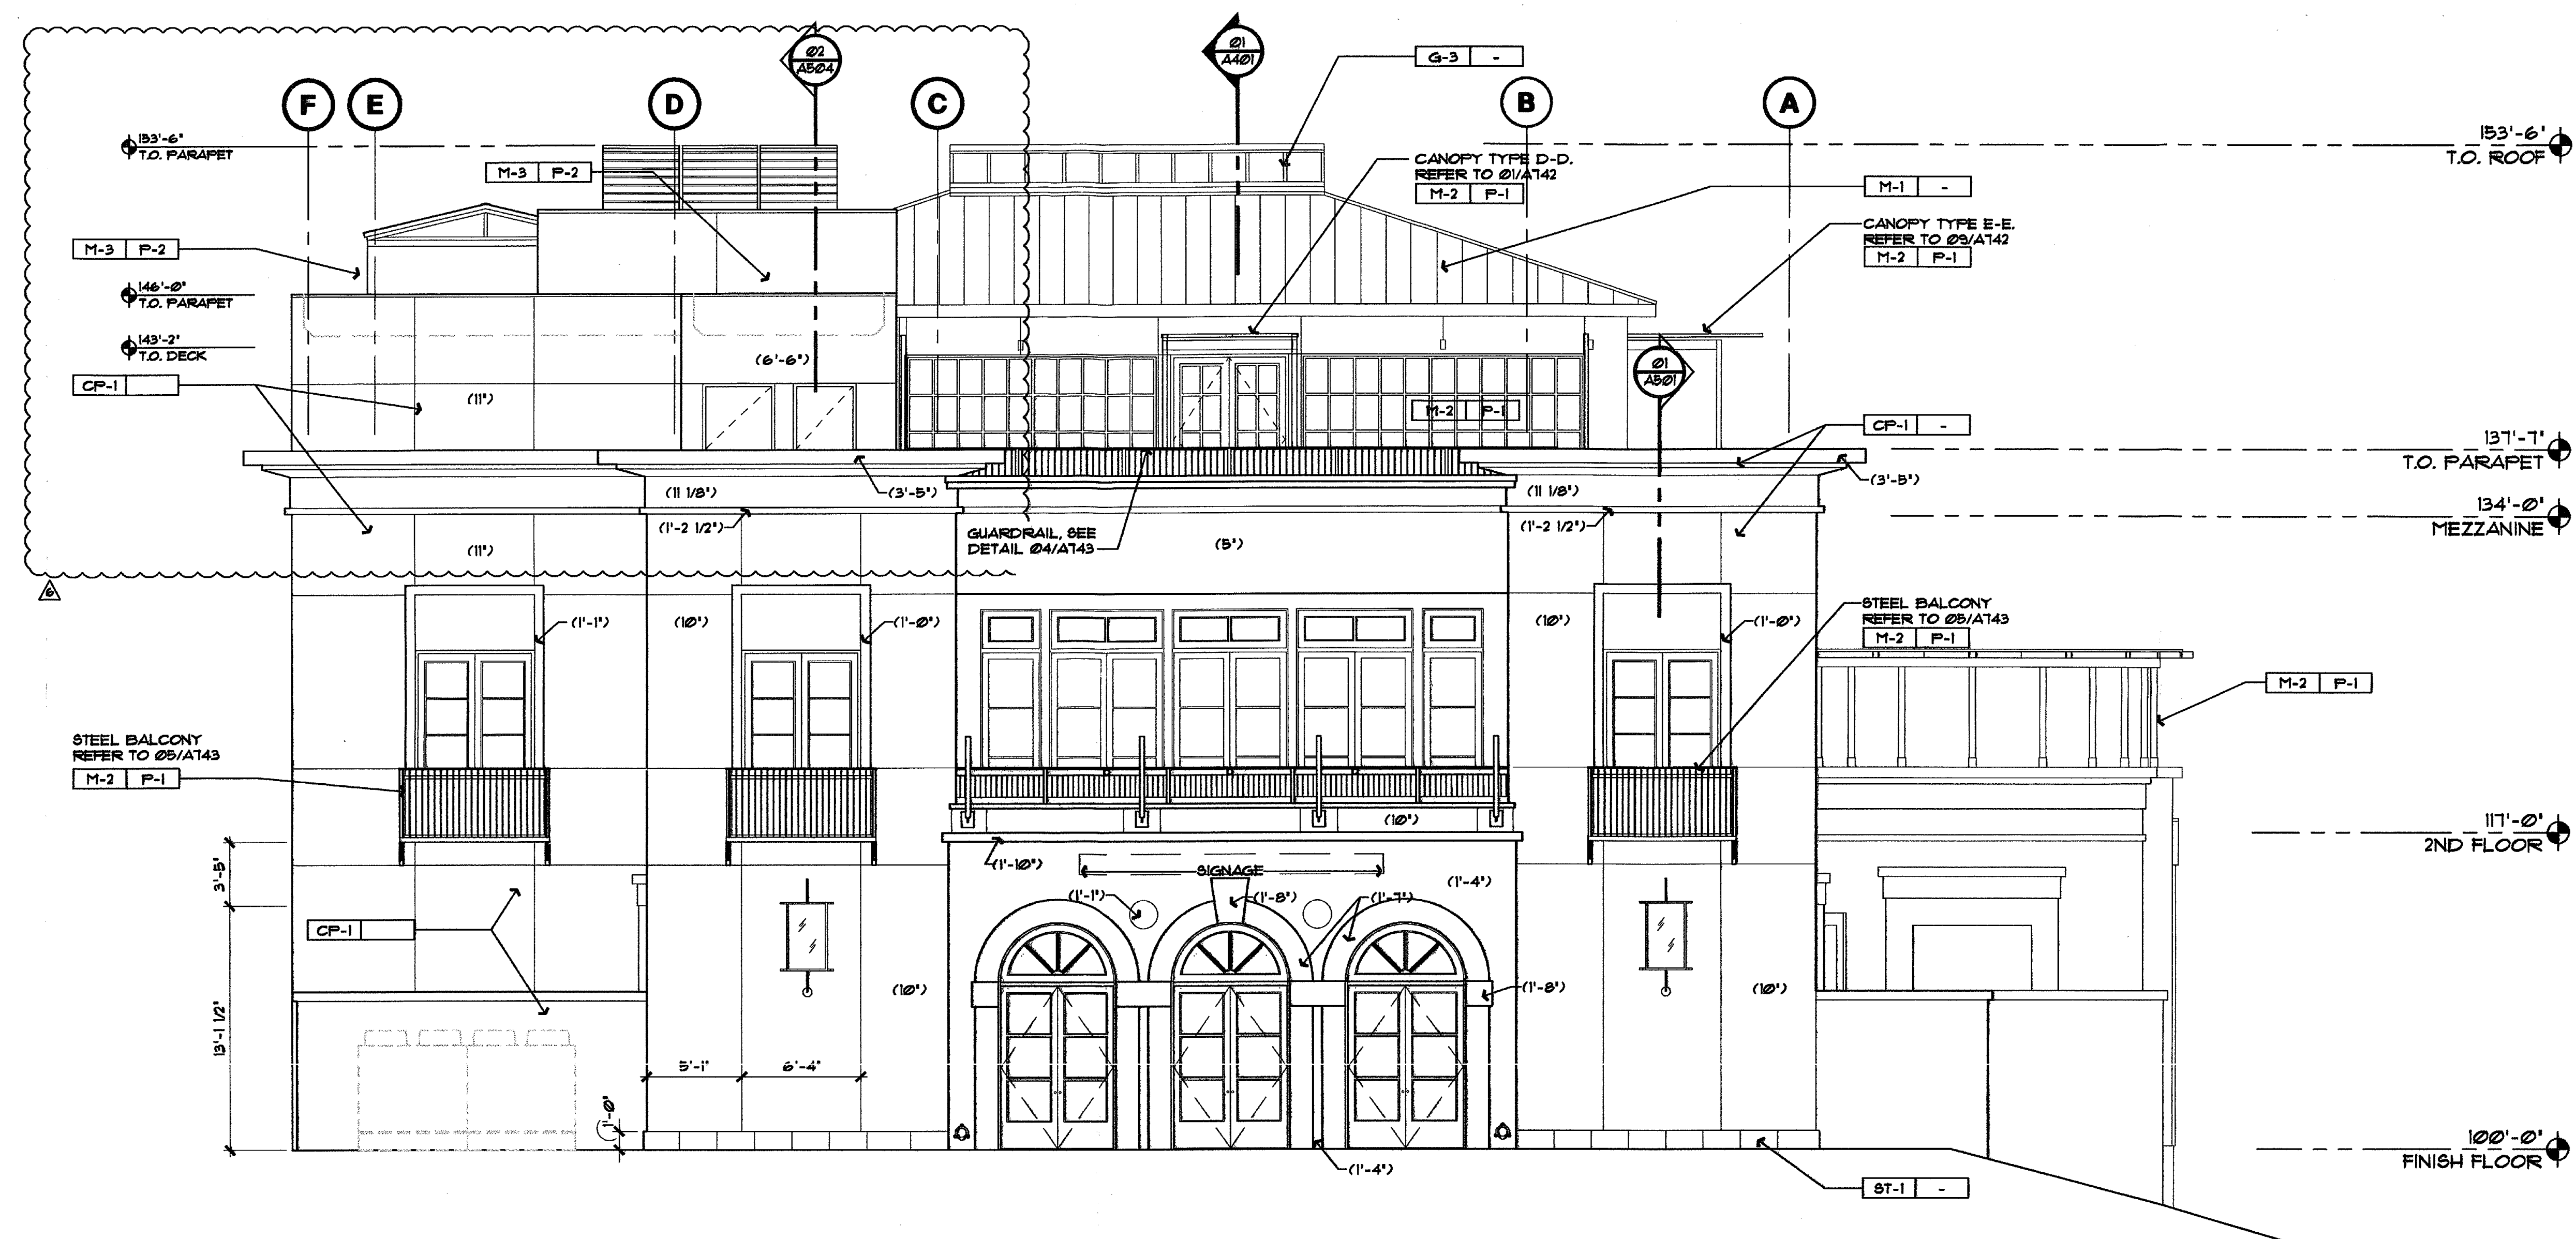

02 WEST BUILDING ELEVATION - NO SITE WALL OR CANOPIES
SCALE: 3/16"=1'-0"
REF: 01/A201

ELEVATION NOTES
1. SITE WALLS ARE NOT PART OF THIS REVIEW.
2. (X'-X") EQUALS THE DISTANCE FROM FACE OF FINISH TO THE NEAREST ADJACENT GRIDLINE, UNO.

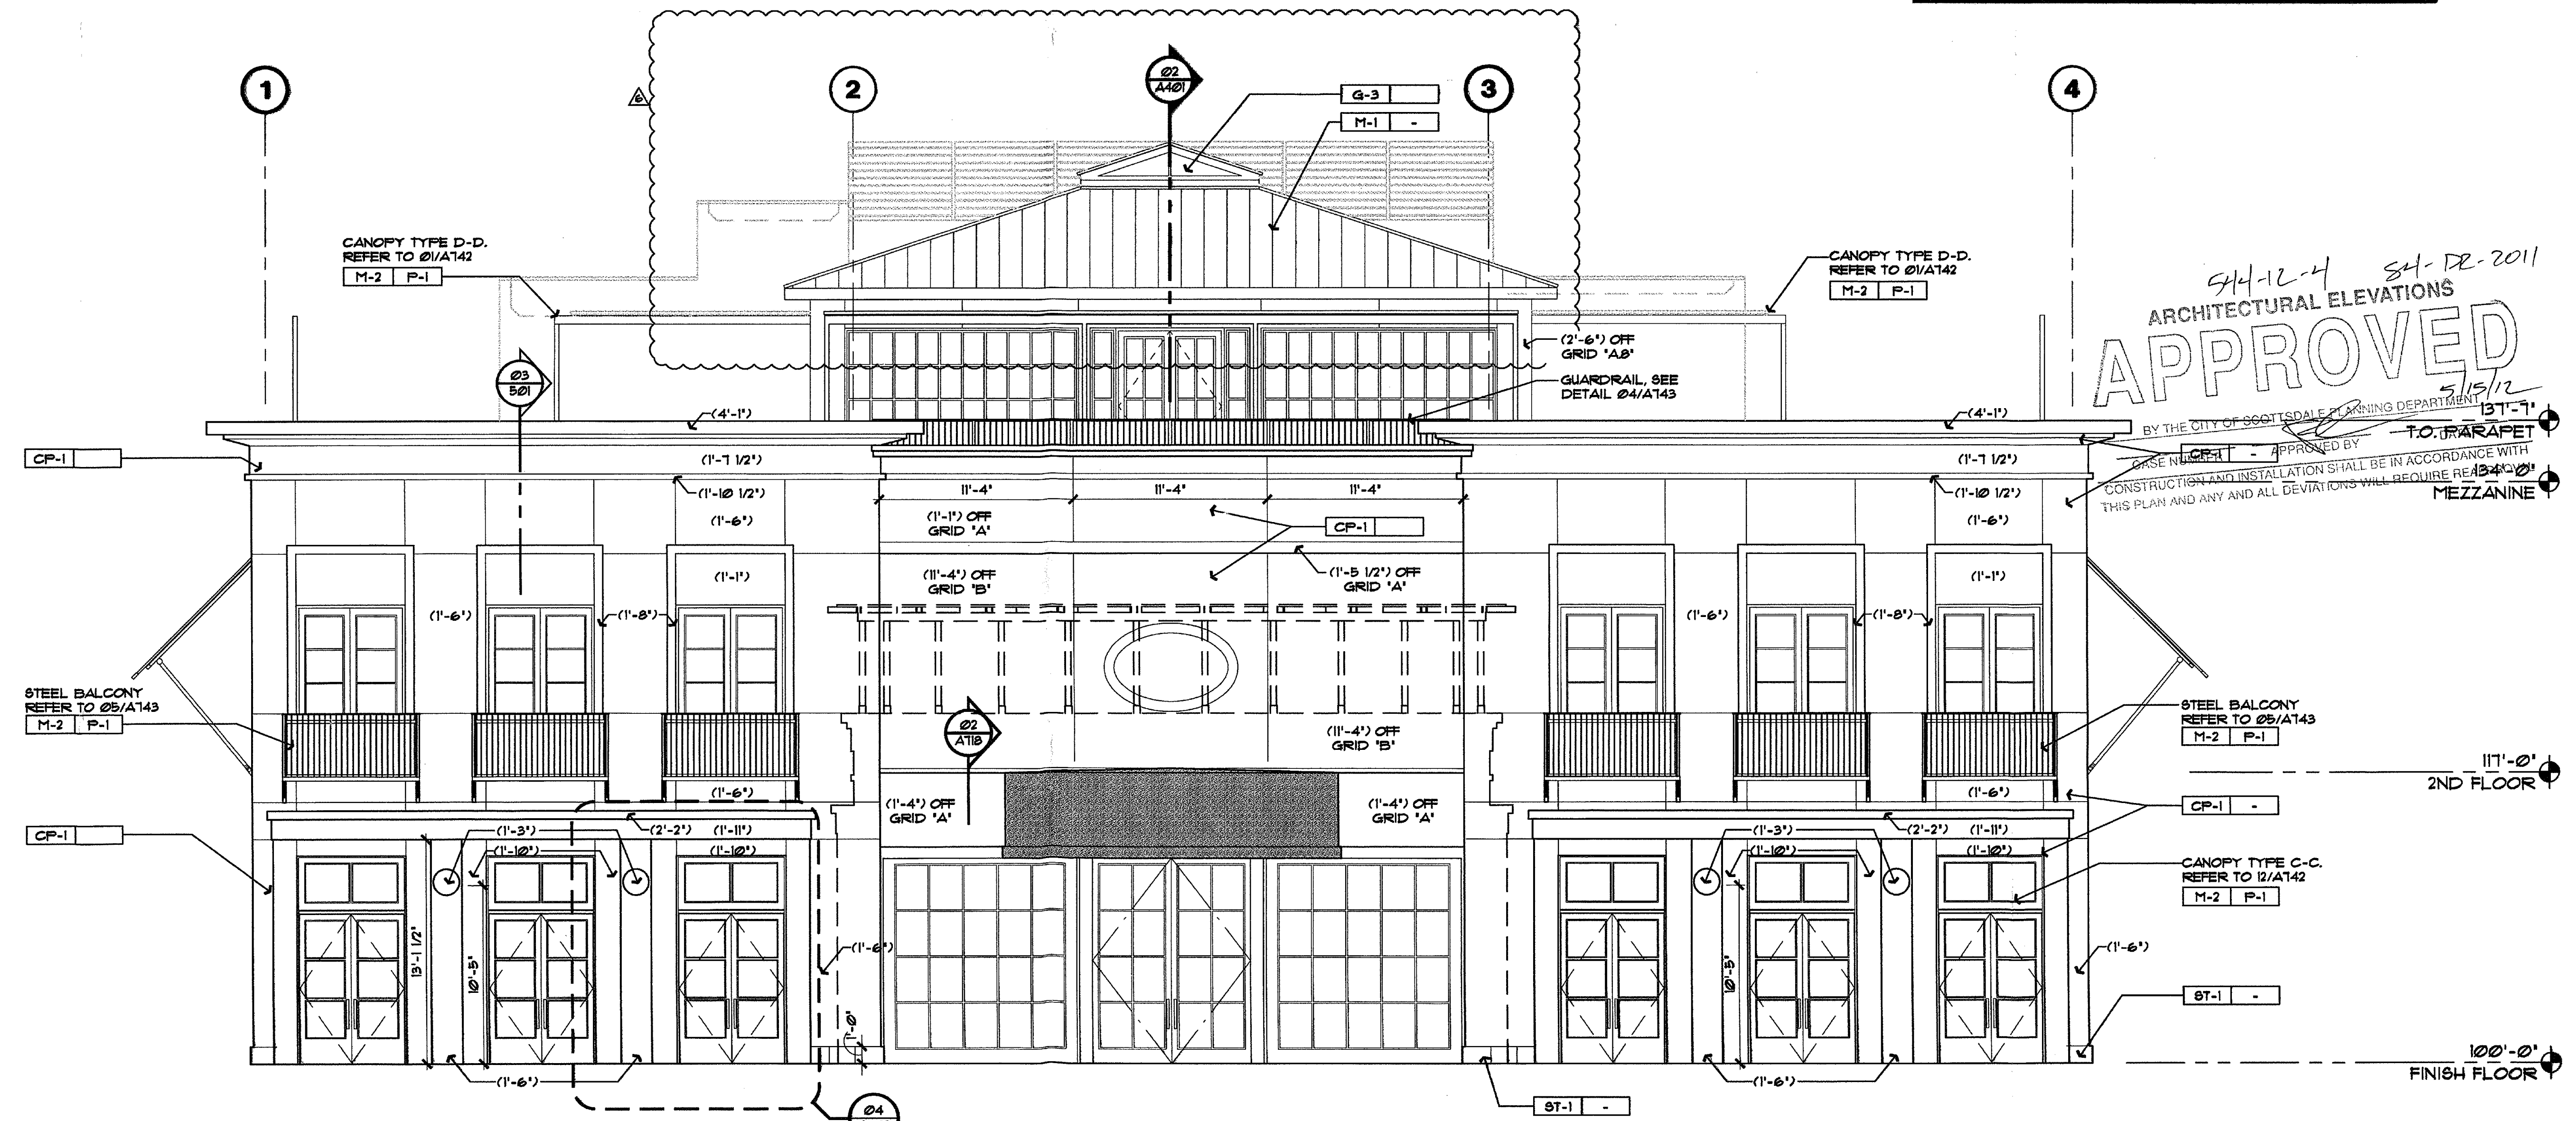

01 SOUTH BUILDING ELEVATION - NO SITE WALL OR CANOPIES
SCALE: 3/16"=1'-0"
REF: 01/A201

ELEVATION NOTES
1. SITE WALLS ARE NOT PART OF THIS REVIEW.
2. (X'-X") EQUALS THE DISTANCE FROM FACE OF FINISH TO THE NEAREST ADJACENT GRIDLINE, UNO.


Date
28 FEBRUARY 2012
Revisions
30 MARCH 2012
COORDINATION
10 MAY 2012
PLANNING COMMENTS

Drawings and written material appearing herein constitute original and unpublished work of the architect and may not be duplicated, used, or disclosed without written consent of the architect.

© 2008 NELSEN PARTNERS, INC.

Project No.
31185

A303
BUILDING ELEVATIONS

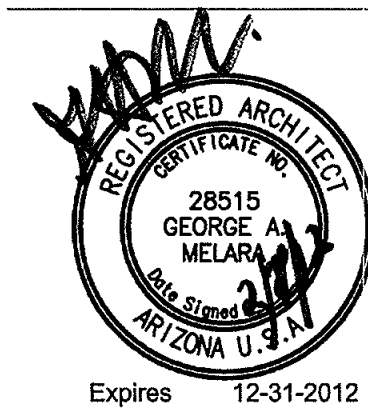

Restoration Hardware
15015 N Scottsdale Rd.
Scottsdale, Arizona 85260

Date
12.23.2011



8-1-DE-2011
STIPULATION SET
RETAIN FOR RECORDS
2/16/12
DATE
APPROVED
INITIALS

Drawings and written material appearing herein constitute original and unpublished work of the architect and may not be duplicated, used, or disclosed without written consent of the architect.

© 2008 NELSEN PARTNERS, INC.

Project No.
31185

A302
BUILDING ELEVATION

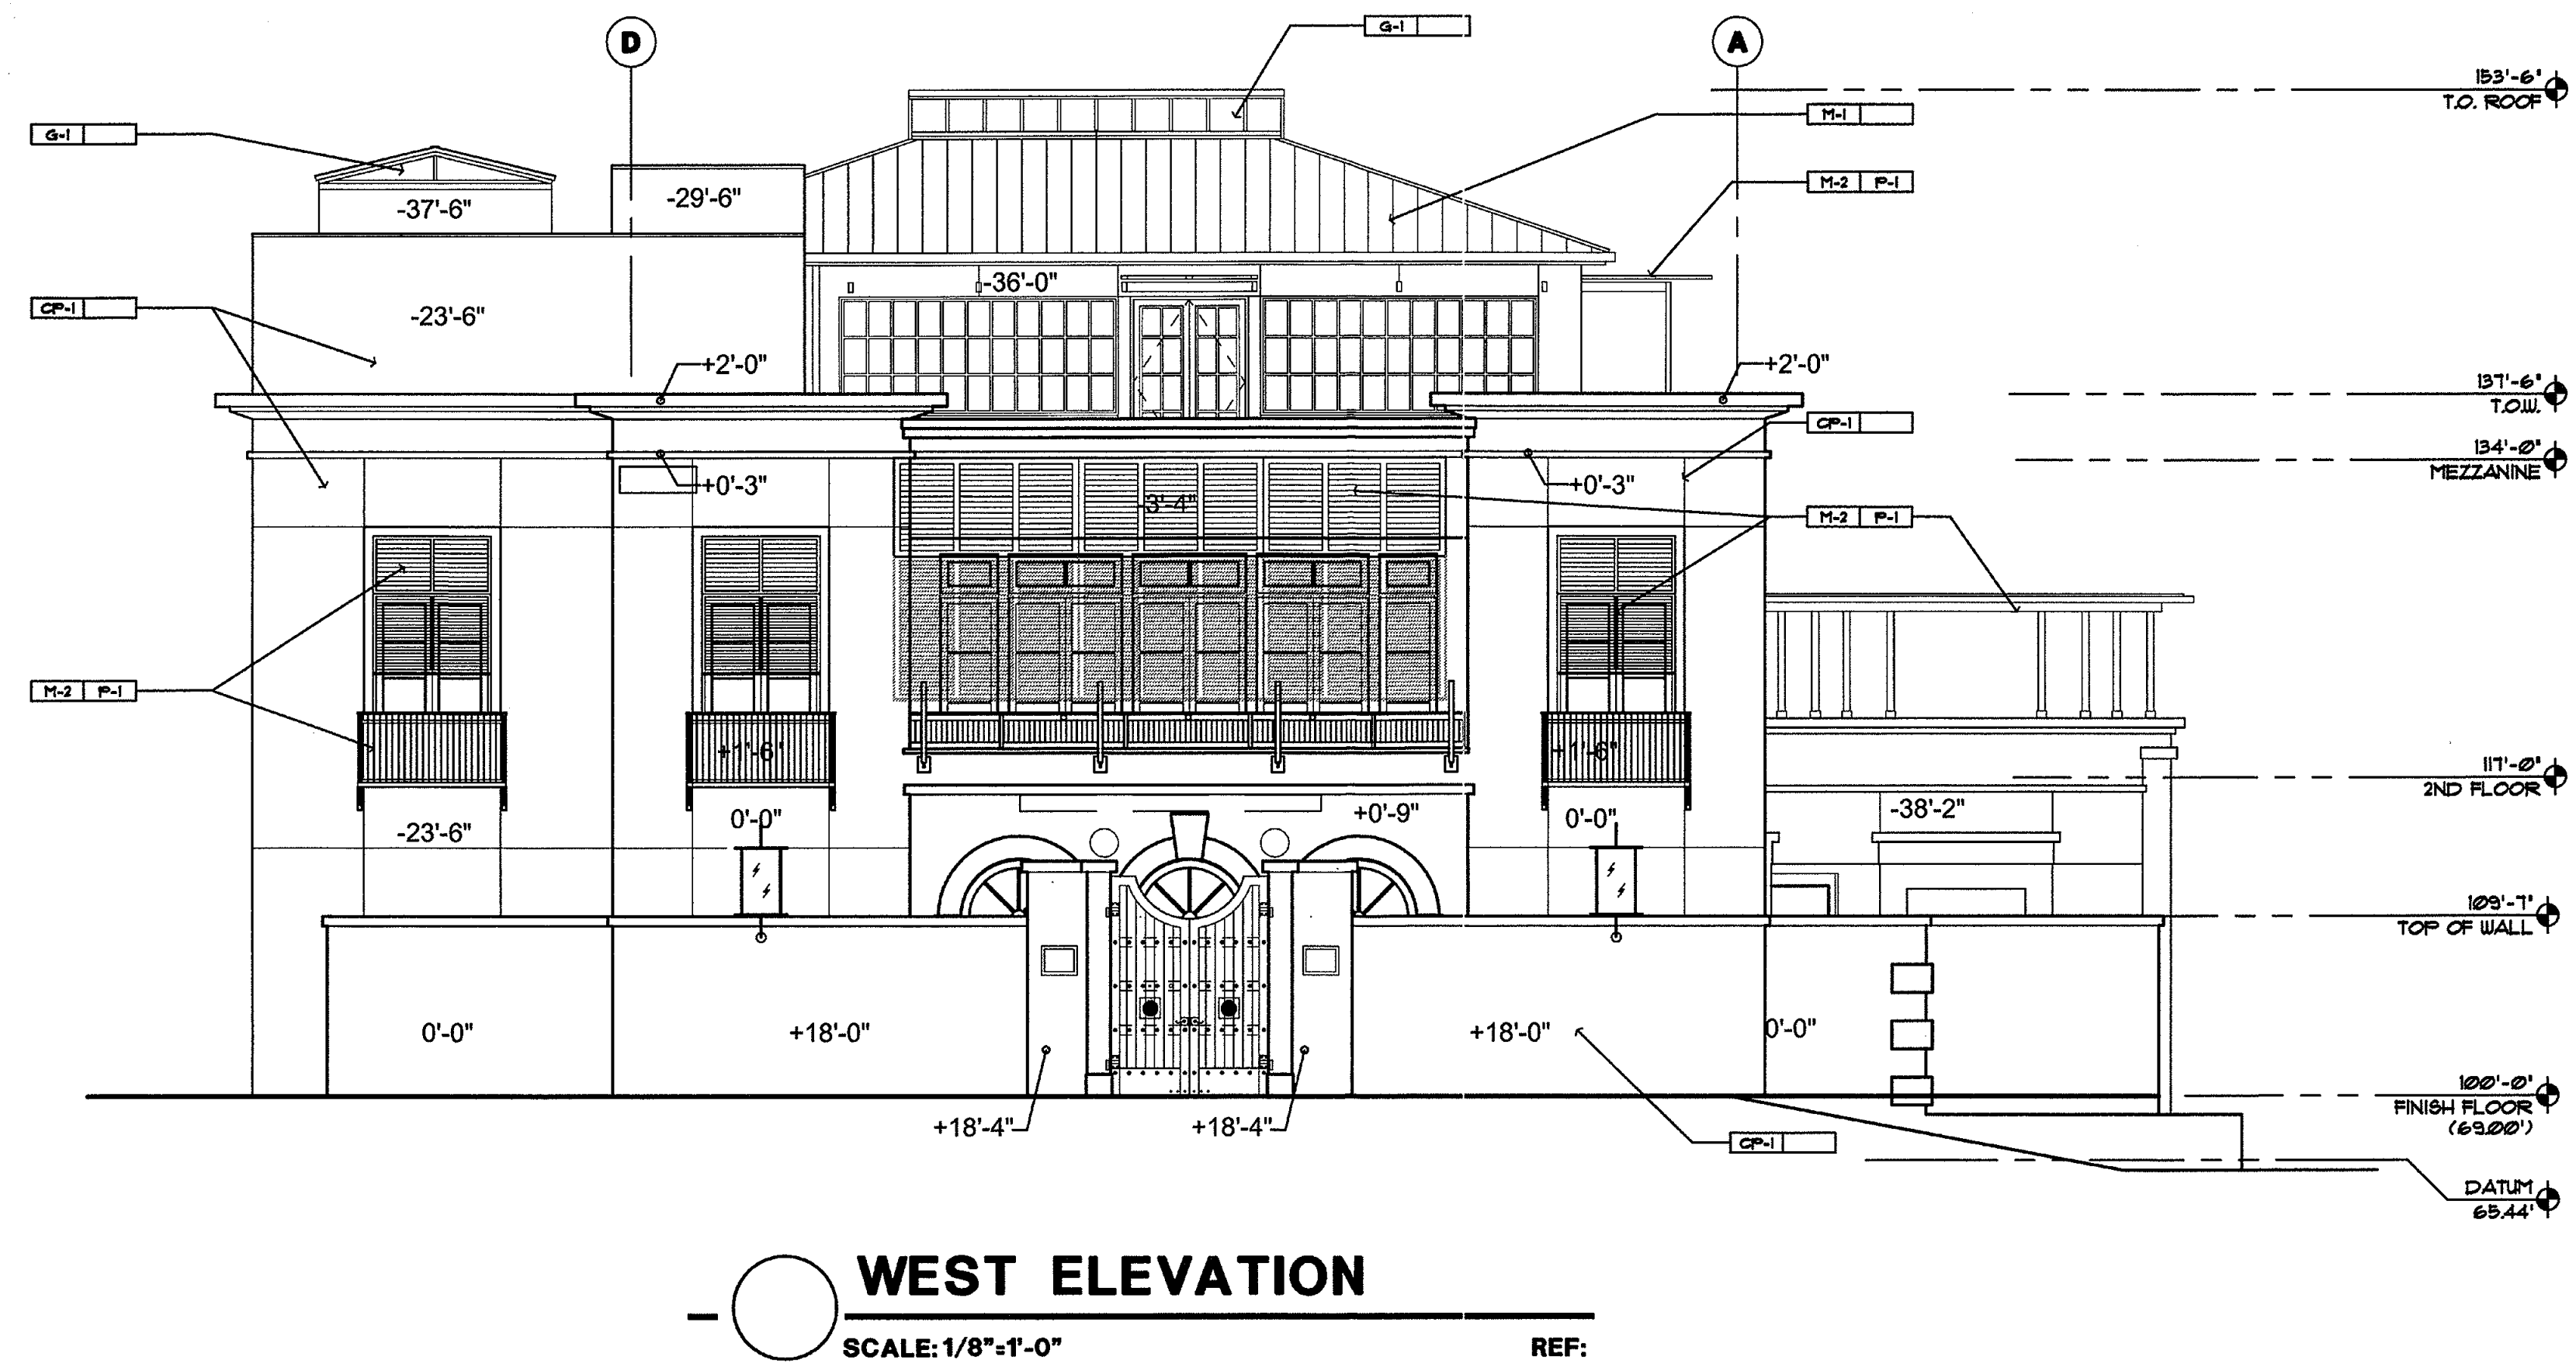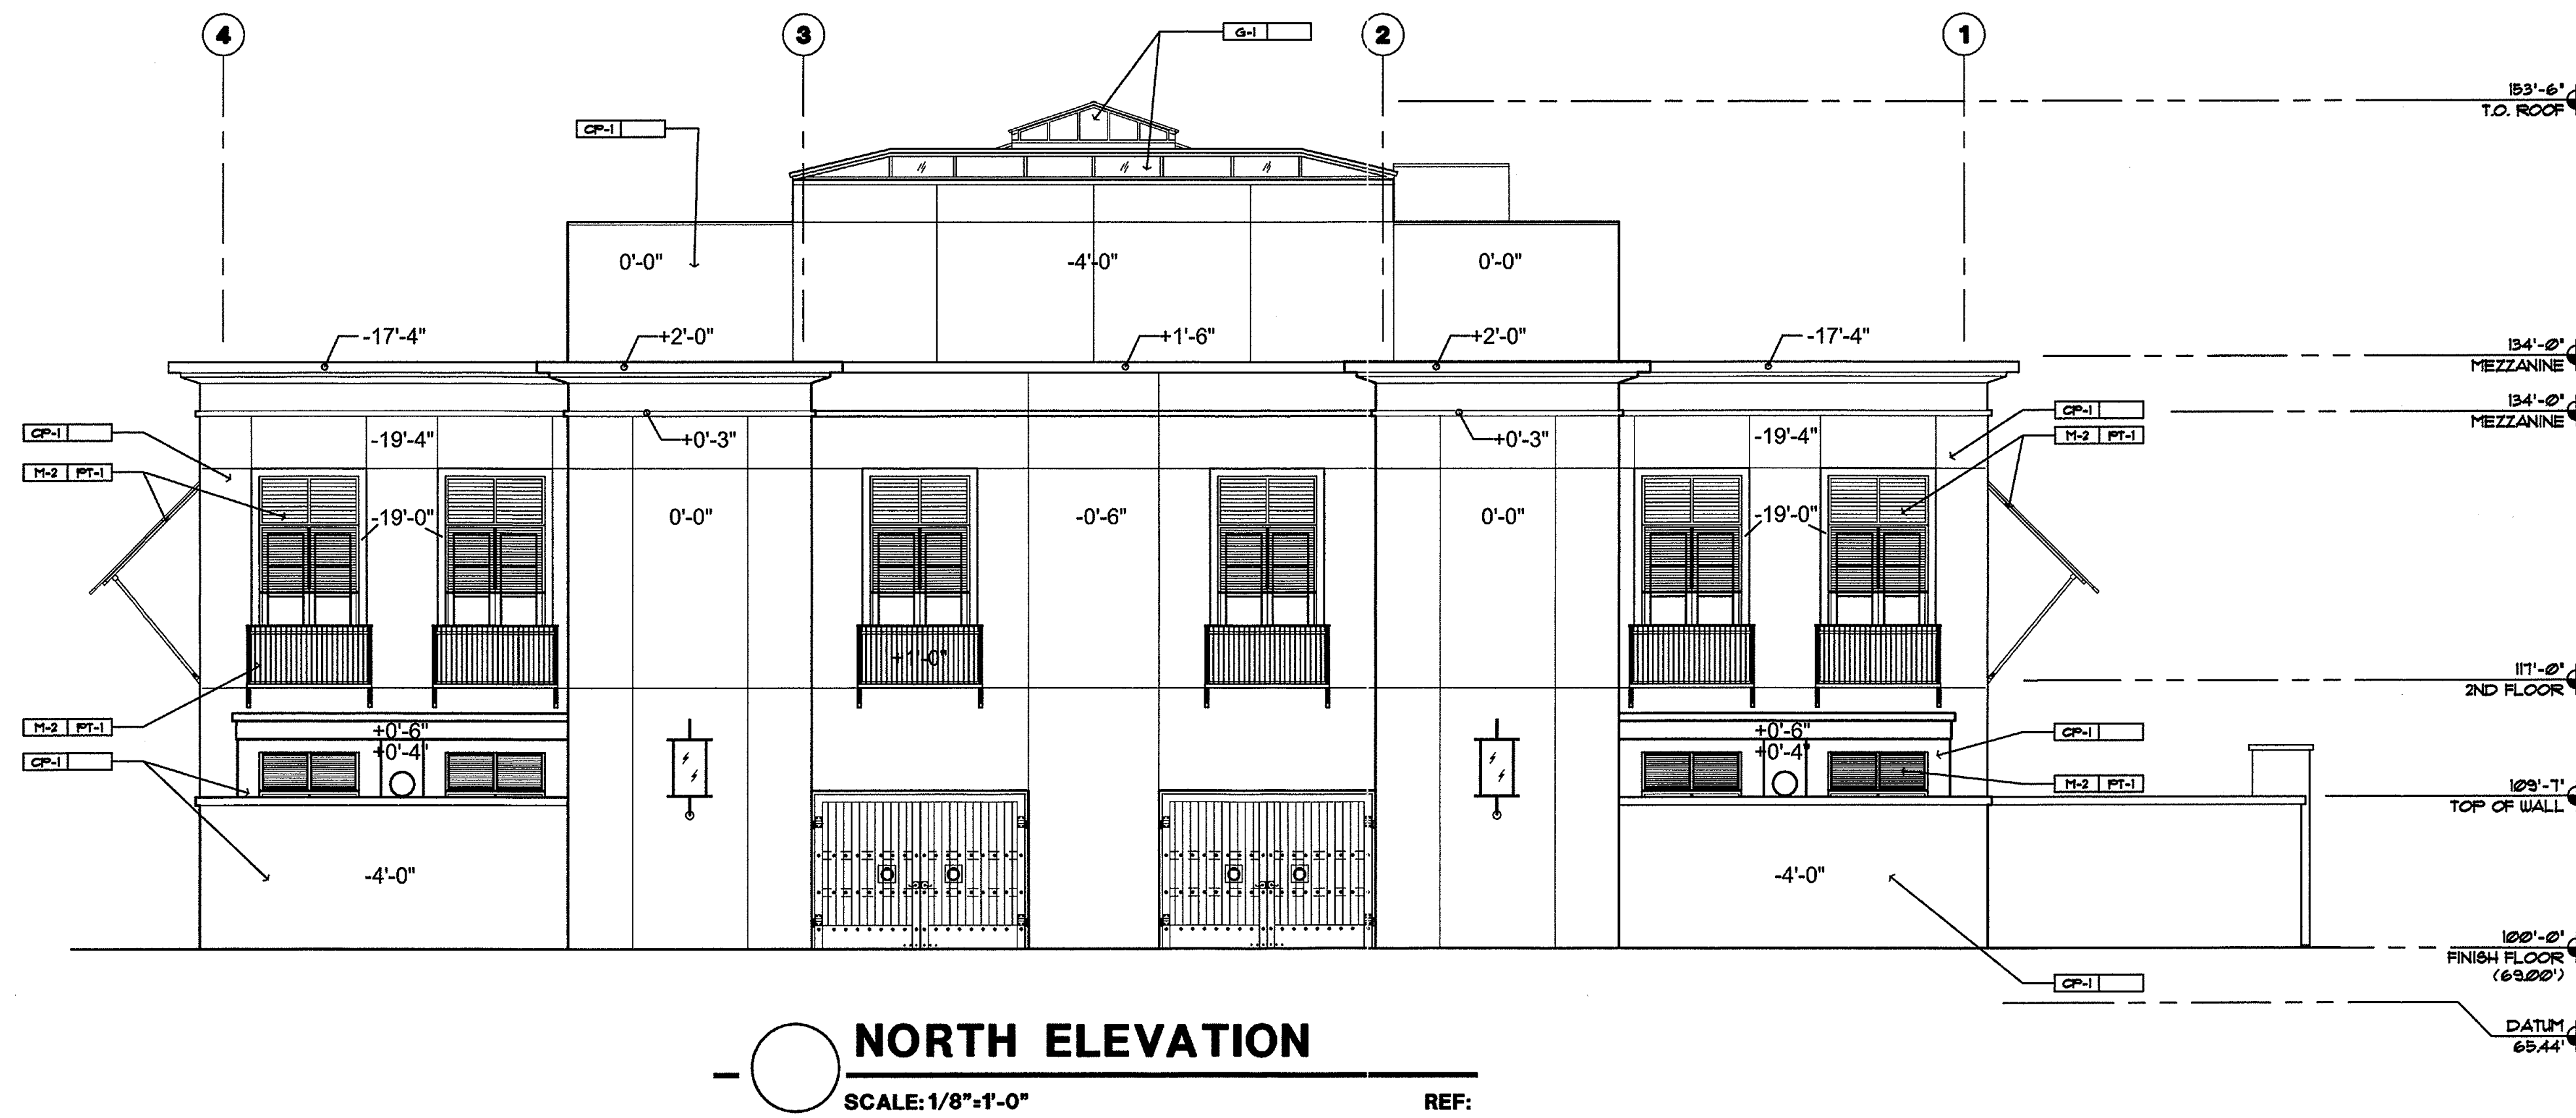



Expires 12-31-2012

Restoration Hardware

15015 N Scottsdale Rd.
Scottsdale, Arizona 85260

Date
12.23.2011

8-1-12-2011
STIPULATION SET
RETAIN FOR RECORDS
APPROVED
2/16/12
DATE INITIALS

Drawings and written material appearing herein constitute original and unpublished work of the architect and may not be duplicated, used, or disclosed without written consent of the architect.

© 2008 NELSEN PARTNERS, INC.

Project No.
31185

A301

BUILDING ELEVATION

