

PLANT LIST

SYMBOL	BOTANICAL NAME	COMMON NAME	QTY.	SIZE	COMMENTS
SHADE TREES					
CP	Cercidium praecox	Palo Brea	8	48" Box (3.5' Min. Caliper)	Multi-Trunk
Alternative:	Cercidium praecox 'Desert Bloom'	Desert Bloom Palo Brea (Thornless)			
DS	Dalbergia sissoo	Sissoo Tree	35	48" Box (3' Min. Caliper)	Standard -Trunk, Matched Heads 6' Branching Height
PC	Prosopis chilensis	Mesquite "Thornless"	35		Multi-Trunk
ACCENT TREES					
CC	Caesalpinia cacalaco	Cascalote	10	36" Box (2.5' Min. Caliper)	Multi-Trunk
PALMS					
PD	Phoenix dactylifera	Date Palm	22	18"-0" Height	Diamond Cut
SHRUBS					
hes	Hesperaloe parviflora	Red Yucca	170	5 Gal	Spacing as shown
aga	Agave yuccifolia	Ocotillo Agave	106	5 Gal	Spacing as shown
gem	Agave geminiflora	Twin-Flowered Agave	22	5 Gal	Spacing as shown
ju	Justicia candidans	Red Justicia	23	5 Gal	Spacing as shown
rb	Leucophyllum langmaniae	'Rio Bravo' Sage	54	5 Gal	Space 3'-0" O.C.
cs	Leucophyllum laevigatum	Chihuahuan Sage	64	5 Gal	Space 3'-0" O.C.
chu	Justicia californica	Chuparosa	10	5 Gal	Space 3'-0" O.C.
GROUNDCOVERS					
con	Convolvulus cneorum	Bush Morning Glory	133	5 Gal	Spacing as shown
ver	Verbena tenuisecta	Summer Beauty	118	1 Gal	Spacing as shown
dsg	Dalea capitata 'Sierra Gold'	Sierra Gold Dalea	261	5 Gal	Spacing as shown
lav	Lavandula x intermedia 'Provence'	Blue Lavandin	146	5 Gal	Spacing as shown
VINES					
cam	Campsis radicans	Trumpet Vine	30	5 Gal	Especially to Light Pole
mac	Macladyena Unguis-Cati	Catclaw	9	5 Gal	Train to Fencing
TURF					
	Cynodon dactylon 'Midiron' Mix	Hybrid Bermuda Mix	6,430 sf		SOD
Seasonal Plantings (See #1)					
	Eustoma grandiflora	Florum Lisianthus	213 sf	3" Pot	
	Impatiens	Balsam	985 sf	3" Pot	
	Lobelia erinus	Lobelia	1750 sf	3" Pot	
	Phlox drummondii	Annual phlox	240 sf	3" Pot	

REVEGETATION SEED MIX

Revegetation Mix A	6,290 sf
Revegetation Mix B	2,825 sf

REVEGETATION SEED MIX RATIOS


BOTANICAL NAME	COMMON NAME	RATE (POUNDS PER ACRE)	
		MIX-A	MIX-B
Baileya multiradiata	Desert Marigold	2.00	
Bouteloua aristodes	Needle Grama	1.00	
Aristida purpurea	Purple Three Awn		3.75
Bouteloua aristodes	Needle Grama	1.00	3.75
Bouteloua curtipendula	Side Oats Grama		4.50
Sporobolus cryptandrus	Sand Dropseed		1.50
Erioneuron pulchellus	Fluffgrass		1.50
Dyssodia pentachaeta	Dogweed	1.00	
Eschscholzia californica	California Poppy	3.00	
Eschscholzia mexicana	Mexican Poppy	2.00	
Lupinus succulentus	Arroyo Lupine	4.00	
Penstemon eatonii	Firecracker Penstemon	1.00	
Penstemon parryi	Parry Penstemon	1.00	
Phacelia campanularia	Desert Bluebell	3.00	
Senna covesii	Desert Senna	2.00	
Sphaeralcea ambigua	Desert-mallow	2.00	
Verbena pulchella	Moss Verbena	2.00	
TOTALS		22.00	15.00

SITE DETAIL KEYNOTES:

DETAIL/SHEET	DESCRIPTION
9.0	PLANTING AND LANDSCAPE
9.1	Ground Cover / Annual Planting 1,2/L7-03
9.2	Shrub Planting 3/L7-03
9.3	Palm Tree Planting 4/L7-03
9.4	Shade Tree Planting in Hardscape 5/L7-03
9.5	Perennial Planting 7/L7-03
9.6	Potted Plants 9/L7-03
9.7	Accent Planting 1/L7-04
9.8	Tree Planting on Slope 2/L7-04
9.9	Tree Planting in Lawn 3/L7-04
9.11	Palm Tree over Structure 5/L7-04
9.17	Soil Preparation 8/L7-03
9.18	Irrigation-Only Water Meter See Irrigation Plans
9.19	Irrigation Backflow Prevention Assembly See Irrigation Plans
9.20	Irrigation Controller See Irrigation Plans
9.21	Hose Bid See Irrigation Plans
9.22	Trash Receptacle See Materials Plans
9.23	Light Pole See Electrical Plans

DESIGNWORKSHOP
 Landscape Architecture • Land Planning
 Urban Design • Tourism Planning
 Asheville • Aspen • Denver • Jackson Hole
 Park City • Santa Fe • Tempe • Lake Tahoe • Vail
 310 S. Mill Avenue, Suite 201
 Tempe, Arizona 85281
 (480) 966-5881
 Facsimile (480) 966-2799
 WWW.DESIGNWORKSHOP.COM
OWNER
CITY OF SCOTTSDALE
 7447 E. INDIAN SCHOOL RD. SCOTTSDALE, AZ. 85251
 480-312-7869

Arizona Canal at Scottsdale - Phase I Scottsdale, Arizona

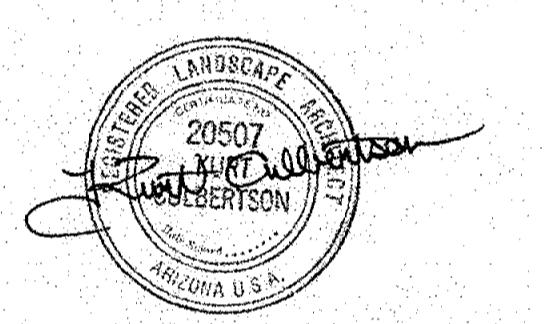

ADDENDUM # 1
PHASE ONE

PLANTING PLAN

ISSUED FOR: BID DOCUMENTS
 ISSUE DATE: OCTOBER 31, 2003
 REVISIONS:
 # DATE DESCRIPTION
 1 10/31/03 ADDENDUM #1
 DRAWN: PC,BT REVIEWED: KC,KB
 PROJECT NUMBER: 2829
 © COPYRIGHT DESIGNWORKSHOP, INC.

REVISION BY

 MUNICIPAL SERVICES DEPARTMENT
 CAPITAL PROJECT MANAGEMENT
 3939 DRINKWATER BLVD.
 SCOTTSDALE, ARIZONA 85251

PROJECT TITLE
 ARIZONA CANAL AT SCOTTSDALE-PHASE I
 DESIGNED BY: KC/KB DATE: 10-31-03 BID NO.: #04PB034 SHEET: L7-02
 DRAWN BY: PC/BT AS-BUILT PROJECT NO.: 2829 15 OF 89

