


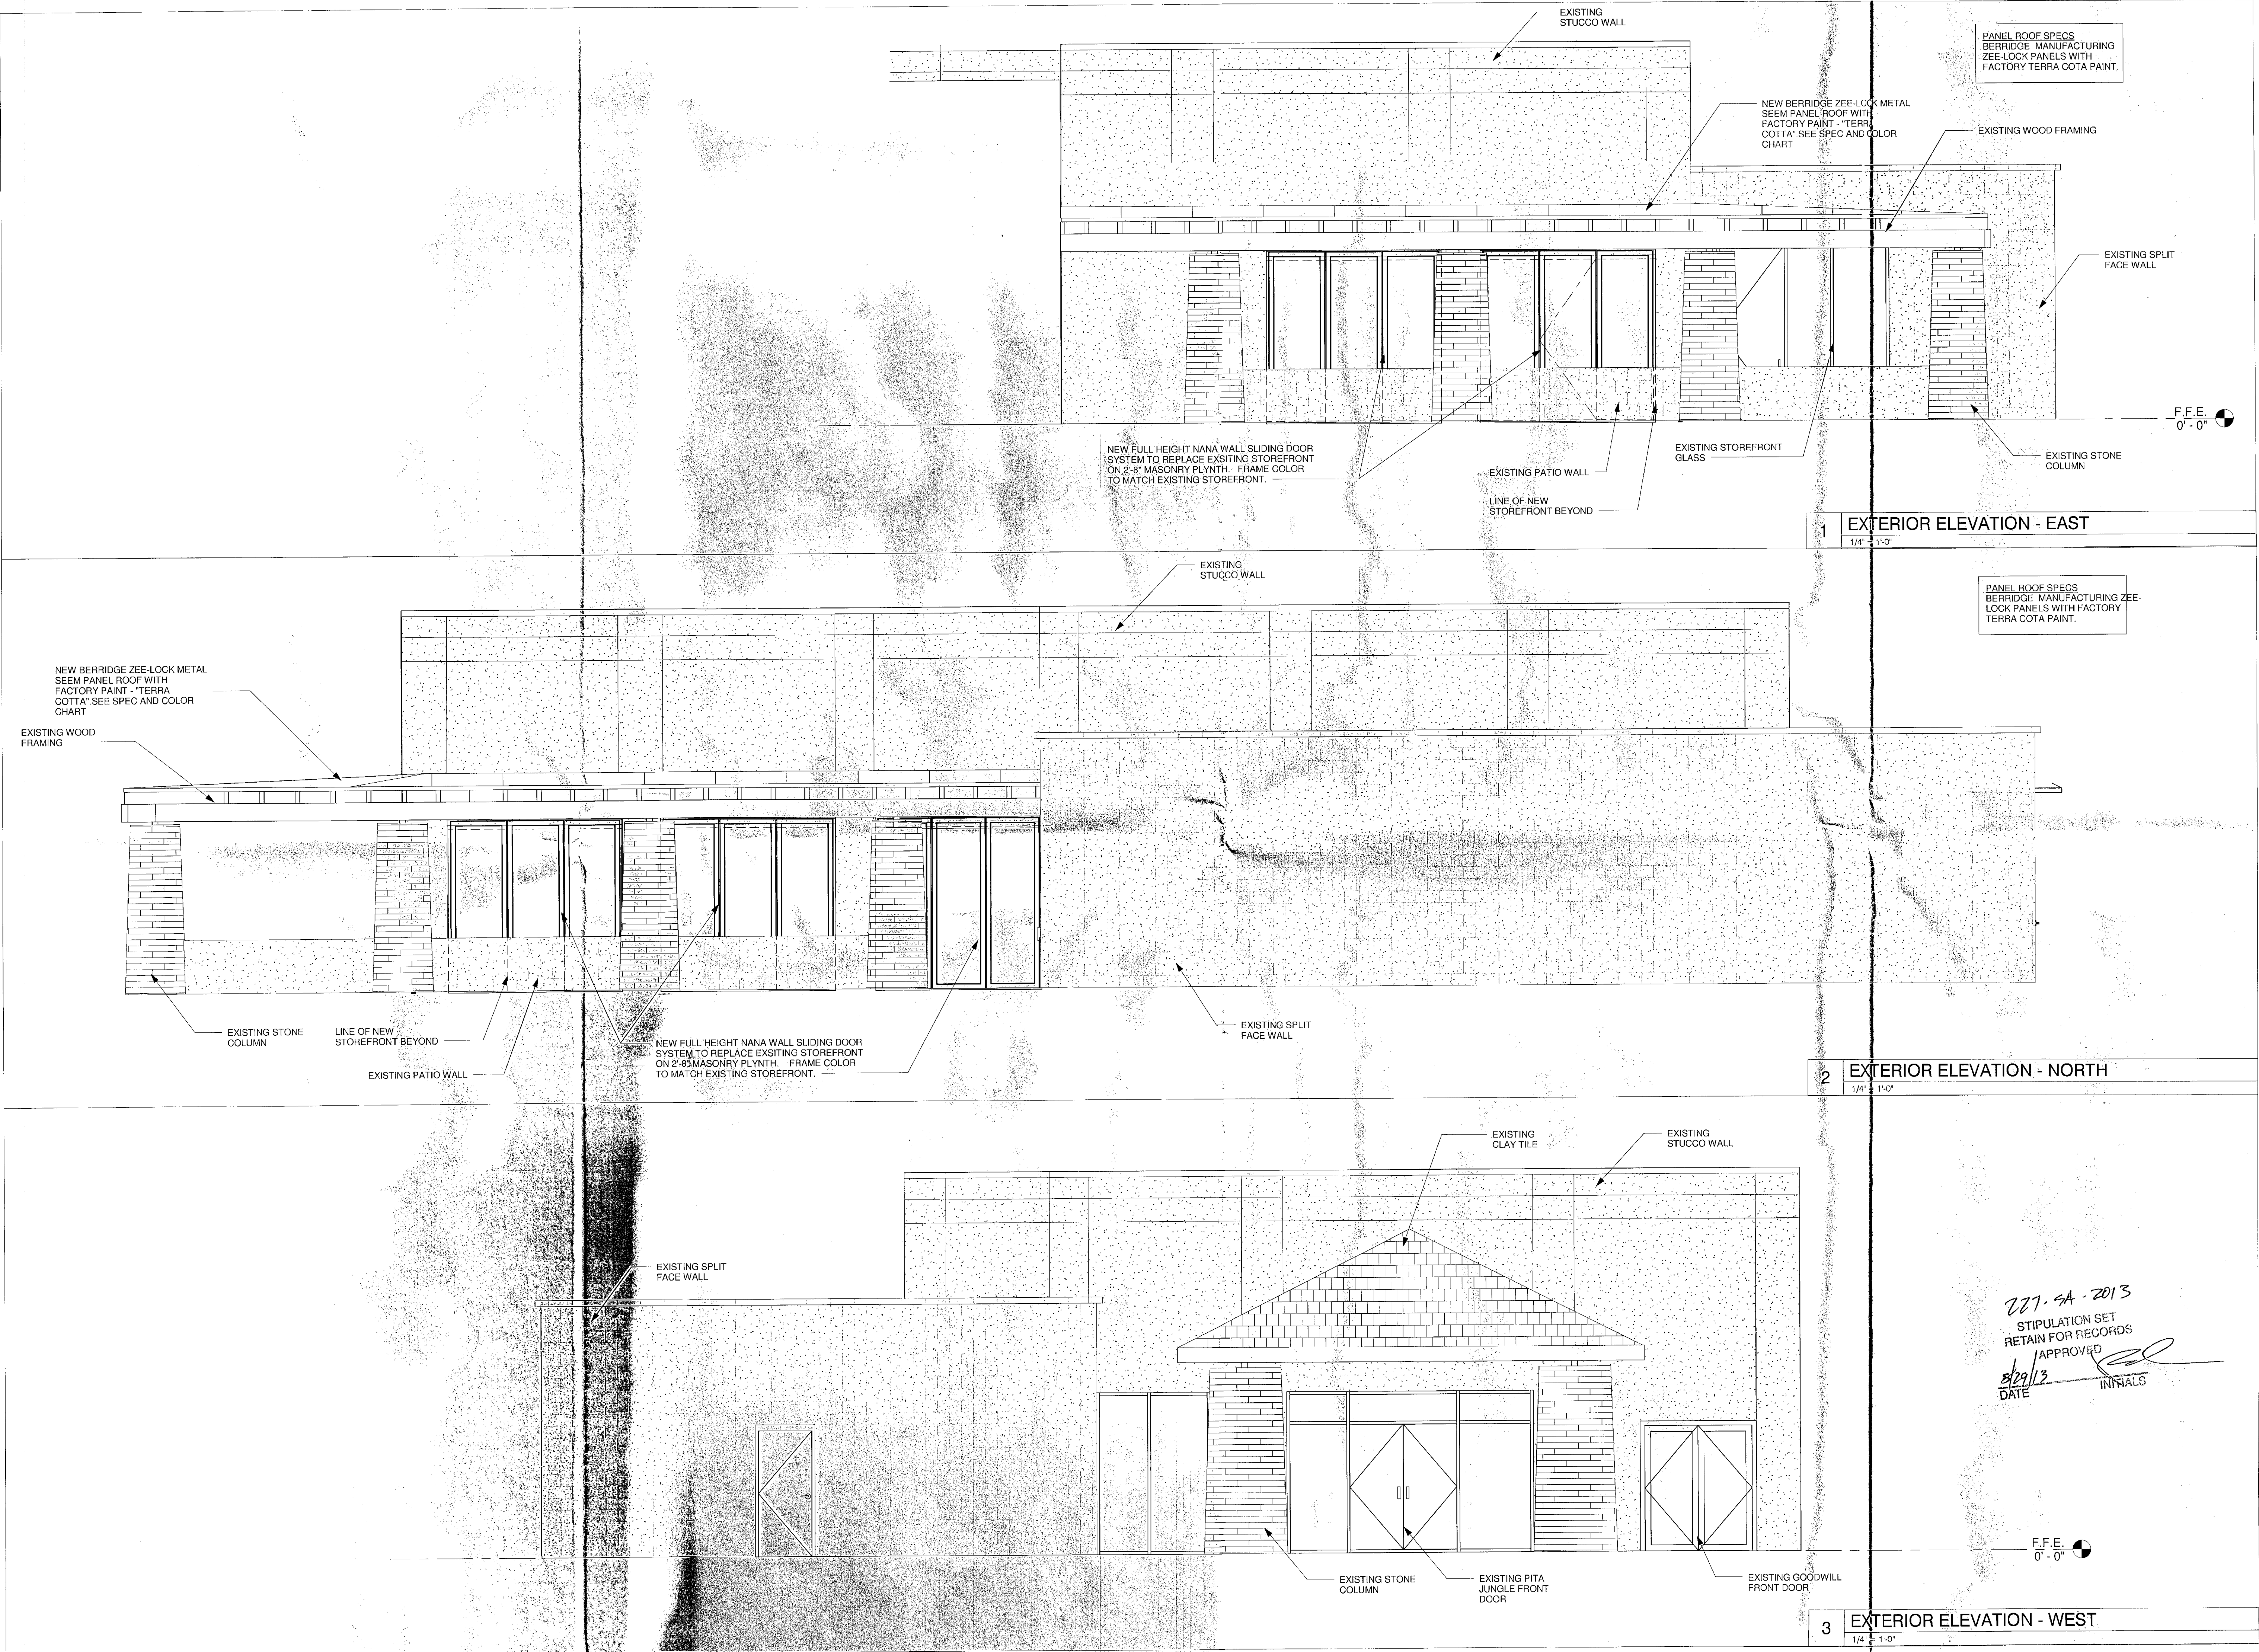

SHIFT

Shift Companies, LLC
7333 E. MONTE VISTA ROAD
SCOTTSDALE, ARIZONA 85257
ph: 480.264.0829
fax: 480.264.0163

THIS DRAWING IS COPYRIGHTED AND IS THE SOLE PROPERTY OF THE OWNER. IT IS PRODUCED SOLELY FOR USE BY THE OWNER AND ITS AFFILIATES. REPRODUCTION OR USE OF THIS DRAWING AND/OR THE INFORMATION CONTAINED HEREIN IS FORBIDDEN WITHOUT THE WRITTEN PERMISSION OF THE OWNER.

RECORD DRAWINGS 04/07/13
ISSUE DATE:

PITA JUNGLE RESTAURANT
14858 N. FRANK LLOYD WRIGHT BLVD.
SCOTTSDALE, AZ 85260

NATIVE PLANT CASE #

RELEASE	
DATE	SUBMITTAL

REVISIONS

NO.	DATE	COMMENT

SHIFT JOB NUMBER
010313

IN HOUSE

DRAWN BY: CSM
CHECKED BY: CSM

SHEET TITLE
EXTERIOR ELEVATIONS

SHEET NUMBER
A2.1

PLOT SCALE:
1:1 @ 24"x36"; 1:2 @ 12"x18"

CASE #