



BENCHMARK-C.O.S. DATUM
 C.O.S. BRASS CAP IN HANDHOLE AT INTERSECTION
 OF 68TH STREET AND CAMELBACK ROAD.
 NAVD '83 ELEVATION: 1288.852

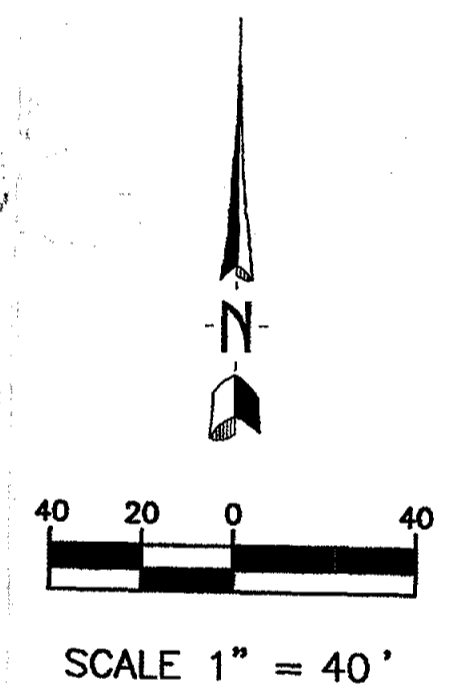

LEGEND

NG	NATURAL GROUND ELEVATION
SW	SIDEWALK ELEVATION
P	PAVEMENT ELEVATION
TC	TOP OF CURB ELEVATION
G	GUTTER ELEVATION
FL	FLOWLINE ELEVATION
CB	CATCH BASIN
SMH	SEWER MANHOLE
SDMH	STORMDRAIN MANHOLE
SCO	SEWER CLEANOUT
(Symbol)	INDICATES A CORNER OF THIS SURVEY.

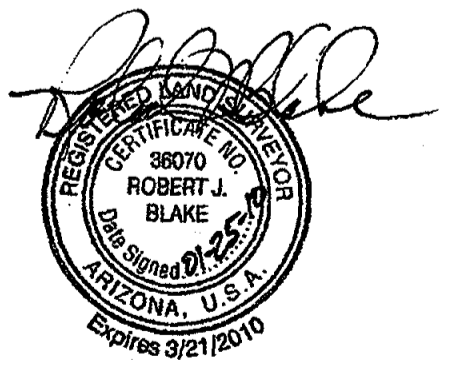

Clouse Engineering, Inc.
 ENGINEERS • SURVEYORS
 1642 E. Orangewood Ave., Phoenix, Arizona 85020
 Tel 602-395-5300 Fax 602-395-9310

PROJECT ELEVATIONS
ORCHID TREE APARTMENTS
 6801 EAST CAMELBACK ROAD

Revised
 01-25-10

Date
 01-15-10
 As-Built
 Job No.
 030102

1-ZN-2010
 1"= 202/10