



5-MS-2013#5

## Development Review (Minor) Staff Approval

Sonora Village Master Sign  
Program Amendment (El Pollo  
Loco)

### APPLICATION INFORMATION

|                   |                   |            |                                                 |
|-------------------|-------------------|------------|-------------------------------------------------|
| LOCATION:         | 15681 N Hayden Rd | APPLICANT: | Z. Hess                                         |
| PARCEL:           | 215-51-019        | COMPANY:   | Arizona Sign and Lighting LLC dba Sign Services |
| Q.S.:             | 35-48             | ADDRESS:   | 16845 N 29th ave 445 Phoenix, AZ 85053          |
| CODE VIOLATION #: |                   | PHONE:     | (602) 350-4572                                  |

**Request:** Request to amend the Sonora Village Master Sign Program (5-MS-2013) to incorporate corporate sign standards for a new pad building at an existing mixed-use commercial development (El Pollo Loco).

### STIPULATIONS

1. All building wall signs and freestanding signs for El Pollo Loco shall comply with the Sonora Village Master Sign Program Amendment (El Pollo Loco), Case# 5-MS-2013#4, submitted by Arizona Sign and Lighting, and approved by City Staff with a date of 1/17/17.
2. Any modifications to the Sonora Village Master Sign Program shall require Development Review Board or City Staff Approval.
3. All signs shall require separate submittals, reviews and permits.

Related Cases: 55-DR-2015, 5-MS-2013#4, 5-MS-2013#3, 5-MS-2013#2, 5-MS-2013

### CONSTRUCTION DOCUMENT PLAN REVIEW SUBMITTAL REQUIREMENTS

Submit two (2) copies of this approval letter, along with the required plans listed in the Sign Permit Application (link below), to the One Stop Shop for sign plan review:


SIGN PERMIT APPLICATION

Completed Sign Permit Application: [www.scottsdaleaz.gov/codes/signs](http://www.scottsdaleaz.gov/codes/signs)

### Expiration of Development Review (Minor) Approval

This approval expires two (2) years from date of approval if a permit has not been issued, or if no permit is required, work for which approval has been granted has not been completed.

Staff Signature: \_\_\_\_\_

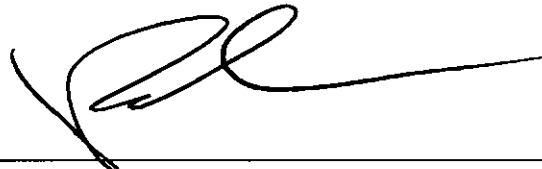  
Bryan Cluff, LEED AP  
Senior Planner

DATE: \_\_\_\_\_

1/17/17

### Planning and Development Services

7447 East Indian School Road, Suite 105, Scottsdale, Arizona 85251 Phone: 480-312-7000 Fax: 480-312-7088

City of Scottsdale's Website: [www.scottsdaleaz.gov](http://www.scottsdaleaz.gov)

Page 1 of 1

Form Revision Date: 12/11/2014

**NARRATIVE FOR SONORA VILLAGE (EL POLLO LOCO) MSP AMENDMENT**

We seek approval for all exterior signage for El Pollo Loco located at the address of 15448 N Pima Rd (also reference 55-DR-2015 which lists the address as 15681 N Hayden). El Pollo Loco will be a new Pad tenant occupying a parcel along Pima Rd and would like to propose the attached wall signage, directional signage and menu board/pre menu board signage in accordance with Sec 8.501 of the Sign Ordinance.

Thank you for your time and consideration

Z Hess

Arizona Sign and Lighting LLC dba Sign Services

Z@AZSIGNSERVICES.COM

602-350-4572



EXPRES 02/30/2018



N/A



APPROVED *[Signature]*  
DATE 1/17/17 INITIALS

STIPULATION SET *5-MY-2013* #5  
RETAIN FOR RECORDS

 


SCALE: 1" = 100'-0"

ACCESSIBLE SPACES PROVIDED: 65 SPACES

REMAIN FOR RECORDS  
APPROVED  
1/17/17  
DATE INITIALS

5-MS-20345  
STIPULATION SET  
RETAIN FOR RECORDS  
APPROVED



|      |      |    |             |
|------|------|----|-------------|
| REV. | DATE | BY | DESCRIPTION |
|      |      |    | INITIALS    |



9 - PROTOTYPE  
STORE #5121  
15508 N. PIMA RD  
SCOTTSDALE, AZ 85260


11/12/95

|      |       |
|------|-------|
| DATE | DATE  |
| CH   | PO/TF |

**OVERALL CENTER  
PARKING ANALYSIS**

### C1.2



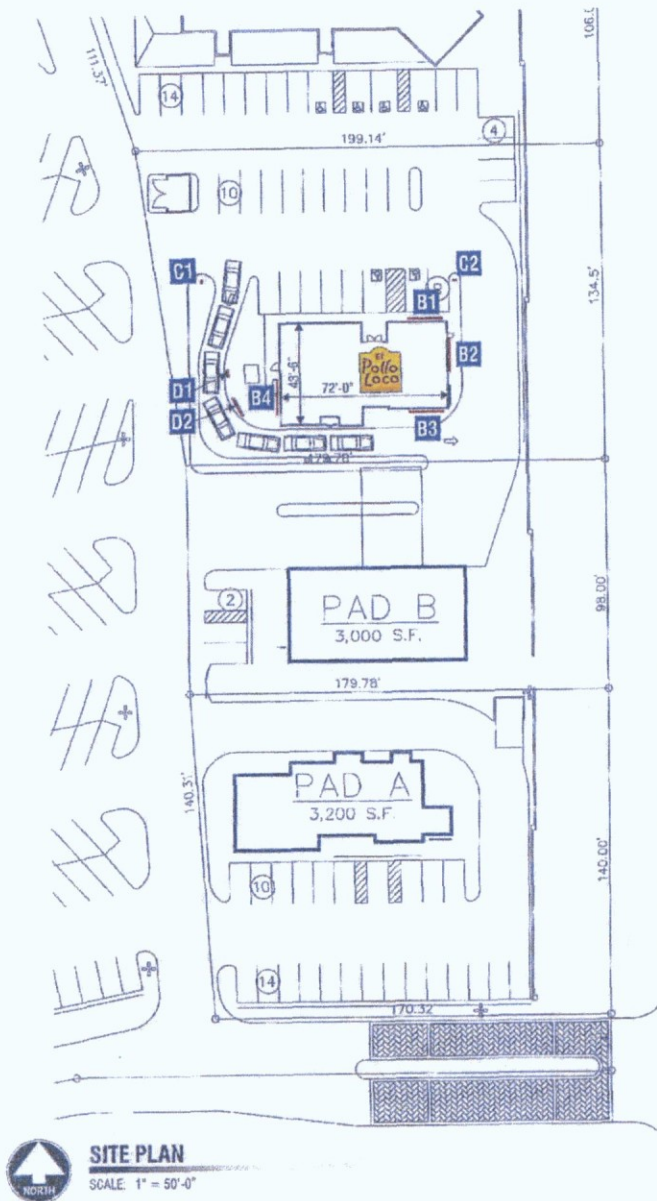

PIMA ROAD  
FUTURE FREEWAY

#### KEY

- B1 1'10" x 14'9" LETTER WALL SIGN - LINEAR VERSION  
26.99 SF
- B2 1'10" x 14'9" CHANNEL LETTER WALL SIGN - LINEAR VERSION  
26.99 SF
- B3 1'10" x 14'9" CHANNEL LETTER WALL SIGN - LINEAR VERSION  
26.99 SF
- B4 2'-0" CHANNEL LETTER WALL SIGN - STACKED VERSION  
4'10" x 5'9" 27.77 SF
- C1 1'-6" x 2'-0" DIRECTIONAL CABINET "DRIVE THRU"
- C2 1'-6" x 2'-0" DIRECTIONAL CABINET "THANK YOU! DO NOT ENTER"
- D1 S/F PREVIEW MENU
- D2 S/F MENU WITH SPEAKER

Total 108.74 SF  
 $108.74 \times .9 = 97.87 \text{ SF}$   
 ALLOWED  $72 \times 1.5 = 108 \text{ SF}$

DATE 11/7/17  
 INITIALS [Signature]

5-M3-2013 #5  
 STIPULATION SET  
 RETAIN FOR RECORDS  
 APPROVED

**CNP**  
 SIGNS & GRAPHICS  
 4530 Mission Gorge Place  
 San Diego, CA 92120  
 Tel: 619.283.2191  
 Fax: 619.283.9503  
 Web: www.cnpsigns.com

CUBIT



PROJECT  
 EL POLLO LOCO #6121

LOCATION  
 15448 NORTH PIMA RD.  
 SCOTTSDALE, AZ 85260

SHEET TITLE  
 SITE PLAN

ACCT REP  
 JENNIFER GLAVIN  
 DESIGNER  
 ANDREW WRIGHT

DATE 07/21/14  
 SCALE NOTED

CUSTOMER APPROVAL

UNLESS SPECIFIED, THIS DRAWING IS NOT FOR PRODUCTION. The information shown is for permitting and design intent only. Colors shown are representations of the indicated specifications, and may not be an exact match of the finished product.

©2014 CNP Signs & Graphics  
 The original concepts and/or illustrations contained in this document are the exclusive property of CNP Signs & Graphics. Disclosure or reproduction of this design, in any manner or medium without written consent and without payment of CNP's copyright fee is prohibited.

|           |        |           |        |
|-----------|--------|-----------|--------|
| BLANK     | 14-414 | PROJECT # | 315448 |
| REVISIONS | 5      | NOT       | 000000 |

| REVISIONS | DATE     | BY | REASON | REMARK |
|-----------|----------|----|--------|--------|
| 1         | 07/21/14 | AW |        |        |
| 2         | 11/07/17 | AW |        |        |
| 3         | 02/02/18 | AW |        |        |
| 4         | 02/02/18 | AW |        |        |
| 5         | 10/10/18 | AW |        |        |
| 6         |          |    |        |        |

KEY NO

CUSTOMER APPROVAL  
 APPROVED BY: [Signature] DATE: [Blank]

1 of 7




# **NORTH/RIGHT ELEVATION**

SCALE: 1/8" = 1'-0"

DATE 11/21/14

INITIALS

APPROVED  
STIPULATION SET  
RETAIN FOR RECORDS  
5-M-5-2013/HJS

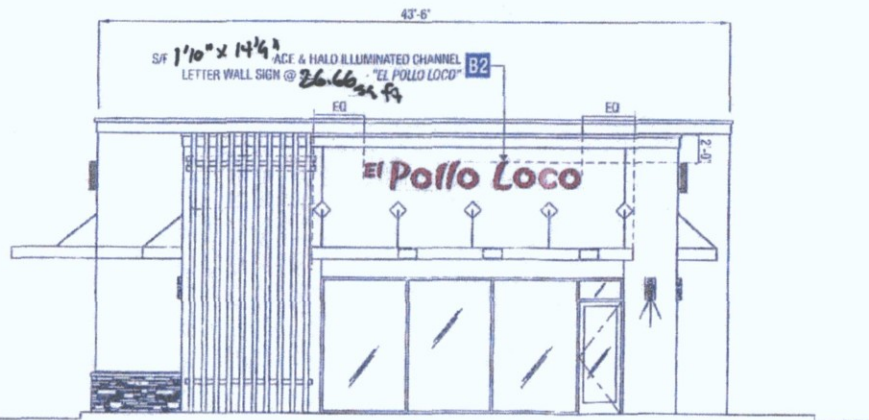

# **EAST/FRONT ELEVATION**

SCALE: 1/8" = 1'-0"

26.99 sq ft

26.99 sq ft

**CNP**  
SIGNS & GRAPHICS

4530 Mission Gorge Place  
San Diego, CA 92120  
Tel: 619.283.2191  
Fax: 619.283.9503  
Web: www.cnp-signs.com

CLIENT



PROJECT  
EL POLLO LOCO #6121

LOCATION  
15448 NORTH PIMA RD.  
SCOTTSDALE, AZ 85260

SHEET TITLE  
BUILDING ELEVATIONS

ACCT REP  
JENNIFER GLAVIN  
DESIGNER  
ANDREW WRIGHT

DATE  
07/21/14  
SCALE  
NOTED

CUSTOMER APPROVAL

UNLESS SPECIFIED, THIS  
DRAWING IS NOT FOR  
PRODUCTION. The information shown  
on the permitting and design listed only.  
Colors shown are representations of  
the indicated specifications, and may  
not be an exact match of the finished  
product.

©2014 CNP Signs & Graphics  
The original concepts and/or alterations  
contained in this document are the  
exclusive property of CNP Signs & Graphics.  
Reproduction or modification of this design, in any  
manner or medium without authorized and  
written consent of CNP is expressly prohibited.

|           |        |           |        |
|-----------|--------|-----------|--------|
| SHEET     | 14-414 | PROJECT # | 315448 |
| REVISIONS | 5      | DATE      |        |


| NO. | DESCRIPTION | DATE | BY |
|-----|-------------|------|----|
| 1   | 2014/11/21  | 11   |    |
| 2   | 2014/11/21  | 11   |    |
| 3   | 2014/11/21  | 11   |    |
| 4   | 2014/11/21  | 11   |    |
| 5   | 2014/11/21  | 11   |    |
| 6   | 2014/11/21  | 11   |    |

KEY NO.

B1 B2

CUSTOMER APPROVAL  
APPROVED BY: \_\_\_\_\_ DATE: \_\_\_\_\_


2 of 7

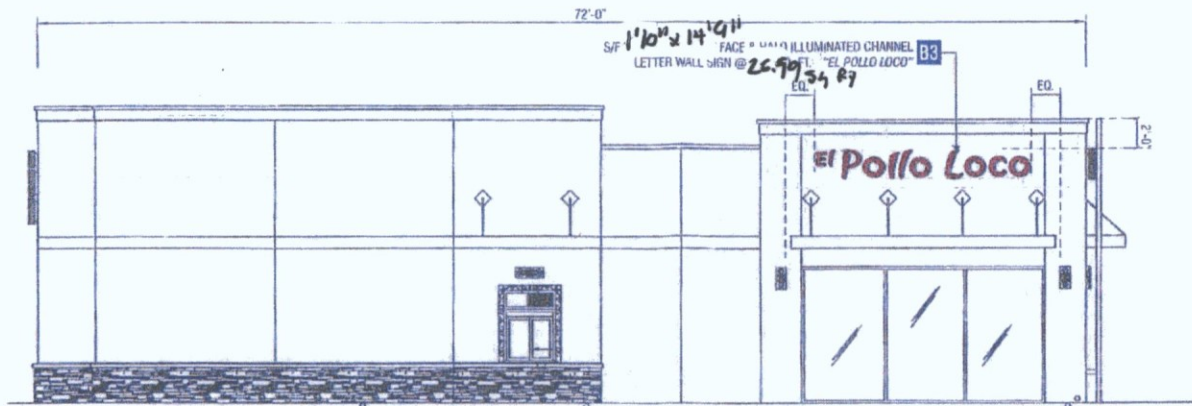

26.99 sf

# SOUTH/LEFT ELEVATION

SCALE: 1/8" = 1'-0"

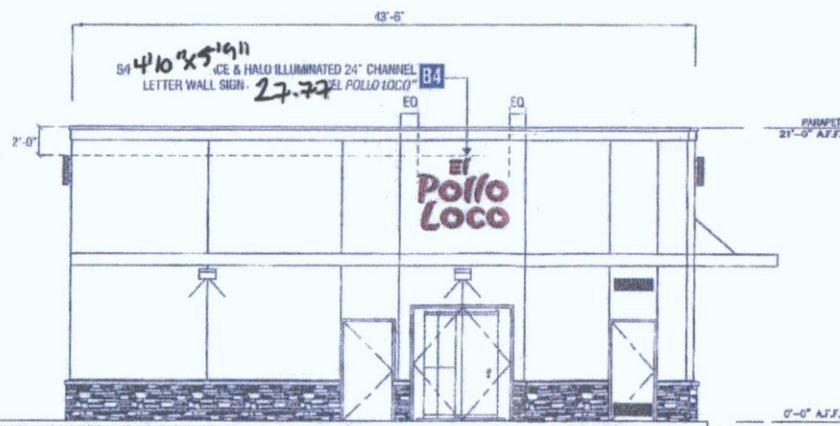

27.77 sf

# WEST/REAR ELEVATION

SCALE: 1/8" = 1'-0"

DATE 1/17/17

INITIALS [Signature]

STIPULATION SET  
RETAIN FOR RECORDS  
APPROVED

5-M5-2013/15

**CNP**  
SIGNS & GRAPHICS

4530 Mission Gorge Place  
San Diego, CA 92120  
Tel: 619.283.2191  
Fax: 619.283.8503  
Web: www.cnpsigns.com

CLIENT



PROJECT  
EL POLLO LOCO #6121

LOCATION  
15448 NORTH PIMA RD.  
SCOTTSDALE, AZ 85260

SHEET TITLE  
BUILDING ELEVATIONS

ARCHITECT  
JENNIFER GLAVIN  
DESIGNER  
ANDREW WRIGHT

DATE 07/21/14 SCALE NOTED

CUSTOMER APPROVAL

UNLESS SPECIFIED, THIS DRAWING IS NOT FOR PRODUCTION. The information shown is for permitting and design intent only. Colors shown are representative of the indicated specifications, and may not be an exact match of the finished product.

©2014 CNP Signs & Graphics  
The original concepts and/or illustrations contained in this document are the exclusive property of CNP Signs & Graphics. Disclosure or reproduction of this design, in any manner or medium without individual and written consent of CNP is expressly forbidden.

| DATE      | PROJECT # |
|-----------|-----------|
| 14-414    | 315448    |
| REVISIONS | NO.       |
| 5         |           |


| NO. | DATE     | BY | REVISION |
|-----|----------|----|----------|
| 1   | 10/10/14 | 11 |          |
| 2   | 10/10/14 | 11 |          |
| 3   | 10/10/14 | 11 |          |
| 4   | 10/10/14 | 11 |          |
| 5   | 10/10/14 | 11 |          |
| 6   | 10/10/14 | 11 |          |

KEY NO.

B3/B4

3 of 7

| CUSTOMER APPROVAL |       |
|-------------------|-------|
| APPROVED BY:      | DATE: |

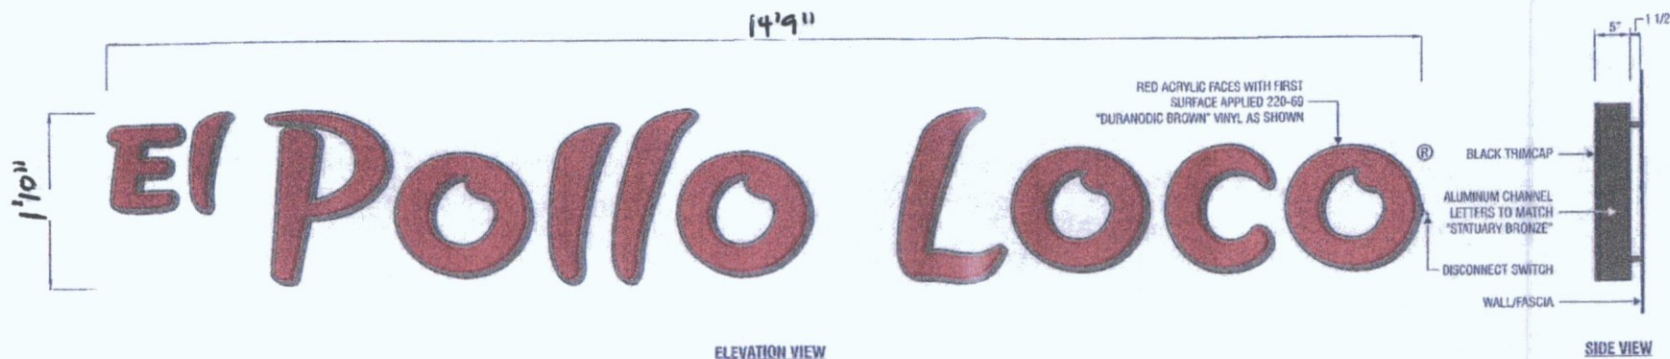


ELEVATION VIEW

SIDE VIEW

24" FACE & HALO ILLUMINATED CHANNEL LETTER WALL SIGN 26.99 SQUARE FEET

SCALE: 3/4" = 1'-0"

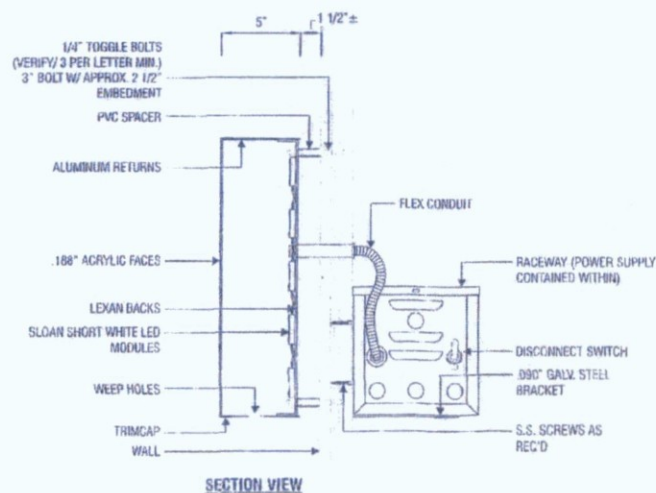

SECTION VIEW

GENERAL LED POWER SUPPLY  
(11PS-12-60W-100-277V (0.8 AMP))

**CNP**  
SIGNS & GRAPHICS

4530 Mission Gorge Place  
San Diego, CA 92120  
Tel: 619.283.2191  
Fax: 619.283.9503  
Web: www.cnpsigns.com

CLIENT



PROJECT

EL POLLO LOCO #6121

LOCATION

15448 NORTH PIMA RD.  
SCOTTSDALE, AZ 85260

SHEET NO.

WALL SIGNS

NOTED BY

JENNIFER GLAVIN

DESIGNER

ANDREW WRIGHT

DATE

07/21/14

SCALE

NOTED

CUSTOMER APPROVAL

UNLESS SPECIFIED, THIS DRAWING IS NOT FOR PRODUCTION. The information shown is for permitting and design intent only. Colors shown are representations of the indicated specifications, and may not be an exact match of the finished product.

© 2014 CNP Signs & Graphics  
The original concepts and/or illustrations contained in this document are the exclusive property of CNP Signs & Graphics. Duplication or reproduction of this design, in any manner or without written authorization, is strictly prohibited.

| Sheet     | Project # |
|-----------|-----------|
| 14-414    | 315448    |
| REVISIONS | 5         |

| NO. | DATE     | BY | REVISION |
|-----|----------|----|----------|
| 1   | 07/21/14 | JW |          |
| 2   | 07/21/14 | JW |          |
| 3   | 07/21/14 | JW |          |
| 4   | 07/21/14 | JW |          |
| 5   | 07/21/14 | JW |          |
| 6   |          |    |          |

KEY NO.

B1 B2 B3

NOTES: 120V POWER. SIGN TO BE UL LISTED WITH APPROVED DISCONNECT SWITCH. GROUNDING AND BONDING IN ACCORDANCE WITH ARTICLE 600 NEC.



CUSTOMER APPROVAL

APPROVED BY

DATE


DATE 11/27/17  
INITIALS [Signature]  
APPROVED  
STIPULATION SET  
RETAIN FOR RECORDS  
5-M5-2013#5

4 of 7

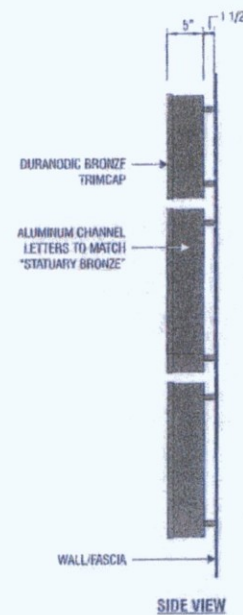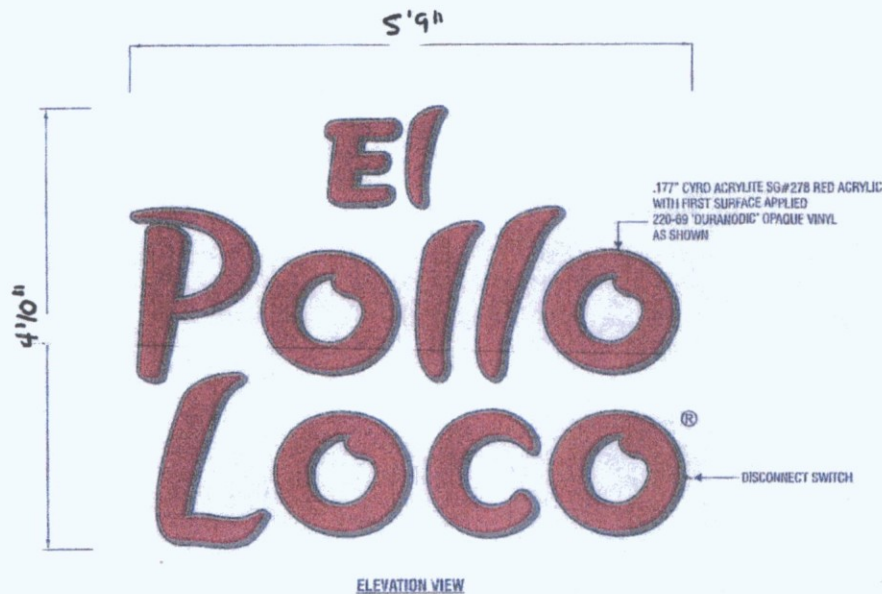


24" FACE & HALO ILLUMINATED CHANNEL LETTER WALL SIGN (STACKED VERSION) 24.75 SQUARE FEET

SCALE: 3/4" = 1'-0"

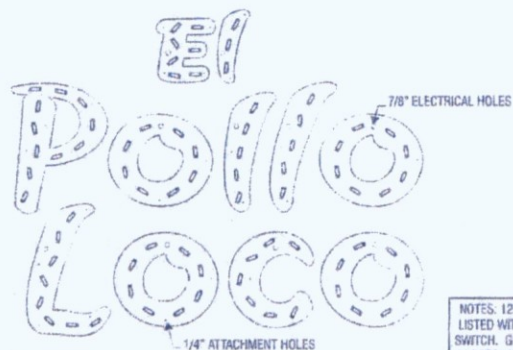

NOTES: 120V POWER. SIGN TO BE UL LISTED WITH APPROVED DISCONNECT SWITCH. GROUNDING AND BONDING IN ACCORDANCE WITH ARTICLE 600 NEC.

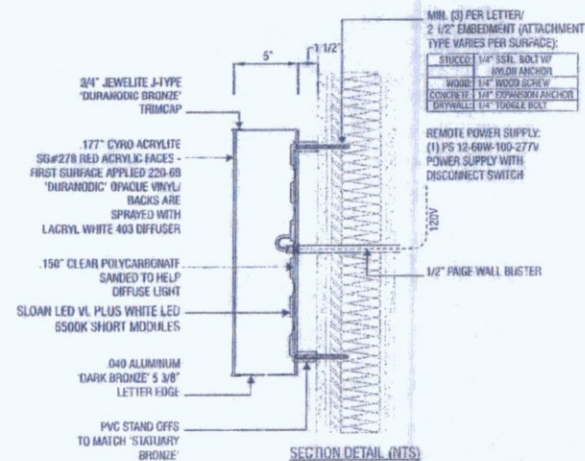

GENERAL LED POWER SUPPLY  
(1)PS-12-60W-100-277V (0.8 AMPS)

**CNP**  
SIGNS & GRAPHICS

4530 Mission Gorge Place  
San Diego, CA 92120  
Tel: 619.283.2191  
Fax: 619.283.9803  
Web: www.cnp signs.com

CLIENT



PROJECT  
EL POLLO LOCO #6121

LOCATION  
15448 NORTH PIMA RD.  
SCOTTSDALE, AZ 85260

SHEET NAME  
WALL SIGNS

DESIGNED BY  
JENNIFER GLAVIN  
DESIGNED BY  
ANDREW WRIGHT

DATE  
07/21/14  
SCALE  
NOTED

CUSTOMER APPROVAL

UNLESS SPECIFIED, THIS DRAWING IS NOT FOR PRODUCTION. The information shown is for permitting and design intent only. Colors shown are representations of the indicated specifications, and may not be an exact match of the finished product.

©2014 CNP Signs & Graphics

The original concepts and/or illustrations contained in this document are the exclusive property of CNP Signs & Graphics. No reproduction or use of this design, in any manner or medium, without individual and written consent of CNP is expressly forbidden.

PROJECT # 315448  
DRAWING NO 14-414  
REVISIONS 5

| NO. | DATE     | BY | CHK | APP |
|-----|----------|----|-----|-----|
| 1   | 07/21/14 | JG |     |     |
| 2   | 08/05/14 | JG |     |     |
| 3   | 08/05/14 | JG |     |     |
| 4   | 08/18/14 | JG |     |     |
| 5   | 10/12/14 | JG |     |     |
| 6   |          |    |     |     |

KEY NO

B4

4 of 7

DATE 11/1/17  
INITIALS JGE  
APPROVED  
STIPULATION SET  
RETAIN FOR RECORDS  
5-M-5-2013 #15

# CNP

## SIGNS & GRAPHICS

4530 Mission Gorge Place  
San Diego, CA 92120  
Tel: 619.283.2191  
Fax: 619.283.9503  
Web: www.cnp-signs.com

CUSTOMER



PROJECT  
EL POLLO LOCO #6121

LOCATION  
15448 NORTH PIMA RD.  
SCOTTSDALE, AZ 85260

SHEET TITLE  
DIRECTIONAL SIGNS

ACCEPTED BY  
JENNIFER GLAVIN

DESIGNED BY  
ANDREW WRIGHT

DATE  
07/21/14

SCALE  
NOTED

CUSTOMER APPROVAL

UNLESS SPECIFIED, THIS  
DRAWING IS NOT FOR  
PRODUCTION. The information shown  
is for planning and design intent only.  
Colors shown are representations of  
the indicated specifications, and may  
not be an exact match of the finished  
product.

©2014 CNP Signs & Graphics  
The original concepts and/or illustrations  
contained in this document are the  
exclusive property of CNP Signs & Graphics.  
Disclosure or reproduction of this design, in any  
manner or medium without authorized and  
written consent of CNP is expressly forbidden.


|           |        |           |        |
|-----------|--------|-----------|--------|
| DATE      | 14-414 | PROJECT # | 315446 |
| REVISIONS | 5      | DATE      |        |

| NO. | DESCRIPTION | DATE | BY |
|-----|-------------|------|----|
| 1   | ISSUED      | JAN  |    |
| 2   | REVISED     | FEB  |    |
| 3   | REVISED     | FEB  |    |
| 4   | REVISED     | FEB  |    |
| 5   | REVISED     | FEB  |    |

KEY NO.

C1/C2


5 of 7

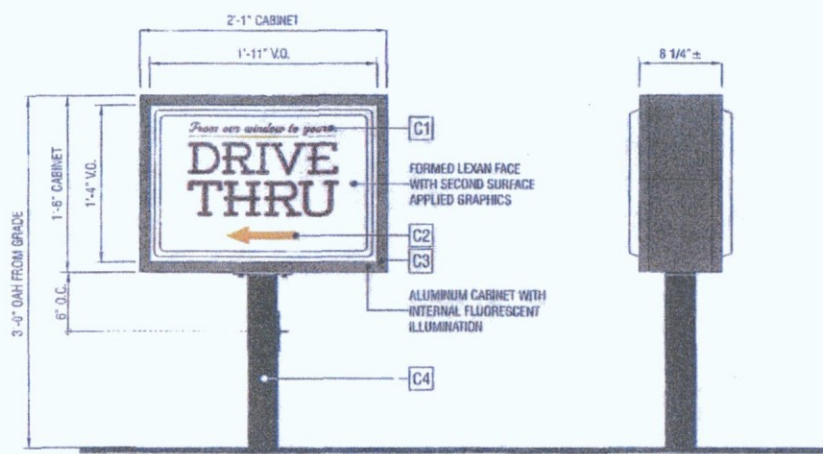


ELEVATION VIEW

SIDE VIEW

| COLOR SPECIFICATIONS |                                        |
|----------------------|----------------------------------------|
| C1                   | 383C-63 "Rust Brown" Translucent Vinyl |
| C2                   | Aston 3826 "Orange" Translucent Vinyl  |
| C3                   | Lacryl Series 400 L-403-W "White"      |
| C4                   | BLACK POWDERCOAT WITH SATIN FINISH     |

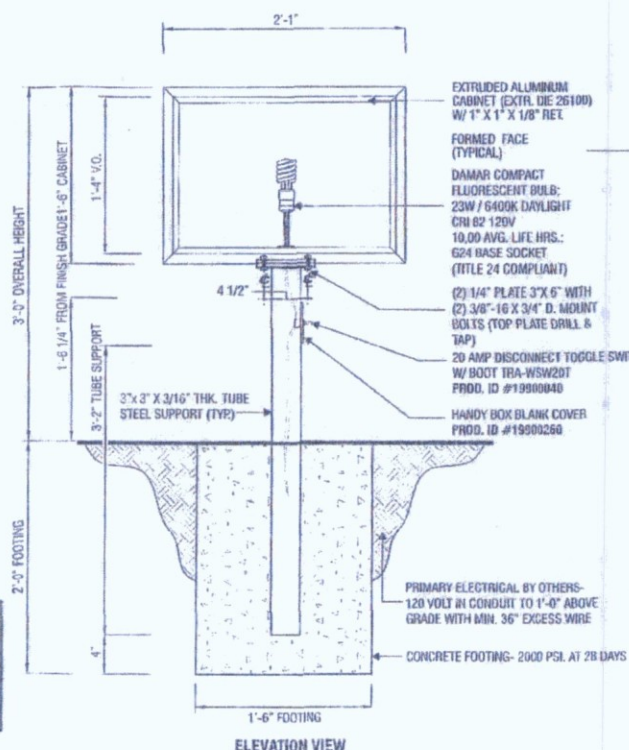

ELEVATION VIEW

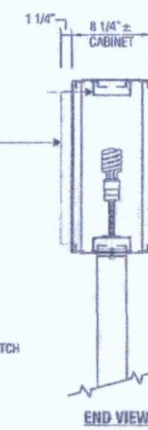

EXTRUDED ALUMINUM  
CABINET (EXTRA DIE 26100)  
W/ 1" X 1" X 1/8" RET.  
FORMED FACE  
(TYPICAL)  
DAMAR COMPACT  
FLUORESCENT BULB:  
23W / 6400K DAYLIGHT  
CRI 82 120V  
10,000 AVG. LIFE HRS.:  
G24 BASE SOCKET  
(TITLE 24 COMPLIANT)  
(2) 1/4" PLATE 3"x6" WITH  
(2) 3/8"-16 X 3/4" D. MOUNT  
BOLTS (TOP PLATE DRILL &  
TAP)  
20 AMP DISCONNECT TOGGLE SWITCH  
W/ BOOT TRA-WSW20T  
PRD. ID #19990040  
HANDY BOX BLANK COVER  
PRD. ID #19990260

PRIMARY ELECTRICAL BY OTHERS-  
120 VOLT IN CONDUIT TO 1'-0" ABOVE  
GRADE WITH MIN. 36" EXCESS WIRE  
CONCRETE FOOTING- 2000 PSI AT 28 DAYS


NOTES: 120V POWER. SIGN TO BE UL  
LISTED WITH APPROVED DISCONNECT  
SWITCH. GROUNDING AND BONDING IN  
ACCORDANCE WITH ARTICLE 600 NEC.

### D/F DIRECTIONAL SIGN

SCALE: 1" = 1'-0"

DATE 11/7/17  
INITIALS [Signature]  
APPROVED  
STIPULATION SET  
RETAIN FOR RECORDS  
5-M-201375

CUSTOMER APPROVAL  
APPROVED BY: [Signature]  
DATE: [Signature]

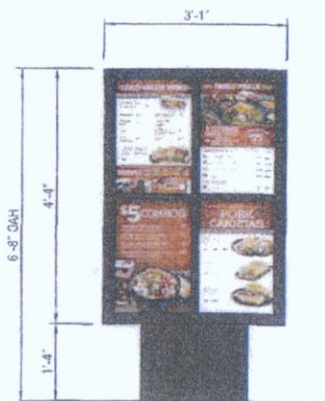


ELEVATION VIEW

S/F PREVIEW MENU 13.4 SQ. FT.

SCALE: 1/2" = 1'-0"

NOTE: THE DIAGRAM BELOW IS ALSO BASED OFF THE "STANDARD" LOCATION. EPL CORP. HAS PROVIDED TO CNP IT IS THE GC'S RESPONSIBILITY TO COORDINATE WITH THE OWNER ON THE EXACT LOCATION. CNP WILL NOT BE HELD RESPONSIBLE FOR ANY REMOVALS, RE-POSITIONING AND RE-INSTALLATION. ALL REMOVALS, RE-POSITIONING AND RE-INSTALLATION WILL BE BILLED ON A T&M BASIS.

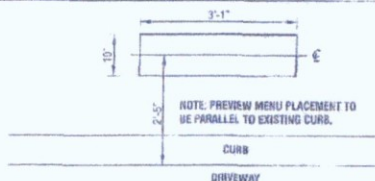

NOTE: THE DIAGRAM ABOVE IS BASED OFF A STRAIGHT CURB. SHOULD THE MENU FALL ON THE RADIUS OF A CURB THIS DIAGRAM IS NOT APPLICABLE. IT IS THE CONTRACTOR'S RESPONSIBILITY TO COORDINATE THE LOCATION OF THE MENU BOARD IN THAT INSTANCE.

MENU BOARD PLACEMENT


NOTES:

1. INSTALL LEVELING NUTS ONTO ANCHOR BOLTS.
2. ATTACH POLE TO MENU BOARD.
3. INSTALL NEW SIGN POLE & SHROUD ONTO ANCHOR BOLT FOUNDATION.
4. INSTALL ILLUMINATED EXTENDER. MAKE ELECTRICAL CONNECTION.
5. LEVEL SIGN.
6. MAKE FINAL ELECTRICAL CONNECTIONS. TEST LIGHT SIGN.
7. CLEAN AREA & REMOVE PACKING MATERIALS.

DESIGN NOTE:

SIGN, POLE AND CONCRETE BASE ARE DESIGNED TO WITHSTAND A WIND OF 30 PS.F CONCRETE BASE DESIGNED USING A LATERAL SOIL BEARING CAPACITY OF 300 PS.F/FT. IF THESE SOIL CONDITIONS DO NOT EXIST IT IS THE ERECTOR'S RESPONSIBILITY TO HAVE A NEW BASE DESIGNED FOR THE EXISTING SOIL CONDITIONS BY A LICENSED STRUCTURAL ENGINEER. FOUNDATION TO BE POURED AGAINST UNDISTURBED SOIL.

5-MAY-2013 HS  
STIPULATION SET  
RETAIN FOR RECORDS  
APPROVED  
DATE 11/27/14  
INITIALS

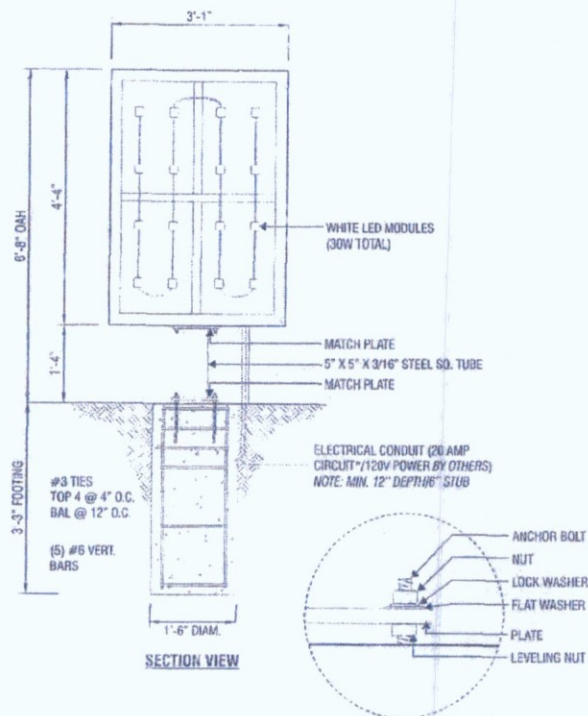


SECTION VIEW

\* SINGLE 20 AMP CIRCUIT TO BE PROVIDED FOR MENUS AND DIRECTIONAL SIGNS.

MENU DETAIL

SCALE: 1/2" = 1'-0"

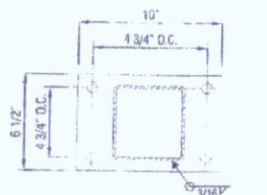

1/2" STEEL PLATE DETAIL (5/8" BOLTS)

NOTES: 120V POWER. SIGN TO BE UL LISTED WITH APPROVED DISCONNECT SWITCH. GROUNDING AND BONDING IN ACCORDANCE WITH ARTICLE 600 NEC.

CUSTOMER APPROVAL

APPROVED BY: DATE:

**CNP**  
SIGNS & GRAPHICS

4530 Mission Gorge Place  
San Diego, CA 92120  
Tel: 619.283.2191  
Fax: 619.283.9503  
Web: www.cnpsigns.com

CLIENT



PROJECT  
EL POLLO LOCO #6121

LOCATION  
15448 NORTH PIMA RD.  
SCOTTSDALE, AZ 85260

SHEET TITLE  
PREVIEW MENU

DESIGNER  
JENNIFER GLAVIN  
ANDREW WRIGHT

DATE  
07/21/14

SCALE  
NOTED

CUSTOMER APPROVAL

UNLESS SPECIFIED, THIS DRAWING IS NOT FOR PRODUCTION. The information shown is for permitting and design intent only. Colors shown are representations of the indicated specifications, and may not be an exact match of the finished product.

© 2014 CNP Signs & Graphics

The original concepts and/or illustrations contained in this document are the exclusive property of CNP Signs & Graphics. Checkmark or reproduction of this design, in any manner or medium without authorized and written consent of CNP is expressly forbidden.

|           |        |          |        |
|-----------|--------|----------|--------|
| DRW#      | 14-414 | PROJECT# | 315448 |
| REVISION# | 5      | REV      |        |

| REVISIONS | DATE     | BY | TO |
|-----------|----------|----|----|
| 1         | 07/21/14 | JM | 7  |
| 2         | 10/07/14 | TT | 8  |
| 3         | 08/06/14 | TT | 9  |
| 4         | 08/06/14 | TT | 10 |
| 5         | 07/21/14 | TT | 11 |
| 6         |          |    | 12 |

KEY NO.  
D1

6 of 7




ELEVATION VIEW

S/F SPEAKER MENU 37.1 SQ. FT.

SCALE: 1/2" = 1'-0"

NOTE: THE DIAGRAM BELOW IS ALSO BASED OFF THE "STANDARD" LOCATION EPL CORPORATION HAS PROVIDED TO CNP. IT IS THE GO'S RESPONSIBILITY TO COORDINATE WITH THE OWNER ON THE EXACT LOCATION. CNP WILL NOT BE HELD RESPONSIBLE FOR ANY REMOVALS, RE-POSITIONING AND RE-INSTALLATION. ALL REMOVALS, RE-POSITIONING AND RE-INSTALLATION WILL BE BILLED ON A T&M BASIS.

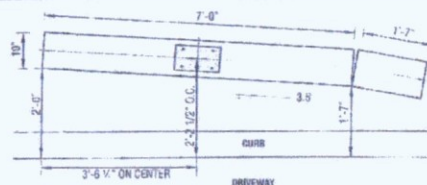

NOTE: THE DIAGRAM ABOVE IS BASED OFF A STRAIGHT CURB. SHOULD THE MENU FALL ON THE RADIUS OF A CURB THIS DIAGRAM IS NOT APPLICABLE. IT IS THE CONTRACTOR'S RESPONSIBILITY TO COORDINATE THE LOCATION OF THE MENU BOARD IN THAT INSTANCE.



MENU BOARD PLACEMENT

- NOTES:
1. INSTALL LEVELING NUTS ONTO ANCHOR BOLTS.
  2. ATTACH POLE TO MENU BOARD.
  3. INSTALL NEW SIGN POLE & SHROUD ONTO ANCHOR BOLT FOUNDATION.
  4. INSTALL ILLUMINATED EXTENDER. MAKE ELECTRICAL CONNECTION.
  5. LEVEL SIGN.
  6. MAKE FINAL ELECTRICAL CONNECTIONS. TEST LIGHT SIGN.
  7. CLEAN AREA & REMOVE PACKING MATERIALS.

NOTE: SPEAKER INSTALLATION & FINAL CONNECTION IS THE RESPONSIBILITY OF THE STORE.

DESIGN NOTE: SIGN POLE AND CONCRETE BASE ARE DESIGNED TO WITHSTAND A WIND OF 30 PS.F. CONCRETE BASE DESIGNED USING A LATERAL SOIL BEARING CAPACITY OF 300 PS.F./FT. IF THESE SOIL CONDITIONS DO NOT EXIST IT IS THE CONTRACTOR'S RESPONSIBILITY TO HAVE A NEW BASE DESIGNED FOR THE EXISTING SOIL CONDITIONS BY A LICENSED STRUCTURAL ENGINEER. FOUNDATION TO BE POURED AGAINST UNDISTURBED SOIL.

DATE 11/19/14  
INITIALS [Signature]  
STIPULATION SET  
RETAIN FOR RECORDS  
APPROVED

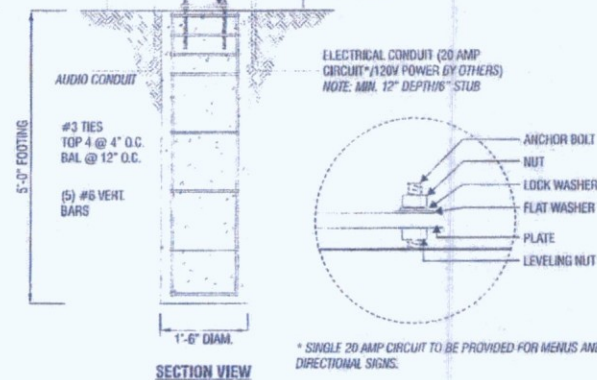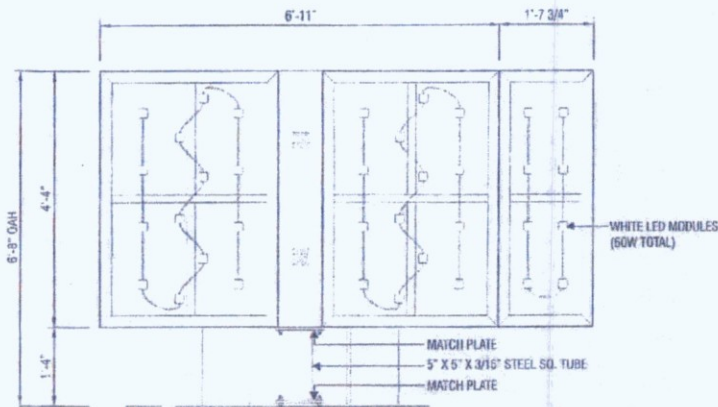


SECTION VIEW

\* SINGLE 20 AMP CIRCUIT TO BE PROVIDED FOR MENUS AND DIRECTIONAL SIGNS.

MENU DETAIL

SCALE: 1/2" = 1'-0"

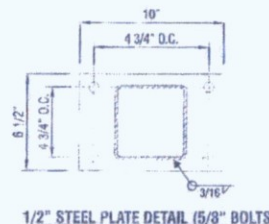

1/2" STEEL PLATE DETAIL (5/8" BOLTS)

NOTES: 120V POWER. SIGN TO BE UL LISTED WITH APPROVED DISCONNECT SWITCH. GROUNDING AND BONDING IN ACCORDANCE WITH ARTICLE 600 NEC.

CUSTOMER APPROVAL

APPROVED BY: [Signature] DATE: [Blank]

**CNP**  
SIGNS & GRAPHICS

4530 Mission Gorge Place  
San Diego, CA 92120  
Tel: 619.283.2191  
Fax: 619.283.9503  
Web: www.cnp-signs.com

CLIENT



PROJECT  
EL POLLO LOCO #6121

LOCATION  
15448 NORTH PIMA RD.  
SCOTTSDALE, AZ 85260

SHEET TITLE  
SPEAKER MENU

ACCT. REP.  
JENNIFER GLAVIN  
DESIGNER  
ANDREW WRIGHT

DATE 07/21/14 SCALE NOTED

CUSTOMER APPROVAL

UNLESS SPECIFIED, THIS DRAWING IS NOT FOR PRODUCTION. The information shown is for planning and design intent only. Colors shown are representative of the indicated specifications, and may not be an exact match of the finished product.

©2014 CNP Signs & Graphics  
The original concepts and illustrations contained in this document are the exclusive property of CNP Signs & Graphics. No reproduction or distribution of this design, in any manner or medium without written consent and without payment of CNP's fee is permitted.

|           |        |           |        |
|-----------|--------|-----------|--------|
| ORDER     | 14-414 | PROJECT # | 315448 |
| REVISIONS | 5      | NEW       |        |

| REV | DATE     | BY | CHK |
|-----|----------|----|-----|
| 1   | 07/21/14 | AW |     |
| 2   | 11/03/14 | AW |     |
| 3   | 06/24/16 | AW |     |
| 4   | 02/19/16 | AW |     |
| 5   | 12/16/16 | AW |     |
| 6   |          |    |     |

KEY NO.

D2

7 of 7