

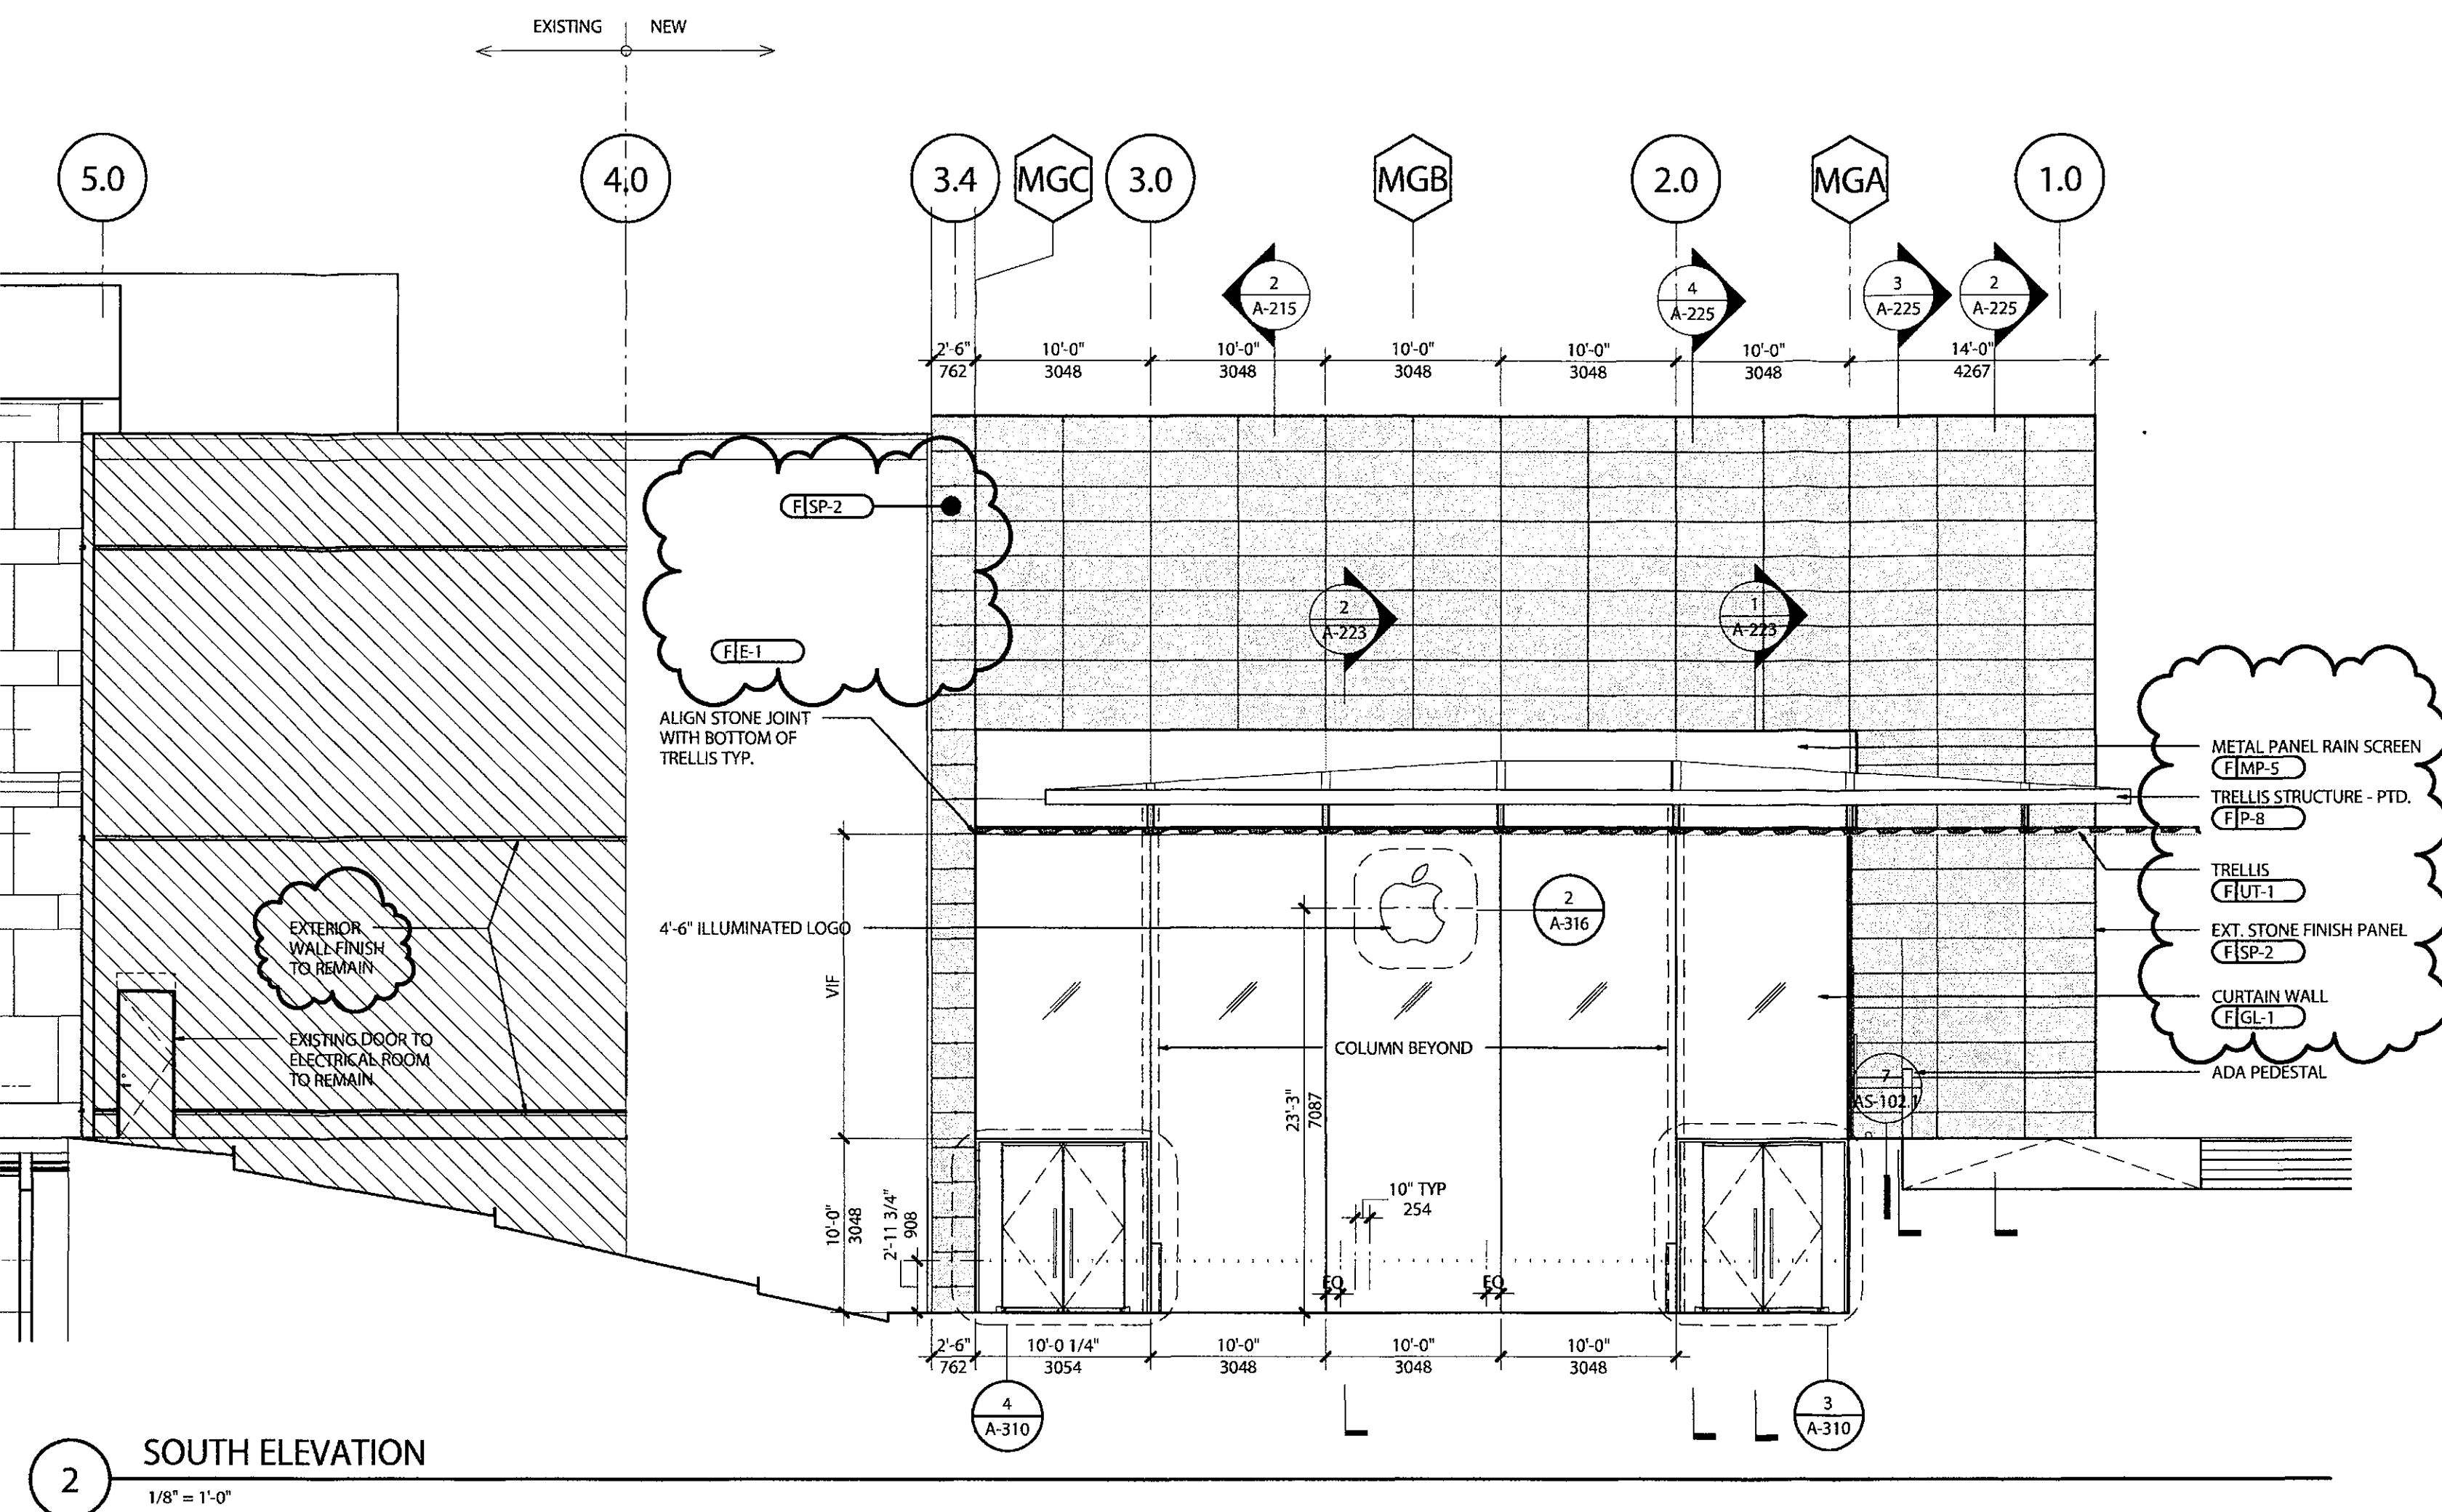
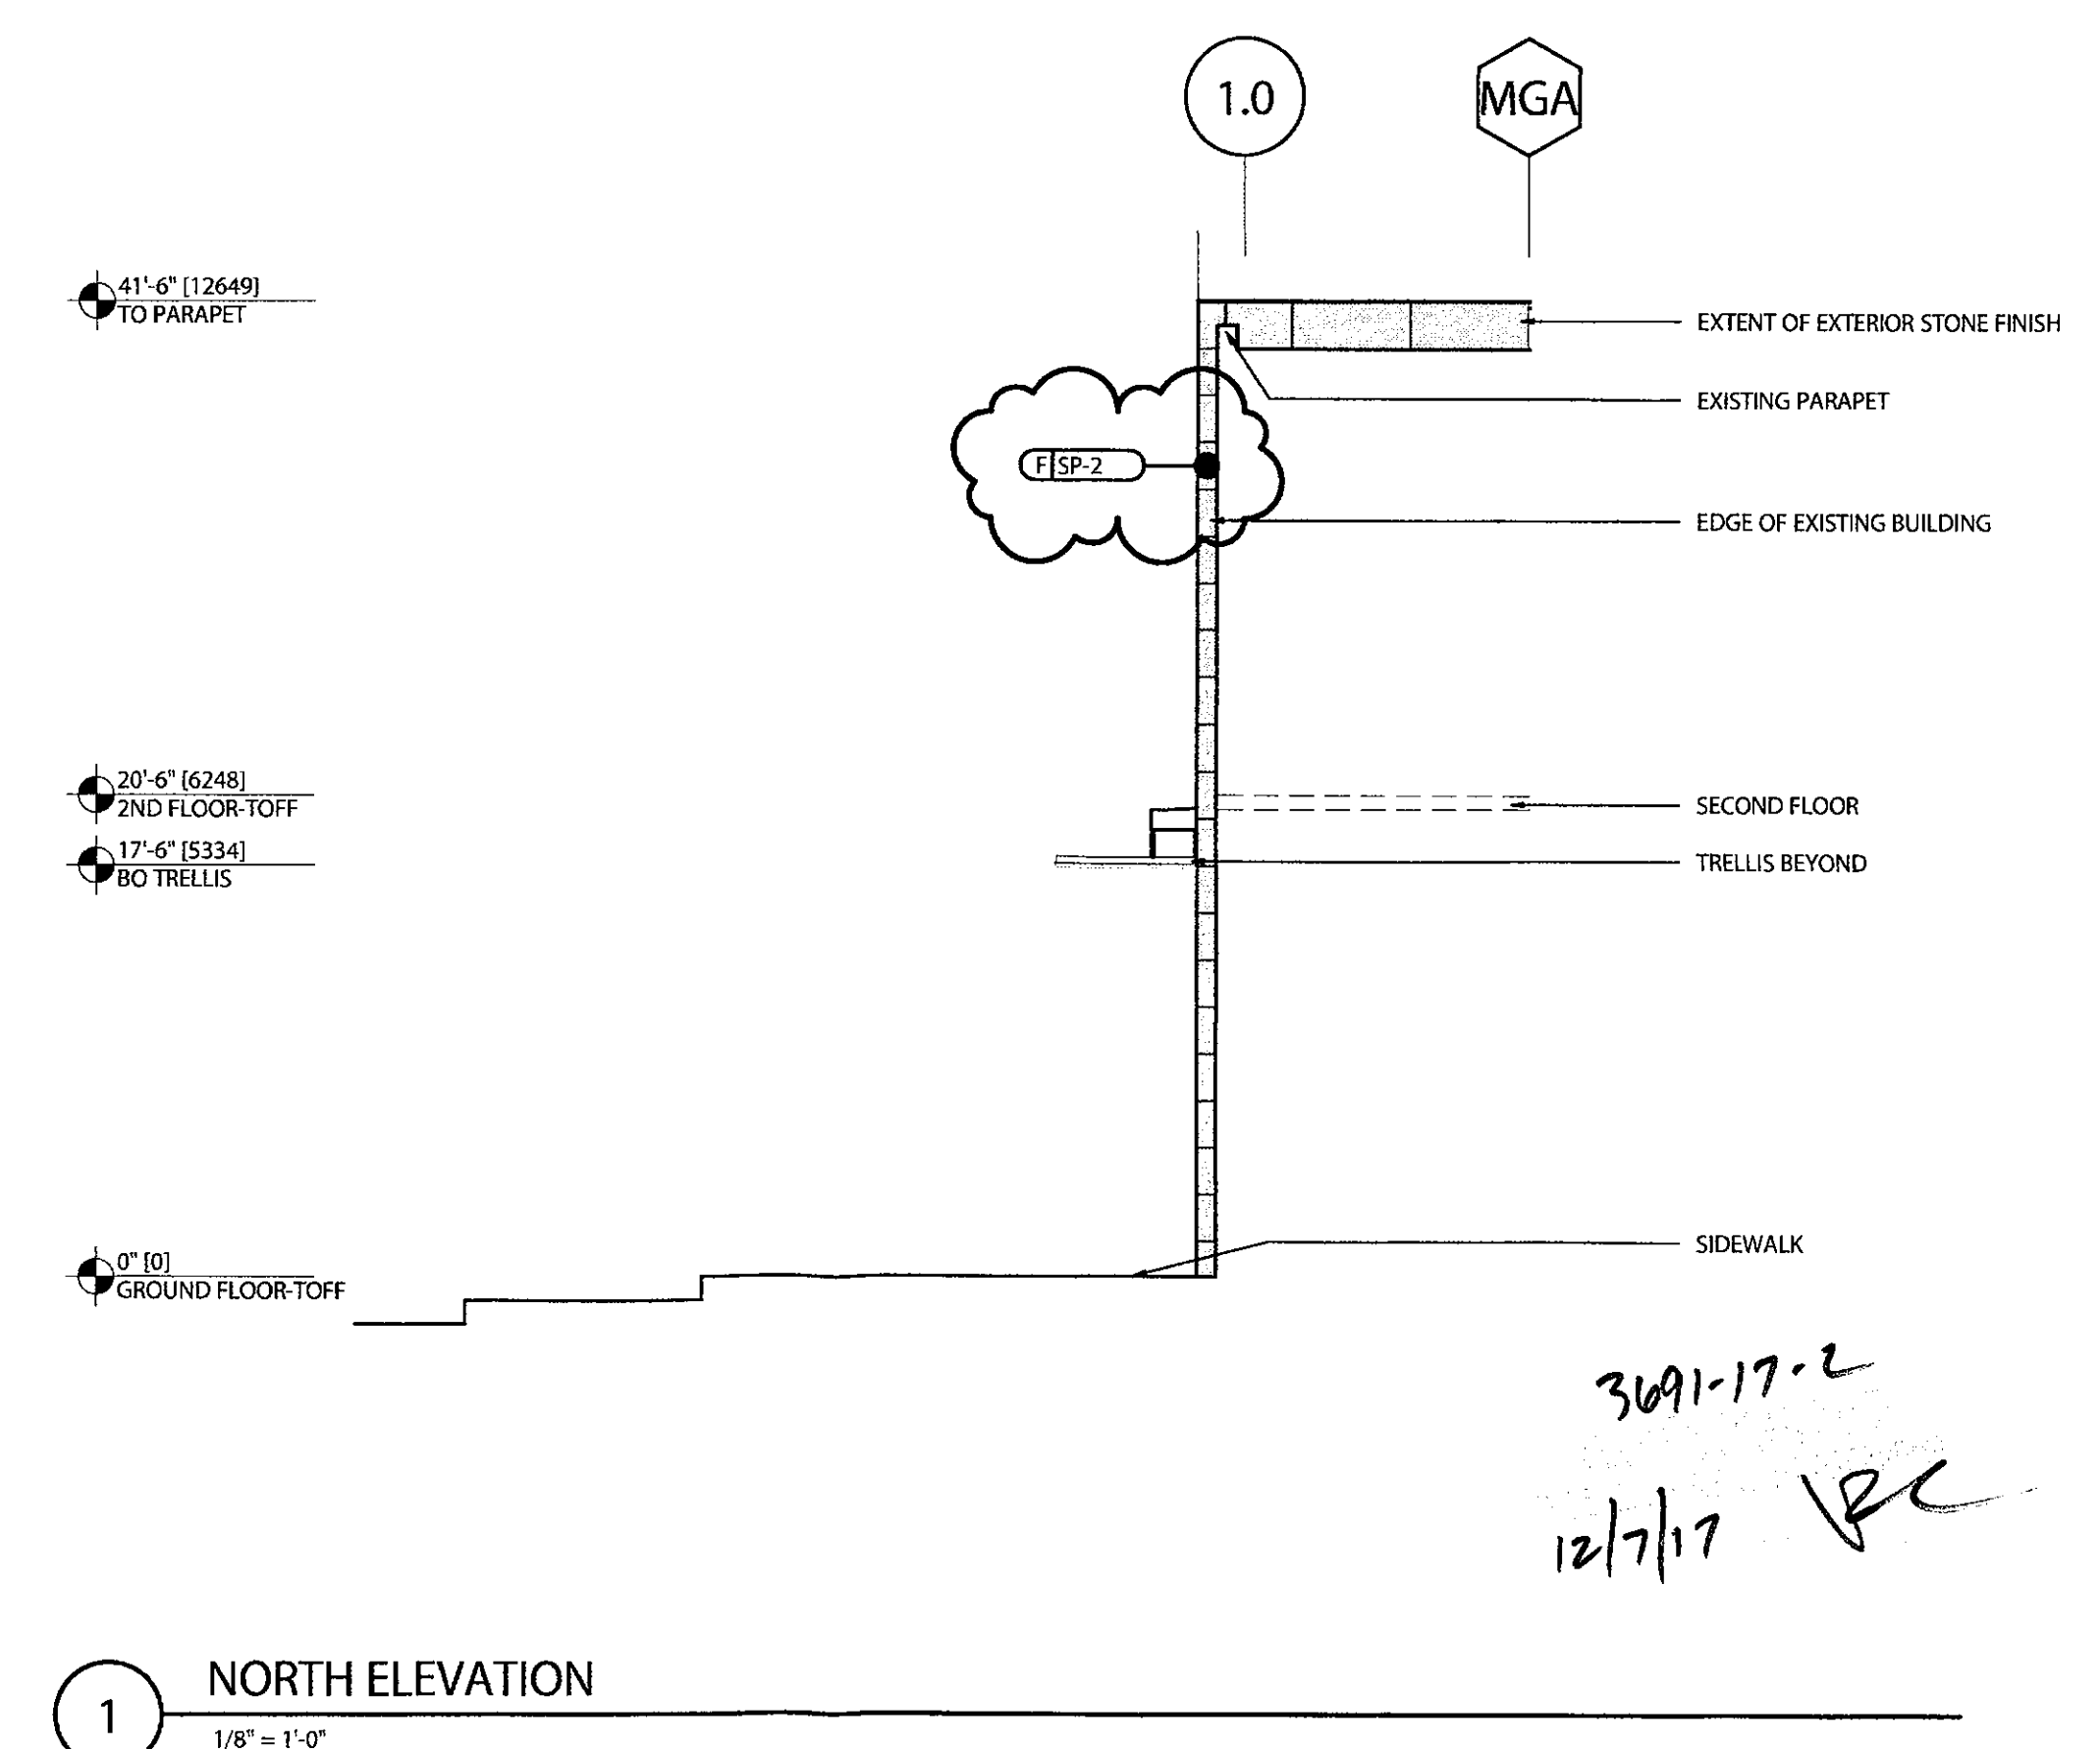
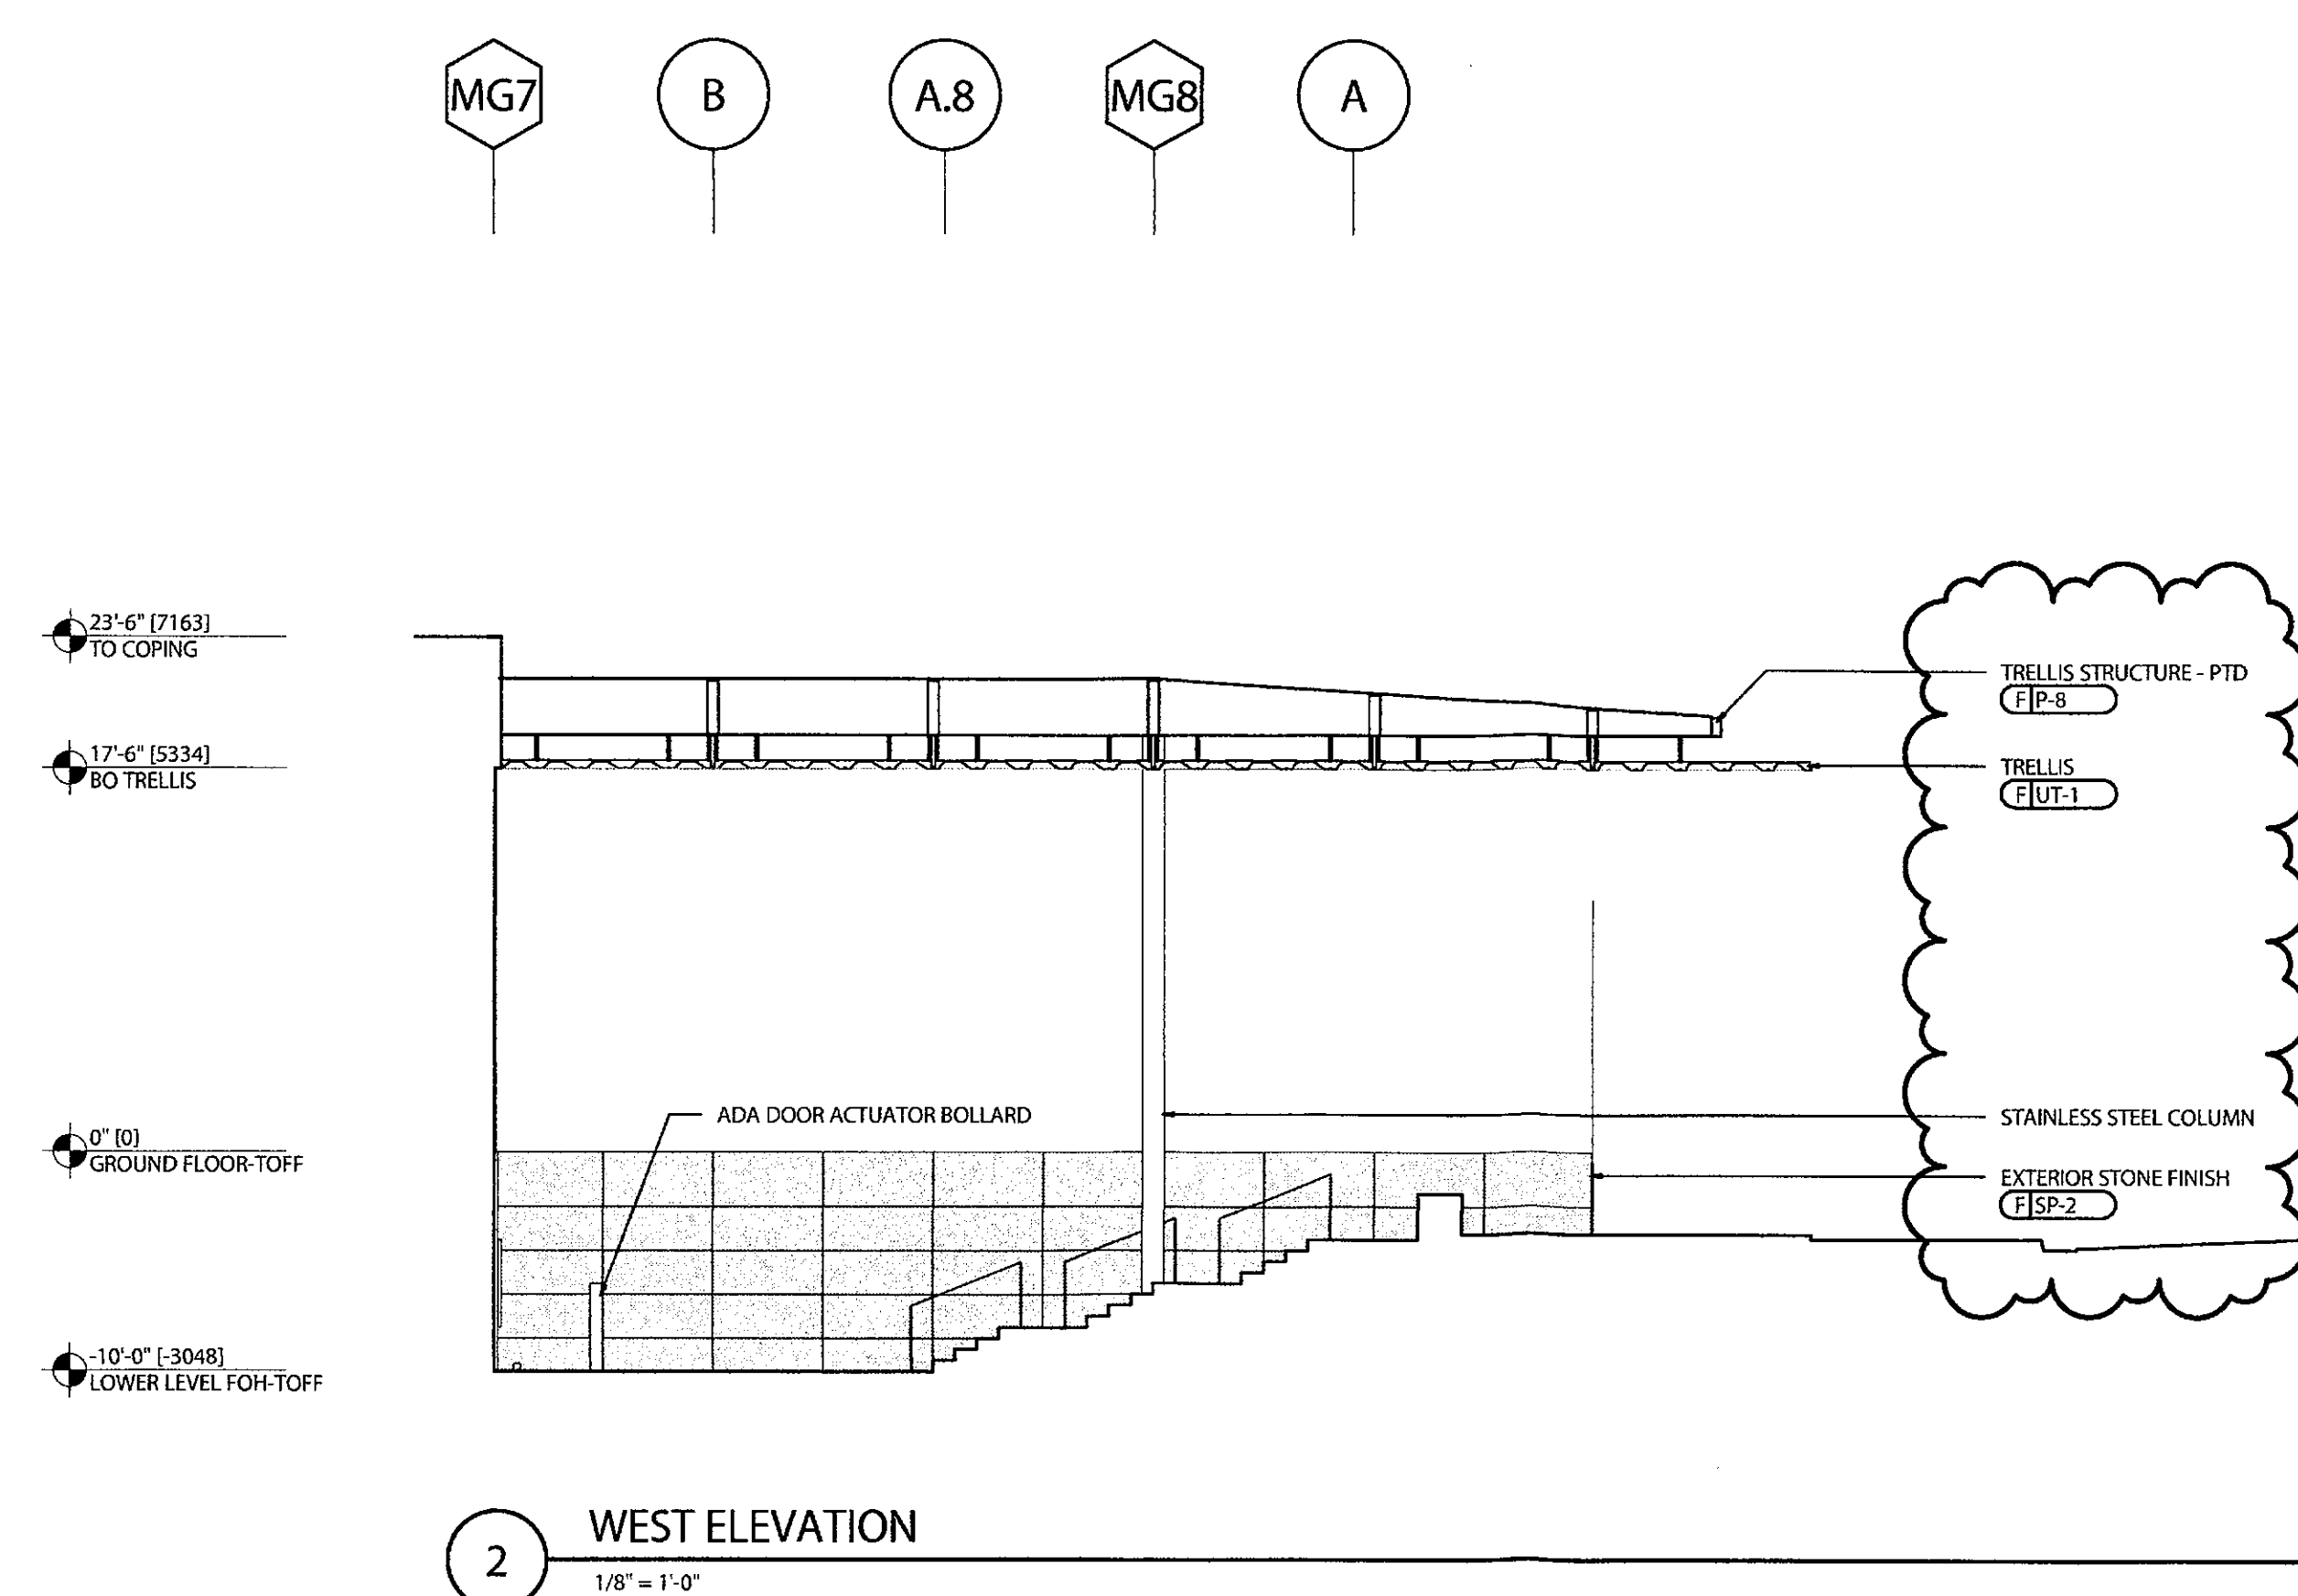
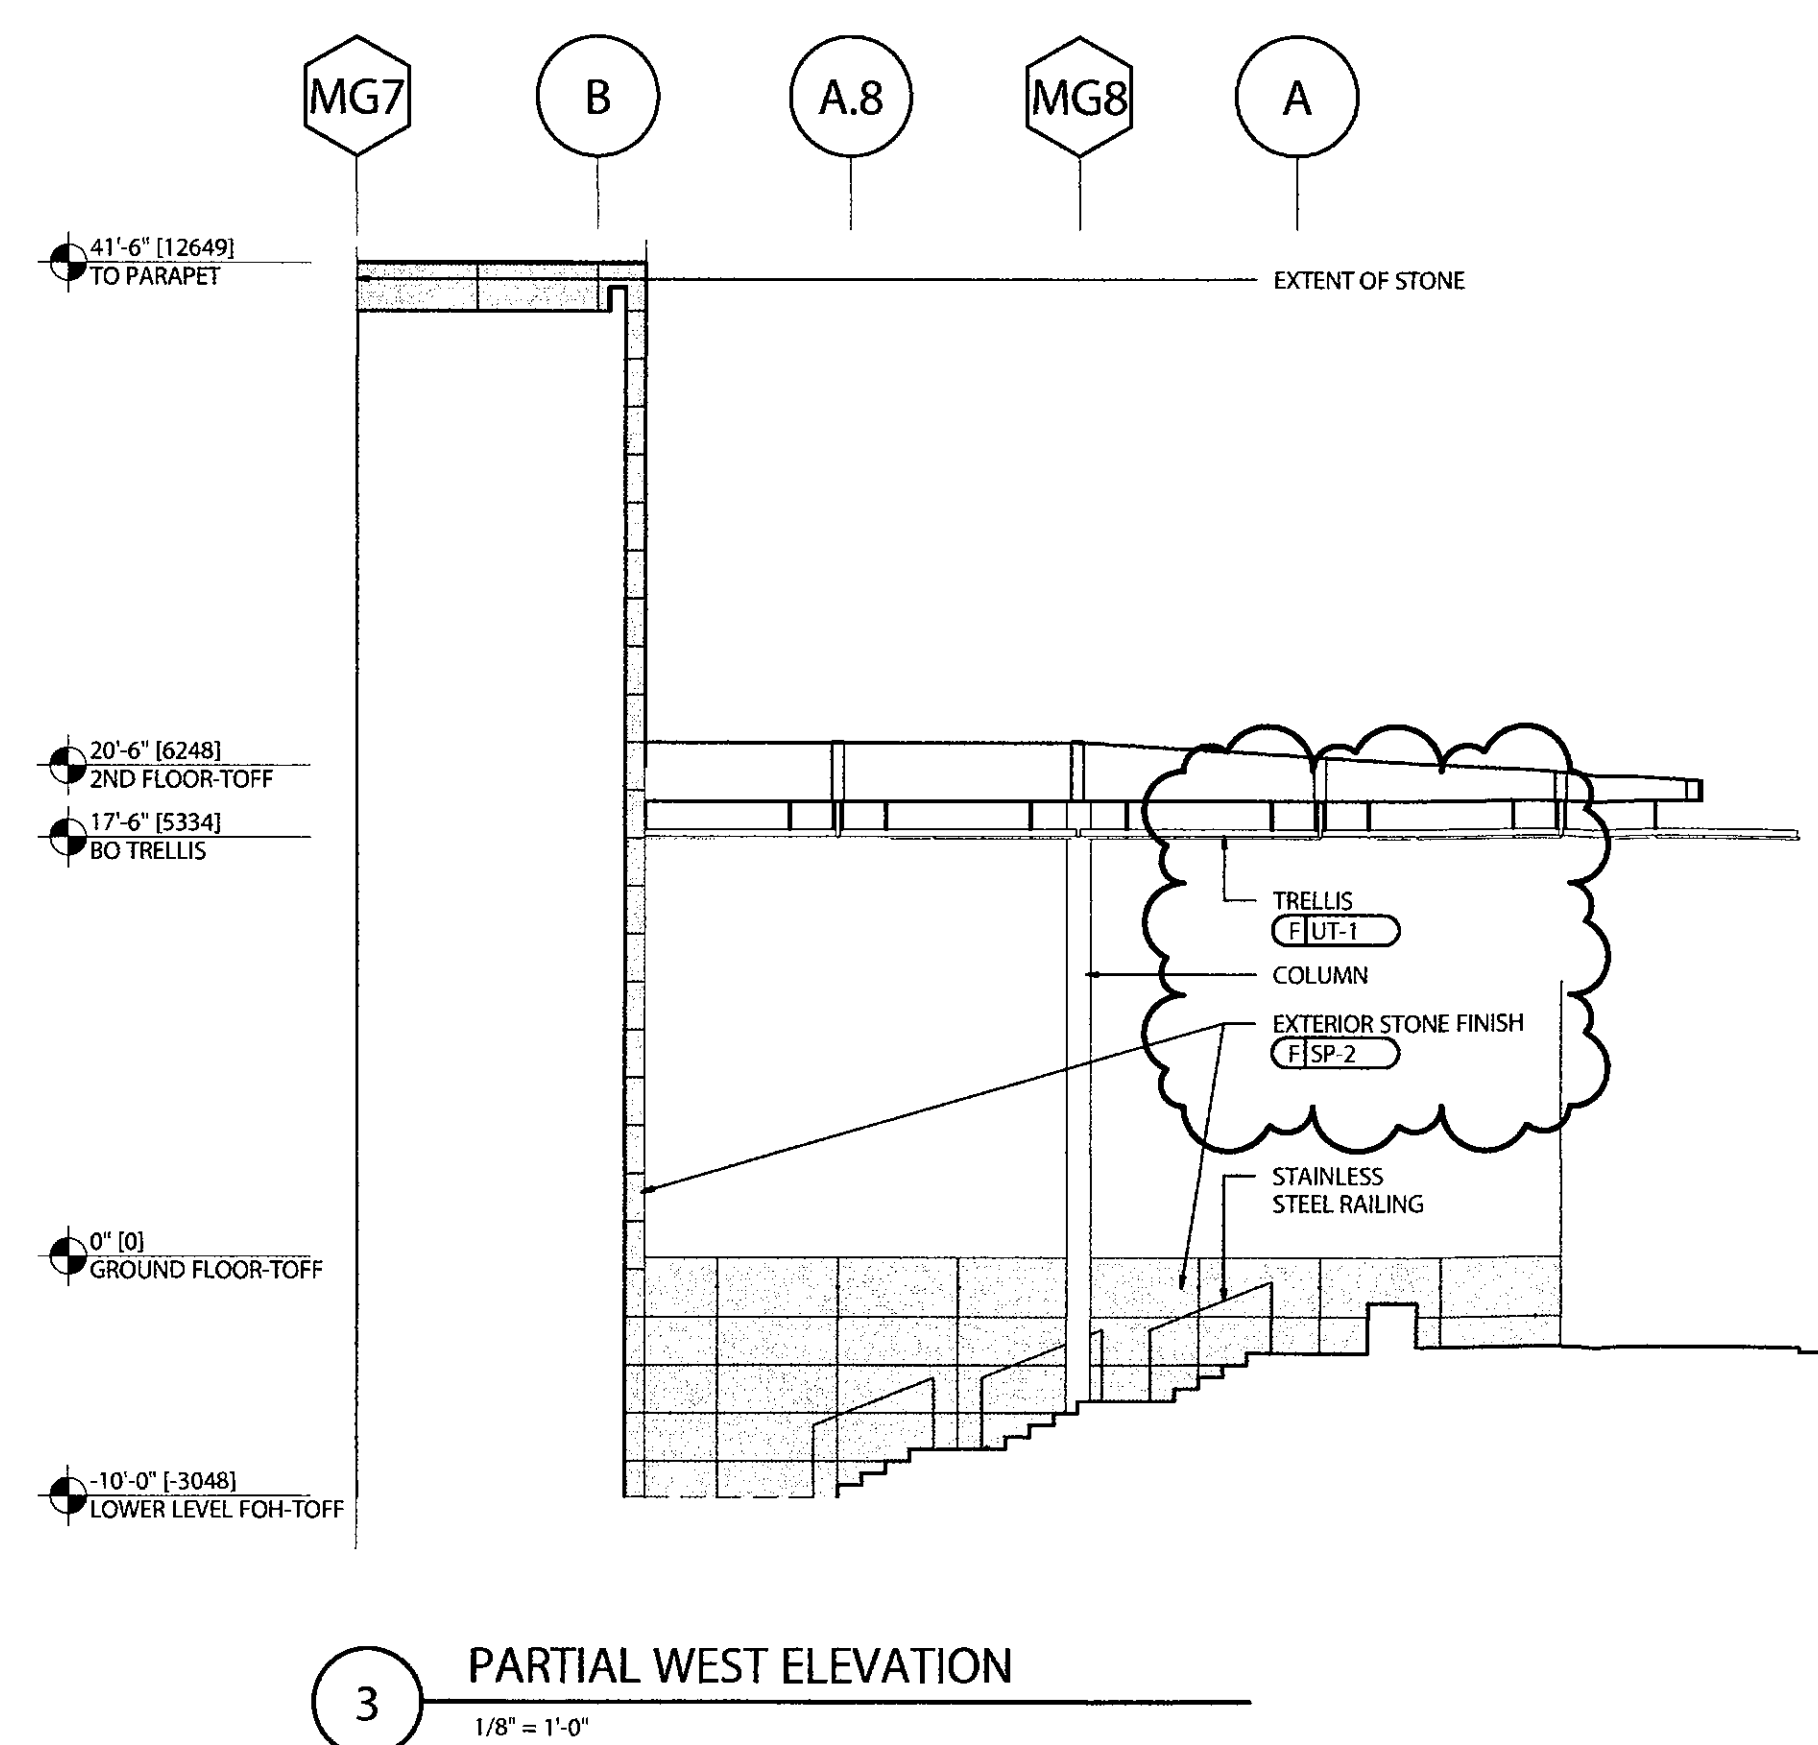


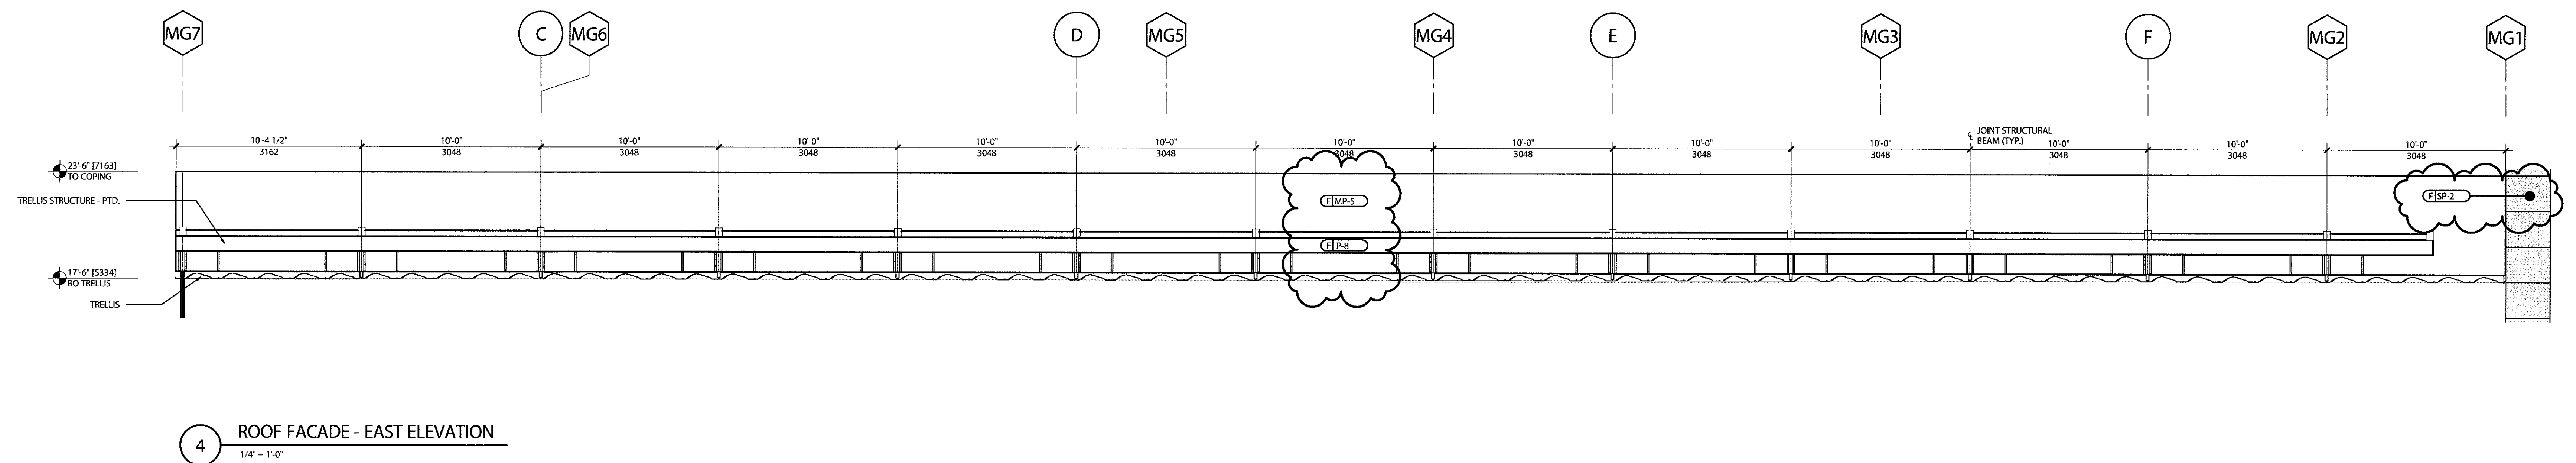

3691-17.2
12/7/17 *Red*

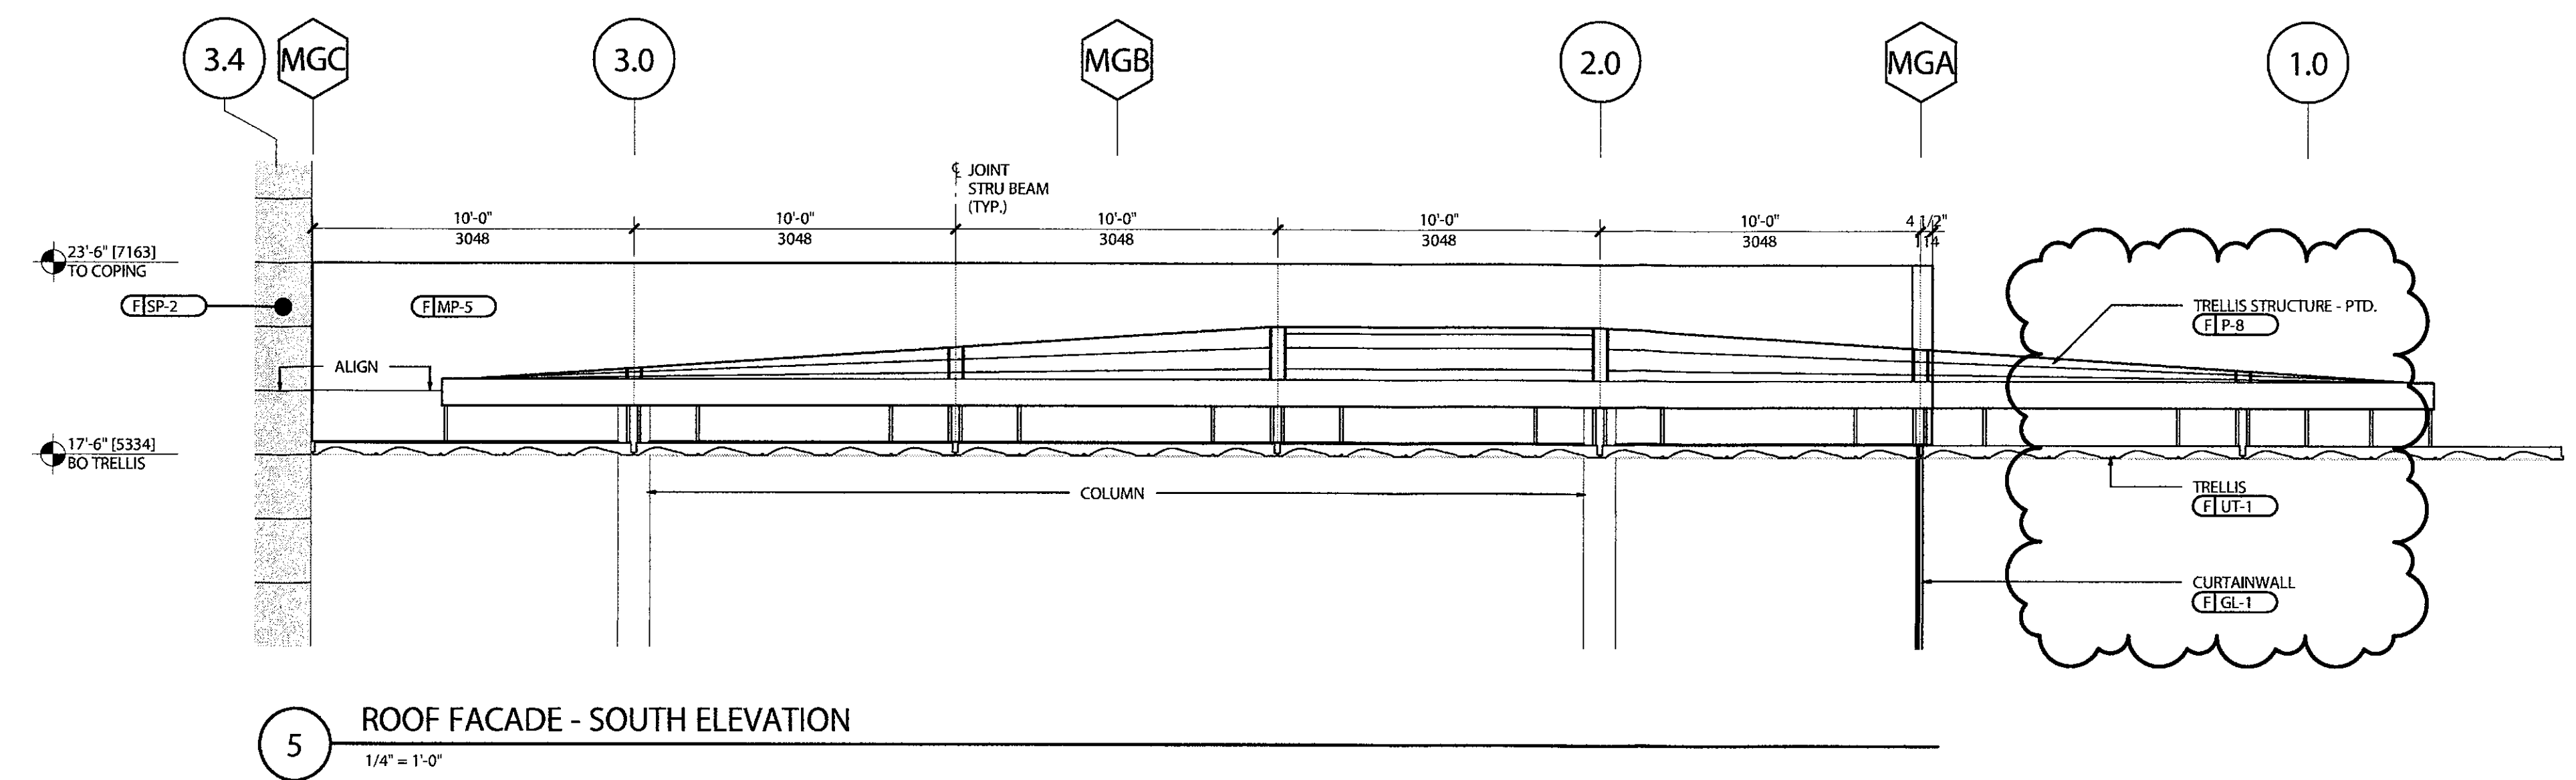

Architect:
Ennead Architects LLP
www.ennead.com

EP, Structure:
Buro Happold
www.burohappold.com


Class Facade
 Nickersley O'Callaghan
 www.eocengineers.com

ighting:
renfro Design Group
www.renfrodesign.com

ndscape:
Colwell Shelor
www.colwellshelor.com

Fire Safety:
Jensen Hughes
www.jensenhughes.com


onspectus Inc.
www.conspectusinc.com

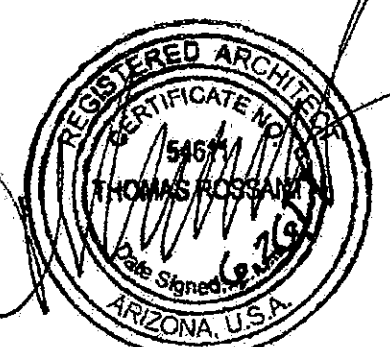


Scottsdale Fashion Square - R031
Scottsdale, AZ

ued/Revised	Date
% CD	05/22/2017
% CD Addendum	05/30/2017
% CD Addendum #2	06/09/2017
heck Set	07/07/2017
0% CD Issue - Draft	07/17/2017
ermit Issue	07/19/2017
0% CD Issue	08/09/2017
ermit Reissue	09/14/2017

BUILDING ELEVATIONS

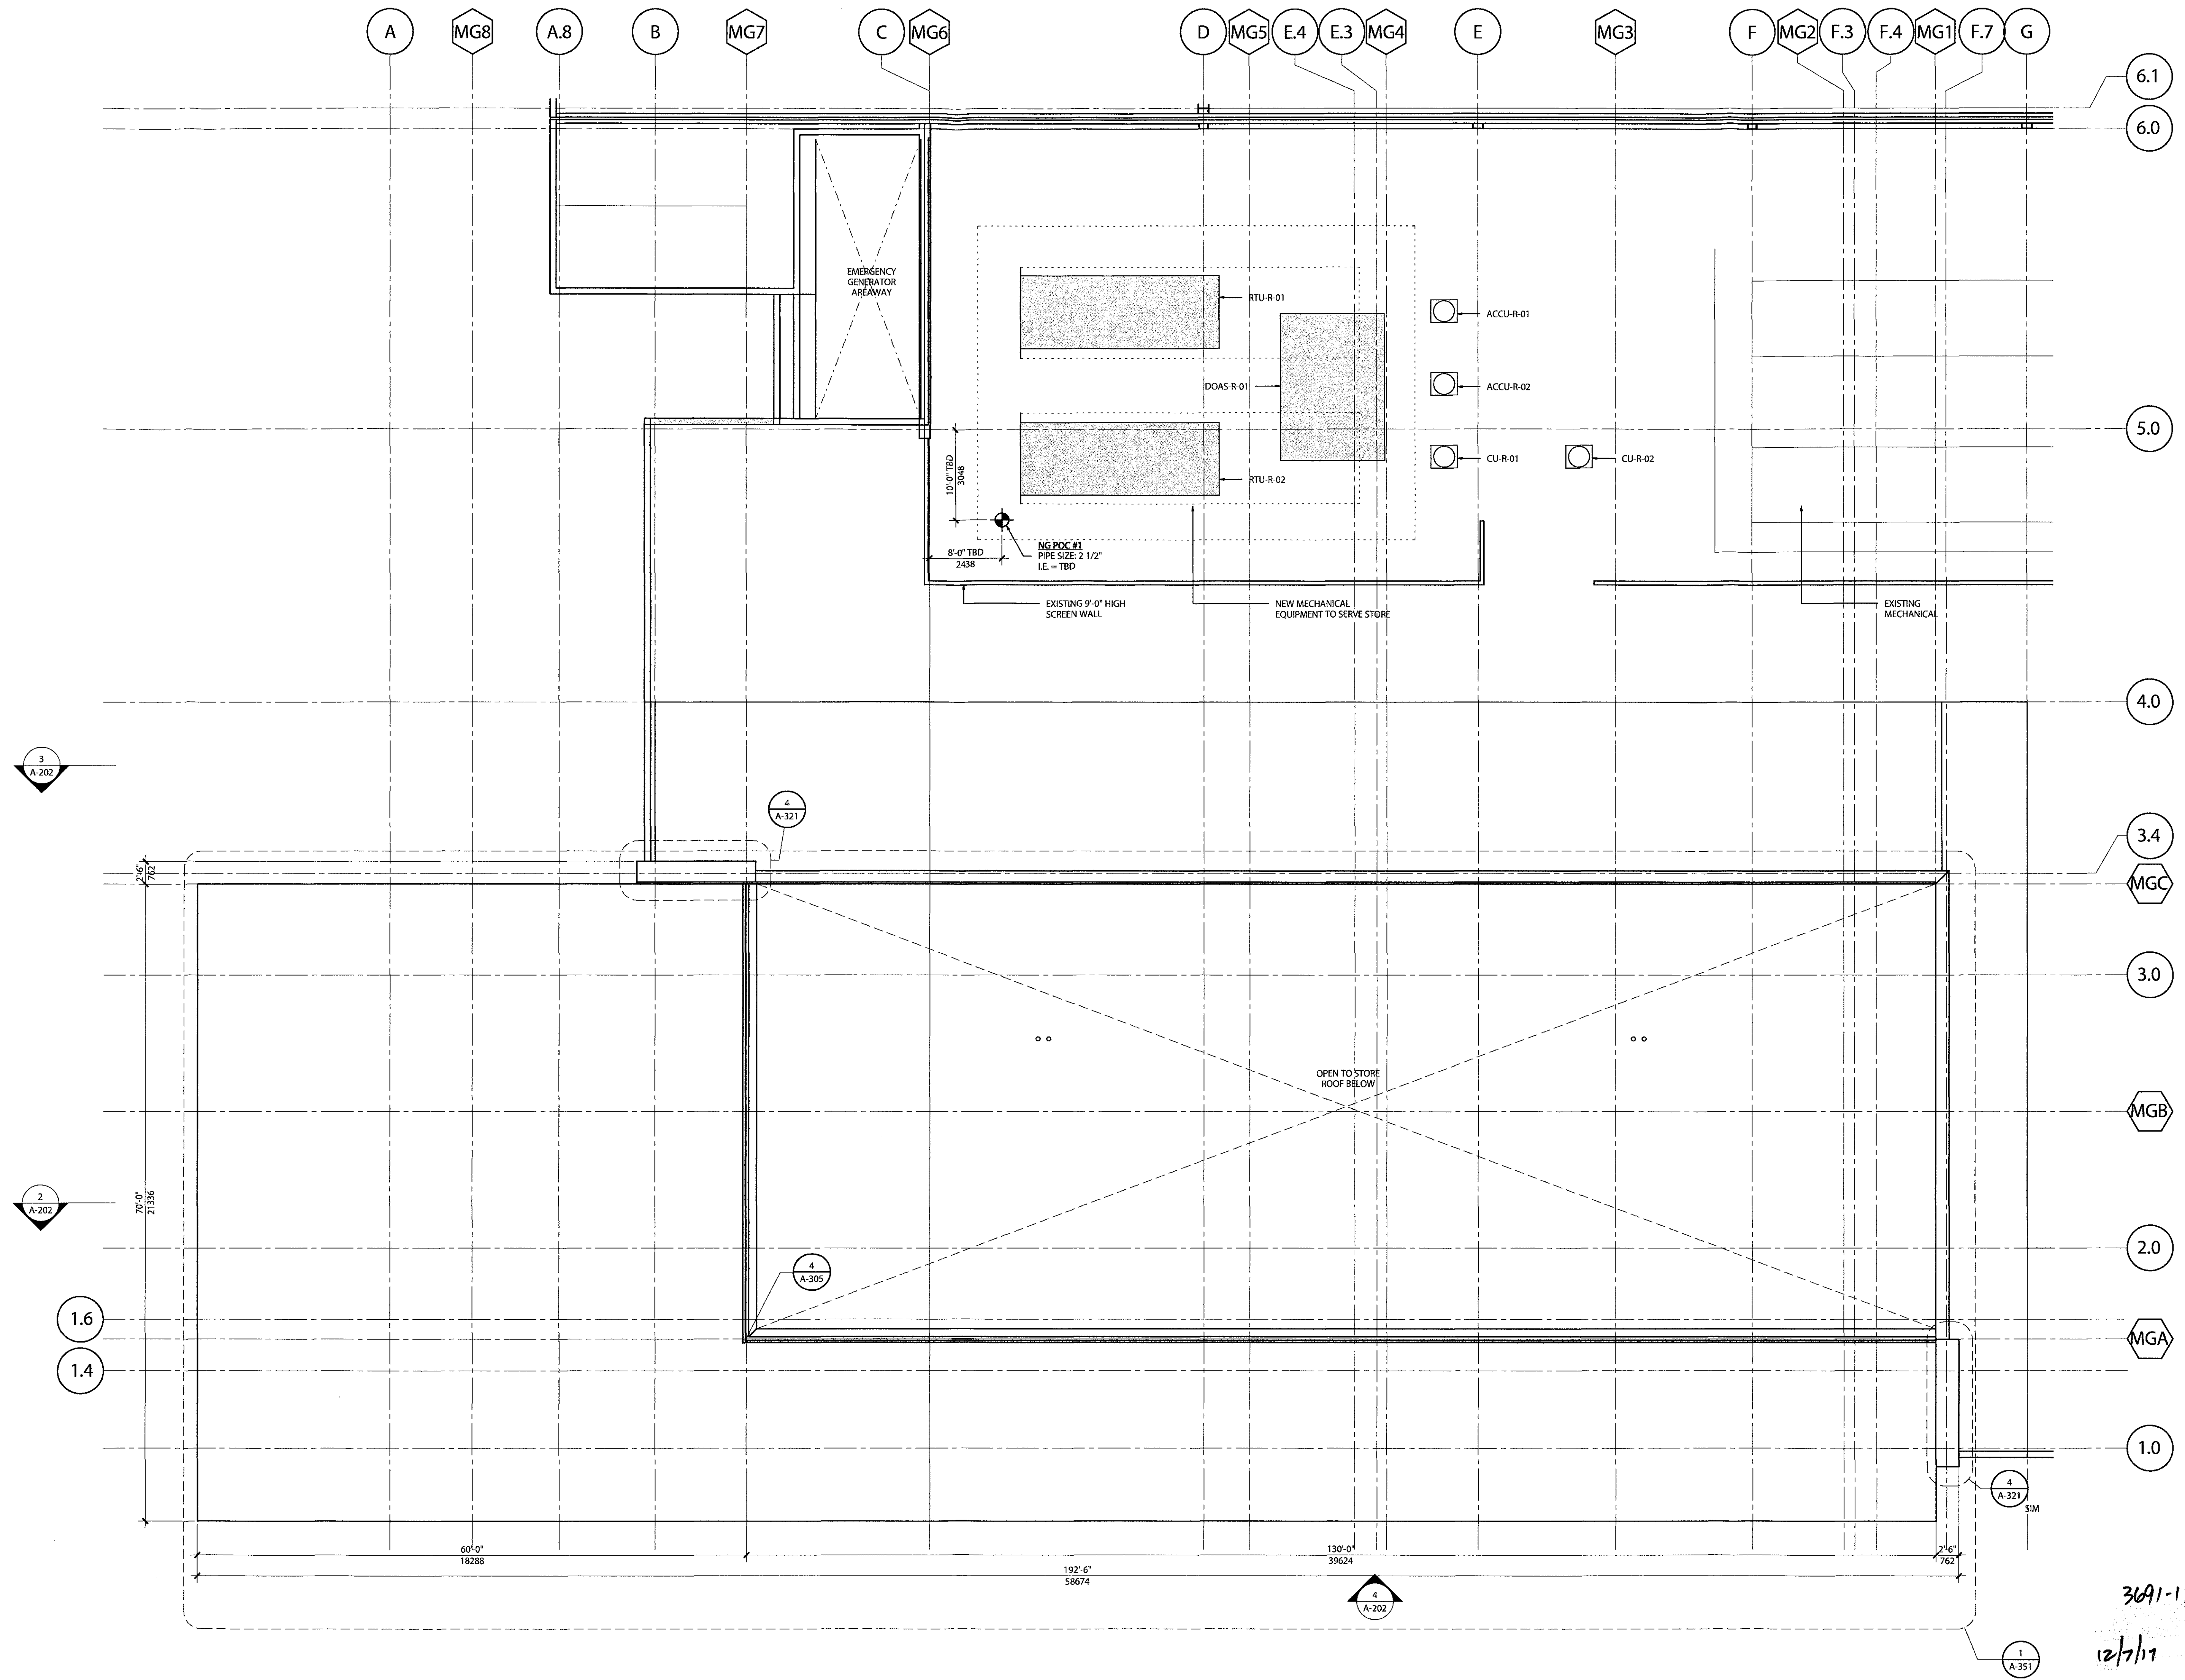

1 ROOF PLAN
1/8" = 1'-0"

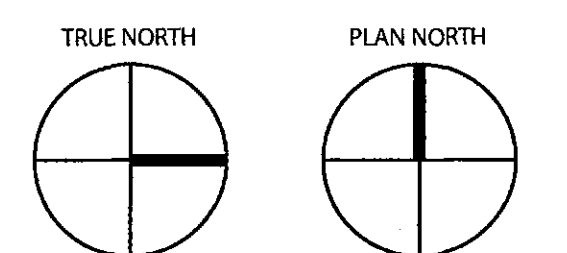

Architect:
Ennead Architects LLP
www.ennead.com

MEP, Structure:
Buro Happold
www.burohappold.com

Glass Facade
Eckersley O'Callaghan
www.eocengineers.com

Lighting:
Renfro Design Group
www.renfrodesign.com

Landscape:
Colwell Shelor
www.colwellshelor.com

Life Safety:
Jensen Hughes
www.jensenhughes.com

Specifications:
Conspectus Inc.
www.conspectusinc.com



Retail Store
Scottsdale Fashion Square - R031
Scottsdale, AZ

Issued/Revised
Check Set
100% CD Issue - Draft
Permit Issue
100% CD Issue
Permit Reissue

Date
07/07/2017
07/17/2017
07/19/2017
08/09/2017
09/14/2017


ROOF PLAN

A-105

SCOTTSDALE SITE PLAN NOTES

1. SIGHT DISTANCE TRIANGLES SHALL BE SHOWN ON FINAL PLANS FOR DRIVEWAYS FROM COMMERCIAL SITES AND ANY INTERSECTIONS. AREA WITHIN THE SAFETY TRIANGLE IS TO BE CLEAR OF LANDSCAPING, SIGNS, OR OTHER VISIBILITY OBSTRUCTIONS WITH A HEIGHT GREATER THAN 15 FEET. TREES WITHIN THE SAFETY TRIANGLE SHALL BE SINGLE TRUNK AND HAVE A CANOPY THAT BEGINS AT 8 FEET IN HEIGHT UPON INSTALLATION. ALL HEIGHTS ARE MEASURED FROM NEAREST STREET LINE ELEVATION.
2. TEMPORARY/SECURITY FENCING THAT IS REQUIRED OR IS OPTIONALLY PROVIDED SHALL BE IN ACCORDANCE WITH THE ZONING ORDINANCE AND THE DESIGN STANDARDS AND POLICY MANUAL.
3. THE TEMPORARY/SECURITY FENCE LOCATION SHALL NOT BE MODIFIED OR THE TEMPORARY/SECURITY FENCE SHALL NOT BE REMOVED WITHOUT THE APPROVAL OF THE PLANNING AND DEVELOPMENT SERVICES INSPECTION SERVICES DIVISION.
4. ALL RIGHTS-OF-WAY ADJACENT TO THIS PROPERTY SHALL BE LANDSCAPED AND MAINTAINED BY THE PROPERTY OWNER.
5. ALL SIGNS REQUIRE SEPARATE PERMITS AND APPROVALS.
6. A MASTER SIGN PROGRAM SHALL BE SUBJECT TO THE APPROVAL OF THE DEVELOPMENT REVIEW BOARD PRIOR TO THE ISSUANCE OF A SIGN PERMIT FOR MULTI-TENANT BUILDINGS.
7. NO EXTERIOR VENDING OR DISPLAY SHALL BE ALLOWED.
8. FLAGPOLES, IF PROVIDED, SHALL BE ONE PIECE CONICAL TAPERED.
9. PATIO UMBRELLAS, IF PROVIDED, SHALL BE SOLID COLORS AND SHALL NOT HAVE ANY ADVERTISING IN THE FORM OF SIGNAGE OR LOGOS.
10. ALL EXTERIOR MECHANICAL, UTILITY, AND COMMUNICATION EQUIPMENT SHALL BE SCREENED TO THE HEIGHT OF THE TALLEST UNIT BY PARAPET OR SCREEN WALL THAT MATCHES THE ARCHITECTURAL COLOR AND ARCHITECTURAL FINISH OF THE BUILDING. GROUND MOUNTED MECHANICAL, UTILITY, AND COMMUNICATION EQUIPMENT SHALL BE SCREENED BY A SCREEN WALL THAT MATCHES THE ARCHITECTURAL COLOR AND ARCHITECTURAL FINISH OF THE BUILDING, WHICH IS A MINIMUM OF 1'-0" HIGHER THAN THE HIGHEST POINT OF TALLEST UNIT. (DETAILS ARE REQUIRED.)
11. ALL EQUIPMENT, UTILITIES, OR OTHER APPURTENANCES ATTACHED TO THE BUILDING SHALL BE AN INTEGRAL PART OF THE BUILDING DESIGN IN TERMS OF FORM, COLOR AND TEXTURE.
12. NO EXTERIOR VISIBLE LADDERS SHALL BE ALLOWED.
13. ALL POLE-MOUNTED LIGHTING SHALL BE A MAXIMUM OF 20 FEET IN HEIGHT.
14. NO CHAIN LINK FENCING SHALL BE ALLOWED.
15. NO TURF AREAS SHALL BE PROVIDED.

VICINITY MAP

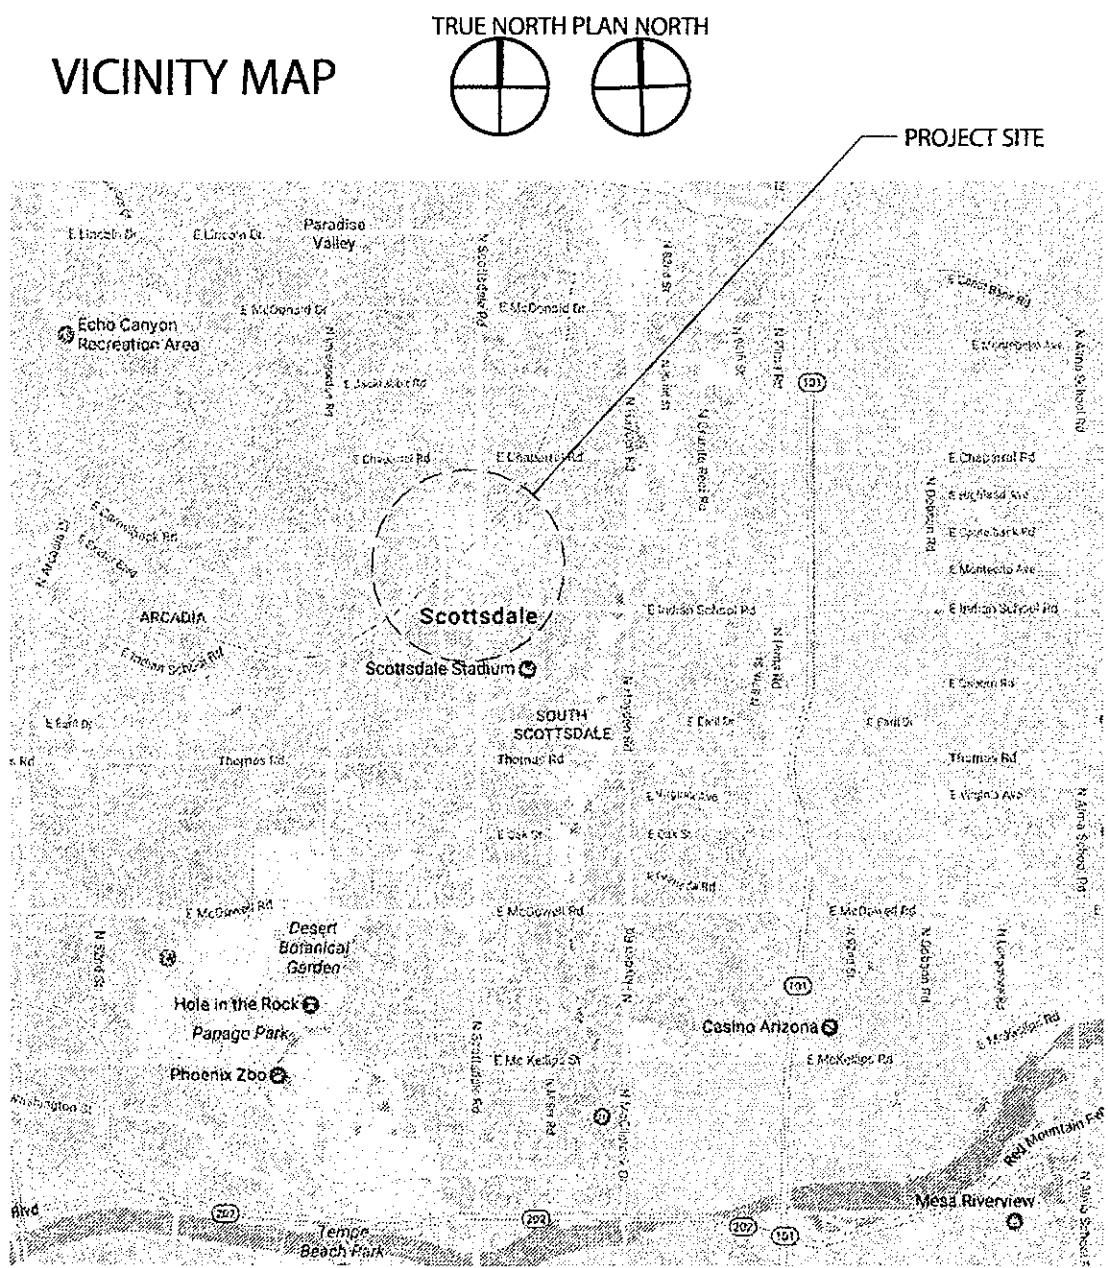

PROJECT DIRECTORY

CLIENT:
APPLE, INC.
1 INFINITE LOOP, MS: 52 RD
CUPERTINO, CA 95014
PHONE: 415-847-1015
DESIGN MANAGER: HILARY ROBE
EMAIL: HROBE@APPLE.COM
DEVELOPMENT MANAGER: MECHAN SARNOZI
EMAIL: MSARNOZI@APPLE.COM

ARCHITECT:
ENNEAD ARCHITECTS LLP
2 GANSEVOORT ST
NEW YORK, NY 10014
PHONE: 212-807-7171
CONTACT: ANTHONY GUARALDO
EMAIL: AGUARALDO@ENNEAD.COM

STRUCTURAL:
BURO HAPPOLD
100 BROADWAY
NEW YORK, NY 10005
PHONE: 212-334-2025
CONTACT: TILMAN SCHOBBER
EMAIL: TILMAN.SCHOBBER@BUROHAPPOLD.COM

MECHANICAL/PLUMBING/ELECTRICAL:
BURO HAPPOLD
100 BROADWAY
NEW YORK, NY 10005
PHONE: 212-334-2025
CONTACT: JAMES HANLEY
EMAIL: JAMES.HANLEY@BUROHAPPOLD.COM

LIFE SAFETY:
JENSEN HUGHES
3610 COMMERCIAL DR, SUITE B17
BALTIMORE, MD 21227
PHONE: 410-737-8677
CONTACT: CHRIS MORAN
EMAIL: CMORAN@JENSENHUGHES.COM

GENERAL CONTRACTOR:
SHAWMUT DESIGN AND CONSTRUCTION
560 HARRISON AVENUE
BOSTON, MA 02118
PHONE: 617-622-7000
CONTACT: PAUL EAGLES
EMAIL: PEAGLES@SHAWMUT.COM

PROPERTY OWNER: SCOTTSDALE FASHION
SQUARE LLC (MACERICH)
11411 N TATUM BOULEVARD
PHOENIX, AZ 85028
PHONE: 602-953-6206
CONTACT: ANDY GREENWOOD
EMAIL: ANDY.GREENWOOD@MACERICH.COM

CIVIL:
OLSSON ASSOCIATES
2750 NORTH 16TH STREET, SUITE 210
PHOENIX, AZ 85016
PHONE: 480-333-4326
CONTACT: CARDELL ANDREWS
EMAIL: CANDREWS@OLSSONASSOCIATES.COM

STRUCTURAL:
PK ASSOCIATES
7434 EAST McDONALD DRIVE
SCOTTSDALE, AZ 85250
PHONE: 480-922-8854
CONTACT: JACK KOEHLER
EMAIL: JACK@PKSTRUCTURAL.COM

LANDSCAPE:
COLWELL SHELOR
4450 N 12TH ST, SUITE 228
PHOENIX, AZ 85014
PHONE: 212-334-2025
CONTACT: JAMES HANLEY
EMAIL: ACOLWELL@COLWELLSHELOR.COM

LIGHTING:
RENRO DESIGN GROUP
15 EAST 32nd
NEW YORK, NY 10016
PHONE: 212-229-9988
CONTACT: RICHARD RENRO
EMAIL: RRENRO@RENRODESIGN.COM

SPECIFICATIONS:
CONSPECTUS, INC.
2331 SUITE 501 PO BOX 248
TUCKAHOE, NJ 08250
PHONE: 609-513-6992
CONTACT: DAVID STUTZMAN
EMAIL: DSTUTZMAN@CONSPECTUSINC.COM

PROPERTY LEGAL DESCRIPTION

BEING A PORTION OF THE SOUTHEAST QUARTER OF THE NORTHEAST QUARTER AND THE SOUTHWEST QUARTER OF SECTION 22, TOWNSHIP 2 NORTH, RANGE 4 EAST OF THE GILA AND SALT RIVER BASE AND MERIDIAN, MARICOPA COUNTY, ARIZONA, TOGETHER WITH THAT RIGHT-OF-WAY ABANDONED IN INSTRUMENT 91-57648D, MARICOPA COUNTY RECORDS PARTICULARLY DESCRIBED AS FOLLOWS: COMMENCING AT THE SOUTHEAST CORNER OF THE SOUTHEAST QUARTER OF THE NORTHEAST QUARTER OF SAID SECTION 22; THENCE SOUTH 88 DEGREES 56 MINUTES 13 SECONDS WEST, ALONG THE SOUTH LINE OF THE NORTHEAST QUARTER OF SAID SECTION 22, FOR A DISTANCE OF 73.86 FEET; THENCE NORTH 01 DEGREES 03 MINUTES 47 SECONDS WEST, 55.00 FEET TO THE TRUE POINT OF BEGINNING; THENCE SOUTH 88 DEGREES 56 MINUTES 13 SECONDS WEST, ALONG A LINE WHICH IS PARALLEL WITH AND 55.00 FEET NORTH OF THE SOUTH LINE OF SAID NORTHEAST QUARTER, 125.97 FEET; THENCE NORTH 01 DEGREES 03 MINUTES 47 SECONDS WEST, 6.00 FEET TO A POINT ON A LINE PARALLEL WITH AND 61 FEET NORTH OF THE SOUTH LINE OF SAID NORTHEAST QUARTER; THENCE SOUTH 88 DEGREES 56 MINUTES 13 SECONDS WEST, ALONG SAID LINE, 113.00 FEET; THENCE SOUTH 01 DEGREES 03 MINUTES 47 SECONDS EAST, 6.00 FEET TO A POINT ON A LINE WHICH IS PARALLEL WITH AND 55.00 FEET NORTH OF THE SOUTH LINE OF SAID NORTHEAST QUARTER; THENCE SOUTH 88 DEGREES 56 MINUTES 13 SECONDS WEST, ALONG SAID LINE, 252 FEET; THENCE NORTH 01 DEGREES 03 MINUTES 47 SECONDS WEST, 6.00 FEET TO A POINT ON A LINE WHICH IS PARALLEL WITH AND 61.00 FEET NORTH OF THE SOUTH LINE OF SAID NORTHEAST QUARTER; THENCE SOUTH 88 DEGREES 56 MINUTES 13 SECONDS WEST, ALONG SAID LINE, 219.82 FEET; THENCE SOUTH 01 DEGREES 03 MINUTES 47 SECONDS EAST, 6.00 FEET TO A POINT ON A LINE WHICH IS PARALLEL WITH AND 55.00 FEET NORTH OF THE SOUTH LINE OF SAID NORTHEAST QUARTER; THENCE SOUTH 88 DEGREES 56 MINUTES 13 SECONDS WEST, ALONG SAID LINE, 604.58 FEET; THENCE NORTH 45 DEGREES 31 MINUTES 56 SECONDS WEST, 28.02 FEET TO A POINT ON A LINE 100 FEET WEST OF AND PARALLEL WITH THE EAST LINE OF LOT 5, ARCADIA VISTA UNIT NUMBER 4, ACCORDING TO BOOK 21 OF MAPS PAGE 38 RECORDS OF MARICOPA COUNTY, ARIZONA, THENCE NORTH 00 DEGREES 00 MINUTES 00 SECONDS WEST, ALONG SAID LINE, 587.68 FEET TO THE NORTH LINE OF SAID LOT 5; THENCE NORTH 88 DEGREES 52 MINUTES 52 SECONDS EAST, ALONG SAID NORTH LINE, 100.00 FEET TO THE WEST LINE OF THE SOUTH LINE OF SAID NORTHEAST QUARTER; THENCE NORTH 00 DEGREES 00 MINUTES 00 SECONDS WEST, ALONG SAID WEST LINE, 637.72 FEET TO A POINT ON A LINE WHICH IS PARALLEL WITH AND 30 FEET SOUTH OF THE NORTH LINE OF THE SOUTHWEST QUARTER OF SAID NORTHEAST QUARTER; THENCE NORTH 88 DEGREES 49 MINUTES 52 SECONDS EAST, ALONG SAID LINE, 287.35 FEET TO AN INTERSECTION WITH A NONTANGENT CURVE THE CENTER OF WHICH BARES SOUTH 15 DEGREES 53 MINUTES 33 SECONDS EAST, 365.72 FEET; THENCE EAST, ALONG THE ARC OF SAID CURVE THROUGH A CENTRAL ANGLE OF 14 DEGREES 43 MINUTES 05 SECONDS FOR AN ARC DISTANCE OF 93.95 FEET; THENCE NORTH 88 DEGREES 49 MINUTES 52 SECONDS EAST, 275.22 FEET; THENCE NORTH 00 DEGREES 00 MINUTES 00 SECONDS WEST, 3.00 FEET TO A POINT ON A LINE WHICH IS PARALLEL WITH AND 15 FEET SOUTH OF THE NORTH LINE OF THE SOUTHEAST QUARTER OF SAID NORTHEAST QUARTER; THENCE NORTH 88 DEGREES 49 MINUTES 52 SECONDS EAST, ALONG SAID LINE, 579.81 FEET TO A POINT MARKING THE BEGINNING OF A TANGENT CURVE TO THE RIGHT HAVING A RADIUS OF 20.0 FEET; THENCE ALONG SAID CURVE THROUGH A CENTRAL ANGLE OF 91 DEGREES 10 MINUTES 28 SECONDS AN ARC DISTANCE OF 31.83 FEET TO A POINT ON A LINE WHICH IS PARALLEL WITH AND 55 FEET WEST OF THE EAST LINE OF SAID NORTHEAST QUARTER; THENCE SOUTH 00 DEGREES 00 MINUTES 00 SECONDS WEST, ALONG SAID LINE, 1207.44 FEET TO A POINT WHICH BEARS NORTH 33 DEGREES 21 MINUTES 40 SECONDS EAST FROM THE TRUE POINT OF BEGINNING; THENCE SOUTH 33 DEGREES 21 MINUTES 40 SECONDS WEST, 36.35 FEET TO THE TRUE POINT OF BEGINNING, EXCEPT THAT PART OF THE SOUTHEAST QUARTER OF SAID SECTION 22 DESCRIBED AS FOLLOWS: COMMENCING AT THE NORTHEAST CORNER AT THE SOUTHEAST QUARTER OF THE NORTHEAST QUARTER OF SECTION 22, TOWNSHIP 2 NORTH, RANGE 4 EAST OF THE GILA AND SALT RIVER BASE AND MERIDIAN, MARICOPA COUNTY, ARIZONA, THENCE SOUTH ALONG THE EAST LINE OF SAID SECTION 22 A DISTANCE OF 300 FEET TO A POINT; THENCE WEST A DISTANCE OF 55 FEET TO THE WEST RIGHT-OF-WAY LINE OF SCOTTSDALE ROAD WHICH IS THE TRUE POINT OF BEGINNING; THENCE SOUTH ALONG SAID WEST RIGHT-OF-WAY LINE OF SCOTTSDALE ROAD 175 FEET TO A POINT; THENCE WEST 175 FEET; THENCE NORTH 175 FEET; THENCE EAST 175 FEET TO THE POINT OF BEGINNING. BASED ON LEGAL DESCRIPTION PREPARED BY PKC ENGINEERS DATED 11/14/95.


PROJECT INFORMATION / DATA

PROJECT INFORMATION
PROJECT NAME: SCOTTSDALE FASHION SQUARE
PARCEL ADDRESS: 4500 NORTH SCOTTSDALE ROAD, SCOTTSDALE, AZ 85251
PARCEL ZONING: D/RCO-2 PBD DO
GROSS PROPERTY AREA: 65 ACRES
NET PROPERTY AREA: 29,052 SF (PROPOSED 1ST FLOOR AREA)
GROSS FLOOR AREA: 25,538 SF (PROPOSED 2ND FLOOR AREA)

PARKING AREA
PARKING LOT LANDSCAPE REQUIRED: N/A (ALL SUBTERRANEAN PARKING)

MIXED USE		2,135,029 SF		REQUIRED RATIO		REQUIRED PARKING		PARKING PROVIDED		ACCESSIBLE PARKING		ACCESSIBLE PROVIDED		VAN ACCESSIBLE PROVIDED	
UNCOVERED		1/350		6,095		8,204		164		199		27			
COVERED				2,171		2,171		66		17					
				6,033		8,204				199		27			
BIKE RACKS		9 (50 BIKES)													

LEGEND

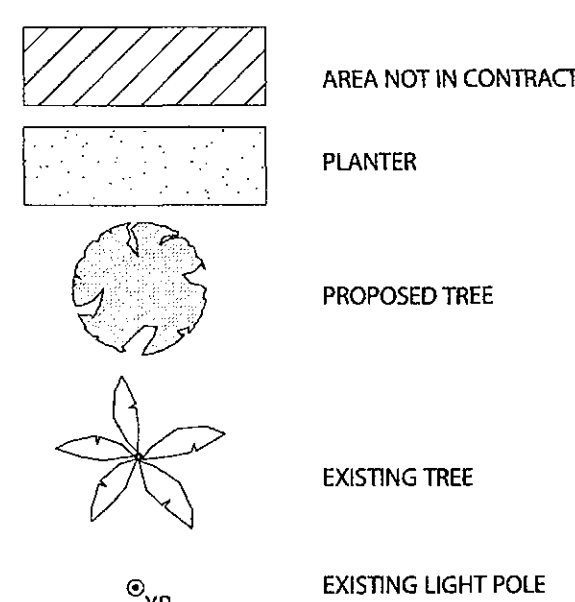

CITY APPROVALS

CASE: 20-DR-2017
CDS (P. C.): #3691-17-2



Architect:
Ennead Architects LLP
www.ennead.com

MEP, Structure:
Buro Happold
www.burohappold.com

Glass Facade:
Eckersley O'Callaghan
www.eocengineers.com

Lighting:
Renfro Design Group
www.renfrodesign.com

Landscape:
Colwell Shelor
www.colwellshel.com

Life Safety:
Jensen Hughes
www.jensenhughes.com

Specifications:
Conspectus Inc.
www.conspectusinc.com



Retail Store
Scottsdale Fashion Square - R031
Scottsdale, AZ

Issued/Revised
50% CD 05/22/2017
50% CD Addendum 05/30/2017
50% CD Addendum #2 06/09/2017
Check Set 07/07/2017
100% CD Issue - Draft 08/09/2017
100% CD Issue 09/14/2017
Permit Reissue

SITE PLAN

SHEET NOTES

1. VERIFY FIELD CONDITIONS AND LOCATIONS OF ALL STRUCTURAL ELEMENTS, MECHANICAL DUCTWORK, PLUMBING PIPING, ELECTRICAL CONDUITS AND OTHER APPLICABLE ITEMS. MAINTAIN DESIGN HEIGHTS AND CLEARANCES. NOTIFY ARCHITECT AND APPLE DM OF ANY DISCREPANCIES OR OTHER CONFLICTS IN CEILING LAYOUT PRIOR TO CONSTRUCTION.
2. PROVIDE ADEQUATE CLEARANCES FOR FIXTURES, DUCTS, CEILINGS, AND RELATED TRAVEL ITEMS NECESSARY TO MAINTAIN SPECIFIED CEILING HEIGHTS.
3. LOCATE FIXTURES AND CEILING DEVICES DIMENSIONED AND IDENTIFIED ON THIS PLAN. DIMENSIONS FOR ELEMENTS SHOWN ON THIS PLAN SHALL GOVERN OVER AND IF IN CONFLICT, SHALL SUPERCEDE THOSE SHOWN ON ALL OTHER DRAWINGS.
4. REFER TO MECHANICAL, PLUMBING, ELECTRICAL, AND FIRE PROTECTION DRAWINGS AND SPECIFICATIONS FOR DESIGN OF THESE SYSTEMS (DUCT SIZES, CIRCUITING, ETC).
5. REFER TO LIGHT FIXTURE SYSTEM SPECIFICATION AND INSTALLATION MANUAL FOR ATTACHMENT AND INSTALLATION DETAILS.
6. SEE ELECTRICAL DRAWINGS FOR DEVICES NOT SHOWN AND FIXTURE NUMBERS AND QUANTITIES.
7. ALL THROUGH-MOUNTED DEVICES WHICH ARE NOT LOCATED ON THE CEILING PLAN WITH DIMENSIONS ARE TO ALIGN WITH DEVICES WHICH HAVE BEEN LOCATED WITH DIMENSIONS.
8. WAP ANTENNAS TO BE MOUNTED ABOVE THE TRELLIS AND GFCG COFFERS AND SHALL BE HIDDEN FROM VIEW. TYPICAL FOR ALL.
9. REFER TO SALES AREA TABLES FOR SPEAKERS AND SUB WOOFERS
10. REFER TO I/A-351 FOR FULL EXTENT OF TRELLIS CEILING PANELS

FOH / EXTERIOR LIGHTING FIXTURE SCHEDULE

TYPE	MANUFACTURER	DESCRIPTION	CATALOG NUMBER	LAMP	LUMEN OUTPUT	DEGREE BEAM ANGLE	CONTROL ZONE	QUANTITY
RA-1	RICHTER	CUSTOM LAMPADINA DOWNLIGHT	CUSTOM - REFER TO 265100	3000K LED	3500	20	Z-02, Z-03	80
RA-2	RICHTER	CUSTOM LAMPADINA DOWNLIGHT	CUSTOM - REFER TO 265100	3000K LED	5000	20	Z-04, Z-05, Z-06	37
RA-3	RICHTER	CUSTOM LAMPADINA DOWNLIGHT	CUSTOM - REFER TO 265100	3000K LED	5000	10	Z-05	12
RA-4	RICHTER	CUSTOM LAMPADINA DOWNLIGHT	CUSTOM - REFER TO 265100	3000K LED	5000	20x60	Z-07	3
RB	ECOSENSE	SLIM COVE DIM	SCD SERIES - REFER TO 265100	4000K LED	355lm / ft	120	Z-01a, Z-01b, Z-01c, Z-01d, Z-01e	1500
RC	DESIGN PLAN	RECESSED IN-GRADE ROUND LED	BRIGHT 5.8 - REFER TO 265100	3000K LED	671	16	Z-08	16
RD	GRUPO MCI	EXTERIOR STAIR UPLIGHT	SLIM GROUND LINEAR - REFER TO 265100	3000K LED	260 lm / m		Z-11	223
RD-1	GRUPO MCI	EXTERIOR STAIR UPLIGHT	SLIM GROUND LINEAR - REFER TO 265100	3000K LED	260 lm / m		Z-11	68
RF	ELECTRIX	EXTERIOR BENCH DOWNLIGHT	LT40W SERIES - REFER TO 265100	3000K LED	258 lm / ft	90	Z-10	19
RG	EXTERIOR TREE UPLIGHT	EXTERIOR TREE UPLIGHT	EXTERIOR TREE UPLIGHT	3000K LED			Z-09	6
XP	COOPER / PATON	EXTERIOR PATHWAY LIGHT POLE	MSA-E02-LED-E1-T3-UP-LCF REUSE OF EXISTING FIXTURE	4000K LED	4970		Z-12	9

1. REFER TO A-111 FOR FIXTURE TYPE RC LAYOUT (LIGHTING ZONE Z-08)
2. REFER TO A-660 FOR FIXTURE TYPE RB LAYOUT (LIGHTING ZONE Z-01a, Z-01b, Z-01c, Z-01d, Z-01e)
3. REFER TO A-331.1 & A-331.2 FOR FIXTURE TYPES RD, RD-1, RF, RG LAYOUT (LIGHTING ZONES Z-09, Z-10, Z-11)
4. REFER TO A-131 FOR FIXTURES RA-1, RA-2, RA-3, RA-4 (LIGHTING ZONES Z-02, Z-03, Z-04, Z-05, Z-06, Z-07)

SYMBOLS

- RG EXTERIOR TREE UPLIGHT - STAKE MOUNTED
- RD EXTERIOR STAIR UPLIGHT - RECESS MOUNTED
- RF EXTERIOR BENCH DOWNLIGHT - RECESS MOUNTED
- FINISH INDICATOR
- XP LIGHT POLE - REUSE EXISTING

EXT DETAILS - ENTRY PLAZA PLAN

3/16" = 1'-0"

Architect:
Ennead Architects LLP
www.ennead.com

MEP, Structure:
Buro Happold
www.burohappold.com

Glass Facade:
Eckersley O'Callaghan
www.eocengineers.com

Lighting:
Renfro Design Group
www.renfrodesign.com

Landscape:
Colwell Shelor
www.colwellshelor.com

Life Safety:
Jensen Hughes
www.jensenhughes.com

Specifications:
Conspectus Inc.
www.conspectusinc.com




Retail Store
Scottsdale Fashion Square - R031
Scottsdale, AZ

Issued/Revised
50% CD
50% CD Addendum
50% CD Addendum #2
Check Set
100% CD Issue - Draft
Permit Issue
100% CD Issue
Permit Reissue

Date
05/23/2017
05/30/2017
06/09/2017
07/07/2017
07/17/2017
07/19/2017
08/09/2017
09/14/2017


EXTERIOR DETAILS - SITE

A-331.1

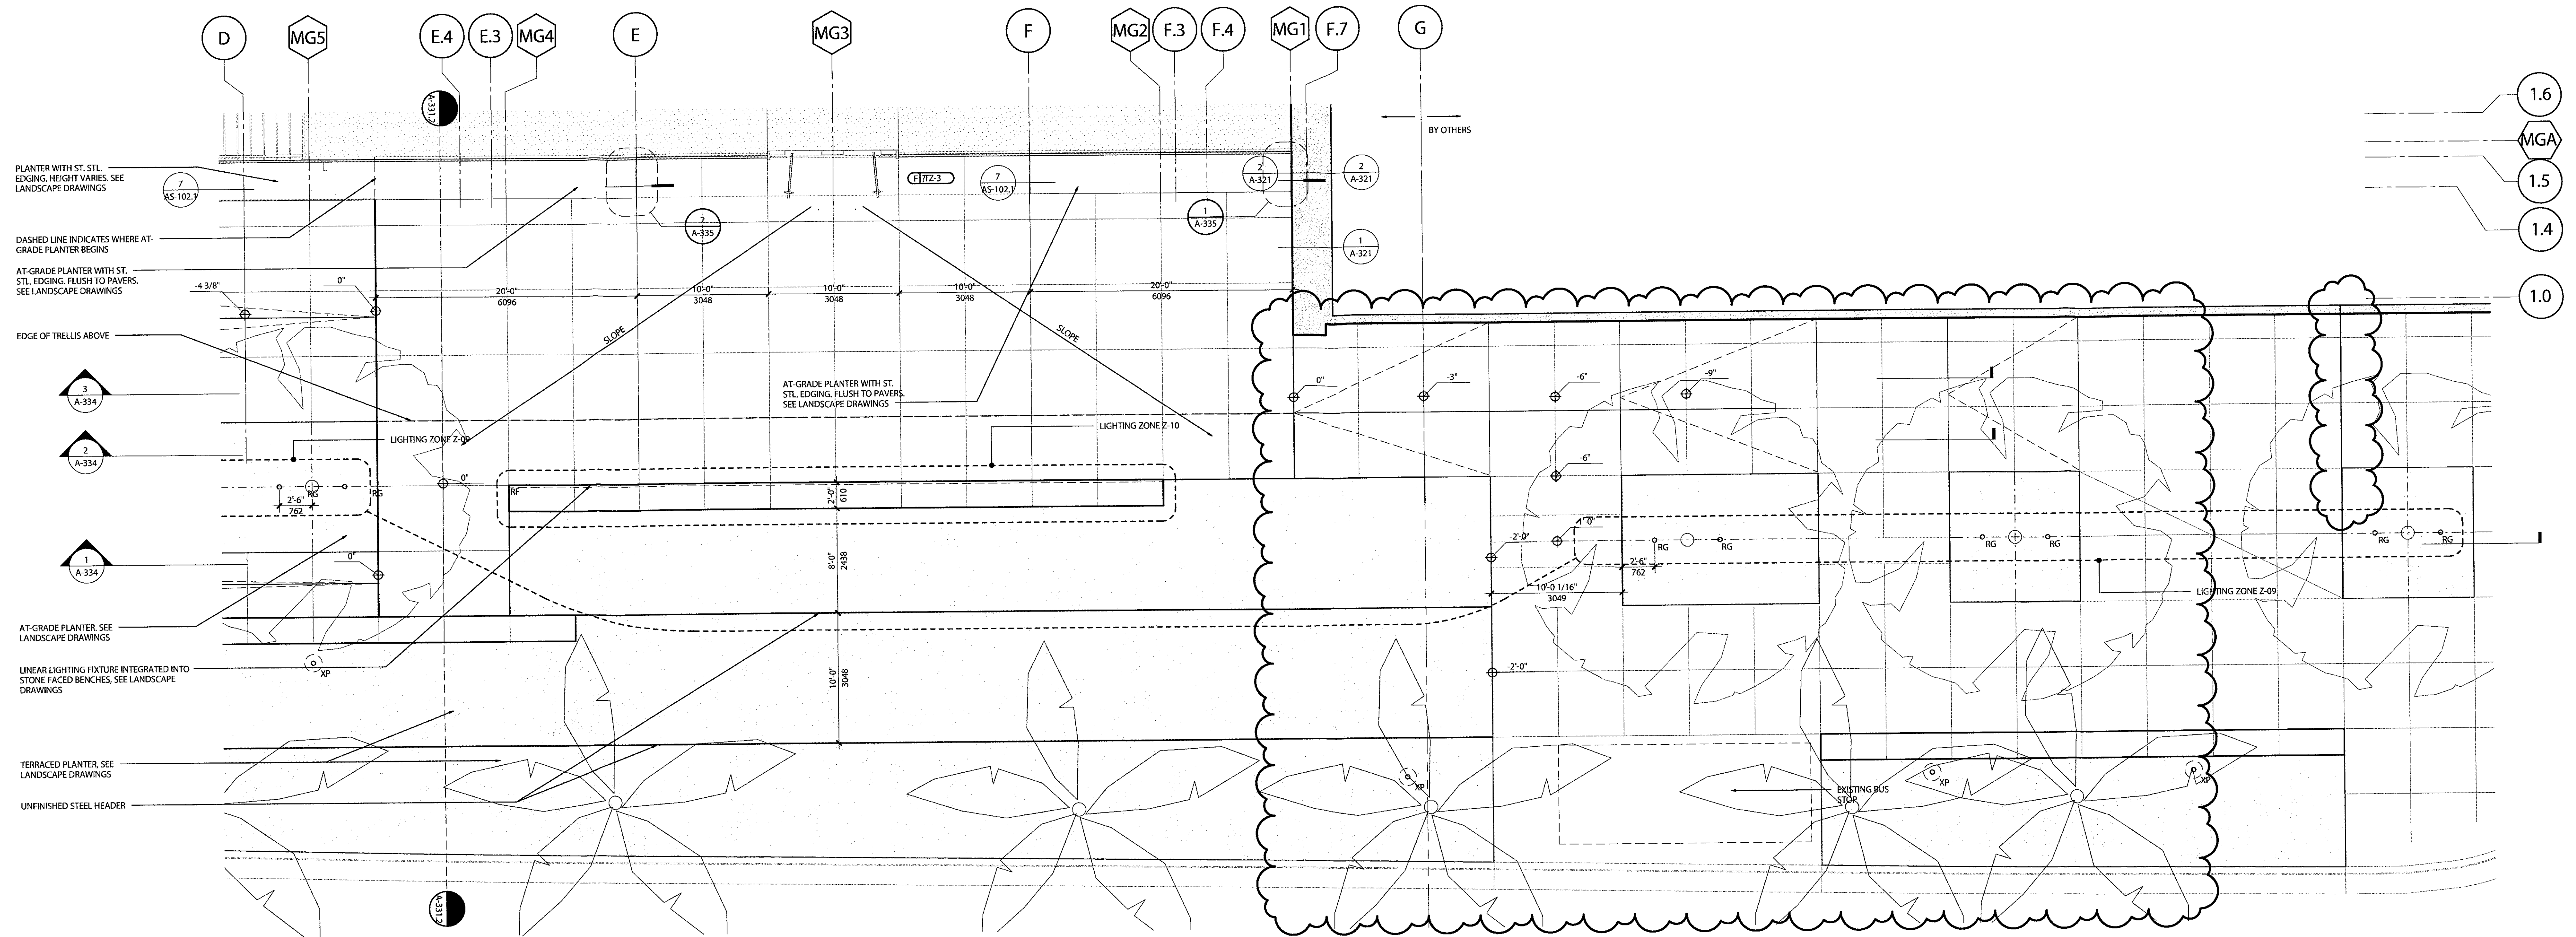

2 EXT DETAILS - EAST PLAZA PARTIAL PLAN 2

3/16" = 1'-0"

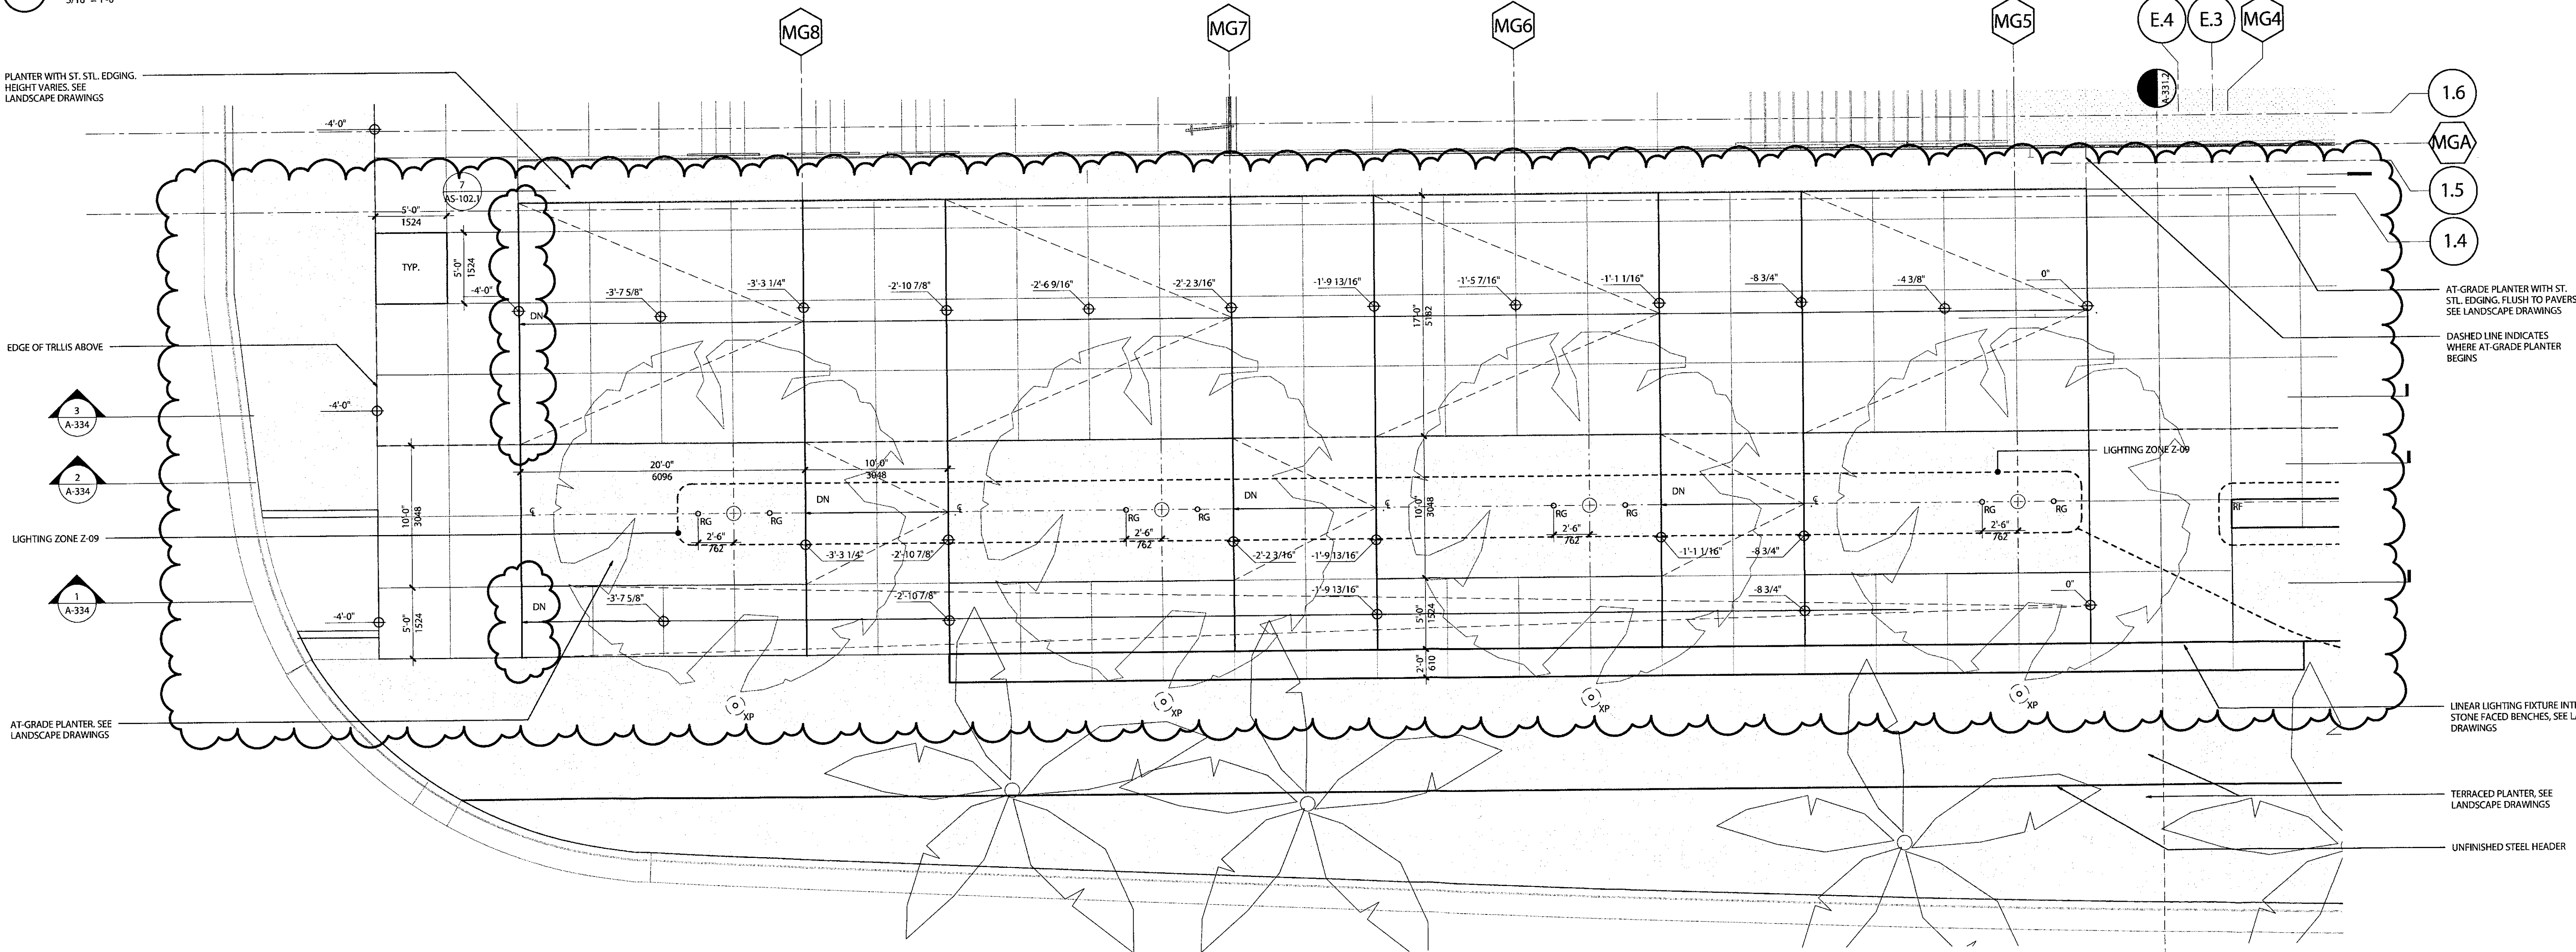

1 EXT DETAILS - EAST PLAZA PARTIAL PLAN 1

3/16" = 1'-0"

Architect:
Ennead Architects LLP
www.ennead.com

MEP, Structure:
Buro Happold
www.burohappold.com


Glass Facade:
Eckersley O'Callaghan
www.eocengineers.com

Lighting:
Renfro Design Group
www.renfrodesign.com

Landscape:
Colwell Shelor
www.colwellshelor.com

Life Safety:
Jensen Hughes
www.jensenhughes.com

Specifications:
Conspectus Inc.
www.conspectusinc.com

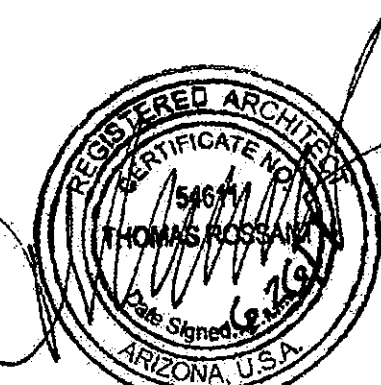


Retail Store
Scottsdale Fashion Square - R031
Scottsdale, AZ

Issued/Revised: 50% CD Addendum #2
Check Set
100% CD Issue - Draft
Permit Issue
100% CD Issue
Permit Reissue


Date: 06/09/2017
07/07/2017
07/17/2017
07/19/2017
08/09/2017
09/14/2017

3691-17-2
12/1/17

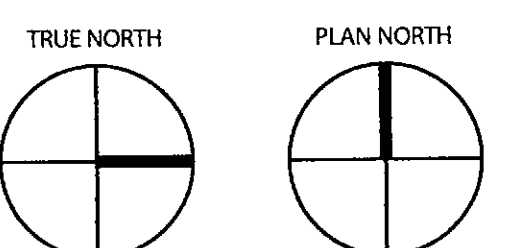

EXTERIOR DETAILS - SITE

A-331.2

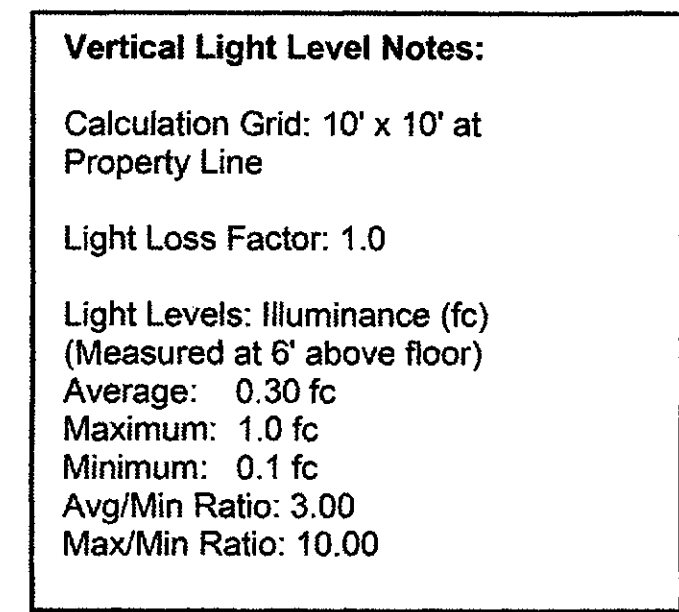

IDENTIFY THE EXISTING ~~DATE~~
~~UNMOUNTED~~ FIXTURES (XP)
WHICH WERE STIPULATED TO
REMAIN IN PLACE.

(DIES - STIPULATION #3)

3091-17-2



12/7/17

22

FOR FIXTURE DETAILS ONLY.
REFER TO LANDSCAPE FOR PHOTOMETRICS.

Apple Approval _____ Date _____

FIXTURE TYPES RD & RD-1 SUMMARY (L-1)			
Lumen Output per fixture: 222 lumens per 2' fixture (111 lumens / foot)			
Zoning Ordinance Section 7.200 - Outdoor Lighting Requirements:			
Table 7.602.A.1			
Standard	Other outdoor lighting	Additional Regulations	Application of Standards
Height	DRB Review	None Applicable	Subject to DRB Approval - NOTE: Fixture is mounted flush to grade
Lens	Required	None	Lens integral to fixture
Shield	See Table 7.602.A.2	None Applicable	Not required per 7.602.A.2
Direct Light Source Down	See Table 7.602.A.2	None Applicable	Not required per 7.602.A.2
Full Cutoff	See Table 7.602.A.2	None Applicable	Not required per 7.602.A.2
Light Trespass	Note 4b, 4c	None	Subject to DRB Approval
Hours of Operation	DRB Review, Note 6	None Applicable	Subject to DRB Approval
4b. Maximum light trespass: Single-family residential use adjacent to or abutting single-family residential use, maximum: 0.1 foot candles: NOT APPLICABLE 4c. Maximum light trespass: Non-residential use adjacent to or abutting single-family residential use, maximum: subject to DRB approval 6. Single-family residential use adjacent to or abutting single-family residential use: any fixture with output equal to or greater than 2,600 initial lumens shall not be operated between 11:00pm and 6:00am, except security lighting may be operated for a period of not more than 15 minutes: NOT APPLICABLE			
Table 7.602.A.2			
Total Initial Lumens of All Light Sources Within a Luminaire	Lighting Shield	Direct Downward	Full Cutoff
1600 or less	No	No²	No
Over 1600 to 3050	Yes	No ^{2,3}	No
Over 3050	Yes	Yes	Yes
2. All lighting mounted eight (8) feet or higher shall be directed downward: NOT APPLICABLE - Fixture mounted flush to grade 3. Wherever practicable, lighting which is directed upward should be located on the west or east sides of the object being lit NOT PRACTICABLE - Fixtures oriented with architectural features			

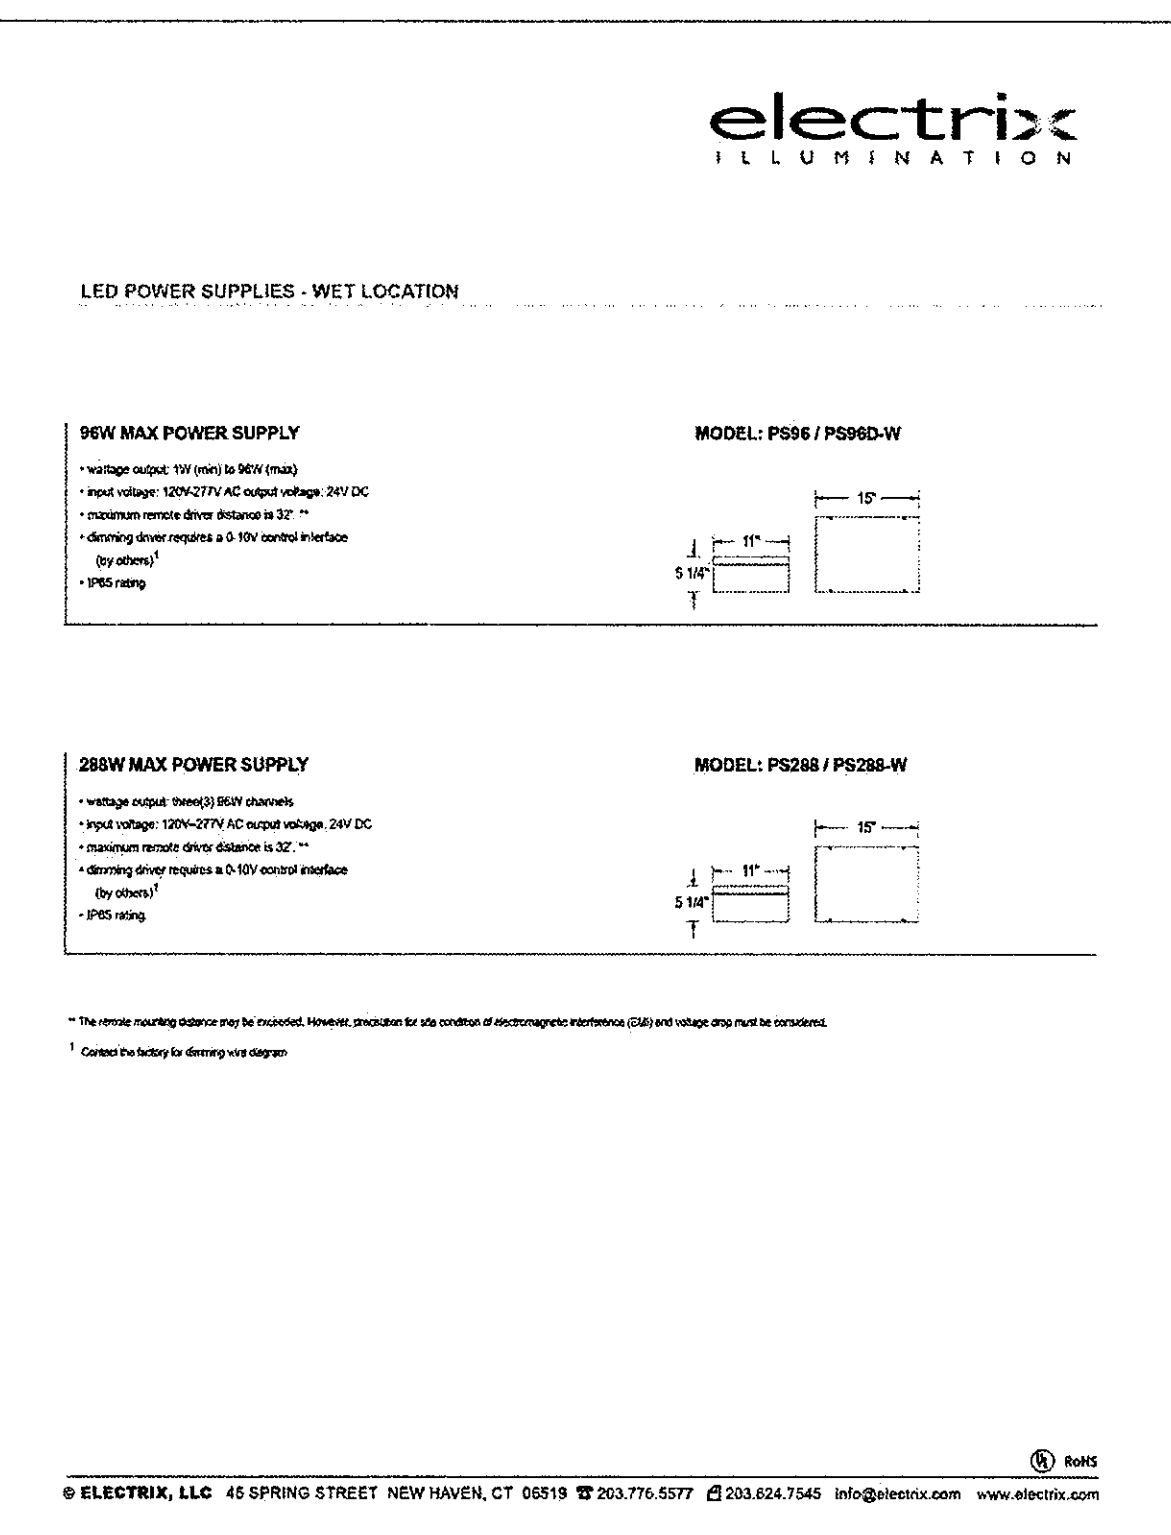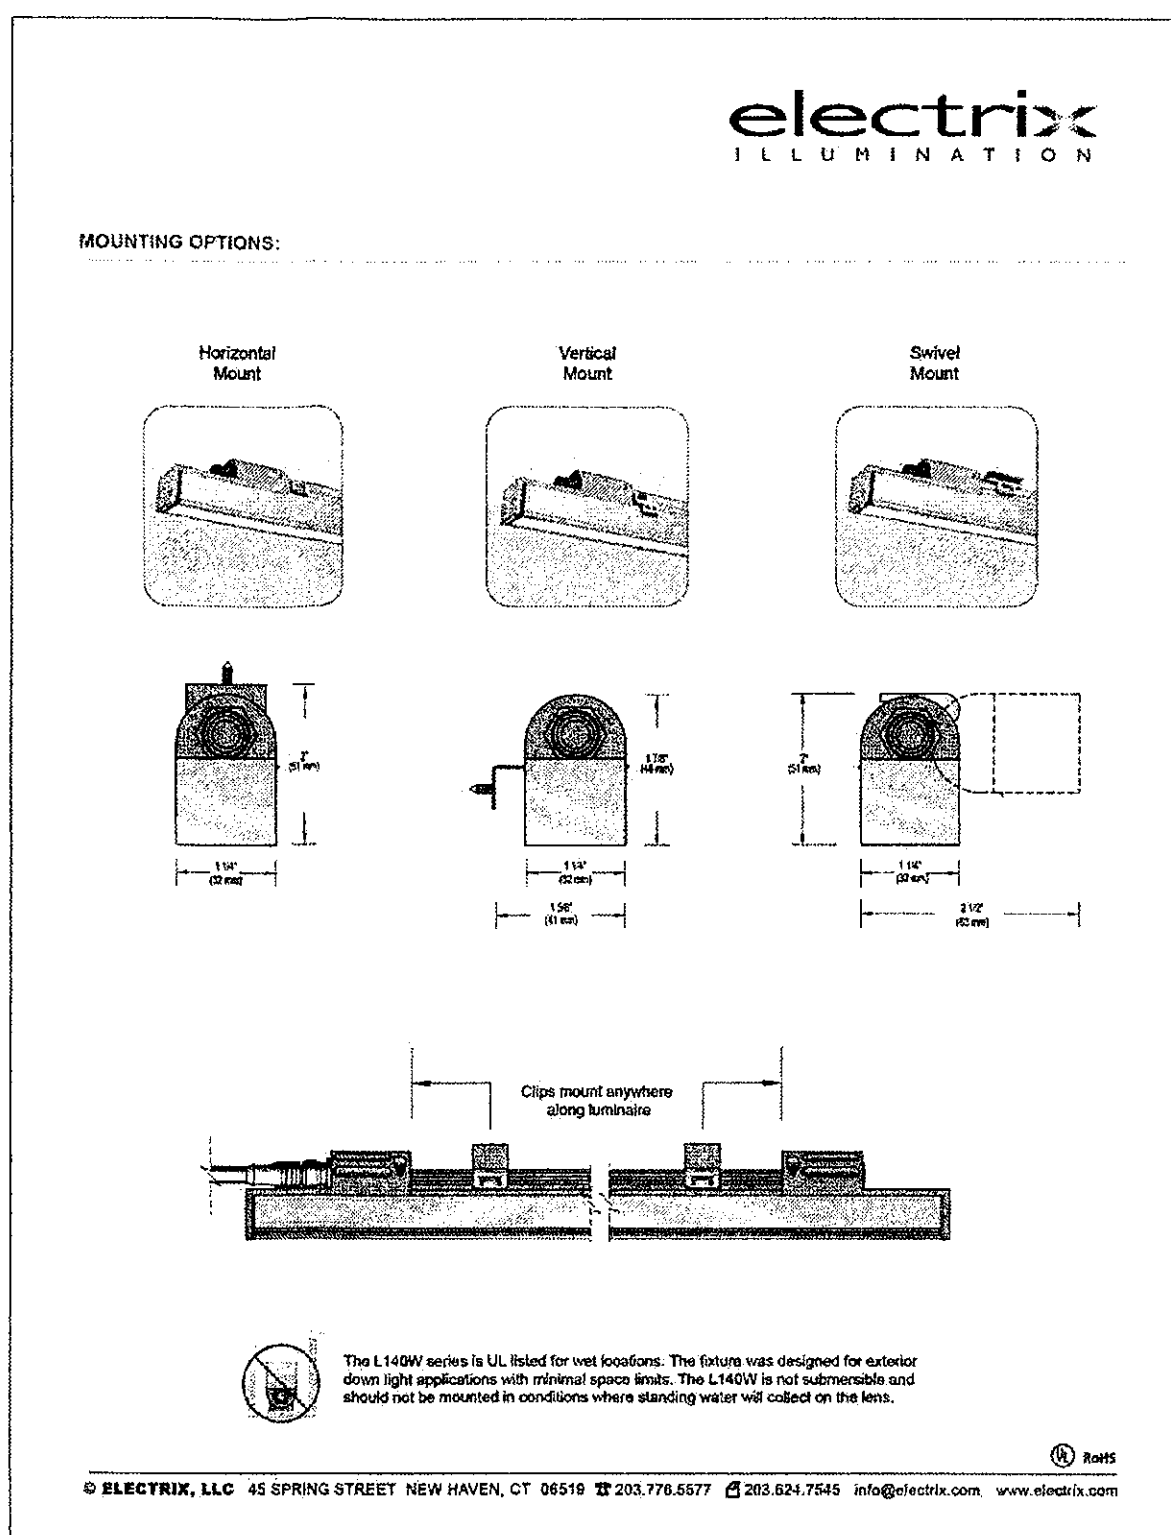

2. All lighting mounted eight (8) feet or higher shall be directed downward:
NOT APPLICABLE - Fixture cove mounted to underside of bench directed downward

3. Wherever practicable, lighting which is directed upward should be located on the west or east sides of the object being lit
NOT PRACTICABLE - Fixtures oriented with architectural features

SPECIFICATIONS

DESCRIPTION:
Anchor bolt for ground mounting
Landscape grade, suitable for wet/dampness
location installations.

MATERIAL:
Standard: steel material is PVC coated,
6063-T5C2 plastic

FINISH:
K - Natural, Black PVC

ELECTRICAL:
Wiring equipment suitable for low
voltage or line voltage fixtures.

ROUTING:
Post has (1) 1/2" NPS round.

SAMPLE ORDER SPECIFICATION:
G3A-10

RATINGS:
Weatherability location.

MADE IN THE USA

1/2" NPS

3/4" DIA. (1.5x)

1 1/2" DIA. (4x)


1 1/2" DIA. (4x)

ORDER SPECIFICATION:

Finish	Post	Length	Voltage	Customer Material
PROJECT:				
APPROVED:				
NOTE:				
TYPE:				

HEVI LITE, INC.
1714 Vandal Way, Columbus, GA 31911
Tel.: (818) 541-4001 • Fax: (818) 998-1086
Web: www.hevylite.com

CATALOG NUMBER
G-3A

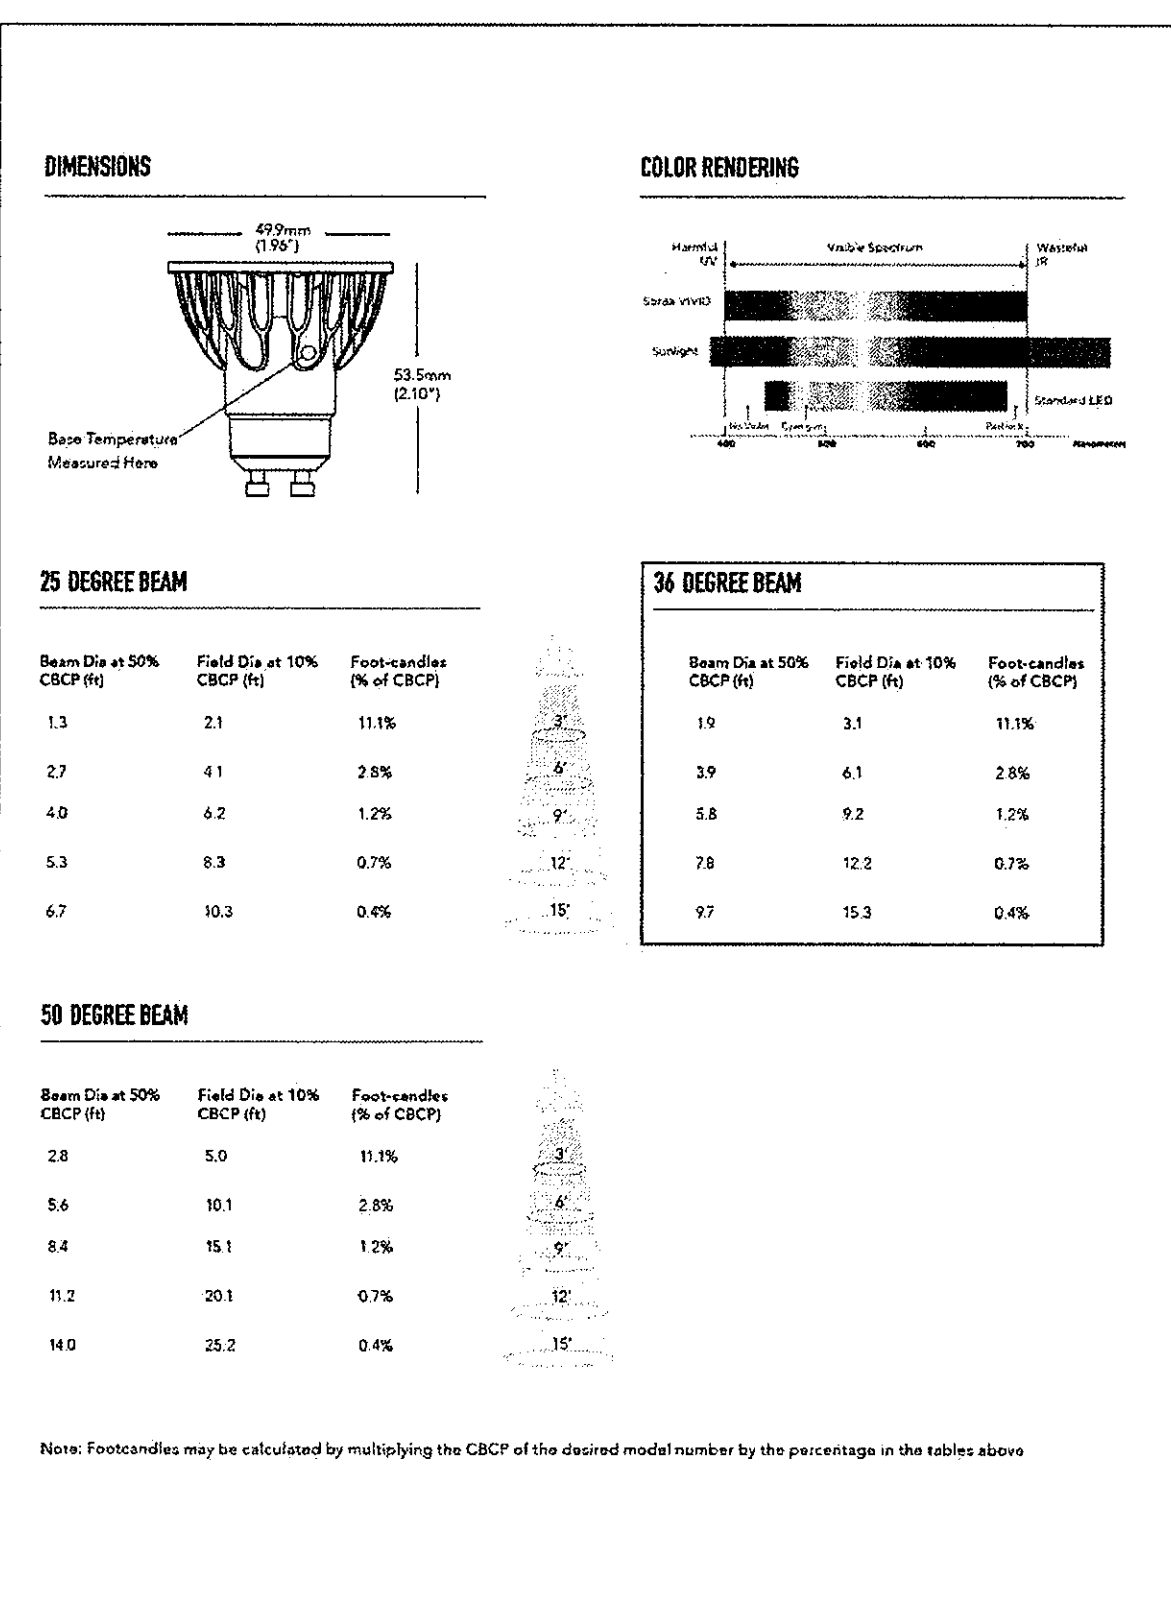

E-702

MEWA USA, INC.

POWER AND 1 (UNITS) BY RAKE POINT (1 LIT/100 LB/HR)

Nominal Horsepower		851	856	858 (B&C) 1000			906	908	908
Extra Center									
Power (Horse)		2000	2050	2060	2090	12700	10000		
Center @ 1000 PSI		0.02	0.04	0.05	0.05	1.01	1.01	1.01	1.01
Center Power (Horse)		0.10	0.20	0.30	0.30	0.70	0.60	0.60	0.60
Power (Horse)		2000	2000	2000	2000	1000	1000	1000	1000
Center @ 800 PSI		0.11	0.10	0.10	0.10	0.20	0.20	0.20	0.20
Center @ 600 PSI		0.06	0.10	0.10	0.10	0.21	0.21	0.21	0.21
12" Lanes		1.000	4.500	3.000	3.000	12.000	14.100		
B&C Rake		0.01-01	0.01-01	0.01-01	0.01-01	0.01-01	0.01-01		
Lanes		1.000	4.500	3.000	3.000	12.000	14.100		
18" Rake		0.01-01	0.01-01	0.01-01	0.01-01	0.01-01	0.01-01		
18" Rake Power		0.00-00	0.00-00	0.00-00	0.00-00	0.00-00	0.00-00		
Lanes		1.000	4.500	3.000	3.000	12.000	14.100		
18" Rake		0.01-01	0.01-01	0.01-01	0.01-01	0.01-01	0.01-01		
Lanes		1.000	4.500	3.000	3.000	12.000	14.100		
B&C Rake		0.01-01	0.01-01	0.01-01	0.01-01	0.01-01	0.01-01		
Lanes		1.000	4.500	3.000	3.000	12.000	14.100		
180°									
B&C Rake		0.01-01	0.01-01	0.01-01	0.01-01	0.01-01	0.01-01		
Lanes		1.000	4.500	3.000	3.000	12.000	14.100		
180°									
B&C Rake		0.01-01	0.01-01	0.01-01	0.01-01	0.01-01	0.01-01		
Lanes		1.000	4.500	3.000	3.000	12.000	14.100		
200° Rake		0.01-01	0.01-01	0.01-01	0.01-01	0.01-01	0.01-01		
Lanes		1.000	4.500	3.000	3.000	12.000	14.100		
200° Rake Power		0.00-00	0.00-00	0.00-00	0.00-00	0.00-00	0.00-00		
Lanes		1.000	4.500	3.000	3.000	12.000	14.100		
200° Rake		0.01-01	0.01-01	0.01-01	0.01-01	0.01-01	0.01-01		
Lanes		1.000	4.500	3.000	3.000	12.000	14.100		
240° Rake		0.01-01	0.01-01	0.01-01	0.01-01	0.01-01	0.01-01		
Lanes		1.000	4.500	3.000	3.000	12.000	14.100		
240° Rake Power		0.00-00	0.00-00	0.00-00	0.00-00	0.00-00	0.00-00		
Lanes		1.000	4.500	3.000	3.000	12.000	14.100		
240° Rake		0.01-01	0.01-01	0.01-01	0.01-01	0.01-01	0.01-01		
Lanes		1.000	4.500	3.000	3.000	12.000	14.100		
240° Rake Power		0.00-00	0.00-00	0.00-00	0.00-00	0.00-00	0.00-00		
Lanes		1.000	4.500	3.000	3.000	12.000	14.100		

[illegible]

E-703