


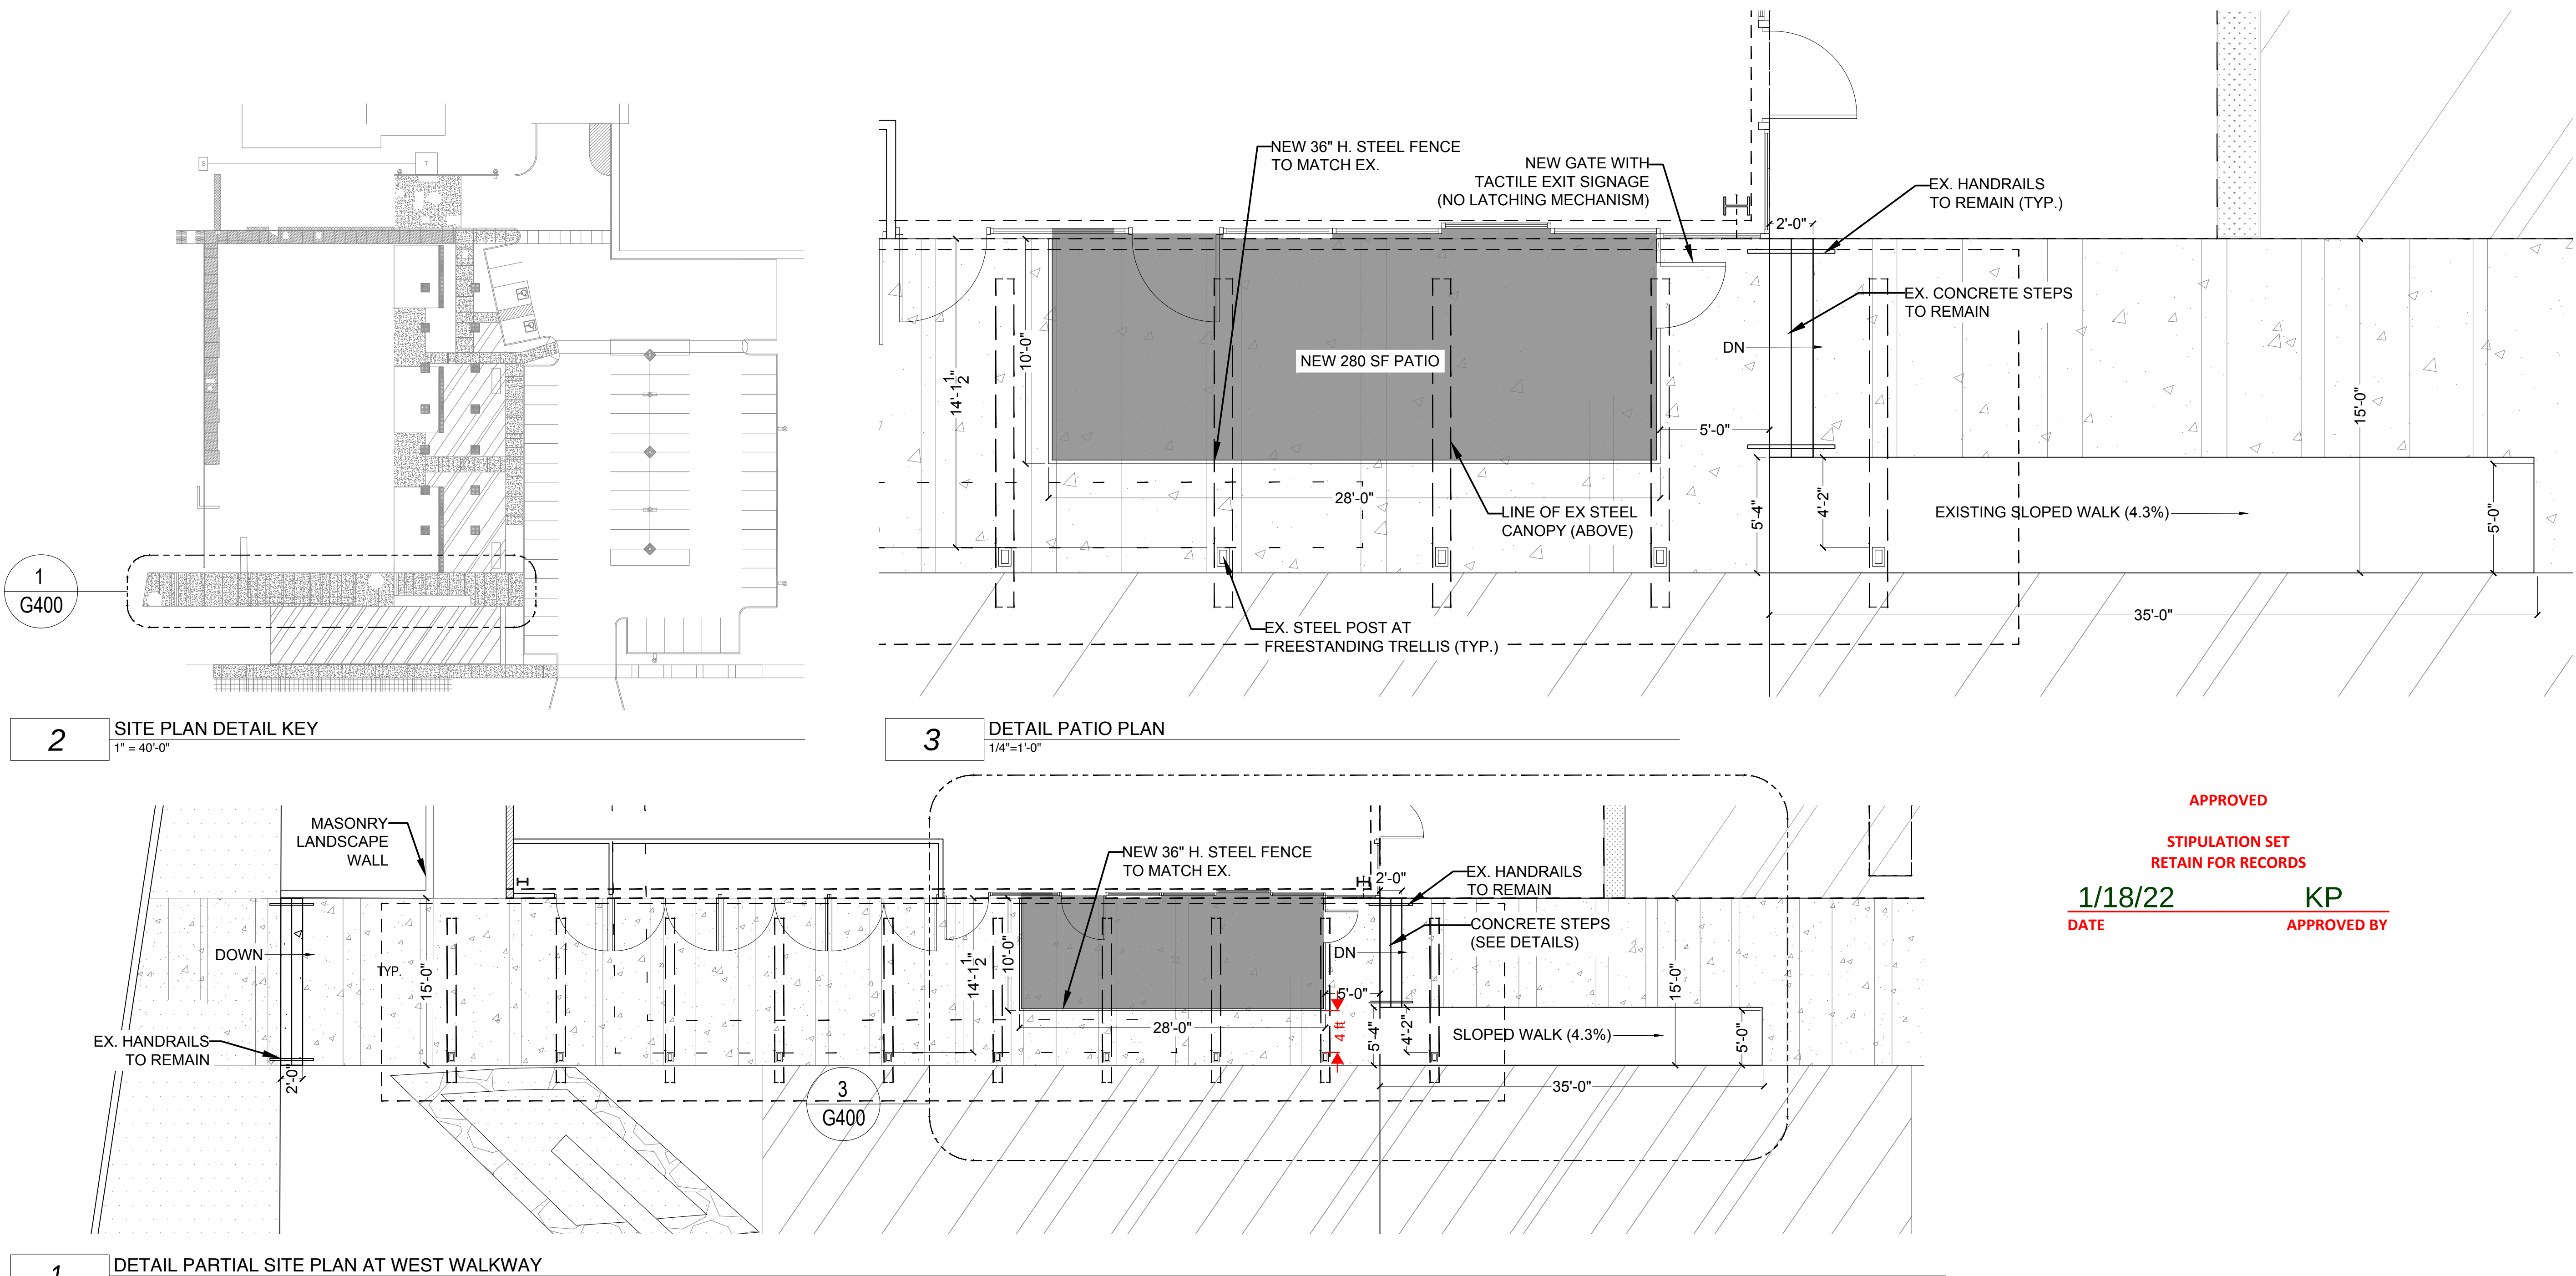


APPROVED
STIPULATION SET
RETAIN FOR RECORDS
1/18/22 DATE
KP APPROVED BY

THIS DRAWING IS PART OF A SET OF WORKING DRAWINGS. THE INFORMATION CONTAINED ON THIS DRAWING MUST BE COORDINATED WITH THE BALANCE OF THE DRAWINGS, AND CANNOT BE TAKEN AS A STAND-ALONE INSTRUCTION. ALL GENERAL NOTES AND SPECIFICATIONS APPLY TO EVERY SHEET IN THIS SET.

SKYSONG RESTAURANTS BUILDING
1455 N. Scottsdale Road
Scottsdale, AZ 85257

Date	2021-11-15
Project No.	1219
Drawn By	MXR
Checked By	JED
Revision	
Date	

G400
DETAIL SITE PLANS

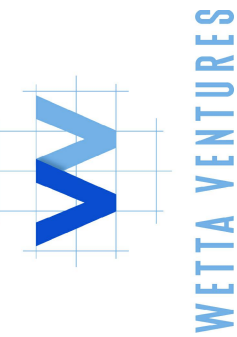

BRICK & WEST
DESIGN

CONSULTANTS:

CERTIFICATION:

TRACKING #:

PLAN CHECK #: