



Special Event Application

2/19/2025

Standard

29-SE-2025

Event Information

Event Name CANAL CONVERGENCE | SHOWTIME!

Event Location 7124 E STETSON DR

Event URL CANALCONVERGENCE.COM

Event Description CANAL CONVERGENCE IS AN ANNUAL, FREE EVENT THAT CELEBRATES THE VIBRANT ARTS AND CULTURE COMMUNITY. EACH CANAL CONVERGENCE, SINCE THE FIRST OFFICIAL EVENT IN 2012, HAS FEATURED LARGE-SCALE PUBLIC ART INSTALLATIONS, CREATED BY LOCAL, NATIONAL, AND INTERNATIONAL ARTISTS. IN ADDITION TO THE ARTWORKS, THE EVENT INCLUDES AN ARRAY OF EDUCATIONAL PROGRAMMING, FAMILY-ORIENTED ACTIVITIES, ART-MAKING WORKSHOPS, AND MORE. CANAL CONVERGENCE ALSO OFFERS A BROAD SELECTION OF LIVE MUSIC, DANCE PERFORMANCES, AND A BEER, WINE, AND FOOD GARDEN. THE FEATURED THEME OF THIS YEAR'S EVENT, NOV. 7-16, 2025, IS SHOWTIME!.

Event Dates

Event Dates (10)	Start Date	End Date	Participant Attendance	Other Attendance
	FRI 11/7/2025 6:00 PM	FRI 11/7/2025 10:00 PM	6000	35
	SAT 11/8/2025 6:00 PM	SAT 11/8/2025 10:00 PM	6000	35
	SUN 11/9/2025 6:00 PM	SUN 11/9/2025 9:00 PM	5000	35
	MON 11/10/2025 6:00 PM	MON 11/10/2025 9:00 PM	5000	35
	TUE 11/11/2025 6:00 PM	TUE 11/11/2025 9:00 PM	5000	35
	WED 11/12/2025 6:00 PM	WED 11/12/2025 9:00 PM	5000	35
	THU 11/13/2025 6:00 PM	THU 11/13/2025 9:00 PM	5000	35
	FRI 11/14/2025 6:00 PM	FRI 11/14/2025 10:00 PM	8000	35
	SAT 11/15/2025 6:00 PM	SAT 11/15/2025 10:00 PM	8000	35
	SUN 11/16/2025 6:00 PM	SUN 11/16/2025 9:00 PM	5000	35

Setup Date FRI 10/24/2025 8:00 AM - 10:00 PM

Teardown Date MON 11/17/2025 8:00 AM - 07:00 PM

Applicant Information

Applicant SCOTTSDALE ARTS

Applicant Address 7380 E 2ND ST

Applicant City SCOTTSDALE, AZ 85251

Applicant Name JENNIFER GILL

Title DEPUTY DIRECTOR FOR CANAL CONVERGENCE

Phone (248) 840-7012 **Email** JENNIFERG@SCOTTSDALEARTS.ORG

On-Site Contact JENNIFER GILL

Title DEPUTY DIRECTOR FOR CANAL CONVERGENCE

Phone (248) 840-7012 **Email** JENNIFERG@SCOTTSDALEARTS.ORG



Special Event Application

2/19/2025

Standard

29-SE-2025

Applicant Experience THIS IS A CITY SIGNATURE EVENT AND IS ON ITS 13TH YEAR.

Prior Events

Has this event been produced before? YES

Is this an annual event? YES Previous Years : 12

Are there any changes from previous years? NO

Event Elements

Elements CIVIC, CULTURAL, EDUCATIONAL, ENTERTAINMENT, RECREATIONAL

Description CANAL CONVERGENCE IS AN ANNUAL FREE EVENT THAT FEATURES LARGE-SCALE PUBLIC ART INSTALLATIONS CREATED BY LOCAL, NATIONAL, AND INTERNATIONAL ARTISTS. IN ADDITION TO THE ARTWORKS, THE EVENT INCLUDES AN ARRAY OF EDUCATIONAL PROGRAMMING, FAMILY-ORIENTED ACTIVITIES, ART-MAKING WORKSHOPS, AND MORE. CANAL CONVERGENCE ALSO OFFERS A BROAD SELECTION OF LIVE MUSIC, DANCE PERFORMANCES, AND A BEER, WINE, AND FOOD GARDEN.

Public Property Criteria

Are there any cross promotions or collaborations with local businesses to encourage sales or visibility? NO

CANAL CONVERGENCE WORKS WITH MANY LOCAL BUSINESSES THROUGH VARIOUS SPONSORSHIP OR PARTNERSHIP PROGRAMS THAT PROMOTE SALES AND VISIBILITY FOR THOSE BUSINESSES. WHILE THOSE HAVE YET TO BE CONFIRMED FOR 2025, WE WILL MOVE FORWARD WITH SIMILAR INITIATIVES.

Explain any anticipated regional, national, or international attendance.

WE HOST 8-10 NATIONAL AND INTERNATIONAL ARTISTS AND WORK WITH LARGE PUBLIC ART NETWORKS TO MARKET THIS DESTINATION EVENT.

Is Scottsdale promoted in the special event marketing? YES

THIS IS THE CITY'S SIGNATURE DESTINATION EVENT.

Explain how the community benefits from the event from a civic or cultural perspective.

THIS EVENT IS AN INTEGRAL PART OF OUR ARTS COMMUNITY AND IS AN INTERNATIONAL AND NATIONAL PUBLIC ART DESTINATION EVENT.

Does your event require a paid fee for participants and/or spectators? NO

Event Equipment

Stages	YES QTY: 2	Tables, Chairs, Furniture	YES	
Generators	YES KW SIZE: 56 QTY: 6	Inflatables	NO	
Portable Bars	YES QTY: 4	Amplified Sound	YES	
Speakers	YES QTY: 5+	Temporary Restrooms	YES QTY: 20	
Fencing	YES HEIGHT: 4 TYPE: BIKE	BBQ Grills or Propane Use	NO	Fire show - propane storage on south side of canal bank
Lighting	YES	Tents/Canopies	YES	
		10' x 10' QTY: 25	10' x 20' QTY: 2	
		20' x 20' QTY: 1		

Vendor Sales



Special Event Application

2/19/2025

Standard

29-SE-2025

Retail Merchandise YES QTY: 1
Food Trucks YES QTY: 6
Services NO

Food And Non-Alcoholic Beverages YES QTY: 1
Alcohol YES QTY: 1
APPLICATION FOR : SPECIAL EVENT LIQUOR LICENSE
ORGANIZATION NAME : SCOTTSDALE ARTS

Signage Plan

On-Site Signs? YES QTY: 10 TYPE: PORTABLE (A-FRAME- SITS ON TOP OF GROUND)

Off-Premise Signs? NO

Signage Plan Description:

8 TOWER SIGNS, 30 HEAVY-DUTY SIGNS, MULTIPLE BANNERS, ETC. ADDITIONAL INFO TBD

Parking Plan

City parking lot YES City parking garage YES
On-street parking YES On-site parking NO
Off-site parking NO Shuttle service from off-site parking areas NO
Valet service NO Rider Provider NO

Parking Plan Description

WE ONLY ADVERTISE FREE AND OPEN-TO-THE-PUBLIC PARKING.

Street Use

Street or Alley Use

Street Closure : YES
Number of Lanes : 1
Direction : N
Street Name : ROUNDABOUT
Closure Dates : 11/3/2025 8:00:00 AM - 11/19/2025 8:00:00 PM
11/4/2025 11/17/2025

Public Parking Use

Parking Closure : YES
Parking Name : 700 E VIA SOLERI DRIVE/NORDSTROM PARKING GARAGE
Closure Dates : 11/7/2025 8:00:00 AM - 11/16/2025 7:00:00 PM

Sidewalk Use

Sidewalk Closure : NO

Barricade Company

Entertainment - Amplification/Sound Plan

Entertainment

LIVE BAND, PRE-RECORDED MUSIC, DJ, SPEAKER/ANNOUNCER, OTHER PERFORMER



Special Event Application

2/19/2025

Standard

29-SE-2025

Application Authorization

WARRANTY: Applicant warrants that the information provided in this application is true and accurate to the best of Applicant's knowledge and belief.

INDEMNIFICATION: To the fullest extent allowed by law, the Applicant agrees to defend, indemnify and hold harmless the City, its officers, officials, representatives, agents, employees and volunteers from and against all allegations, demands, proceedings, suits, actions, claims, damages, losses, expenses, including but not limited to, attorney fees, court costs, the cost of appellate proceedings, and all claim adjusting and handling expenses, arising from or related to any acts or omissions of the permit holder or its agents, contractors and subcontractors related to the Special Event including any claims, damages, or losses resulting from the City's or its employees' or agents' negligence.

The Applicant's signature below authorizes a City representative to inspect a special event on City or private property at any time, including setup.

AUTHORITY: For special events on public property, the Applicant warrants:

I am the permittee or an authorized agent of the permittee with authority to legally bind the permittee (an agent may sign only if the event is on private property) and agree to the conditions of this permit.

Signature of Applicant - must be the same person listed on application.

Printed Name JENNIFER GILL


Date 2/19/2025

Title of Applicant DEPUTY DIRECTOR OF CANAL CONVERGENCE

Canal Convergence | SHOWTIME

Nov. 7-16, 2025

Full Event Map

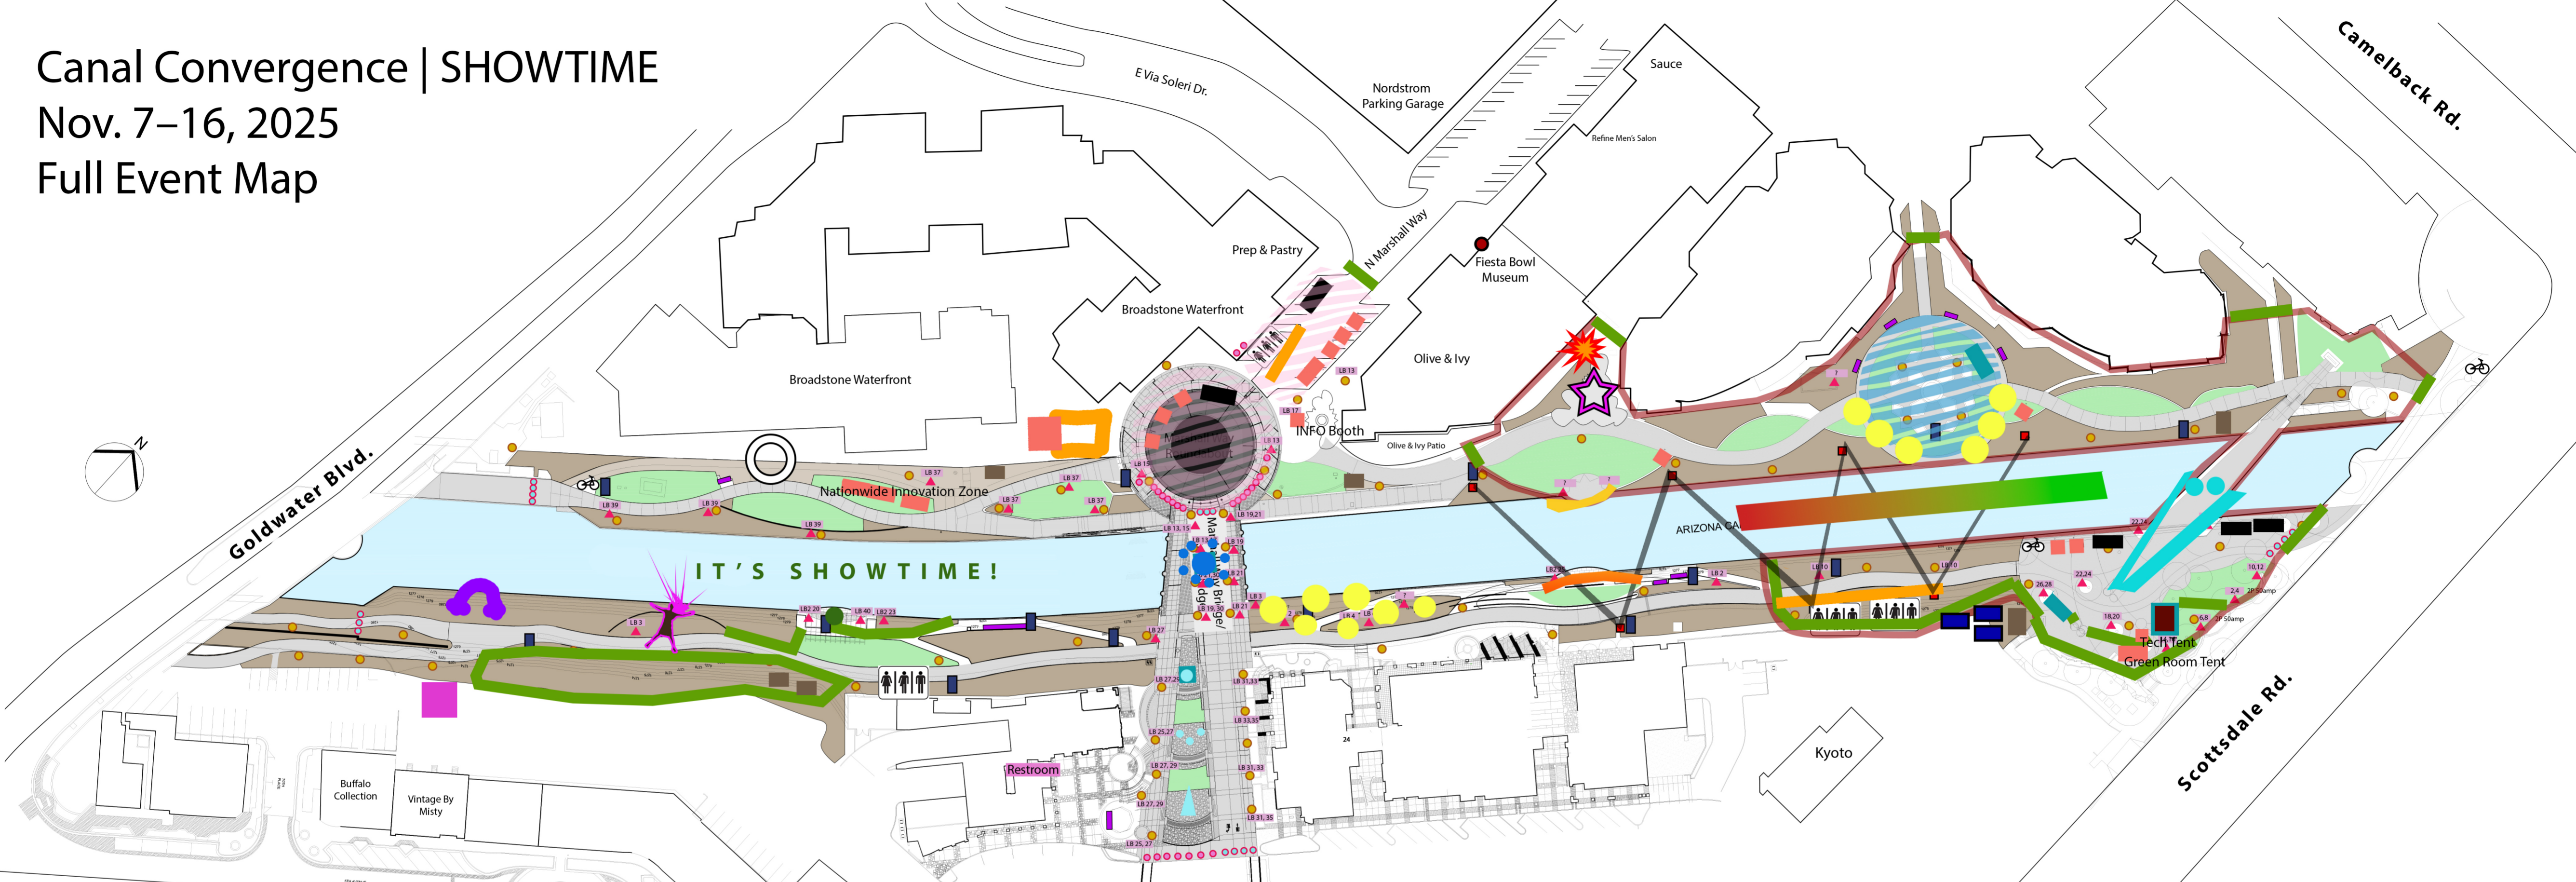

	Parallel Flow Dina Fisher and David Howe		Octopoda Amigo & Amigo		HD-BMP MASARY Studios		Portable Toilets		CC24 Staff/Volunteer Check-in and Greenroom		Bars
	RECOGNITION New American Public Art and Wonderspaces		Showtime Walter Productions		Polychroma In Theory Art Studios		Liquor Perimeter		Staff/Volunteer ONLY Fiesta Bowl Entry and Exit		Main Stage
	Long Wave Pneuhaus		STARGATE Chalk River Labs		Chainlink Fence		Scottsdale Arts Roundabout		Dumpsters		SRP LED Display
	Pulse MattCreative		BIG TV BIG ART		PED Fence		Lounge		Food Trucks		SRP Booth
							Generators		Tents		SRP Info Signs

	Light Poles		Electricity
	Permanent Rigging Poles		
	Benches		
	Bike Rack		
	Trash Cans		
	Permanent Stations		
	Temporary Stations		



Canal Convergence *SHOWTIME*

November 7-16, 2025 at the Scottsdale Waterfront

General Event Information:

Dates:

Nov. 7–16, 2025

Hours:

Fridays + Saturdays:
6-10 pm

Sundays +
Mon.–Thurs.:
6-9 p.m.

Admission:

FREE and open to the public, with nominal fees for some workshops, special events and public art tours.

Location:

Scottsdale Waterfront between Scottsdale Road and Goldwater Boulevard.

Programming Highlights:

Nationwide Innovation Zone Workshops
Public Art and SRP Tours
Billie Jo Herberger's Lounge Events
Scottsdale Arts Roundabout Community Partners Program
Live Music, Dance, and more!

Featured Theme:

SHOWTIME: This year's event theme will focus on the fusion of public art and performance, as well as the subject of performance itself, including its history, cultural significance, and role in art and society.

Long Wave by Pnuehaus

Fabricated in Rhode Island by Pnuehaus, *Long Wave* is 330 feet long and over 20 feet tall, creating a presence that meets the vast scale of its surroundings. The title refers not only to the sine-like geometry of the structure, but also to broader cycles that unfold slowly and steadily across space.





Octopoda by Amigo & Amigo

Join *Octopoda* in his quest to conquer the seas as the greatest eight-legged steampunk drummer-pus. This immersive installation invites you to power and control the intricate machinations of *Octopoda* through eight giant barrel drums, each connected to his fully computerized, light-responsive limbs. Watch his mood blossom to life with every beat and crash.



***B!G TV* by B!G ART**

B!G TV is a 16-foot screen that invites the audience to play, engage, and co-create by triggering animations, responding to prompts, or contributing real-time content. It reimagines the living room TV of your childhood—wood paneling, rabbit ears, Saturday morning cartoons—and catapults it into the future with a bold, interactive twist.

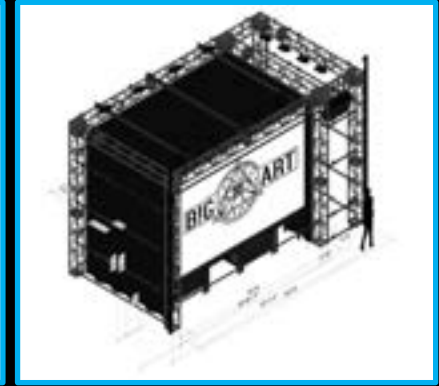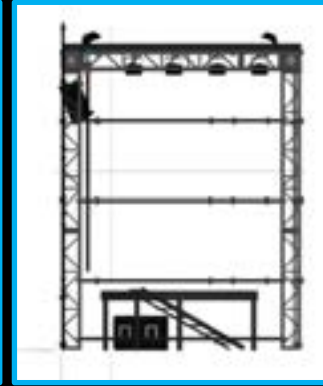


HD-BPM by MASARY Studios

HD-BPM is an instrument for public play that transforms rhythm into light. By striking the illuminated drum pads, participants send crisscrossing pulses of colored light down a series of LED arrays, transforming the artwork into a stage where light becomes the music. Hitting harder produces a faster velocity of light, while playing two drums at once mixes the primary colors.



***Parallel Flow* by Dina Fisher and David Howe**

Parallel Flow is an interactive sound and light show. Twin arrays of colorful light tubes, one on each canal shore, exchange a call-and-response lightshow that continually evolves with a responsive soundscape. Festivalgoers contribute using a handheld interactive sensor, and nightly musical performances by *Parallel Flow*'s creators similarly transform the lightshow.

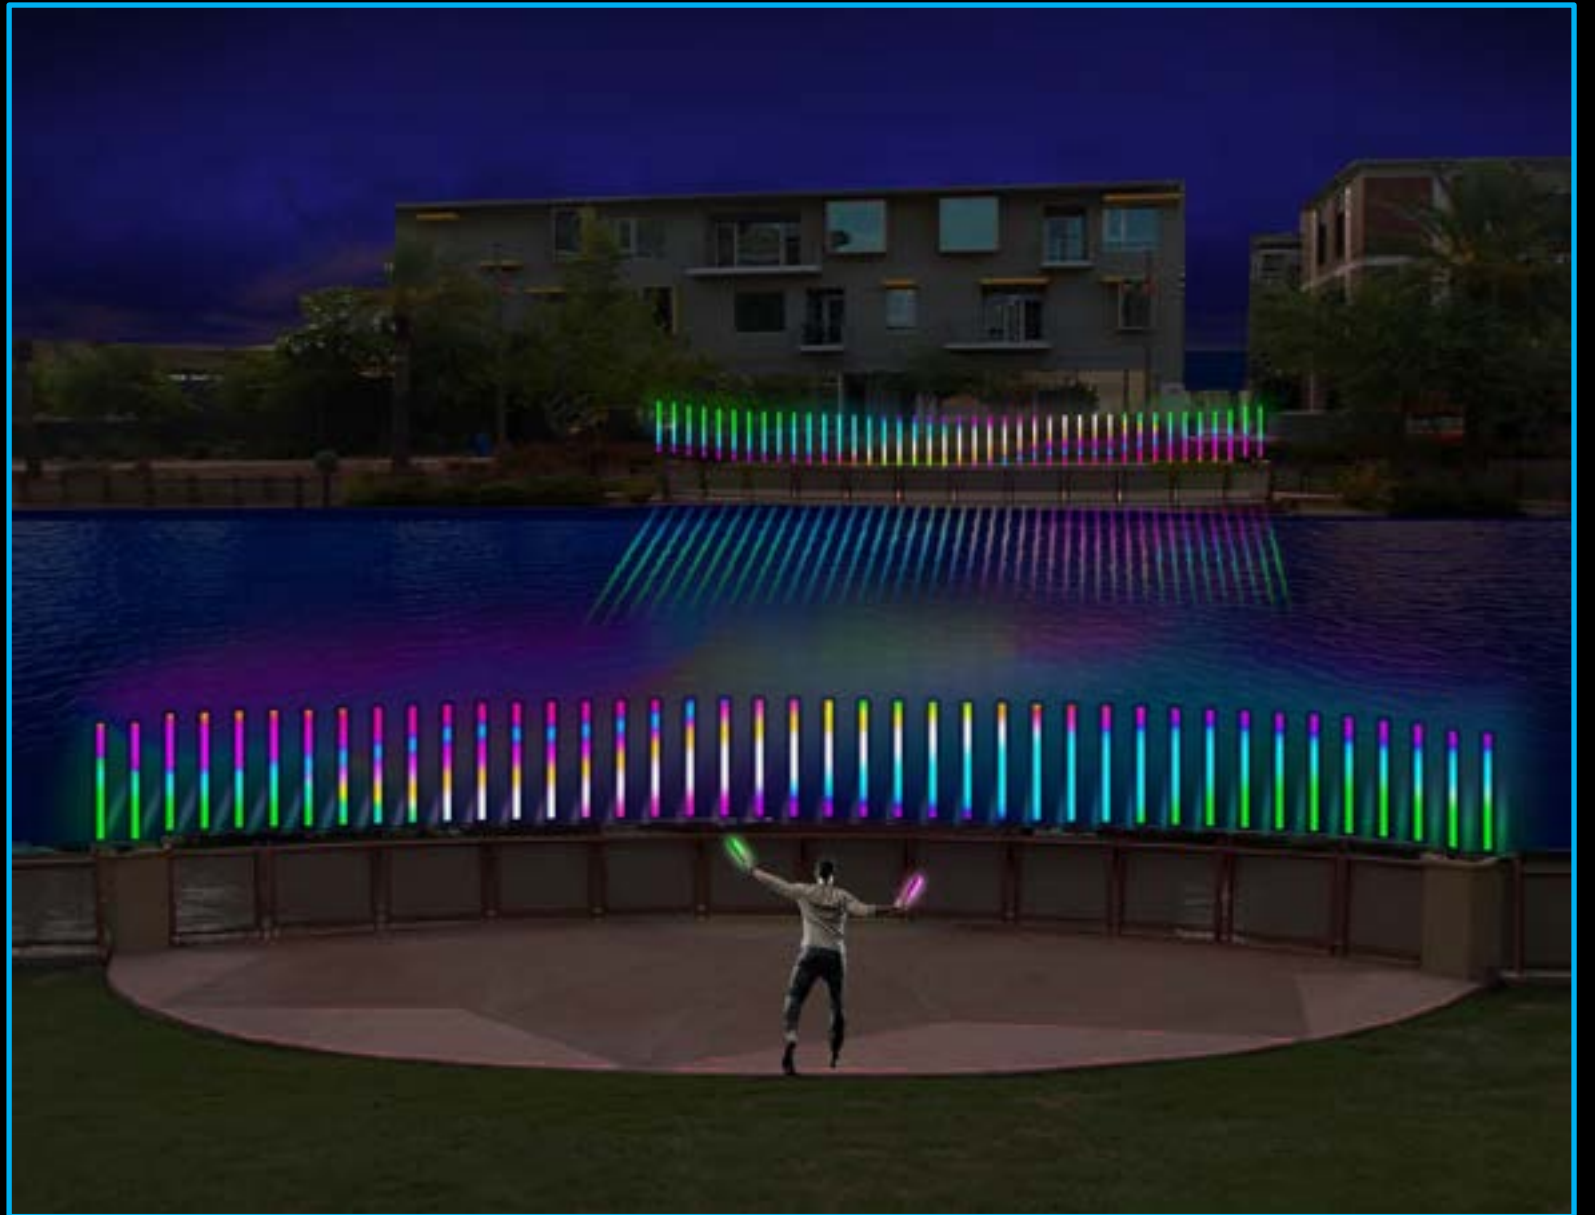

Pulse by MattCreative

Pulse is an interactive art installation designed to explore our connection to nature. A large LED ring suspended around each tree allows visitors to sit back and watch the trees create stunning visualizations of light, or walk amongst them and discover how they react to your presence.



Recognition **by New American Public Art**

Recognition uses live facial tracking to automatically project participants' faces onto a giant polygonal 3D form, blending organic and digital elements in real time. This playful yet provocative work explores themes of self-representation, surveillance, and the performative nature of modern digital life.



Showtime **by Walter** **Productions**

Showtime captures the essence of live entertainment, intertwining flames, light, and music in a vibrant spectacle. Attendees can interact with Showtime by controlling the lighting of the artwork.





Stargate by Chalk River Labs

Step into the future with Stargate, an innovative projection sculpture. Featuring a 12-foot square encompassing a circular ring, it is designed to usher viewers on a journey through the cosmos. Viewers are encouraged to climb into the central ring, serving as a meditative space and a photo opportunity, creating interaction and shared experiences.




polychroma by In Theory Art Studios

This mighty rainbow sculpture, composed of dichroic and LEDs, embodies the magnificence of inclusivity and diversity. Casting a vivid spectrum of colors that illuminates the surrounding space, it is a captivating symbol of diversity, celebrating the beauty of differences and inspiring awe and wonder through its impressive iridescent and LED effects.





EQUIPMENT LEGEND	_____ "A" Lights
■ Sign Symbol	_____ "B" Lights
● Vertical Panel	_____ "C" Lights
▨ Type 1	▬▬▬▬ Arrow Panel
▨ Type 3	⚡ High Level

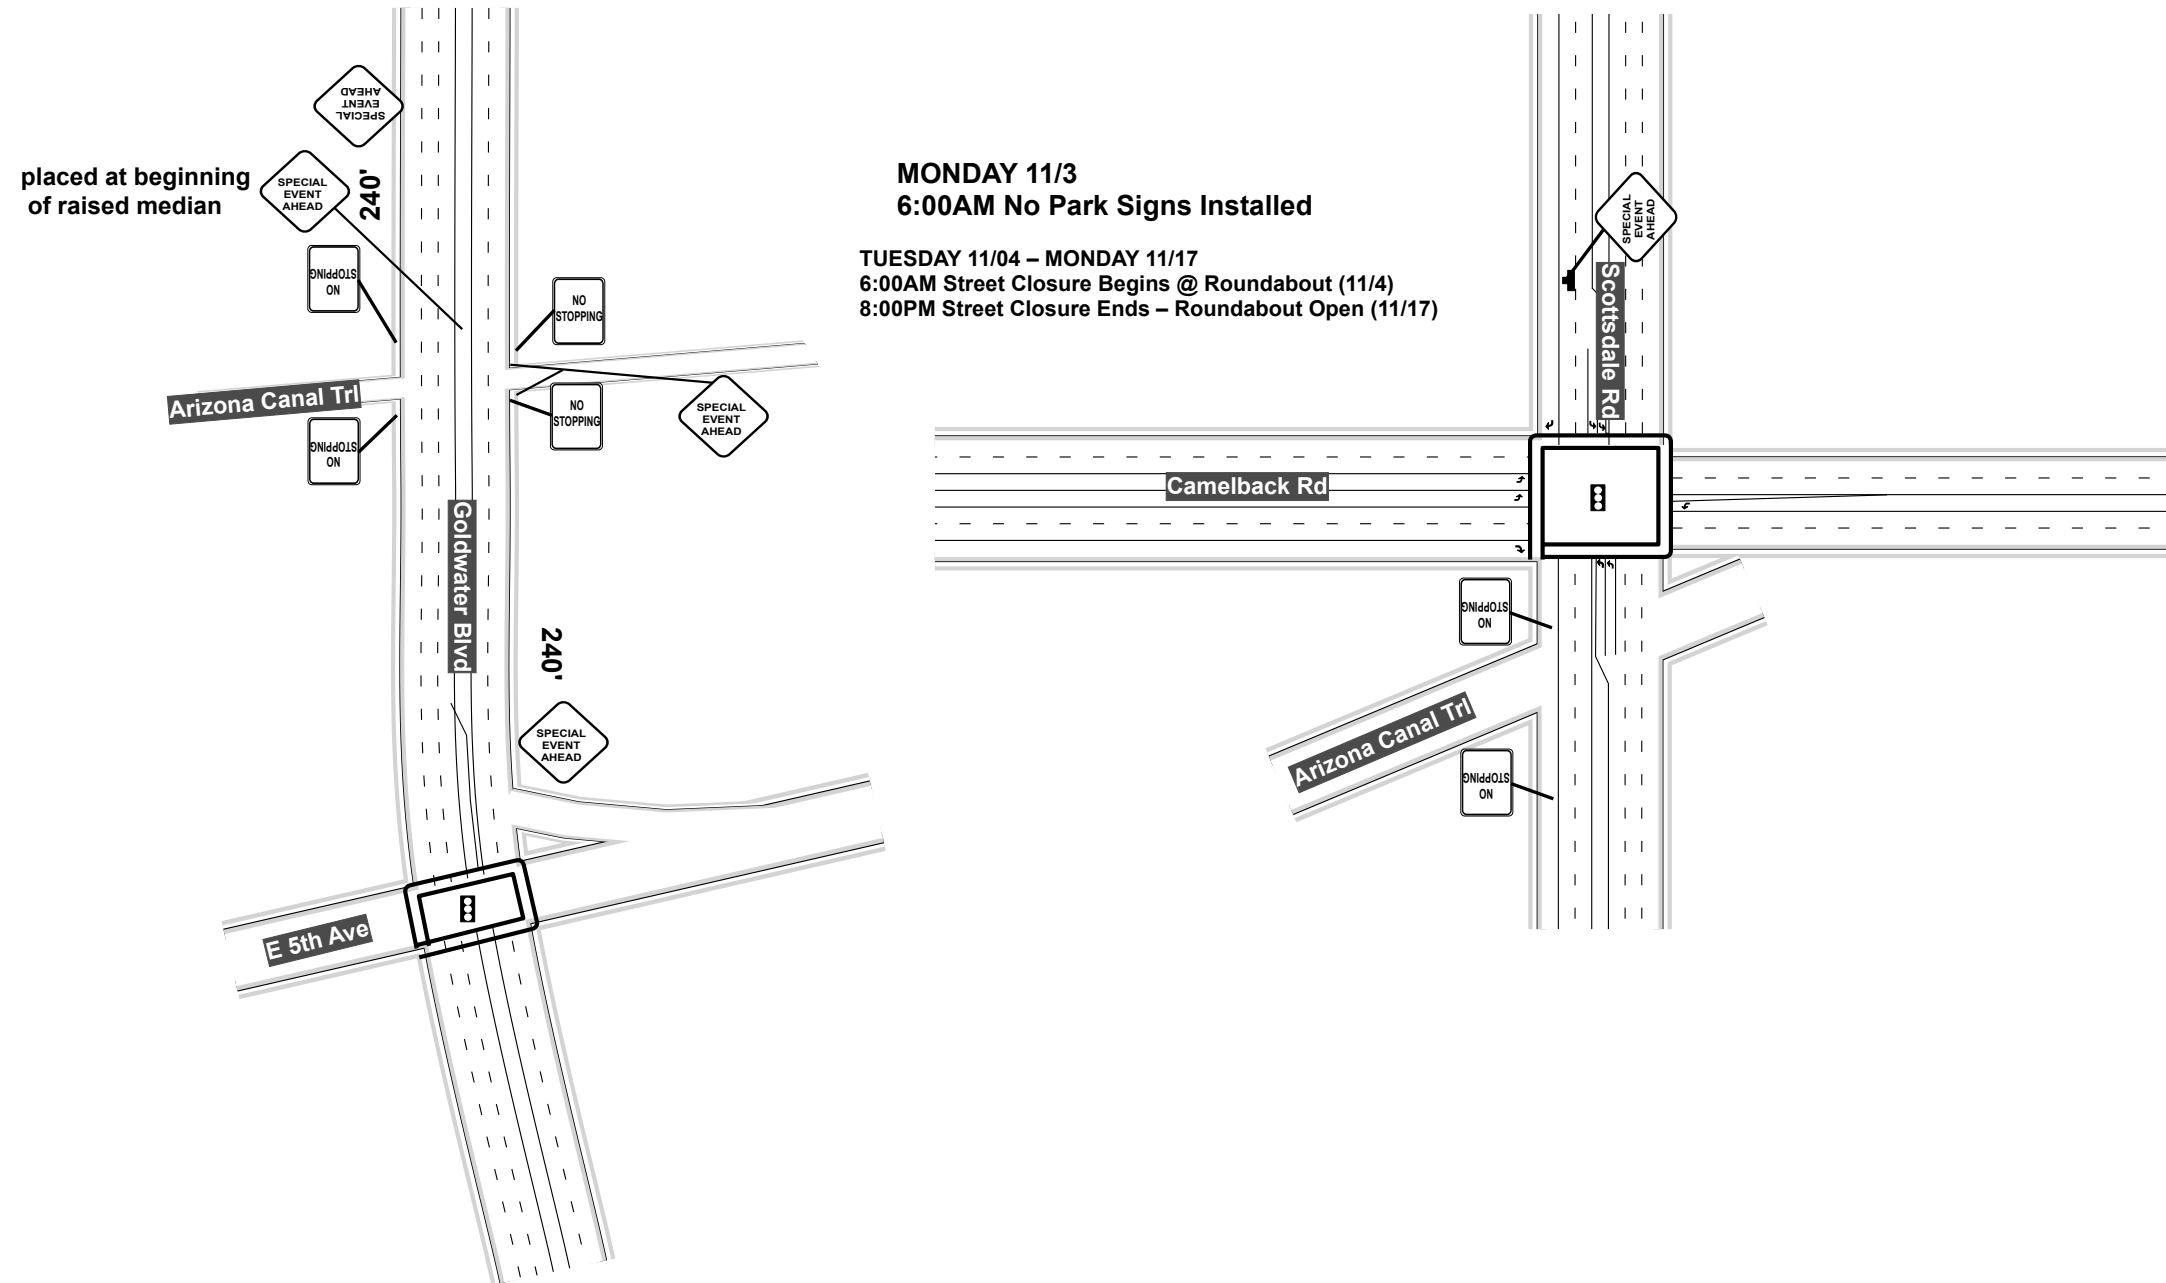

OFF-DUTY OFFICER IS REQUIRED IF WORKZONE IS WITHIN 300' OF SIGNALIZED INTERSECTION DRAWING NOT TO SCALE




Drawn by: Gibran Plascencia
Phone: 602-788-2222
Email: TCP@swbarricades.com



TCP NAME: 22-4676 A COS PERMIT: X
 LOCATION: Via Soleri Dr & Marshall Way
 START DATE: 11/4/2025 END DATE: 11/17/2025
 WORK HOURS: 8:30am-3:30pm Mon-Fri 24 HR
 10:00pm-5:00am Sun-Thur Other: _____
 CONTRACTOR: Entertainment Solution
 CONTACT PERSON: Kevin Koziol
 EMAIL: kevin@solutionsaz.com


COMPASS

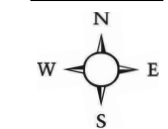

POSTED SPEED



	EQUIPMENT LEGEND	___ "A" Lights	=Water barrier	PAGE: 2 of 2	City of Scottsdale Approval Field Engineering
	Sign Symbol	___ "B" Lights			
	Vertical Panel	___ "C" Lights		Traffic Engineering	
	Type 1	Arrow Panel			
	Type 3	High Level			

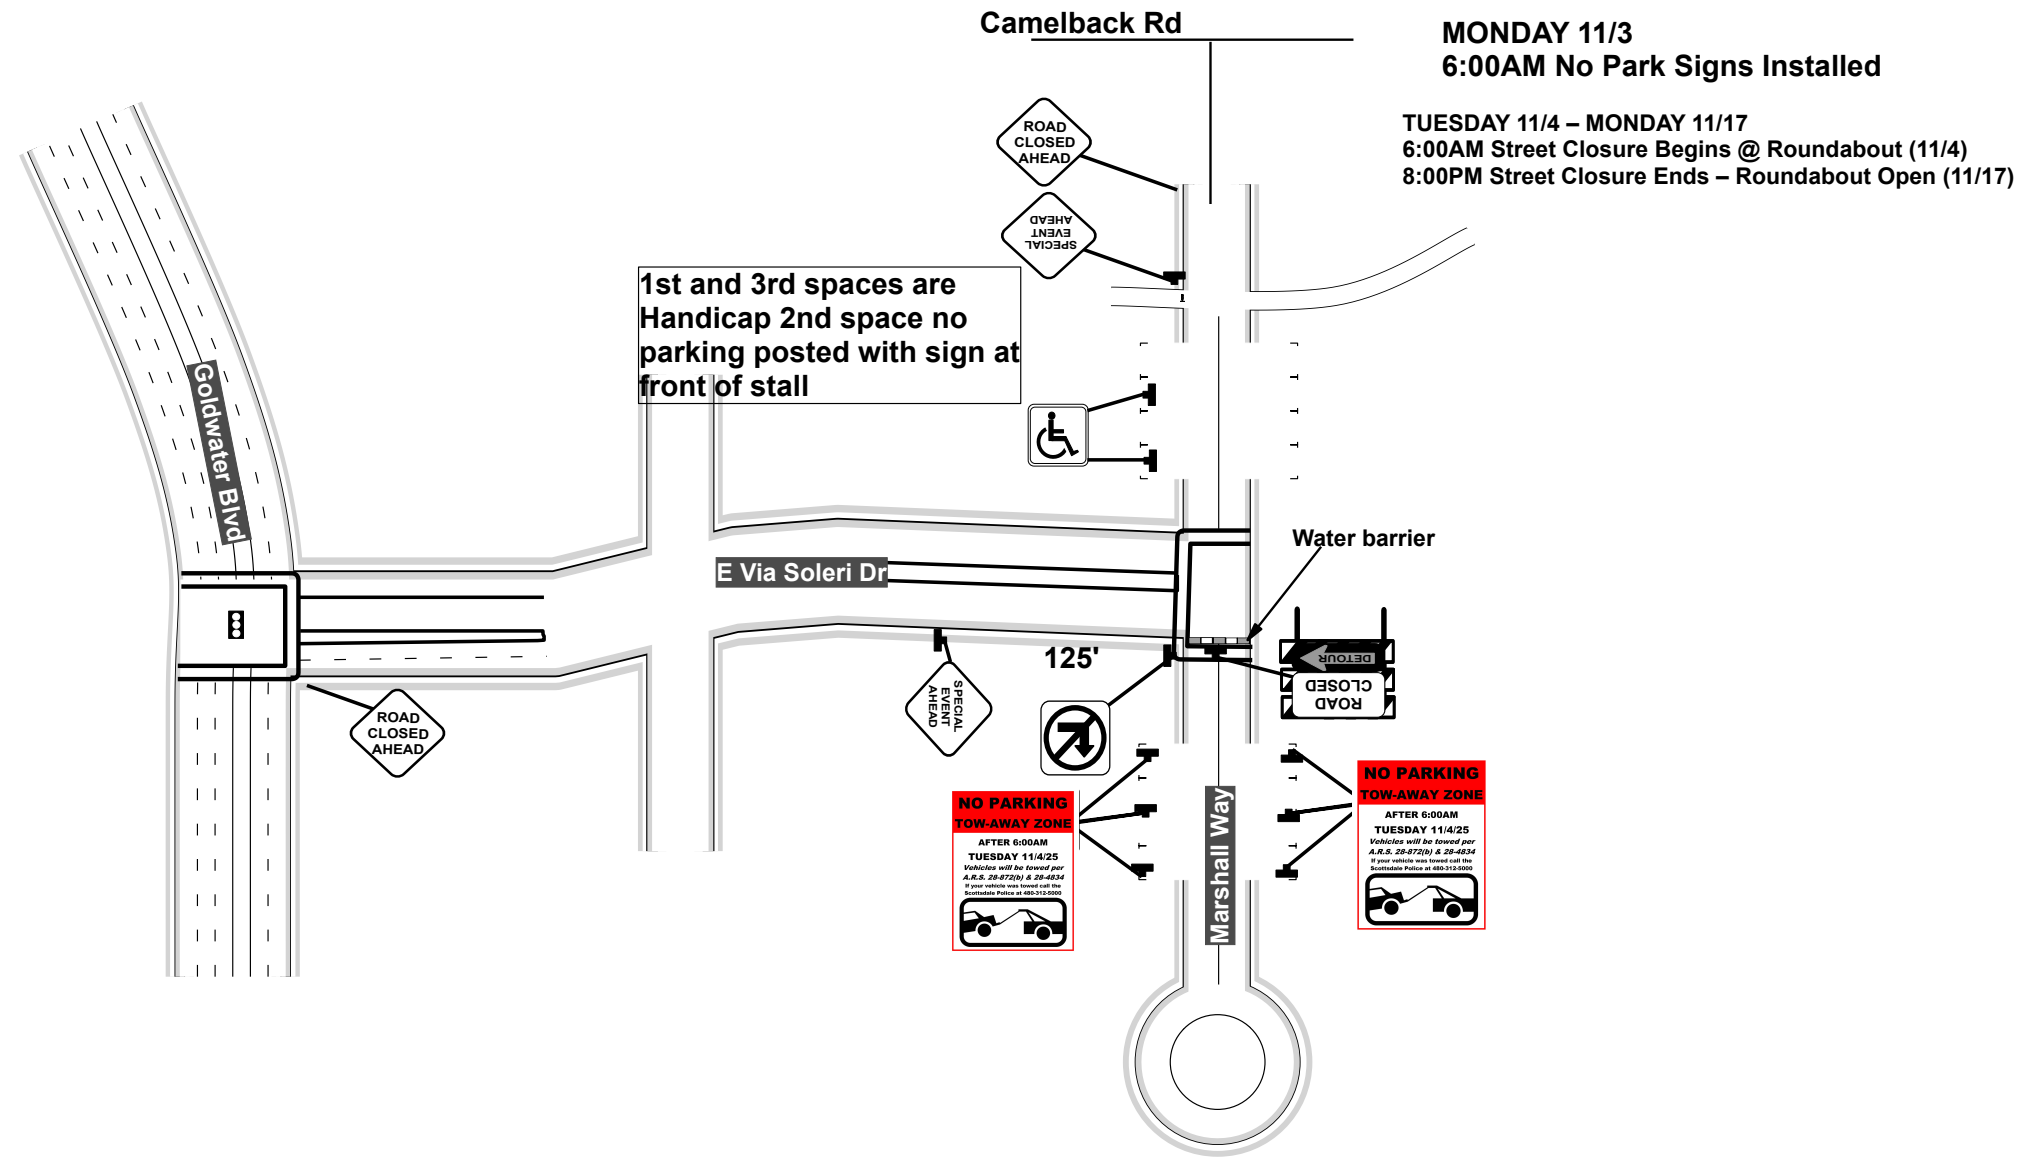

OFF-DUTY OFFICER IS REQUIRED IF WORKZONE IS WITHIN 300' OF SIGNALIZED INTERSECTION DRAWING NOT TO SCALE

 Drawn by: Gibran Plascencia Phone: 602-788-2222 Email: TCP@swbarricades.com 	TCP NAME: <u>22-4676 B</u> COS PERMIT: <u>X</u>	COMPASS 	POSTED SPEED
	LOCATION: <u>Via Soleri Dr & Marshall Way</u>		
	START DATE: <u>11/4/2025</u> END DATE: <u>11/17/2025</u>	WORK HOURS: <input checked="" type="checkbox"/> 8:30am-3:30pm Mon-Fri <input type="checkbox"/> 24 HR	
	CONTRACTOR: <u>Entertainment Solution</u>	<input type="checkbox"/> 10:00pm-5:00am Sun-Thur <input type="checkbox"/> Other: _____	
	CONTACT PERSON: <u>Kevin Koziol</u> EMAIL: <u>kevin@solutionsaz.com</u>	PHONE: <u>602-620-3351</u>	



CERTIFICATE OF LIABILITY INSURANCE

DATE (MM/DD/YYYY)

10/30/2025

THIS CERTIFICATE IS ISSUED AS A MATTER OF INFORMATION ONLY AND CONFERS NO RIGHTS UPON THE CERTIFICATE HOLDER. THIS CERTIFICATE DOES NOT AFFIRMATIVELY OR NEGATIVELY AMEND, EXTEND OR ALTER THE COVERAGE AFFORDED BY THE POLICIES BELOW. THIS CERTIFICATE OF INSURANCE DOES NOT CONSTITUTE A CONTRACT BETWEEN THE ISSUING INSURER(S), AUTHORIZED REPRESENTATIVE OR PRODUCER, AND THE CERTIFICATE HOLDER.

IMPORTANT: If the certificate holder is an ADDITIONAL INSURED, the policy(ies) must have ADDITIONAL INSURED provisions or be endorsed. If SUBROGATION IS WAIVED, subject to the terms and conditions of the policy, certain policies may require an endorsement. A statement on this certificate does not confer rights to the certificate holder in lieu of such endorsement(s).

PRODUCER Marsh & McLennan Agency LLC 8605 E. Raintree Drive, Suite 200 Scottsdale AZ 85260	CONTACT NAME: Soo Murray	
	PHONE (A/C, No. Ext):	FAX (A/C, No):
E-MAIL ADDRESS: Soo.Murray@MarshMMA.com		
INSURER(S) AFFORDING COVERAGE		NAIC #
INSURER A: Philadelphia Indemnity Insurance Co.		18058
INSURED Scottsdale Arts fka Scottsdale Cultural Council 7380 E. 2nd St. Scottsdale AZ 85251	INSURER B: CopperPoint Insurance Company	14216
	INSURER C:	
	INSURER D:	
	INSURER E:	
INSURER F:		

COVERAGES

CERTIFICATE NUMBER: 1374397343

REVISION NUMBER:

THIS IS TO CERTIFY THAT THE POLICIES OF INSURANCE LISTED BELOW HAVE BEEN ISSUED TO THE INSURED NAMED ABOVE FOR THE POLICY PERIOD INDICATED. NOTWITHSTANDING ANY REQUIREMENT, TERM OR CONDITION OF ANY CONTRACT OR OTHER DOCUMENT WITH RESPECT TO WHICH THIS CERTIFICATE MAY BE ISSUED OR MAY PERTAIN, THE INSURANCE AFFORDED BY THE POLICIES DESCRIBED HEREIN IS SUBJECT TO ALL THE TERMS, EXCLUSIONS AND CONDITIONS OF SUCH POLICIES. LIMITS SHOWN MAY HAVE BEEN REDUCED BY PAID CLAIMS.

INSR LTR	TYPE OF INSURANCE	ADDL INSD	SUBR WVD	POLICY NUMBER	POLICY EFF (MM/DD/YYYY)	POLICY EXP (MM/DD/YYYY)	LIMITS
A	<input checked="" type="checkbox"/> COMMERCIAL GENERAL LIABILITY <input type="checkbox"/> CLAIMS-MADE <input checked="" type="checkbox"/> OCCUR GEN'L AGGREGATE LIMIT APPLIES PER: <input type="checkbox"/> POLICY <input type="checkbox"/> PRO-JECT <input checked="" type="checkbox"/> LOC <input type="checkbox"/> OTHER:	Y	Y	PHPK2566860009	7/1/2025	7/1/2026	EACH OCCURRENCE \$ 1,000,000 DAMAGE TO RENTED PREMISES (Ea occurrence) \$ 1,000,000 MED EXP (Any one person) \$ 20,000 PERSONAL & ADV INJURY \$ 1,000,000 GENERAL AGGREGATE \$ 2,000,000 PRODUCTS - COMP/OP AGG \$ 2,000,000 \$
A	<input checked="" type="checkbox"/> AUTOMOBILE LIABILITY <input checked="" type="checkbox"/> ANY AUTO <input type="checkbox"/> OWNED AUTOS ONLY <input type="checkbox"/> SCHEDULED AUTOS <input checked="" type="checkbox"/> HIRED AUTOS ONLY <input checked="" type="checkbox"/> NON-OWNED AUTOS ONLY	Y	Y	PHPK2566860009	7/1/2025	7/1/2026	COMBINED SINGLE LIMIT (Ea accident) \$ 1,000,000 BODILY INJURY (Per person) \$ BODILY INJURY (Per accident) \$ PROPERTY DAMAGE (Per accident) \$ \$
A	<input checked="" type="checkbox"/> UMBRELLA LIAB <input type="checkbox"/> OCCUR <input type="checkbox"/> EXCESS LIAB <input type="checkbox"/> CLAIMS-MADE <input type="checkbox"/> DED <input checked="" type="checkbox"/> RETENTION \$ 10,000			PHUB868473009	7/1/2025	7/1/2026	EACH OCCURRENCE \$ 5,000,000 AGGREGATE \$ 5,000,000 \$
B	<input checked="" type="checkbox"/> WORKERS COMPENSATION AND EMPLOYERS' LIABILITY ANY PROPRIETOR/PARTNER/EXECUTIVE OFFICER/MEMBER EXCLUDED? (Mandatory in NH) If yes, describe under DESCRIPTION OF OPERATIONS below	Y/N	N/A	1019573	7/1/2025	7/1/2026	<input checked="" type="checkbox"/> PER STATUTE <input type="checkbox"/> OTH-ER E.L. EACH ACCIDENT \$ 1,000,000 E.L. DISEASE - EA EMPLOYEE \$ 1,000,000 E.L. DISEASE - POLICY LIMIT \$ 1,000,000
A	Liquor Liability			PHPK2566860009	7/1/2025	7/1/2026	Each cause limit 1,000,000 Aggregate Limit 1,000,000

DESCRIPTION OF OPERATIONS / LOCATIONS / VEHICLES (ACORD 101, Additional Remarks Schedule, may be attached if more space is required)

The above-indicated Additional Insured and Waiver of Subrogation (WOS) are provided with respects to General Liability when required in a written and executed contract. Such coverage afforded by these policies for the benefit of the additional insured(s) is primary and any other coverage maintained by such additional insured(s) shall be non-contributory when required in a written and executed contract. Subject to all policy terms, conditions and exclusions

Sexual Abuse Molestation coverage included per Policy #PHPK2566860008: Occurrence Form- Limits \$1,000,000 Aggregate/ \$1,000,000 Each Abusive Conduct/\$0 Deductible

Supporting endorsements attached include: CG2026 04 13; CG2001 04 13; CG2404 05 09
 RE: Canal Convergence.

CERTIFICATE HOLDER**CANCELLATION**

City of Scottsdale
 3939 N Drinkwater Blvd
 Scottsdale AZ 85251

SHOULD ANY OF THE ABOVE DESCRIBED POLICIES BE CANCELLED BEFORE THE EXPIRATION DATE THEREOF, NOTICE WILL BE DELIVERED IN ACCORDANCE WITH THE POLICY PROVISIONS.

AUTHORIZED REPRESENTATIVE

© 1988-2015 ACORD CORPORATION. All rights reserved.

THIS ENDORSEMENT CHANGES THE POLICY. PLEASE READ IT CAREFULLY.

ADDITIONAL INSURED – DESIGNATED PERSON OR ORGANIZATION

This endorsement modifies insurance provided under the following:

COMMERCIAL GENERAL LIABILITY COVERAGE PART

SCHEDULE

Name Of Additional Insured Person(s) Or Organization(s):

As Per Written Contract

Information required to complete this Schedule, if not shown above, will be shown in the Declarations.

A. Section II – Who Is An Insured is amended to include as an additional insured the person(s) or organization(s) shown in the Schedule, but only with respect to liability for "bodily injury", "property damage" or "personal and advertising injury" caused, in whole or in part, by your acts or omissions or the acts or omissions of those acting on your behalf:

1. In the performance of your ongoing operations; or
2. In connection with your premises owned by or rented to you.

However:

1. The insurance afforded to such additional insured only applies to the extent permitted by law; and
2. If coverage provided to the additional insured is required by a contract or agreement, the insurance afforded to such additional insured will not be broader than that which you are required by the contract or agreement to provide for such additional insured.

B. With respect to the insurance afforded to these additional insureds, the following is added to **Section III – Limits Of Insurance:**

If coverage provided to the additional insured is required by a contract or agreement, the most we will pay on behalf of the additional insured is the amount of insurance:

1. Required by the contract or agreement; or
2. Available under the applicable Limits of Insurance shown in the Declarations;

whichever is less.

This endorsement shall not increase the applicable Limits of Insurance shown in the Declarations.

THIS ENDORSEMENT CHANGES THE POLICY. PLEASE READ IT CAREFULLY.

PRIMARY AND NONCONTRIBUTORY – OTHER INSURANCE CONDITION

This endorsement modifies insurance provided under the following:

COMMERCIAL GENERAL LIABILITY COVERAGE PART
PRODUCTS/COMPLETED OPERATIONS LIABILITY COVERAGE PART

The following is added to the **Other Insurance** Condition and supersedes any provision to the contrary:

Primary And Noncontributory Insurance

This insurance is primary to and will not seek contribution from any other insurance available to an additional insured under your policy provided that:

- (1) The additional insured is a Named Insured under such other insurance; and
- (2) You have agreed in writing in a contract or agreement that this insurance would be primary and would not seek contribution from any other insurance available to the additional insured.

WAIVER OF TRANSFER OF RIGHTS OF RECOVERY AGAINST OTHERS TO US

This endorsement modifies insurance provided under the following:

COMMERCIAL GENERAL LIABILITY COVERAGE PART
PRODUCTS/COMPLETED OPERATIONS LIABILITY COVERAGE PART

SCHEDULE

Name Of Person Or Organization:

Information required to complete this Schedule, if not shown above, will be shown in the Declarations.

The following is added to Paragraph 8. **Transfer Of Rights Of Recovery Against Others To Us** of Section IV – Conditions:

We waive any right of recovery we may have against the person or organization shown in the Schedule above because of payments we make for injury or damage arising out of your ongoing operations or "your work" done under a contract with that person or organization and included in the "products-completed operations hazard". This waiver applies only to the person or organization shown in the Schedule above.



THIS ENDORSEMENT CHANGES THE POLICY. PLEASE READ IT CAREFULLY

CA2048-City of Scottsdale

The following is added as additional insured CA2048-Designated Insured
City of Scottsdale, its representatives, agents and employees
9191 E San Salvador Dr
Scottsdale, AZ 85258

All other terms and conditions of this Policy remain unchanged.



WORKERS COMPENSATION AND EMPLOYERS LIABILITY INSURANCE POLICY

COPPERPOINT • ALASKA NATIONAL

WAIVER OF OUR RIGHT TO RECOVER FROM OTHERS ENDORSEMENT

We have the right to recover our payments from anyone liable for an injury covered by this policy. We will not enforce our right against the person or organization named in the Schedule. (This agreement applies only to the extent that you perform work under a written contract that requires you to obtain this agreement from us.)

This agreement shall not operate directly or indirectly to benefit anyone not named in the Schedule.

Schedule

Person or Organization
City of Scottsdale

Job Description
And its officers, officials, agents, employees and volunteers.

This endorsement changes the policy to which it is attached and is effective on the date issued unless otherwise stated. (The information below is required only when this endorsement is issued subsequent to preparation of the policy.)

Endorsement Effective 07/01/2024
Insured Scottsdale Cultural Council

Policy No. 1019573

Endorsement No.
Premiums 100.00

Insurance Company CopperPoint National Insurance Company

Countersigned by [Signature]

Authorized Representative

WC 00 03 13
(Ed. 04-1984)

THIS ENDORSEMENT CHANGES THE POLICY. PLEASE READ IT CAREFULLY.

ADDITIONAL INSURED – DESIGNATED PERSON OR ORGANIZATION

This endorsement modifies insurance provided under the following:

COMMERCIAL GENERAL LIABILITY COVERAGE PART

SCHEDULE

Name Of Additional Insured Person(s) Or Organization(s):

As Per Written Contract

Information required to complete this Schedule, if not shown above, will be shown in the Declarations.

A. Section II – Who Is An Insured is amended to include as an additional insured the person(s) or organization(s) shown in the Schedule, but only with respect to liability for "bodily injury", "property damage" or "personal and advertising injury" caused, in whole or in part, by your acts or omissions or the acts or omissions of those acting on your behalf:

1. In the performance of your ongoing operations;
or
2. In connection with your premises owned by or rented to you.

However:

1. The insurance afforded to such additional insured only applies to the extent permitted by law; and
2. If coverage provided to the additional insured is required by a contract or agreement, the insurance afforded to such additional insured will not be broader than that which you are required by the contract or agreement to provide for such additional insured.

B. With respect to the insurance afforded to these additional insureds, the following is added to **Section III – Limits Of Insurance:**

If coverage provided to the additional insured is required by a contract or agreement, the most we will pay on behalf of the additional insured is the amount of insurance:

1. Required by the contract or agreement; or
2. Available under the applicable Limits of Insurance shown in the Declarations;

whichever is less.

This endorsement shall not increase the applicable Limits of Insurance shown in the Declarations.

THIS ENDORSEMENT CHANGES THE POLICY. PLEASE READ IT CAREFULLY.

PRIMARY AND NONCONTRIBUTORY – OTHER INSURANCE CONDITION

This endorsement modifies insurance provided under the following:

COMMERCIAL GENERAL LIABILITY COVERAGE PART
PRODUCTS/COMPLETED OPERATIONS LIABILITY COVERAGE PART

The following is added to the **Other Insurance** Condition and supersedes any provision to the contrary:

Primary And Noncontributory Insurance

This insurance is primary to and will not seek contribution from any other insurance available to an additional insured under your policy provided that:

- (1) The additional insured is a Named Insured under such other insurance; and
- (2) You have agreed in writing in a contract or agreement that this insurance would be primary and would not seek contribution from any other insurance available to the additional insured.

WAIVER OF TRANSFER OF RIGHTS OF RECOVERY AGAINST OTHERS TO US

This endorsement modifies insurance provided under the following:

COMMERCIAL GENERAL LIABILITY COVERAGE PART
PRODUCTS/COMPLETED OPERATIONS LIABILITY COVERAGE PART

SCHEDULE

Name Of Person Or Organization:
Information required to complete this Schedule, if not shown above, will be shown in the Declarations.

The following is added to Paragraph 8. **Transfer Of Rights Of Recovery Against Others To Us** of Section IV – Conditions:

We waive any right of recovery we may have against the person or organization shown in the Schedule above because of payments we make for injury or damage arising out of your ongoing operations or "your work" done under a contract with that person or organization and included in the "products-completed operations hazard". This waiver applies only to the person or organization shown in the Schedule above.

2025 Canal Convergence Timeline

- Installation, Event and Deinstallation take place along the Arizona Canal between Scottsdale Road and Goldwater Blvd.
- Security will be present throughout the Install/Load-In, Event, and Deinstall/Load-Out.

INSTALL/LOAD-IN SCHEDULE

Monday, October 27th

8:00am-5:00pm

- Artwork Install
- Heavy Equipment arrives on-site
- Homebase Tent Installed

Tuesday, October 28th – Wednesday, October 29

8:00am-10:00pm

- Artwork Install

Thursday, October 30 – Sunday, November 2

8:00am-10:00pm

- Artwork Install
- Light Testing After Dark

Monday, November 3

8:00am-10:00pm

- Artwork Install
- Artwork-Related Rentals Delivered
- Power Delivery
- Light Testing After Dark

Tuesday, November 4

8:00am-10:00pm

- Artwork Install
- Light Testing After Dark

Wednesday, November 5

8:00am-10:00pm

- Artwork Install
- Signage Delivery, Begin Placement
- Temporary Toilets and Bike Fencing Delivery and Installation
- Light Testing After Dark

- 5:30pm-7pm
 - Staff & Volunteer Site Tours
- 8:00pm-10:00pm Dance Rehearsal at *B!G TV* artwork

Thursday, November 6

8:00am-10:00pm

- 6:00am
 - Street Closure Begins at Marshall Way Roundabout (SW Barricades)
- Pro EM (and other misc. rental companies) delivery and installation
- Scottsdale Arts Main Stage and Programming Load-In
- Artwork Install/Artwork Install Contingency Day
- Signage Placement Completed
- 5:30pm-7:30pm
 - VIP Behind the Scenes Tour
- 5:30pm-7:00pm
 - Dance Performance Rehearsal at *B!G TV* Artwork
- Light Testing After Dark

EVENT SCHEDULE

Friday, November 7 (8:00am – 10:00pm)

- 8:00am– 3:00pm Artwork Install/Event Load-In Wrap Up, Audio/Tech Delivery
- 12:00–1:00pm Dance Rehearsal at *B!G TV* Artwok
- 2:00-4:00pm Scottsdale Solid Waste Staff On-Site Installing 3-Compartment Containers/90gal Barrels/(50) Cardboard Trash Boxes
- 3:00–5:00pm Ops On-Site, Daily Event Load-In
- 5:00pm Generators Turned On
- 5:00pm-5:30pm Artwork Turned On
- 5:00pm Info Booth Open
- 5:00pm-11:00pm Scottsdale Solid Waste Staff On-Site
- 5:00pm-6:00pm: SRP Canal History Tour
- 5:30pm-6:30pm Canal Convergence Art Tour
- 5:30pm Art Ambassadors & Volunteers On-Site
- 6:00pm Event Begins
- 6:00pm-10:00pm Merchantile Market – Roundabout
- 6:00pm-10:00pm Community Partner Activities – Roundabout
- 6:00pm-10:00pm Innovation Zone Drop In Workshops: SHOWTIME in Print: Printmaking with Xico
- 6:15pm-7:45pm Innovation Zone Workshop: Create your own Light-Based Artwork w/ Chalk River Labs

- 6:30PM WALTER FIRE SHOW
- 6:45pm Flashmob Performance – Big TV (Steph)
- 6:45pm VIP Area – Stage Remarks
- 7:00pm-9:00pm GLOW by Vessel Performances
- 7:15pm Flashmob Performance – VIP Lounge
- 7:30PM WALTER FIRE SHOW
- 7:30pm Herberger Stage Performance – Bad Cactus Brass Band
- 7:45pm Flashmob Performance – Big TV (Steph)
- 8:00pm Herberger Stage Performance – Pijama Piyama
- 8:30PM WALTER FIRE SHOW
- 10:00pm Event Ends

Saturday, November 8 (3:00pm-10:00pm)

- 3:00–5:00pm Ops On-Site, Daily Event Load-In
- 5:00pm Generators Turned On
- 5:00pm-5:30pm Artwork Turned On
- 5:00pm Info Booth Open
- 5:00pm-11:00pm Scottsdale Solid Waste Staff On-Site
- 5:00pm-6:00pm: SRP Canal History Tour
- 5:30pm-6:30pm Canal Convergence Art Tour
- 5:30pm Art Ambassadors & Volunteers On-Site
- 6:00pm Event Begins
- 6:00pm Herberger Stage Performance – Megan Diana
- 6:00pm-9:00pm Scottsdale Arts VIP / Member Night VIP / Opening Celebration
- 6:00pm-10:00pm Community Partner Activities – Roundabout
- 6:00pm-10:00pm Merchantile Market – Roundabout
- 6:00pm-10:00pm Innovation Zone Drop In – SHOWTIME in Print: Printmaking with Xico
- 6:45pm-7:30pm Innovation Zone Workshop at Splashpad – Bucket Drumming w/ MASARY
- 6:30PM WALTER FIRE SHOW
- 6:45pm Dance Performance – Big TV
- 6:45pm VIP Area – Stage Remarks
- 7:00pm-9:00pm GLOW by Vessel Performances
- 7:15pm Dance Performance – VIP Lounge
- 7:30PM WALTER FIRE SHOW
- 7:30pm Herberger Stage Performance – Bolero Jonze
- 7:45pm Dance Performance – Big TV
- 8:30PM WALTER FIRE SHOW
- 9:00pm Herberger Stage Performance - MRCH
- 10:00pm Event Ends

Sunday, November 9 (3:00pm-9:00pm)

- 3:00–5:00pm Ops On-Site, Daily Event Load-In
- 5:00pm Generators Turned On
- 5:00pm-5:30pm Artwork Turned On
- 5:00pm Info Booth Open
- 5:00pm-11:00pm Scottsdale Solid Waste Staff On-Site
- 5:30pm-6:30pm Canal Convergence Art Tour
- 5:30pm Art Ambassadors & Volunteers On-Site
- 6:00pm Event Begins
- 6:00pm Herberger Stage Performance - Obai
- 6:00pm-9:00pm Community Partner Activities – Roundabout
- 6:00pm-10:00pm Merchantile Market – Roundabout
- 6:00pm-9:00pm Innovation Zone Drop-in Workshops: Canalogic with urbanSTEW
- 6:30PM WALTER FIRE SHOW
- 6:45pm Dance Performance – Big TV
- 6:45pm-7:30pm Innovation Zone Workshop at Splashpad – Bucket Drumming w/ MASARY
- 7:15pm Dance Performance – Big TV
- 7:30PM WALTER FIRE SHOW
- 7:30pm Herberger Stage Performance – Outside The Line
- 7:45pm Dance Performance – Big TV
- 8:30PM WALTER FIRE SHOW
- 9:00pm Event Ends

Monday, November 10 (3:00pm-9:00pm)

- 3:00–5:00pm Ops On-Site, Daily Event Load-In
- 5:00pm Generators Turned On
- 5:00pm-5:30pm Artwork Turned On
- 5:00pm Info Booth Open
- 5:00pm-11:00pm Scottsdale Solid Waste Staff On-Site
- 5:15–6:15 p.m. My Story as Movement with Ruby Morales
- 5:30pm-6:30pm Canal Convergence Art Tour
- 5:30pm Art Ambassadors & Volunteers On-Site
- 6:00pm Event Begins
- 6:00pm Herberger Stage Performance - Seligo
- 6:00pm-9:00pm Community Partner Activities – Roundabout
- 6:00pm-9:00pm Innovation Zone Drop-in Workshops: CREATE a Marquee w/ AZ Science Center
- 6:15pm-7:15pm Innovation Zone Workshop: Showstopper Headpieces w/ Walter Hive

- 6:30PM WALTER FIRE SHOW
- 7:30PM WALTER FIRE SHOW
- 6:45–9:00pm Community Get Down with Ruby Morales, Free drop-in activity at B!G TV
- 8:30PM WALTER FIRE SHOW
- 9:00pm Event Ends

Tuesday, November 11 (3:00pm-9:00pm)

- 3:00–5:00pm Ops On-Site, Daily Event Load-In
- 5:00pm Generators Turned On
- 5:00pm-5:30pm Artwork Turned On
- 5:00pm Info Booth Open
- 5:00pm-11:00pm Scottsdale Solid Waste Staff On-Site
- 5:30pm-6:30pm Canal Convergence Art Tour w/ Spanish
- 5:30pm Art Ambassadors & Volunteers On-Site
- 6:00pm Event Begins
- 6:00pm Herberger Stage Performance – Dylan Paul Thomas
- 6:00pm-8:00pm Scottsdale Chamber / Young Professionals VIP Night
- 6:00pm-9:00pm Community Partner Activities – Roundabout
- 6:00pm-9:00pm Innovation Zone Drop-in Workshops: Puppets w/ The Great Arizona Puppet Theater
- 6:30PM WALTER FIRE SHOW
- 7:30PM WALTER FIRE SHOW
- 7:30pm Herberger Stage Performance – Mo Maduro
- 8:30PM WALTER FIRE SHOW
- 9:00pm Event Ends

Wednesday, November 12 (3:00pm-9:00pm)

- 3:00–5:00pm Ops On-Site, Daily Event Load-In
- 5:00pm Generators Turned On
- 5:00pm-5:30pm Artwork Turned On
- 5:00pm Info Booth Open
- 5:00pm-11:00pm Scottsdale Solid Waste Staff On-Site
- 5:30pm-6:30pm Canal Convergence Art Tour
- 5:30pm Art Ambassadors & Volunteers On-Site
- 6:00pm Event Begins
- 6:00pm Herberger Stage Performance – Lunar Calendar
- 6:00pm-8:00pm SRP VIP Night
- 6:00pm-9:00pm Community Partner Activities – Roundabout
- 6:00pm-9:00pm Innovation Zone Drop-in Workshops: Beat Making w/ AZ Beat Lab at Big TV

- 6:15pm-7:15pm Innovation Zone Workshop: Calaca Masks w/ Zarco Guerrero
- 6:30PM WALTER FIRE SHOW
- 7:30PM WALTER FIRE SHOW
- 7:30pm Herberger Stage Performance – Miana y la Musica
- 7:30pm-9:00pm Innovation Zone Drop In: Masks w/ Zarco Guerrero
- 8:30PM WALTER FIRE SHOW
- 9:00pm Event Ends

Thursday, November 13 (3:00pm-9:00pm)

- 3:00–5:00pm Ops On-Site, Daily Event Load-In
- 5:00pm Generators Turned On
- 5:00pm-5:30pm Artwork Turned On
- 5:00pm Info Booth Open
- 5:00pm-11:00pm Scottsdale Solid Waste Staff On-Site
- 5:30pm-6:30pm Canal Convergence Art Tour
- 5:30pm Art Ambassadors & Volunteers On-Site
- 6:00pm Event Begins
- 5:00pm-6:30pm Scottsdale Salutes Celebration VIP Night
- 6:00pm Event Begins
- 6:00pm Herberger Stage Performance – Space Travelers Union
- 6:00pm-9:00pm Community Partner Activities – Roundabout
- 6:00pm-9:00pm Innovation Zone Drop-in Workshops: Masks w/ Zarco Guerrero
- Beat Making w/ AZ Beat Lab at Big TV
- 6:30PM WALTER FIRE SHOW
- 6:30pm-7:00pm VIP Lounge Load Out
- 7:00pm VIP Lounge Open to General Public
- 7:30PM WALTER FIRE SHOW
- 8:00pm Herberger Stage Performance - Valgur
- 8:30PM WALTER FIRE SHOW
- 9:00pm Event Ends

Friday, November 14 (3:00pm-10:00pm)

- 3:00–5:00pm Ops On-Site, Daily Event Load-In
- 5:00pm Generators Turned On
- 5:00pm-5:30pm Artwork Turned On
- 5:00pm Info Booth Open
- 5:00pm-11:00pm Scottsdale Solid Waste Staff On-Site
- 5:00pm-6:00pm: SRP Canal History Tour
- 5:30pm-6:30pm Canal Convergence Art Tour
- 5:30pm Art Ambassadors & Volunteers On-Site
- 6:00pm Event Begins

- 6:00pm Herberger Stage Performance – Betsy Ganz
- 6:00pm-10:00pm VIP Lounge Open to General Public
- 6:00pm-10:00pm Community Partner Activities – Roundabout
- 6:00pm-10:00pm Innovation Zone Drop-in Workshops: Create a Marquee sign w/ AZ Science Center
- 6:30PM WALTER FIRE SHOW
- 7:00pm-7:10pm Nicole Olson Dance Performance at Parallel Flow Artwork
- 7:30PM WALTER FIRE SHOW
- 7:30pm Herberger Stage Performance – Cameron Jeong
- 8:00pm-8:10pm Nicole Olson Dance Performance at Stargate Artwork
- 8:30PM WALTER FIRE SHOW
- 9:00pm Herberger Stage Performance – Ali A and the Agency
- 10:00pm Event Ends

Saturday, November 15 (9:00am-10:00pm)

- 9:00am-11:am Nicole Olson Dress Rehearsal
- 3:00–5:00pm Ops On-Site, Daily Event Load-In
- 5:00pm Generators Turned On
- 5:00pm-5:30pm Artwork Turned On
- 5:00pm Info Booth Open
- 5:00pm-11:00pm Scottsdale Solid Waste Staff On-Site
- 5:00pm-6:00pm: SRP Canal History Tour
- 5:30pm-6:30pm Canal Convergence Art Tour
- 5:30pm Art Ambassadors & Volunteers On-Site
- 6:00pm Event Begins
- 6:00pm Herberger Stage Performance – Rhythm is Life
- 6:00pm-10:00pm VIP Lounge Open to Public
- 6:00pm-10:00pm Community Partner Activities – Roundabout
- 6:00pm-10:00pm Innovation Zone Drop-in Workshops :Create a Marquee sign w/ AZ Science Center, Canalogic w/ ubranSTEW
- 6:30PM WALTER FIRE SHOW
- 7:30PM WALTER FIRE SHOW
- 7:30pm Herberger Stage Performance – Lunes
- 8:00pm-8:10pm Nicole Olson Dance Performance at Marshall Way Bridge
- 8:30PM WALTER FIRE SHOW
- 9:00pm Herberger Stage Performance – Sugar Thieves
- 10:00pm Event Ends

Sunday, November 16 (3:00pm-10:00pm)

- 3:00–5:00pm Ops On-Site, Daily Event Load-In
- 5:00pm Generators Turned On

- 5:00pm-5:30pm Artwork Turned On
- 5:00pm Info Booth Open
- 5:00pm-11:00pm Scottsdale Solid Waste Staff On-Site
- 5:30pm-6:30pm Canal Convergence Art Tour
- 5:30pm Art Ambassadors & Volunteers On-Site
- 6:00pm Event Begins
- 6:00pm Herberger Stage Performance - Alassane
- 6:00pm-9:00pm VIP Lounge Open to Public
- 6:00pm-9:00pm Community Partner Activities – Roundabout
- 6:00pm-9:00pm Innovation Zone Drop-in Workshops: Puppets w/ The Great AZ Puppet Theater
- 6:15pm-7:15pm Innovation Zone Workshop: The Marvelous Medium of Masking Tape
- 6:30PM WALTER FIRE SHOW
- 7:00PM ASU FASHION SHOW at BIG TV
- 7:30PM WALTER FIRE SHOW
- 7:30pm Herberger Stage Performance - Jaleo
- 8:30PM WALTER FIRE SHOW
- 9:00pm Event Ends
- 9:00pm-10:00pm: Preliminary Event Load-Out

DEINSTALLATION/LOAD-OUT

Monday, November 17

8:00am-5:00pm

- Pro EM and All Other Event Rentals Load-Out (except for Homebase Tent)
- Scottsdale Arts Main Stage and Programming Load-Out
- All Remaining Vendors Load-Out
- Artwork Deinstallation
- Signage Removed
- Power (Generators) Load-Out

Tuesday, November 18

8:00am-5:00pm

- Artwork Deinstallation

Wednesday, November 19

8:00am-5:00pm

- Artwork Deinstallation

Thursday, November 20

8:00am-5:00pm

- Artwork Deinstallation

Friday, November 21

8:00am-5:00pm

- Artwork Deinstallation
- Homebase Tent Load-Out

Scottsdale Arts'
CANAL CONVERGENCE
Theme: SHOWTIME
EVENT PROGRAM
November 7–16, 2025

Hours:

Fridays and Saturdays: 6–10 p.m.
Sundays and Monday–Thursday: 6–9 p.m.
Scottsdale Waterfront

SA logo

[panel 2 and 7]
Map and Key

If additional room at the bottom/end of key:

Explore the artworks online at CanalConvergence.com or scan the QR code.
[FY26_CC_2025_Event_Brochure_Artworks_QR_Code.svg](#)

(Panels 3,4,5,6) **Schedule**

Things to Do:

This year's event theme, SHOWTIME, explores the fusion of performance and public art through an exciting variety of light-based artworks, workshops, fire shows, live music, and dance performances.

In addition to the vast selection of art experiences, Canal Convergence offers a Beer and Wine Garden, multiple food vendors, and arts-focused shopping experiences for all 10 evenings.

View the full Things to Do daily schedule and more information about all the event has to offer this year at CanalConvergence.com or scan the QR code.

Nightly Events Schedule:

- **Fire Shows at the Walter Productions 2025 artwork, *Showtime*:**
 - 6:30, 7:30 and 8:30 p.m.
- **Free Drop-in Workshops and Activities at the Nationwide Innovation Zone and Scottsdale Arts Roundabout:**
 - Fridays and Saturdays: 6–10 p.m.

- Sundays and Monday–Thursday: 6–9 p.m.
- **Dress Up the Future – An Interactive Wearable Experience at the Nationwide Innovation Zone**
 - Fridays and Saturdays: 6–10 p.m.
 - Sundays and Monday–Thursday: 6–9 p.m.
- **Ticketed Canal Convergence Artwork Tours:**
 - 5:30–6:30 p.m.

Daily Event Schedule:

Friday, Nov. 7, 2025

6 p.m. Ang Sirena

Live music: indie-pop/alternative R&B.

6:15–7:45 p.m. Create Your Own Light-Based Artwork

\$15

7–9 p.m. GLOW by Vessel

A living lightscape that transforms the desert night into a dreamlike passage, where audiences drift through color, stillness, and wonder.

7:30 p.m. Showtime Fire Show by Walter Productions

Flames intertwine with light and music in a vibrant, choreographed spectacle.

7:30 p.m. Bad Cactus Brass Band

Live music: funk/jazz.

8:30 p.m. Showtime Fire Show by Walter Productions

Flames intertwine with light and music in a vibrant, choreographed spectacle.

9 p.m. Pijama Piyama

Live music: psychedelic cumbia.

Saturday, Nov. 8, 2025

5:30–6:30 p.m. Canal Convergence Art Tour

\$6

Join us for a one-hour, behind-the-scenes look at Canal Convergence. Wear comfortable shoes and bring water!

Time: Surprise! Javi Star Entertainment

We're not going to spoil the surprise; expect a performance by Javi Star Entertainment at some point tonight.

6 p.m. Megan Diana

Live music: disco country.

6–9 p.m. Canal Convergence Opening Celebration

\$25/\$15 for ONE Members

Enjoy savory bites, festive drinks, glowing décor, and lively conversation alongside artists and other special guests at this one-night-only party at the heart of the festival.

6–10 p.m. SHOWTIME in Print: Printmaking with Xico

Try your hand at the printmaking art form as Xico guides you through inking a printing block, preparing paper, and using a printing press.

6–10 p.m. Finger Puppets with The Walter Hive

Make a fun puppet, headband, or sculpture with pom-poms, pipe cleaners, and googly eyes in this playful workshop, perfect for kids, families, or anyone who loves to create!

6–10 p.m. Dress Up the Future – An Interactive Wearable Experience

Immerse yourself in wearable technology, transformative design, and storytelling at The Dress Up Space.

6–10 p.m. It's SHOWTIME!—Ephemeral Futures: Wearable Ecologies

View student-designed garments that integrate wearable technology and explore biodiversity, ecological grief, and transformative futures.

6:30 p.m. Showtime Fire Show by Walter Productions

Flames intertwine with light and music in a vibrant, choreographed spectacle.

6:45–7:15 p.m. Bucket Drumming with MASARY

\$15

Grab a bucket and some sticks to explore the joys of synchronization and syncopation in a fun drumming workshop with Ryan Edwards of Boston's MASARY Studios.

7–9 p.m. GLOW by Vessel

A living lightscape that transforms the desert night into a dreamlike passage, where audiences drift through color, stillness, and wonder.

7:30 p.m. Showtime Fire Show by Walter Productions

Flames intertwine with light and music in a vibrant, choreographed spectacle.

7:30 p.m. Bolero Jonze

Live music: bolero/lounge.

8:30 p.m. Showtime Fire Show by Walter Productions

Flames intertwine with light and music in a vibrant, choreographed spectacle.

9 p.m. MRCH

Live music: indie-electronica.

Sunday, Nov. 9, 2025

5:30–6:30 p.m. Canal Convergence Art Tour

\$6

Join us for a one-hour, behind-the-scenes look at Canal Convergence. Wear comfortable shoes and bring water!

Time: Surprise! Javi Star Entertainment

We're not going to spoil the surprise; expect a performance by Javi Star Entertainment at some point tonight.

6 p.m. Obai

Live music: R&B/pop.

6–9 p.m. Canalogic with urbanSTEW

Make noise. Make art. Make memories at Canalogic, where you build a musical instrument, then use it to add your music to the sound scrambler!

6–9 p.m. Dress Up the Future – An Interactive Wearable Experience

Immerse yourself in wearable technology, transformative design, and storytelling at The Dress Up Space.

6–9 p.m. It's SHOWTIME!—Ephemeral Futures: Wearable Ecologies

View student-designed garments that integrate wearable technology and explore biodiversity, ecological grief, and transformative futures.

6:30 p.m. Showtime Fire Show by Walter Productions

Flames intertwine with light and music in a vibrant, choreographed spectacle.

6:45–7:15 p.m. Bucket Drumming with MASARY

\$15

Grab a bucket and some sticks to explore the joys of synchronization and syncopation in a fun drumming workshop with Ryan Edwards of Boston's MASARY Studios.

7:30 p.m. Showtime Fire Show by Walter Productions

Flames intertwine with light and music in a vibrant, choreographed spectacle.

7:30 p.m. Outside The Line

Live music: soul/Motown.

Monday, Nov. 10, 2025

5:15–6:15 p.m. My Story as Movement

\$10

Reflect and embody your truths and personal stories through journaling, dance, and movement in an intergenerational space where participants of all ages learn from each other.

5:30–6:30 p.m. Canal Convergence Art Tour

\$6

Join us for a one-hour, behind-the-scenes look at Canal Convergence. Wear comfortable shoes and bring water!

6 p.m. Seligo

Live music: electro-pop-rock/world.

6–9 p.m. CREATE a Marquee

Make and decorate your own marquee sign using markers, chalk, and acrylic accessories with CREATE at Arizona Science Center, where science, design, and engineering collide.

6–9 p.m. Dress Up the Future – An Interactive Wearable Experience

Immerse yourself in wearable technology, transformative design, and storytelling at The Dress Up Space.

6–9 p.m. It's SHOWTIME!—Ephemeral Futures: Wearable Ecologies

View student-designed garments that integrate wearable technology and explore biodiversity, ecological grief, and transformative futures.

6:15–7:15 Showstopper Headpieces with The Walter Hive

\$30

Using rhinestones, feathers, metallic trims, and more, you'll design your own wearable artwork, a headpiece that's part crown, part costume, and all creativity.

6:30 p.m. Showtime Fire Show by Walter Productions

Flames intertwine with light and music in a vibrant, choreographed spectacle.

7:30 p.m. Showtime Fire Show by Walter Productions

Flames intertwine with light and music in a vibrant, choreographed spectacle.

Tuesday, Nov. 11, 2025

5:30–6:30 p.m. Canal Convergence Art Tour (Spanish Translation)

\$6

Join us for a one-hour, behind-the-scenes look at Canal Convergence with Spanish translation. Wear comfortable shoes and bring water!

6 p.m. Dylan Thomas

Live music: acoustic rock.

6–8 p.m. Scottsdale Professionals Converge

\$20 in advance/\$30 day of event

Join us for an evening of unforgettable art, ambiance, and networking with light hors d'oeuvres, a cash bar, and access to Billie Jo Herberger's Lounge.

6–9 p.m. Puppets with the Great Arizona Puppet Theater

Jump into your own SHOWTIME with the Great Arizona Puppet Theater as you design and decorate easy stick puppets in this all-ages workshop!

6–9 p.m. Dress Up the Future – An Interactive Wearable Experience

Immerse yourself in wearable technology, transformative design, and storytelling at The Dress Up Space.

6–9 p.m. It's SHOWTIME!—Ephemeral Futures: Wearable Ecologies

View student-designed garments that integrate wearable technology and explore biodiversity, ecological grief, and transformative futures.

6:30 p.m. Showtime Fire Show by Walter Productions

Flames intertwine with light and music in a vibrant, choreographed spectacle.

7:30 p.m. Showtime Fire Show by Walter Productions

Flames intertwine with light and music in a vibrant, choreographed spectacle.

7:30 p.m. Mo Maduro

Live music: folk/blues.

Wednesday, Nov. 12, 2025

5:30–6:30 p.m. Canal Convergence Art Tour (ASL Translation)

\$6

Join us for a one-hour, behind-the-scenes look at Canal Convergence with ASL translation. Wear comfortable shoes and bring water!

6 p.m. Lunar Calendar

Live music: contemporary classical.

6–9 p.m. Beat Making Workshop with AZ Beat Lab

Create your own beats, experiment with sound, and share your music with others in this hands-on workshop open to everyone with a love for sound.

6–9 p.m. Dress Up the Future – An Interactive Wearable Experience

Immerse yourself in wearable technology, transformative design, and storytelling at The Dress Up Space.

6–9 p.m. It's SHOWTIME!—Ephemeral Futures: Wearable Ecologies

View student-designed garments that integrate wearable technology and explore biodiversity, ecological grief, and transformative futures.

6:15–7:15 Calaca Masks with Zarco Guerrero

\$20

Learn folded paper cutting techniques to create a Calaca [kah-lah-kah], a highly decorated and colorful Dia de Los Muertos mask to wear to your next party!

6:30 p.m. Showtime Fire Show by Walter Productions

Flames intertwine with light and music in a vibrant, choreographed spectacle.

7:30 p.m. Showtime Fire Show by Walter Productions

Flames intertwine with light and music in a vibrant, choreographed spectacle.

7:30 p.m. Miana y la Musica

Live music: indie-pop.

7:30–9 p.m. Masks with Zarco Guerrero

Learn how to make a fun and expressive cut-out mask with this easy mask-making process, taught by a professional mask-maker.

Thursday, Nov. 13, 2025

5:30–6:30 p.m. Canal Convergence Art Tour

\$6

Join us for a one-hour, behind-the-scenes look at Canal Convergence. Wear comfortable shoes and bring water!

6 p.m. Space Travelers Union

Live music: cosmic jazz.

6–9 p.m. Beat Making Workshop with AZ Beat Lab

Create your own beats, experiment with sound, and share your music with others in this hands-on workshop open to everyone with a love for sound.

6–9 p.m. Masks with Zarco Guerrero

Learn how to make a fun and expressive cut-out mask with this easy mask-making process, taught by a professional mask-maker.

6–9 p.m. Dress Up the Future – An Interactive Wearable Experience

Immerse yourself in wearable technology, transformative design, and storytelling at The Dress Up Space.

6–9 p.m. It's SHOWTIME!—Ephemeral Futures: Wearable Ecologies

View student-designed garments that integrate wearable technology and explore biodiversity, ecological grief, and transformative futures.

6:30 p.m. Showtime Fire Show by Walter Productions

Flames intertwine with light and music in a vibrant, choreographed spectacle.

7:30 p.m. Showtime Fire Show by Walter Productions

Flames intertwine with light and music in a vibrant, choreographed spectacle.

8 p.m. Valgur

Live music: vampire pop.

Friday, Nov. 14, 2025

5:30–6:30 p.m. Canal Convergence Art Tour

\$6

Join us for a one-hour, behind-the-scenes look at Canal Convergence. Wear comfortable shoes and bring water!

6 p.m. Betsy Ganz

Live music: Americana.

6–10 p.m. Finger Puppets with The Walter Hive

Make a fun puppet, headband, or sculpture with pom-poms, pipe cleaners, and googly eyes in this playful workshop, perfect for kids, families, or anyone who loves to create!

6–10 p.m. CREATE a Marquee

Make and decorate your own marquee sign using markers, chalk, and acrylic accessories with CREATE at Arizona Science Center, where science, design, and engineering collide.

6–10 p.m. Dress Up the Future – An Interactive Wearable Experience

Immerse yourself in wearable technology, transformative design, and storytelling at The Dress Up Space.

6–10 p.m. It's SHOWTIME!—Ephemeral Futures: Wearable Ecologies

View student-designed garments that integrate wearable technology and explore biodiversity, ecological grief, and transformative futures.

6:30 p.m. Showtime Fire Show by Walter Productions

Flames intertwine with light and music in a vibrant, choreographed spectacle.

7 p.m. Atmospheric Collision by Scottsdale Community College Dance

A mesmerizing site-specific dance performance from Scottsdale Community College Dance at the *Parallel Flow* artwork by Dina Fisher and David Howe.

7:30 p.m. Showtime Fire Show by Walter Productions

Flames intertwine with light and music in a vibrant, choreographed spectacle.

7:30 p.m. Cameron Jeong

Live music: jazz/R&B.

8 p.m. Chroma by Scottsdale Community College Dance

An enchanting site-specific dance performance from Scottsdale Community College Dance at the *Stargate* artwork by Chalk River Labs.

8:30 p.m. Showtime Fire Show by Walter Productions

Flames intertwine with light and music in a vibrant, choreographed spectacle.

9 p.m. Ali A and the Agency

Live music: rock.

Saturday, Nov. 15, 2025

5:30–6:30 p.m. Canal Convergence Art Tour

\$6

Join us for a one-hour, behind-the-scenes look at Canal Convergence. Wear comfortable shoes and bring water!

6 p.m. Rhythm is Life

Live music: steel pan.

6–10 p.m. Finger Puppets with The Walter Hive

Make a fun puppet, headband, or sculpture with pom-poms, pipe cleaners, and googly eyes in this playful workshop, perfect for kids, families, or anyone who loves to create!

6–10 p.m. CREATE a Marquee

Make and decorate your own marquee sign using markers, chalk, and acrylic accessories with CREATE at Arizona Science Center, where science, design, and engineering collide.

6–10 p.m. Canalogic with urbanSTEW

Make noise. Make art. Make memories at Canalogic, where you build a musical instrument, then use it to add your music to the sound scrambler!

6–10 p.m. Dress Up the Future – An Interactive Wearable Experience

Immerse yourself in wearable technology, transformative design, and storytelling at The Dress Up Space.

6–10 p.m. It's SHOWTIME!—Ephemeral Futures: Wearable Ecologies

View student-designed garments that integrate wearable technology and explore biodiversity, ecological grief, and transformative futures.

6:30 p.m. Showtime Fire Show by Walter Productions

Flames intertwine with light and music in a vibrant, choreographed spectacle.

7:30 p.m. Showtime Fire Show by Walter Productions

Flames intertwine with light and music in a vibrant, choreographed spectacle.

7:30 p.m. Lunes

Live music: Chicano soul/rock.

8 p.m. Oceana by NicoleOlson|MovementChaos

a captivating site-specific dance performance from NicoleOlson|MovementChaos within the *Octopoda* artwork by Amigo and Amigo.

8:30 p.m. Showtime Fire Show by Walter Productions

Flames intertwine with light and music in a vibrant, choreographed spectacle.

9 p.m. Sugar Thieves

Live music: blues.

Sunday, Nov. 16, 2025

5:30–6:30 p.m. Canal Convergence Art Tour

\$6

Join us for a one-hour, behind-the-scenes look at Canal Convergence. Wear comfortable shoes and bring water!

6 p.m. Alassane

Live music: rock/jazz.

6–9 p.m. Puppets with the Great Arizona Puppet Theater

Jump into your own SHOWTIME with the Great Arizona Puppet Theater as you design and decorate easy stick puppets in this all-ages workshop!

6–9 p.m. Dress Up the Future – An Interactive Wearable Experience

Immerse yourself in wearable technology, transformative design, and storytelling at The Dress Up Space.

6–9 p.m. It's SHOWTIME!—Ephemeral Futures: Wearable Ecologies

View student-designed garments that integrate wearable technology and explore biodiversity, ecological grief, and transformative futures.

6:15–7:15 p.m. The Marvelous Medium of Masking Tape: Props, masks, puppets, decor, and more! with Matt McGee of the Great Arizona Puppet Theater

\$25

Turn your ideas into 3D artworks with masking tape and some imagination, using tricks and techniques from award-winning master puppet builder Matt McGee.

6:30 p.m. Showtime Fire Show by Walter Productions

Flames intertwine with light and music in a vibrant, choreographed spectacle.

7 p.m. It's SHOWTIME!—Ephemeral Futures: Wearable Ecologies Fashion Show

Catch a fashion show at Canal Convergence featuring garments that integrate wearable technology to explore biodiversity, ecological grief, and transformative futures.

7:30 p.m. Showtime Fire Show by Walter Productions

Flames intertwine with light and music in a vibrant, choreographed spectacle.

7:30 p.m. Jaleo

Live music: Latin.

6 – 10pm

- **Event Open****
 - Artists Workshops (tickets and drop-in) – Nationwide Innovation Zone and Misc. Locations Around the Scottsdale Waterfront.
 - **Live Music – Soleri Plaza**
 - **Food Trucks and Vendor – Soleri Plaza and Scottsdale Arts Roundabout**
 - Community Partner Activities – Scottsdale Arts Roundabout
 - Sponsors and Partner Booths – **Soleri Plaza and Scottsdale Arts Roundabout**

Special Event Notice



Neighborhood Input

EVENT NOTIFICATION & NEIGHBORHOOD INPUT

Event Name: Canal Convergence Event Location: Scottsdale Waterfront
 Event Dates: Nov. 7 -16, 2025 Event Hours: Fri./Sat.: 6 p.m. - 10 pm, Sun-Thurs: 6 p.m. - 9 p.m.
 Street Closures: Nov. 6 (12:01 a.m.) - Nov. 17 (6:00 a.m.)
 Day/Time Closed: _____ Day/Time Reopened: _____

We are thrilled to be guests in your neighborhood and it's important to us that we are communicating clearly with you, the neighbors, to determine if there are any comments or concerns related to the event and/or proposed street closure. I have provided a copy of the site plan and details of the street closure explaining the proposed Special Event. If you have any comments or concerns related to the event, please note in the applicable column. If you prefer to contact the City's Events Administrator directly, contact Cheryl Sumners at 480-312-7834 or csumners@scottsdaleaz.gov.

Please read before filling out: I hereby declare that I am an authorized representative of the listed business and have been informed by the event applicant/designee of the event details, including proposed street closures. By marking "No" for concerns, I am relaying that I have no significant concerns about the event. By marking "Yes" for concerns, I am relaying that I have concerns with the event and/or street closure and will state the reason(s) why in the comment box.

DATE	PRINTED NAME	TITLE (Owner, Manager, etc.)	EMAIL	BUSINESS NAME & ADDRESS	DID YOU RECEIVE A COPY OF THE SITE PLAN?	CONCERNS?
10/5/2025	Peggy Fiandaca	Owner	peggy@ldvwinery.com	LDV Winery, 7134 E. Stetson Dr., B-110	<input checked="" type="checkbox"/> Yes <input type="checkbox"/> No	<input type="checkbox"/> Yes <input checked="" type="checkbox"/> No
COMMENTS/CONCERNS: It looks great.						
					<input type="checkbox"/> Yes <input type="checkbox"/> No	<input type="checkbox"/> Yes <input type="checkbox"/> No
COMMENTS/CONCERNS:						
					<input type="checkbox"/> Yes <input type="checkbox"/> No	<input type="checkbox"/> Yes <input type="checkbox"/> No
COMMENTS/CONCERNS:						
					<input type="checkbox"/> Yes <input type="checkbox"/> No	<input type="checkbox"/> Yes <input type="checkbox"/> No
COMMENTS/CONCERNS:						

Special Event Notice

Neighborhood Input



EVENT NOTIFICATION & NEIGHBORHOOD INPUT

Event Name: Canal Convergence Event Location: Scottsdale Waterfront
 Event Dates: Nov. 7 -16, 2025 Event Hours: Fri./Sat.: 6 p.m. - 10 pm, Sun-Thurs: 6 p.m. - 9 p.m.
 Street Closures: Nov. 6 (12:01 a.m.) - Nov. 17 (6:00 a.m.)
 Day/Time Closed: _____ Day/Time Reopened: _____

We are thrilled to be guests in your neighborhood and it's important to us that we are communicating clearly with you, the neighbors, to determine if there are any comments or concerns related to the event and/or proposed street closure. I have provided a copy of the site plan and details of the street closure explaining the proposed Special Event. If you have any comments or concerns related to the event, please note in the applicable column. If you prefer to contact the City's Events Administrator directly, contact Cheryl Sumners at 480-312-7834 or csumners@scottsdaleaz.gov.

Please read before filling out: I hereby declare that I am an authorized representative of the listed business and have been informed by the event applicant/designee of the event details, including proposed street closures. By marking "No" for concerns, I am relaying that I have no significant concerns about the event. By marking "Yes" for concerns, I am relaying that I have concerns with the event and/or street closure and will state the reason(s) why in the comment box.

DATE	PRINTED NAME	TITLE (Owner, Manager, etc.)	EMAIL	BUSINESS NAME & ADDRESS	DID YOU RECEIVE A COPY OF THE SITE PLAN?	CONCERNS?
11/25	Kim Keyser	partner	kim@prepandpastry.com	Prep & Pastry 7025 E Via Soler Rd	<input checked="" type="checkbox"/> Yes <input type="checkbox"/> No	<input type="checkbox"/> Yes <input checked="" type="checkbox"/> No
COMMENTS/CONCERNS: Approval for closure to begin Tue 11/4 per email 10/25/25.						
11/25	Jennifer Williams	manager	jennifer.williams@evrealstate.com	Engel + Volkers	<input checked="" type="checkbox"/> Yes <input type="checkbox"/> No	<input type="checkbox"/> Yes <input checked="" type="checkbox"/> No
COMMENTS/CONCERNS: Approval to begin closure on Tue. 11/4 per Jim Bruske phone call on 11/3.						
					<input type="checkbox"/> Yes <input type="checkbox"/> No	<input type="checkbox"/> Yes <input type="checkbox"/> No
COMMENTS/CONCERNS:						
					<input type="checkbox"/> Yes <input type="checkbox"/> No	<input type="checkbox"/> Yes <input type="checkbox"/> No
COMMENTS/CONCERNS:						

Special Event Notice

Neighborhood Input



EVENT NOTIFICATION & NEIGHBORHOOD INPUT

Event Name: Canal Convergence Event Location: Scottsdale Waterfront
 Event Dates: Nov. 7 -16, 2025 Event Hours: Fri./Sat.: 6 p.m. - 10 pm, Sun-Thurs: 6 p.m. - 9 p.m.
 Street Closures: Nov. 6 (12:01 a.m.) - Nov. 17 (6:00 a.m.)
 Day/Time Closed: _____ Day/Time Reopened: _____

We are thrilled to be guests in your neighborhood and it's important to us that we are communicating clearly with you, the neighbors, to determine if there are any comments or concerns related to the event and/or proposed street closure. I have provided a copy of the site plan and details of the street closure explaining the proposed Special Event. If you have any comments or concerns related to the event, please note in the applicable column. If you prefer to contact the City's Events Administrator directly, contact Cheryl Sumners at 480-312-7834 or csumners@scottsdaleaz.gov.

Please read before filling out: I hereby declare that I am an authorized representative of the listed business and have been informed by the event applicant/designee of the event details, including proposed street closures. By marking "No" for concerns, I am relaying that I have no significant concerns about the event. By marking "Yes" for concerns, I am relaying that I have concerns with the event and/or street closure and will state the reason(s) why in the comment box.

DATE	PRINTED NAME	TITLE (Owner, Manager, etc.)	EMAIL	BUSINESS NAME & ADDRESS	DID YOU RECEIVE A COPY OF THE SITE PLAN?	HEIGHT OF STRUCTURE CONCERNS?
9/16	Pamela Dobson	Gm SWFRCA	Pamela.dobson@ swfrca.org	Scottsdale Waterfront Residence	<input type="checkbox"/> Yes <input type="checkbox"/> No	Height of structure <input type="checkbox"/> Yes <input type="checkbox"/> No
COMMENTS/CONCERNS:						
9/16	Alison Sanchez	manager SWFMA	alison asanchez@mspa.net	Scottsdale waterfront master	<input checked="" type="checkbox"/> Yes <input type="checkbox"/> No	<input checked="" type="checkbox"/> Yes <input type="checkbox"/> No insurance use fee
COMMENTS/CONCERNS: Approval for closure to begin Tue 11/4 per email 10/30/25.						
					<input type="checkbox"/> Yes <input type="checkbox"/> No	<input type="checkbox"/> Yes <input type="checkbox"/> No
COMMENTS/CONCERNS:						
					<input type="checkbox"/> Yes <input type="checkbox"/> No	<input type="checkbox"/> Yes <input type="checkbox"/> No
COMMENTS/CONCERNS:						

Special Event Notice

Neighborhood Input



EVENT NOTIFICATION & NEIGHBORHOOD INPUT

Event Name: Canal Convergence Event Location: Scottsdale Waterfront
 Event Dates: Nov. 7 -16, 2025 Event Hours: Fri./Sat.: 6 p.m. - 10 pm, Sun-Thurs: 6 p.m. - 9 p.m.
 Street Closures: Nov. 6 (12:01 a.m.) - Nov. 17 (6:00 a.m.)
 Day/Time Closed: _____ Day/Time Reopened: _____

We are thrilled to be guests in your neighborhood and it's important to us that we are communicating clearly with you, the neighbors, to determine if there are any comments or concerns related to the event and/or proposed street closure. I have provided a copy of the site plan and details of the street closure explaining the proposed Special Event. If you have any comments or concerns related to the event, please note in the applicable column. If you prefer to contact the City's Events Administrator directly, contact Cheryl Sumners at 480-312-7834 or csumners@scottsdaleaz.gov.

Please read before filling out: I hereby declare that I am an authorized representative of the listed business and have been informed by the event applicant/designee of the event details, including proposed street closures. By marking "No" for concerns, I am relaying that I have no significant concerns about the event. By marking "Yes" for concerns, I am relaying that I have concerns with the event and/or street closure and will state the reason(s) why in the comment box.

DATE	PRINTED NAME	TITLE (Owner, Manager, etc.)	EMAIL	BUSINESS NAME & ADDRESS	DID YOU RECEIVE A COPY OF THE SITE PLAN?	CONCERNS?
9/23/25	Ashley Guthrie	AGM	amguthrie@foxrc.com	7135 E. CAMELBACK RD STE 195 (OLIVE & IVY)	<input checked="" type="checkbox"/> Yes <input type="checkbox"/> No	<input type="checkbox"/> Yes <input checked="" type="checkbox"/> No
COMMENTS/CONCERNS: Approval for closure to begin Tue 11/4 per Jakob Michaelis email 10/20/25.						
9/23/25	VICTOR CASTRO	GM	victor.castro@marvic-taylor.com	7025 E Via Soceri	<input checked="" type="checkbox"/> Yes <input type="checkbox"/> No	<input type="checkbox"/> Yes <input checked="" type="checkbox"/> No
COMMENTS/CONCERNS: Approval for closure to begin Tue 11/4 per Julie Mizcles email 10/30/25.						
					<input type="checkbox"/> Yes <input type="checkbox"/> No	<input type="checkbox"/> Yes <input type="checkbox"/> No
COMMENTS/CONCERNS:						
					<input type="checkbox"/> Yes <input type="checkbox"/> No	<input type="checkbox"/> Yes <input type="checkbox"/> No
COMMENTS/CONCERNS:						

Special Event Notice

Neighborhood Input



EVENT NOTIFICATION & NEIGHBORHOOD INPUT

Event Name: Canal Convergence Event Location: Scottsdale Waterfront
 Event Dates: Nov. 7 -16, 2025 Event Hours: Fri./Sat.: 6 p.m. - 10 pm, Sun-Thurs: 6 p.m. - 9 p.m.
 Street Closures: Nov. 6 (12:01 a.m.) - Nov. 17 (6:00 a.m.)
 Day/Time Closed: _____ Day/Time Reopened: _____

We are thrilled to be guests in your neighborhood and it's important to us that we are communicating clearly with you, the neighbors, to determine if there are any comments or concerns related to the event and/or proposed street closure. I have provided a copy of the site plan and details of the street closure explaining the proposed Special Event. If you have any comments or concerns related to the event, please note in the applicable column. If you prefer to contact the City's Events Administrator directly, contact Cheryl Sumners at 480-312-7834 or csumners@scottsdaleaz.gov.

Please read before filling out: I hereby declare that I am an authorized representative of the listed business and have been informed by the event applicant/designee of the event details, including proposed street closures. By marking "No" for concerns, I am relaying that I have no significant concerns about the event. By marking "Yes" for concerns, I am relaying that I have concerns with the event and/or street closure and will state the reason(s) why in the comment box.

DATE	PRINTED NAME	TITLE (Owner, Manager, etc.)	EMAIL	BUSINESS NAME & ADDRESS	DID YOU RECEIVE A COPY OF THE SITE PLAN?	CONCERNS?
10/8/25	Erik Yee		chefemail@kyoto-scottsdale.com	480 973 2645 text only	<input checked="" type="checkbox"/> Yes <input type="checkbox"/> No	<input type="checkbox"/> Yes <input checked="" type="checkbox"/> No
COMMENTS/CONCERNS:						
					<input type="checkbox"/> Yes <input type="checkbox"/> No	<input type="checkbox"/> Yes <input type="checkbox"/> No
COMMENTS/CONCERNS:						
					<input type="checkbox"/> Yes <input type="checkbox"/> No	<input type="checkbox"/> Yes <input type="checkbox"/> No
COMMENTS/CONCERNS:						
					<input type="checkbox"/> Yes <input type="checkbox"/> No	<input type="checkbox"/> Yes <input type="checkbox"/> No
COMMENTS/CONCERNS:						

5/8/2025

Insomniac
9441 W. Olympic Blvd.
Beverly Hills, CA 90212
ATTN: Jasmyne Balderama

Entertainment Engineering Consultants, LLC
6104 S. Helena St.
Spokane, WA 9923

Polychroma Stability

EEC Project #: 25.133.35A

Dear Jasmyne,


We have completed our review of the attached structure according to the provisions of the 2018/2021 International Building Code, 2022 California Building Code, and 2023 Florida Building Code.

A stability- only review was performed on a structure comprised of steel tubing for use supporting scenic paneling. The structure will be installed at various locations throughout the United States for dates to be determined. The stability only review we performed does not review member framing or connections but rather determines the safe wind load ratings with the assumption that the structure overturns or slides as a single rigid body.





A High Wind Action Plan has been provided with the original report and shall be strictly adhered to for the duration of the event. The structure has a minimum 1.5 factor of safety vs overturning or sliding in a maximum wind speed of 40mph 3-second gusts

I trust this information is suitable for your needs at this time. Please direct any questions to myself or my office as necessary.

Sincerely,

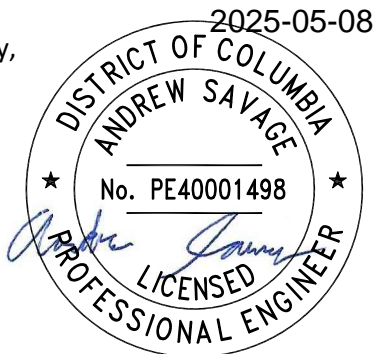

Andrew L. Savage, P.E.
DC Registration No.: PE40001498

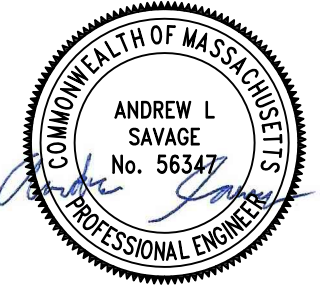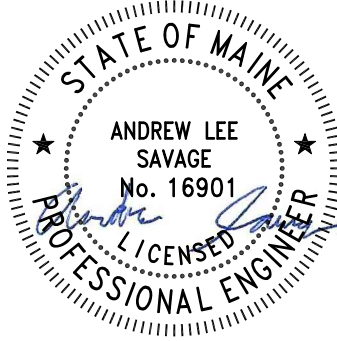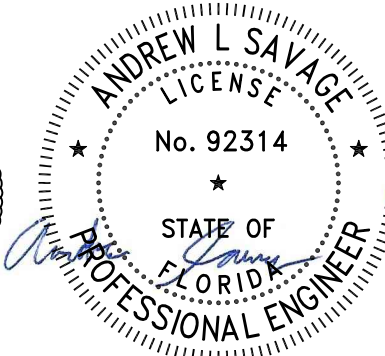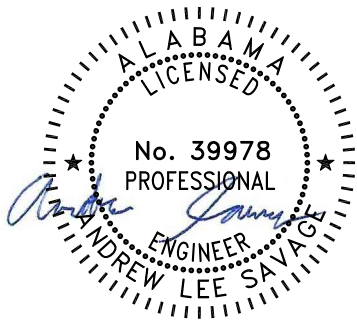

Entertainment
Engineering
Consultants, LLC

Entertainment Engineering Consultants, LLC
6104 S Helena St.
Spokane, WA 99223

COPYRIGHT © 2020
THIS DRAWING IS THE EXCLUSIVE PROPERTY OF ENTERTAINMENT ENGINEERING CONSULTANTS, LLC. NEITHER
THE DRAWING OR INFORMATION CONTAINED MAY BE USED OR DISCLOSED TO THIRD PARTIES WITHOUT PRIOR
WRITTEN PERMISSION FROM ENTERTAINMENT ENGINEERING CONSULTANTS, LLC.

Project Name

Polychroma Stability Review

Event/Venue Name and Address

Varies

Project No.

25.133.35A

Sheet

Date

05/08/2025








I hereby certify that this plan, specification, or report was prepared by me or under my direct supervision and that I am a duly Licensed Professional Engineer under the laws of the state of Minnesota.

Signature: *Andrew Lee Savage*

Name: Andrew L. Savage

Date: 05/08/205 License Number: 59052

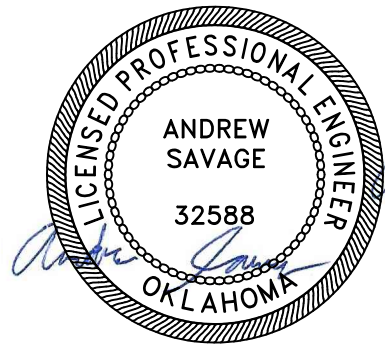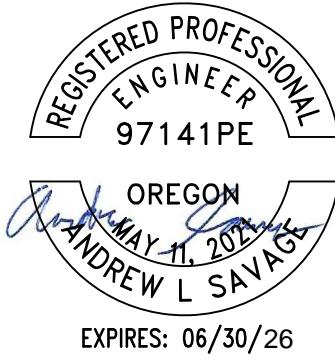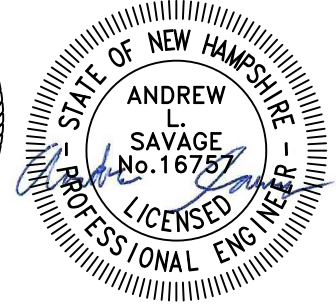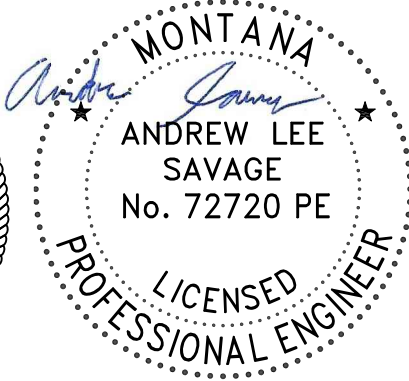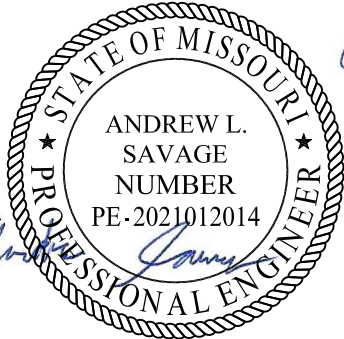

EXPIRES: 06/30/26

 Entertainment Engineering Consultants, LLC

Entertainment Engineering Consultants, LLC
6104 S Helena St.
Spokane, WA 99223







COPYRIGHT © 2020
THIS DRAWING IS THE EXCLUSIVE PROPERTY OF ENTERTAINMENT ENGINEERING CONSULTANTS, LLC. NEITHER THE DRAWING OR INFORMATION CONTAINED MAY BE USED OR DISCLOSED TO THIRD PARTIES WITHOUT PRIOR WRITTEN PERMISSION FROM ENTERTAINMENT ENGINEERING CONSULTANTS, LLC.

Project Name		Polychroma Stability Review	
Event/Venue Name and Address			
Varies			
Project No.	25.133.35A		Sheet
Date	05/08/2025		

ANDREW L SAVAGE



REGISTERED PROFESSIONAL ENGINEER CIVIL

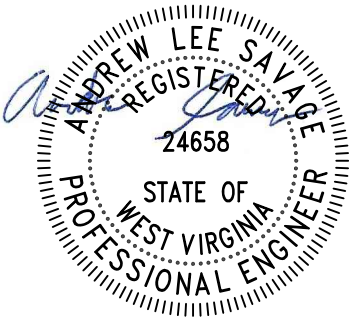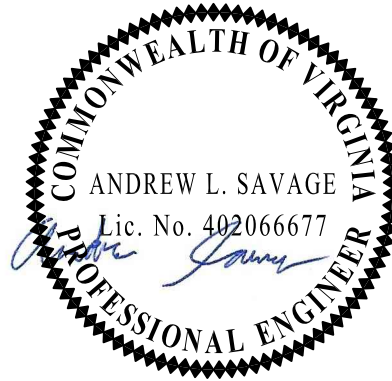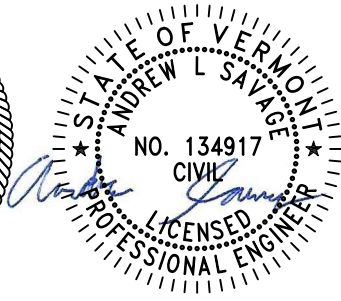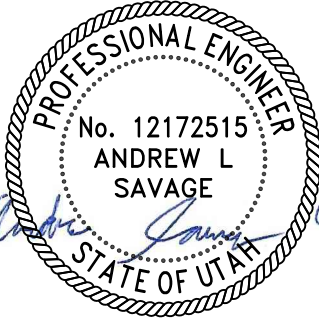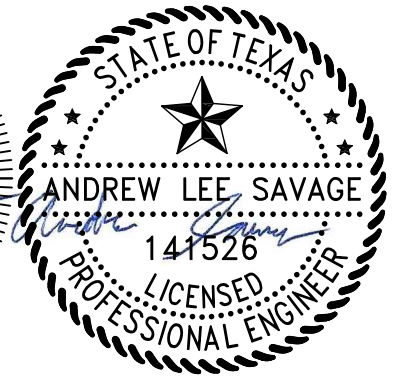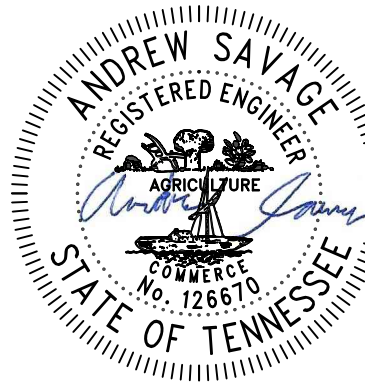

Entertainment Engineering Consultants, LLC

Entertainment Engineering Consultants, LLC
6104 S Helena St.
Spokane, WA 99223

COPYRIGHT © 2020
THIS DRAWING IS THE EXCLUSIVE PROPERTY OF ENTERTAINMENT ENGINEERING CONSULTANTS, LLC. NEITHER THE DRAWING OR INFORMATION CONTAINED MAY BE USED OR DISCLOSED TO THIRD PARTIES WITHOUT PRIOR WRITTEN PERMISSION FROM ENTERTAINMENT ENGINEERING CONSULTANTS, LLC.

Project Name

Polychroma Stability Review

Event/Venue Name and Address

Varies

Project No.

25.133.35A

Sheet

Date

05/08/2025

GENERAL NOTES

EVENT LOCATION: VARIOUS

EVENT DATES: VARIOUS

REFERENCED CODES AND STANDARDS

1. 2018/2021 INTERNATIONAL BUILDING CODE
2. 2022 CALIFORNIA BUILDING CODE
3. 2023 FLORIDA BUILDING CODE
4. ASCE 7-16 'MINIMUM DESIGN LOADS AND ASSOCIATED CRITERIA FOR BUILDINGS AND OTHER STRUCTURES'
5. ASCE 37-14 'DESIGN LOADS ON STRUCTURES DURING CONSTRUCTION'
6. ANSI E1.21-2020 'ENTERTAINMENT TECHNOLOGY - TEMPORARY STRUCTURES USED FOR TECHNICAL PRODUCTION OF OUTDOOR ENTERTAINMENT EVENTS'
7. ANSI E1.2-2021 'ENTERTAINMENT TECHNOLOGY – DESIGN, MANUFACTURER AND USE OF ALUMINUM TRUSSES AND TOWERS'
8. ALUMINUM DESIGN MANUAL, 2015 EDITION
9. AISC STEEL MANUAL, 15TH EDITION

DESIGN LOADS

1. DEAD LOAD: SELF WEIGHT OF STRUCTURE
2. WIND LOAD:
 - a. RISK CATEGORY: II
 - b. HIGH WIND ACTION PLAN: 40MPH - EVACUATE
 - c. EXPOSURE: C
 - d. INSTALLATION DURATION: LESS THAN 6 WEEKS
3. SEISMIC LOAD: NOT REVIEWED DUE TO THE TEMPORARY NATURE OF THE STRUCTURE

ALUMINUM

1. FABRICATION AND ERECTION OF STRUCTURAL ALUMINUM SHALL CONFORM TO THE ALUMINUM DESIGN MANUAL – 2015
2. STRUCTURAL ALUMINUM SHALL BE ALLOY 6005A-T6 (U.N.O.)
3. ALL WELD FILLER SHALL BE 4043 (U.N.O.)
4. ALL WELDING MUST CONFORM TO AWS D1.2

STEEL

1. FABRICATION AND ERECTION OF STRUCTURAL STEEL SHALL CONFORM TO THE AMERICAN INSTITUTE OF STEEL CONSTRUCTION 15TH EDITION.
2. ALL WELDING MUST CONFORM TO AWS D1.1
3. ALL W-SHAPE MEMBERS MUST CONFORM TO ASTM A992
4. 1-3/4" DIAMETER FX LADDER TRUSS CHORD PINS ARE MACHINED FROM 1144 STRESSPROOF STEEL
5. 4"X4" STEEL CLEVIS MACHINED FROM 1045 COLD DRAWN STEEL
6. BOLTS AND FASTENERS ARE MIN. A490 (GR. 8)

SCAFFOLD, TRUSS AND RIGGING EQUIPMENT

1. ALL SCAFFOLDING SHALL BE INSTALLED PER THE MANUFACTURERS SPECIFICATIONS.
2. ALL SCAFFOLD LEG SPLICES REQUIRE BOLTS AT THE TOP AND BOTTOM OF THE SPLICE.
3. GRAVITY CLIPS MUST BE INSTALLED AT ALL SCAFFOLD STANDARD CONNECTIONS.
4. LOAD CAPACITIES USED IN DESIGN WERE PROVIDED BY THE SCAFFOLD MANUFACTURER (STEP-UP SCAFFOLD)
5. ALL SCAFFOLD, ALUMINUM TRUSS AND RIGGING EQUIPMENT MUST BE INSPECTED FOR DAMAGE PRIOR TO INSTALLATION. ANY DAMAGED OR MODIFIED EQUIPMENT SHALL NOT BE USED.

FOUNDATIONS

1. THE STRUCTURE IS ASSUMED TO BE INSTALLED ON LEVEL GROUND.

OPERATIONS MANAGEMENT PLAN

ONE OR MORE COPIES OF THIS OPERATIONS MANAGEMENT PLAN MUST BE POSTED CONSPICUOUSLY ON SITE. THE OPERATIONS MANAGEMENT PLAN MUST BE AVAILABLE TO ALL CREW, STAFF AND AUTHORIZED PUBLIC INSTITUTIONS (POLICE DEPT., FIRE DEPT., BUILDING DEPT., ETC.)

EVENT COMMENCEMENT

1. AN EVENT IS DEFINED TO COMMENCE AT THE INITIAL PREPERATION, INSTALLATION OR ASSEMBLY OF EQUIPMENT AND CONCLUDE AFTER COMPLETE DISASSEMBLY AND REMOVAL OF EQUIPMENT AND PERSONNEL.
2. PRIOR TO THE COMMENCEMENT OF ANY USE OF THE STRUCTURE, THE INDIVIDUAL(S) HAVING AUTHORITY MUST DESIGNATE A RESPONSIBLE PERSON WHO IS IN CHARGE OF IMPLEMENTING ALL ITEMS IN THIS OPERATIONS MANAGEMENT PLAN.
3. PRIOR TO THE COMMENCEMENT OF ANY EVENT A MEETING MUST BE HELD BETWEEN THE RESPONSIBLE PERSON AND THE VENUE, STAGE MANAGER, OWNER OR STAGING COMPANY TO DISCUSS THE IMPLEMENTATION OF ALL ACTIONABLE ITEMS. CRITERIA LEADING TO EVENT CANCELLATION MUST BE CLEARLY DEFINED SUCH THAT IMMEDIATE ACTION MAY BE PERFORMED DUE TO ENVIRONMENTAL CONDITIONS SUCH AS WIND, SNOW, OR RAIN.


HIGH WIND ACTION PLAN

1. THE HIGH WIND ACTION PLAN SHALL BE IN PLACE FOR THE ENTIRE EVENT DURATION.
2. AN ANEMOMETER MUST BE SECURED TO THE HIGHEST ELEVATION STRUCTURE IN THE IMMEDIATE AREA FOR THE PURPOSE OF MONITORING ON-SITE WIND SPEEDS.
3. WEATHER MUST BE CONTINUOUSLY MONITORED VIA NOTICES AND REPORTS ISSUED BY THE NATIONAL WEATHER SERVICE OR LOCAL WEATHER AUTHORITIES AS WELL AS ON-SITE ANEMOMETER READINGS.
4. WIND SPEEDS LISTED BELOW ARE DEFINED AS A 3-SECOND GUST.
5. WHEN WIND SPEEDS ARE EXPECTED TO EXCEED 40MPH: IMMEDIATE AREA SHALL BE EVACUATED OF ALL PERSONS. A SAFE DISTANCE MUST BE MAINTAINED AWAY FROM THE STRUCTURE UNTIL SUCH TIME THAT WINDS HAVE SUBSIDED.
6. FAILURE TO FOLLOW THE HIGH WIND ACTION PLAN MAY RESULT IN INJURY OR DEATH OF PERSONS AND DAMAGE TO EQUIPMENT OR PROPERTY.

SEISMIC ACTION PLANS


1. IN THE EVENT OF AN EARTHQUAKE OF ANY MAGNITUDE THE EVENT SHALL BE POSTPONED UNTIL SUCH TIME THAT ALL STRUCTURES AND EQUIPMENT MAY BE VISUALLY INSPECTED BY A COMPETENT PERSON ON SITE.
2. IF A SEISMIC EVENT OF ANY MAGNITUDE OCCURS WHILE STRUCTURE IS NOT IN USE, THE STRUCTURE SHALL BE VISUALLY INSPECTED BY A COMPETENT PERSON ON SITE PRIOR TO USAGE.

12 11 10 9 8 7 6 5 4 3 2 1

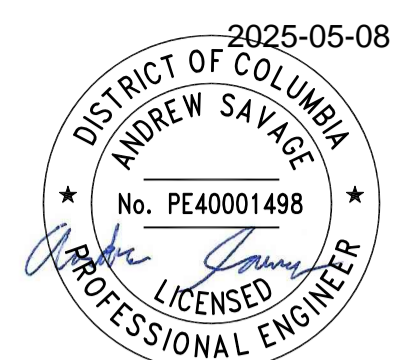


Entertainment Engineering Consultants, LLC

THIS STAMP APPLIES TO THE STABILITY ONLY REVIEW OF THE STRUCTURE DETAILED ON THIS PAGE

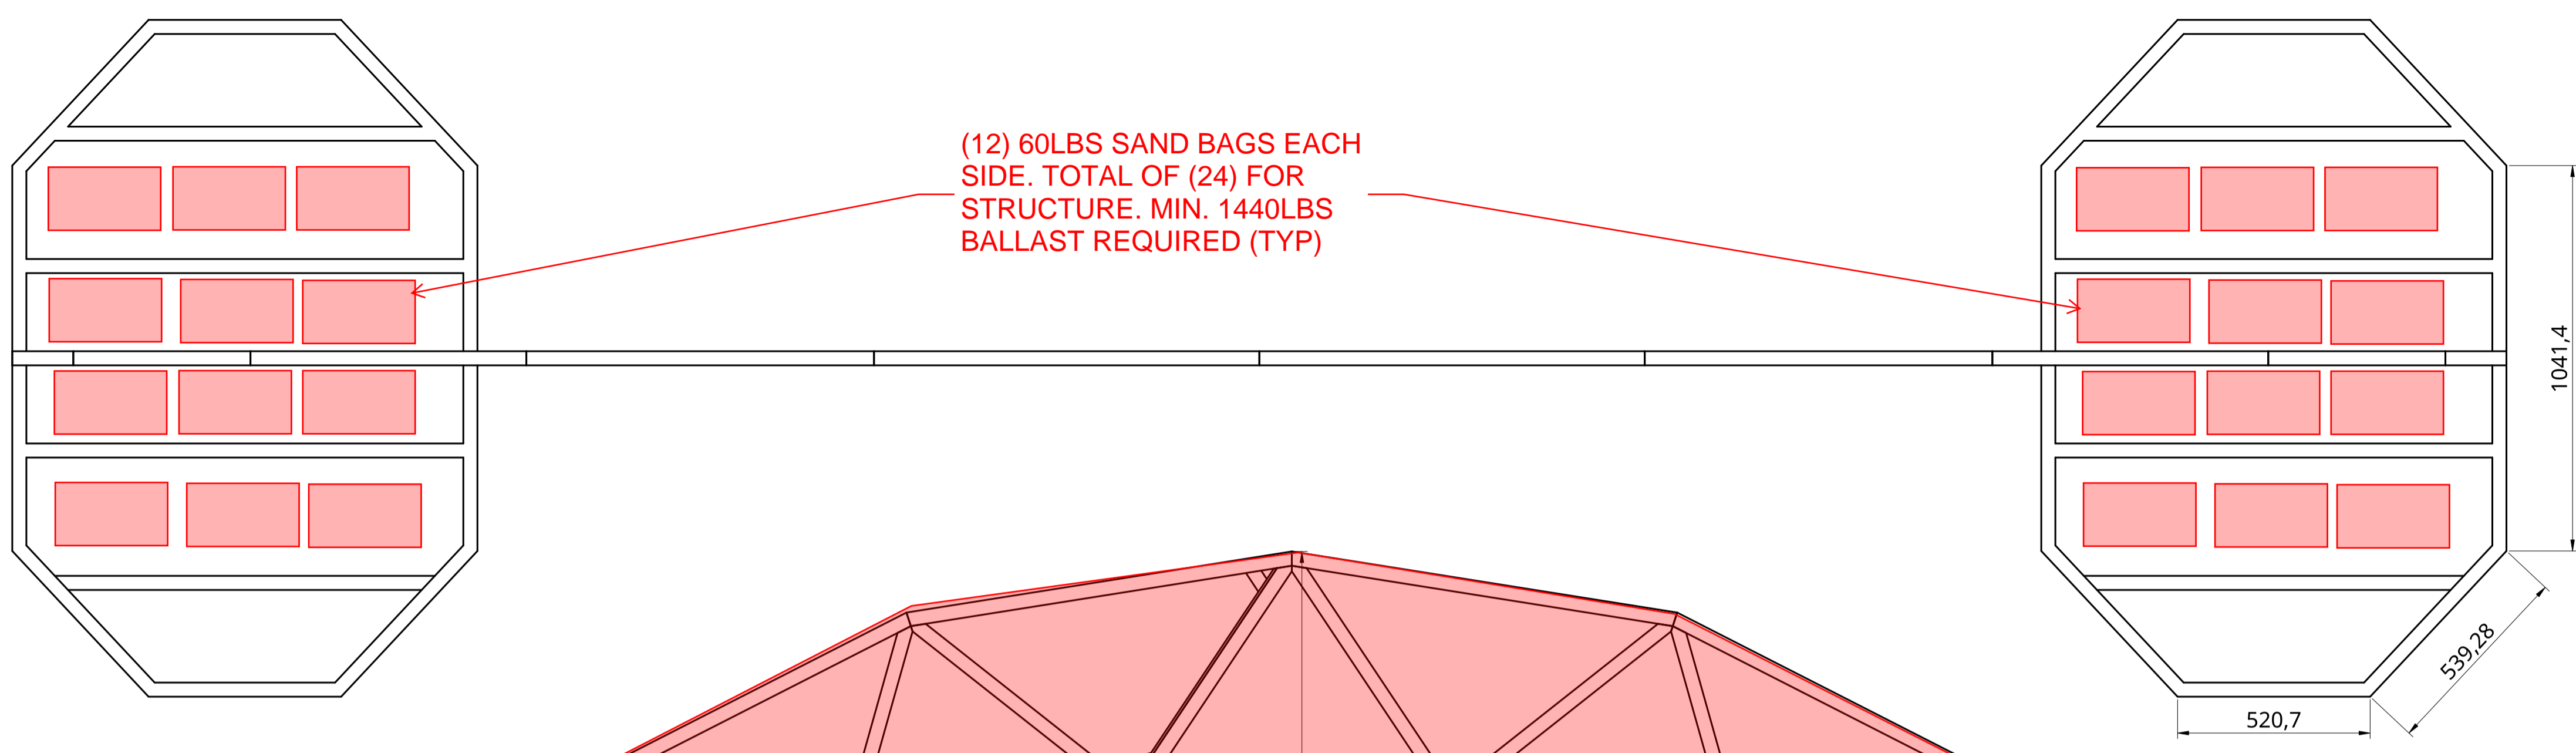

(12) 60LBS SAND BAGS EACH SIDE. TOTAL OF (24) FOR STRUCTURE. MIN. 1440LBS BALLAST REQUIRED (TYP)


520,7
539,28

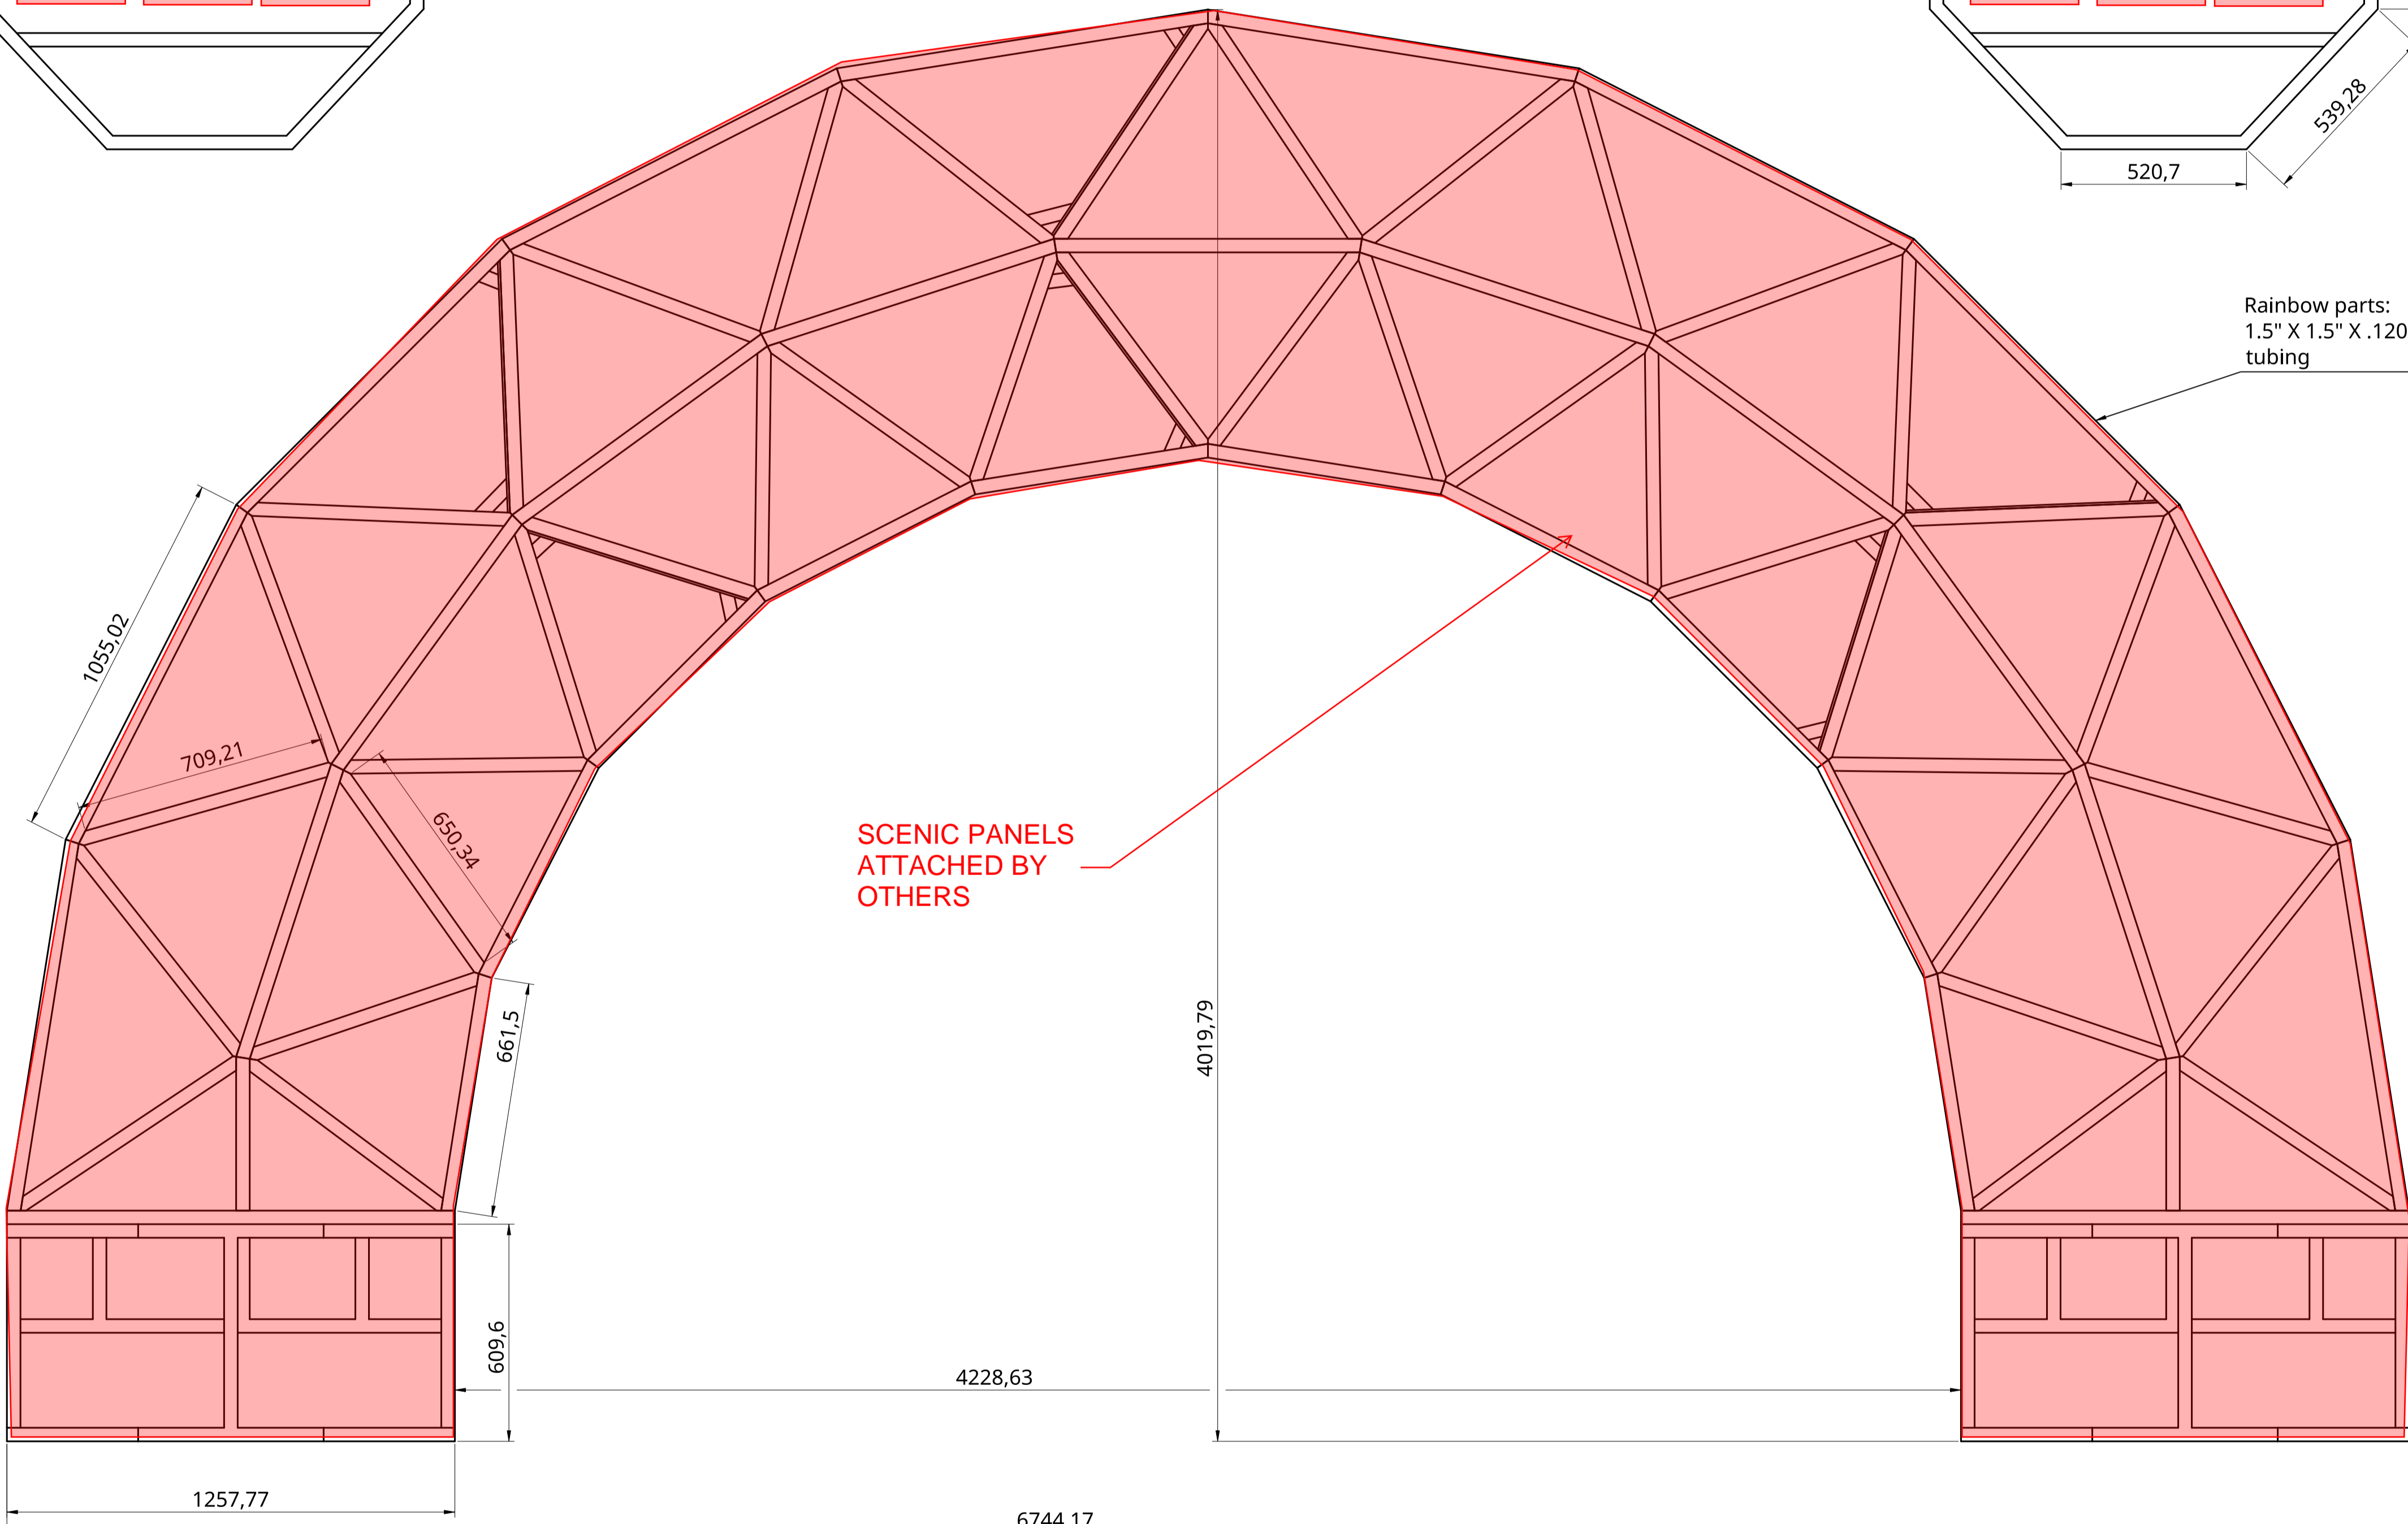

SCENIC PANELS ATTACHED BY OTHERS

Rainbow parts:
1.5" X 1.5" X .120" Steel square tubing

Base:
1.5" X 1.5" X 3/16" Steel square tubing

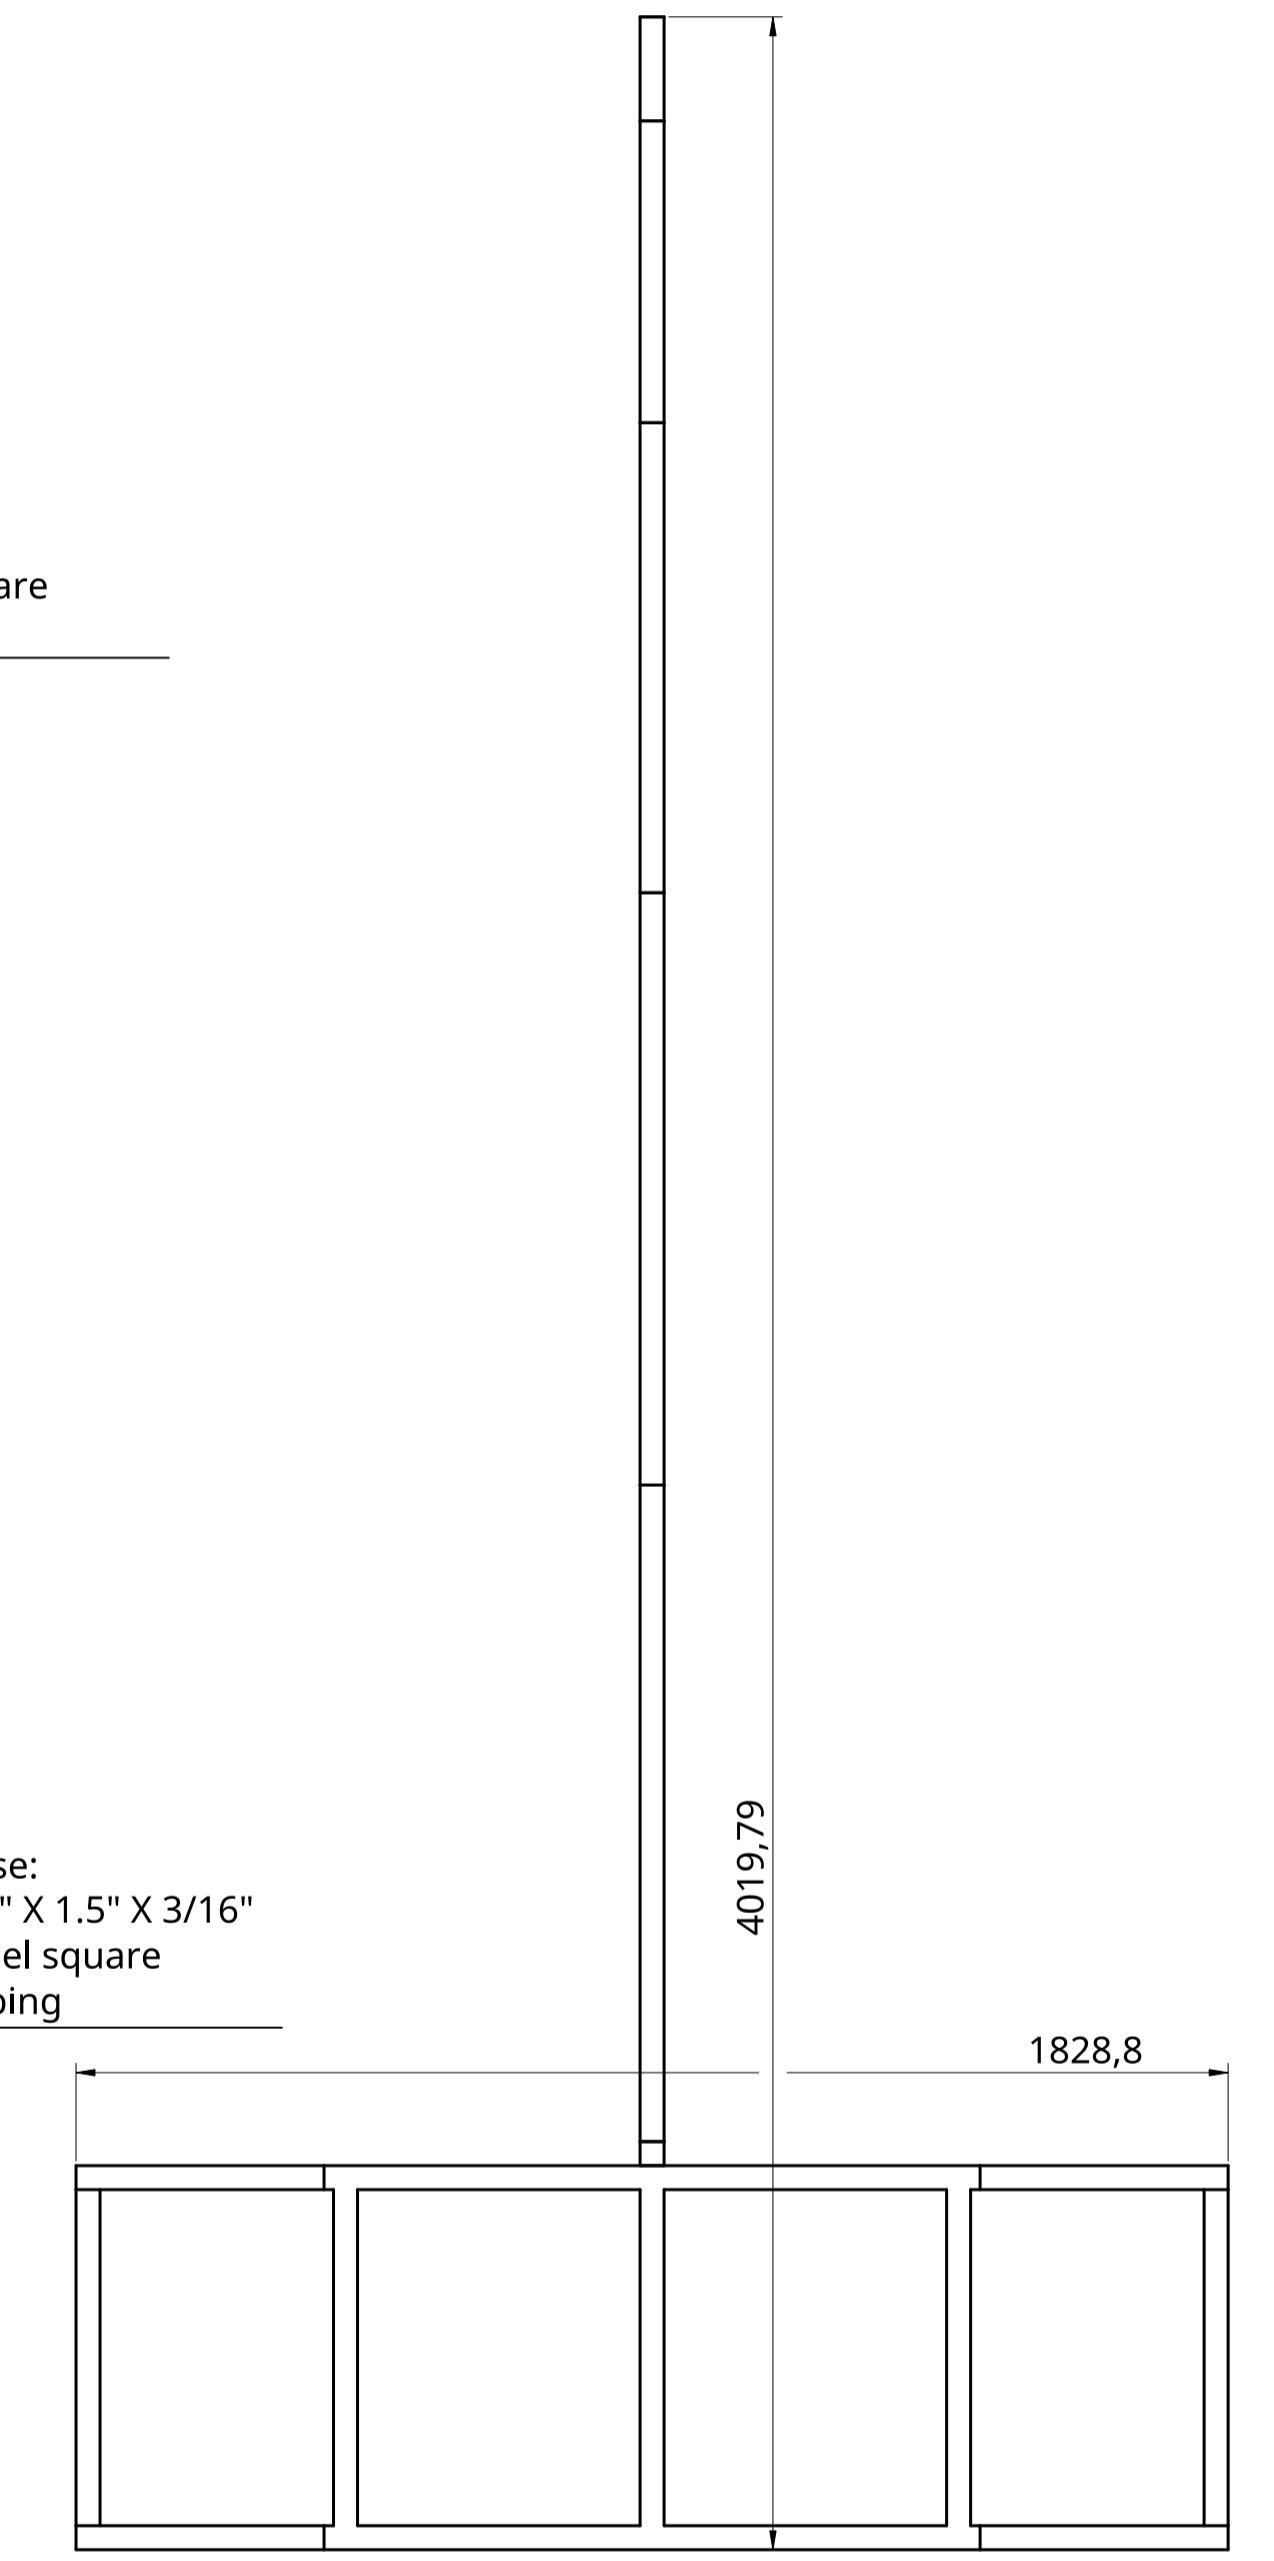

UNLESS OTHERWISE SPECIFIED, DIMENSIONS ARE IN MILLIMETERS				NAME		SIGNATURE		DATE	
ANGULAR = ± °				DRAWN		EMILY NICOLosi		2025-05-01	
SURFACE FINISH				CHECKED				TITLE	
DO NOT SCALE DRAWING				APPROVED				Polychroma	
BREAK ALL SHARP EDGES AND REMOVE BURRS				MATERIAL		FINISH		SIZE A1 DWG NO.	
FIRST ANGLE PROJECTION								SCALE 1:12 WEIGHT 800 lbs SHEET 1 of 1	

12 11 10 9 8 7 6 5 4 3 2 1

H
G
F
E
D
C
B
A


H
G
F
E
D
C
B
A

- Rainbow parts are
1.5' X 1.5' X.120' Steel square tubing

- Base (white) is made using
1.5' X 1.5' X 3/16' tubing

-Each colored section is welded
together completely individually.

- 2 in grade 8 bolts with washers and lock nuts
- 6 in grade 8 bolts with washers and lock nuts

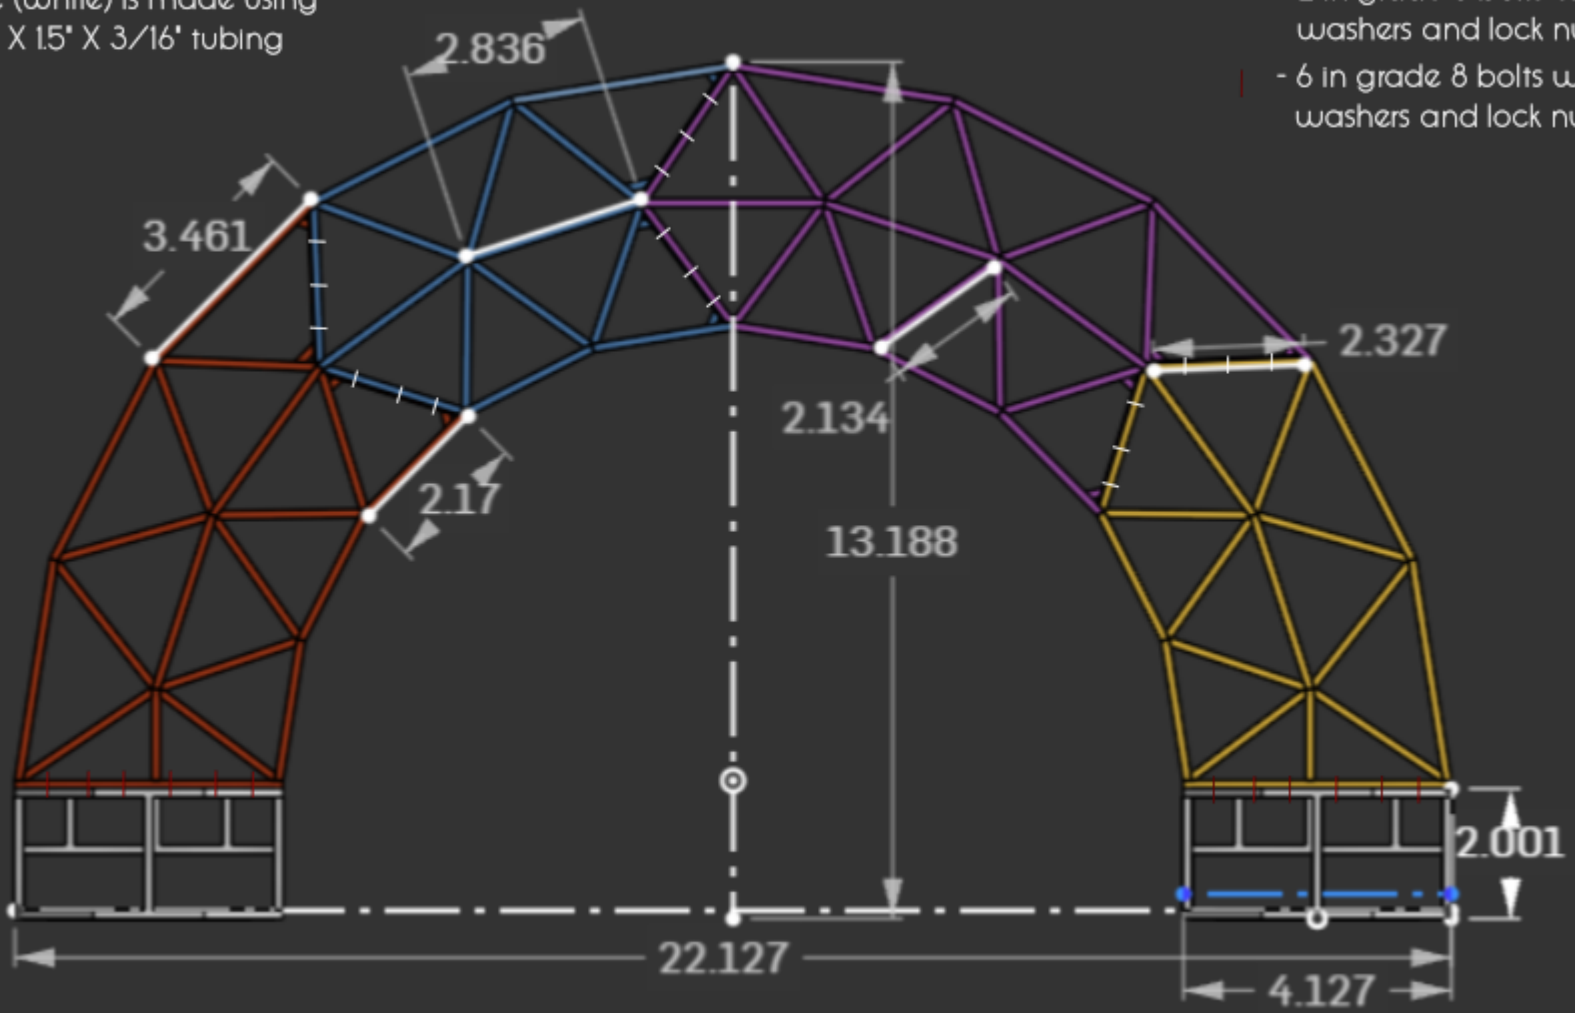



Entertainment Engineering Consultants, LLC

Polychroma Stability

Project Description

This project includes the stability review of a scenic structure comprised of steel tubing.

Design Codes

- 2018/ 2021 International Building Code
- 2022 California Building Code
- 2023 Florida Building Code
- ASCE 7-16 '*Minimum Design Loads and Associated Criteria for Buildings and Other Structures*'
- ANSI E1.2 - 2021 '*Entertainment Technology - Design, Manufacture and Use of Aluminum Trusses and Towers*'
- ANSI E1.21 - 2020 '*Entertainment Technology - Temporary Structures Used for Technical Production of Outdoor Entertainment Events*'
- ASCE 37-14 '*Design Loads on Structures During Construction*'

General Design Factors of Safety (U.N.O.)

	<u>Steel</u>	<u>Aluminum</u>
Yield	$\Omega_{s_y} := 1.67$	$\Omega_{a_y} := 1.65$
Rupture	$\Omega_{s_r} := 2$	$\Omega_{a_r} := 1.95$

Assumptions

Additional assumptions may be located in the body of the calculations.

- Wind Exposure is C for High Wind Action Plan, Exposure C for service
- Risk Category II

Design Loads - Wind

Ground Elevation of site (ft) $EL := 0$

Risk Category is II.

Determination of Velocity Pressure - ASCE 7-16 Section 26

Basic Wind Speed (MPH)
(based on ASCE Hazards Map) $V_{basic} := 115$

ASCE 37-14 Reduction for temporary structure $red := .75$

Service Wind Speed (MPH) $V_{service} := red \cdot \sqrt{.6 \cdot V_{basic}^2} = 66.809$

High Wind Action Plan Wind Speed (MPH) $V_{hwap} := 40$

Maximum height of evaluation $h := 13.2 \cdot ft$

Velocity Pressure Coefficient $K_{z_s} := .85$

Velocity Pressure Coefficient (Exp C) $K_{z_{hwap}} := .85$

Topographic factor $K_{zt} := 1$

Wind directionality factor $K_d := .85$


Ground Elevation Factor $K_e := e^{-.0000362 \cdot EL} = 1$

Gust-effect factor $G_e := .85$

Velocity Pressure (Service) $q_{z_s} := .00256 \cdot K_{z_s} \cdot K_{zt} \cdot K_d \cdot K_e \cdot V_{service}^2 \cdot psf = 8.256 psf$

Velocity Pressure (HWAP) $q_{z_{hwap}} := .00256 \cdot K_{z_{hwap}} \cdot K_{zt} \cdot K_d \cdot K_e \cdot V_{hwap}^2 \cdot psf = 2.959 psf$

Determination of Sign Wind Pressures - ASCE 7-16 Section 29.3

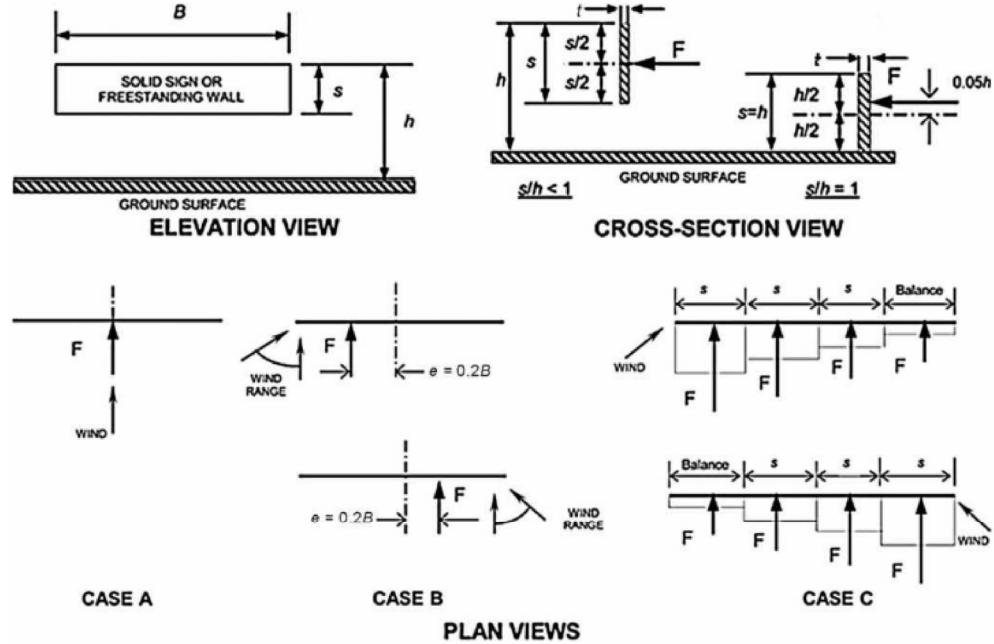

Force Coefficients, C_f , for Case A and Case B

Clearance Ratio, s/h	Aspect Ratio, B/s											
	≤ 0.05	0.1	0.2	0.5	1	2	4	5	10	20	30	≥ 45
1	1.80	1.70	1.65	1.55	1.45	1.40	1.35	1.35	1.30	1.30	1.30	1.30
0.9	1.85	1.75	1.70	1.60	1.55	1.50	1.45	1.45	1.40	1.40	1.40	1.40
0.7	1.90	1.85	1.75	1.70	1.65	1.60	1.60	1.55	1.55	1.55	1.55	1.55
0.5	1.95	1.85	1.80	1.75	1.75	1.70	1.70	1.70	1.70	1.70	1.70	1.75
0.3	1.95	1.90	1.85	1.80	1.80	1.80	1.80	1.80	1.80	1.85	1.85	1.85
0.2	1.95	1.90	1.85	1.80	1.80	1.80	1.80	1.80	1.85	1.90	1.90	1.95
≤ 0.16	1.95	1.90	1.85	1.85	1.80	1.80	1.85	1.85	1.85	1.90	1.90	1.95

Taken from ASCE 7-16 Figure 29.3-1

Case A

Top of Sign Height

$$\bar{h} := 13.2 \cdot ft$$

Vertical Dimension of sign

$$s := 4.2 \cdot ft$$

Width of sign

$$B := 13 \cdot ft$$

Aspect Ratio (B / s)

$$aspect := \frac{B}{s} = 3.095$$

Clearance Ratio (s / h)

$$clearance := \frac{s}{h} = 0.318$$

Force Coefficient

$$C_f := 1.8$$



High Wind Action Plan Sign Pressure

$$q_{sign_hwap} := q_{z_hwap} \cdot G_e \cdot C_f = 4.528 \text{ psf}$$

Service Sign Pressure

$$q_{sign_s} := q_{z_s} \cdot G_e \cdot C_f = 12.631 \text{ psf}$$

Polychroma Stability

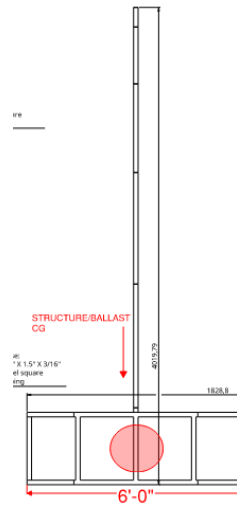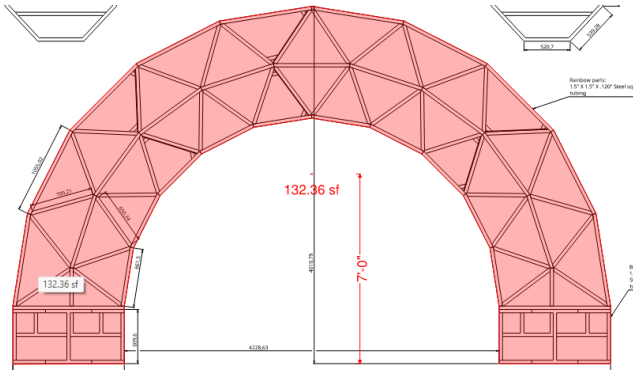

Dimensions of structure

$$h_{str} := 13.2 \text{ ft}$$

$$b_{str} := 22.2 \text{ ft}$$

$$d_{str} := 6 \text{ ft}$$

Weight of structure

$$wt_{str} := 800 \text{ lbf}$$

Weight of ballast

$$wt_{ballast} := 24 \cdot (60 \text{ lbf}) = (1.44 \cdot 10^3) \text{ lbf}$$

Area of scenic

$$A_{scenic} := 132.4 \text{ ft}^2$$

Wind on scenic

$$wind_{scenic} := (A_{scenic} \cdot q_{sign_hwap}) = 599.483 \text{ lbf}$$

Overturning moment

$$M_{ot} := 7 \text{ ft} (wind_{scenic}) = 4.196 \text{ kip} \cdot \text{ft}$$

Restoring moment

$$M_{res} := \frac{d_{str}}{2} (wt_{str} + wt_{ballast}) = 6.72 \text{ kip} \cdot \text{ft}$$

$$\frac{M_{res}}{M_{ot}} = 1.601$$

Sliding calculations

Forces on structure

$$p_{slide} := (wind_{scenic}) = 599.483 \text{ lbf}$$

Self-Weight of structure

$$P_{slide_resistance} := (wt_{str} + wt_{ballast}) \cdot 0.4 = 896 \text{ lbf}$$

$$\frac{P_{slide_resistance}}{P_{slide}} = 1.495$$



Scottsdale Arts
7380 E 2nd Street
Scottsdale, AZ 85251
Attn: Jennifer Gill

RE: Canal Convergence (Stargate) - Peer Review

CRE Proj. No: 25.701.104
Date: October 27th, 2025

Dear Ms. Gill,

Clark Reder Engineering Inc. has completed the structural peer review on the Stargate structure.

Calculations for the Stargate structure were provided by Brushwood Engineering Group. The original calculations are attached for reference. It is our understanding that the structure will be installed for Canal Convergence, which takes place November 7-16, 2025.

The objective of this review is to determine if the structural calculations provided for the referenced project comply with the structural requirements of the applicable building code in Scottsdale, AZ. This review is limited in scope and will be conducted to the extent necessary to render an opinion regarding the stability and integrity of the primary structural system of the project.

At no time shall it be construed that the project peer reviewer, in providing structural peer review services, is supplanting, or supplementing the Structural Engineer of Record in their professional responsibility for the design of the primary structural system. No attempt will be made to verify dimensions, except to the extent necessary to review the adequacy of a particular structural component. This prepared peer review report is intended for one-time use in connection with this project and location. Any reuse without written approval or adaptation by Clark Reder Engineering, Inc. is prohibited.

We have completed our structural peer review for the above-referenced project for conformance to the structural provisions of the 2018 International Building Code, ASCE 7-16, and ASCE 37-14. The proposed temporary structures are aluminum framed structure that are welded together. The stargate structure will be bolted down to a ballast base via (12) M12 class 70 bolts. The projector tower is aluminum framed and bolted together and used to support a speaker and a projector.

The proposed design loads were reviewed with respect to gravity and lateral loading criteria. The dead load consists of the self-weight of the structure and loading for sound or lighting equipment. Rain and snow loading were not considered in the live load calculations, which is consistent with the temporary nature of the structure and seasonal installation (all rain and snow accumulations must be removed from tent structures). Seismic lateral loads were not addressed in the calculations, which is consistent with the temporary nature of the structure (in the event of an earthquake, the event shall be suspended until such

time that the tent structures have been inspected by a competent person on site). Wind lateral loads were addressed for client-specified wind gusts of 33m/s or 74mph. The original engineering has a wind management plan starting at 15m/s(35mph) to have a crew on standby. Then, at 18m/s(40mph) the area surrounding the structure shall be excavated. Temporary structures should not be considered a place of refuge during high-wind events. The high wind action plan (HWAP) must be strictly followed for the duration of the project.

In conclusion, the Stargate structure was reviewed and will be structurally adequate for installation at Canal Convergence 2025 as described in the original calculations.

We trust this information is sufficient for your needs at this time. Please do not hesitate to contact our office should you have any questions or require additional information.

Regards,
Clark-Reder Engineering, Inc.



Jeffrey M. Reder, P.E.

Eric P. Kelly

STRUCTURAL DESIGN CERTIFICATE - TEMPORARY STRUCTURES



Project: Stargate Activation Artwork
Certificate No: BE2024 135
Description of Works: Free Standing Artwork – 4m (L) x 0.5m (W) x 4m (H)
Site Address: Australia Wide – (Wind Region A&B only)
Date of Issue: 13.11.24

Attention: Stormy



studio@chalkriverlabs.art

Brushwood Engineering Group has been engaged to certify the structures outlined in the above description. The design has been carried out in accordance with Australian Standards and the Building Codes of Australia by a registered professional engineer.

The design inputs, including loads, actions and assumptions are in accordance with the following design codes, standards and principles, and meet the requirements of the Australian Standards outlined below and Building Codes of Australia.

- AS1170.0:2002 Structural Design Actions – General principles;
- AS1170.1:2002 Structural Design Actions – Permanent, imposed and other actions;
- AS1170.2:2021 Structural Design Actions – Wind actions;
- AS1664.2:1997 Aluminium Structures – Allowable stress design;
- AS1720:2010 Timber Structures;
- AS4100:2020 Steel Structures;
- ABCB Temporary Structures 2015;
- National Construction Code 2022 (May).

This certificate addresses the structural capacity of the described items and does not relieve the contractor or other parties of responsibilities, and liabilities. It is noted that any modifications not illustrated within this certificate does not form part of this certification.

Document No.	Description
1.	230922 VST773A_a R0 FS Stargate Artwork - 4mH x 4mW Free Standing Sculpture (Generic REG A&B only)
2.	BE2024 135 CRL Stargate Activation - Analysis Pack

This certificate should only be used in conjunction with the attached documents and a safety assessment carried out by contractor or parties involved within this project.

Contractor, client and end user of the design shall be fully aware of the design conditions and limitations as follows:

1. Activation period: 3-4 Week Activation Period;
2. Design Wind Speed: 33m/s (119km/h);
3. Loading Specifications:
 - a) Dead = 0.1kPa of Cladding;
 - b) Live = Max. 2 People on Bottom Half of Circle;
4. Minimum Ballast:
 - a) 1500kg Concrete Ballast
5. Framing Specifications:
 - a) 65x65x3.0 SHS (6060 T5) Aluminium – Stargate Frame
 - b) 65x65x4.0 SHS (C350) Steel – Stargate Platform Frame
 - c) 15mm Plywood Base – Stargate Platform Base
6. Fixings Details:
 - a) Ballast to be positioned inside base of stargate frame and tied into structure;
 - b) Aluminium & Steel members to be fully welded using 6 CFW all around;
 - c) Plywood floor and edging to be bolted down using M8 bolts. Insert riv nuts to top surface and all edges;
 - d) 6 M12(ss/Class 70) Bolts to Fix Base Modules Top and Bottom. Total 12 Bolts
7. Amendments: To be provided to the engineer prior to works;
8. Wind Management Plan: 25m/s Maximum Wind Speed (90km/h)
 - a) Wind speeds should be monitored by an anemometer on site or by the closest Bureau of Meteorology weather station;
 - b) If wind speeds approach 18m/s (65km/h), event crew are to go on standby to evacuate the structure;
 - c) If wind speeds approach 20m/s (72km/h), the structure is to be evacuated and an exclusion zone is to be established of 10m radius;
 - d) If wind speeds approach 25m/s (90km/h), the structure and site is to be abandoned.

All works are to be carried out by qualified technicians and certified riggers where applicable. Brushwood Engineering Group is not responsible for the safety of the public during engagement with this structure. The scope of works is solely for structural elements and does not relieve the contractor or other parties of responsibilities, and liabilities.





Rowan Doskey
BEng. (Hons) (Structures) MIEAust
PRE0001984 DEP0003280 (NSW)
STRUCTURAL ENGINEER

Notes:

- Frame and Base are 6060 - T6 Aluminum 65x3 SHS Sections
- 5mm Aluminum Base Plate added at bottom of structure for ballast

BE2024 135 CRL Stargate Activation - Analysis Pack

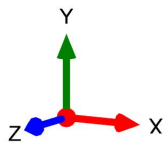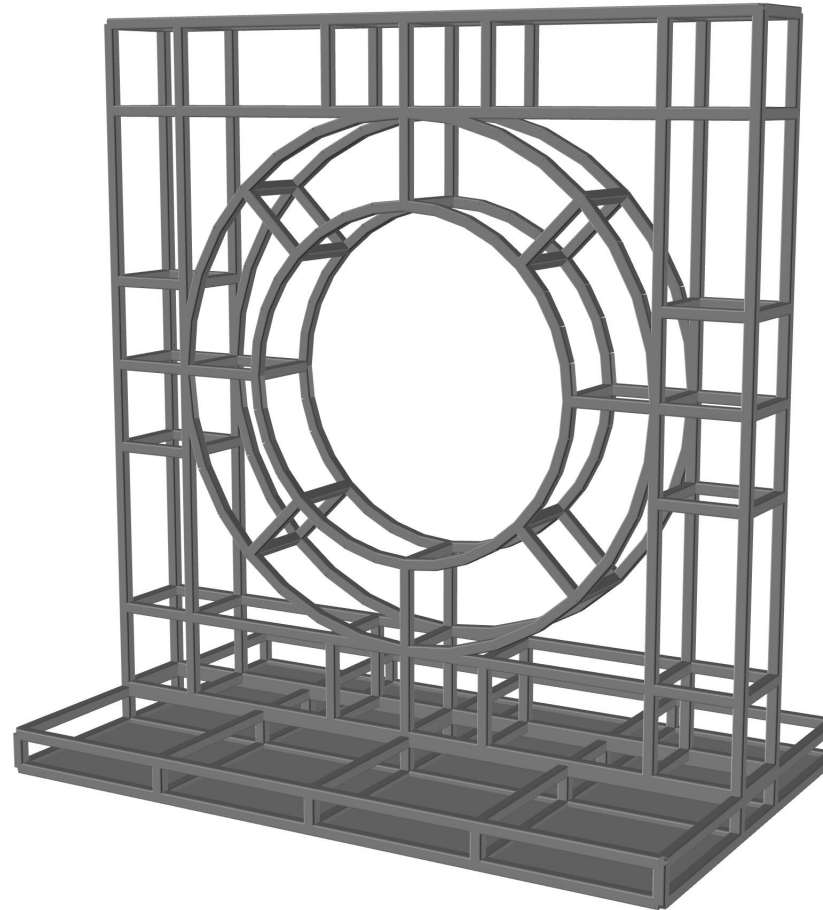


Materials:
■ 1 ALUMINIUM

Sections:
■ 1 65*3 SHS


Load case 12

Axial + Bending Stress:

- 89.54 MPa
- 80.16 MPa
- 70.78 MPa
- 61.40 MPa
- 52.02 MPa
- 42.64 MPa
- 33.26 MPa
- 23.87 MPa
- 14.49 MPa
- 5.11 MPa
- -4.27 MPa
- -13.65 MPa
- -23.03 MPa
- -32.41 MPa
- -41.79 MPa
- -51.17 MPa
- -60.55 MPa
- -69.93 MPa
- -79.31 MPa
- -88.69 MPa

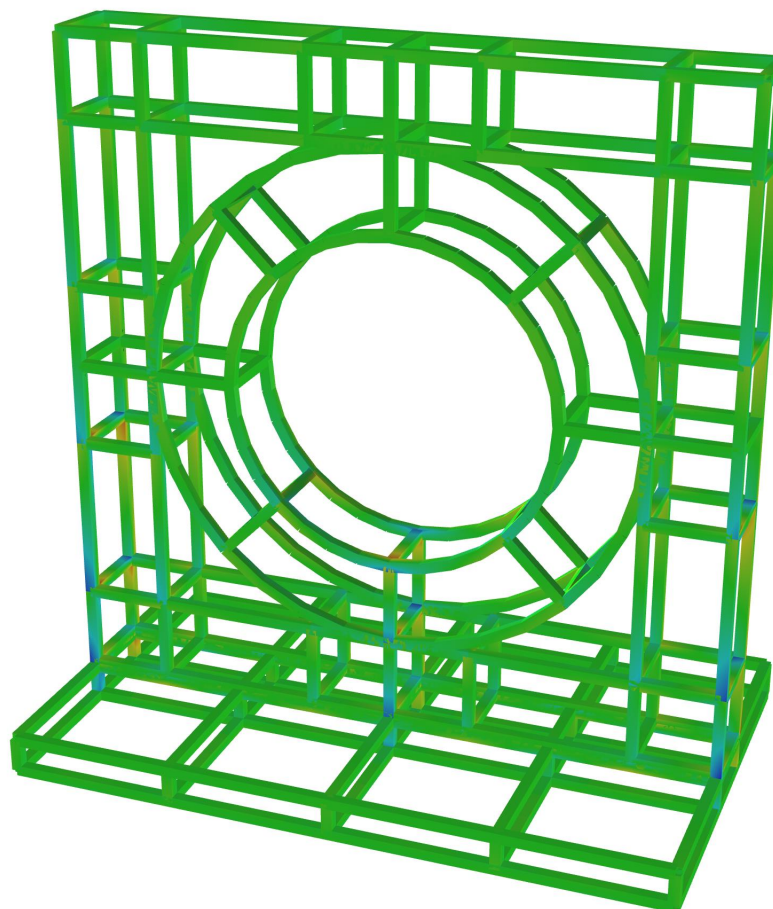

Strength - Frame:
 Max Stress = 89.54 MPa
 Allowable Stress = 241 MPa
 O.K. ✓✓

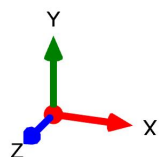



Materials:
 ■ 1 ALUMINIUM

Sections:
 ■ 1 65*3 SHS

Load case 12
Axial + Bending Stress:

- 89.54 MPa
- 80.16 MPa
- 70.78 MPa
- 61.40 MPa
- 52.02 MPa
- 42.64 MPa
- 33.26 MPa
- 23.87 MPa
- 14.49 MPa
- 5.11 MPa
- -4.27 MPa
- -13.65 MPa
- -23.03 MPa
- -32.41 MPa
- -41.79 MPa
- -51.17 MPa
- -60.55 MPa
- -69.93 MPa
- -79.31 MPa
- -88.69 MPa



Strength - Frame Base:
 Max Stress = 55.32 MPa
 Allowable Stress = 241 MPa
O.K. ✓✓

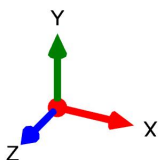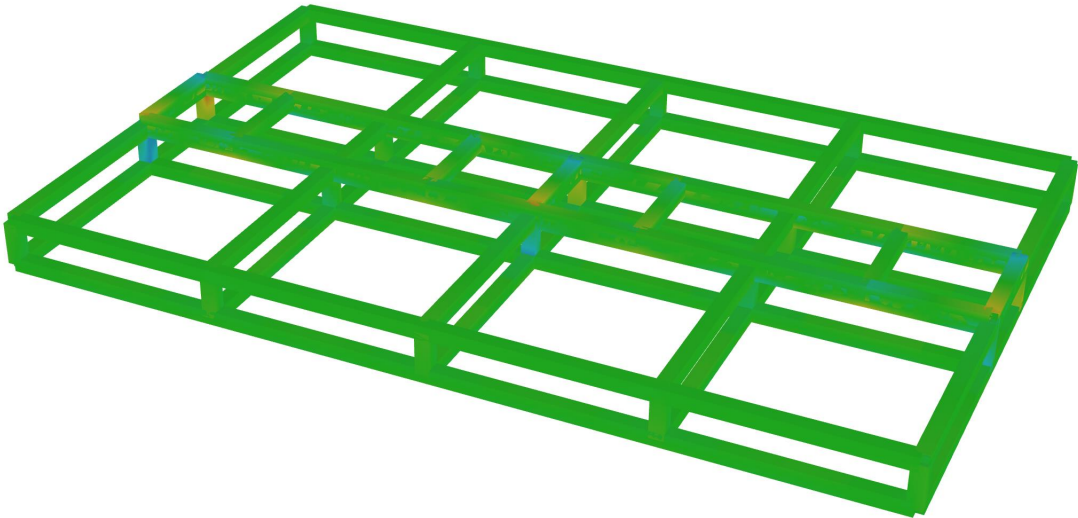


Materials:
 ■ 1 ALUMINIUM

Sections:
 ■ 1 65*3 SHS

Load case 12
Von Mises Stress:

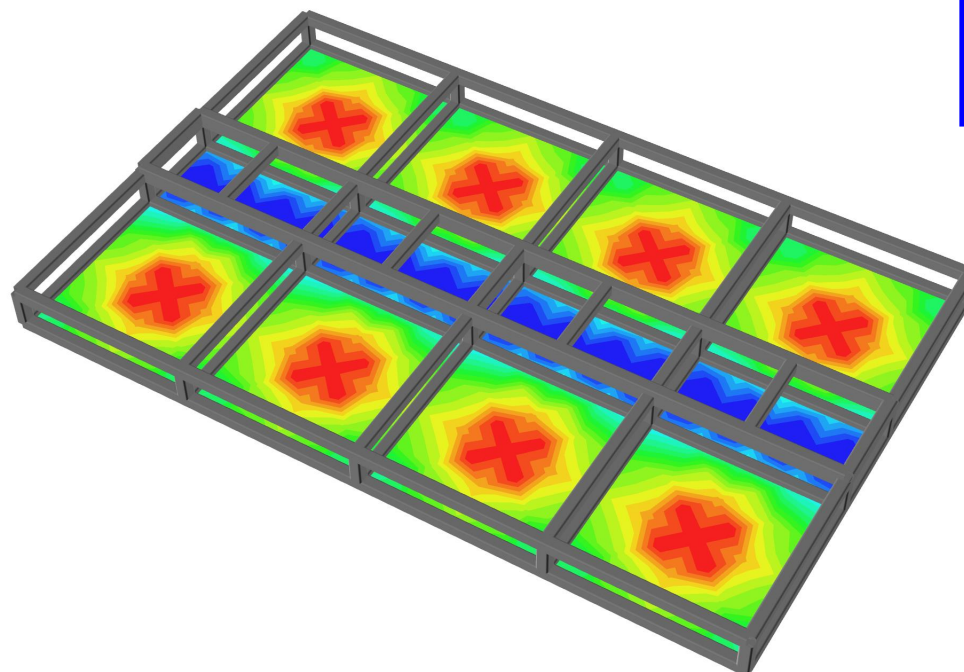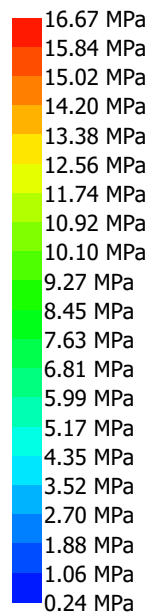



Strength - 5mm Aluminum Plate:
 Max Stress = 16.67 MPa
 Allowable Stress = 241 MPa
 O.K. ✓✓

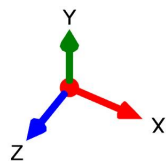


Materials:
 ■ 1 ALUMINIUM

Sections:
 ■ 1 65*3 SHS

Load case 12
Total Displacement:

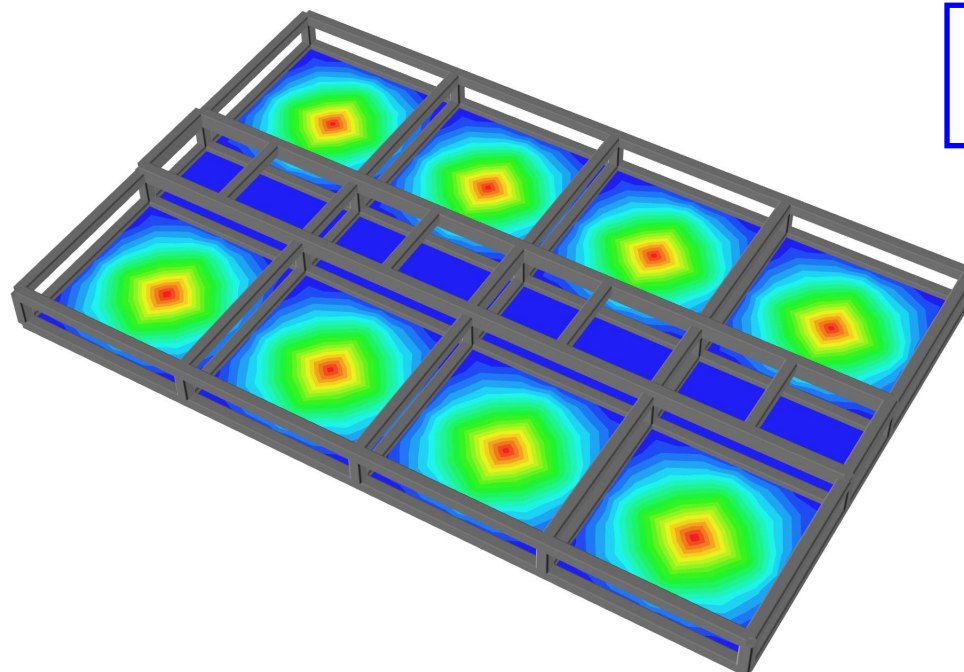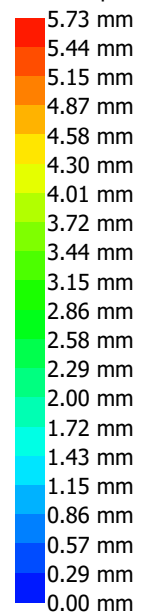

Deflection - 5mm Aluminum Plate:
 Max Deflection = 5.73 mm
 Allowable Deflection = 8 mm
O.K. ✓✓

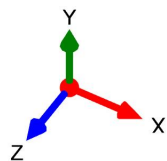

STRUCTURAL DESIGN CERTIFICATE - TEMPORARY STRUCTURES



Project: Stargate Activation Artwork
Certificate No: BE2024 135
Description of Works: Stargate Project Tower – 0.70m (L) x 0.70m (W) x 2.93m (H)
Site Address: Australia Wide – (Wind Region A&B only)
Date of Issue: 13.11.24

Attention: Stormy



studio@chalkriverlabs.art

Brushwood Engineering Group has been engaged to certify the structures outlined in the above description. The design has been carried out in accordance with Australian Standards and the Building Codes of Australia by a registered professional engineer.

The design inputs, including loads, actions and assumptions are in accordance with the following design codes, standards and principles, and meet the requirements of the Australian Standards outlined below and Building Codes of Australia.

- AS1170.0:2002 Structural Design Actions – General principles;
- AS1170.1:2002 Structural Design Actions – Permanent, imposed and other actions;
- AS1170.2:2021 Structural Design Actions – Wind actions;
- AS1664.2:1997 Aluminium Structures – Allowable stress design;
- AS1720:2010 Timber Structures;
- ABCB Temporary Structures 2015;
- National Construction Code 2022 (May).

This certificate addresses the structural capacity of the described items and does not relieve the contractor or other parties of responsibilities, and liabilities. It is noted that any modifications not illustrated within this certificate does not form part of this certification.


Document No.	Description
1.	Stargate Projector Towers v3

This certificate should only be used in conjunction with the attached documents and a safety assessment carried out by contractor or parties involved within this project.

Contractor, client and end user of the design shall be fully aware of the design conditions and limitations as follows:

1. Activation period: 3-4 Week Activation Period;
2. Design Wind Speed: 33m/s (119km/h);
3. Loading Specifications:
 - a) Dead = 0.1kPa of Cladding;
 - b) Live = No Loading;
4. Minimum Ballast:
 - a) 1000kg Concrete Ballast
5. Framing Specifications:
 - a) 65x65x3.0 SHS (6060 T5) Aluminium
 - b) 150 x 50 RHS (6060 T5) Aluminium
6. Fixings Details:
 - a) Ballast to be positioned on base plate;
 - b) Aluminium members in base and top frame section to be fully welded using 6 CFW all around;
 - c) 2 M12(ss/Class 70) Bolts each side to fix base module to top frame section. Total 8 Bolts.
7. Amendments: To be provided to the engineer prior to works;
8. Wind Management Plan: 25m/s Maximum Wind Speed (90km/h)
 - a) Wind speeds should be monitored by an anemometer on site or by the closest Bureau of Meteorology weather station;
 - b) If wind speeds approach 18m/s (65km/h), event crew are to go on standby to evacuate the structure;
 - c) If wind speeds approach 20m/s (72km/h), the structure is to be evacuated and an exclusion zone is to be established of 10m radius;
 - d) If wind speeds approach 25m/s (90km/h), the structure and site is to be abandoned.

All works are to be carried out by qualified technicians and certified riggers where applicable. Brushwood Engineering Group is not responsible for the safety of the public during engagement with this structure. The scope of works is solely for structural elements and does not relieve the contractor or other parties of responsibilities, and liabilities.



Rowan Doskey
BEng. (Hons) (Structures) MIEAust
PRE0001984 DEP0003280 (NSW)
STRUCTURAL ENGINEER



STRUCTURAL SUBMITTAL PACKAGE

for

Scottsdale Art

Canal Convergence - Recognition

Project Location: Scottsdale, AZ

Event Dates: November 7-16, 2025

Submittal Date: 10/15/2025

Clark Reder Project Number: 25.701.104

Reviewed by:

Prepared by:



Jeffrey M. Reder, P.E.
AZ Registration #: PE 50654

A handwritten signature in blue ink that reads 'Eric Kelly'.

Eric Kelly



Table of Contents for Structural Submittal Package

Cover Page	1
Table of Contents	2
Project Information	3
General Notes	4-5
Operations Management Plan	6
Reference Drawings	Appendix A
Calculations	Appendix B

Project Information

Project Summary

The project referenced by this submittal consists of a temporary aluminum truss goalpost used to support a scenic element (by others). The truss structure will be installed for Canal Convergence in Scottsdale, Arizona which takes place November 7th - November 16th, 2025.

The scenic element weighs 280 pounds. A scrim backdrop will cover the entire area between the truss towers and horizontal span. Ballast blocks will be placed at the end of each outrigger and will be attached to the corner blocks at the top of the structure via 3/8" 7x19 GAC guywires, as well as 2" ratchet straps around the outriggers.

Scope of Review

Clark Reder Engineering reviewed the structure for lateral and gravity loads. The structure was reviewed for 30mph wind speeds with the scenic element and backdrop flown, as well as 59mph wind speeds on the truss wraps only.

No review was performed on the scenic elements or their attachment to the structure.

Conclusions

Our review has concluded that the structure meets the structural requirements of the 2018 International Building Code, ASCE 7-16, and ASCE 37-14.

Limitations and Exceptions

The scope of review for this submittal is limited to the items listed above. All other temporary or permanent structures on site not specifically referenced above under "Scope of Review" are the responsibility of others.

Where the items covered by this submittal are attached to existing structures, it is the responsibility of the engineer of record for those existing structures to review the impact of the elements referenced in this submittal.

The Professional Engineering Stamp on this document is for the one-time use of the structure(s) listed in the project summary above for the specific date and event listed. The reuse of this document for other events must be approved in writing by the Professional Engineer listed on the cover sheet.



GENERAL STRUCTURAL NOTES

EVENT DATE & LOCATION

1. EVENT DATE: NOVEMBER 7-16, 2025
2. EVENT LOCATION: SCOTTSDALE, AZ

CODES

1. 2018 INTERNATIONAL BUILDING CODE
2. ASCE 7-16: MINIMUM DESIGN LOADS AND ASSOCIATED CRITERIA FOR BUILDINGS AND OTHER STRUCTURES
3. ASCE 37-14: DESIGN LOADS ON STRUCTURES DURING CONSTRUCTION
4. 2015 ALUMINUM DESIGN MANUAL

REFERENCES

1. ANSI E1.21-2013 ENTERTAINMENT TECHNOLOGY, "TEMPORARY GROUND-SUPPORTED OVERHEAD STRUCTURES USED TO COVER THE STAGE AREAS AND SUPPORT EQUIPMENT IN THE PRODUCTION OF OUTDOOR ENTERTAINMENT EVENTS"
2. ANSI E1.2-2012 ENTERTAINMENT TECHNOLOGY, "DESIGN, MANUFACTURE AND USE OF ALUMINUM TRUSSES AND TOWERS"

DESIGN LOADS

1. DEAD LOAD: SELF-WEIGHT OF STRUCTURE
2. RIGGING LOADS: 280-POUND SCENIC ELEMENT
3. WIND LOADS:
 - A. WIND RISK CATEGORY: II
 - B. BEFORE HIGH WIND ACTION PLAN IS ACTIVATED:
 1. DESIGN SERVICE-LEVEL WIND SPEED: 30 MPH
 2. EXPOSURE: C
 - C. AFTER HIGH WIND ACTION PLAN IS ACTIVATED:
 1. DESIGN SERVICE-LEVEL WIND SPEED: 59 MPH
 - a. REQUIRED WIND SPEED HAS BEEN REDUCED IN ACCORDANCE WITH ASCE 37-14 DUE TO THE TEMPORARY NATURE OF STRUCTURE
 2. EXPOSURE: C
 - D. SITE ELEVATION: 1278 FT
 - E. REFERENCE THE HIGH WIND ACTION PLAN FOR SPECIFIC ACTIONS THAT SHALL BE TAKEN TO ENSURE STABILITY OF THE TEMPORARY STRUCTURE IN HIGH WINDS.
4. SEISMIC LOADS DO NOT CONTROL THE DESIGN OF THIS STRUCTURE.

CONSTRUCTION AND SAFETY

1. ENGINEER SHALL NOT BE RESPONSIBLE FOR MEANS, METHODS, OR SEQUENCE OF CONSTRUCTION UNLESS SPECIFICALLY STATED ON THE DRAWINGS.
2. ENGINEER HAS DESIGNED THE STRUCTURES FOR THEIR FINAL AS-BUILT CONDITION. ENGINEER IS NOT RESPONSIBLE FOR TEMPORARY STABILITY OF STRUCTURES DURING ERECTION UNLESS SPECIFICALLY STATED ON THE DRAWINGS.
3. STRUCTURE HAS BEEN DESIGNED AS A TEMPORARY STRUCTURE THAT SHALL BE IN PLACE FOR LESS THAN SIX WEEKS.

FOUNDATIONS

1. THE STRUCTURE IS ASSUMED TO BE FOUNDED ON LEVEL GROUND (CONCRETE, ASPHALT, GRASS, ETC) WITH A MINIMUM NET ALLOWABLE BEARING CAPACITY OF 1500 PSF.

BALLAST

1. BALLAST SHALL BE INSTALLED PER THE ENGINEERING DRAWINGS. DEVIATIONS IN WEIGHT OR PLACEMENT SHALL BE APPROVED IN WRITING BY THE ENGINEER OF RECORD.
2. BALLAST SHALL NOT BE INSTALLED ON GRAVEL, ICE, GRASS, SLOPING OR OTHERWISE UNSTABLE TERRAIN UNLESS MEANS TO PREVENT SLIDING ARE PROVIDED.
3. BALLAST AMOUNTS GIVEN CONSIDER UPLIFT AND SLIDING, WITH A MINIMUM 1.5 FACTOR OF SAFETY AGAINST OVERTURNING.
4. MULTIPLE BALLAST LOCATIONS MAY NOT BE COMBINED INTO A SINGLE LOCATION WITHOUT PRIOR WRITTEN APPROVAL FROM A LICENSED STRUCTURAL ENGINEER.



RIGGING

1. ALL POINTS SHALL BE DEAD HUNG POINTS.
2. ALL RIGGING SHALL BE HUNG FROM PANEL POINTS (LOCATIONS ON THE TRUSS CHORDS BRACED BOTH VERTICALLY AND HORIZONTALLY) UNLESS SPECIFICALLY APPROVED BY THE ENGINEER OF RECORD.
3. BRIDLES SHALL NOT BE USED UNLESS SPECIFICALLY ALLOWED BY THE ENGINEER OF RECORD.

ALUMINUM TRUSS

1. ALUMINUM TRUSS SHALL BE MANUFACTURED BY ONE OF THE FOLLOWING COMPANIES OR AN APPROVED EQUAL:
 - A. TOTAL STRUCTURES
 - B. JAMES THOMAS ENGINEERING
 - C. TOMCAT USA
2. TRUSS TO TRUSS CONNECTION HARDWARE (UNLESS NOTED OTHERWISE):
 - A. PLATED ENDS: 5/8"Ø GRADE 8 BOLTS
3. TRUSS END PLATE BOLTS SHALL BE TIGHTED TO THE SNUG TIGHT CONDITION. SNUG TIGHT CONDITION EXISTS WHEN ALL PLIES IN THE CONNECTION HAVE BEEN PULLED INTO FIRM CONTACT BY THE BOLTS AND ALL BOLTS HAVE BEEN TIGHTENED SUFFICIENTLY TO PREVENT REMOVAL OF THE NUTS WITHOUT THE USE OF WRENCH.
4. UNLESS NOTED OTHERWISE, ALL LOADS SHALL BE APPLIED TO TRUSSES AT PANEL POINTS.
5. RATED SPANS, CAPACITIES AND LOADING CONDITIONS PUBLISHED BY THE TRUSS MANUFACTURER SHALL NOT BE EXCEEDED UNLESS REVIEWED AND APPROVED BY A LICENSED ENGINEER FOR A SPECIFIC USE.
6. DO NOT PLACE LIGHTING CLAMPS OR WIRE ROPE IN DIRECT CONTACT WITH THE TRUSS UNLESS THE CHORD MATERIAL IS PROTECTED FROM DAMAGE DUE TO OVERTIGHTENING OR WIRE ROPE RUBBING.

STRUCTURAL STEEL

1. ALL STEEL DETAILING, FABRICATION, AND ERECTION SHALL CONFORM TO THE LATEST VERSION OF THE FOLLOWING SPECIFICATIONS UNLESS NOTED OTHERWISE ON THE DRAWINGS:
 - A. AISC 360: SPECIFICATION FOR STRUCTURAL STEEL BUILDINGS
2. STRUCTURAL STEEL SHALL CONFORM TO THE FOLLOWING CRITERIA UNLESS NOTED OTHERWISE ON THE DRAWINGS:
 - A. PIPE SHAPES: ASTM A53, TYPE E OR S, GRADE B, FY = 35 KSI
 - B. HSS ROUND: ASTM A500 GR B, FY = 42KSI
 - C. BOLTS: ASTM A325-N
 - D. HARDENED WASHERS: ASTM F436
 - E. NUTS: ASTM A563

WIRE ROPE AND RIGGING ACCESSORIES

1. WIRE ROPE 3/8" OR LESS IN DIAMETER: 7X19 GAC, MEETING FEDERAL SPEC. RR-W-410E
2. WIRE ROPE 7/16" OR GREATER IN DIAMETER: 6X19 IWRC, MEETING FEDERAL SPEC. RR-W-410D, TYPE 1 CLASS 2
3. SHACKLES: GALVANIZED, SCREW PIN ANCHOR TYPE, ASTM A153
4. TURNBUCKLES: GALVANIZED, ASTM F-1145
5. FORGED WIRE ROPE CLIPS: GALVANIZED, MEETING FEDERAL SPEC. FF-C-450 TYPE I CLASS I
6. WIRE ROPE THIMBLES: GALVANIZED, MEETING FEDERAL SPEC. FF-T-276B TYPE II
7. RATCHET STRAPS: MEETING ASME B30.9 - 2018
8. CHAIN PULLERS: MEETING ASME HST-2 - 2018
9. POLYESTER OR STEEL CORE ROUND SLING: MEETING ASME B30.9 - 2018

INSPECTIONS

1. ALL TRUSS UNITS AND/OR OTHER RIGGING EQUIPMENT SHALL BE VISUALLY INSPECTED PRIOR TO ERECTION. DAMAGED OR CORRODED EQUIPMENT SHALL NOT BE USED. FIELD MODIFICATIONS SHALL BE APPROVED BY THE ENGINEER OF RECORD PRIOR TO INSTALLATION.



OPERATIONS MANAGEMENT PLAN

IMPLEMENTATION OF PLAN

1. PRIOR TO EACH INSTALLATION, THE TRUSS PROVIDER IN CONJUNCTION WITH THE VENUE, SHALL DESIGNATE A RESPONSIBLE PERSON IN CHARGE OF IMPLEMENTING ALL PHASES OF THE OPERATIONS MANAGEMENT PLAN AS IT PERTAINS TO THE STRUCTURE.
2. A MEETING SHALL BE HELD AT THE VENUE WITH THE PROMOTER, OWNER OR STAGE MANAGER TO DISCUSS THE HIGH WIND ACTION PLAN AND OTHER OPERATIONAL ITEMS.

DAILY OPERATIONS PLAN

1. CHECK WEATHER EACH MORNING AND PERIODICALLY THROUGHOUT THE DAY.
2. CHECK TOWER BASES DAILY TO ENSURE ALL REMAIN LEVEL AND PLUMB
3. CHECK GUY WIRES DAILY TO VERIFY LINES ARE TENSIONED.
4. PROVIDE A DAILY LOG OF THE ABOVE CHECKS FOR EACH INSTALLATION.

HIGH WIND ACTION PLAN

1. THE HIGH WIND ACTION PLAN SHALL BE IN EFFECT FOR THE ENTIRETY OF THE INSTALLATION. AN INSTALLATION SHALL BE DEFINED AS STARTING AT THE INITIAL COMMENCEMENT OF THE STRUCTURE INSTALLATION AND ENDING ONCE THE STRUCTURE IS COMPLETELY DISMANTLED.
2. A COMPETENT RESPONSIBLE PERSON FROM THE TRUSS PROVIDER OR VENUE SHALL BE PRESENT FOR THE DURATION OF THE EVENT TO IMPLEMENT THE HIGH WIND ACTION PLAN (SEE ABOVE).
3. A REGULAR LIAISON WITH LOCAL AIRPORTS AND/OR WEATHER INFORMATION CENTERS SHALL BE MAINTAINED TO ASCERTAIN IF ANY SIGNIFICANT WEATHER EVENTS ARE EXPECTED IN THE IMMEDIATE VICINITY OF THE STRUCTURE
4. AN ANEMOMETER SHALL BE PLACED ON THE STRUCTURE TO MONITOR WIND SPEEDS. THE ANEMOMETER SHALL BE PLACED AT THE TOP OF A TOWER OR AN ADJACENT STRUCTURE AT A HEIGHT EQUIVALENT TO THE HEIGHT OF THE TOWER. THE ANEMOMETER SHALL BE LOCATED WITHIN 50 YARDS OF THE STRUCTURE.
5. NOTED WIND SPEEDS ARE 3-SECOND GUSTS IN ACCORDANCE WITH ASCE 7
6. **WHEN THE STRUCTURE IS UNATTENDED OR NOT IN USE:** VIDEO WALLS AND SCRIM/BANNERS SHALL BE LOWERED TO THE GROUND AND SECURED AGAINST MOVEMENT OR COMPLETELY REMOVED FROM THE STRUCTURE.
7. **WHEN WIND SPEEDS ARE EXPECTED TO EXCEED 20 MPH:** A TEAM OF QUALIFIED PERSONNEL SHALL BE PUT ON ALERT. ALL NECESSARY PERSONNEL SHALL BE IN PLACE AND PUT ON STANDBY.
8. **WHEN WIND SPEEDS ARE EXPECTED TO EXCEED 30 MPH:**
 - a. SCRIM/BACKDROP SHALL BE LOWERED AND/OR REMOVED FROM THE SYSTEM.
 - b. LOWERING OF SCRIM SHALL BE DONE FROM THE GROUND BY MEANS OF REMOTELY ACTIVATED EQUIPMENT SUCH AS MOTORS OR MECHANICAL RELEASES.
9. **WHEN WIND SPEEDS ARE EXPECTED TO EXCEED 40 MPH:** ALL SHOW OPERATIONS SHALL BE SUSPENDED, AND THE IMMEDIATE AREA SHALL BE EVACUATED OF ALL PATRONS AND NON-ESSENTIAL PERSONNEL.
10. **AT WINDS SPEEDS IN EXCESS OF 50 MPH:** ALL PERSONNEL SHOULD MAINTAIN SAFE DISTANCE FROM THE STRUCTURE.
11. THE HIGH WIND ACTION PLAN SHALL BE POSTED AT A CONSPICUOUS AREA ON SITE. IT MUST BE AVAILABLE AT ALL TIMES TO VENUE OPERATORS AND CREW.
12. FAILURE TO FOLLOW THE HIGH WIND ACTION PLAN MAY RESULT IN COLLAPSE OF THE STRUCTURE, DAMAGE TO EQUIPMENT AND INJURY TO PERSONS.

PLAN EXCEPTIONS

1. THIS PLAN IS SPECIFIC TO THE STRUCTURE LISTED IN THIS SUBMITTAL. THE EVENT OPERATIONS MANAGEMENT PLAN, IF MORE STRINGENT, SHALL BE FOLLOWED.



APPENDIX A

REFERENCE DRAWINGS



COPYRIGHT © 2025
THIS DOCUMENT IS THE PRODUCT AND EXCLUSIVE PROPERTY OF CLARK REDER ENGINEERING, INC. NEITHER THE DOCUMENT NOR THE INFORMATION IT CONTAINS MAY BE COPIED OR USED FOR OTHER THAN THE SPECIFIC PURPOSE FOR WHICH IT WAS PREPARED, WITHOUT THE WRITTEN CONSENT OF CLARK REDER ENGINEERING, INC.

CANAL CONVERGENCE
GOAL POST

ARIZONA


ISSUE/REVISIONS

REVISION DESCRIPTION - DATE



DATE: 10/15/2025
CRE PROJECT NO: 25.701.104
DRAWN BY: EPK/TAK

**GOAL POST PLAN
& ELEVATIONS**

S1.1

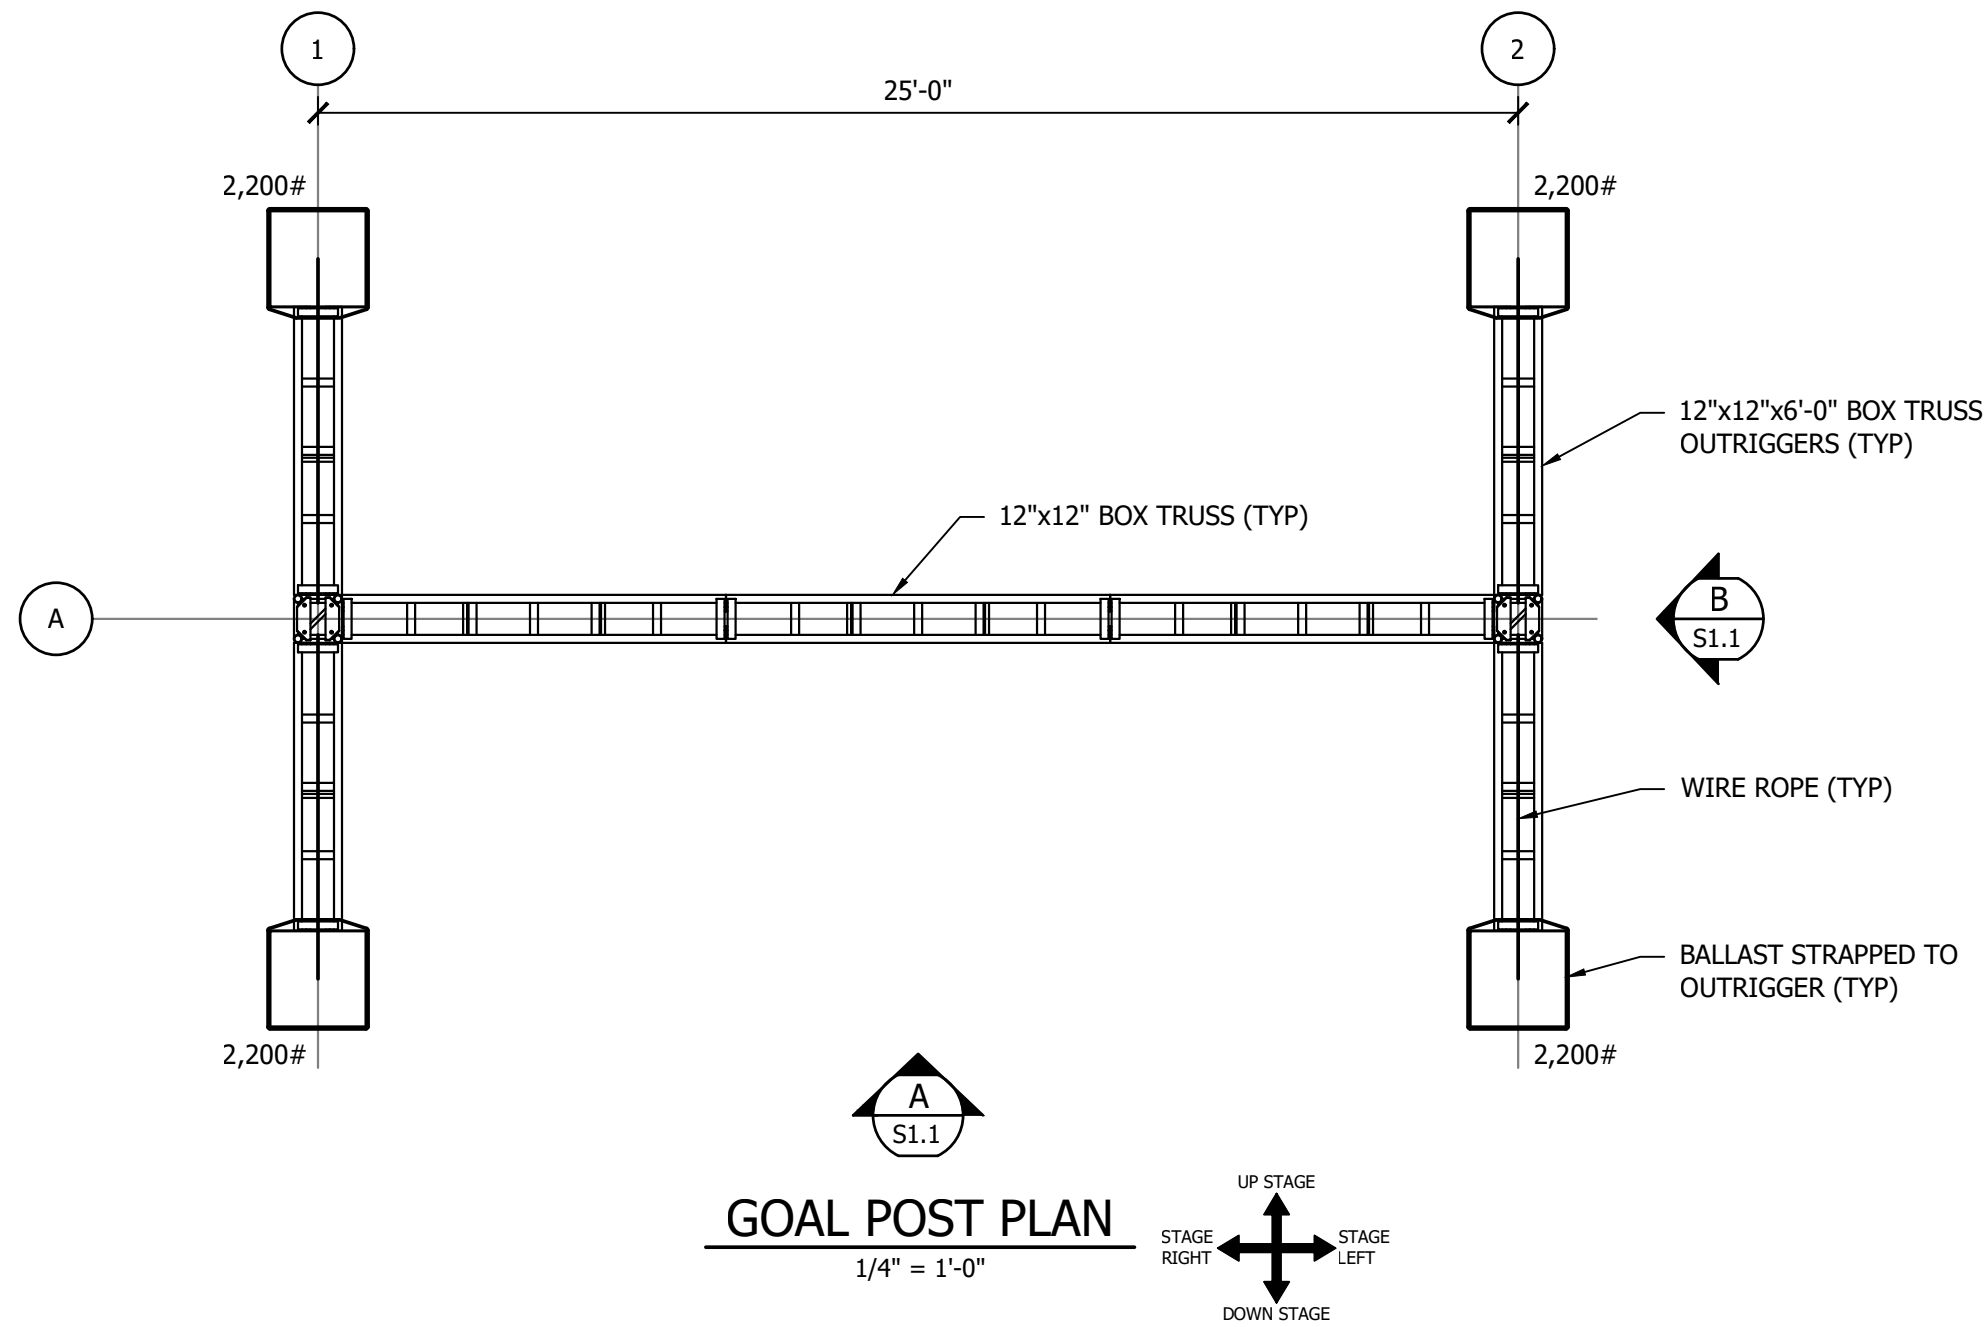

**12" x 12" ALUMINUM BOX TRUSS
WITH TRUSS WRAPS - TYP.**

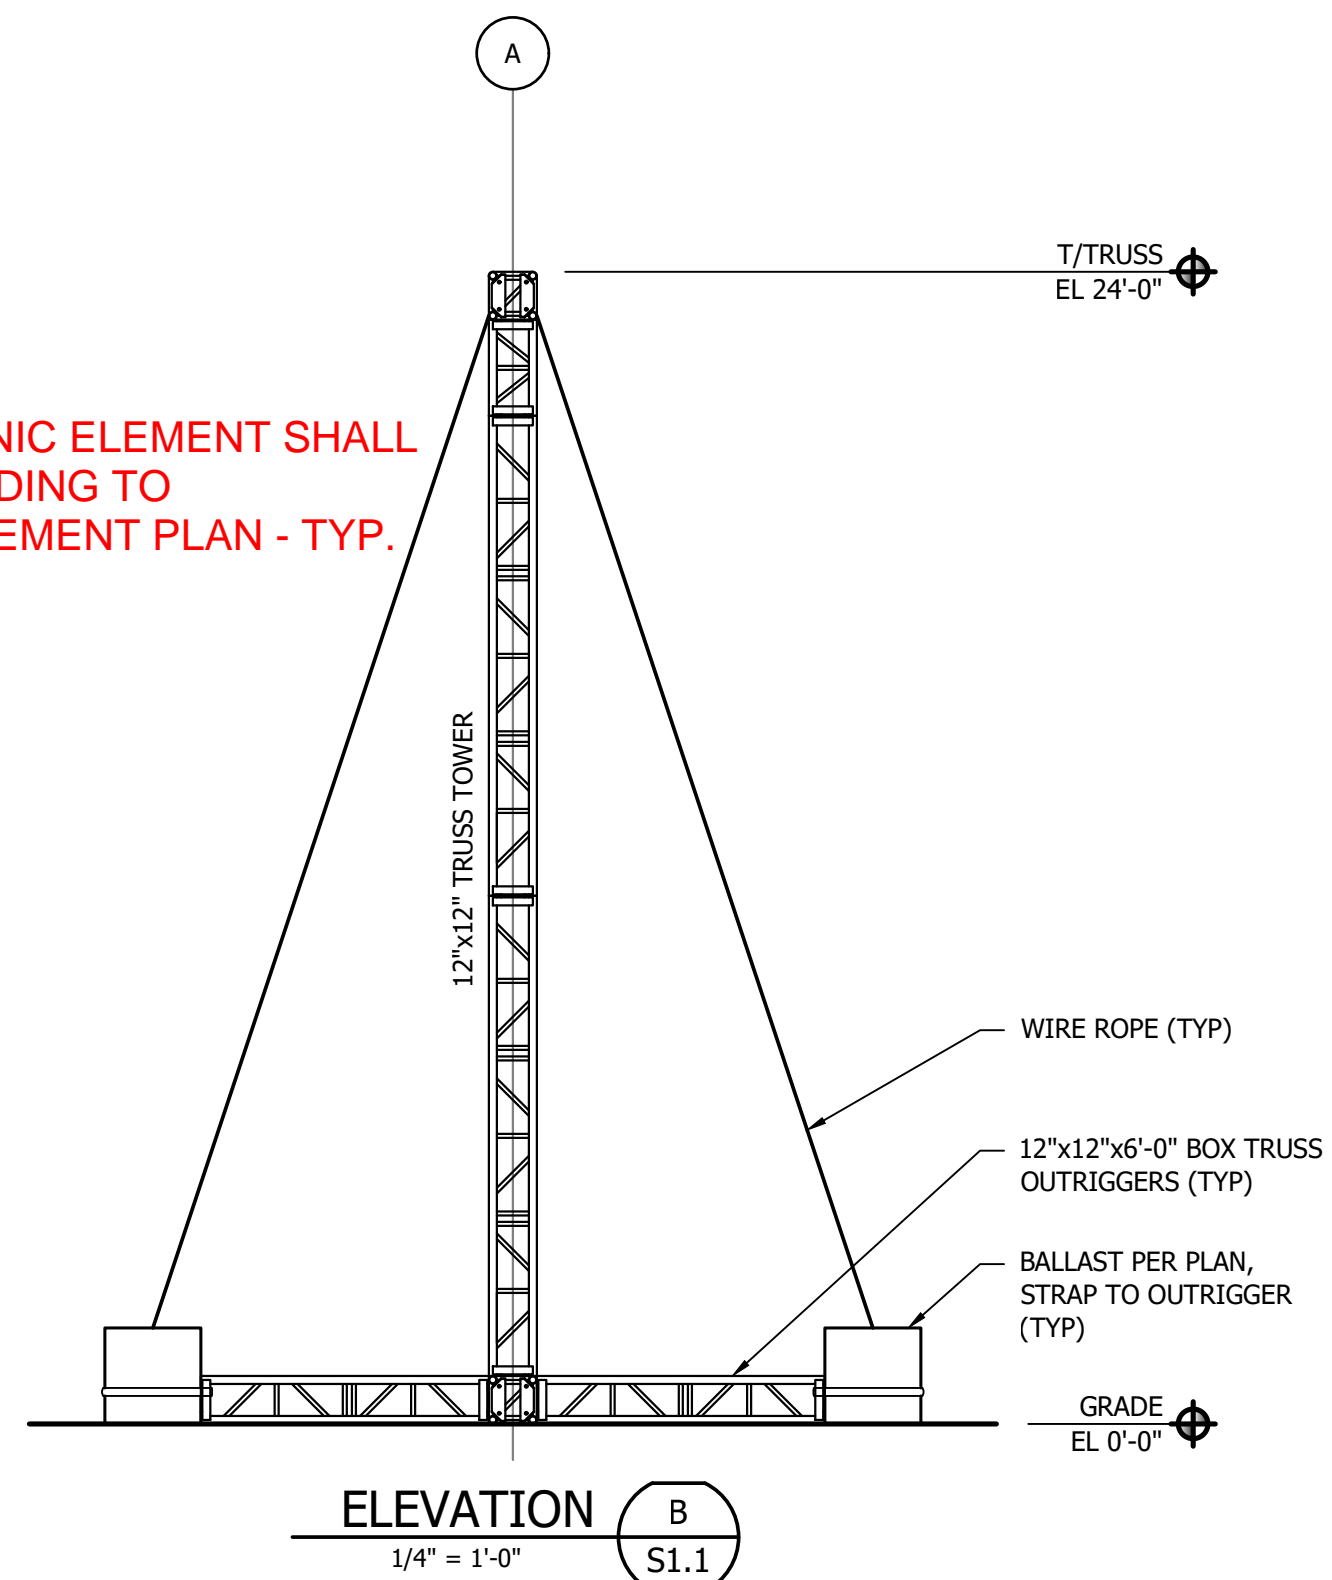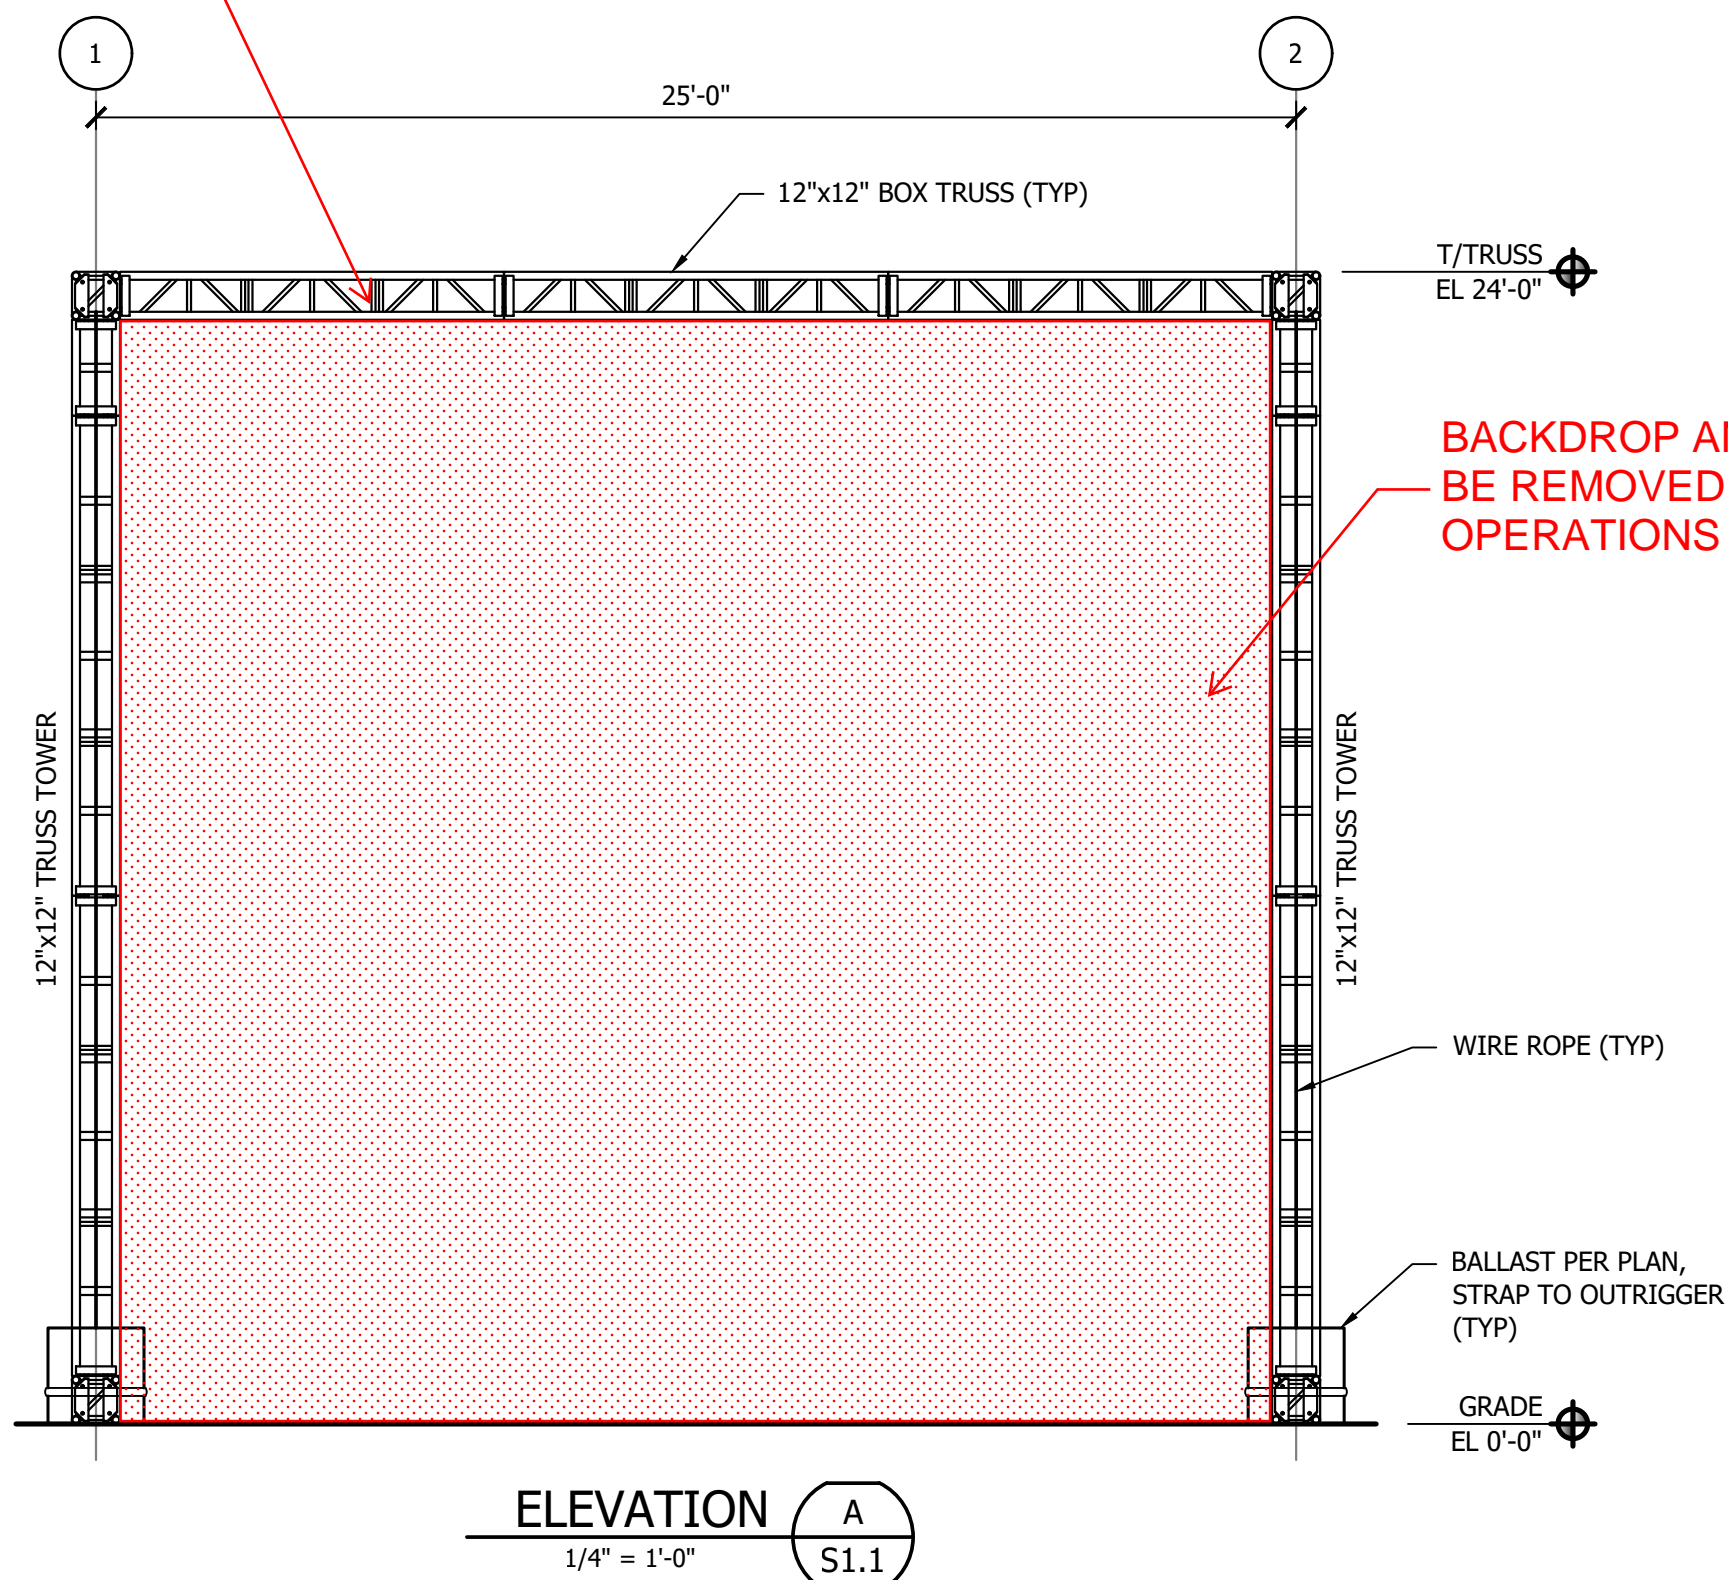



APPENDIX B

CALCULATIONS

Canal Convergence - Recongnition

Event Date & Location: November 7-16, 2025; Scottsdale, AZ

Codes and Referenced Standards

- 2018 International Building Code
- Aluminum Design Manual, 2015 ed.
- American Institute of Steel Construction, Steel Construction Manual 15th Edition
- American Society of Civil Engineers 7-16 (ASCE 7-16) "*Minimum Design Loads for Buildings and Other Structures*"
- American Society of Civil Engineers 37-14 (ASCE 37-14) "*Design Loads on Structures During Construction*"
- ANSI E 1.21-2013 "*Temporary Structures Used for Technical Production of Outdoor Entertainment Events*"
- ANSI E 1.2-2012 "*Manufacture and Use of Aluminum Trusses and Towers*"

Project Description

- Review of temporary structure for lateral and gravity loads.

Analysis Assumptions/Design Criteria

- A high wind action plan has been issued and must be strictly followed.
- All truss is 12" x 12" aluminum box truss from Total Structures or equivalent.

General Design - Applies To All Assemblies

Steel/Aluminum Factors of Safety

Note: The following factors/design criteria applies to all assemblies and will be used throughout design package (U.N.O).

AISC Typical Factors of Safety (U.N.O.): $\Omega_{y.AISC} := 1.67$ $\Omega_{r.AISC} := 2.0$

ADM Typical Factors of Safety (U.N.O.): $\Omega_{y.ADM} := 1.65$ $\Omega_{r.ADM} := 1.95$

ASTM A36 Mechanical Properties

Yield Strength: $F_{y.A36} := 36\text{ksi}$

Tensile Strength: $F_{u.A36} := 58\text{ksi}$

ASTM A572 Mechanical Properties

Yield Strength: $F_{y.A572} := 50\text{ksi}$

Tensile Strength: $F_{u.A572} := 65\text{ksi}$

ASTM A500 GR. B (Rectangular) Mechanical Properties

Yield Strength: $F_{y.A500.rect} := 46\text{ksi}$

Tensile Strength: $F_{u.A500.rect} := 58\text{ksi}$

ASTM A500 GR. B (Round) Mechanical Properties

Yield Strength: $F_{y.A500.rd} := 42\text{ksi}$

Tensile Strength: $F_{u.A500.rd} := 58\text{ksi}$

ASTM A992 Mechanical Properties

Yield Strength: $F_{y.A992} := 50\text{ksi}$

Tensile Strength: $F_{u.A992} := 65\text{ksi}$

Weld (Steel) Mechanical Properties

Weld Strength: $F_{weld} := 70\text{ksi} \cdot 0.6 = 42.00\text{-ksi}$

Grade 8 Bolt Mechanical Properties

Tensile Strength of Bolt: $F_{u.bolt} := 150\text{ksi}$

6061-T6 Mechanical Properties

Unwelded

Welded

Tension Ultimate Stress: $F_{tu} := 38\text{ksi}$

$F_{tuw} := 24\text{ksi}$

Tension Yield Stress: $F_{ty} := 35\text{ksi}$

$F_{tyw} := 15\text{ksi}$

Compression Yield Stress: $F_{cy} := 35\text{ksi}$

$F_{cyw} := 15\text{ksi}$

Shear yield stress: $F_{sy} := 0.6 \cdot F_{ty} = 21.00\text{-ksi}$

$F_{syw} := 0.6 \cdot F_{tyw} = 9.00\text{-ksi}$

Ultimate shear stress: $F_{su} := 24\text{ksi}$

$F_{suw} := 15\text{ksi}$

Tension coefficient: $k_t := 1.0$

$k_{tw} := 1.0$

Applied Loads:

Wind Loads - Per ASCE 7-16 and ASCE 37-14

- Ultimate wind speed (LRFD): $V_u := 101$ mph
- Service level wind speed (ASD): $V_s := \sqrt{V_u^2 \cdot 0.6}$ $V_s = 78.23$ mph
- HWAP service level wind speed (ASD): $V_{hwap} := 40$ mph
- Exposure category (service): $Exp_s :=$
- Exposure category (HWAP): $Exp_{hwap} :=$
- Gust effect factor: $G_w := 0.85$
- Topographic factor: $K_{zt} := 1.0$
- Ground elevation: $z_g := 1278$ ft
- Ground elevation factor: $K_e := e^{-0.0000362 \cdot \frac{z_g}{ft}} = 0.95$

6.2.1.1.1 Construction Period in Hurricane-Prone Areas
 For construction between November 1 and June 30 (outside of the hurricane season), the basic wind speed of 115 mph (51 m/s) shall be permitted for structures sited near the Gulf Coast and Eastern Seaboard, where the ASCE/SEI 7-10 specified basic wind speed exceeds 115 mph (51 m/s) (3 second gust) (hurricane-prone areas). The 115 mph (51 m/s) wind speed is permitted to be reduced by the factors in Section 6.2.1 only for a construction period between November 1 and June 30. If the construction period shifts into the period between July 1 and October 31, the design shall be reviewed and modified, as appropriate, to conform to the requirements shown below for a construction period between July 1 and October 31.

Between July 1 and October 31, basic wind speed of 115 mph (51 m/s) shall be permitted for structures sited near the Gulf Coast and Eastern Seaboard, where the ASCE/SEI 7-10 specified basic wind speed exceeds 115 mph (51 m/s) (3 second gust) provided additional bracing is prepared in advance and applied in time before the onset of an announced hurricane. The 115 mph (51 m/s) wind speed shall not be reduced by the factors in Section 6.2.1 for the construction period. The bracing shall be designed for the full, unmodified wind load determined using the mapped wind speed and procedures found in ASCE/SEI 7-10.

ASCE 37-14 Reduction Factor

Construction Period	Factor
Less than six weeks	0.75
From six weeks to one year	0.8
From one to two years	0.85
From two to five years	0.9

Reduction coefficient for temporary structure: $red :=$

Service level (ASD) wind speed for design of temporary structure: $V_{temp_service} := V_s \cdot red$ $V_{temp_service} = 58.68$ mph

Ultimate level (LRFD) wind speed for design of temporary structure: $V_{temp_ultimate} := V_u \cdot red$ $V_{temp_ultimate} = 75.75$ mph

NOTE: Per ASCE 7-16, ultimate wind speeds are reduced by a factor of 0.6 in all service level (ASD) load combinations found in Section 2.4. Service level wind speeds are the design wind speeds that should be monitored.

Wind Loads on Trussed Towers

This Mathcad sheet calculates the wind pressures on a trussed tower in accordance with figure 29.4-3 of ASCE 7-16.

Height of wind evaluation:

$z := 24 \cdot \text{ft}$

Truss property table:

Type of truss:

type :=

Wind directionality factor:

$K_d :=$

Tower cross section:

TCS :=

Are tower members round?

RM :=

Truss	"ε"	"Width"
"12" Truss"	0.461	12
"20½" Truss"	0.329	20.5
"26x30 PRT Empty"	0.289	26
"26x30 PRT Full"	0.594	26
"20"x30" HD Truss"	0.254	30
"G2 Truss"	.220	60

Ratio of solid area to gross area:

$\epsilon := \text{Table}_{\text{truss}}_{\text{type}, 2} = 0.461$

Truss width:

$B_{\text{truss}} := \text{Table}_{\text{truss}}_{\text{type}, 3} \cdot \text{in} = 12.00 \cdot \text{in}$

Velocity Pressure Exposure Coefficient (service):

$K_{z_s} := K_{z_{F_s}}(z) \quad K_{z_s} = 0.94$

Velocity Pressure Exposure Coefficient (HWAP):

$K_{z_{hwap}} := K_{z_{F_{hwap}}}(z) \quad K_{z_{hwap}} = 0.94$

Wind velocity pressure (service):

$q_{z_s} := 0.00256 \cdot K_{z_s} \cdot K_{zt} \cdot K_d \cdot K_e \cdot (\text{red} \cdot V_s)^2 \cdot \text{psf} \quad q_{z_s} = 6.70 \cdot \text{psf}$

Wind velocity pressure (HWAP):

$q_{z_{hwap}} := 0.00256 \cdot K_{z_{hwap}} \cdot K_{zt} \cdot K_d \cdot K_e \cdot (V_{hwap})^2 \cdot \text{psf} \quad q_{z_{hwap}} = 3.12 \cdot \text{psf}$

Round member reduction (if applicable):

$\text{rnd_red} := \begin{cases} 1.0 & \text{if RM} = \text{"NO"} \\ \min(1.0, 0.51 \cdot \epsilon^2 + 0.57) & \text{otherwise} \end{cases} \quad \text{rnd_red} = 0.68$

Force coefficient:

$C_f := \text{rnd_red} \cdot \begin{cases} 4.0 \cdot \epsilon^2 - 5.9 \cdot \epsilon + 4.0 & \text{if TCS} = \text{"Square"} \\ 3.4 \cdot \epsilon^2 - 4.7 \cdot \epsilon + 3.4 & \text{otherwise} \end{cases} \quad C_f = 1.45$

Truss wind pressure (service):

$$p_{\text{truss}_s} := q_{z_s} \cdot C_f \cdot G_w$$

$$p_{\text{truss}_s} = 8.23 \cdot \text{psf}$$

Truss wind pressure (HWAP):

$$p_{\text{truss}_{\text{hwap}}} := q_{z_{\text{hwap}}} \cdot C_f \cdot G_w$$

$$p_{\text{truss}_{\text{hwap}}} = 3.83 \cdot \text{psf}$$

Linear wind load (service):

$$w_{\text{truss}_s} := p_{\text{truss}_s} \cdot B_{\text{truss}} \cdot \epsilon$$

$$w_{\text{truss}_s} = 3.80 \cdot \text{plf}$$

Linear wind load (HWAP):

$$w_{\text{truss}_{\text{hwap}}} := p_{\text{truss}_{\text{hwap}}} \cdot B_{\text{truss}} \cdot \epsilon$$

$$w_{\text{truss}_{\text{hwap}}} = 1.76 \cdot \text{plf}$$

Wind Loads on Wrapped Truss or Solid Members

This Mathcad sheet calculates the wind pressures in accordance with figure 29.4-1 of ASCE 7-16.

Height of structure: $h := 24 \cdot \text{ft}$

Diameter or least horizontal dimension: $D := 12 \cdot \text{in}$

Wind evaluation height: $z := h$

Surface roughness definition:
 D' = depth of protruding elements

Rough: D'/D = 0.02
 Very rough: D'/D = 0.08

Cross section: CS :=

Surface Roughness (applies only to round cross section):

SR :=

Wind directionality factor: $K_d := \begin{cases} 0.90 & \text{if CS} = 1 \vee \text{CS} = 2 \\ 0.95 & \text{if CS} = 3 \\ 1.0 & \text{otherwise} \end{cases} \quad K_d = 0.90$

Height/Diameter ratio: $hD := \frac{h}{D} = 24.00$

Velocity Pressure Exposure Coefficient (service): $K_{z_s} := K_{z_{F_s}}(z) = 0.94$

Velocity Pressure Exposure Coefficient (HWAP): $K_{z_{hwap}} := K_{z_{F_{hwap}}}(z) = 0.94$

Wind velocity pressure (service): $q_{z_s} := 0.00256 \cdot K_{z_s} \cdot K_{zt} \cdot K_d \cdot K_e \cdot (\text{red} \cdot V_s)^2 \cdot \text{psf}$ $q_{z_s} = 7.10 \cdot \text{psf}$

Wind velocity pressure (HWAP): $q_{z_{hwap}} := 0.00256 \cdot K_{z_{hwap}} \cdot K_{zt} \cdot K_d \cdot K_e \cdot (V_{hwap})^2 \cdot \text{psf}$ $q_{z_{hwap}} = 3.30 \cdot \text{psf}$

Force Coefficient Table

Table_Cf :=

"Cf"	0	1	7	25	9999
1	1.3	1.3	1.4	2.0	2.0
2	1.0	1.0	1.1	1.5	1.5
3	1.0	1.0	1.2	1.4	1.4
4	0.5	0.5	0.6	0.7	0.7
5	0.7	0.7	0.8	0.9	0.9
6	0.8	0.8	1.0	1.2	1.2
7	0.7	0.7	0.8	1.2	1.2

Diameter/velocity pressure variables: $Dqz := \frac{D}{\text{ft}} \cdot \sqrt{\frac{q_{z_s}}{\text{psf}}} = 2.66$ $Dqz_{hwap} := \frac{D}{\text{ft}} \cdot \sqrt{\frac{q_{z_{hwap}}}{\text{psf}}} = 1.82$

Applicable row in
 Force Coefficient
 Table:

$CS2 := \begin{cases} CS & \text{if } CS \leq 3 \\ 3 & \text{if } CS = 4 \\ \text{otherwise} \\ \begin{cases} 7 & \text{if } Dqz \leq 2.5 \\ \text{otherwise} \\ \begin{cases} 4 & \text{if } SR \leq 2 \\ 5 & \text{if } SR = 3 \\ 6 & \text{otherwise} \end{cases} \end{cases} \end{cases}$	$= 1$	$CS2_{hwap} := \begin{cases} CS & \text{if } CS \leq 3 \\ 3 & \text{if } CS = 4 \\ \text{otherwise} \\ \begin{cases} 7 & \text{if } Dqz_{hwap} \leq 2.5 \\ \text{otherwise} \\ \begin{cases} 4 & \text{if } SR \leq 2 \\ 5 & \text{if } SR = 3 \\ 6 & \text{otherwise} \end{cases} \end{cases} \end{cases}$	$= 1$
---	-------	---	-------

Force coefficient (service):

$C_{f_s} := \text{Spline}(\text{Table}_{C_f}, CS2, hD)$	$C_{f_s} = 1.97$
---	------------------

Force coefficient (HWAP):

$C_{f_{hwap}} := \text{Spline}(\text{Table}_{C_f}, CS2_{hwap}, hD) = 1.97$	$C_{f_{hwap}} = 1.97$
--	-----------------------

Wind pressure (service):

$P_{wind_s} := q_{z_s} \cdot C_{f_s} \cdot G_w$	$P_{wind_s} = 11.87 \cdot \text{psf}$
---	---------------------------------------

Wind pressure (HWAP):

$P_{wind_{hwap}} := q_{z_{hwap}} \cdot C_{f_{hwap}} \cdot G_w$	$P_{wind_{hwap}} = 5.51 \cdot \text{psf}$
--	---

Linear wind load (service):

$w_{wrap_s} := P_{wind_s} \cdot D$	$w_{wrap_s} = 11.87 \cdot \text{plf}$
------------------------------------	---------------------------------------





Linear wind load (HWAP):

$w_{wrap_{hwap}} := P_{wind_{hwap}} \cdot D$	$w_{wrap_{hwap}} = 5.51 \cdot \text{plf}$
--	---

Wind Loads on Scrim / Signs

This Mathcad sheet calculates the wind pressures on a sign or scrim in accordance with figure 29.3-1 of ASCE 7-16.

Diagrams

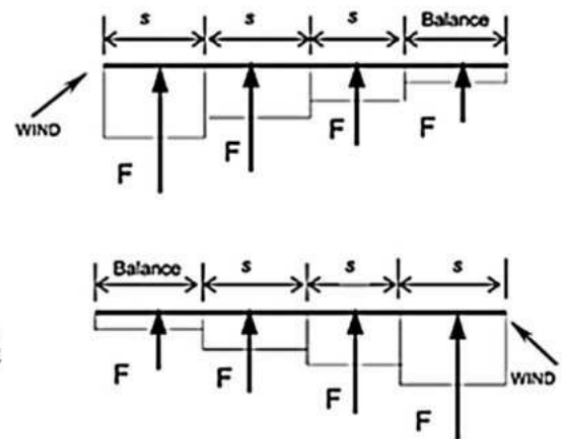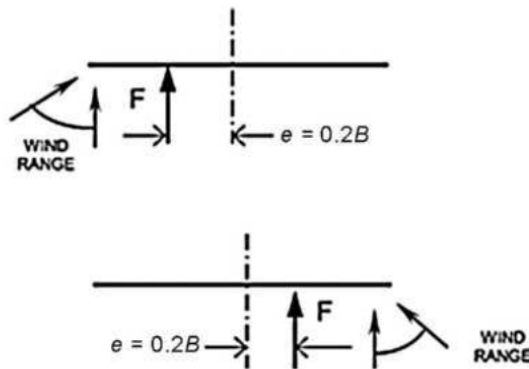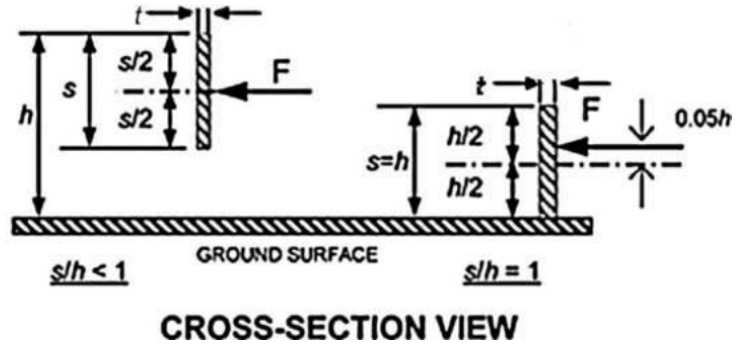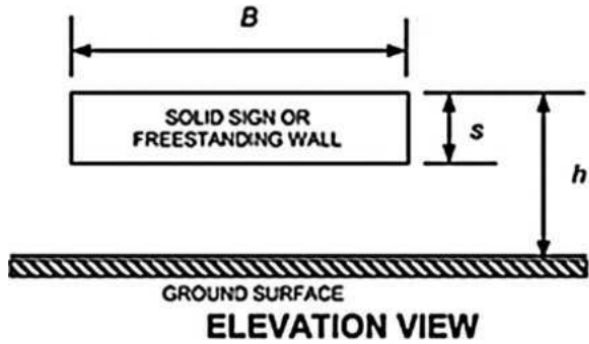

PLAN VIEWS

Top of sign height:

$$h_w := 23 \cdot \text{ft}$$

Sign Width:

$$B := 24 \cdot \text{ft}$$

Vertical dimension of sign:

$$s_w := 23 \cdot \text{ft}$$

Wind directionality factor:

$$K_{d,w} := 0.85$$

Aspect ratio, B/s:

$$B_s := \frac{B}{s} = 1.04$$

Clearance ratio, s/h:

$$s_h := \frac{s}{h} = 1.00$$

Velocity Pressure Exposure Coefficient (service):

$$K_{z_s} := K_{z_F_s}(h)$$

$$K_{z_s} = 0.93$$

Velocity Pressure Exposure Coefficient (HWAP):

$$K_{z_hwap} := K_{z_F_hwap}(h)$$

$$K_{z_hwap} = 0.93$$

Wind velocity pressure (service):

$$q_{h_s} := 0.00256 \cdot K_{z_s} \cdot K_{zt} \cdot K_d \cdot K_e \cdot (V_s)^2 \cdot \text{psf}$$

$$q_{h_s} = 6.64 \cdot \text{psf}$$

Wind velocity pressure (HWAP):

$$q_{h_hwap} := 0.00256 \cdot K_{z_hwap} \cdot K_{zt} \cdot K_d \cdot K_e \cdot (V_{hwap})^2 \cdot \text{psf}$$

$$q_{h_hwap} = 3.09 \cdot \text{psf}$$

Cases A & B:

Case A & B Force Coefficient Table:

Table_CfAB :=

"Cf"	0	0.05	0.1	0.2	0.5	1	2	4	5	10	20	30	45	999
0.0	1.95	1.95	1.90	1.85	1.85	1.80	1.80	1.85	1.85	1.85	1.90	1.90	1.95	1.95
0.16	1.95	1.95	1.90	1.85	1.85	1.80	1.80	1.85	1.85	1.85	1.90	1.90	1.95	1.95
0.2	1.95	1.95	1.90	1.85	1.80	1.80	1.80	1.80	1.80	1.85	1.90	1.90	1.95	1.95
0.3	1.95	1.95	1.90	1.85	1.80	1.80	1.80	1.80	1.80	1.80	1.85	1.85	1.85	1.85
0.5	1.95	1.95	1.85	1.80	1.75	1.75	1.70	1.70	1.70	1.70	1.70	1.70	1.75	1.75
0.7	1.90	1.90	1.85	1.75	1.70	1.65	1.60	1.60	1.55	1.55	1.55	1.55	1.55	1.55
0.9	1.85	1.85	1.75	1.70	1.60	1.55	1.50	1.45	1.45	1.40	1.40	1.40	1.40	1.40
1	1.80	1.80	1.70	1.65	1.55	1.45	1.40	1.35	1.35	1.30	1.30	1.30	1.30	1.30

Case A & B Force Coefficient:

$$C_{f_AB} := \text{Spline}(\text{Table_CfAB}, \text{sh}, \text{Bs})$$

$$C_{f_AB} = 1.45$$

Sign wind pressure (service):

$$P_{\text{sign}_s} := q_{h_s} \cdot C_{f_AB} \cdot G_w$$

$$P_{\text{sign}_s} = 8.18 \cdot \text{psf}$$

Sign wind pressure (HWAP):

$$P_{\text{sign}_hwap} := q_{h_hwap} \cdot C_{f_AB} \cdot G_w$$

$$P_{\text{sign}_hwap} = 3.80 \cdot \text{psf}$$

Total sign wind load (service):

$$P_{\text{sign}_s} := P_{\text{sign}_s} \cdot B \cdot s$$

$$P_{\text{sign}_s} = 4.51 \cdot \text{kip}$$

Total sign wind load (HWAP):

$$P_{\text{sign}_hwap} := P_{\text{sign}_hwap} \cdot B \cdot s$$

$$P_{\text{sign}_hwap} = 2.10 \cdot \text{kip}$$

Horizontal offset for Case B:

$$\text{Offset}_B := 0.2 \cdot B$$

$$\text{Offset}_B = 4.80 \text{ ft}$$

Seismic Loads - Per ASCE 37-14 & ASCE 7-16 (Chapter 12/15)

6.5 EARTHQUAKE

If required by Section 6.5.1 and not exempted by Section 6.5.3, earthquake loads shall be calculated in accordance with procedures in ASCE/SEI 7-10 as modified by Section 6.5.2. All structures shall be treated as Risk Category II, per Table 1.5-1 of ASCE/SEI 7-10, regardless of the group classification of the completed structure.

6.5.1 Applicability Earthquake loads need not be considered unless required by the authority having jurisdiction and the mapped Risk-Targeted MCE_R , 5% damped, spectral response acceleration parameter at a period of 1 s, S_1 , defined in Section 11.4.1 of ASCE/SEI 7-10 equals or exceeds 0.40.

6.5.2 Use of ASCE/SEI 7-10 For use of the earthquake load provisions of ASCE/SEI 7-10, the following modifications should be made:

1. The mapped values for S_s and S_1 may be multiplied by a factor less than 1 to represent the reduced exposure period, but the factor shall not be less than 0.20.
2. The restrictions on types of structural systems in seismic performance categories D and E do not apply, as long as the height of the temporary bracing system designed in accordance with this section is limited in height to 60ft (18.3m) or five stories, whichever is less, above the completed bracing of the permanent structure.

Seismic

S_s	0.191
S_1	0.067
F_a	1.6
F_v	2.4
S_{MS}	0.306
S_{M1}	0.161
S_{DS}	0.204
S_{D1}	0.108
T_L	6
PGA	0.084
PGA_M	0.135
F_{PGA}	1.6
I_e	1
C_v	0.7
Seismic Design Category	B

Seismic Analysis - ASCE 37-14 & ASCE 7-16 (Chapter 12/15)

Site coefficients per ASCE 7-16, Site Class D assumed

Mapped MCE, 5% damped, spectral response, acceleration parameter at short periods: $S_S := 0.191$

Mapped MCE, 5% damped, spectral response, acceleration parameter at 1s: $S_1 := 0.067$

Design 5% damped, spectral response, acceleration parameter at short periods: $S_{DS} := 0.204$

Design 5% damped, spectral response, acceleration parameter at 1s: $S_{D1} := 0.108$

Per ASCE 37-14, does seismic need to be considered? $\text{Consider_seismic} := \begin{cases} \text{"NO"} & \text{if } S_1 < 0.4 \\ \text{"YES"} & \text{otherwise} \end{cases}$ Consider_seismic = "NO"

If seismic is required to be considered:

Temporary reduction coefficient as allowed by ASCE 37-14 (minimum value = 0.2): $\text{red}_{eq} := 0.2$

ASCE 37-14, Section 6.5.2.3:

Response modification factor: $R_{eq} := 2.5$

3. The R factor used for temporary bracing systems shall not exceed 2.5 unless the system is detailed in accordance with the provisions of ASCE/SEI 7-10. Where R = 2.5 is used, only the requirements dealing with the strength of the seismic-resisting structural system need be satisfied.

Importance factor/Risk Category II: $I_e := 1.0$

Structural height (FT): $h_n := 20$

Approximate period parameters (Table 12.8-2, Page 90): $C_t := 0.02$

Long period transition period (Figure 22-12, Page 224): $T_L := 12$

Approximate Fundamental Period: $T_a := C_t \cdot h_n^{.75} = 0.19$

Modified spectral responses with reduction coefficient: $S_{S_mod} := S_S \cdot \text{red}_{eq} = 0.04$ $S_{DS_mod} := S_{DS} \cdot \text{red}_{eq} = 0.04$

$S_{1_mod} := S_1 \cdot \text{red}_{eq} = 0.01$ $S_{D1_mod} := S_{D1} \cdot \text{red}_{eq} = 0.02$

Seismic response coefficient:

$$C_{s,calc} := \min \left[\frac{S_{DS_mod}}{\left(\frac{R_{eq}}{I_e} \right)}, \left[\begin{array}{l} \frac{S_{D1_mod}}{T_a \cdot \left(\frac{R_{eq}}{I_e} \right)} \text{ if } T_a \leq T_L \\ \frac{S_{D1_mod} \cdot T_L}{T_a^2 \cdot \left(\frac{R_{eq}}{I_e} \right)} \text{ if } T_a > T_L \end{array} \right] \right] = 0.016$$

$$C_{s,min} := \left[\begin{array}{l} \max(0.044 \cdot S_{DS_mod} \cdot I_e, 0.01) \text{ if } S_1 < 0.6 \\ \max\left(0.044 \cdot S_{DS_mod} \cdot I_e, 0.01, \frac{0.5 \cdot S_{1_mod}}{\frac{R_{eq}}{I_e}}\right) \text{ if } S_1 \geq 0.6 \end{array} \right] = 0.010$$

$$C_s := \left[\begin{array}{l} 0 \text{ if Consider_seismic} = \text{"NO"} \\ \max(C_{s,calc}, C_{s,min}) \text{ otherwise} \end{array} \right] \quad C_s = 0.000$$

Vertical seismic load effect:

$$EQ_v := \left[\begin{array}{l} 0 \text{ if Consider_seismic} = \text{"NO"} \\ 0.2 \cdot S_{DS_mod} \text{ otherwise} \end{array} \right] \quad EQ_v = 0.000$$

NOTE: WIND LOADS WILL GOVERN SO SEISMIC LOADS CAN BE IGNORED.

Global Stability Review

30mph Wind Stability Checks:

Overturning Stability:

Height of Structure: $h_{\text{structure}} := 24\text{ft}$

Length of Span: $l_{\text{span}} := 24\text{ft}$

Overturning Force: $M_{\text{OT, truss}} := 0.56w_{\text{wrap_hwap}} \cdot (2 \cdot h_{\text{structure}} \cdot 0.55h_{\text{structure}} + l_{\text{span}} \cdot h_{\text{structure}}) = 3.74 \cdot \text{kip} \cdot \text{ft}$

Overturning Force: $M_{\text{OT, sign}} := 0.56 \cdot p_{\text{sign_hwap}} \cdot h_{\text{structure}} \cdot l_{\text{span}} \cdot 0.5 \cdot h_{\text{structure}} = 14.71 \cdot \text{kip} \cdot \text{ft}$

Overturning Force: $M_{\text{OT}} := M_{\text{OT, truss}} + M_{\text{OT, sign}} = 18.44 \cdot \text{kip} \cdot \text{ft}$

Self Weight of Truss: $sw_{\text{truss}} := 6.0\text{plf}$

Length of Outriggers: $l_{\text{outriggers}} := 6\text{ft}$

Linear Footage of Structure: $LF_{\text{truss}} := 2 \cdot h_{\text{structure}} + l_{\text{span}} + 4 \cdot l_{\text{outriggers}} = 96.00\text{ft}$

Dead Load of Structure: $wt_{\text{truss}} := sw_{\text{truss}} \cdot LF_{\text{truss}} = 576.00\text{ lbf}$

Weight of Ballast: $wt_{\text{ballast}} := 2200\text{lbf}$

Depth of Structure: $d_{\text{structure}} := 1\text{ft} + 2 \cdot l_{\text{outriggers}} = 13.00\text{ft}$

Overturning Resistance: $M_{\text{R}} := 0.5 \cdot d_{\text{structure}} \cdot (wt_{\text{truss}} + 4 \cdot wt_{\text{ballast}}) = 60.94 \cdot \text{kip} \cdot \text{ft}$

Overturning Safety Factor: $FS_{\text{ovt}} := \frac{M_{\text{R}}}{M_{\text{OT}}} = 3.30$

Sliding Stability:

Total Sliding: $F_{\text{slide}} := 0.56w_{\text{wrap_hwap}} \cdot (2 \cdot h_{\text{structure}} + l_{\text{span}}) + 0.56 \cdot p_{\text{sign_hwap}} \cdot h_{\text{structure}} \cdot l_{\text{span}} = 1447.97\text{ lbf}$

Sliding Coefficient: $\mu_{\text{slide}} := 0.4$

Weight of Ballast: $W_{\text{tballast, slide}} := wt_{\text{truss}} + 4 \cdot wt_{\text{ballast}} = 9376.00\text{ lbf}$

Sliding Resistance: $F_{\text{res, slide}} := (W_{\text{tballast, slide}}) \cdot \mu_{\text{slide}} = 3750.40\text{ lbf}$

Factor of Safety (Sliding): $FS_{\text{sliding}} := \frac{F_{\text{res, slide}}}{F_{\text{slide}}} = 2.59$

59mph Wind Stability Checks:

Overturning Stability:

Height of Structure: $h_{structure} := 24\text{ft}$

Length of Span: $l_{span} := 24\text{ft}$

Overturning Force: $M_{OT} := w_{wrap_s} \cdot (2 \cdot h_{structure} \cdot 0.55h_{structure} + l_{span} \cdot h_{structure}) = 14.35 \cdot \text{kip} \cdot \text{ft}$

Self Weight of Truss: $sw_{truss} := 6.0\text{plf}$

Length of Outriggers: $l_{outriggers} := 6\text{ft}$

Linear Footage of Structure: $LF_{truss} := 2 \cdot h_{structure} + l_{span} + 4 \cdot l_{outriggers} = 96.00\text{ft}$

Dead Load of Structure: $wt_{truss} := sw_{truss} \cdot LF_{truss} = 576.00\text{ lbf}$

Weight of Ballast: $wt_{ballast} := 2200\text{lbf}$

Depth of Structure: $d_{structure} := 1\text{ft} + 2 \cdot l_{outriggers} = 13.00\text{ft}$

Overturning Resistance: $M_R := 0.5 \cdot d_{structure} \cdot (wt_{truss} + 4 \cdot wt_{ballast}) = 60.94 \cdot \text{kip} \cdot \text{ft}$

Overturning Safety Factor: $FS_{\text{overturning}} := \frac{M_R}{M_{OT}} = 4.25$

Sliding Stability:

Total Sliding: $F_{slide} := w_{wrap_s} \cdot (2 \cdot h_{structure} + l_{span}) = 854.30\text{ lbf}$

Sliding Coefficient: $\mu_{slide} := 0.4$

Weight of Ballast: $Wt_{ballast.slide} := wt_{truss} + 4 \cdot wt_{ballast} = 9376.00\text{ lbf}$

Sliding Resistance: $F_{res.slide} := (Wt_{ballast.slide}) \cdot \mu_{slide} = 3750.40\text{ lbf}$

Factor of Safety (Sliding): $FS_{sliding} := \frac{F_{res.slide}}{F_{slide}} = 4.39$



STRUCTURAL SUBMITTAL PACKAGE

for

Scottsdale Art

Canal Convergence

Project Location: Scottsdale, AZ

Event Dates: November 7-16, 2025

Submittal Date: 10/10/2025

Clark Reder Project Number: 25.701.104

Reviewed by:

Prepared by:



Jeffrey M. Reder, P.E.
AZ Registration #: PE 50654

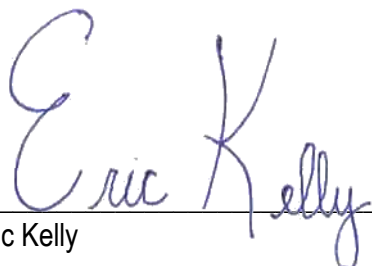

Eric Kelly



Table of Contents for Structural Submittal Package

Cover Page	1
Table of Contents	2
Project Information	3
General Notes	4
Operations Management Plan	5
Reference Drawings	Appendix A
Calculations	Appendix B
Previous Engineering Report.....	Appendix C

Project Information

Project Summary

The project referenced by this submittal consists of a temporary scenic octopus suspended from a truss span bearing on a bridge. The truss and scenic octopus will be installed for Canal Convergence in Scottsdale, Arizona which takes place November 7th - November 16th, 2025.

The scenic octopus and all rigging components weigh a maximum 200 pounds. The octopus was assumed to be placed at midspan of the F34 truss that spans 24'. The truss is bearing on a bridge at each end and will be attached to the bridge via 3" ratchet straps.

Scope of Review

Clark Reder Engineering reviewed the truss span for gravity loads only. Per client, the octopus and all rigging elements weigh a maximum 200 pounds.

No review was performed on the scenic elements or its attachment to the truss. Clark Reder Engineering did not perform any review on the existing bridge or the loads to the existing bridge. The loads to the existing bridge shall be verified by others.

Conclusions

Our review has concluded that the structure meets the structural requirements of the 2018 International Building Code, ASCE 7-16, and ASCE 37-14.

Limitations and Exceptions

The scope of review for this submittal is limited to the items listed above. All other temporary or permanent structures on site not specifically referenced above under "Scope of Review" are the responsibility of others.

Where the items covered by this submittal are attached to existing structures, it is the responsibility of the engineer of record for those existing structures to review the impact of the elements referenced in this submittal.

The Professional Engineering Stamp on this document is for the one-time use of the structure(s) listed in the project summary above for the specific date and event listed. The reuse of this document for other events must be approved in writing by the Professional Engineer listed on the cover sheet.



GENERAL STRUCTURAL NOTES

EVENT DATE & LOCATION

1. EVENT DATE: NOVEMBER 6-17, 2025
2. EVENT LOCATION: SCOTTSDALE, AZ

CODES

1. 2018 INTERNATIONAL BUILDING CODE
2. ASCE 7-16: MINIMUM DESIGN LOADS AND ASSOCIATED CRITERIA FOR BUILDINGS AND OTHER STRUCTURES
3. ASCE 37-14: DESIGN LOADS ON STRUCTURES DURING CONSTRUCTION
4. 2015 ALUMINUM DESIGN MANUAL

REFERENCES

1. ANSI E1.21-2013 ENTERTAINMENT TECHNOLOGY, "TEMPORARY GROUND-SUPPORTED OVERHEAD STRUCTURES USED TO COVER THE STAGE AREAS AND SUPPORT EQUIPMENT IN THE PRODUCTION OF OUTDOOR ENTERTAINMENT EVENTS"
2. ANSI E1.2-2012 ENTERTAINMENT TECHNOLOGY, "DESIGN, MANUFACTURE AND USE OF ALUMINUM TRUSSES AND TOWERS"

DESIGN LOADS

1. DEAD LOAD: SELF-WEIGHT OF STRUCTURE
2. RIGGING LOADS: 200-POUND SCENIC OCTOPUS
3. WIND LOADS: CRE REVIEWED FOR GRAVITY LOADS ONLY. OCTOPUS PREVIOUSLY REVIEWED FOR 55MPH WINDS.
4. SEISMIC LOADS DO NOT CONTROL THE DESIGN OF THIS STRUCTURE.

CONSTRUCTION AND SAFETY

1. ENGINEER SHALL NOT BE RESPONSIBLE FOR MEANS, METHODS, OR SEQUENCE OF CONSTRUCTION UNLESS SPECIFICALLY STATED ON THE DRAWINGS.
2. ENGINEER HAS DESIGNED THE STRUCTURES FOR THEIR FINAL AS-BUILT CONDITION. ENGINEER IS NOT RESPONSIBLE FOR TEMPORARY STABILITY OF STRUCTURES DURING ERECTION UNLESS SPECIFICALLY STATED ON THE DRAWINGS.
3. STRUCTURE HAS BEEN DESIGNED AS A TEMPORARY STRUCTURE THAT SHALL BE IN PLACE FOR LESS THAN SIX WEEKS.

RIGGING

1. ALL POINTS SHALL BE DEAD HUNG POINTS.
2. ALL RIGGING SHALL BE HUNG FROM PANEL POINTS (LOCATIONS ON THE TRUSS CHORDS BRACED BOTH VERTICALLY AND HORIZONTALLY) UNLESS SPECIFICALLY APPROVED BY THE ENGINEER OF RECORD.
3. BRIDLES SHALL NOT BE USED UNLESS SPECIFICALLY ALLOWED BY THE ENGINEER OF RECORD.

ALUMINUM TRUSS

1. ALUMINUM TRUSS SHALL BE MANUFACTURED BY GLOBAL TRUSS OR AN APPROVED EQUAL.
2. TRUSS TO TRUSS CONNECTION HARDWARE (UNLESS NOTED OTHERWISE):
 - A. CONICAL COUPLER: 2007-T4 ALUMINUM
 - B. CONICAL ADAPTER: 6082-T6 ALUMINUM
 - C. COUPLER PIN: 42CRMOS4
3. TRUSS END PLATE BOLTS SHALL BE TIGHTED TO THE SNUG TIGHT CONDITION. SNUG TIGHT CONDITION EXISTS WHEN ALL PLIES IN THE CONNECTION HAVE BEEN PULLED INTO FIRM CONTACT BY THE BOLTS AND ALL BOLTS HAVE BEEN TIGHTENED SUFFICIENTLY TO PREVENT REMOVAL OF THE NUTS WITHOUT THE USE OF WRENCH.
4. UNLESS NOTED OTHERWISE, ALL LOADS SHALL BE APPLIED TO TRUSSES AT PANEL POINTS.
5. RATED SPANS, CAPACITIES AND LOADING CONDITIONS PUBLISHED BY THE TRUSS MANUFACTURER SHALL NOT BE EXCEEDED UNLESS REVIEWED AND APPROVED BY A LICENSED ENGINEER FOR A SPECIFIC USE.
6. DO NOT PLACE LIGHTING CLAMPS OR WIRE ROPE IN DIRECT CONTACT WITH THE TRUSS UNLESS THE CHORD MATERIAL IS PROTECTED FROM DAMAGE DUE TO OVERTIGHTENING OR WIRE ROPE RUBBING.

INSPECTIONS

1. ALL TRUSS UNITS, SCAFFOLD AND/OR OTHER RIGGING EQUIPMENT SHALL BE VISUALLY INSPECTED PRIOR TO ERECTION. DAMAGED OR CORRODED EQUIPMENT SHALL NOT BE USED. FIELD MODIFICATIONS SHALL BE APPROVED BY THE ENGINEER OF RECORD PRIOR TO INSTALLATION.



OPERATIONS MANAGEMENT PLAN

IMPLEMENTATION OF PLAN

1. PRIOR TO EACH INSTALLATION, THE TRUSS PROVIDER IN CONJUNCTION WITH THE VENUE, SHALL DESIGNATE A RESPONSIBLE PERSON IN CHARGE OF IMPLEMENTING ALL PHASES OF THE OPERATIONS MANAGEMENT PLAN AS IT PERTAINS TO THE STRUCTURE.
2. A MEETING SHALL BE HELD AT THE VENUE WITH THE PROMOTER, OWNER OR STAGE MANAGER TO DISCUSS THE HIGH WIND ACTION PLAN AND OTHER OPERATIONAL ITEMS.

DAILY OPERATIONS PLAN

1. CHECK WEATHER EACH MORNING AND PERIODICALLY THROUGHOUT THE DAY.
2. CHECK TOWER BASES DAILY TO ENSURE ALL REMAIN LEVEL AND PLUMB
3. CHECK GUY WIRES AND BALLAST ASSEMBLIES DAILY TO VERIFY LINES ARE TENSIONED AND BALLAST HAS NOT MOVED.
4. PROVIDE A DAILY LOG OF THE ABOVE CHECKS FOR EACH INSTALLATION.

HIGH WIND ACTION PLAN

1. THE HIGH WIND ACTION PLAN SHALL BE IN EFFECT FOR THE ENTIRETY OF THE INSTALLATION. AN INSTALLATION SHALL BE DEFINED AS STARTING AT THE INITIAL COMMENCEMENT OF THE STRUCTURE INSTALLATION AND ENDING ONCE THE STRUCTURE IS COMPLETELY DISMANTLED.
2. A COMPETENT RESPONSIBLE PERSON FROM THE TRUSS PROVIDER OR VENUE SHALL BE PRESENT FOR THE DURATION OF THE EVENT TO IMPLEMENT THE HIGH WIND ACTION PLAN (SEE ABOVE).
3. A REGULAR LIAISON WITH LOCAL AIRPORTS AND/OR WEATHER INFORMATION CENTERS SHALL BE MAINTAINED TO ASCERTAIN IF ANY SIGNIFICANT WEATHER EVENTS ARE EXPECTED IN THE IMMEDIATE VICINITY OF THE STRUCTURE
4. AN ANEMOMETER SHALL BE PLACED ON THE STRUCTURE TO MONITOR WIND SPEEDS. THE ANEMOMETER SHALL BE PLACED AT THE TOP OF A TOWER OR AN ADJACENT STRUCTURE AT A HEIGHT EQUIVALENT TO THE HEIGHT OF THE TOWER. THE ANEMOMETER SHALL BE LOCATED WITHIN 50 YARDS OF THE STRUCTURE.
5. NOTED WIND SPEEDS ARE 3-SECOND GUSTS IN ACCORDANCE WITH ASCE 7
6. **WHEN THE STRUCTURE IS UNATTENDED OR NOT IN USE:** OCTOPUS SHALL BE REMOVED FROM THE TRUSS IF WINDS ARE EXPECTED TO EXCEED 30MPH WHILE UNATTENDED.
7. **WHEN WIND SPEEDS ARE EXPECTED TO EXCEED 30 MPH:** A TEAM OF QUALIFIED PERSONNEL SHALL BE PUT ON ALERT. ALL NECESSARY PERSONNEL SHALL BE IN PLACE AND PUT ON STANDBY.
8. **WHEN WIND SPEEDS ARE EXPECTED TO EXCEED 40 MPH:**
 - a. ALL SHOW OPERATIONS SHALL BE SUSPENDED, AND THE IMMEDIATE AREA SHALL BE EVACUATED OF ALL PATRONS AND NON-ESSENTIAL PERSONNEL.
 - b. OCTOPUS SHALL BE LOWERED AND/OR COMPLETELY REMOVED FROM THE TRUSS.
9. **AT WINDS SPEEDS IN EXCESS OF 50 MPH:** ALL PERSONNEL SHOULD MAINTAIN SAFE DISTANCE FROM THE STRUCTURE.
10. THE HIGH WIND ACTION PLAN SHALL BE POSTED AT A CONSPICUOUS AREA ON SITE. IT MUST BE AVAILABLE AT ALL TIMES TO VENUE OPERATORS AND CREW.
11. FAILURE TO FOLLOW THE HIGH WIND ACTION PLAN MAY RESULT IN COLLAPSE OF THE STRUCTURE, DAMAGE TO EQUIPMENT AND INJURY TO PERSONS.

PLAN EXCEPTIONS

1. THIS PLAN IS SPECIFIC TO THE STRUCTURE LISTED IN THIS SUBMITTAL. THE EVENT OPERATIONS MANAGEMENT PLAN, IF MORE STRINGENT, SHALL BE FOLLOWED.



APPENDIX A

REFERENCE DRAWINGS

DRAWINGS ADDED FOR REFERENCE ONLY.

DESIGNWORKSHOP

Landscape Architecture • Land Planning
Urban Design • Tourism Planning

Asheville • Aspen • Denver • Jackson Hole
Park City • Santa Fe • Tempe • Lake Tahoe • Vail

310 S. Mill Avenue, Suite 201
Tempe, Arizona 85281
(480) 966-5881
Facsimile (480) 966-2799


WWW.DESIGNWORKSHOP.COM

OWNER

CITY OF SCOTTSDALE

7447 E. MCDONALD SCHOOL RD. SCOTTSDALE, AZ 85261
480-312-7895

**Arizona Canal
at Scottsdale - Phase I**
Scottsdale, Arizona

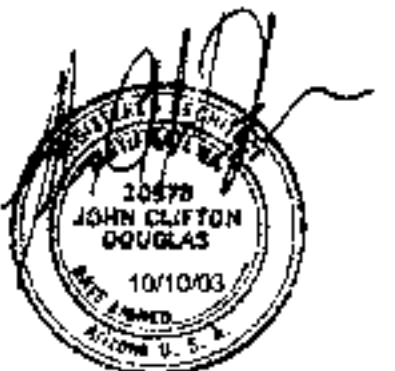

DOUGLAS

Architecture and Planning, P.C.
7522 East McDonald Drive, Scottsdale Arizona 85250

BID DOCUMENTS
PHASE ONE

**BRIDGE FLOOR
PLAN**

ISSUED FOR: BID DOCUMENTS

ISSUE DATE: OCTOBER 10, 2003


REVISIONS

#	DATE	DESCRIPTION

DRAWN: GSC REVIEWED: JCD


PROJECT NUMBER: 2829

© COPYRIGHT DESIGNWORKSHOP, INC.

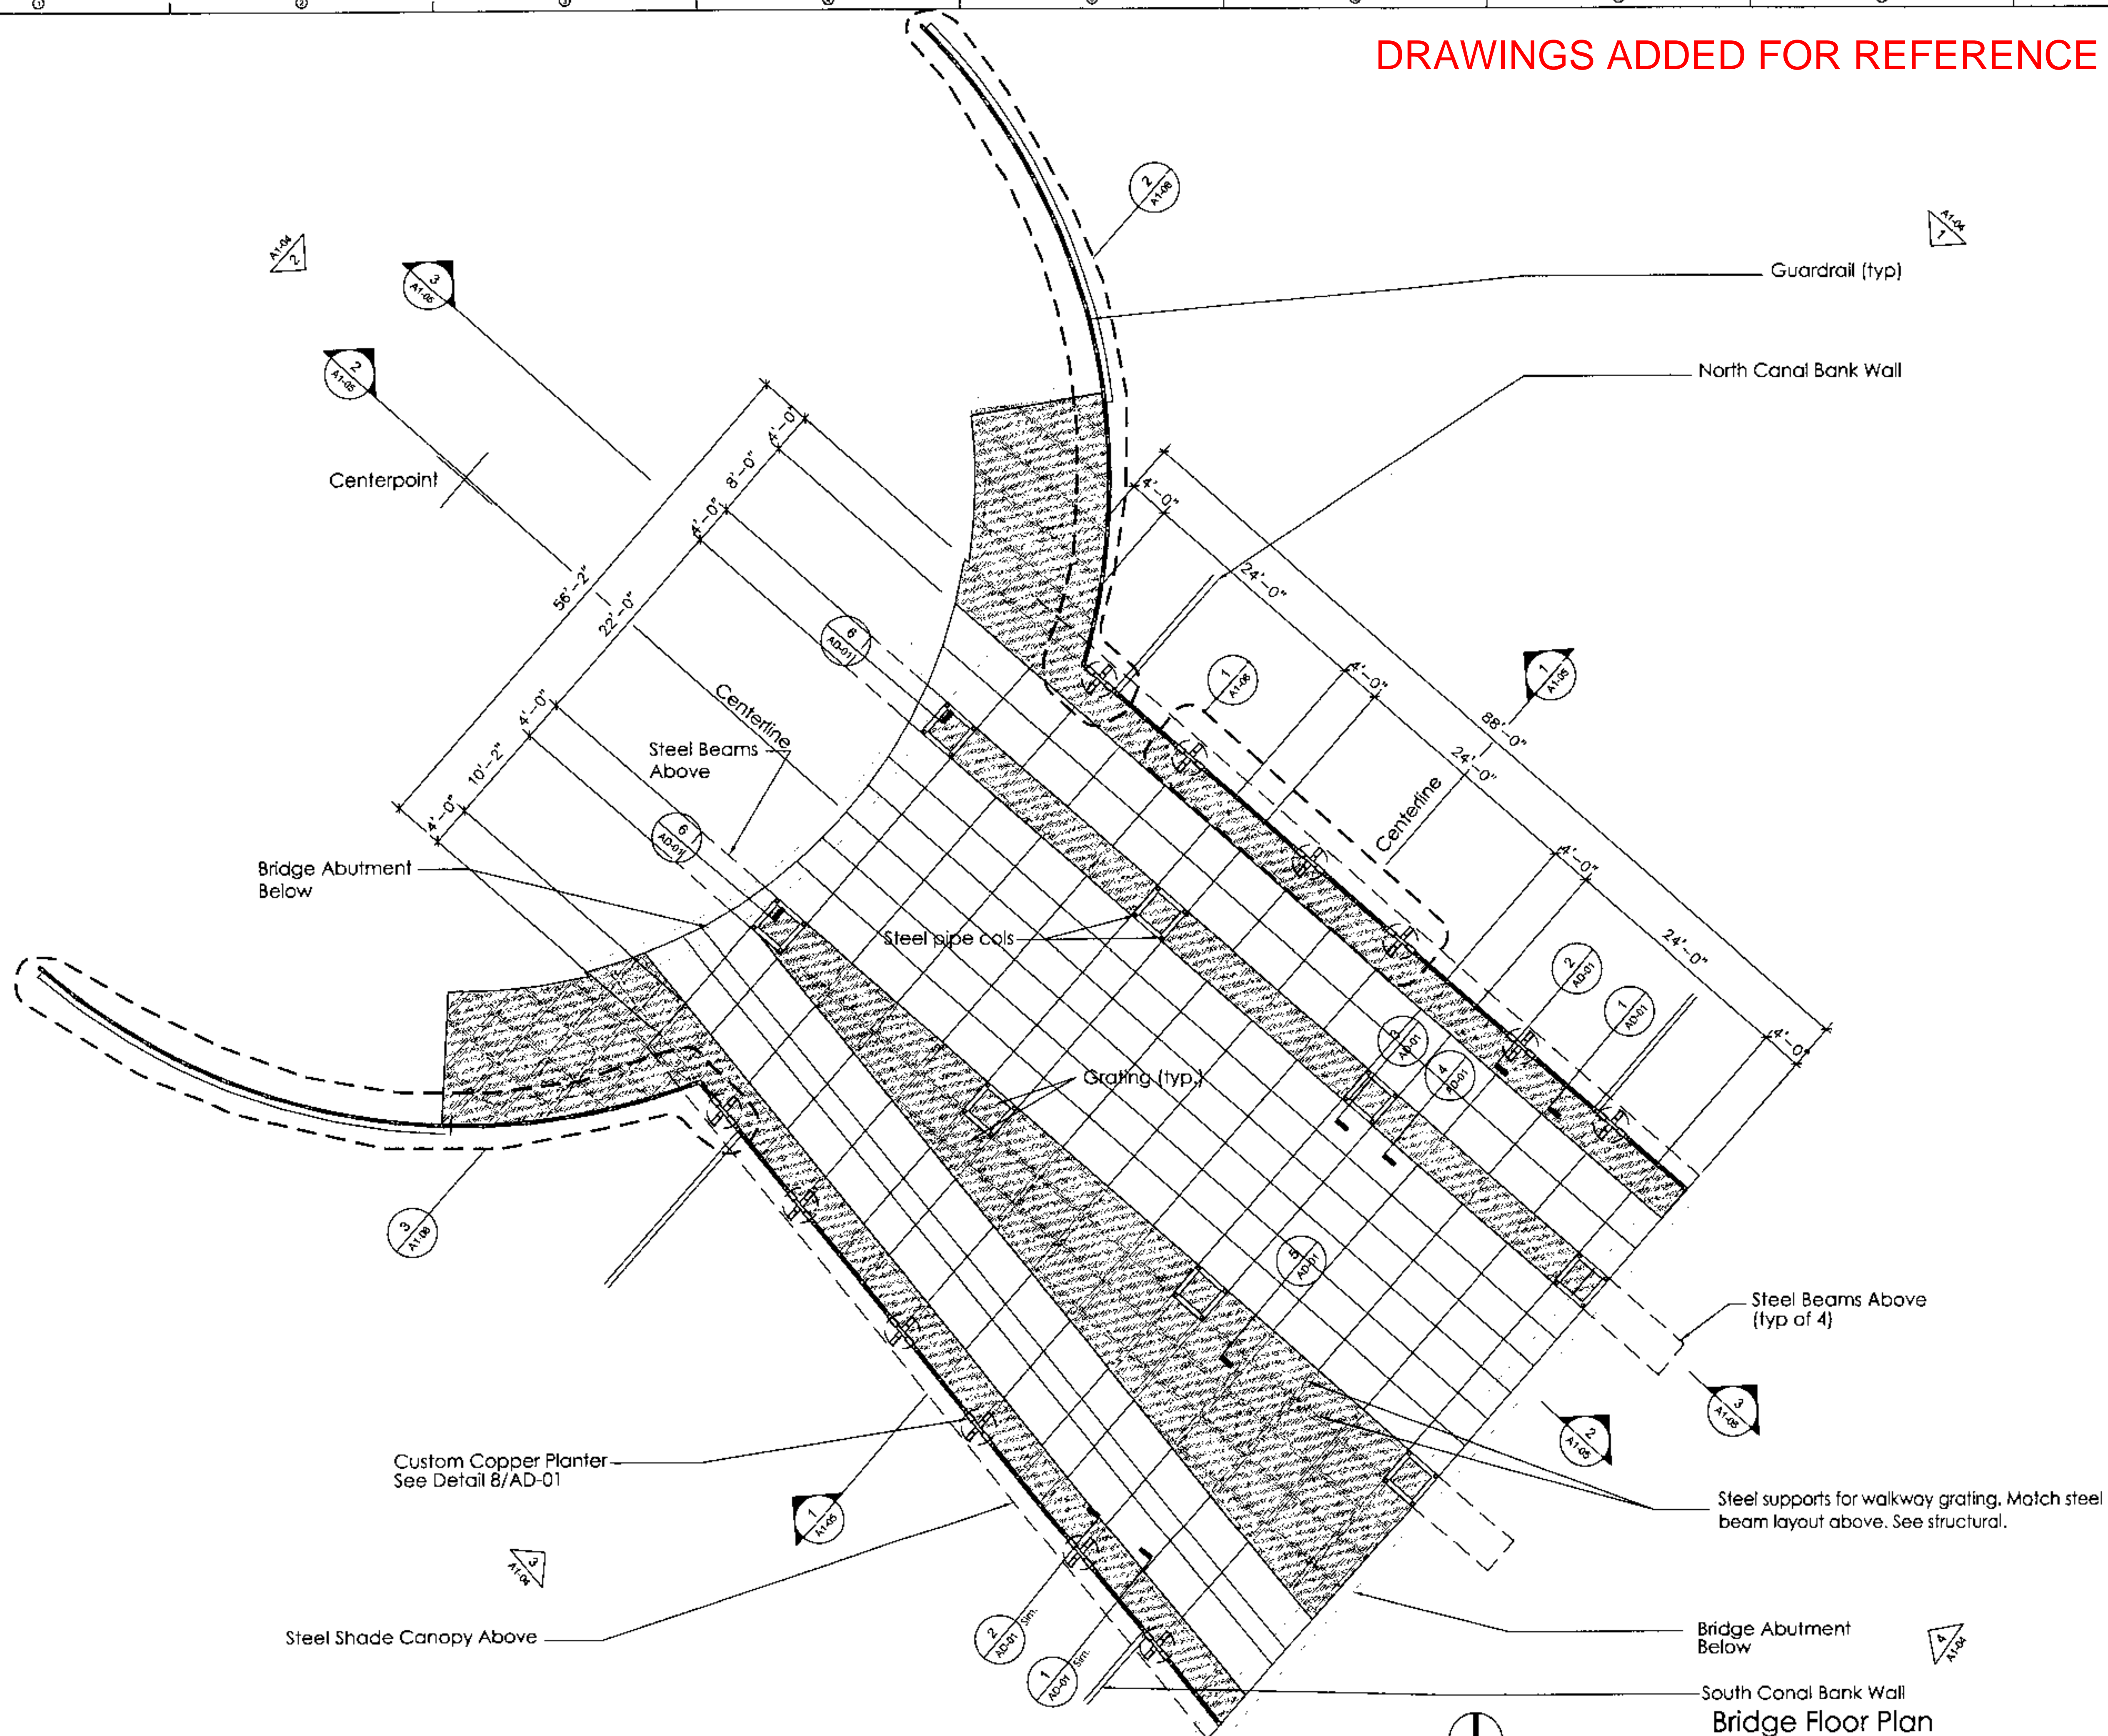


General Notes:
1-Refer to Structural Drawings for further information on bridge and abutment construction.
2-Provide shop drawings for all steel, including guardrails, grating, perf. metal, and structure.

SCALE: 1/8" = 1'-0"

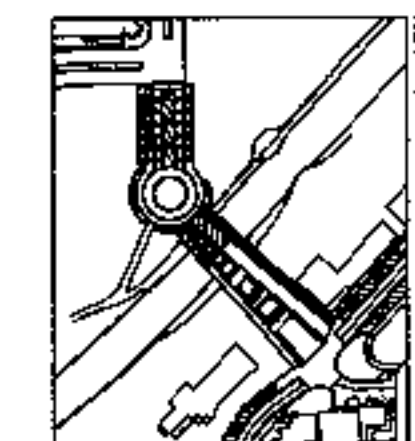

MUNICIPAL SERVICES DEPARTMENT		CAPITAL PROJECT MANAGEMENT	
3939 DRINKWATER BLVD. SCOTTSDALE, ARIZONA 85251			
PROJECT TITLE: ARIZONA CANAL AT SCOTTSDALE-PHASE I			
DESIGNED BY:	DATE: 10-10-03	BD NO: W04PB034	SHT: A1-01
DRAWN BY:	AS-BUILT	PROJECT NO: 2829	65 OF 89

Arizona Canal
at Scottsdale - Phase I
Scottsdale, Arizona

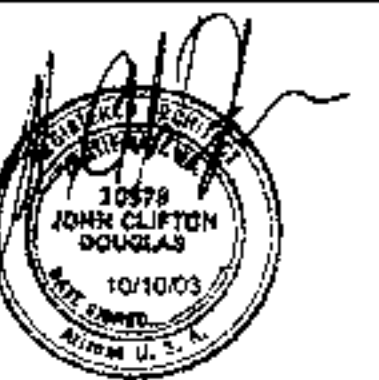

DOUGLAS
Architecture and Planning, P.C.
7522 East McDonald Drive, Scottsdale Arizona 85250

BID DOCUMENTS
PHASE ONE

BRIDGE ROOF
PLAN

ISSUED FOR: BID DOCUMENTS

ISSUE DATE: OCTOBER 10, 2008


REVISIONS

DATE DESCRIPTION

DRAWN: GC REVIEWED: JCD

PROJECT NUMBER: 2829

© COPYRIGHT DESIGNWORKSHOP, LLC

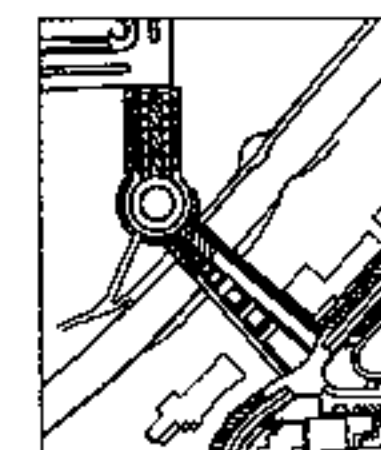


REVISION BY

MUNICIPAL SERVICES DEPARTMENT
CAPITAL PROJECT MANAGEMENT

3939 DRINKWATER BLD.
SCOTTSDALE, ARIZONA 85251

PROJECT TITLE
ARIZONA CANAL AT SCOTTSDALE-PHASE I

DESIGNED BY	DATE	REV. NO.	SHEET
AS-BUILT	10-10-08	#04PB034	A1-02
DRAWN BY	PROJECT NO.	PROJECT NO.	88 OF 89
	2829		

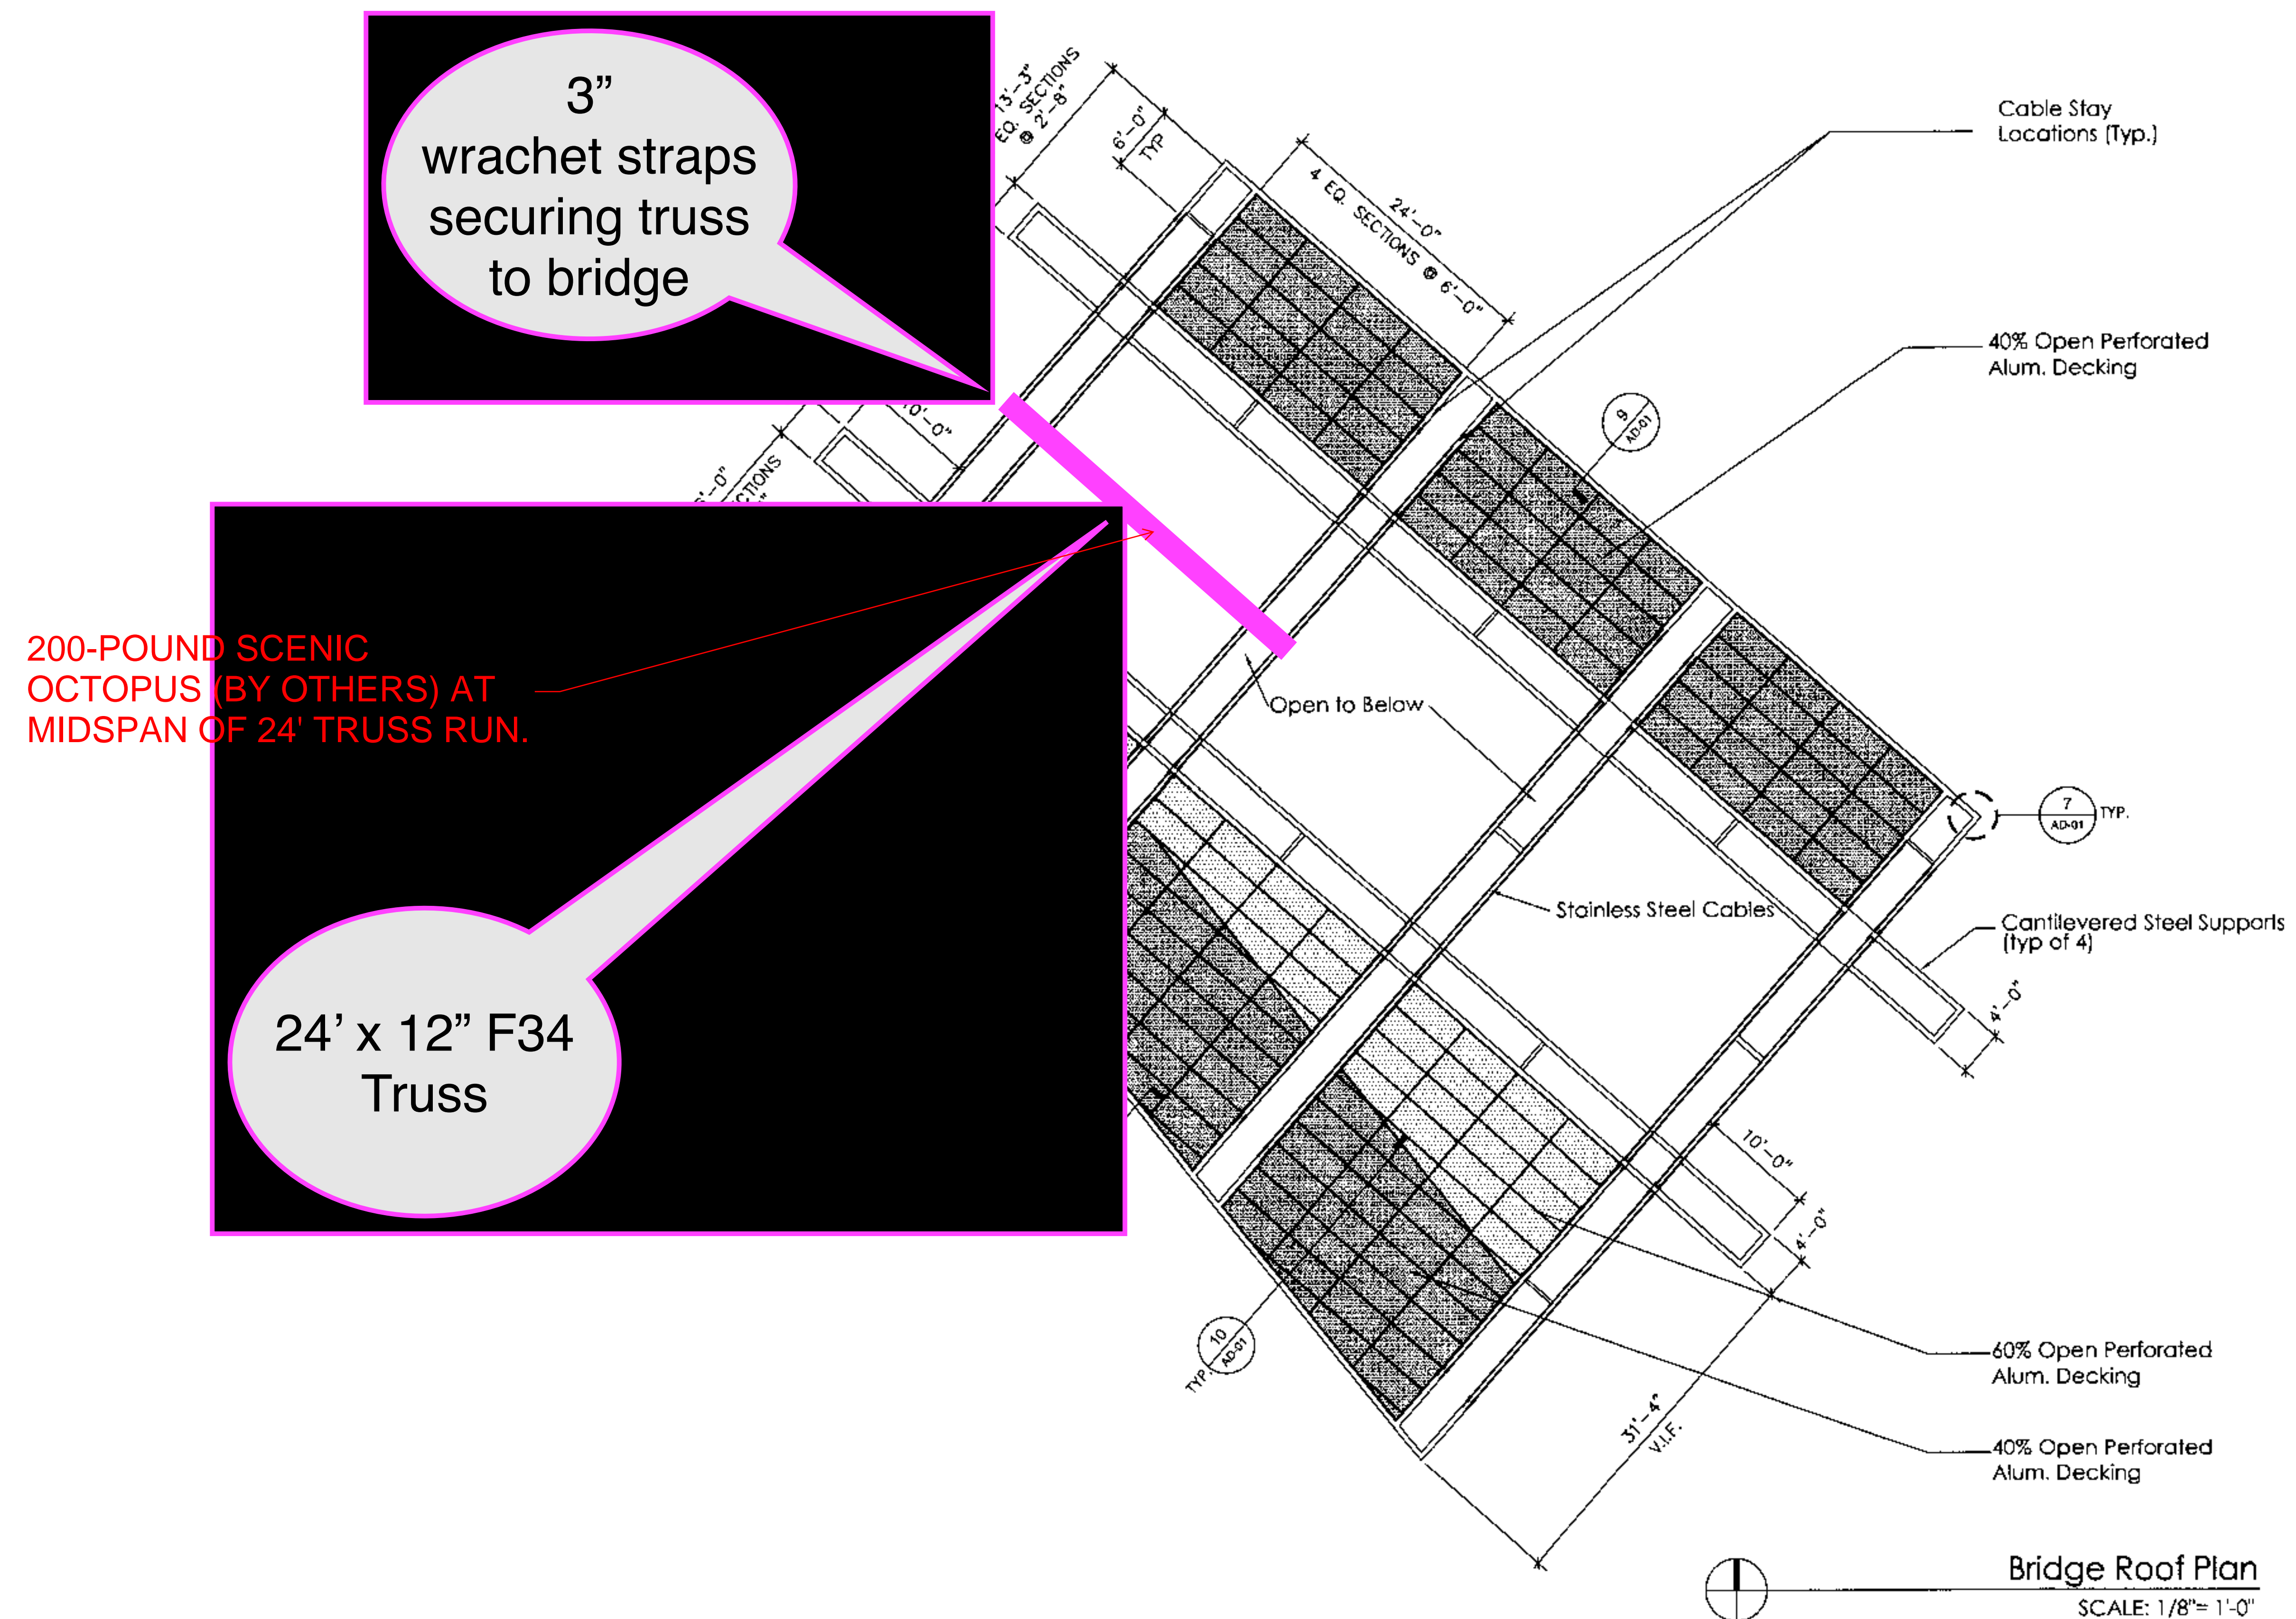

General Notes:
 1-Refer to Structural Drawings for further information on bridge and abutment construction.
 2-Provide shop drawings for all steel, including guardrails, grating, perf. metal, and structure.

DESIGNWORKSHOP

Landscape Architecture • Land Planning
Urban Design • Tourism Planning

Asheville • Aspen • Denver • Jackson Hole
Park City • Santa Fe • Tempe • Lake Tahoe • Vail


310 S. Mill Avenue, Suite 201
Tempe, Arizona 85281
(480) 966-5881
Facsimile (480) 966-2799

WWW.DESIGNWORKSHOP.COM

OWNER
CITY OF SCOTTSDALE

7447 E. INDIAN SCHOOL RD. SCOTTSDALE, AZ. 85251
480-312-7898

**Arizona Canal
at Scottsdale - Phase I
Scottsdale, Arizona**

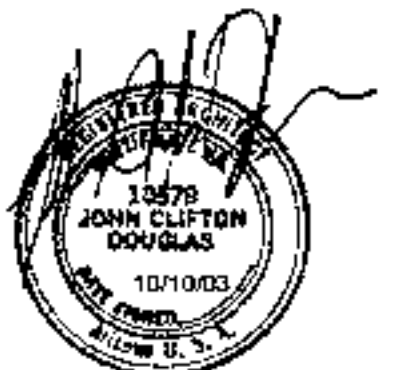

DOUGLAS
Architecture and Planning, P.C.
7522 East McDonald Drive, Scottsdale Arizona 85250

BID DOCUMENTS
PHASE ONE

**BRIDGE ROOF
FRAMING PLAN**

**APPROVED
FINAL PLANS PLANNING**

DATE _____ APPROVED BY _____

ISSUED FOR: BID DOCUMENTS

ISSUE DATE: OCTOBER 10, 2000


REVISIONS

#	DATE	DESCRIPTION

DRAWN: GC REVIEWED: JCD

PROJECT NUMBER: 2829

© COPYRIGHT DESIGNWORKSHOP, INC.

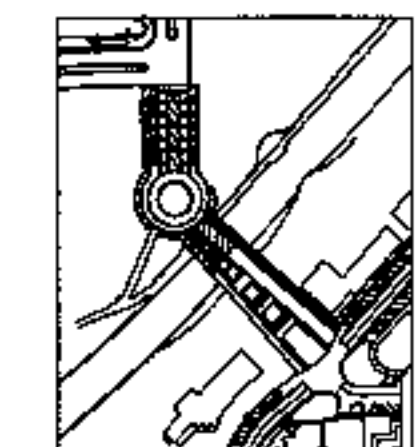

BY _____

**MUNICIPAL SERVICES
DEPARTMENT
CAPITAL PROJECT
MANAGEMENT**

3939 DRINKWATER BLVD.
SCOTTSDALE, ARIZONA 85251


PROJECT TITLE
ARIZONA CANAL AT SCOTTSDALE-PHASE I

DESIGNED BY	DATE	BID NO.	SHT.
AS-BUILT	10-10-03	#04PB034	A1-03
DRAWN BY	PROJECT NO.	67 OF 89	
	2829		

12" F34 Truss
suspension beam


Octopoda
suspended under
Truss Beam

200-POUND SCENIC
OCTOPUS (BY OTHERS) AT
MIDSPAN OF 24' TRUSS RUN.

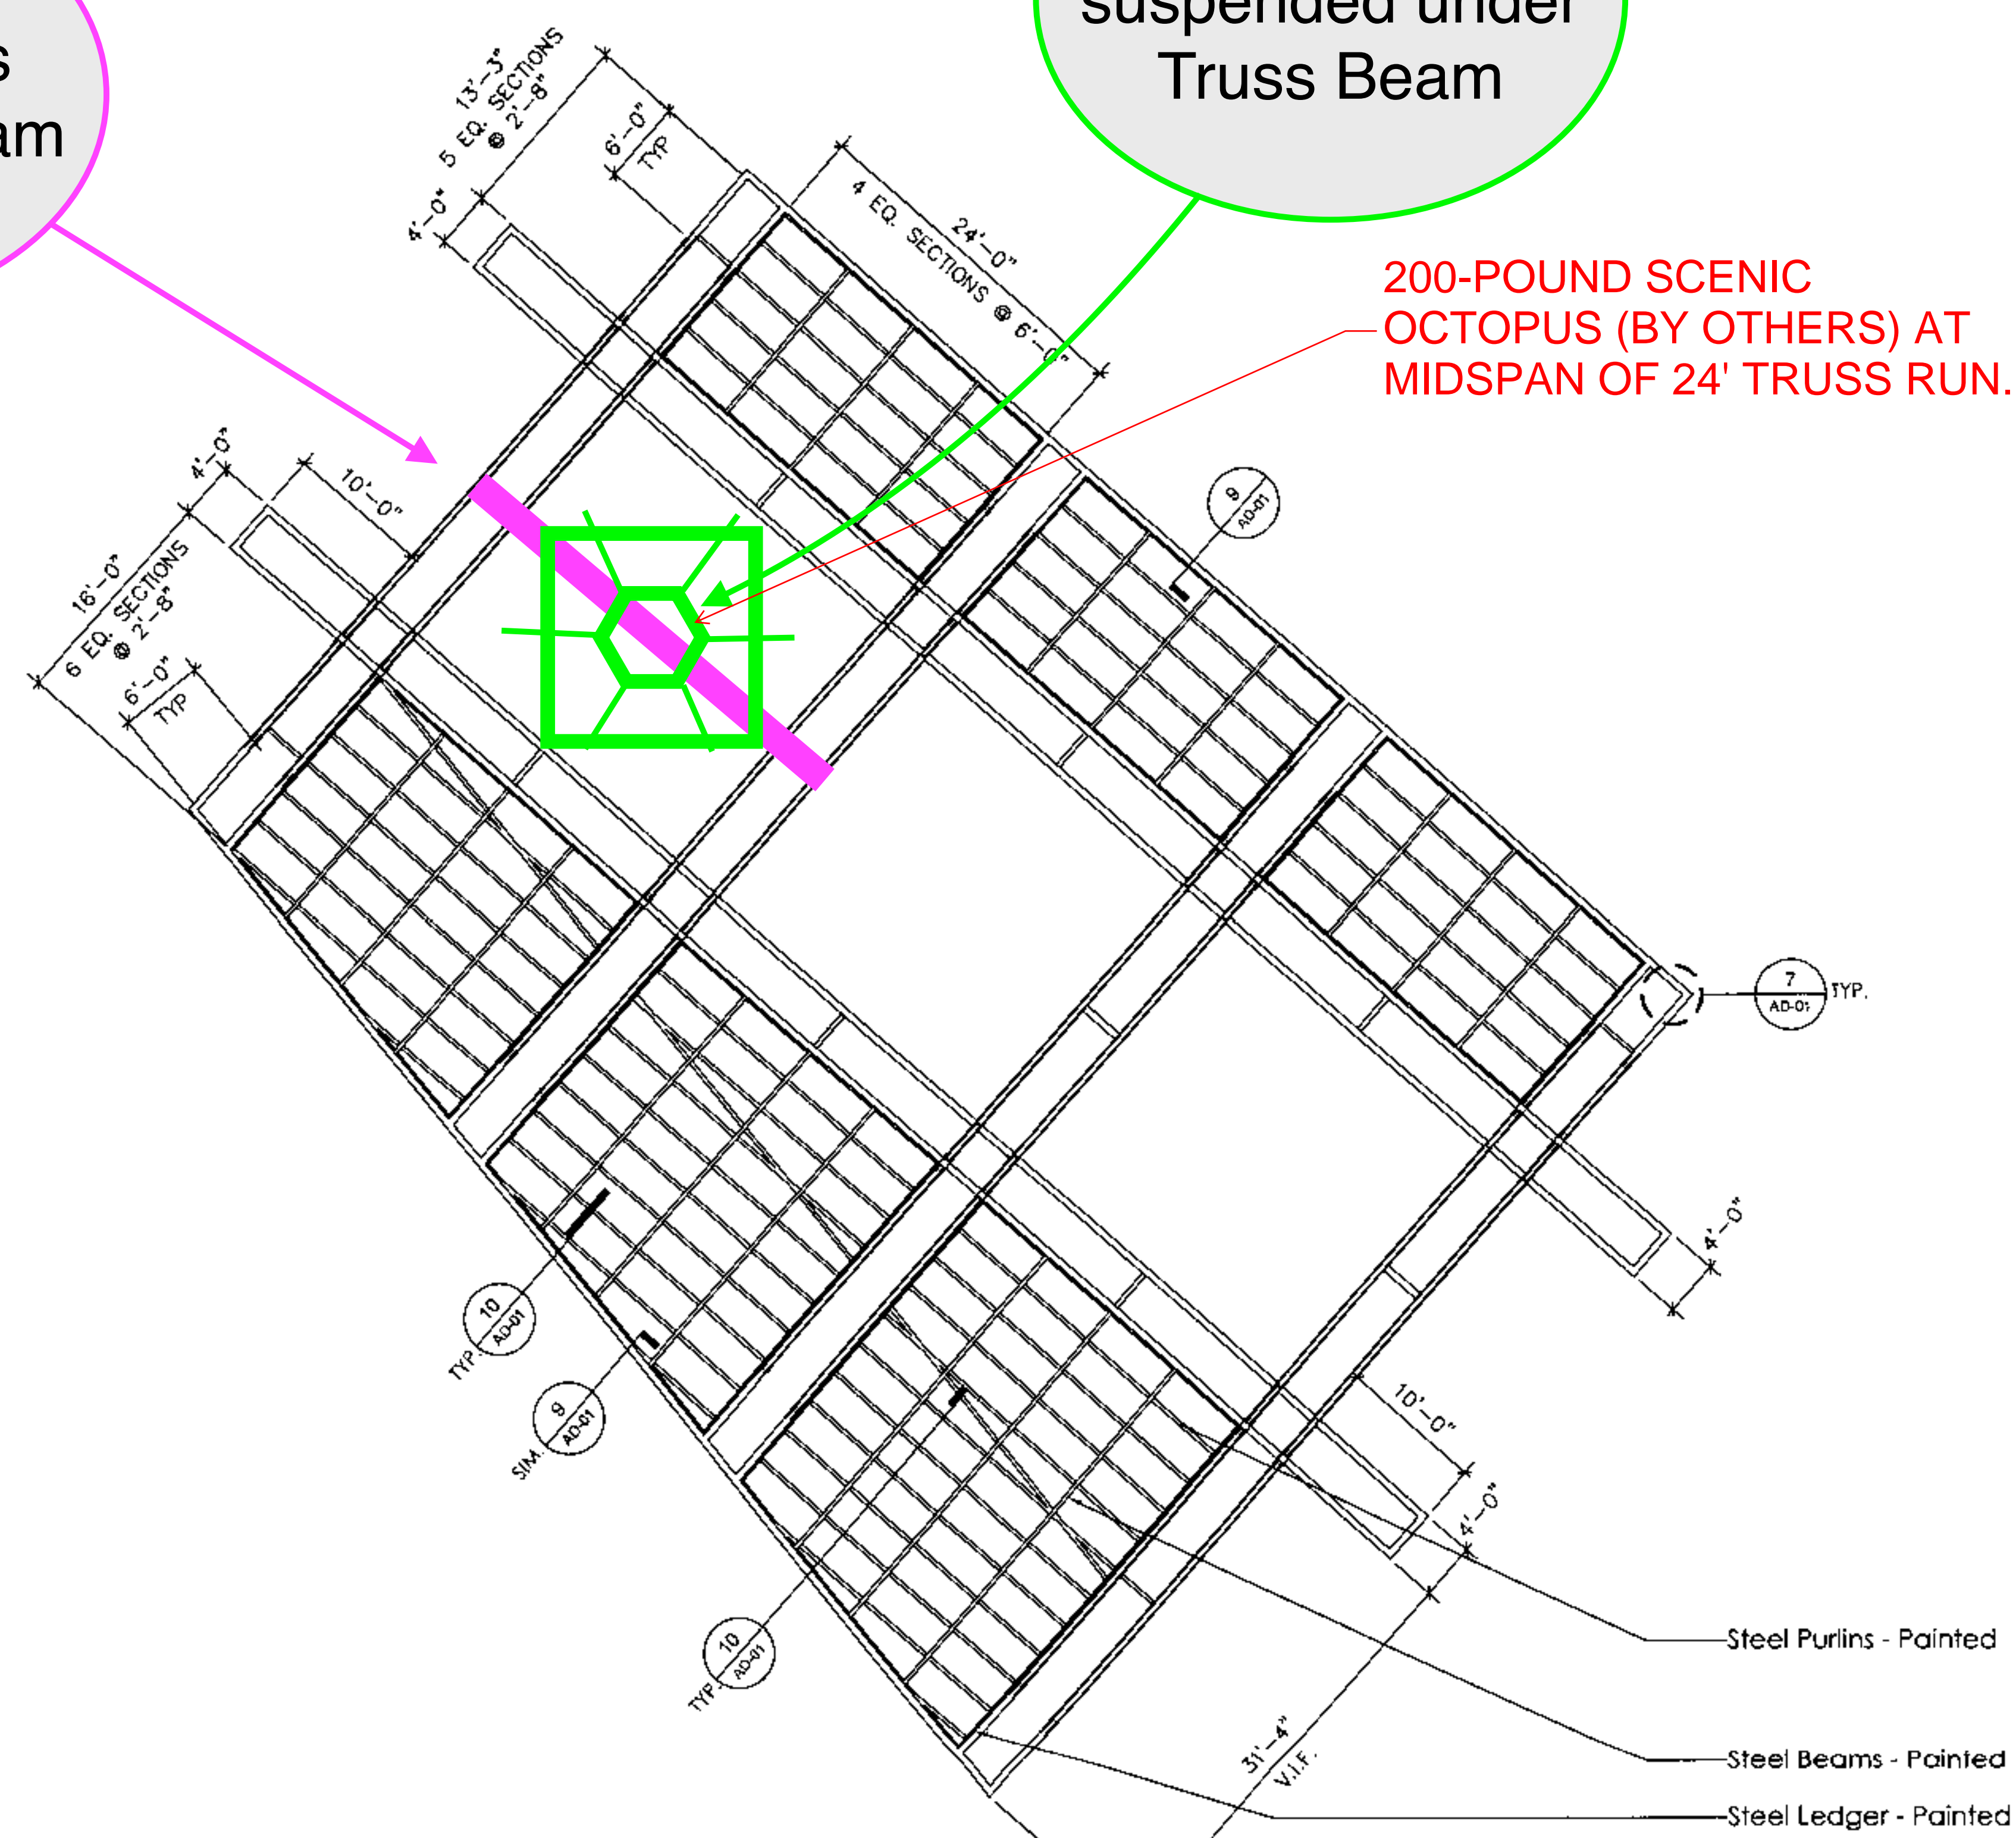

General Notes:
1-Refer to Structural Drawings for further information on bridge and abutment construction.
2-Provide shop drawings for all steel, including guardrails, grating, perf. metal, and structure.

**Arizona Canal
at Scottsdale - Phase I**
Scottsdale, Arizona

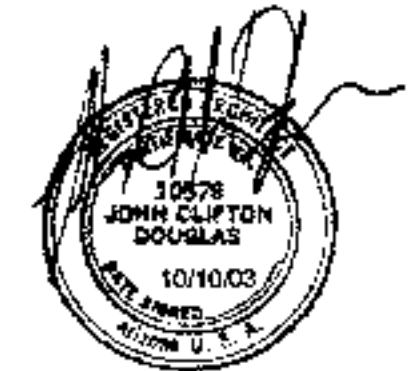

DOUGLAS
Architecture and Planning, P.C.
7522 East McDonald Drive, Scottsdale Arizona 85250

BID DOCUMENTS
PHASE ONE

**BRIDGE
ELEVATIONS**

ISSUED FOR: BID DOCUMENTS

ISSUE DATE: OCTOBER 10, 2003

REVISIONS


#	DATE	DESCRIPTION

ELEVATION GENERAL NOTES:


A. Bridge height set of 16'-0" to top of fascia above final paving elevation at North side of structure. Grades shall drop 1% moving to the Southeast, but the elevation of the bridge roof structure shall remain constant.

ELEVATION KEYNOTES:


1. CUSTOM COPPER PLANTER
2. STEEL GUARDRAIL
3. PERFORATED ALUMINUM PANEL, 60% OPEN
4. CANTILEVERED STEEL SUPPORT
5. CONCRETE BEAM
6. BRIDGE ABUTMENT
7. STEEL SHADE CANOPY
8. CABLE STAY SYSTEM
9. WING WALL

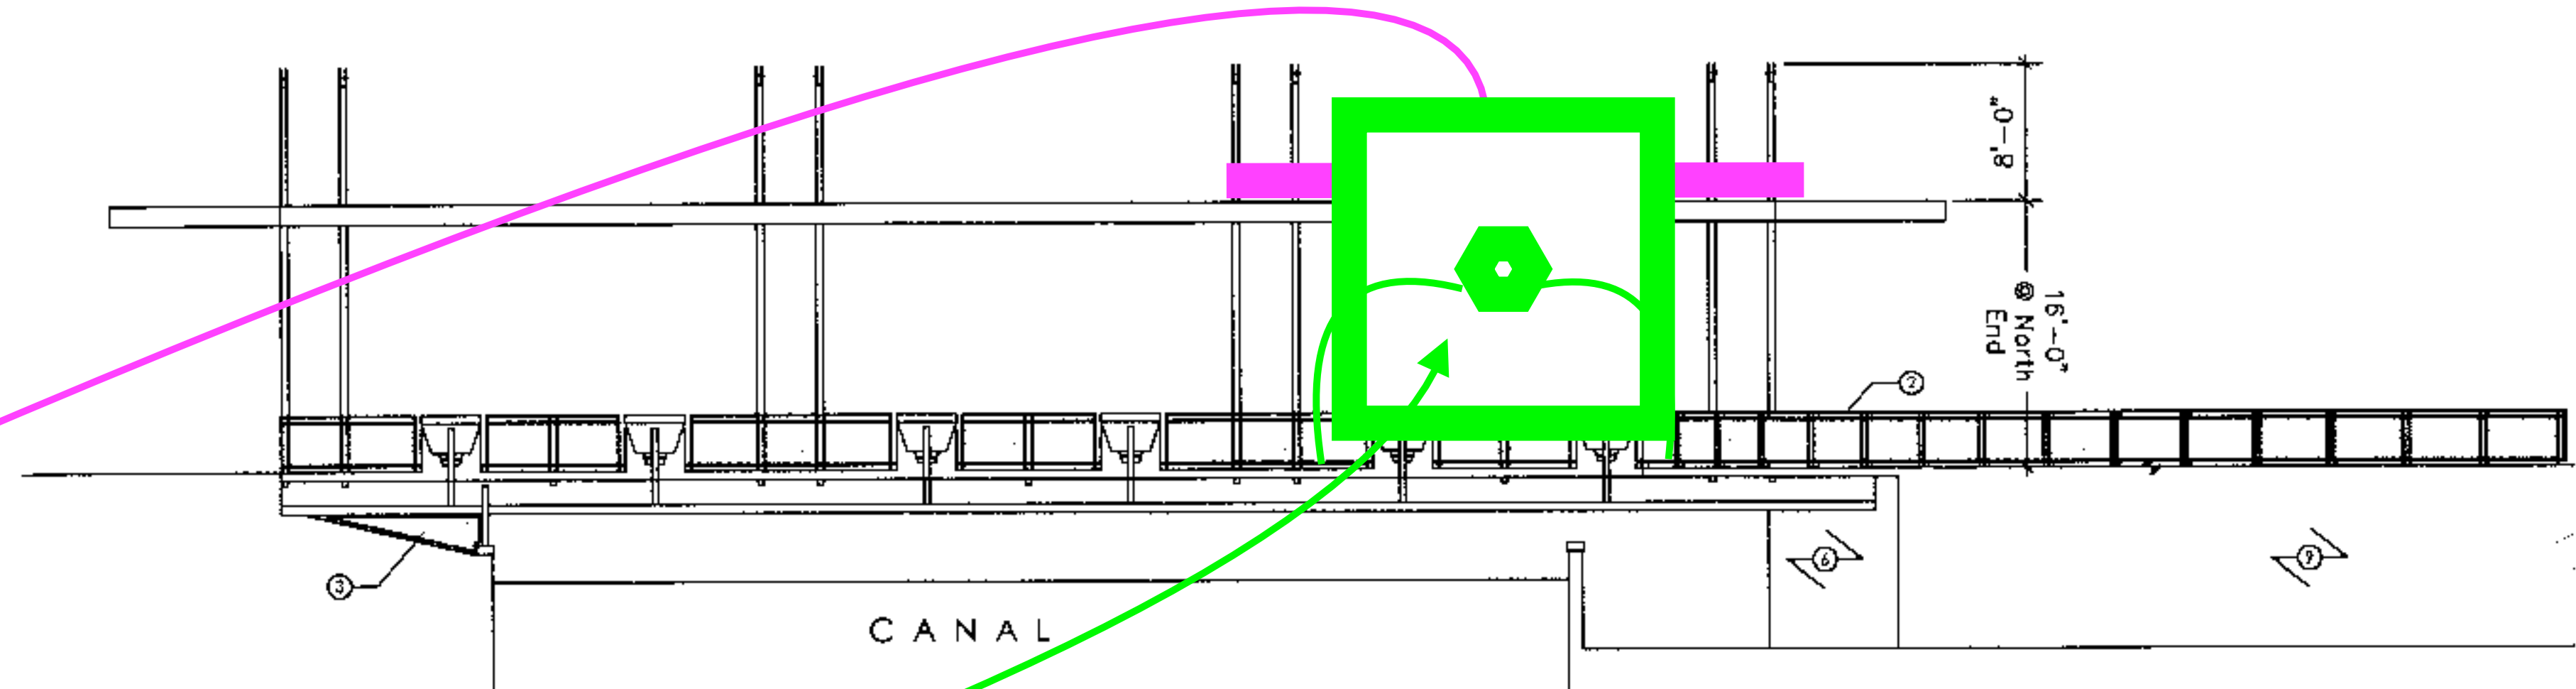


1 North Elevation
SCALE: 1/8" = 1'-0"

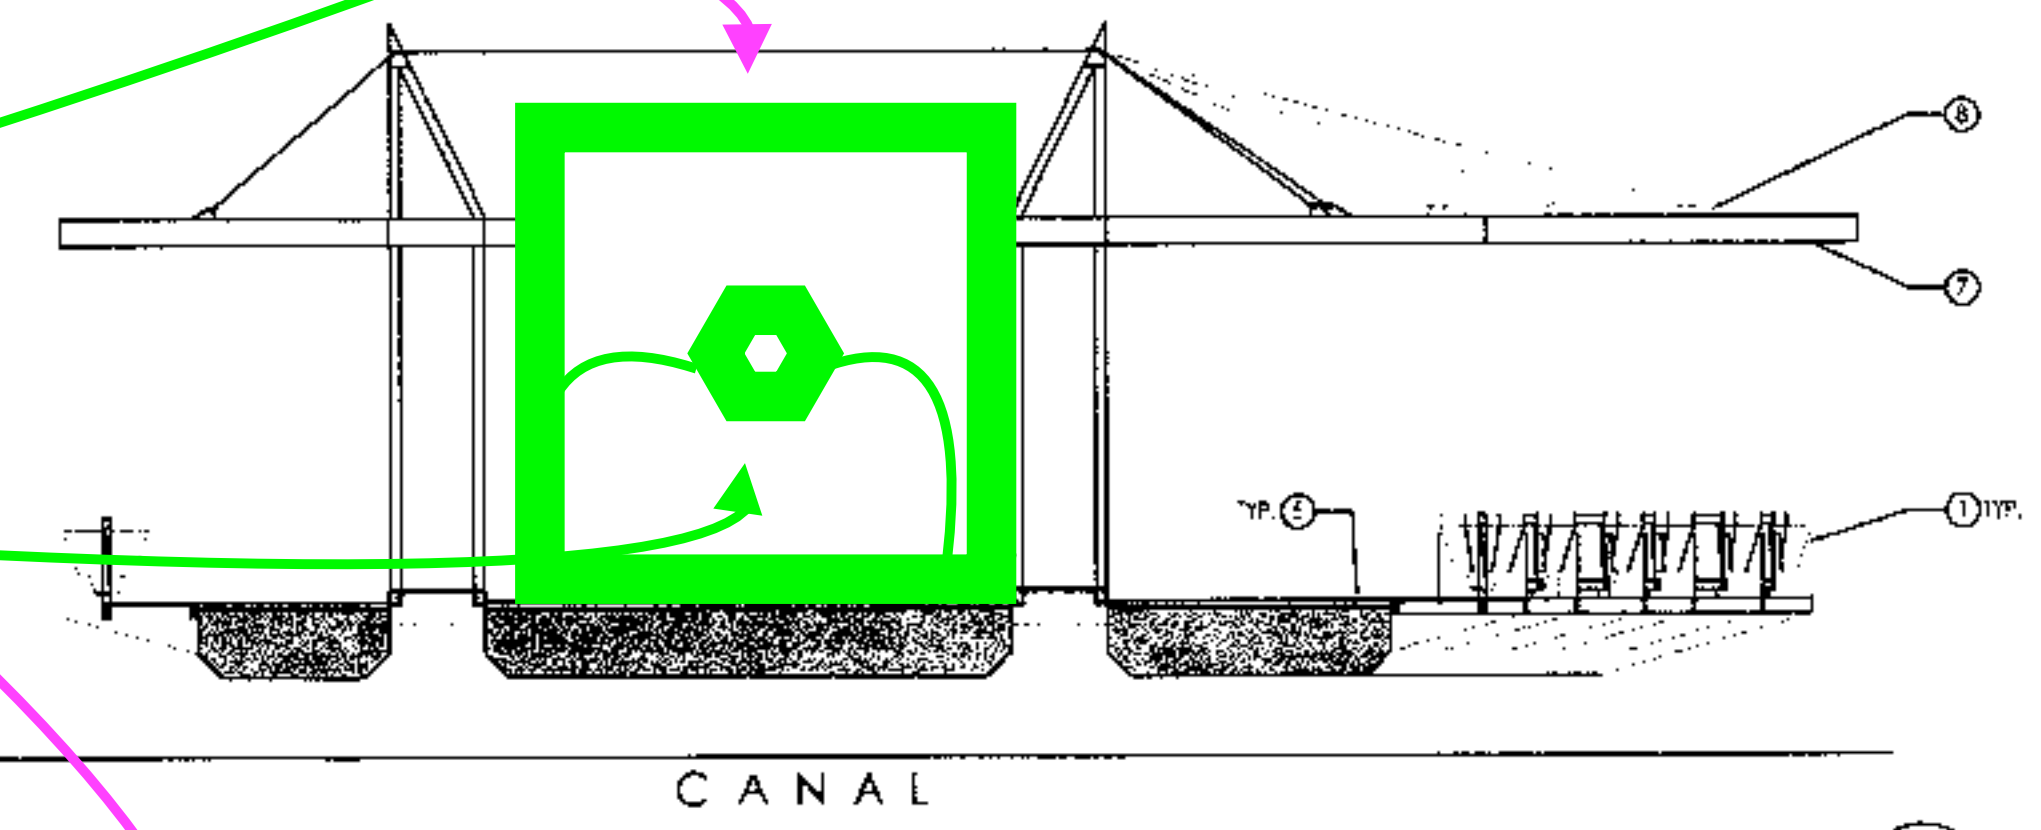

2 West Elevation
SCALE: 1/8" = 1'-0"

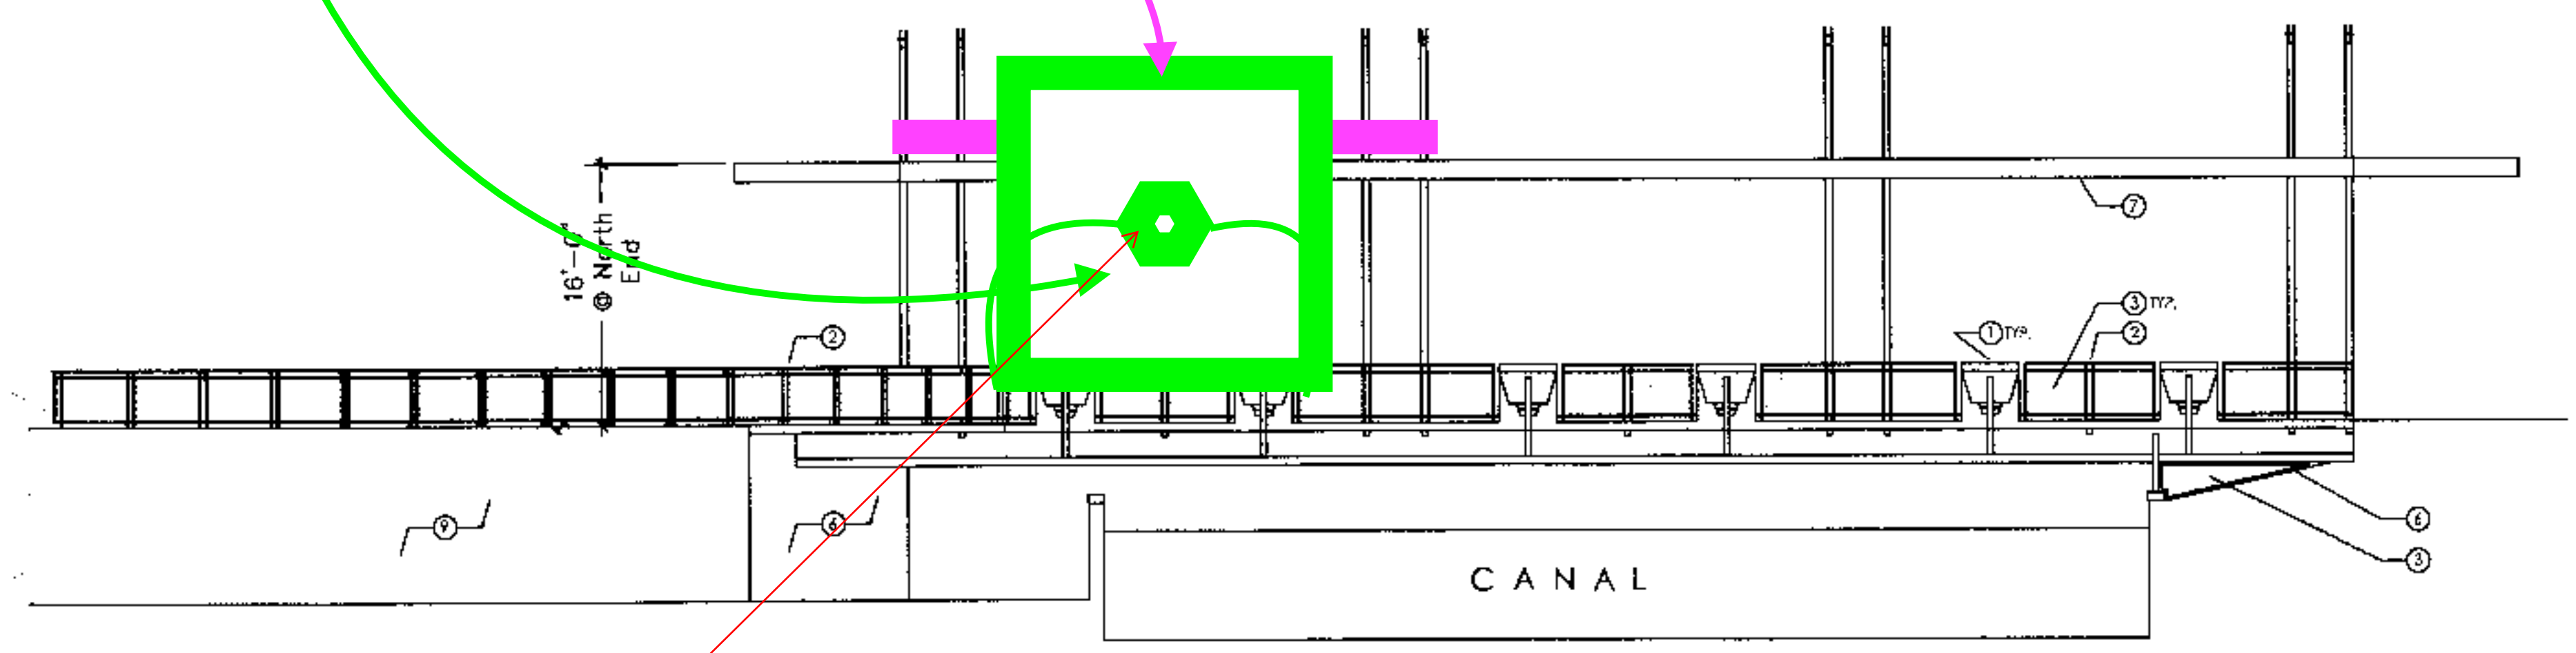

3 South Elevation
SCALE: 1/8" = 1'-0"

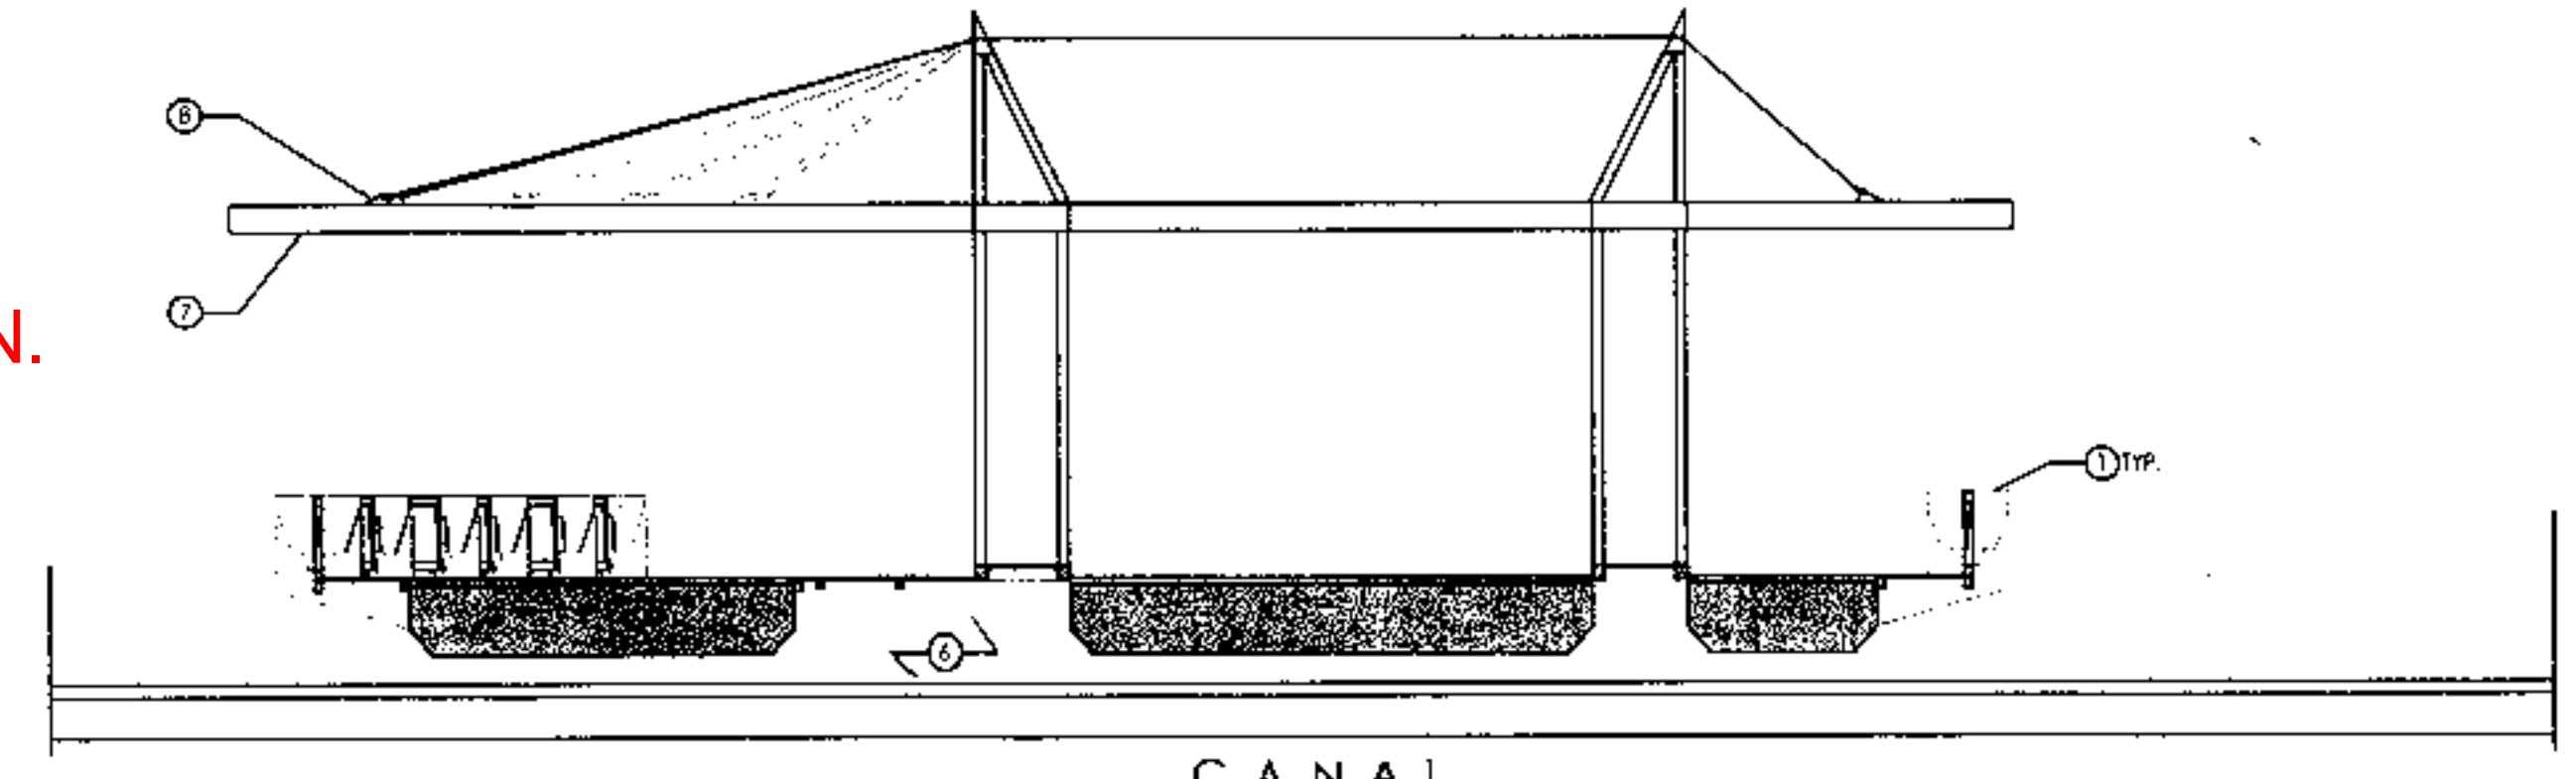

4 East Elevation
SCALE: 1/8" = 1'-0"

Truss Beam

Octopoda

200-POUND SCENIC
OCTOPUS (BY OTHERS) AT
MIDSPAN OF 24' TRUSS RUN.

General Notes:

- 1-Refer to Structural Drawings for further information on bridge and abutment construction.
- 2-Provide shop drawings for all steel, including guardrails, grating, perf. metal, and structure.

FINAL ELEVATION APPROVAL

APPROVED

BY THE CITY OF SCOTTSDALE PLANNING AND DEVELOPMENT SERVICES DEPARTMENT

CASE NUMBER: _____ APPROVED BY: _____ DATE: _____

CONSTRUCTION AND INSTALLATION SHALL BE IN ACCORDANCE WITH THE PLAN AND ANY AND ALL DEVIATIONS WILL REQUIRE A REAPPROVAL.

REVISION

BY

MUNICIPAL SERVICES DEPARTMENT
CAPITAL PROJECT MANAGEMENT


3939 DRINKWATER BLVD.
SCOTTSDALE, ARIZONA 85251

PROJECT TITLE
ARIZONA CANAL AT SCOTTSDALE-PHASE I


DESIGNED BY DATE 10-10-03 BID NO. #04PB034 SHEET A1-04

DRAWN BY AS-BUILT PROJECT NO. 2829 68 OF 89


DRAWINGS ADDED FOR REFERENCE ONLY.

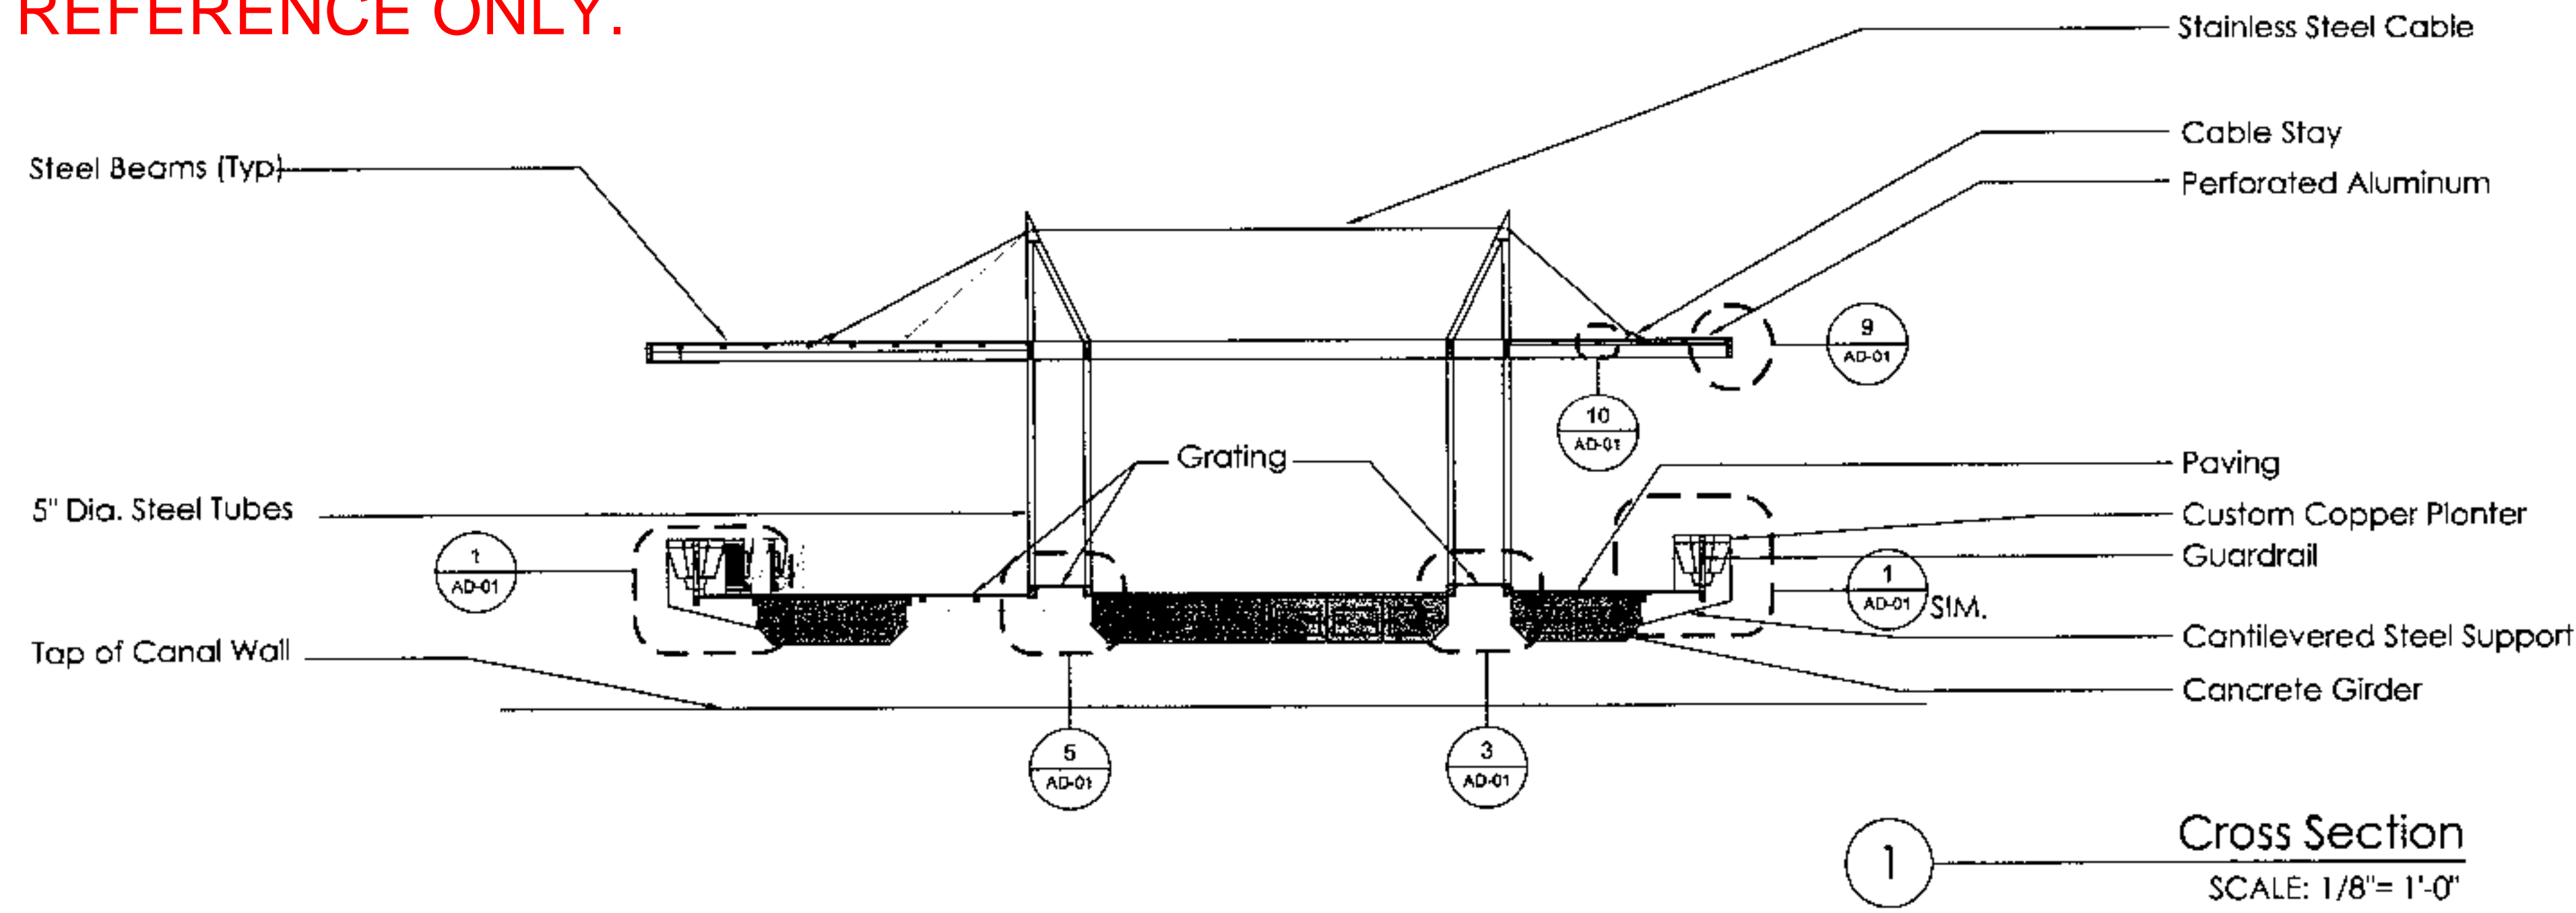

1 Cross Section
SCALE: 1/8"= 1'-0"

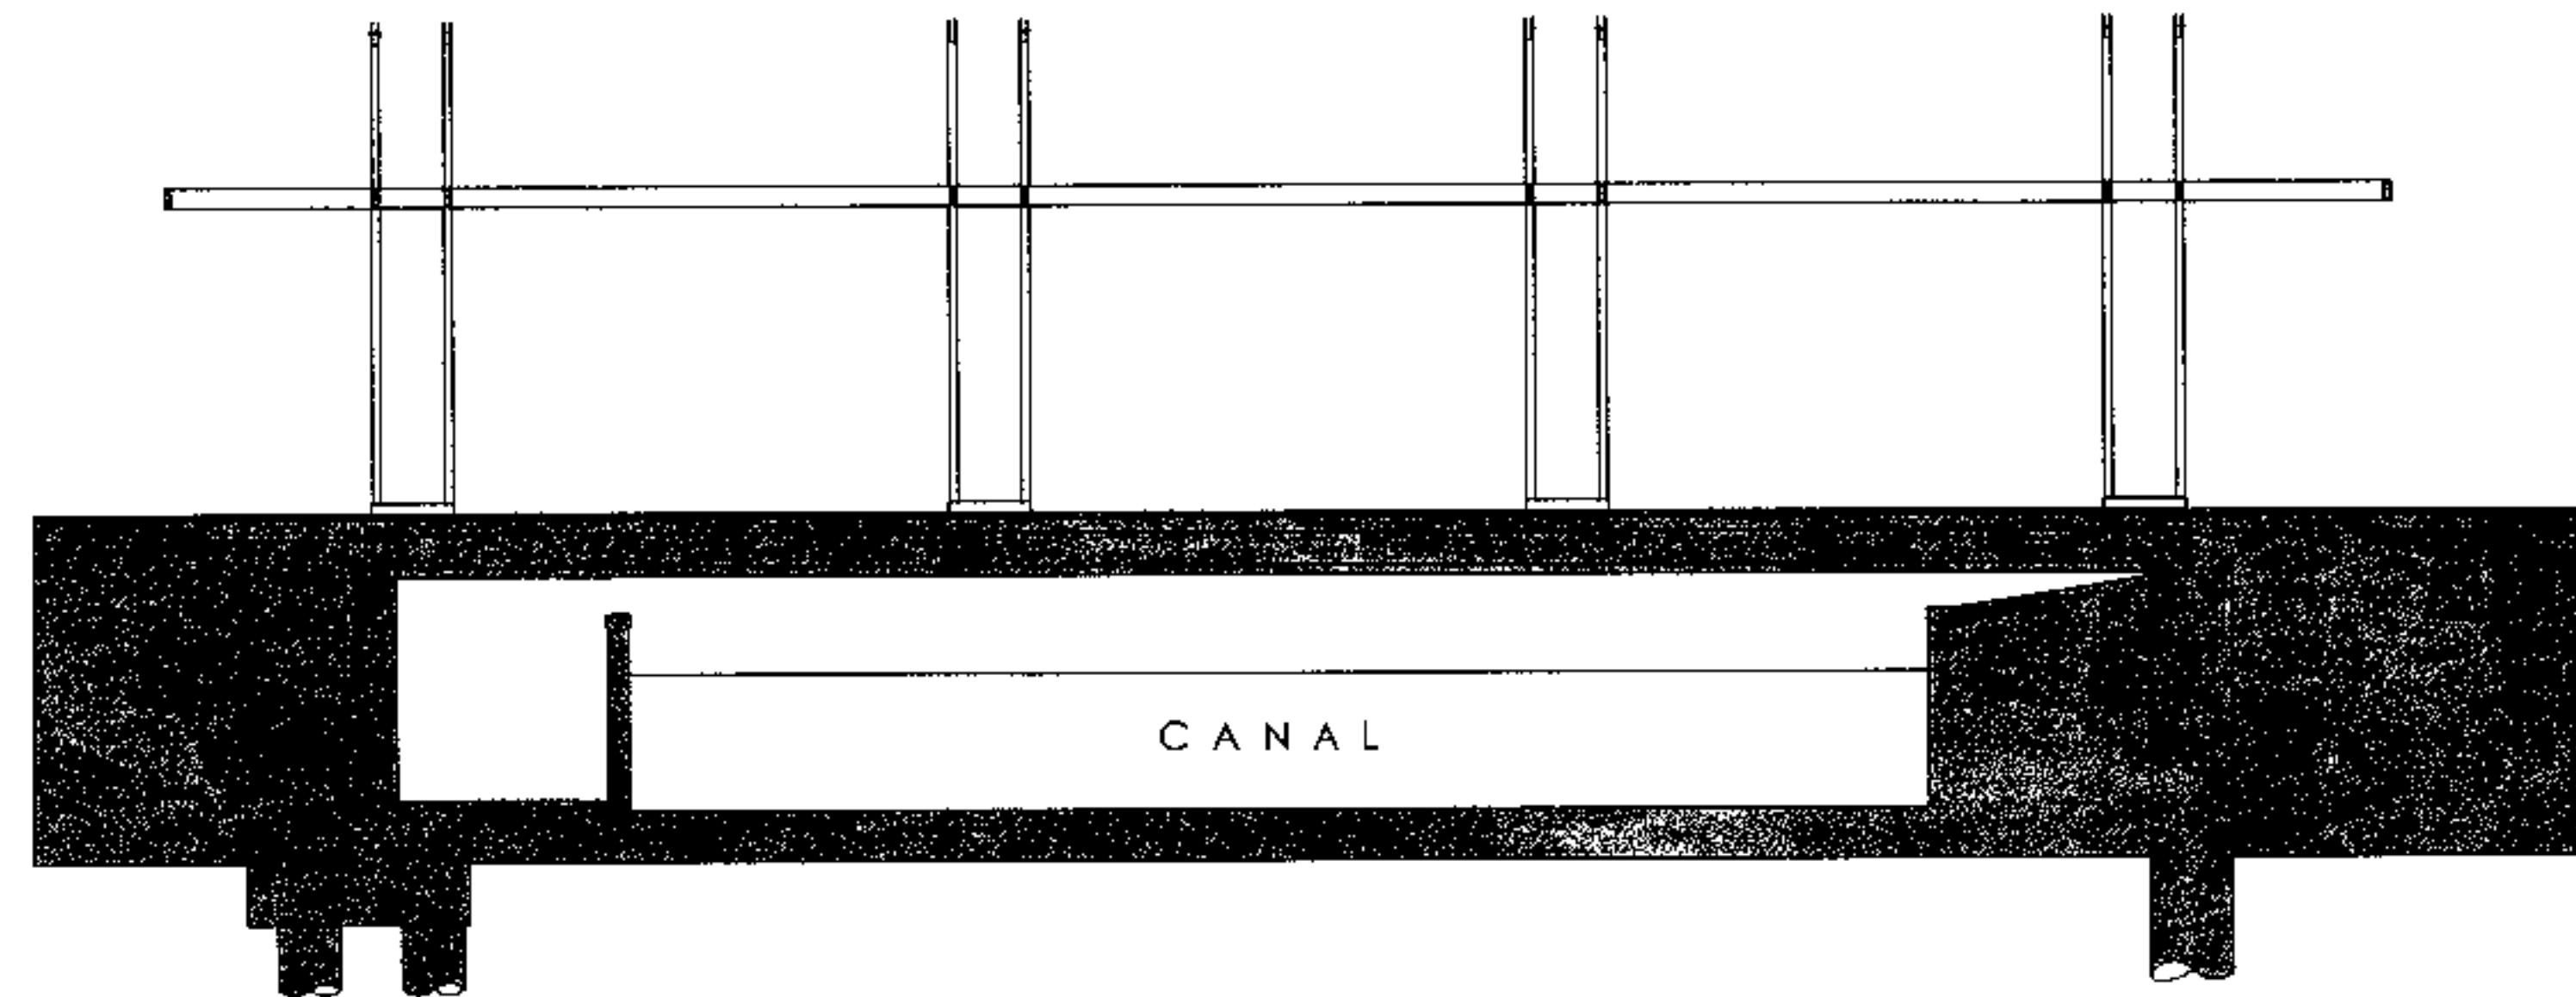

2 Longitudinal Section
SCALE: 1/8"= 1'-0"

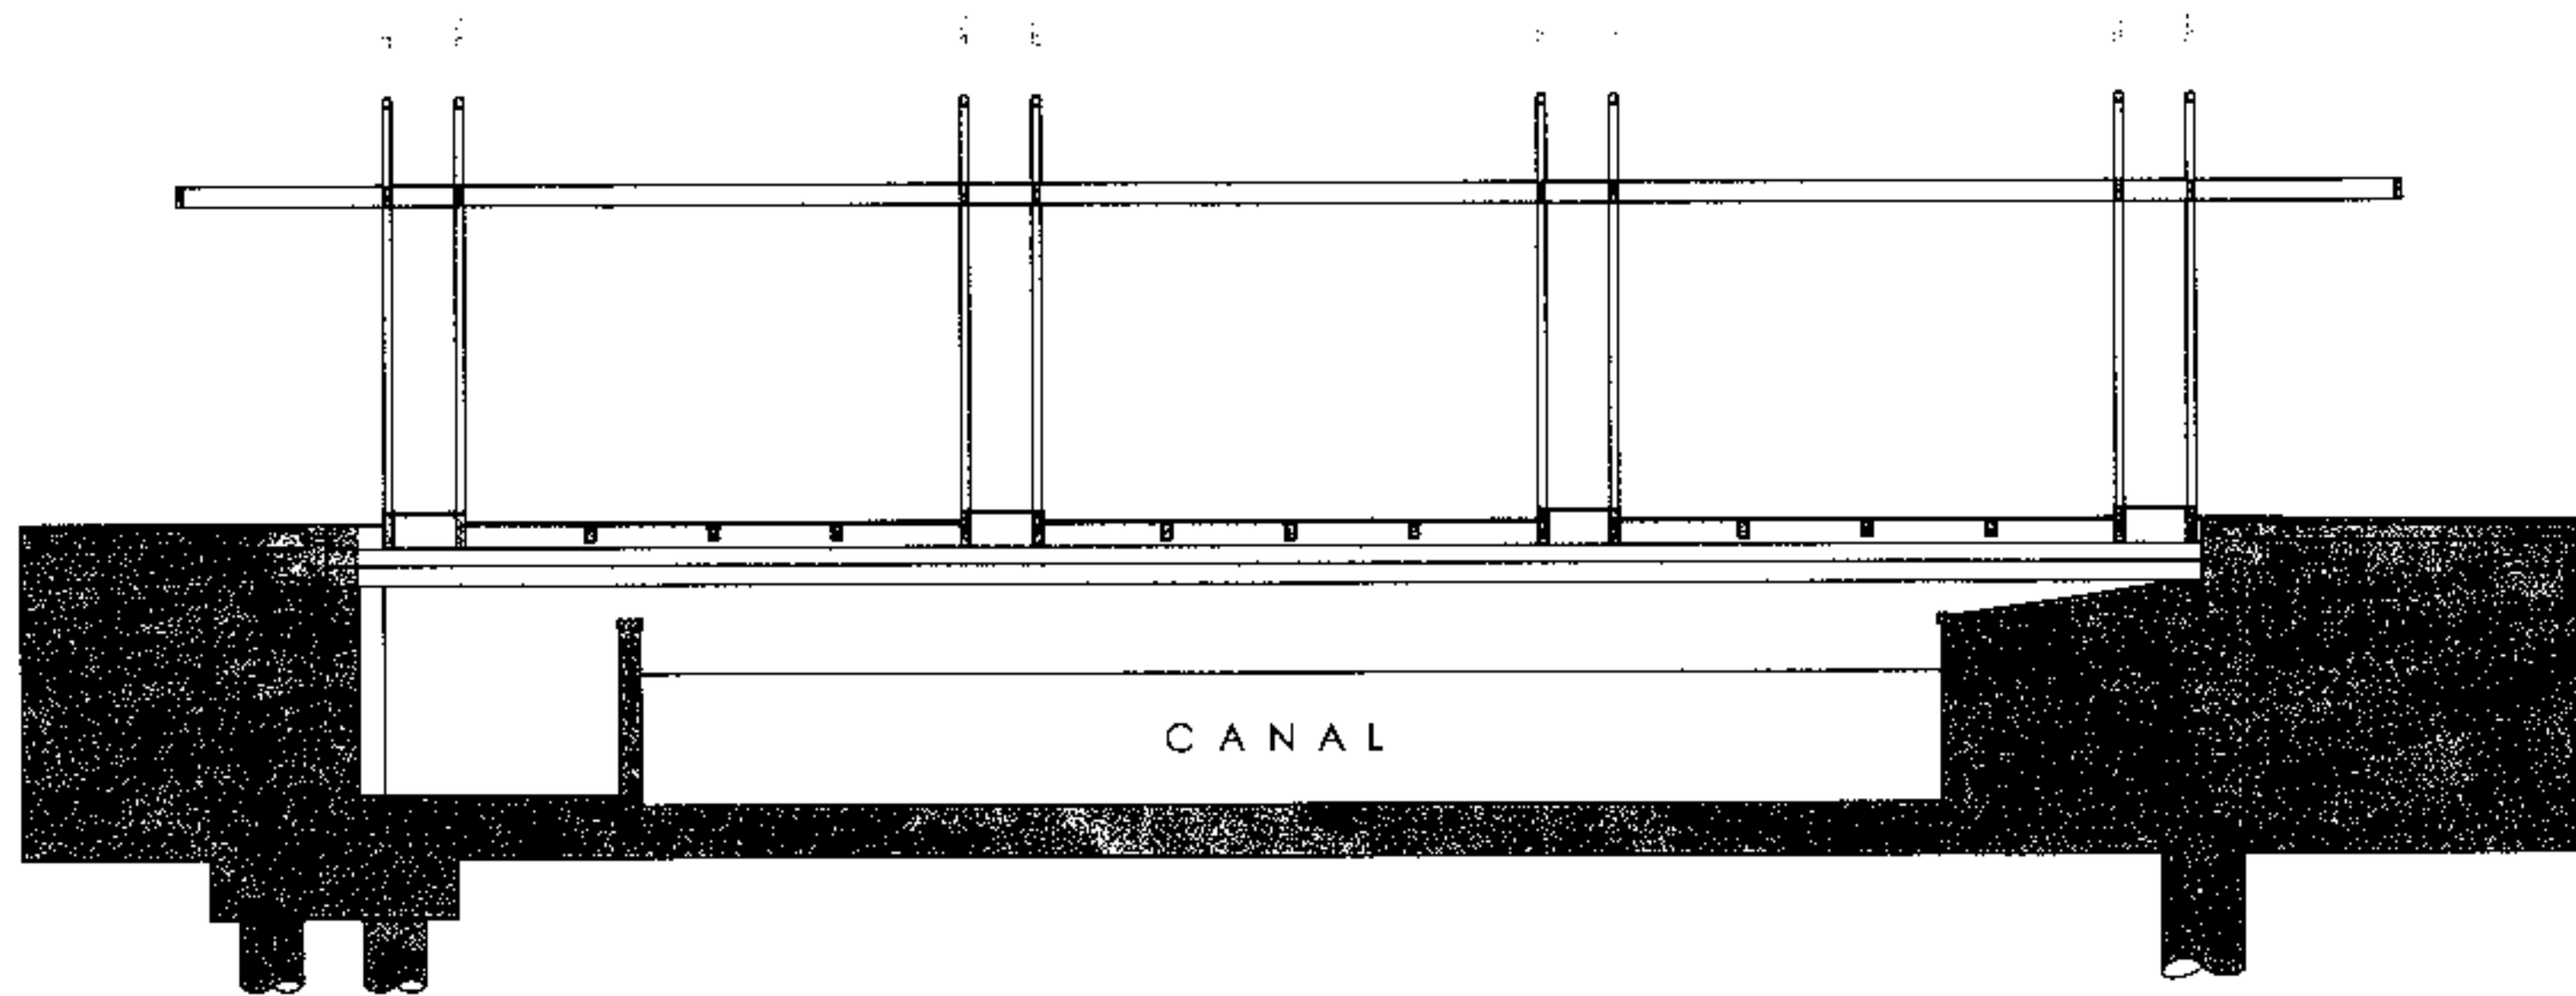


3 Longitudinal Section
SCALE: 1/8"= 1'-0"

General Notes:
1-Refer to Structural Drawings for further information on bridge and abutment construction.
2-Provide shop drawings for all steel, including guardrails, grating, perf. metal, and structure.

DESIGNWORKSHOP
 Landscape Architecture • Land Planning
 Urban Design • Tourism Planning
 Asheville • Aspen • Denver • Jackson Hole
 Park City • Santa Fe • Tempe • Lake Tahoe • Vail
 310 S. Mill Avenue, Suite 201
 Tempe, Arizona 85281
 (480) 966-5881
 Facsimile (480) 966-2798
 WWW.DESIGNWORKSHOP.COM

OWNER
CITY OF SCOTTSDALE
 7447 E. INDIAN SCHOOL RD. SCOTTSDALE, AZ. 85251
 480-372-7888

Arizona Canal - Phase I
at Scottsdale - Phase I
 Scottsdale, Arizona

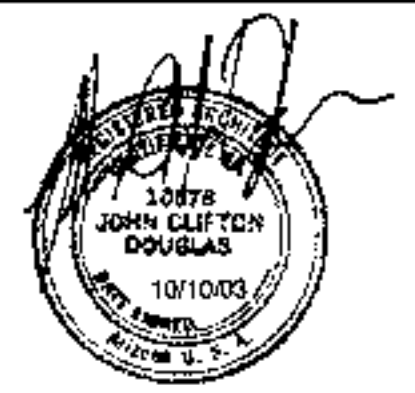

DOUGLAS
 Architecture and Planning, P.C.
 7522 East McDonald Drive, Scottsdale, Arizona 85250

BID DOCUMENTS
 PHASE ONE

BRIDGE
SECTIONS

ISSUED FOR: BID DOCUMENTS

ISSUE DATE: OCTOBER 10, 2003

REVISIONS

#	DATE	DESCRIPTION

DRAWN: GG REVIEWED: JCD

PROJECT NUMBER: 2829

		MUNICIPAL SERVICES DEPARTMENT CAPITAL PROJECT MANAGEMENT 3939 DRINKWATER BLVD. SCOTTSDALE, ARIZONA 85251	
PROJECT TITLE ARIZONA CANAL AT SCOTTSDALE-PHASE I			
DESIGNED BY	DATE	REV NO.	SHT. NO.
AS-BUILT	10-10-03	W04PB034	A1-05
DRAWN BY	PROJECT NO.	89 OF 89	
GG	2829		

DRAWINGS ADDED FOR REFERENCE ONLY.

DESIGNWORKSHOP

Landscape Architecture • Land Planning
Urban Design • Tourism Planning

Asheville • Aspen • Denver • Jackson Hole
Park City • Santa Fe • Tempe • Lake Tahoe • Vail

310 S. Mill Avenue, Suite 201
Tempe, Arizona 85281
(480) 966-5881
Facsimile (480) 966-2799

WWW.DESIGNWORKSHOP.COM

OWNER
CITY OF SCOTTSDALE
7447 E. FORDIAN SCHOOL RD. SCOTTSDALE, AZ 85251
480-312-7889

**Arizona Canal
at Scottsdale - Phase I**
Scottsdale, Arizona



DOUGLAS
Architecture and Planning, P.C.
7222 East McDowell Drive, Scottsdale, Arizona 85250

BID DOCUMENTS
PHASE ONE

**GUARDRAIL
PLANS /
ELEVATIONS**

ISSUED FOR: BID DOCUMENTS

ISSUE DATE: OCTOBER 10, 2003

REVISIONS

#	DATE	DESCRIPTION



DRAWN: GC REVIEWED: JCD

PROJECT NUMBER: 2829


© COPYRIGHT DES DESIGNWORKSHOP, INC.

DESIGNED BY	DATE	BID NO.	SER.
AS-BUILT	10-10-03	W04PB034	A1-06
PROJECT TITLE			
ARIZONA CANAL AT SCOTTSDALE-PHASE I			
PROJECT NUMBER: 2829			
70 OF 88			

MUNICIPAL SERVICES DEPARTMENT
CAPITAL PROJECT MANAGEMENT
3939 DRINKWATER BLVD.
SCOTTSDALE, ARIZONA 85251

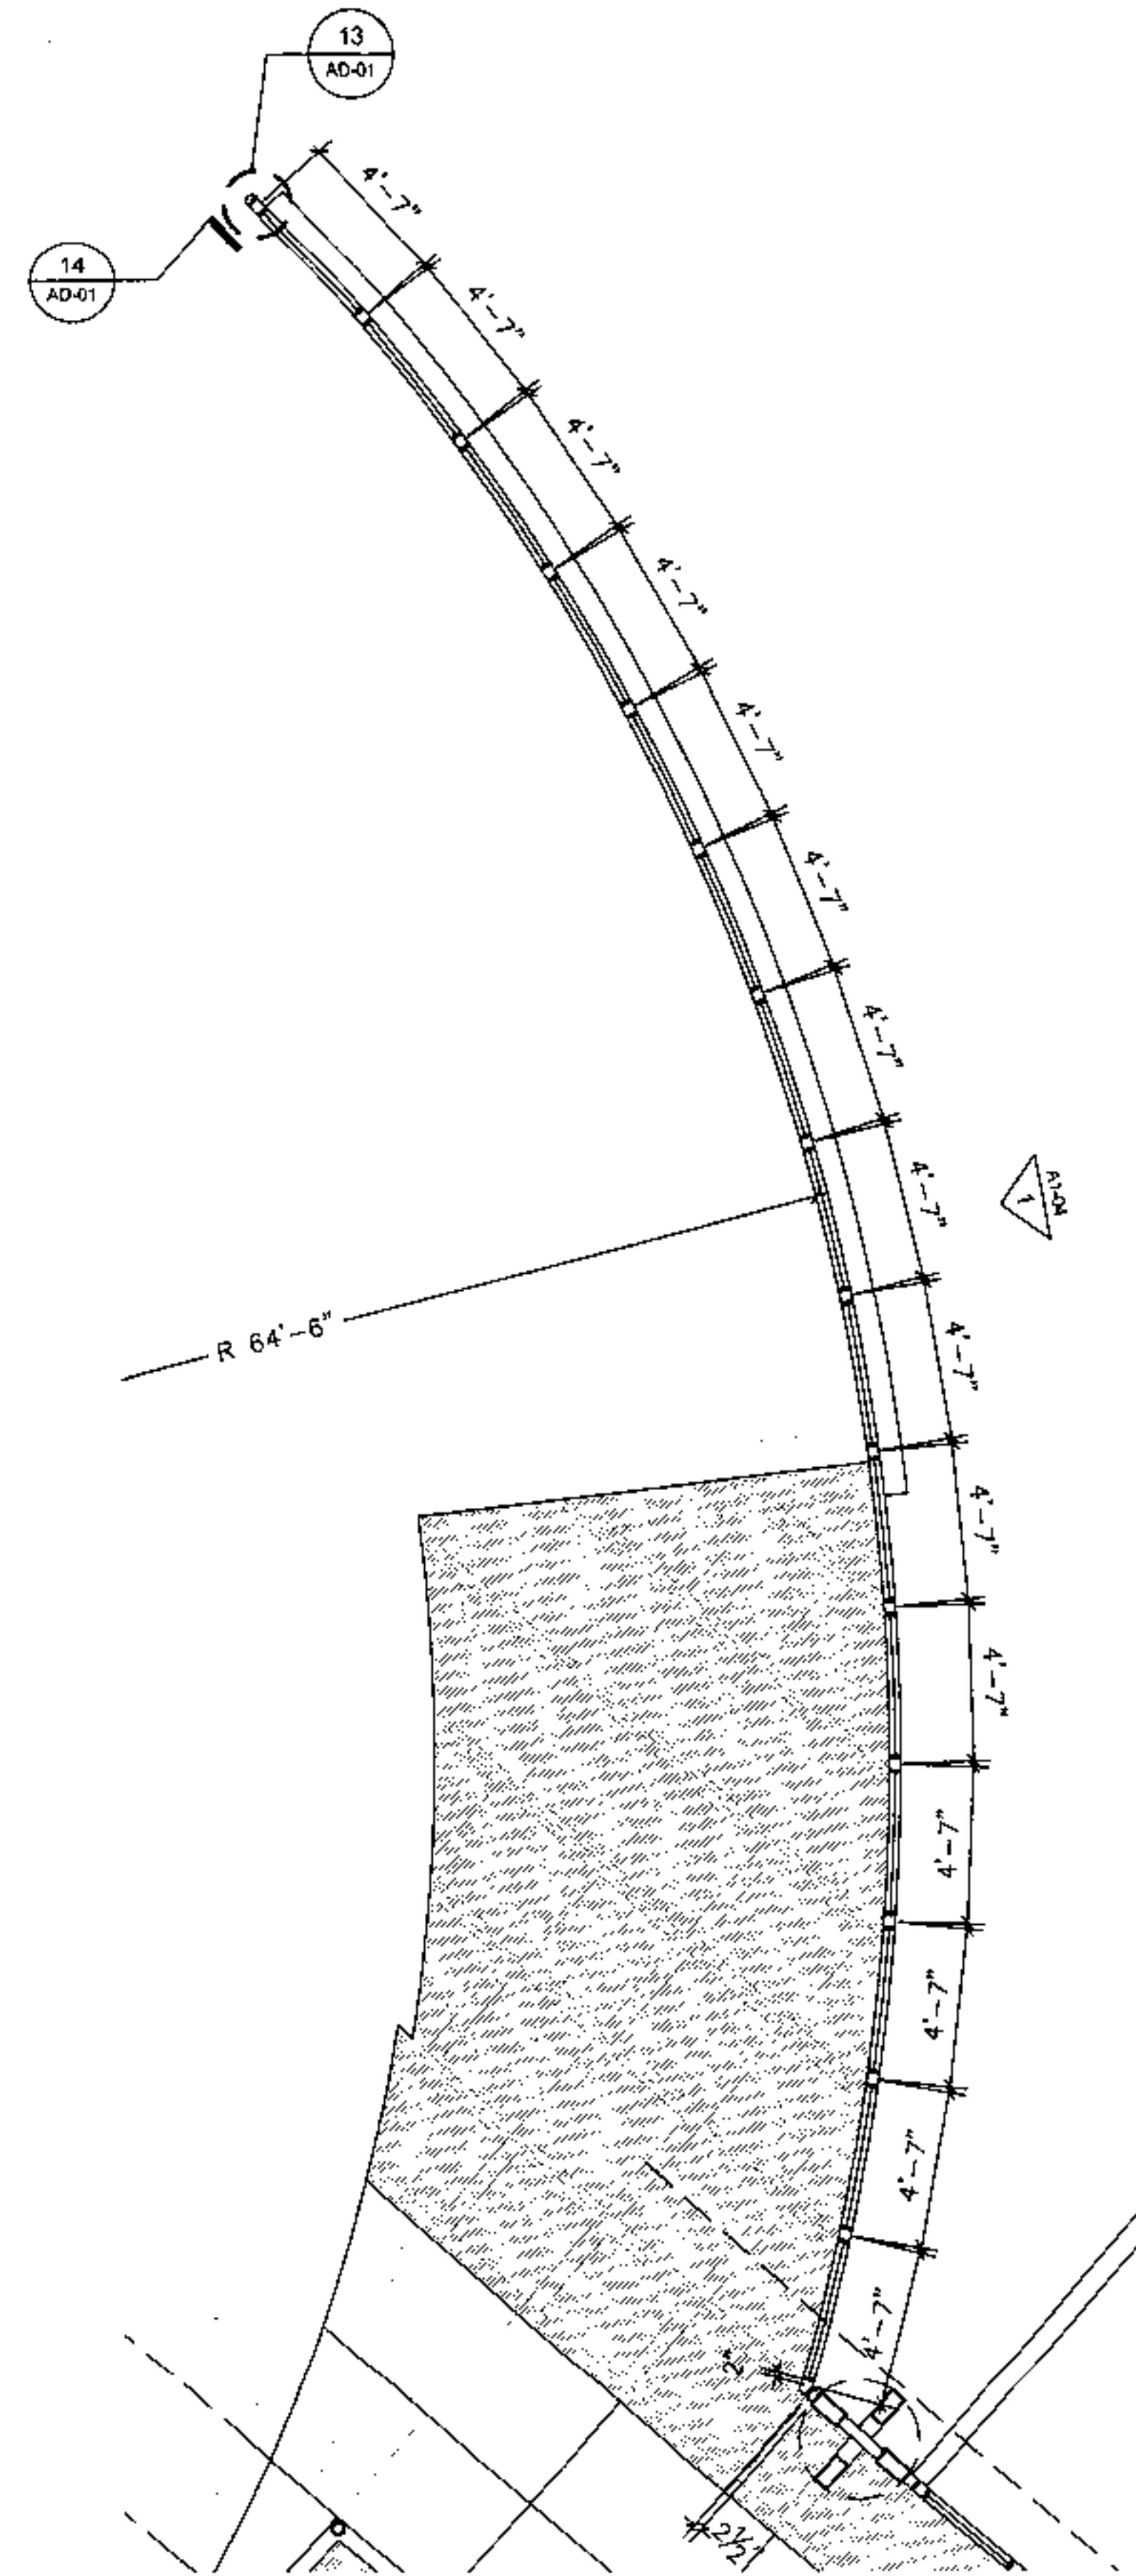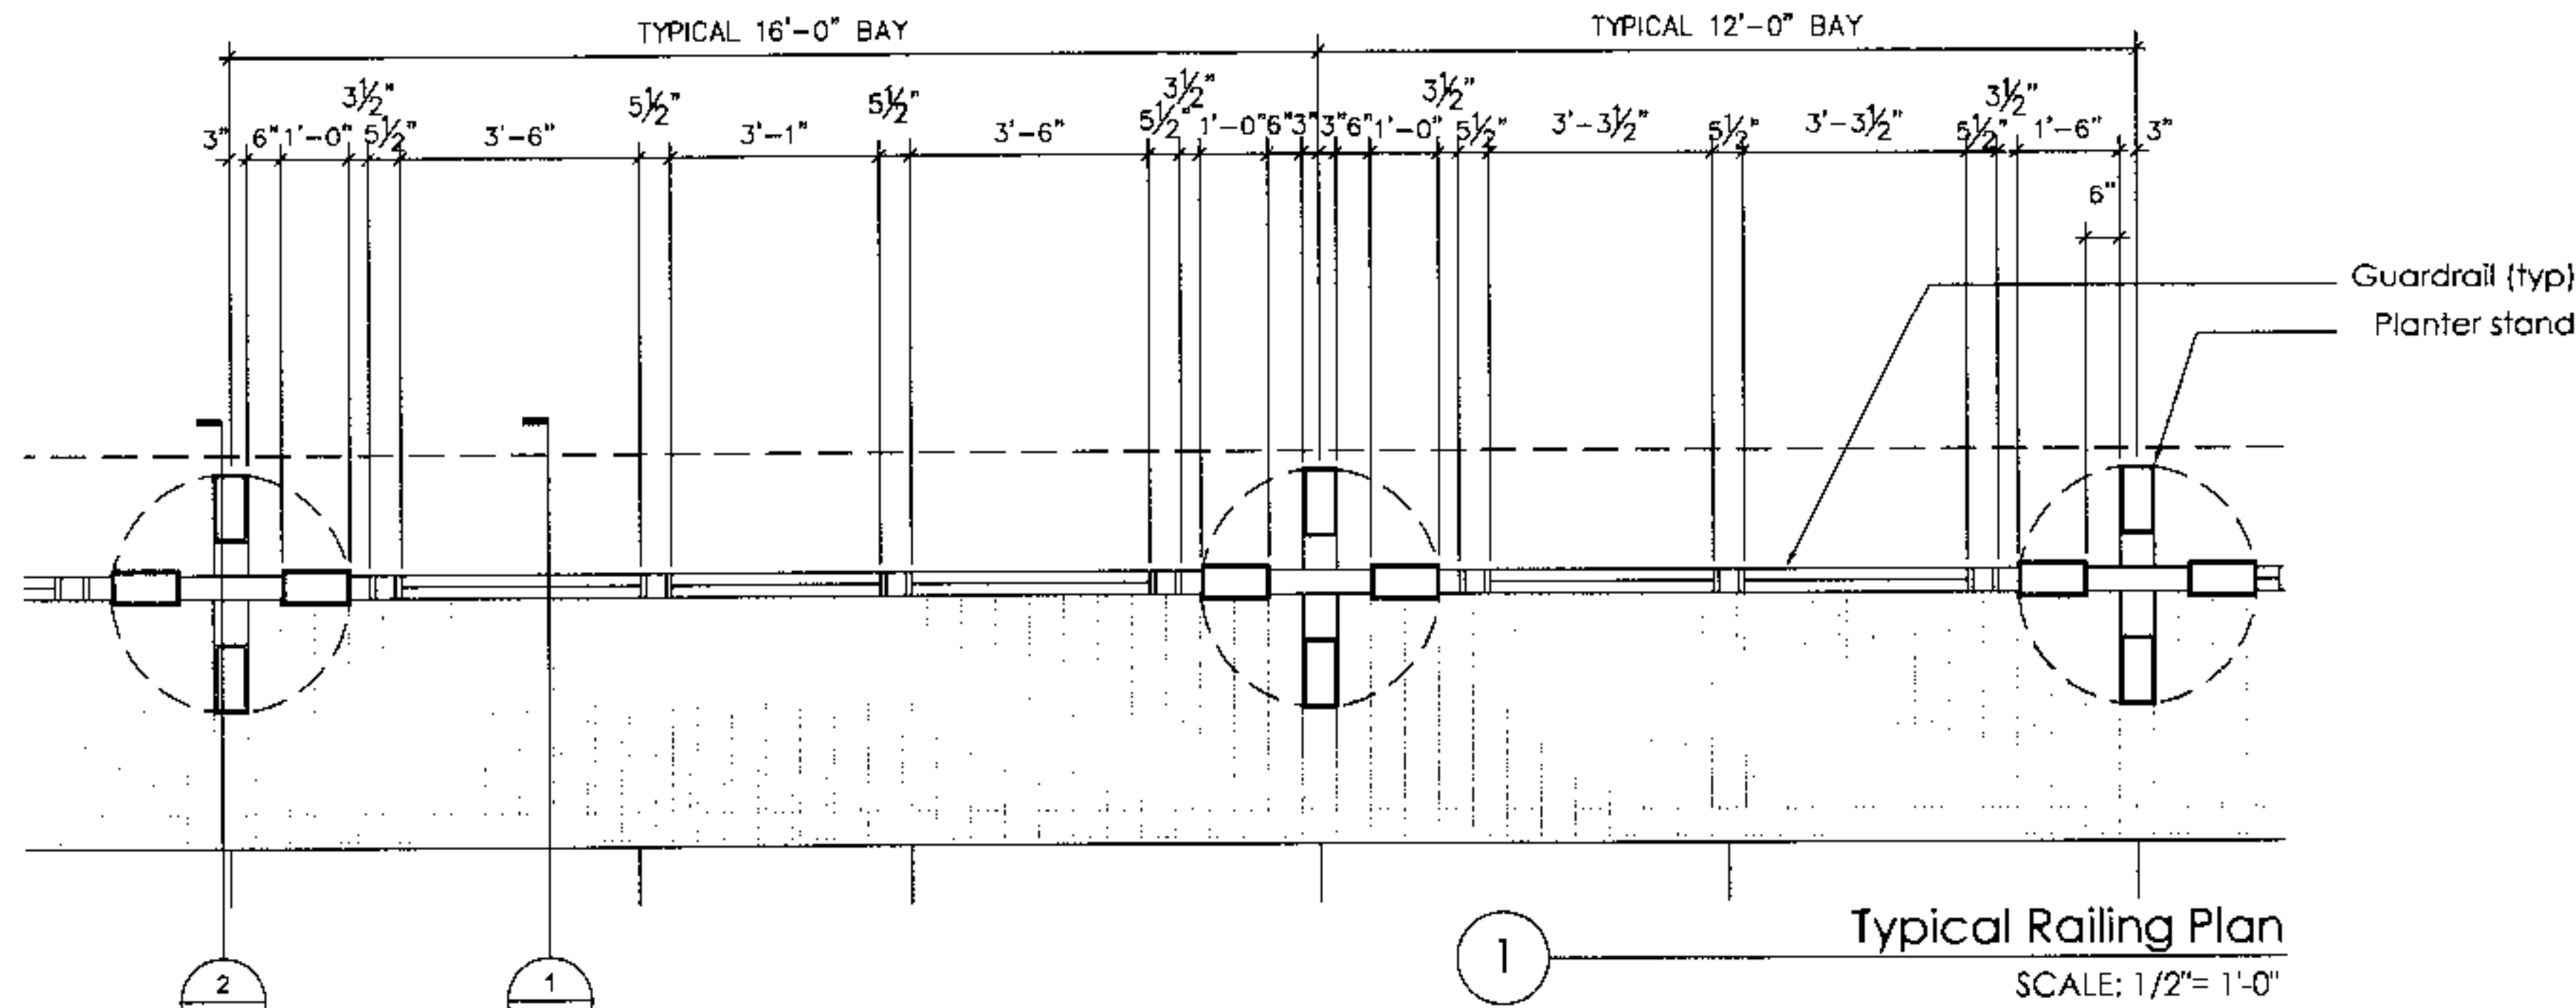

2 Railing Plan @ North Bank
SCALE: 1/4"= 1'-0"

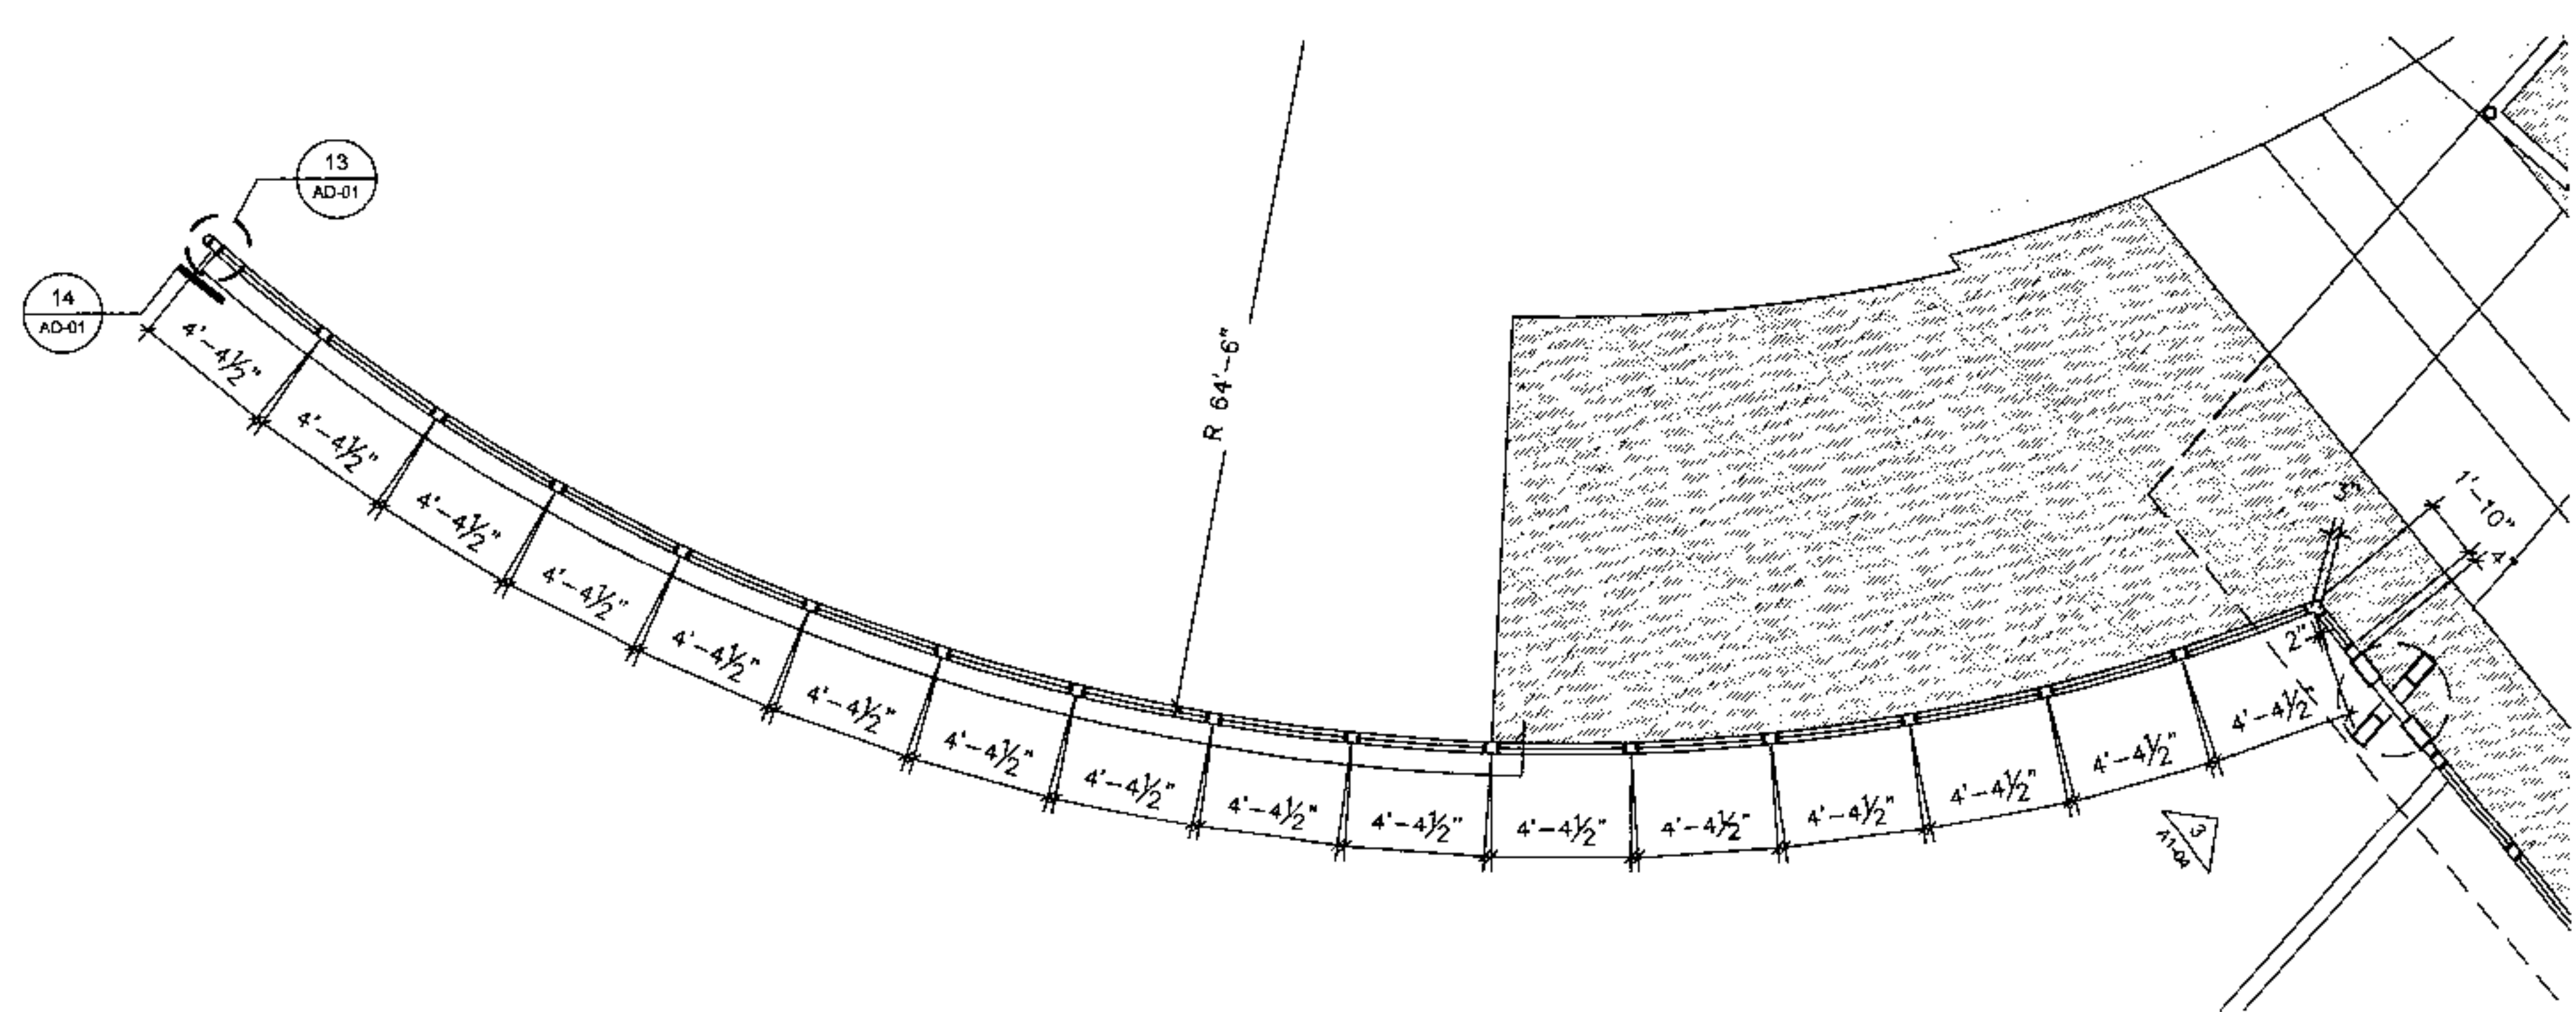

3 Railing Plan @ South Bank
SCALE: 1/4"= 1'-0"

General Notes:
1-Refer to Structural Drawings for further information on bridge and abutment construction.
2-Provide shop drawings for all steel, including guardrails, grating, perf. metal, and structure.

**Arizona Canal - Phase I
at Scottsdale - Phase I
Scottsdale, Arizona**



DOUGLAS
Architecture and Planning, P.C.
7522 East McDonald Drive, Scottsdale, Arizona 85260

BID DOCUMENTS
PHASE ONE

**GUARDRAIL
PLANS /
ELEVATIONS**

ISSUED FOR: BID DOCUMENTS

ISSUE DATE: OCTOBER 10, 2003

REVISIONS

#	DATE	DESCRIPTION

DRAWN: GC REVIEWED: JCD

PROJECT NUMBER: 2829

© COPYRIGHT DESIGNWORKSHOP, INC.


REVISION BY

**MUNICIPAL SERVICES
DEPARTMENT
CAPITAL PROJECT
MANAGEMENT**


3939 DRINKWATER BLVD.
SCOTTSDALE, ARIZONA 85251

PROJECT TITLE
ARIZONA CANAL AT SCOTTSDALE-PHASE I

DESIGNED BY DATE: 10-10-03 BD NO: #04PB034 SH: A1-07
DRAWN BY AS-BUILT PROJECT NO: 2829 71 OF 89

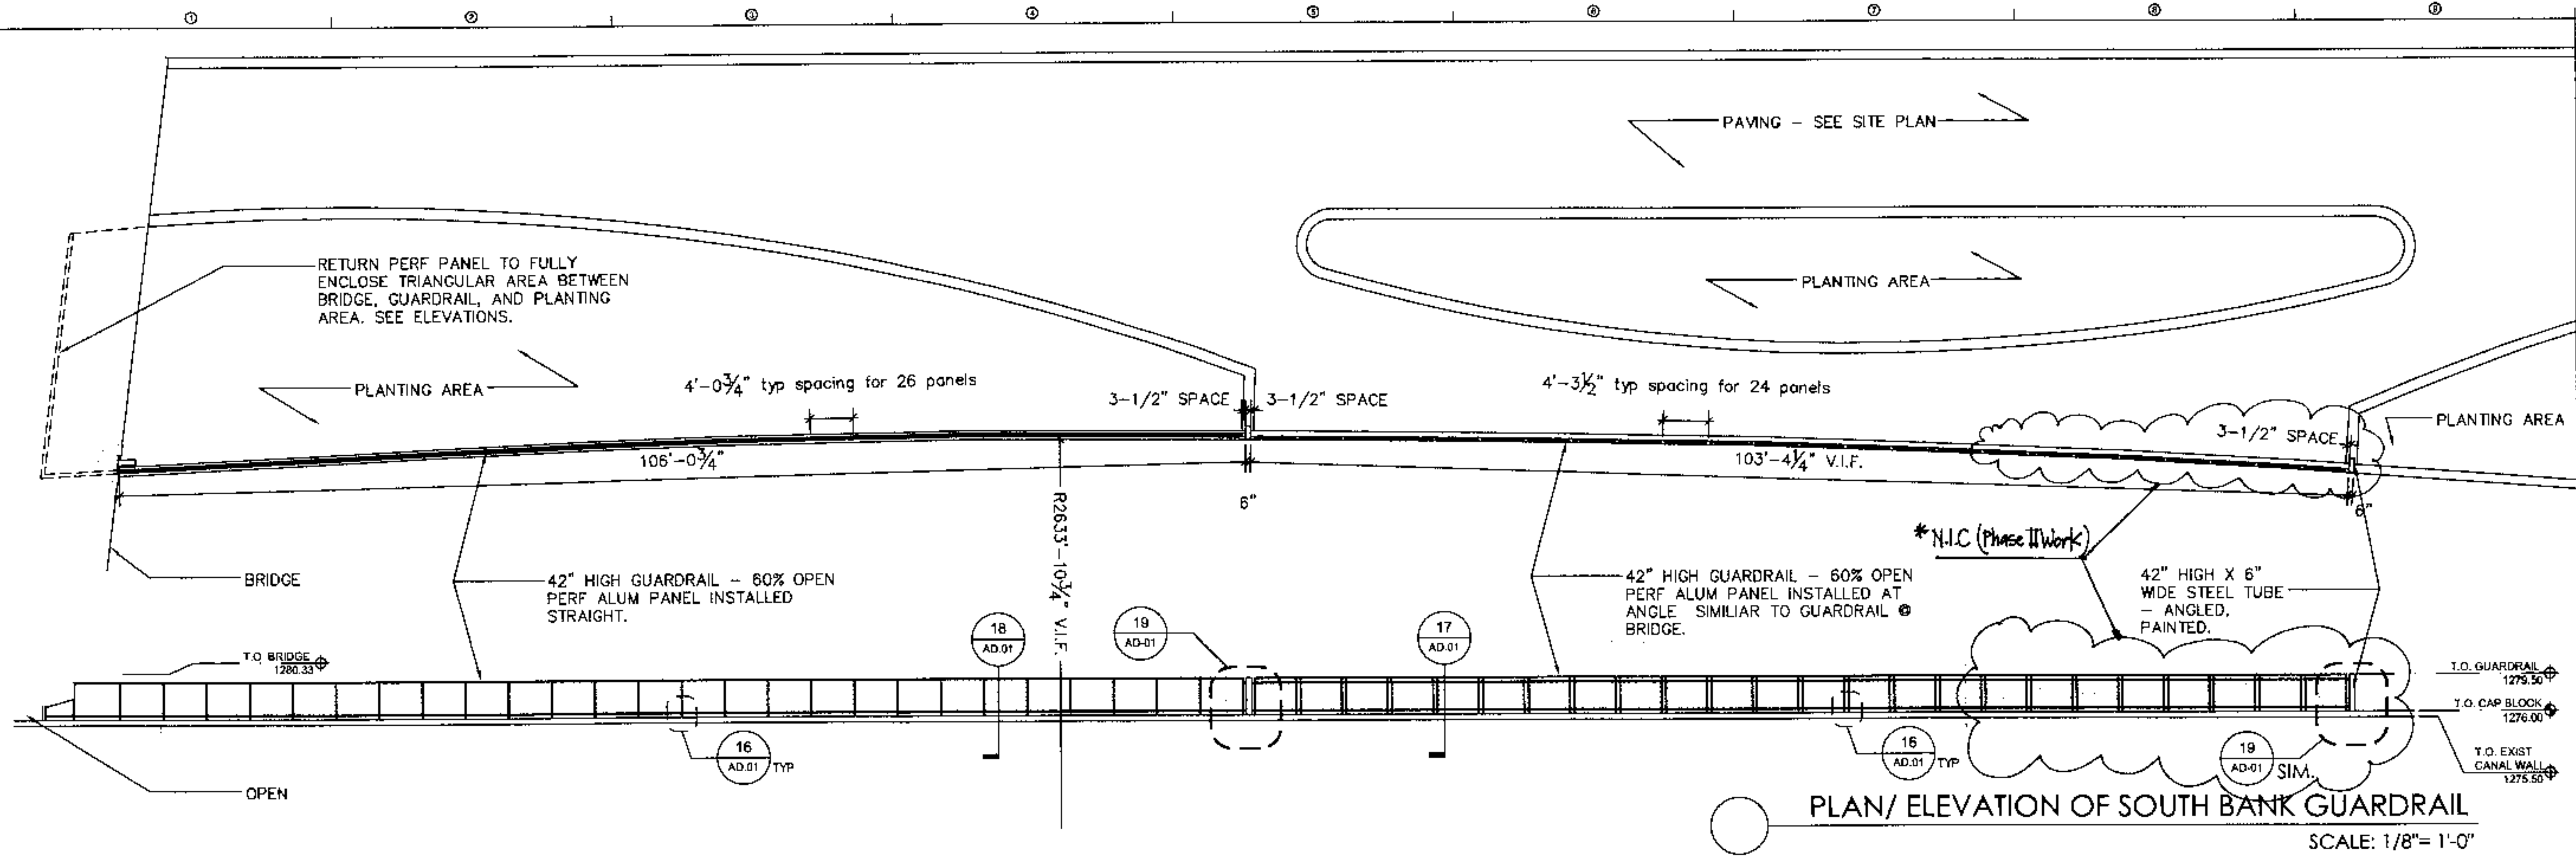

PLAN/ ELEVATION OF SOUTH BANK GUARDRAIL
SCALE: 1/8"= 1'-0"

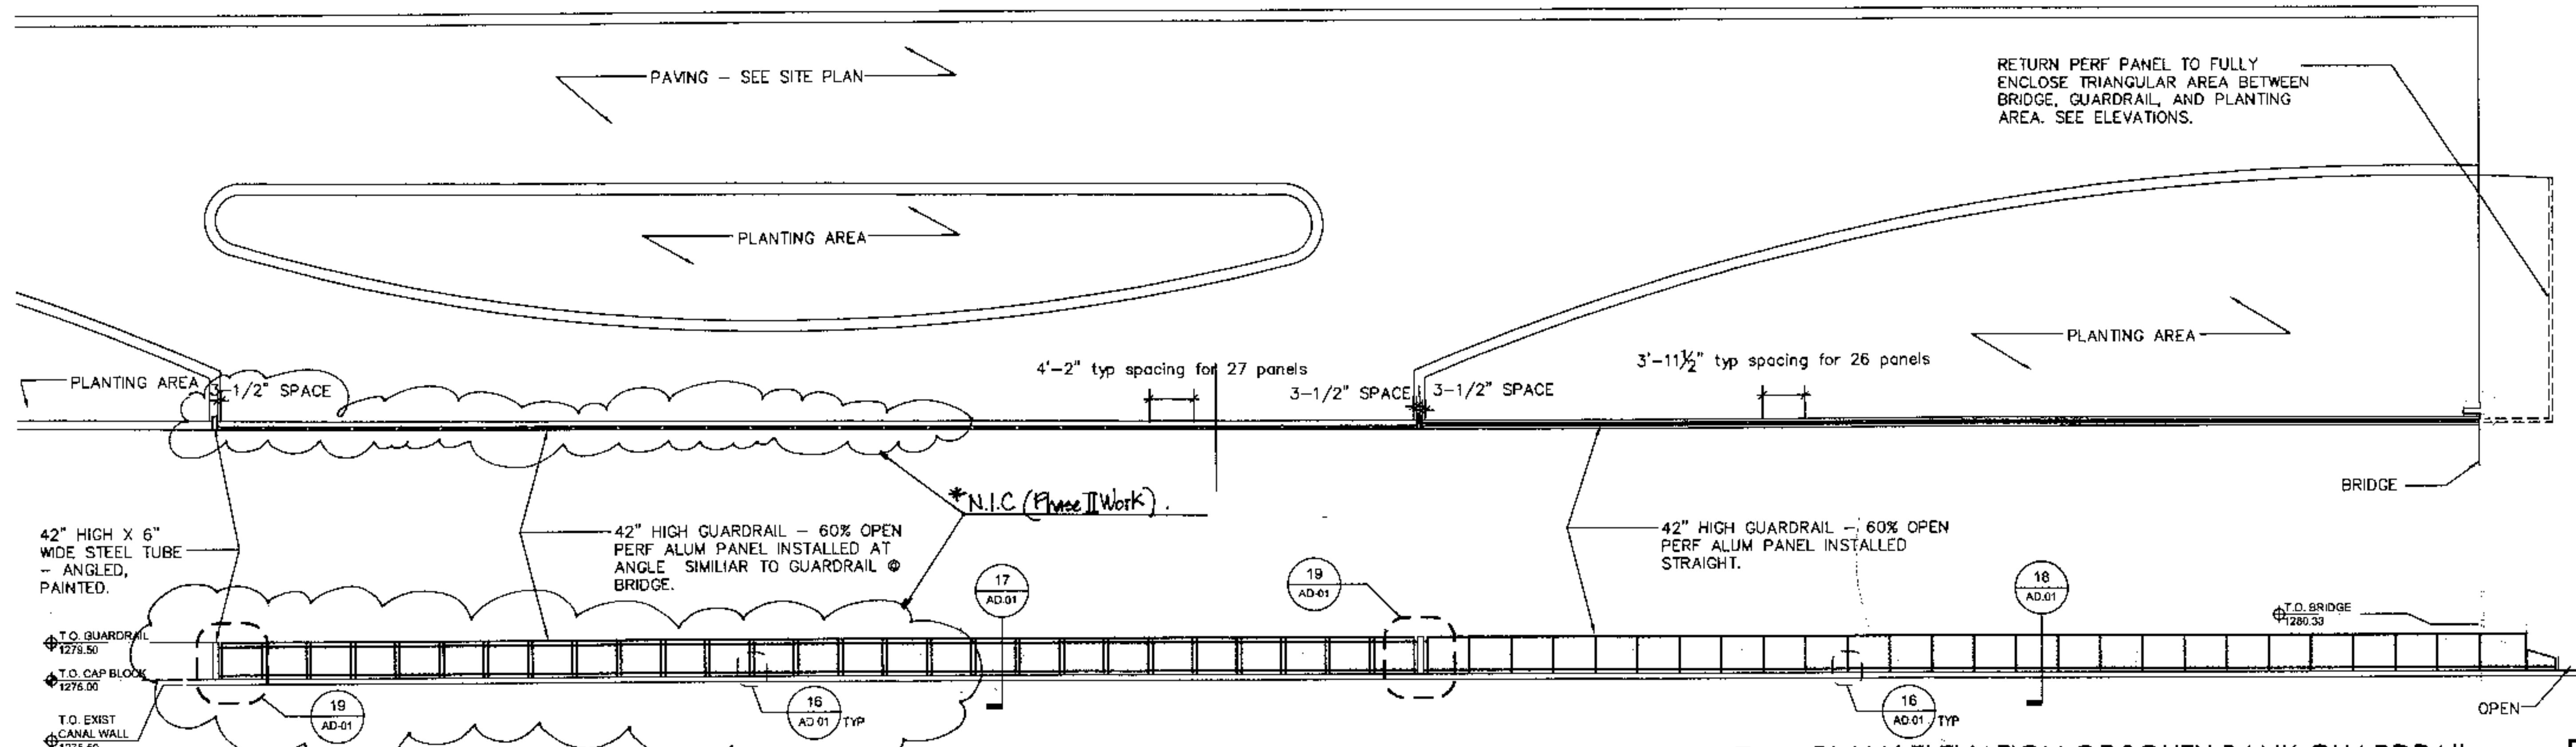

PLAN/ ELEVATION OF SOUTH BANK GUARDRAIL
SCALE: 1/8"= 1'-0"

FINAL ELEVATION APPROVAL:
APPROVED

BY THE CITY OF SCOTTSDALE PLANNING AND
DEVELOPMENT SERVICES DEPARTMENT

CASE NUMBER: APPROVED BY DATE


CONTRACTOR'S INSTALLATION SHALL BE IN ACCORDANCE WITH
THIS PLAN AND ANY OTHER ALL DEVIATIONS WILL BE RETURNED FOR RE-APPROVAL

***Note: Contractor to provide unit prices for handrail components for Phase I area only (not including the Phase II handrails clouded). Final design and length of handrails to be determined by City prior to award of contract.**


General Notes:
1-Refer to Structural Drawings for further information on bridge and abutment construction.
2-Provide shop drawings for all steel, including guardrails, grating, perf. metal, and structure.

DRAWINGS ADDED FOR REFERENCE ONLY.

**Arizona Canal - Phase I
at Scottsdale - Phase I**
Scottsdale, Arizona

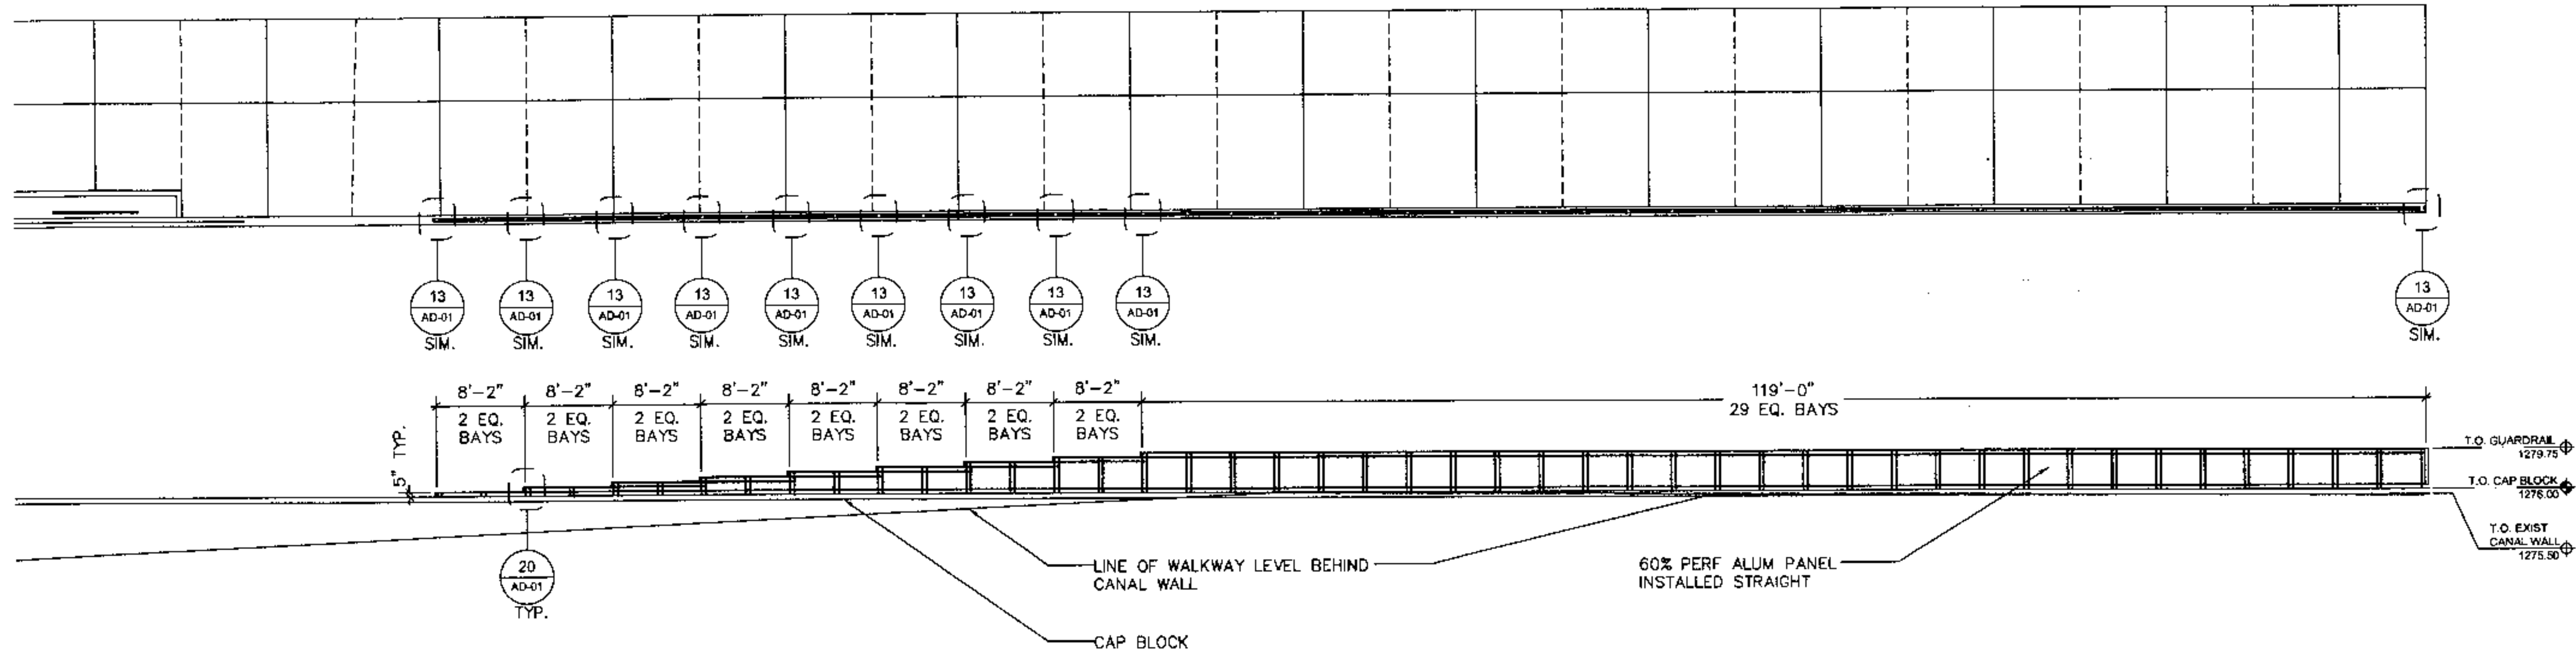

PLAN/ ELEVATION OF NORTH BANK GUARDRAIL
SCALE: 1/8" = 1'-0"

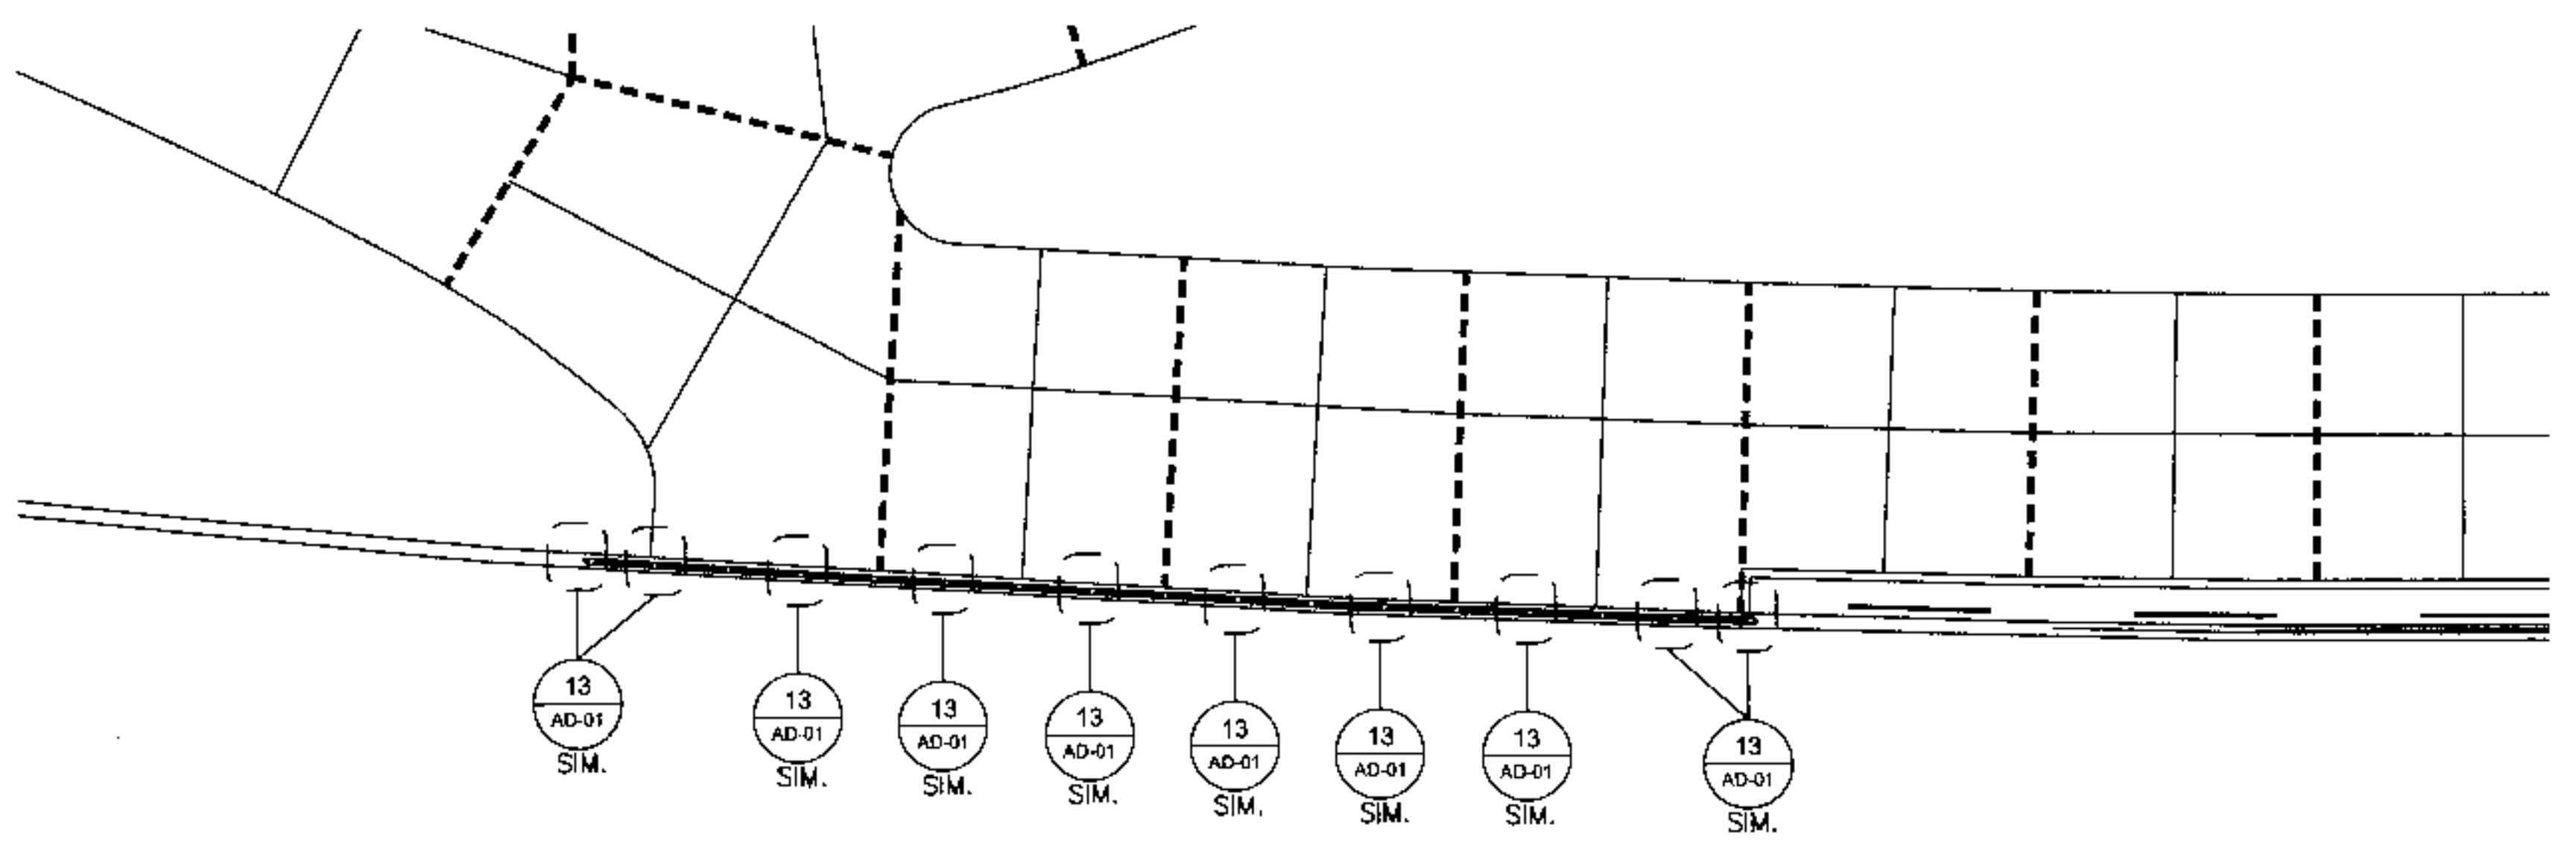

PLAN/ ELEVATION OF NORTH BANK GUARDRAIL
SCALE: 1/8" = 1'-0"

FINAL ELEVATION APPROVAL
APPROVED
BY THE CITY OF SCOTTSDALE PLANNING AND
CONSTRUCTION SERVICES DEPARTMENT
CASE NUMBER: _____ APPROVED BY: _____ DATE: _____
CONSTRUCTION INSTALLATION SHALL BE IN ACCORDANCE WITH
THIS PLAN AND ANY AND ALL DEVIATIONS WILL REQUIRE AN APPROVAL

General Notes:
1-Refer to Structural Drawings for further information on bridge and abutment construction.
2-Provide shop drawings for all steel, including guardrails, grating, perf. metal, and structure.

DRAWINGS ADDED FOR REFERENCE ONLY.



DOUGLAS
Architecture and Planning, P.C.
7522 East McDonald Drive, Scottsdale Arizona 85250

BID DOCUMENTS
PHASE ONE

**GUARDRAIL
PLANS /
ELEVATIONS**

ISSUED FOR: BID DOCUMENTS
ISSUE DATE: OCTOBER 10, 2003

REVISIONS
DATE DESCRIPTION

DRAWN BY: GC REVIEWED: JCD

PROJECT NUMBER: 2829


REVISION _____ BY _____

**MUNICIPAL SERVICES
DEPARTMENT**
**CAPITAL PROJECT
MANAGEMENT**
3939 DRINKWATER BLVD.
SCOTTSDALE, ARIZONA 85251

PROJECT TITLE
ARIZONA CANAL AT SCOTTSDALE-PHASE I

DESIGNED BY: AS-BILT DATE: 10-10-03 BID NO: 04PB034 SHEET: A1-08
DRAWN BY: AS-BILT PROJECT NO: 2829 72 OF 89

**Arizona Canal
at Scottsdale - Phase I**
Scottsdale, Arizona

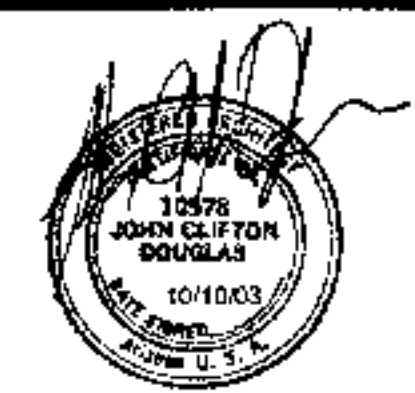

DOUGLAS
Architecture and Planning, P.C.
7322 East McDonald Drive, Scottsdale Arizona 85250

BID DOCUMENTS
PHASE ONE

DETAILS

ISSUED FOR: BID DOCUMENTS
ISSUE DATE: OCTOBER 10, 2003

REVISIONS
DATE DESCRIPTION

DRAWN: GC REVIEWED: JCD

PROJECT NUMBER: 2828


REVISION BY

MUNICIPAL SERVICES DEPARTMENT
CAPITAL PROJECT MANAGEMENT
3939 DRINKWATER BLVD.
SCOTTSDALE, ARIZONA 85251


PROJECT TITLE
ARIZONA CANAL AT SCOTTSDALE-PHASE I

DESIGNED BY DATE 10-10-03 BID NO. #04PBC04 SHEET AD-01


DRAWN BY AS-BUILT PROJECT NO. 2828 73 OF 89

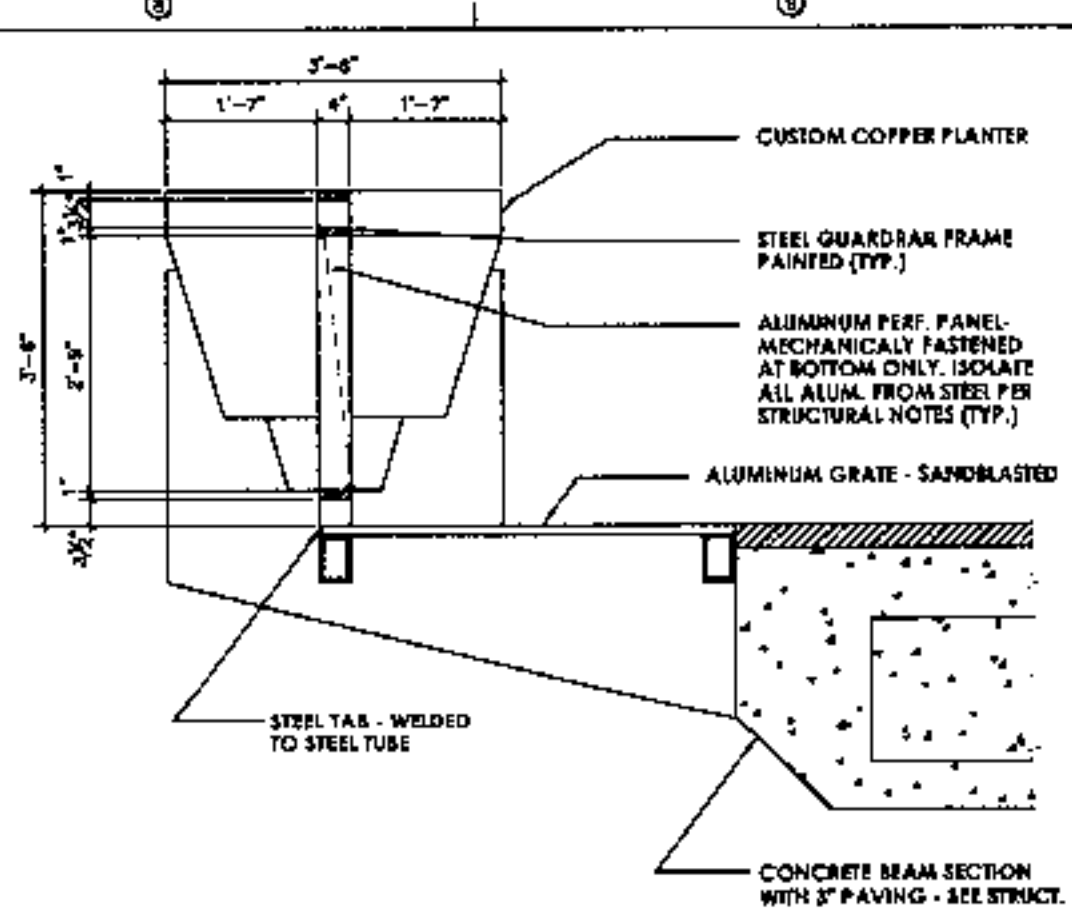


1 Guardrail Detail
SCALE: 1/2"=1'-0"

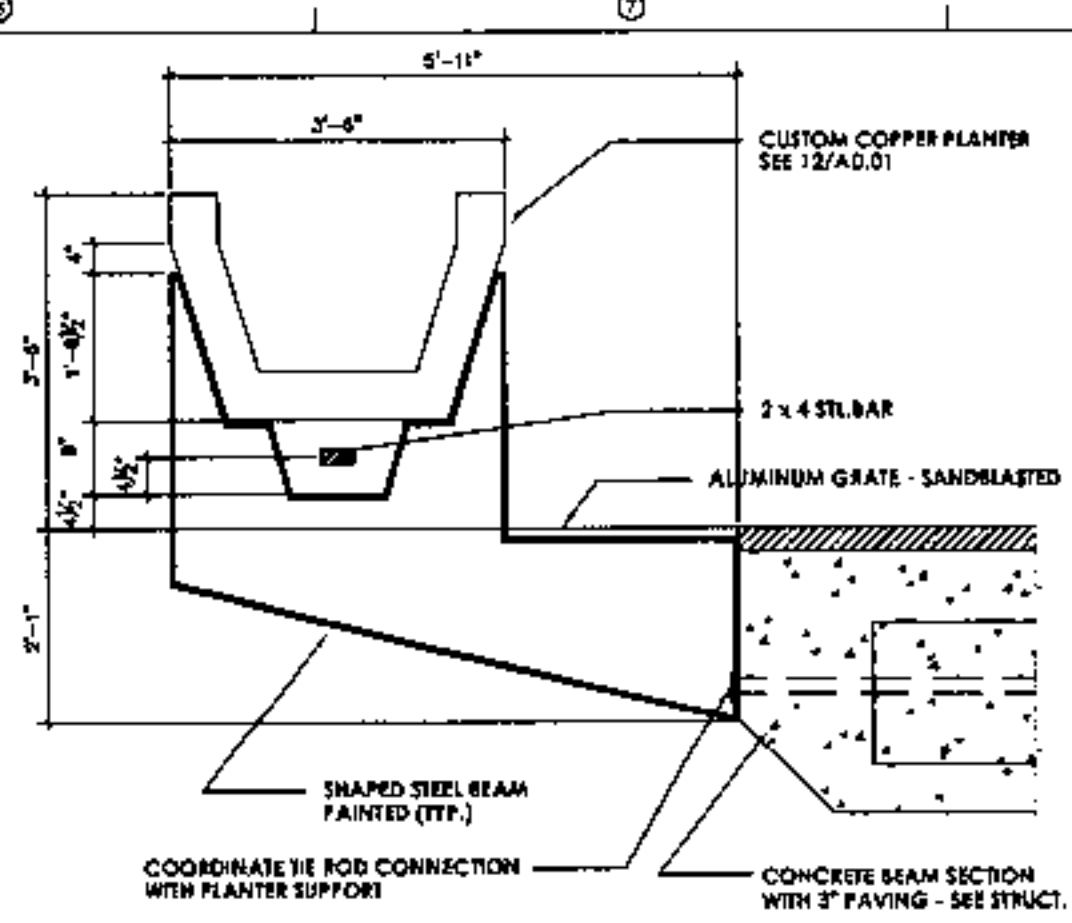


2 Planter Detail
SCALE: 1/2"=1'-0"

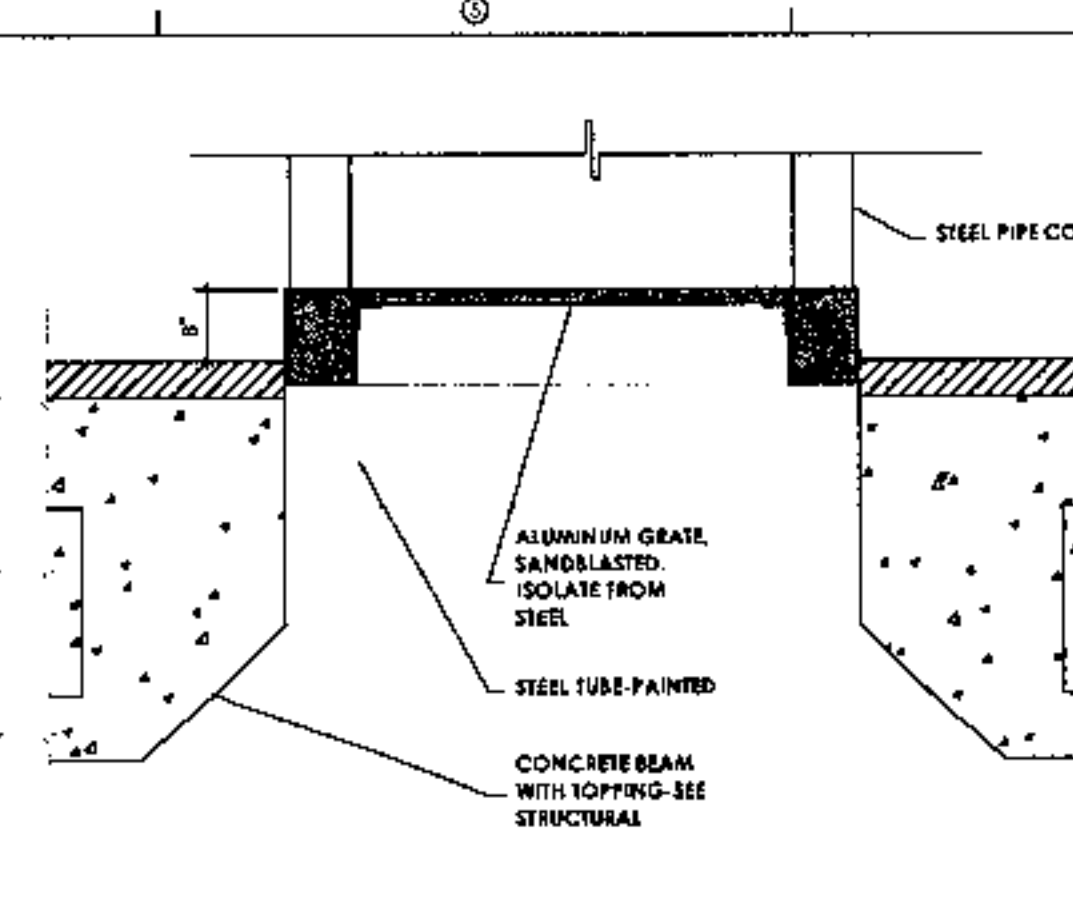


3 Grating Between Columns
SCALE: 3/4"=1'-0"

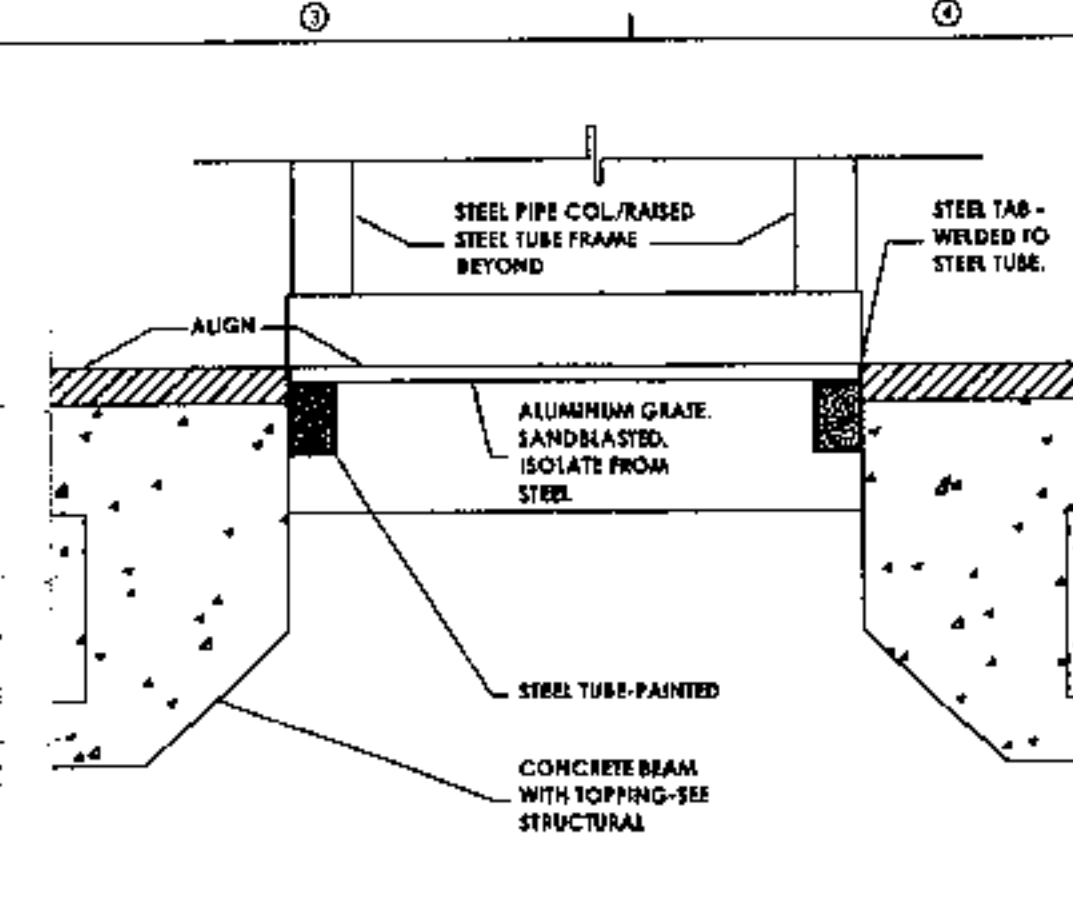


4 Grating between Conc. Beams
SCALE: 3/4"=1'-0"

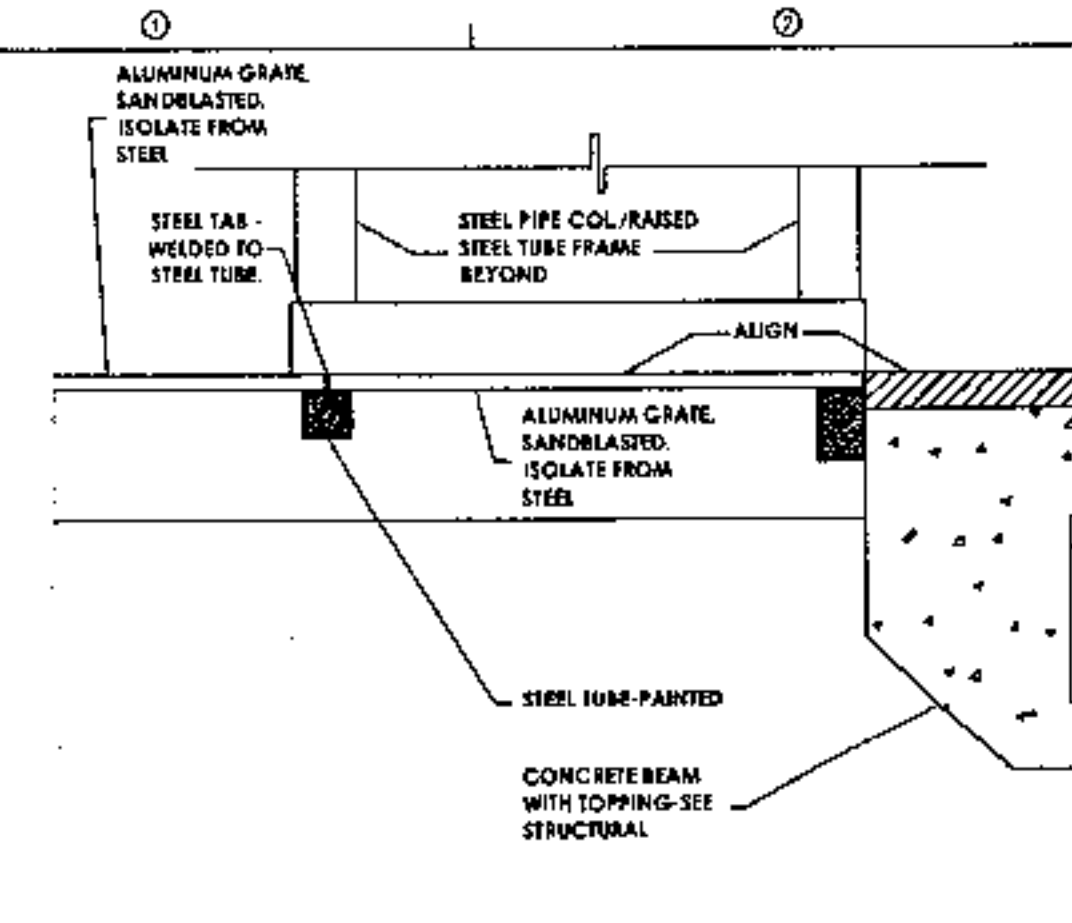


5 Continuous Grating Detail
SCALE: 3/4"=1'-0"

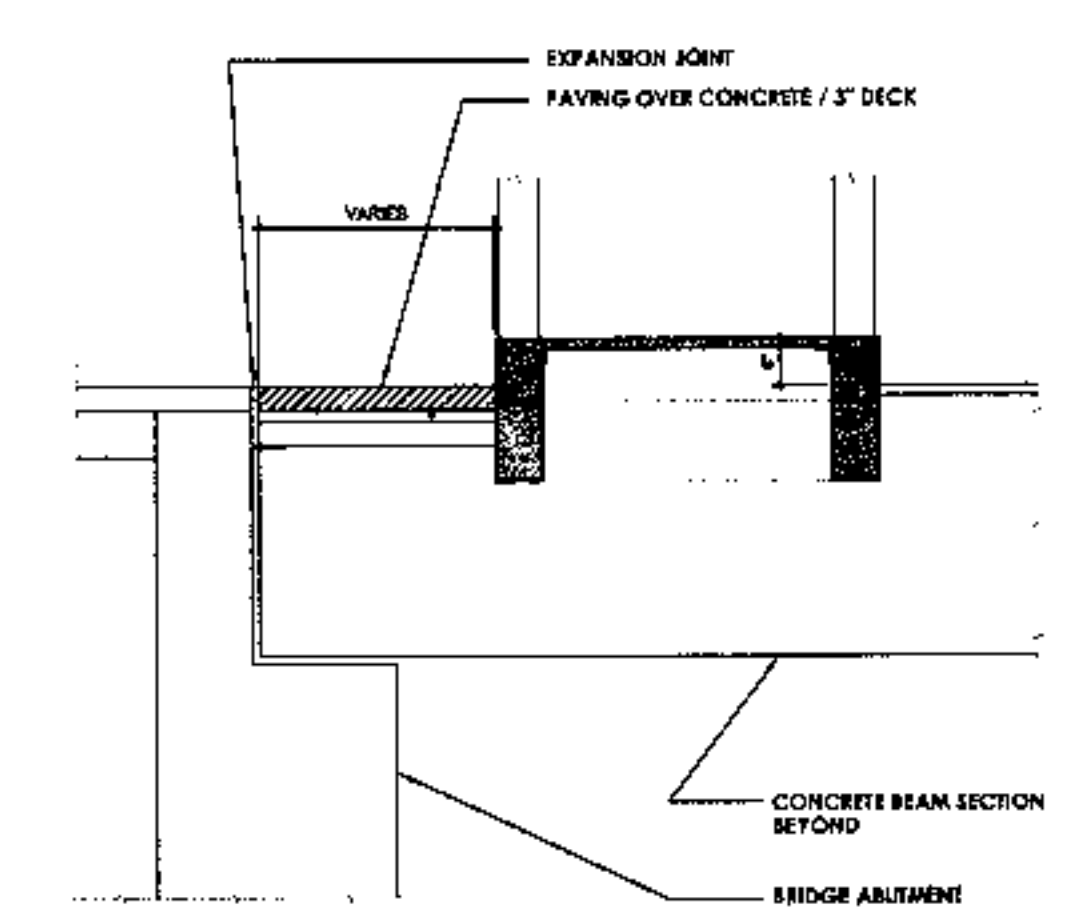


6 Infill at Curved Abutment
SCALE: 1/2"=1'-0"
(SEE DETAIL 3 FOR INFORMATION NOT NOTED HERE)

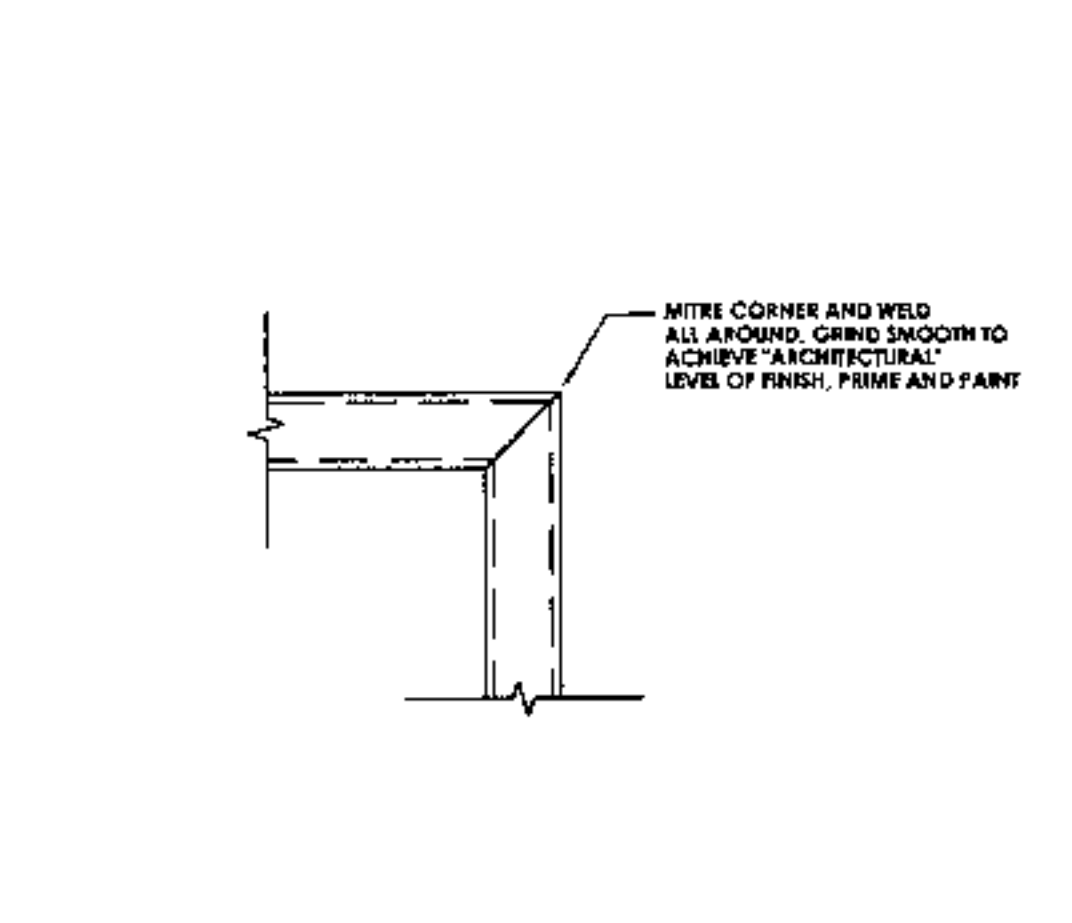


7 Beam / Beam Corner
SCALE: 1 1/2"=1'-0"

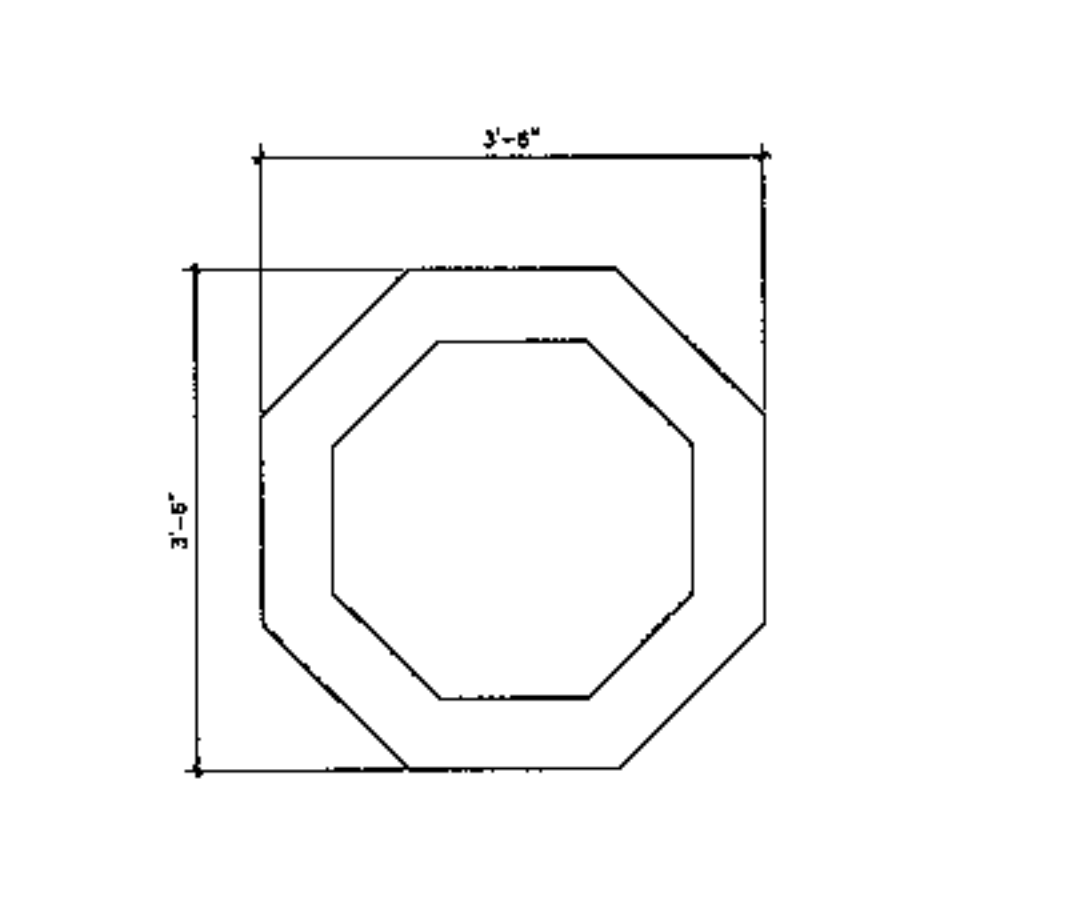


8 Planter Plan
SCALE: NTS

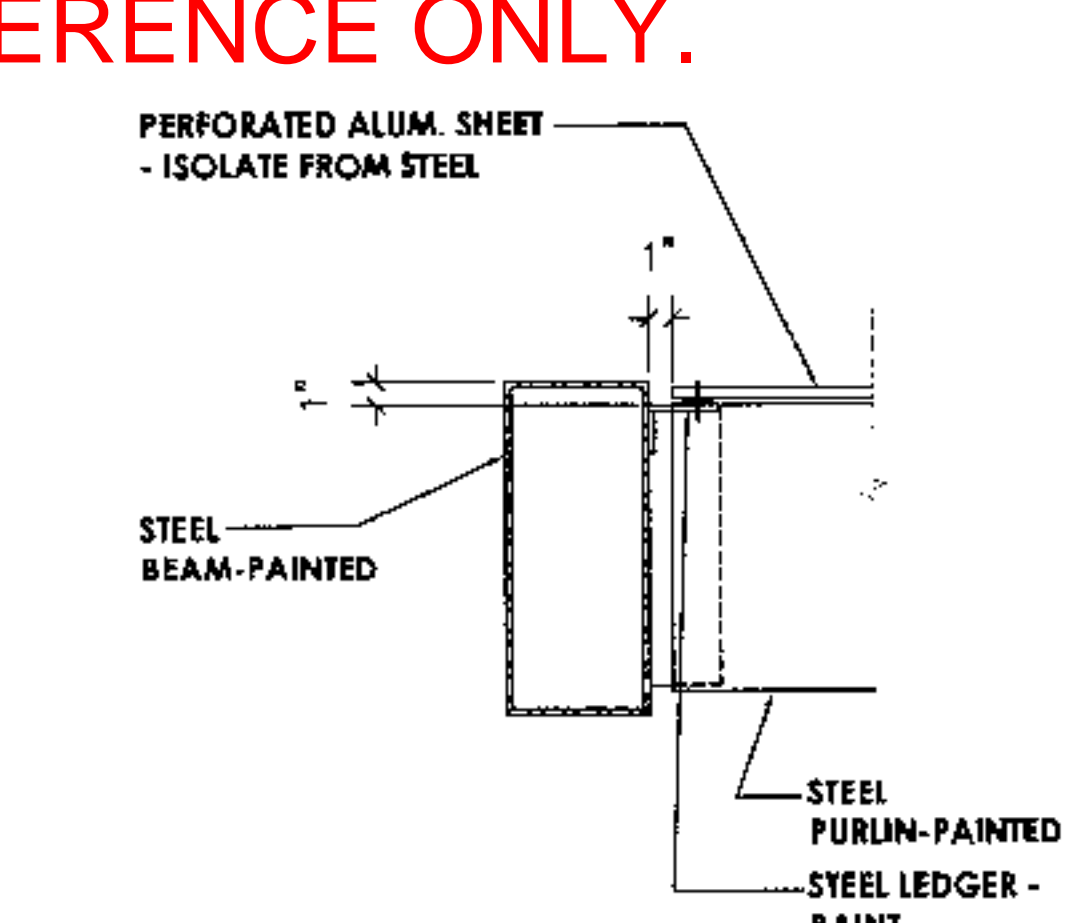


9 Alum Panel @ Edge Condition
SCALE: 1 1/2"=1'-0"

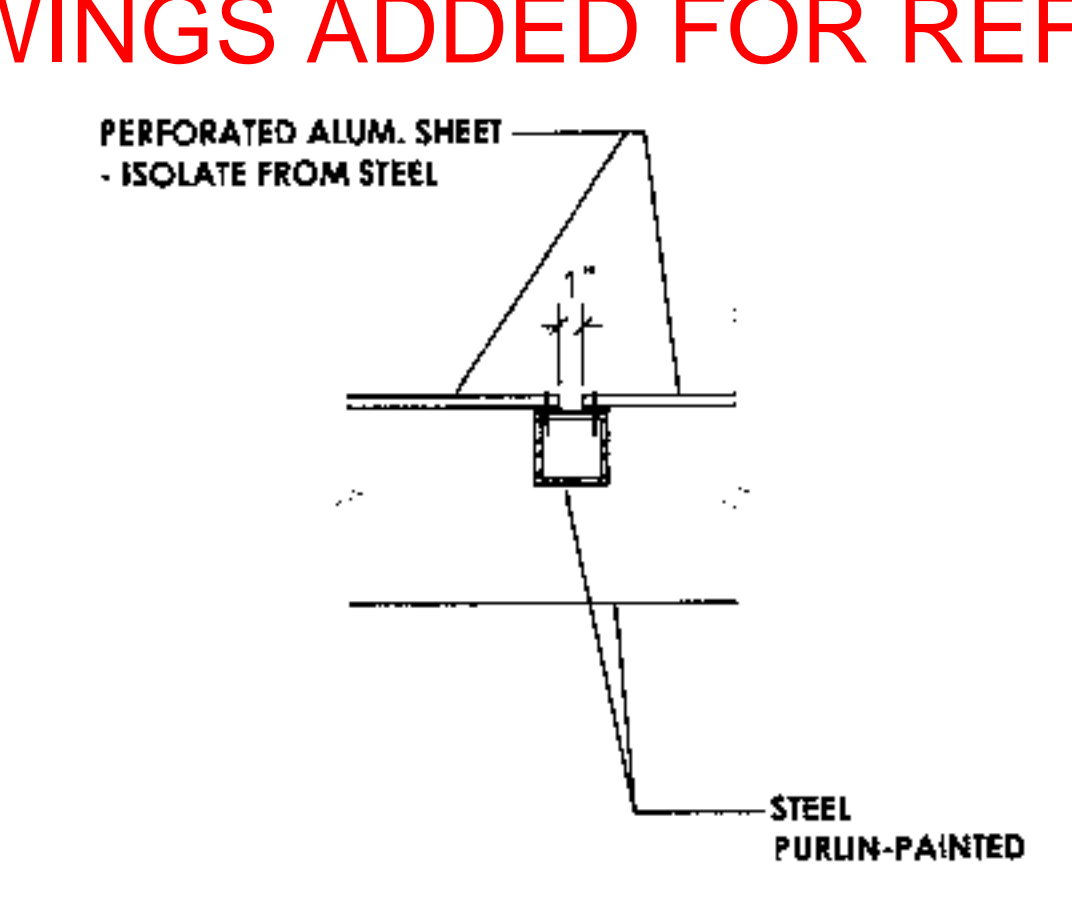


10 Alum Panel @ Purlin
SCALE: 1 1/2"=1'-0"

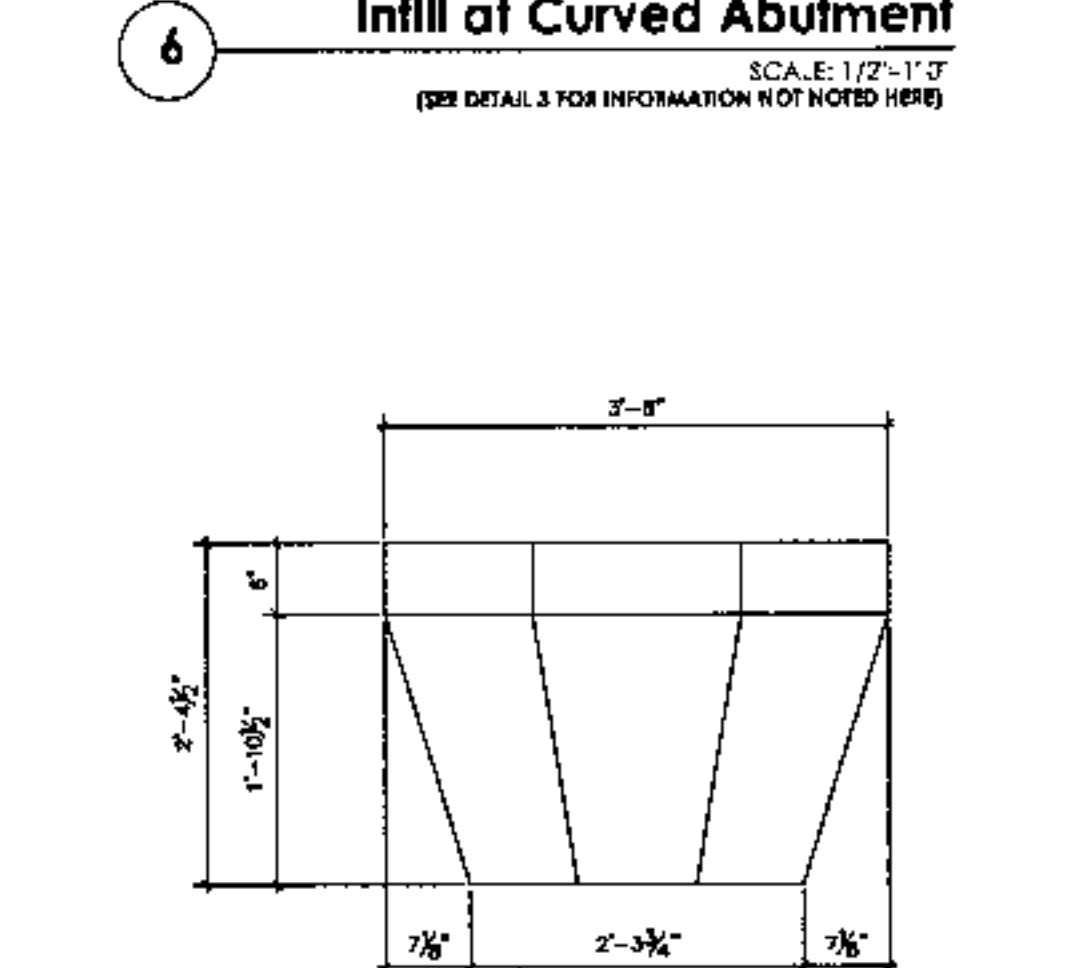


11 Planter Elevation
SCALE: NTS

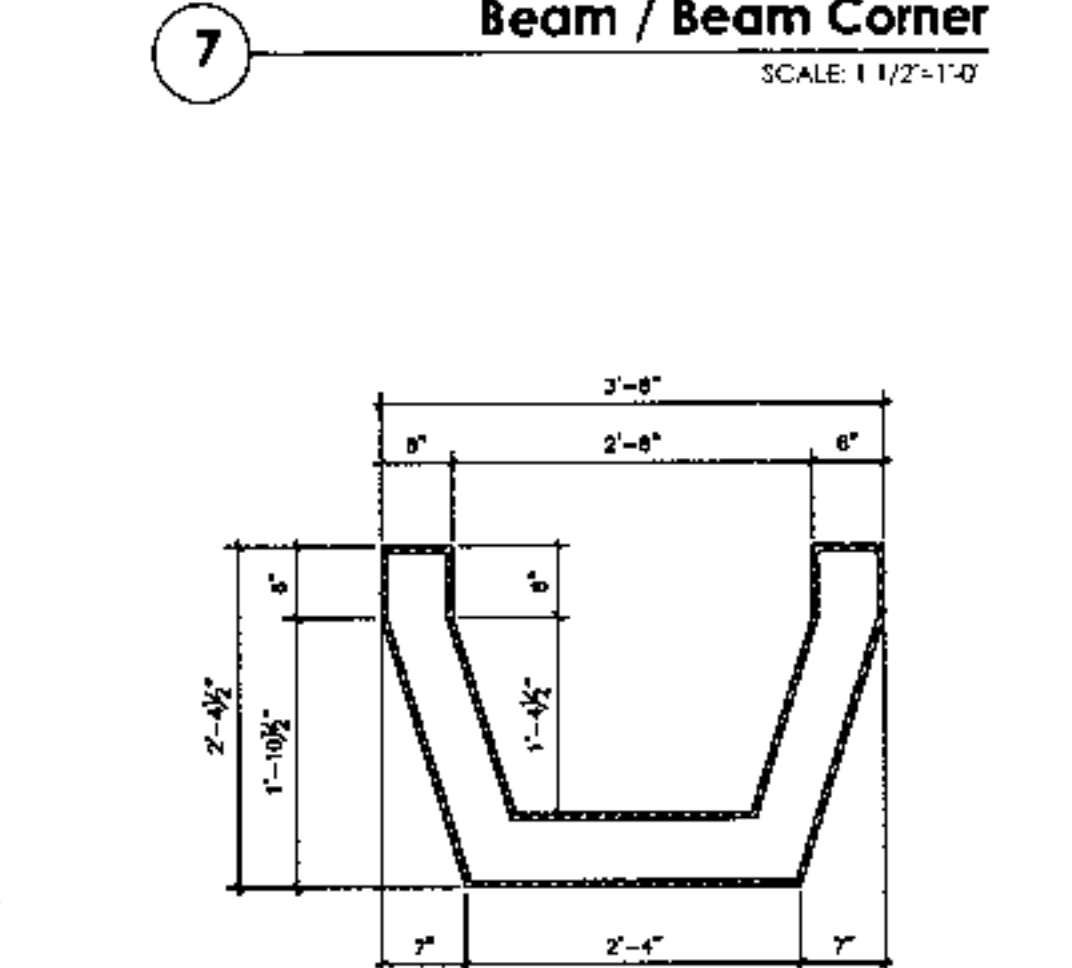


12 Planter Section
SCALE: NTS

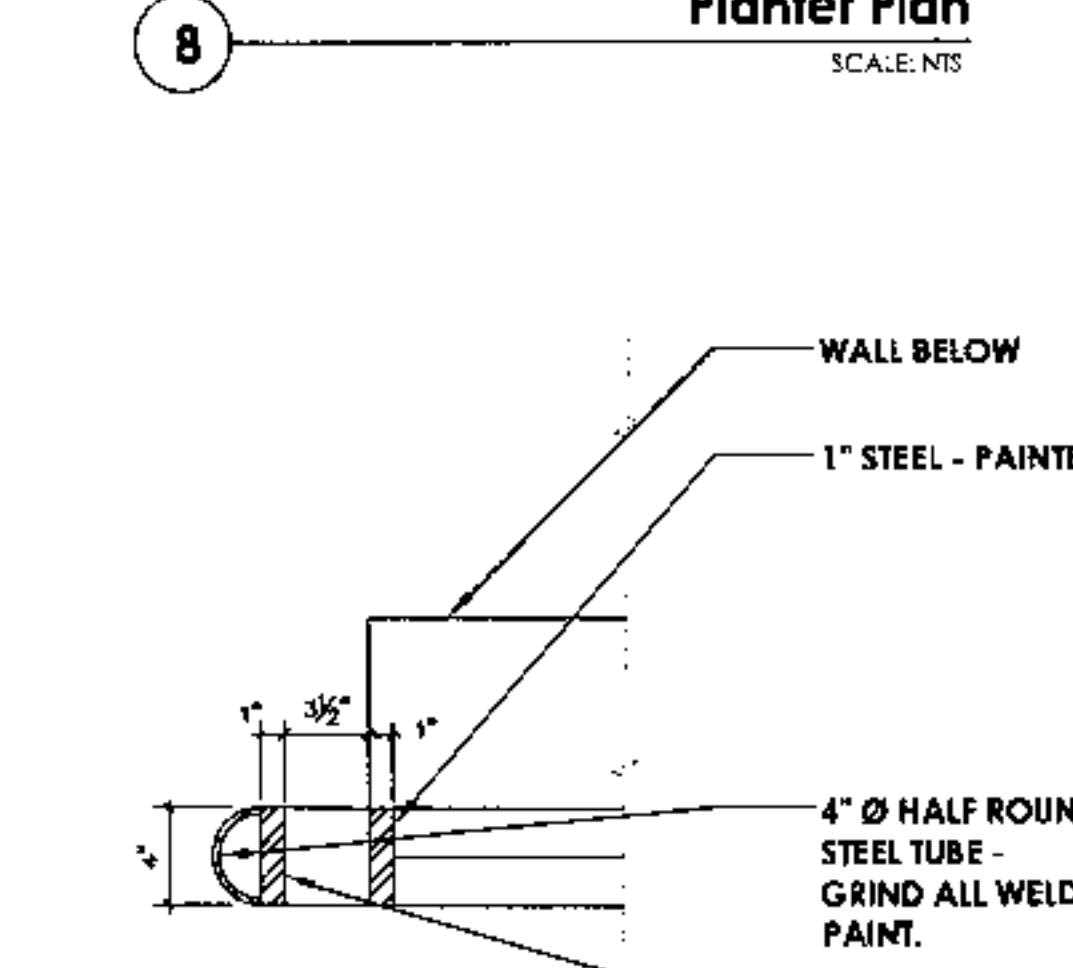


13 End @ Guardrail
SCALE: 1 1/2"=1'-0"

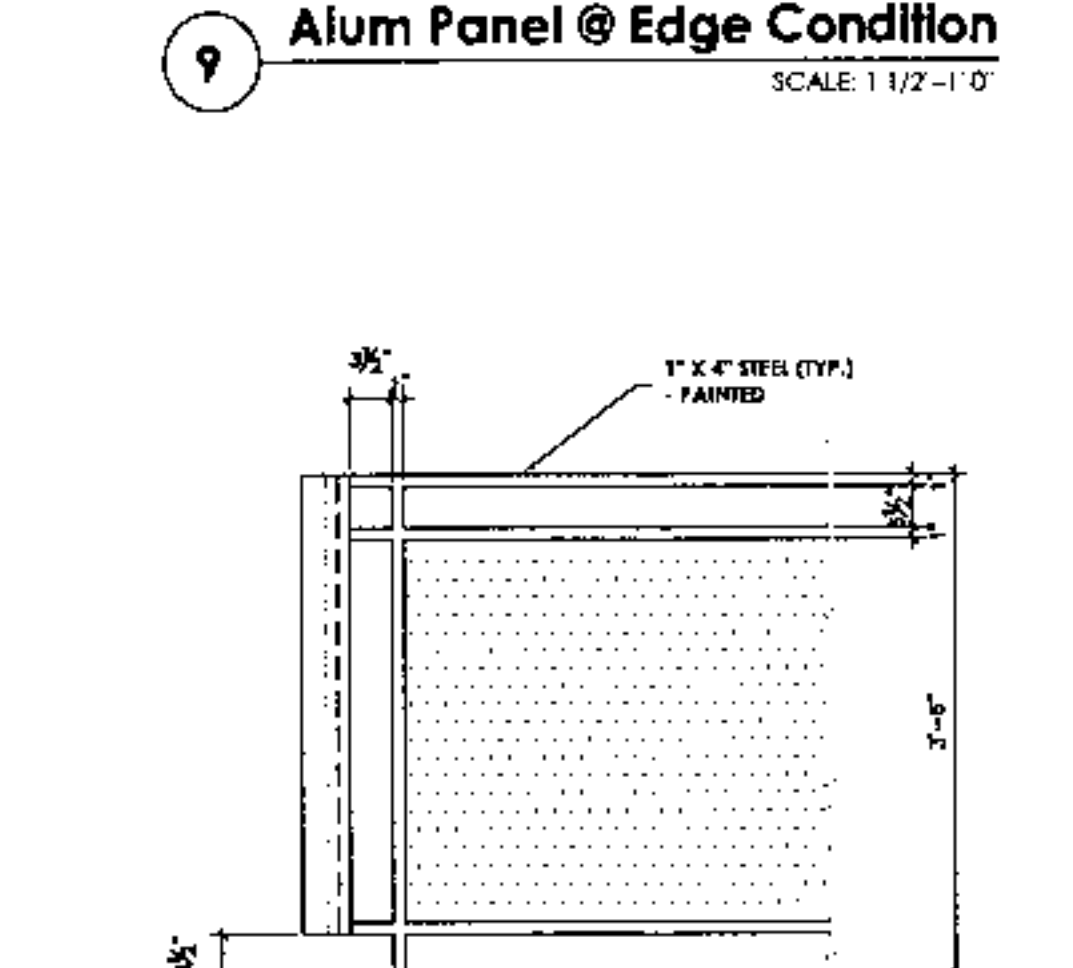


14 Typical Elevation End @ Guardrail
SCALE: 3/4"=1'-0"

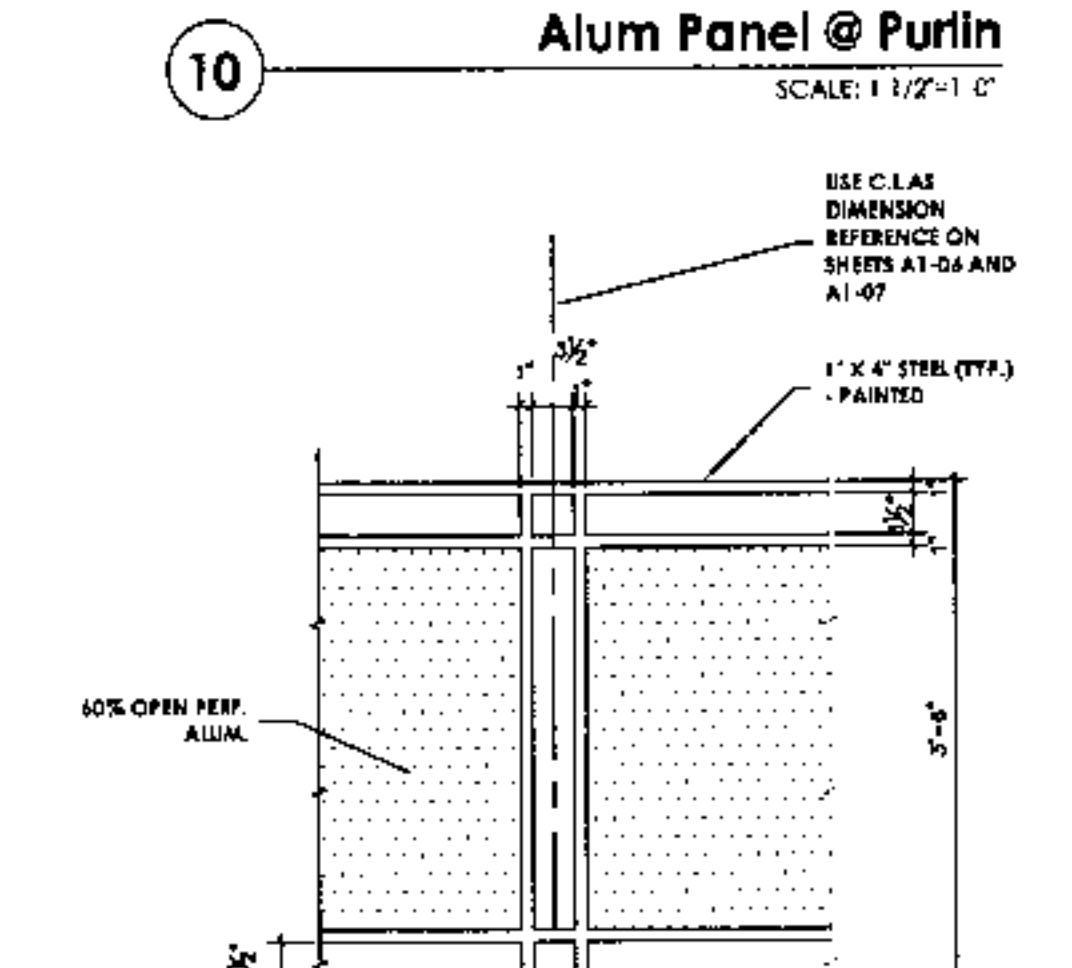


15 Typical Elevation @ Guardrail
SCALE: 3/4"=1'-0"

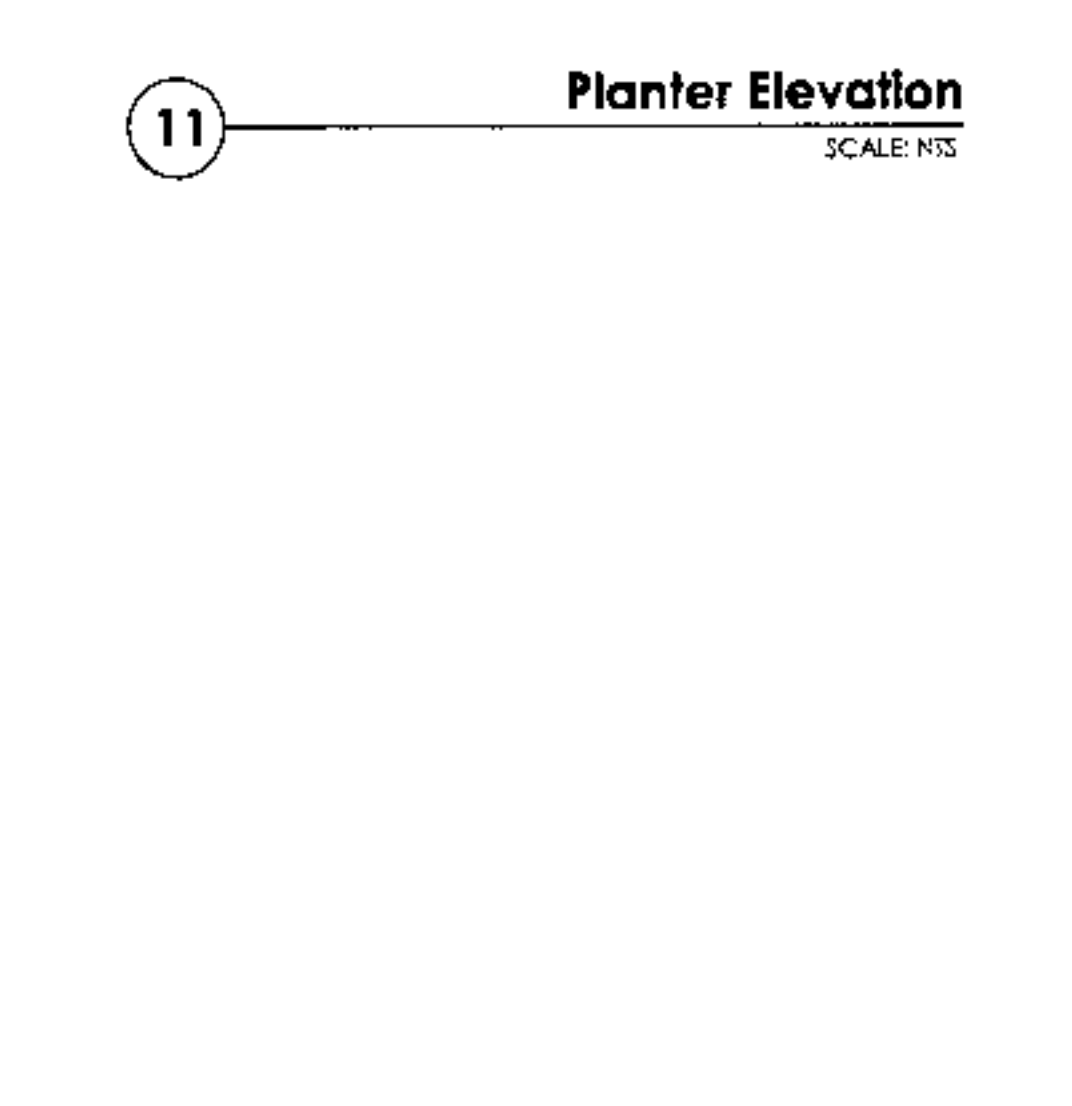


17 Guardrail Section
SCALE: 3/4"=1'-0"

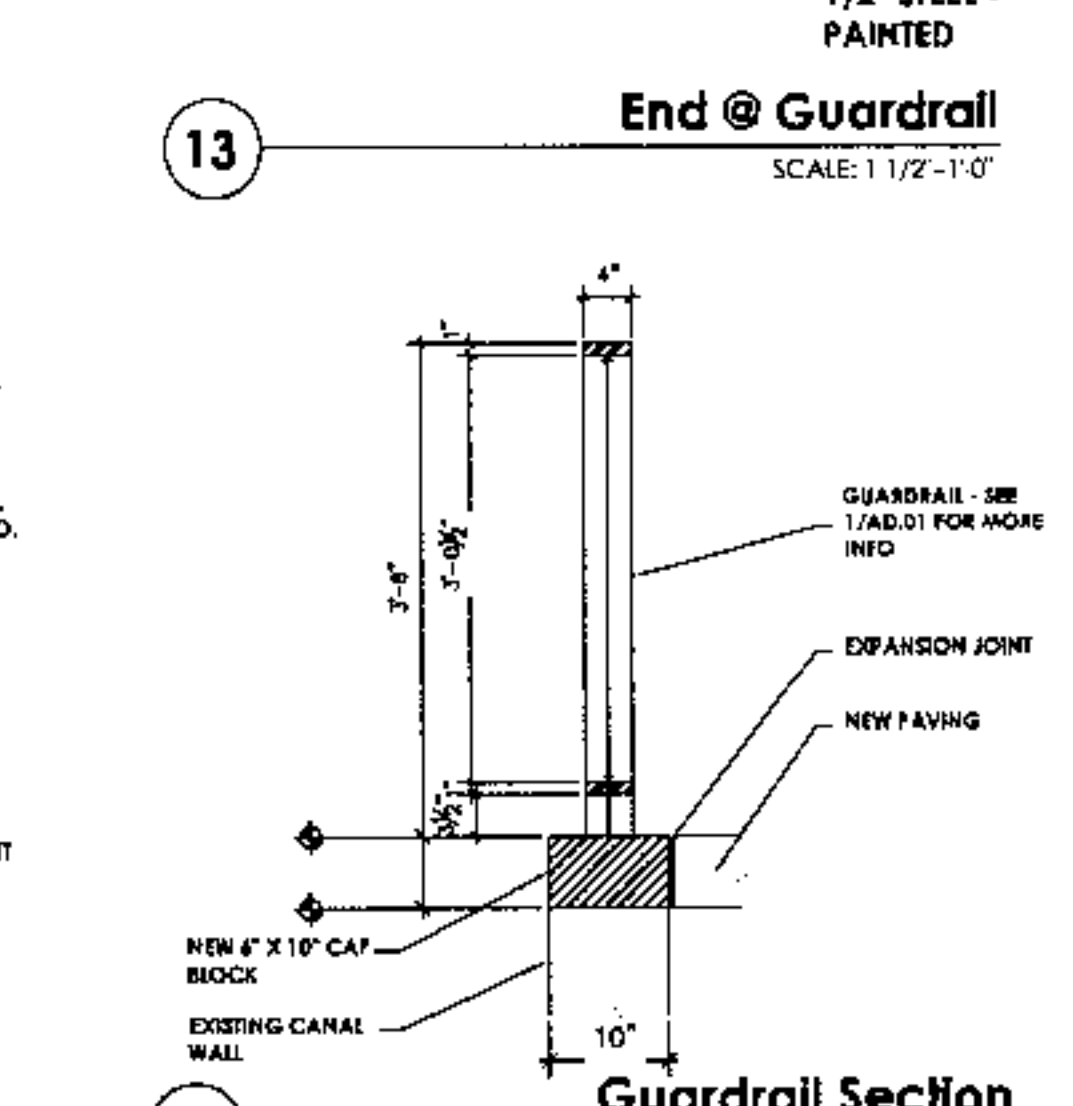

18 Guardrail Section
SCALE: 3/4"=1'-0"

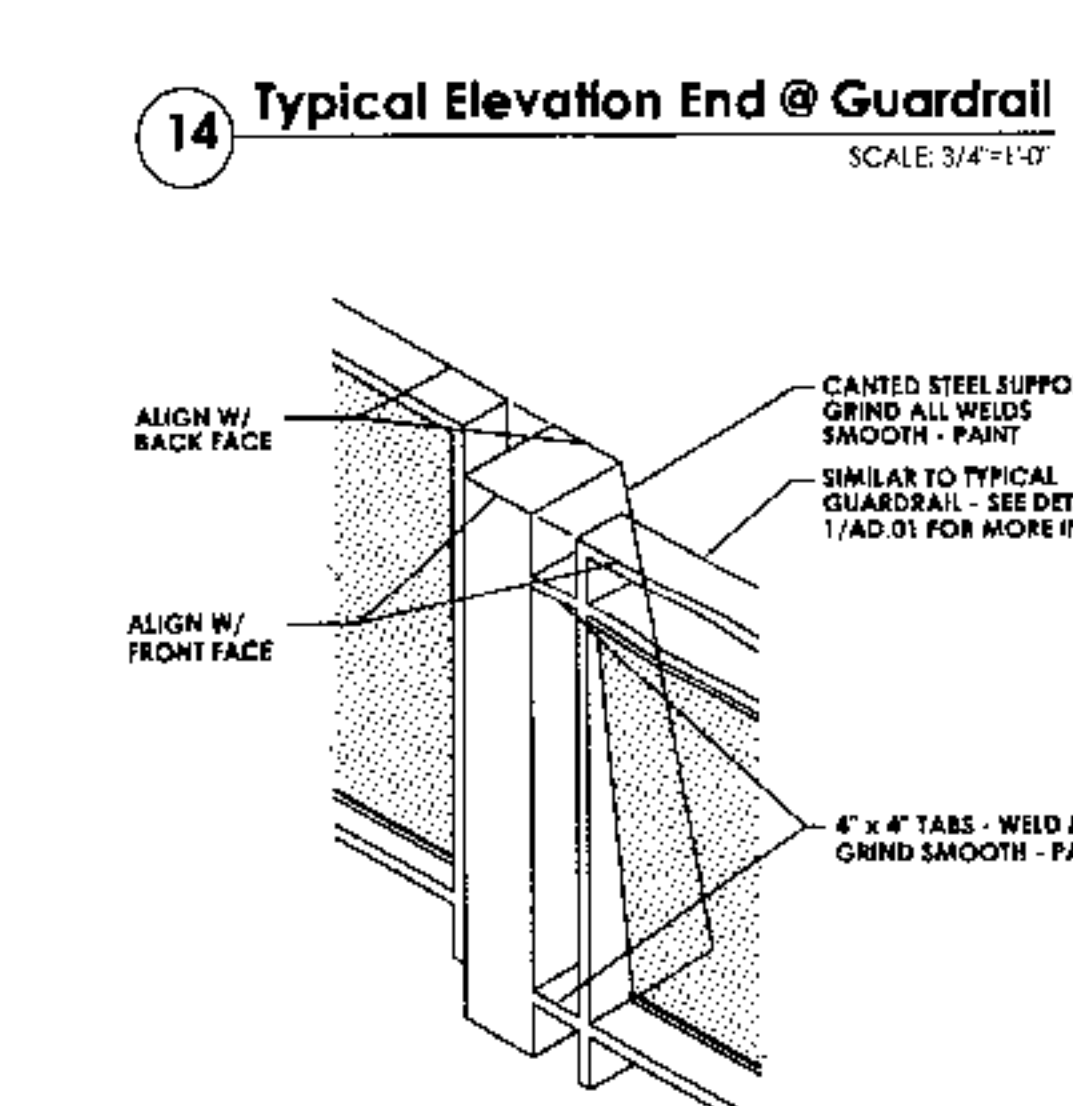

19 Typ. Guardrail @ Canted Sh. Supp.
SCALE: 1 1/2"=1'-0"

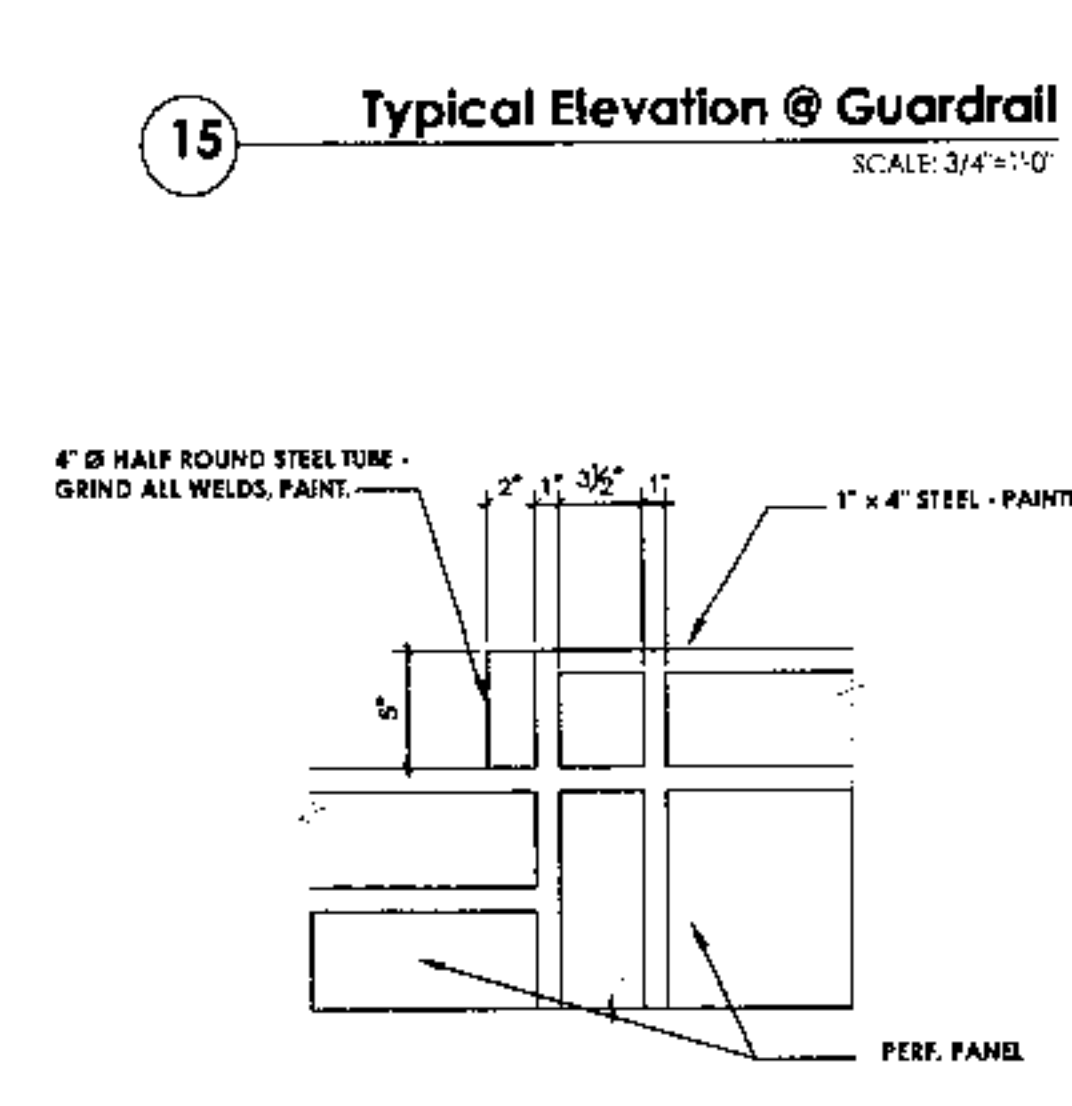

20 End @ Guardrail Transition
SCALE: 1 1/2"=1'-0"

DRAWINGS ADDED FOR REFERENCE ONLY.

General Notes:
1-Refer to Structural Drawings for further information on bridge and abutment construction.
2-Provide shop drawings for all steel, including guardrails, grating, perf. metal, and structure.

DRAWINGS ADDED FOR REFERENCE ONLY.

DESIGNWORKSHOP

Landscape Architecture • Land Planning
Urban Design • Tourism Planning

Asheville • Aspen • Denver • Jackson Hole
Park City • Santa Fe • Tempe • Lake Tahoe • Vail

310 S. Mill Avenue, Suite 201
Tempe, Arizona 85281
(480) 966-5881
Facsimile (480) 966-2799

WWW.DESIGNWORKSHOP.COM

OWNER

CITY OF SCOTTSDALE

747 E. INDIAN SCHOOL RD., SCOTTSDALE, AZ 85251
480-312-7868


**Arizona Canal
at Scottsdale - Phase I**
Scottsdale, Arizona

KEY NOTES:

1. ABUTMENT NO. 1
2. ABUTMENT NO. 2
3. GRATING
4. PRE-STRESSED CONCRETE GIRDERS W/ 3" ARCH. PAVER ON TOP.
5. CONSTRUCTION CENTER LINE
6. ABUTMENT CENTER LINE.
7. EXPANSION JOINT (SEE 1 & 2/SS-03 FOR DETAILS).
8. JOINT (SEE 5 & 6/SS-03 FOR DETAILS).
9. APPROACH SLAB.
10. BRIDGE BEARING (SEE 1/SS-03 AND 12/SS-03 FOR DETAILS).
11. BRIDGE FIXED BEARING (SEE 5/SS-03 AND 12/SS-03 FOR DETAILS).
12. FOR DETAIL SEE RS-03.

SHEET SCHEDULE

- S1-00 GENERAL PLAN
- S1-01 GENERAL STRUCTURAL NOTES
- S2-01 FOUNDATION PLAN
- S3-01 LONGITUDINAL BRIDGE SECTION
- S3-02 ABUTMENT DETAILS
- S3-04 WINGWALL PLAN
- S3-05 WINGWALL DETAILS
- S4-01 GIRDER DETAILS
- S5-01 GRATING PLAN
- S5-02 GRATING DETAILS
- S5-03 GRATING DETAILS
- S5-04 GRATING DETAILS
- S5-05 SHADE CANOPY PLAN, ELEVATION AND SECTIONS
- S5-06 SHADE CANOPY DETAILS
- S6-01 PLAZA SITE PLAN
- S6-02 SITE DETAILS

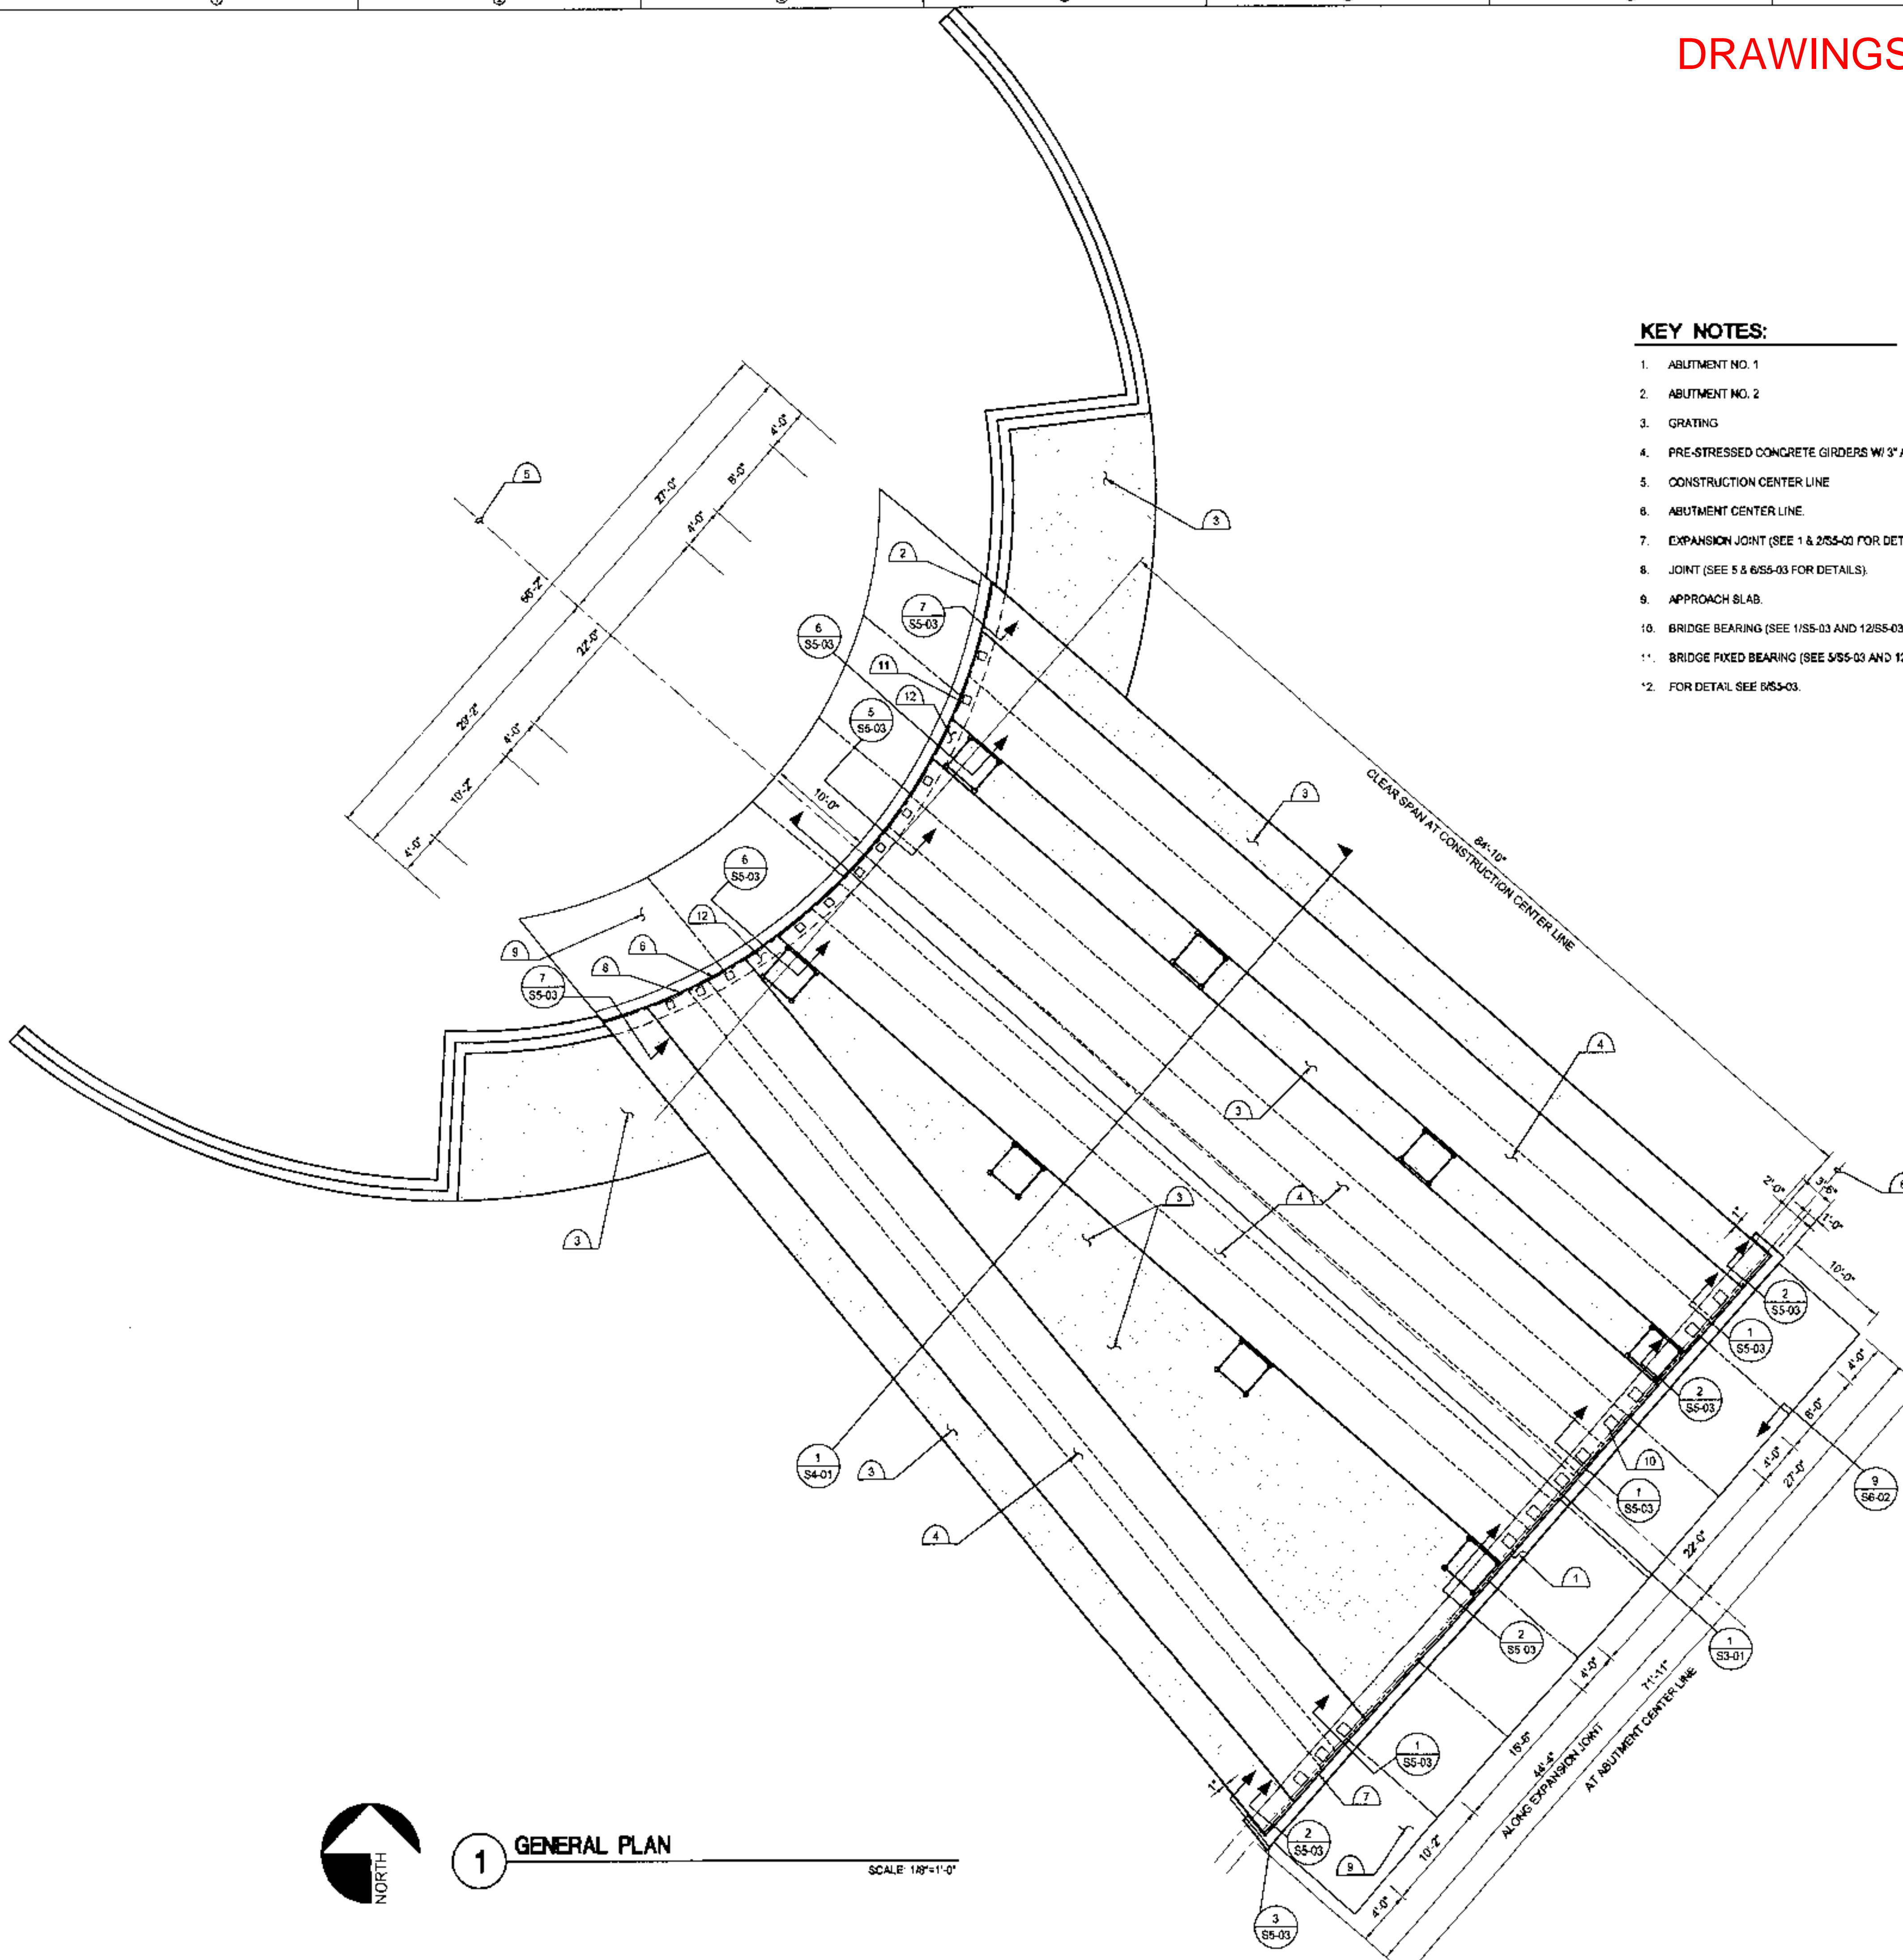

1 GENERAL PLAN
SCALE 1/8"=1'-0"



STAMP / DATE

BID DOCUMENTS
PHASE ONE

GENERAL PLAN

ISSUED FOR: BID DOCUMENTS
ISSUE DATE: OCTOBER 10, 2003

REVISIONS		
#	DATE	DESCRIPTION

DRAWN: GAALIG REVIEWED: MSP, AZ

PROJECT NUMBER: 2829

© COPYRIGHT DESIGNWORKSHOP, INC.

REVISION BY

MUNICIPAL SERVICES DEPARTMENT
CAPITAL PROJECT MANAGEMENT
3929 DRINKWATER BLVD.
SCOTTSDALE, ARIZONA 85251

kpff Consulting Engineers
2800 NORTH CENTRAL AVENUE, SUITE 1010
PHOENIX, ARIZONA 85004
PHONE (602) 264-1010 KPFF PROJECT #:
FAX (602) 265-1010 **110149.1**

PROJECT TITLE: **ARIZONA CANAL AT SCOTTSDALE-PHASE I**

DESIGNED BY	DATE	DR. NO.	SHT.
MSP/AZ	10-10-03	#04PB034	S1-00
DRAWN BY	AS-BUILT	PROJECT NO.	74 OF 89
GAALIG	0000	2829	

**Arizona Canal
at Scottsdale - Phase I
Scottsdale, Arizona**



STAMP / DATE

**BID DOCUMENTS
PHASE ONE**

**GENERAL
STRUCTURAL
NOTES**

ISSUED FOR: BID DOCUMENTS
ISSUE DATE: OCTOBER 10, 2003

REVISIONS	#	DATE	DESCRIPTION

DRAWN: GAJGJ REVIEWED: MSPAZ

PROJECT NUMBER: 2829

© COPYRIGHT DESIGNWORKSHOP, INC.



3539 DRINKWATER BLVD.
SCOTTSDALE, ARIZONA 85251

PROJECT TITLE:
ARIZONA CANAL AT SCOTTSDALE-PHASE I

DESIGNED BY: MSPAZ DATE: 10-10-03
DRAWN BY: GAJGJ DATE: 10-10-03
PROJECT NO.: 2829 SHEET NO.: 75 OF 89

GENERAL STRUCTURAL NOTES

APPLY UNLESS NOTED OTHERWISE ON STRUCTURAL DRAWINGS

CODE: COMPLY WITH 2003 IBC, AS AMENDED BY CITY OF SCOTTSDALE

LIVE LOAD: 22' ROADWAY - AASHTO HS25-44 HIGHWAY LOAD
OTHER PORTIONS 100 P.S.F.

SEISMIC: ZONE 2 B, Z = 0.075, V = .034 W

WIND: BASIC WIND SPEED 70 M.P.H., EXPOSURE C.

SHOP DRAWINGS:

1. THE CONTRACTOR SHALL INCLUDE IN HIS BID ALL COSTS ASSOCIATED WITH COMPLIANCE OF THE FOLLOWING PRE-SHOP DRAWING MEETINGS:

- A. CONTRACTOR SHALL SCHEDULE AND CARRY OUT PRE-SHOP DRAWING MEETINGS WITH THE PROJECT STRUCTURAL ENGINEER
- B. ALL SUCH MEETINGS SHALL BE HELD AT KPFF PHOENIX OFFICE.
- C. EACH TRADE DETAILER REQUIRED TO SUBMIT SHOP DRAWINGS FOR STRUCTURAL REVIEW SHALL PARTICIPATE.

2. THE STRUCTURAL SHOP DRAWING REVIEW IS INTENDED TO HELP THE ENGINEER VERIFY HIS DESIGN CONCEPT. IT IS THE CONTRACTOR'S RESPONSIBILITY TO CHECK HIS OWN SHOP DRAWINGS AND THOSE OF HIS SUBCONTRACTORS.

3. THE STRUCTURAL SHOP DRAWINGS WILL BE RETURNED FOR RESUBMITTAL IF NOT CHECKED BY CONTRACTOR OR A CURSORY REVIEW SHOWS MAJOR ERRORS WHICH SHOULD HAVE BEEN FOUND BY THE CONTRACTOR'S CHECKING.

4. CONCRETE MIX DESIGNS: SUBMITTALS SHALL BE PREPARED BY OR CERTIFIED TO CONFORM TO ACI CODE BY AN INDEPENDENT TESTING LABORATORY PRIOR TO SUBMITTING TO ARCHITECT. EACH CONCRETE MIX DESIGN SHALL BE INCLUDED WITH A COVER LETTER INDICATING ALL LOCATIONS ON THE PROJECT WHERE THE MIX WILL BE USED.

5. FOLLOWING SHOP DRAWINGS ARE NOT REQUIRED FOR SUBMITTAL FOR STRUCTURAL REVIEW:

- A. SHORING AND BRACING.
- B. PICK UP INSERT.
- C. SLAB ON GRADE REBAR AND SPREAD FOOTINGS REBAR.
- D. METAL DECK.
- E. STRUCTURAL STEEL MILL REPORTS.
- F. MESH OR REBAR FOR CONCRETE OVER COMPOSITE STEEL DECK.

6. FOLLOWING SHOP DRAWINGS AND CALCULATIONS WHEN APPLICABLE, ARE REQUIRED FOR SUBMITTAL FOR STRUCTURAL REVIEW. ALLOW THREE DAYS FOR PROCESSING AND ADDITIONAL DAY PER EACH FOUR 24 X 36 SHOP DRAWING SHEETS TO DETERMINE TURN AROUND TIME IN THE STRUCTURAL OFFICE:

- A. PRECAST OR PRESTRESSED MEMBERS.
- B. STRUCTURAL STEEL AND DECK.
- C. MISCELLANEOUS STRUCTURAL STEEL, INCLUDING ALL GUARDRAILS.
- D. SPLICED REINFORCING.
- E. LOCATION OF CONSTRUCTION AND SHRINKAGE CONTROL JOINTS.

7. ANY RESUBMITTAL OF A DETAIL SHEET WITH ADDED INFORMATION SHALL BE ACCOMPANIED BY LOCATION PLAN IDENTIFYING THE MEMBERS INVOLVED, AND CLOUDING AROUND ADDED INFORMATION.

8. DIMENSIONS WILL NOT BE CHECKED. DIMENSION CHECKING AND CHECKING OF DESIGN CHANGES PROPOSED BY CONTRACTOR WITHOUT PRIOR CONSULTATION WITH THE ENGINEER SHALL BE CHECKED ONLY IF THE CONTRACTOR WISHES THEM TO BE CHECKED AT HIS COST.

9. ANY ENGINEERING SUBMITTED FOR REVIEW SHALL BE APPROPRIATELY SEALED. FULL RESPONSIBILITY OF SUCH ENGINEERING RESTS WITH THE PERSON SEALING THE DESIGN.

STRUCTURAL OBSERVATION:

IT IS THE CONTRACTOR'S RESPONSIBILITY TO INSPECT ALL STRUCTURAL WORK FOR CONFORMANCE WITH THE CONTRACT DOCUMENTS. ANY STRUCTURAL OBSERVATION PROVIDED BY OTHERS DOES NOT RELIEVE HIM OF THIS RESPONSIBILITY. ANY STRUCTURAL OBSERVATIONS FROM THE CONTRACT DOCUMENTS THAT ARE FOUND AT A LATER DATE AND ARE DECLARED TO BE SIGNIFICANT BY THE STRUCTURAL ENGINEER SHALL BE CORRECTED BY THE CONTRACTOR WITH ALL DISPATCH. THE STRUCTURAL OBSERVER IS NOT AUTHORIZED TO DIRECT OR APPROVE ANY CHANGES FROM THE CONTRACT DOCUMENTS. IF THE CONTRACTOR WISHES TO QUESTION THE STRUCTURAL OBSERVER'S INTERPRETATION OF THE CONTRACT DOCUMENTS, HE MAY DO SO DIRECTLY WITH THE ARCHITECT OR THE STRUCTURAL ENGINEER. THE STRUCTURAL OBSERVER IS NOT AUTHORIZED TO STOP OR DELAY THE WORK. IF THE CONTRACTOR ELECTS TO CONTINUE WITH A CERTAIN WORK AFTER BEING NOTIFIED BY THE STRUCTURAL OBSERVER THAT SUCH WORK IS UNACCEPTABLE, HE DOES SO AT HIS OWN RESPONSIBILITY AND RISKS CORRECTING THE WORK AT A LESS OPPORTUNE TIME.

THE STRUCTURAL OBSERVER IS NOT INSPECTING FOR OSHA COMPLIANCE AND TEMPORARY CONSTRUCTION, SUCH AS BRACING. THE CONTRACTOR IS RESPONSIBLE FOR PROVIDING ADEQUATE FACILITIES FOR THE STRUCTURAL OBSERVER, TO ALLOW HIM TO PERFORM HIS WORK SAFELY AND EFFICIENTLY.

SPECIAL STRUCTURAL INSPECTION:

SPECIAL STRUCTURAL INSPECTION BY SPECIAL OBSERVERS SATISFACTORY TO THE BUILDING OFFICIAL IS REQUIRED FOR THE FOLLOWING TYPES OF WORK IN CONFORMANCE WITH IBC CODE AND CITY OF SCOTTSDALE BUILDING INSPECTION DEPARTMENT NEWSLETTERS:

- 1. CONCRETE: DURING THE TAKING OF TEST SPECIMENS AND PLACING OF REINFORCED CONCRETE EXCEPT SLABS ON GRADE.
- 2. BOLTS INSTALLED IN CONCRETE: DURING INSTALLATION OF EMBEDDED BOLTS IN CONCRETE AND DURING INSTALLATION OF EXPANSION BOLTS AND EPOXY BOLTS/REBAR INTO EXISTING CONCRETE.
- 3. REINFORCING STEEL AND PRESTRESSING STEEL.
- 4. SPECIAL GRADING, EXCAVATION AND FILL.
- 5. FOUNDATIONS AND CAISSONS.
- 6. WELDING.

A. DURING PLACING OF REINFORCING STEEL, PLACING OF TENDONS AND PRESTRESSING STEEL FOR ALL CONCRETE REQUIRED TO HAVE SPECIAL INSPECTION BY ITEM 1, ABOVE AND PLACING REINFORCING STEEL IN EPOXIED HOLES PER ITEM 2, ABOVE.

B. DURING ALL STRESSING AND GROUTING OF PRESTRESSED CONCRETE.

4. WELDING:
A. DURING ALL STRUCTURAL WELDING, INCLUDING WELDING OF REINFORCING STEEL.

FOUNDATIONS:

SOIL REPORT BY: RICKER ATKINSON MUEBE & ASSOCIATES, INC., R.A.M. PROJECT NO. G07880, AUGUST 16, 2002.

BOTTOMS OF CAISSON FOUNDATIONS SHALL BE PER DRAWINGS. THE CONTRACTOR SHALL ASSUME THE RISK OF ACTUAL DEPTH BEING GREATER.

DUE TO THE COLLAPSE POTENTIAL OF THE INRAE-SURFACE SITE SOILS, AND THE CLOSE PROXIMITY OF THE BRIDGE FOUNDATIONS TO THE EXISTING CANAL BANK, THE MARSHALL WAY BRIDGE SHOULD BE SUPPORTED BY DRILLED SHAFTS EXTENDING TO A DEPTH OF AT LEAST 15 FEET BELOW THE PILE CAP. THE ALLOWABLE CAPACITY FOR A SINGLE, STRAIGHT SHAFT DRILLED PIER WITH 4.0 FT. DIAMETER AND VARIOUS DEPTHS FOR THE BRIDGE SITE IS SHOWN BELOW:

DEPTH	ALLOWABLE PIER (4'-0" DIAMETER CAISSON) CAPACITY (KIPS)
15 FT.	126.3
20 FT.	150.0
25 FT.	161.0

CONCRETE:

SHALL MEET ALL THE REQUIREMENTS OF ACI 301 WITH TYPE II CEMENT. MINIMUM 28 DAY STRENGTH 4,000 P.S.I., EXCEPT AS FOLLOWS:

PRESTRESSED GIRDERS: 6,000 P.S.I.

CONCRETE TOPPING OVER PRECAST: 5,000 P.S.I.
*GREATER IF REQUIRED BY PRECAST MANUFACTURER

SIDEWALKS, CURBS, AND GUTTERS,
SLABS ON GRADE: 2,500 P.S.I.

FOUNDATIONS: 4,000 P.S.I.

NO ADMIXTURES WITHOUT APPROVAL. ADMIXTURES CONTAINING CHLORIDES SHALL NOT BE USED. CONCRETE SHALL NOT BE IN CONTACT WITH ALUMINUM.

CONCRETE SHALL BE PLACED WITHIN 90 MINUTES OF BATCHING AND SHALL NOT EXCEED A TEMPERATURE OF 90 DEGREES FAHRENHEIT UNLESS PREAPPROVED BY THE ENGINEER.

MIX DESIGNS FOR CONCRETE CONTAINING FLY ASH SHALL BE BY AN INDEPENDENT TESTING LABORATORY. ONLY ASTM 0518 CLASS F FLY ASH SHALL BE USED. FLY ASH SHALL BE BY PHOENIX CEMENT OR WESTERN ASH COMPANY. THE AMOUNT OF FLY ASH USED SHALL NOT EXCEED 20 PERCENT BY WEIGHT OF THE COMBINED WEIGHT OF FLY ASH PLUS CEMENT.

MECHANICALLY VIBRATE ALL CONCRETE WHEN PLACED, EXCEPT THAT SLABS ON GRADE NEED BE VIBRATED ONLY AROUND EMBEDDED ITEMS. SLUMP 5 INCHES. DO NOT TAMP SLABS. USE ROLLER BUG, VIBRATING SCREED OR BULL FLOAT TO FINISH. DO NOT ADD WATER TO CONCRETE AT SITE.

ALL REINFORCING, INCLUDING DOWELS AND ANCHOR BOLTS, SHALL BE SECURELY TIED IN LOCATION BEFORE PLACING CONCRETE OR GROUT. DOWELS WILL NOT BE ALLOWED TO BE "STABBED" IN.

TAPE JOINTS WITH 6 INCH LAPS AND COVER WITH SAND. CURING COMPOUND FOR OTHER WORK SHALL BE COMPATIBLE WITH APPLIED FINISH. CONFORM TO ASTM C-509 AND SHALL BE CLEAR ON UNCOVERED STRUCTURE AND WHITE PIGMENTED ON COVERED STRUCTURE. APPLY AT A RATE SUFFICIENT TO RETAIN MOISTURE, BUT NOT LESS THAN 1 GALLON PER 200 SQUARE FEET.

HIGH-RANGE WATER REDUCING ADMIXTURE

THE CONTRACTOR SHALL USE SUPER PLASTICIZER ADMIX IN LOCATIONS INDICATED ON DRAWINGS AND SHALL CONSIDER ITS USE WHERE CONGESTION OF REBAR IS LIKELY TO CAUSE ROCK POCKETS. THE CEMENT FOR THE MIX SHALL BE TYPE II. THE RATE OF PLACING SUCH CONCRETE SHALL BE REDUCED OR THE FORM STRENGTH SHALL BE INCREASED TO SAFELY RESIST INCREASED PRESSURE AGAINST FORMS. THE USE OF THE ADMIX SHALL BE IN STRICT ACCORDANCE WITH THE MANUFACTURER'S SPECIFICATIONS, ASTM C494 TYPE F OR G, AND ACI RECOMMENDATIONS. DO NOT USE WITH COLORED CONCRETE.

MAXIMUM SLUMP MAY BE INCREASED OVER SPECIFIED SLUMP BUT SHALL NOT EXCEED 8".

REINFORCING:

ASTM A-615 GRADE 60 EXCEPT AS FOLLOWS:

#2 BARS: GRADE 40

#7 AND LARGER BARS TO BE WELDED: A-708

WIRE MESH, FLAT SHEETS: A-165

WELDED ANCHORS: GRADE 40, CHEMICAL ANALYSIS LIMITED PER AWS SPEC FOR WELD WITHOUT PREHEAT. ALSO SEE "WELDING" BELOW.

ALL REINFORCING BARS DEFORMED EXCEPT #2 BARS AND WIRE MESH. LATEST ACI CODE AND DETAILING MANUAL APPLY. CLEAR CONCRETE COVERAGES TO ANY REINFORCING INCLUDING TIES ARE AS FOLLOWS:
CONCRETE PLACED AGAINST ROUGH EARTH: 3"

*ALL OTHER: 1 1/2"

*7" COVERAGE FOR FORMED CONCRETE EXPOSED TO EARTH OR WEATHER IS REQUIRED FOR #6 OR LARGER REBAR. SMALLER CLEARANCES PERMISSIBLE FOR PRECAST OR PRESTRESSED.

LAP SPLICES IN CONCRETE: SEE DRAWINGS. UNLESS NOTED OTHERWISE, PROVIDE THE FOLLOWING LAP SPLICES:
#3, 16", #4, 22", #5, 27", #6, 35", #7, 40", #8, 63", #9, 80", #10, 102", #11, 125"
MINIMUM CLEAR COVER FOR SPLICED REINFORCING IS GREATER THAN ONE BAR DIAMETER, AND MINIMUM CLEAR SPACING IS GREATER THAN TWO BAR DIAMETERS. SPLICE BOTTOM BAR OVER SUPPORTS AND TOP BAR AT MIDSPAN ONLY. WHERE BARS ARE SHOWN SPLICED, THEY MAY RUN CONTINUOUS AT CONTRACTOR'S OPTION.

ALL SPLICE LOCATIONS SUBJECT TO APPROVAL. PROVIDE REQUIRED SHOP DRAWINGS AND FABRICATE AFTER THE ARCHITECT'S REVIEW. SEE SHOP DRAWING SECTION ABOVE. PLACE REBAR PER CRSI MANUAL. REBAR SPACINGS GIVEN ARE MAXIMUM ON CENTER UNLESS OTHERWISE STATED AS "O.C." OR NOT, AND ALL REBAR IS CONTINUOUS UNLESS OTHERWISE STATED AS "CONT." OR NOT. PROVIDE BENT CORNER REBAR TO MATCH AND LAP WITH HORIZONTAL REBAR AT CORNERS AND INTERSECTION OF WALLS, BEAMS, BOND BEAMS AND FOOTINGS PER ACI MANUAL. DOWEL ALL VERTICAL REBAR TO FOUNDATIONS. SECURELY TIE ALL REBAR, INCLUDING DOWELS, IN LOCATION BEFORE PLACING CONCRETE OR GROUT.

WHERE REINFORCING IS SHOWN CONTINUOUS THRU CONSTRUCTION JOINTS, LENTON FORM SAVERS DOWEL BAR SPLICE DEVICES AS MANUFACTURED BY ERICO PRODUCTS, INC. (OR EQUIVALENT) MAY BE USED. SIZES AND TYPES SHALL BE SELECTED TO DEVELOP THE FULL TENSION STRENGTH OF THE BAR PER ICBO RESEARCH REPORT.

STRUCTURAL STEEL:

ASTM A572 GRADE 50 WITH SPECIAL REQUIREMENTS PER AISI TECHNICAL BULLETIN 3 FOR ALL WIDE FLANGE SECTIONS AND ASTM A-36 FOR ALL OTHER SECTIONS EXCEPT AS FOLLOWS: PIPE STEEL: ASTM A-53 GRADE B OR A-501. TUBE STEEL: ASTM A-500 GRADE B (FY = 45 KSI) FOR SIZES UP TO 5/8" THICK. ASTM A-501 (FY = 36 KSI) FOR OTHERS UP TO 1" THICK. ASTM A572 GRADE 50 FOR MEMBERS SPECIFICALLY MARKED ON PLANS AND SCHEDULES WITH SYMBOL (50). STRUCTURAL MEMBERS IN AISI GROUPS 4 AND 5 "JUMBO SECTIONS" SHALL BE KILLED FINE-GRAINED STEEL. PLAIN BOLTS, ASTM A-307, PLAIN ANCHOR BOLTS, ASTM A-307 OR ASTM A-36. HIGH STRENGTH ANCHOR BOLTS: ASTM A499 OR A325. HIGH STRENGTH BOLTS, ASTM A-325-N. TESTED BY A CALIBRATED WRENCH UNLESS LOAD INDICATOR BOLTS ARE USED. HIGH STRENGTH BOLTS SHALL BE TIGHTENED TO "SNUG TIGHT" CONDITION PER AISI, UNLESS SPECIFICALLY CALLED OUT TO BE "TORQUED AND TESTED" BY A CALIBRATED TORQUE WRENCH. OPEN WEB JOISTS PER STEEL JOIST INSTITUTE SPECIFICATIONS. LATEST AISI MANUAL PARTS 1 THROUGH 4 AND AISI SPECIFICATIONS APPLY (EXCEPT SECTION 47 AND CHAPTER 4) AND EXCLUDING SECTIONS 3 AND 4 OF THE "AISC CODE OF STANDARD PRACTICE." (DESIGNER NOTE: EDIT OUT REFERENCE TO A-501 FOR TUBES IF NONE EXIST WITH WALL THICKNESS GREATER THAN 5/8")

MINIMUM EMBEDMENT OF ALL HORIZONTAL BOLTS AND PLAIN ANCHORS IN GROUT OR CONCRETE SHALL BE 5 INCHES INCLUDING HEAD OR 6 INCHES WITH A 3 INCH HOOK. VERTICAL BOLTS SHALL HAVE 8 INCHES VERTICAL EMBEDMENT INCLUDING HEAD OR 8 INCHES WITH A 3 INCH HOOK. WELDED "ANCHORS" AND WELDED ANCHOR BOLTS SHALL BE HEADED STUDS, WELDED ALL AROUND WITH 5/16 INCH FILLET WELD AND SHALL NOT CONTAIN THREADS. "HEADED ANCHOR STUDS (H.A.S.)" AND "SHEAR CONNECTORS" SHALL BE USED ONLY WHERE SPECIFICALLY CALLED FOR AND SHALL BE NELSON OR KSM INSTALLED PER MANUFACTURER'S RECOMMENDATIONS. THEY SHALL BE 3/4 INCH DIAMETER X 5 INCHES LONG UNLESS NOTED OTHERWISE.

SEE MECHANICAL DRAWINGS FOR MECHANICAL EQUIPMENT SUPPORT FRAMING AND SPREADERS.

STEEL STAIRS AND RAILINGS SHALL CONFORM TO THE CURRENT EDITION OF THE METAL STAIRS MANUAL BY NAIMA, 221 NORTH LASALLE STREET, CHICAGO, ILLINOIS. IN CASE OF CONFLICT SEE SUPPLEMENTARY SECTION THIS SHEET.

PROVISIONS FOR TEMPERATURE EXPANSION DURING ERECTION: STRUCTURAL STEEL SHALL BE SO DETAILED AND ERECTED SO THAT DURING ERECTION, BEFORE THE DECK IS COVERED AND INSULATED, TEMPERATURE CHANGES ANTICIPATED, DO NOT CAUSE UNACCEPTABLE PERMANENT MISALIGNMENT AND DO NOT THRUST OR PULL AGAINST WALLS OR OTHER ADJOINING CONSTRUCTION TO CAUSE THEM TO BE OVERSTRESSED OR DAMAGED. SUCH PROVISIONS CAN BE MADE BY PROVIDING TEMPORARY SLIP CONNECTIONS AT SUFFICIENT INTERVALS.

TEFLON BEARING PADS: TEFLON BEARING PADS SHALL HAVE LOW-FRICTION SLIDING SURFACES BETWEEN STEEL PLATES. MATERIAL SHALL BE 3/32 INCH THICK WITH SPECIALLY FORMULATED TEFLON TO BEARING SURFACE. TEFLON TO BE SPECIAL FORMULATION SHALL BE REINFORCED WITH GLASS FIBER AND OTHER AGGREGATES. LOW FRICTION (03 TO 06), AND CHEMICALLY INERT CHARACTERISTICS. MATERIALS SHALL BE BONDED TO 10 GAUGE CARBON STEEL PLATES WITH 1/4 INCH LIP. BEARING SURFACES SHALL BE FLUOROCOD FC-1025-05 AS PROVIDED BY FLUOROCARBON CO. OR APPROVED EQUIVALENT. MAXIMUM 2,000 P.S.I. BEARING PRESSURE.

SEE "WELDING" SECTION FOR SPECIAL REQUIREMENTS.

PERFORATED PANELS:

SHALL BE 6062-T34 ALUMINUM ALLOY. PANELS WITH 50% OPEN AREA SHALL HAVE 1/4" DIA. HOLES AT 5/16" STAGGERED CENTERS, 12 HOLES P.S.I. FABRICATED BY MENCHOLS CO. PANELS WITH 40% OPEN AREA SHALL HAVE 1/4" DIA. HOLES AT 3/8" STAGGERED CENTERS, 8.5 HOLES P.S.I. FABRICATED BY MENCHOLS CO. WITH A 3" SOLID METAL BORDER AROUND ALL PERIMETERS OF PERFORATED METAL. SANDBLAST BOTH SIDES.

SEE SPECIFICATIONS FOR SEPARATION MATERIAL REQUIRED BETWEEN ALUMINUM AND STEEL.

FASTENERS: ALUMINUM TO STEEL, #14 STAINLESS STEEL X 3/4" SELF TAPPING SCREWS WITH WEATHER SEAL WASHERS.

SEE "WELDING" SECTION FOR SPECIAL REQUIREMENTS.

ALUMINUM GRATING:

SHALL BE PROVIDED IN ACCORDANCE WITH ANSIN/ANMM METAL BAR GRATING MANUAL, SIXTH EDITION, CAPABLE OF CARRYING A SAFE LIVE LOAD OF 100 POUNDS PER SQUARE FOOT. TOP AND BOTTOM SHOULD BE SANDBLASTED. FASTEN TO SUPPORTS WITH SADDLE CLIPS WHERE GRATING IS TO BE REMOVABLE AND USING WELDING ELSEWHERE. BANDING BARS SHOULD BE PROVIDED TO THE ENDS OF THE BEARING BARS IN REMOVABLE GRATING PANELS.

WELDING:

ALL BRIDGE STEEL CONNECTIONS AT STRUCTURE AND ALL GUARDRAILS MUST BE GROUND SMOOTH AND FINISHED TO AN "ARCHITECTURAL EXPOSED STRUCTURAL STEEL LEVEL" PER AISC.

ALL CONSTRUCTION AND TESTING PER AMERICAN WELDING SOCIETY CODES AND RECOMMENDATIONS. ALL WELDING SHALL BE BY WELDERS HOLDING CURRENT VALID CERTIFICATES AND HAVING CURRENT EXPERIENCE IN TYPE OF WELD CALLED FOR.

WELDING RODS TO BE LOW HYDROGEN TYPE, E70 SERIES, PER AWS D1.1 TYPICALLY EXCEPT E-6010 SERIES FOR STEEL SHEET METAL PER AWS D1.3 AND REINFORCING WELDMENTS PER AWS D1.4. USE E90 SERIES WELDING RODS FOR A708 REBAR.

ALL FULL-PENETRATION GROOVE OR BUTT WELDED SPLICES IN MATERIAL THICKER THAN 5/16" SHALL BE INSPECTED BY AN INDEPENDENT TESTING LABORATORY, WHICH SHALL TEST ULTRASONICALLY A SUFFICIENT NUMBER OF WELDS BUT NOT LESS THAN 25 PERCENT OF TOTAL PER WELDER, TO CERTIFY ALL SPLICES AS MEETING OR EXCEEDING STRENGTH OF MATERIAL SPLICED. TWO COPIES OF ALL TEST REPORTS AND A LETTER OF SUCH CERTIFICATION SHALL BE SUBMITTED TO THE ARCHITECT.

SHOP INDICATED WELDS MAY BE DONE IN FIELD.

CONCRETE GIRDERS:


PRESTRESSED PRETENSIONED HARDROCK ITEMS SHALL BE AS MANUFACTURED BY TPAC (CB0 PFC-2755), CONESLAB (IC80 PFC-4121) OR APPROVED EQUAL. MANUFACTURER SHALL BE RESPONSIBLE FOR DESIGN OF THESE ITEMS FOR LOADS IN ADDITION TO THEIR WEIGHT AS SHOWN ON PLANS, & SHALL INFORM THE ARCHITECT PRIOR TO BIDDING, IF LARGER THAN SPECIFIED SIZES BECOME ADVISABLE.

SUBSTITUTION TO THE DESIGN SHOWN WILL NOT BE PERMITTED UNLESS APPROVED PRIOR TO BIDDING. IF CONTRACTOR ELECTS TO SUBSTITUTE, HE SHALL BE RESPONSIBLE FOR ALL ADDED COORDINATION, COSTS & TIME REQUIRED TO ACHIEVE THE DESIGN INTENT.

PRESTRESSING STRANDS SHALL HAVE SUFFICIENT COVER FOR MIN. TWO HOUR FIRE RATINGS.

DRAWINGS ADDED FOR REFERENCE ONLY.

kpff Consulting Engineers
2800 NORTH CENTRAL AVENUE, SUITE 1010
PHOENIX, ARIZONA 85004
PHONE (602) 264-1010
FAX (602) 265-1010
KPFF PROJECT #: 110149.1

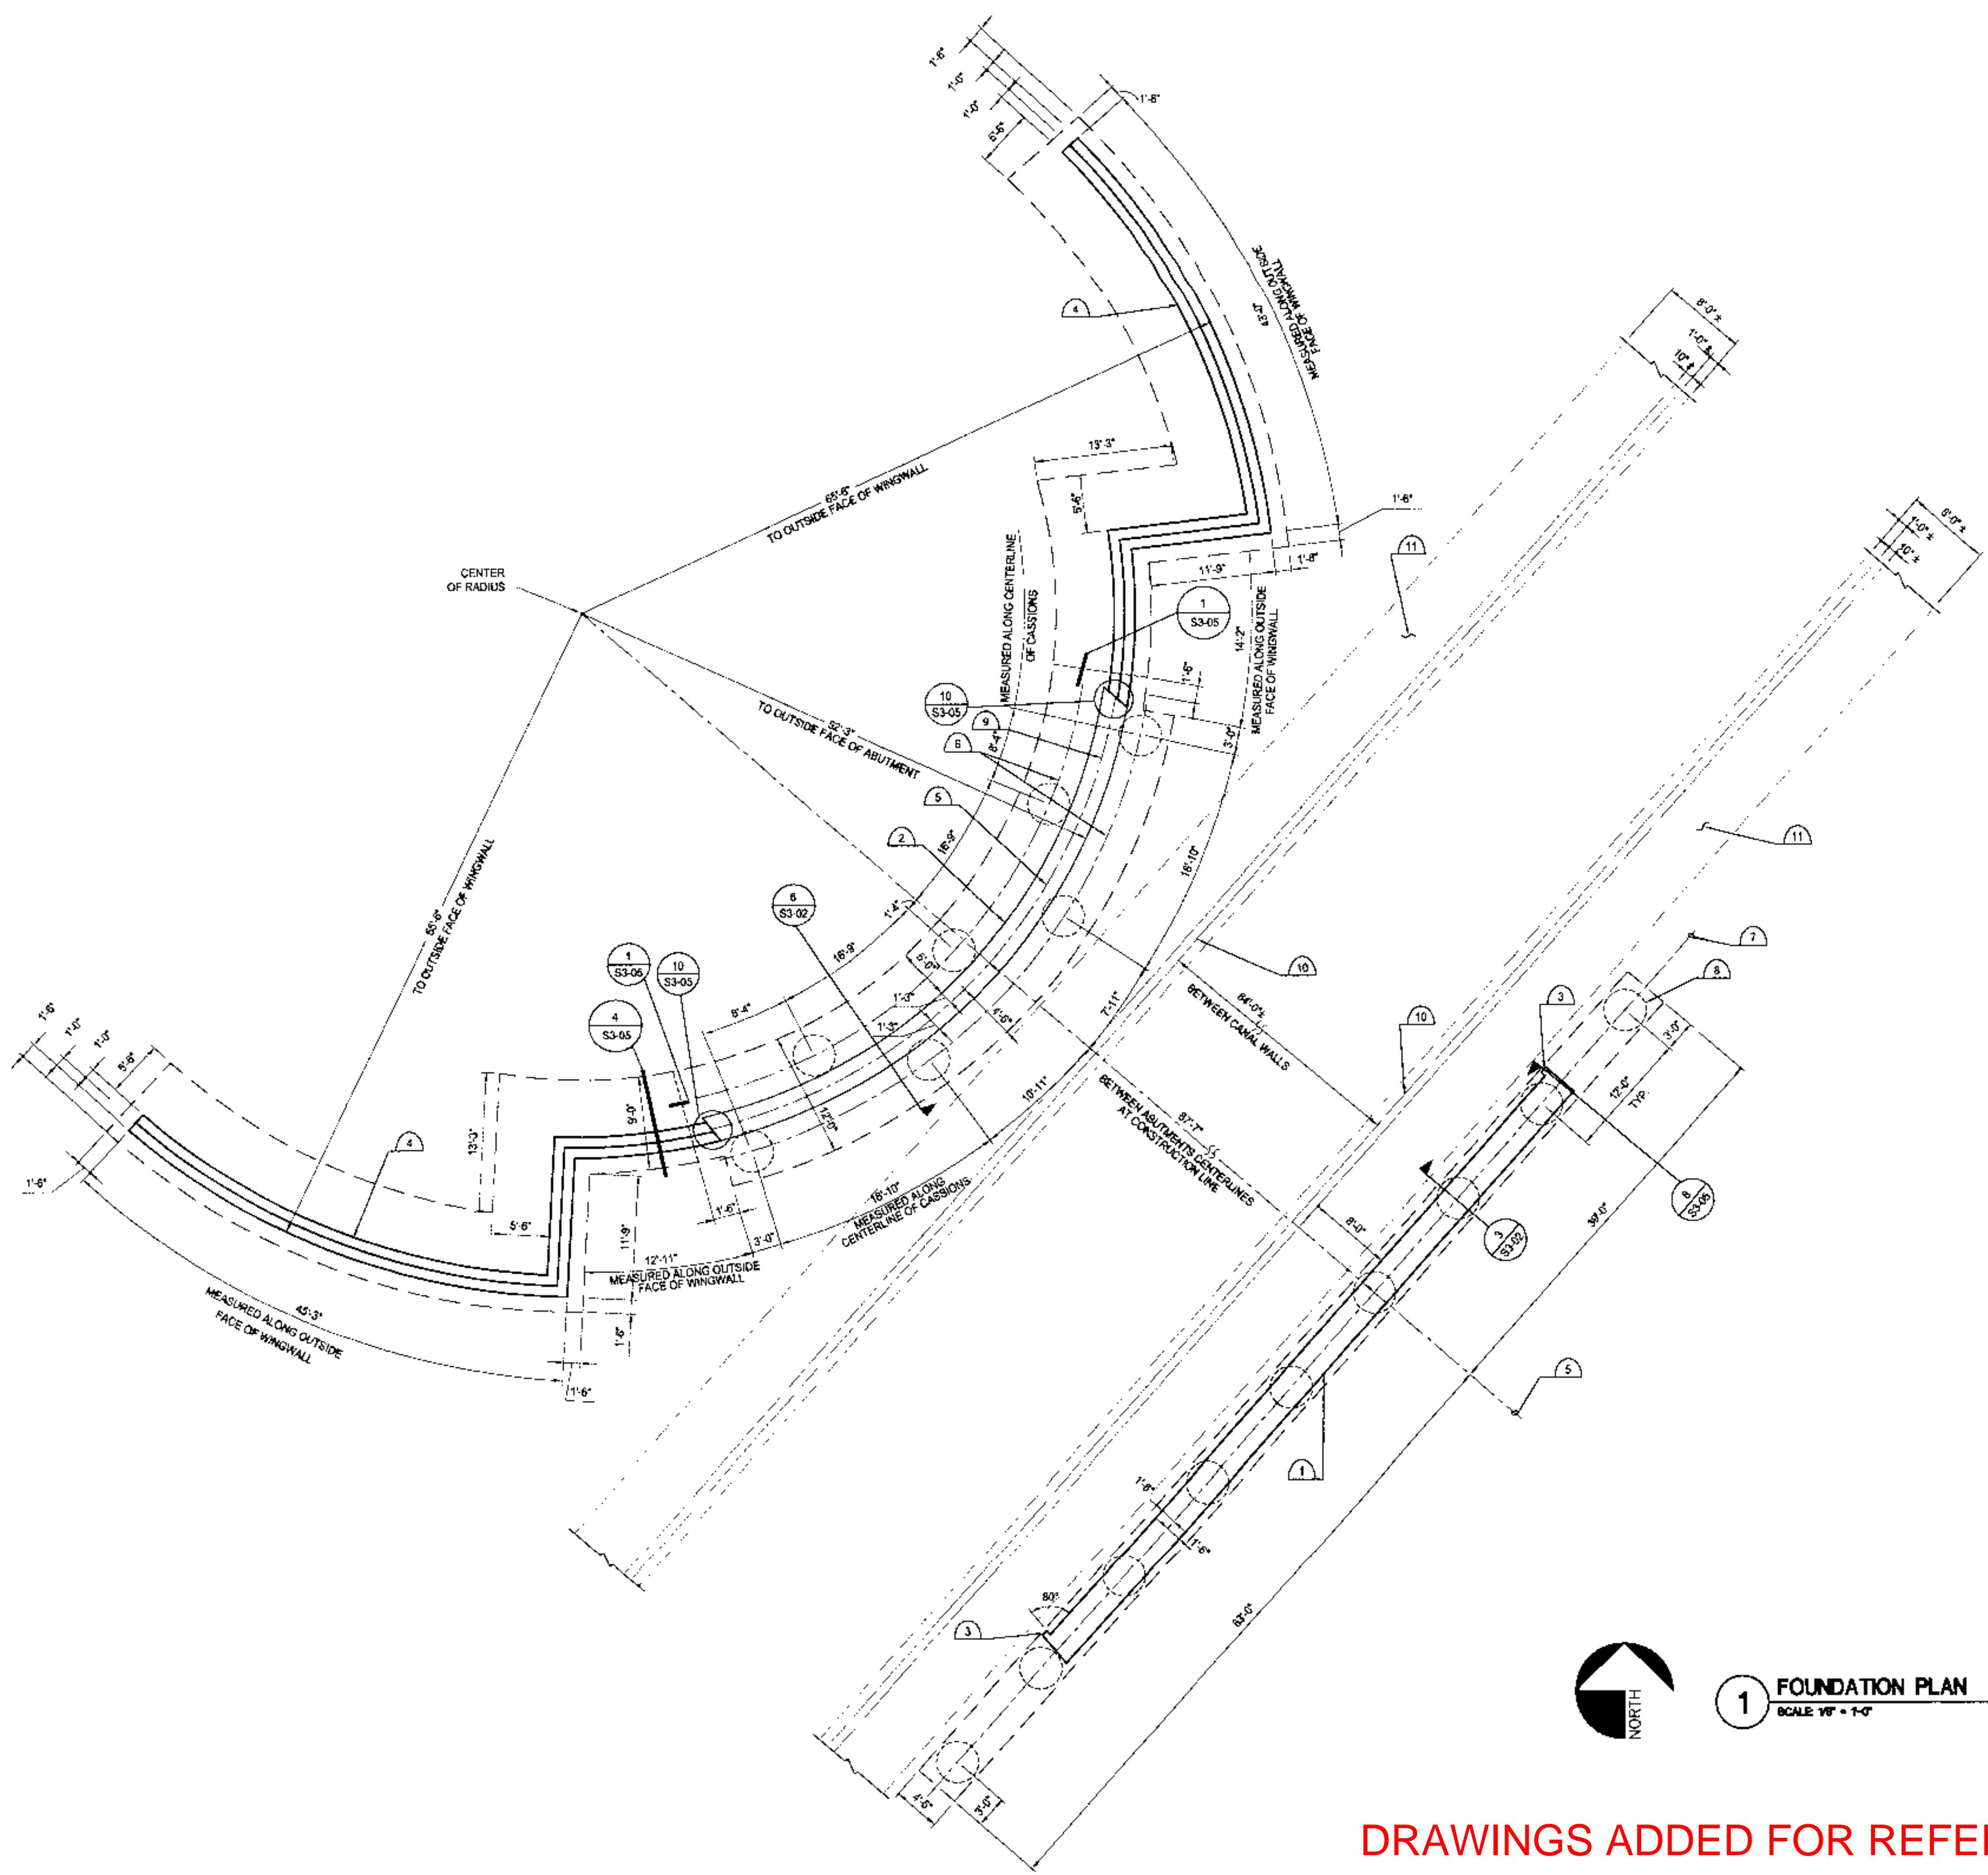

KEY NOTES:

1. ABUTMENT NO. 1
2. ABUTMENT NO. 2
3. WINGWALL (SEE 033-05 FOR DETAILS).
4. WINGWALL (SEE 453-05 FOR DETAILS).
5. CONSTRUCTION CENTER LINE.
6. CENTER LINE OF CAISSONS FOR ABUTMENT NO. 2.
7. CENTER LINE OF CAISSONS AND ABUTMENT NO. 1.
8. 4'-0" CAISSONS (TYP.) (SEE 063-02 FOR DETAILS).
9. ABUTMENT NO. 2 CENTERLINE.
10. EXISTING CANAL WALL
11. EXISTING CANAL WALL FOOTING.

DESIGNWORKSHOP

Landscape Architecture • Land Planning
 Urban Design • Tourism Planning
 Asheville • Aspen • Denver • Jackson Hole
 Park City • Santa Fe • Tempe • Lake Tahoe • Vail

310 S. Mill Avenue, Suite 201
 Tempe, Arizona 85281
 (480) 966-5881
 Facsimile (480) 966-2799
 WWW.DESIGNWORKSHOP.COM

OWNER
CITY OF SCOTTSDALE
 7447 E. INDIAN SCHOOL RD. SCOTTSDALE, AZ 85261
 480-512-7000

**Arizona Canal
 at Scottsdale - Phase I
 Scottsdale, Arizona**



STAMP / DATE

BID DOCUMENTS
 PHASE ONE

**FOUNDATION
 LAYOUT
 AND DETAILS**

ISSUED FOR: BID DOCUMENTS
 ISSUE DATE: OCTOBER 10, 2003

REVISIONS

#	DATE	DESCRIPTION

DRAWN: GAUJG REVIEWED: MSP.AZ

PROJECT NUMBER: 2829

REVISION _____ BY _____

**MUNICIPAL SERVICES
 DEPARTMENT
 CAPITAL PROJECT
 MANAGEMENT**
 3939 DRINKWATER BLVD.
 SCOTTSDALE, ARIZONA 85251

PROJECT TITLE: ARIZONA CANAL AT SCOTTSDALE-PHASE I


DESIGNED BY: MSP/AZ	DATE: 10-10-03	BD NO: W04PB034	SH: S2-01
DRAWN BY: GAUJG	AS-BUILT: 0000	PROJECT NO: 2829	78 OF 89



1 FOUNDATION PLAN
 SCALE 1/8" = 1'-0"

2800 NORTH CENTRAL AVENUE, SUITE 1010
 PHOENIX, ARIZONA 85004
 PHONE (602) 254-1010 KPFF PROJECT #: 110149.1
 FAX (602) 285-1010

DRAWINGS ADDED FOR REFERENCE ONLY.

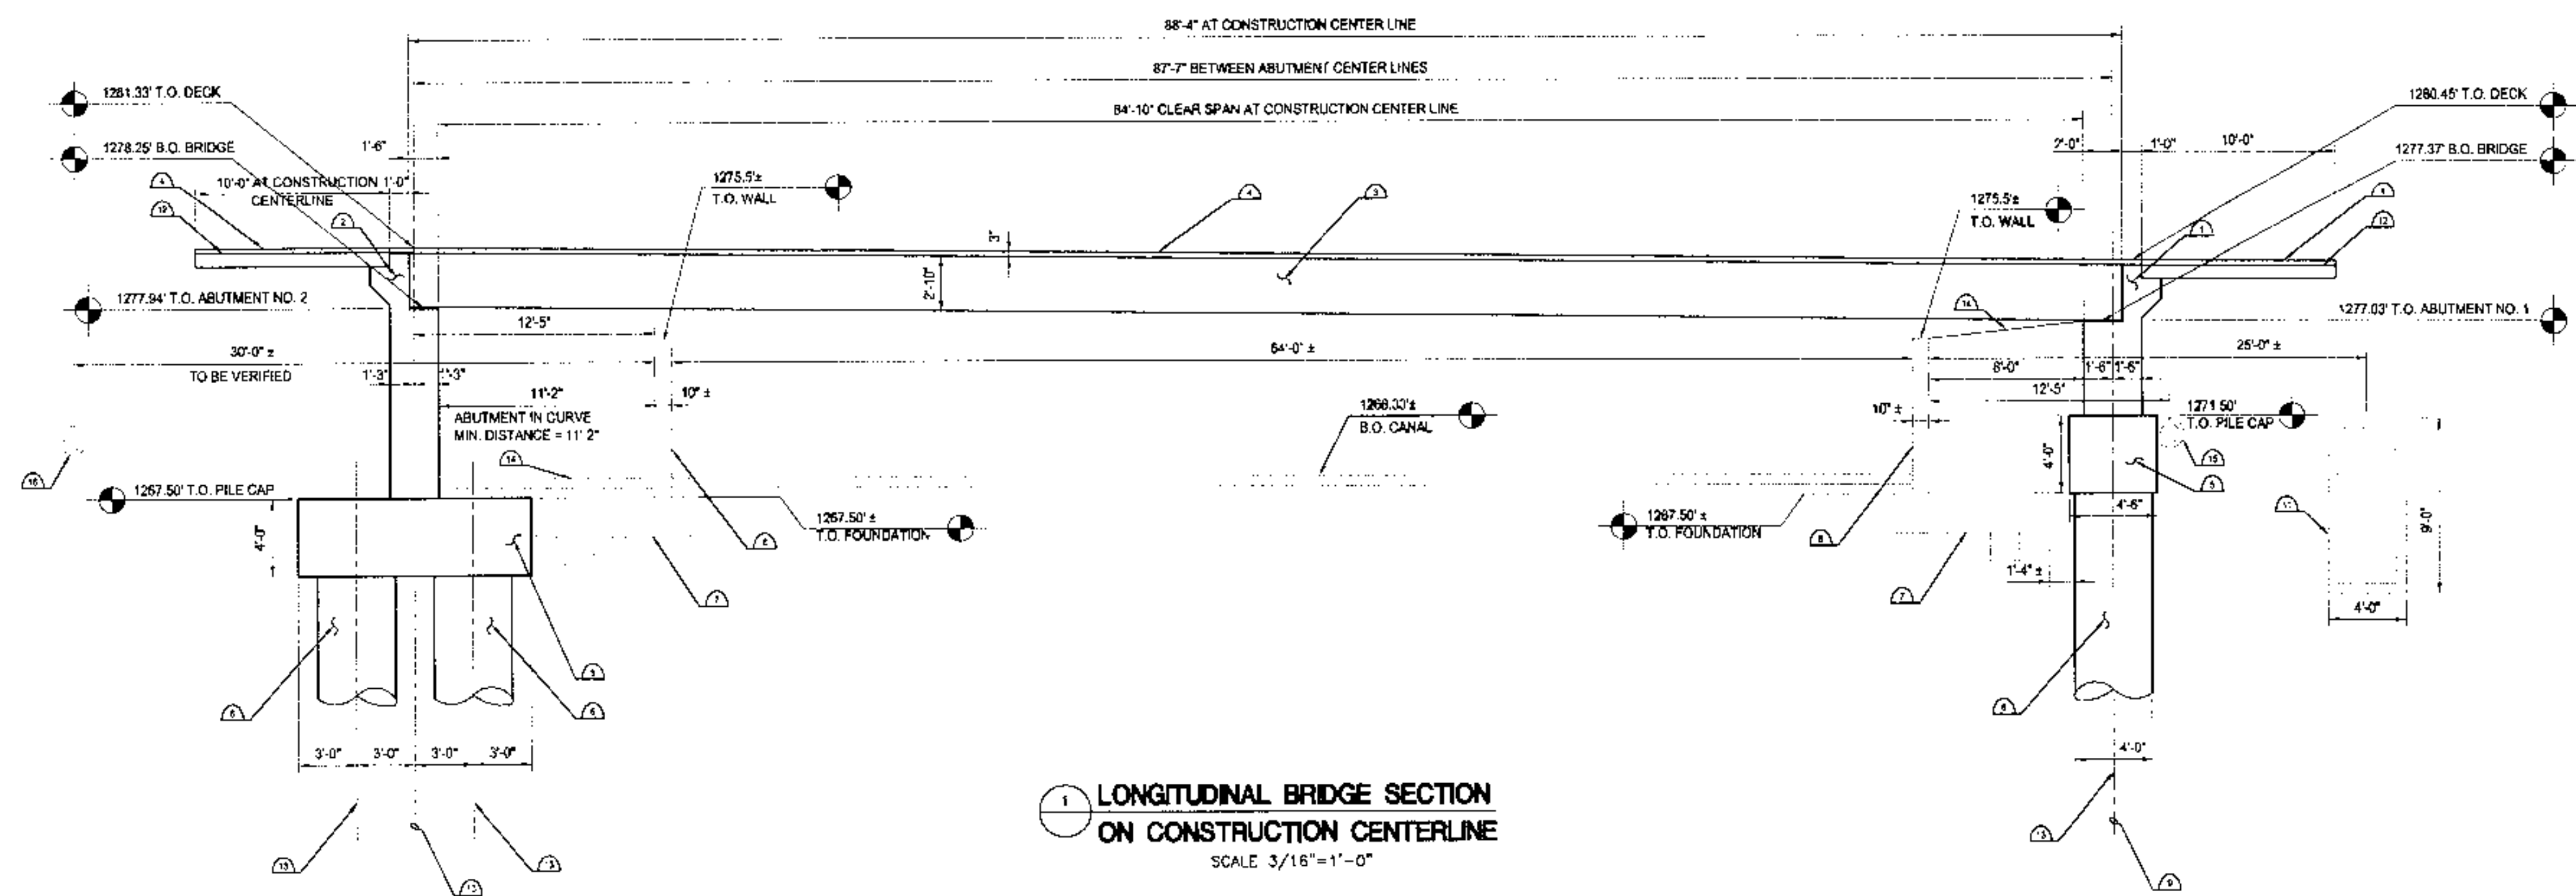

1 LONGITUDINAL BRIDGE SECTION
ON CONSTRUCTION CENTERLINE
SCALE 3/16"=1'-0"

KEY NOTES:

1. ABUTMENT NO. 1 (SEE 3/S3-02 FOR DETAILS).
2. ABUTMENT NO. 2 (SEE 6/S3-02 FOR DETAILS).
3. CONCRETE GIRDER (SEE S4-01 FOR DETAILS).
4. 3" ARCHITECTURAL NON-COMPOSITE PAVER.
5. ABUTMENT CAP (SEE 3/S3-02 AND 6/S3-02 FOR DETAILS).
6. 4'-0" DIA. TYPICAL CAISSON (SEE 9/S3-02 FOR DETAILS).
7. EXISTING CANAL WALL FOOTING.
8. EXISTING CANAL WALL.
9. ABUTMENT NO. 1 CENTER LINE.
10. ABUTMENT NO. 2 CENTER LINE.
11. EXISTING 66KV UTILITY VAULT.
12. APPROACH SLAB, 8" SLAB WITH #4 @ 12" O.C. EACH WAY AT MIDDEPTH (SEE 1/S5-03 AND 5/S5-03).
13. CAISSON CENTER LINES.
14. GRADE AND SURFACE TREATMENT, SEE LANDSCAPE ARCHITECT.
15. EXISTING 12KV (TO BE REMOVED BY SRP).
16. EXISTING 12KV (TO BE VERIFIED).

DESIGNWORKSHOP
Landscape Architecture • Land Planning
Urban Design • Tourism Planning
Asheville • Aspen • Denver • Jackson Hole
Park City • Santa Fe • Tempe • Lake Tahoe • Tell
310 S. Mill Avenue, Suite 201
Tempe, Arizona 85281
(480) 966-5881
Facsimile (480) 966-2799
WWW.DESIGNWORKSHOP.COM

OWNER
CITY OF SCOTTSDALE
7447 E. INDIAN SCHOOL RD. SCOTTSDALE, AZ. 85251
480-312-7869

**Arizona Canal - Phase I
at Scottsdale - Phase I
Scottsdale, Arizona**



STAMP / DATE

BID DOCUMENTS
PHASE ONE

**LONGITUDINAL
BRIDGE
SECTION**

ISSUED FOR: BID DOCUMENTS

ISSUE DATE: OCTOBER 10, 2003

REVISIONS
DATE DESCRIPTION

DRAWN: GAALIG REVIEWED: MSP/AZ

PROJECT NUMBER: 2829

© COPYRIGHT DESIGNWORKSHOP, INC.

REVISION BY

**MUNICIPAL SERVICES
DEPARTMENT
CAPITAL PROJECT
MANAGEMENT**
3638 DRINKWATER BLVD.
SCOTTSDALE, ARIZONA, 85251

PROJECT TITLE: ARIZONA CANAL AT SCOTTSDALE-PHASE I

DESIGNED BY: MSP/AZ	DATE: 10-10-03	BID NO: #04PB034	SHT: S3-01
DRAWN BY: GAALIG	DATE: 10-10-03	PROJECT NO: 2829	77 OF 89

kpff Consulting Engineers
2800 NORTH CENTRAL AVENUE, SUITE 1010
PHOENIX, ARIZONA 85004
PHONE (602) 254-1010 KPF PROJECT #: 110149.1
FAX (602) 255-1010

DRAWINGS ADDED FOR REFERENCE ONLY.

**Arizona Canal
at Scottsdale - Phase I
Scottsdale, Arizona**



STAMP / DATE

BID DOCUMENTS
PHASE ONE

**ABUTMENT
DETAILS**

ISSUED FOR: BID DOCUMENTS

ISSUE DATE: OCTOBER 10, 2003

REVISIONS

#	DATE	DESCRIPTION

DRAWN: GAALIG REVIEWED: MSP/AZ

PROJECT NUMBER: 2829

© COPYRIGHT DESIGNWORKSHOP, INC.



3638 DRINKWATER BLVD.
SCOTTSDALE, ARIZONA 85251


PROJECT TITLE
ARIZONA CANAL AT SCOTTSDALE-PHASE I

DESIGNED BY	DATE	ISS. NO.	REV.
MSP/AZ	10-10-03	#04PB034	S3-02
DRAWN BY	AS-BUILT	PROJECT NO.	78 OF 89
GAALIG	0000	2829	


kpff Consulting Engineers
2800 NORTH CENTRAL AVENUE, SUITE 1010
PHOENIX, ARIZONA 85004
PHONE (602) 264-1010 KPFF PROJECT #:
FAX (602) 265-1010 **110149.1**

DRAWINGS ADDED FOR REFERENCE ONLY.


3 ABUTMENT NO. 1 SECTION

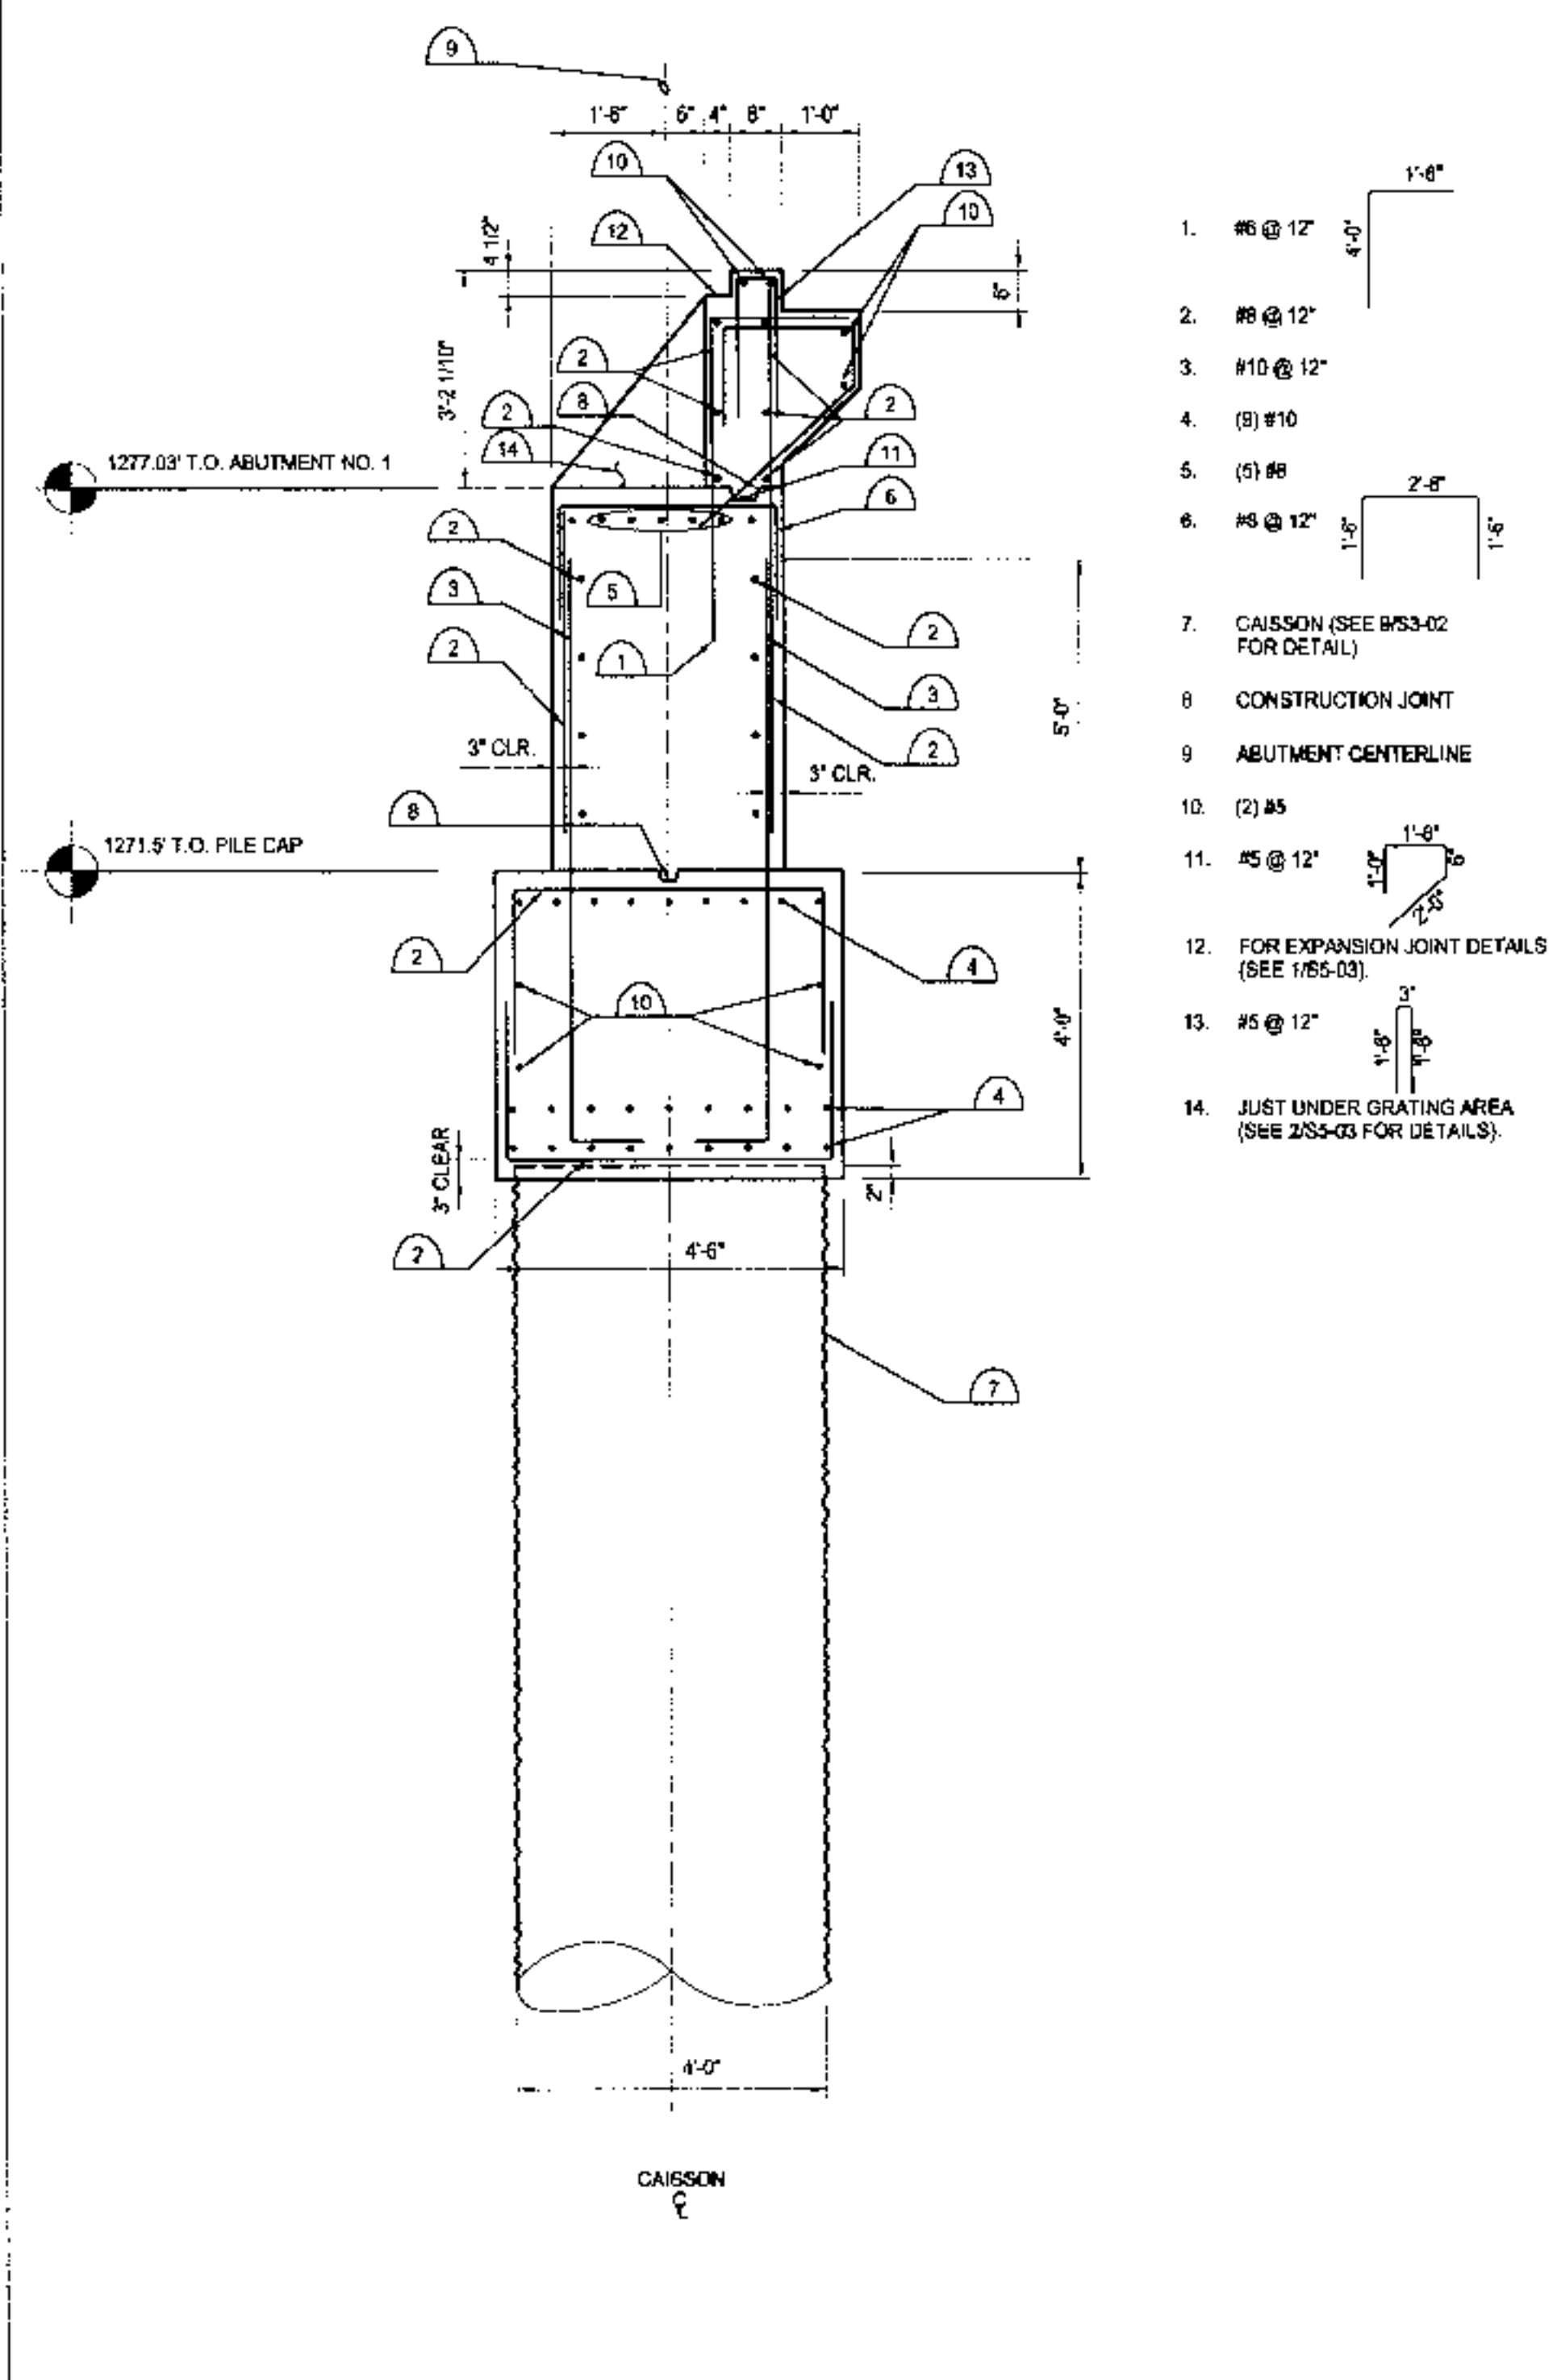

6 ABUTMENT NO. 2 SECTION

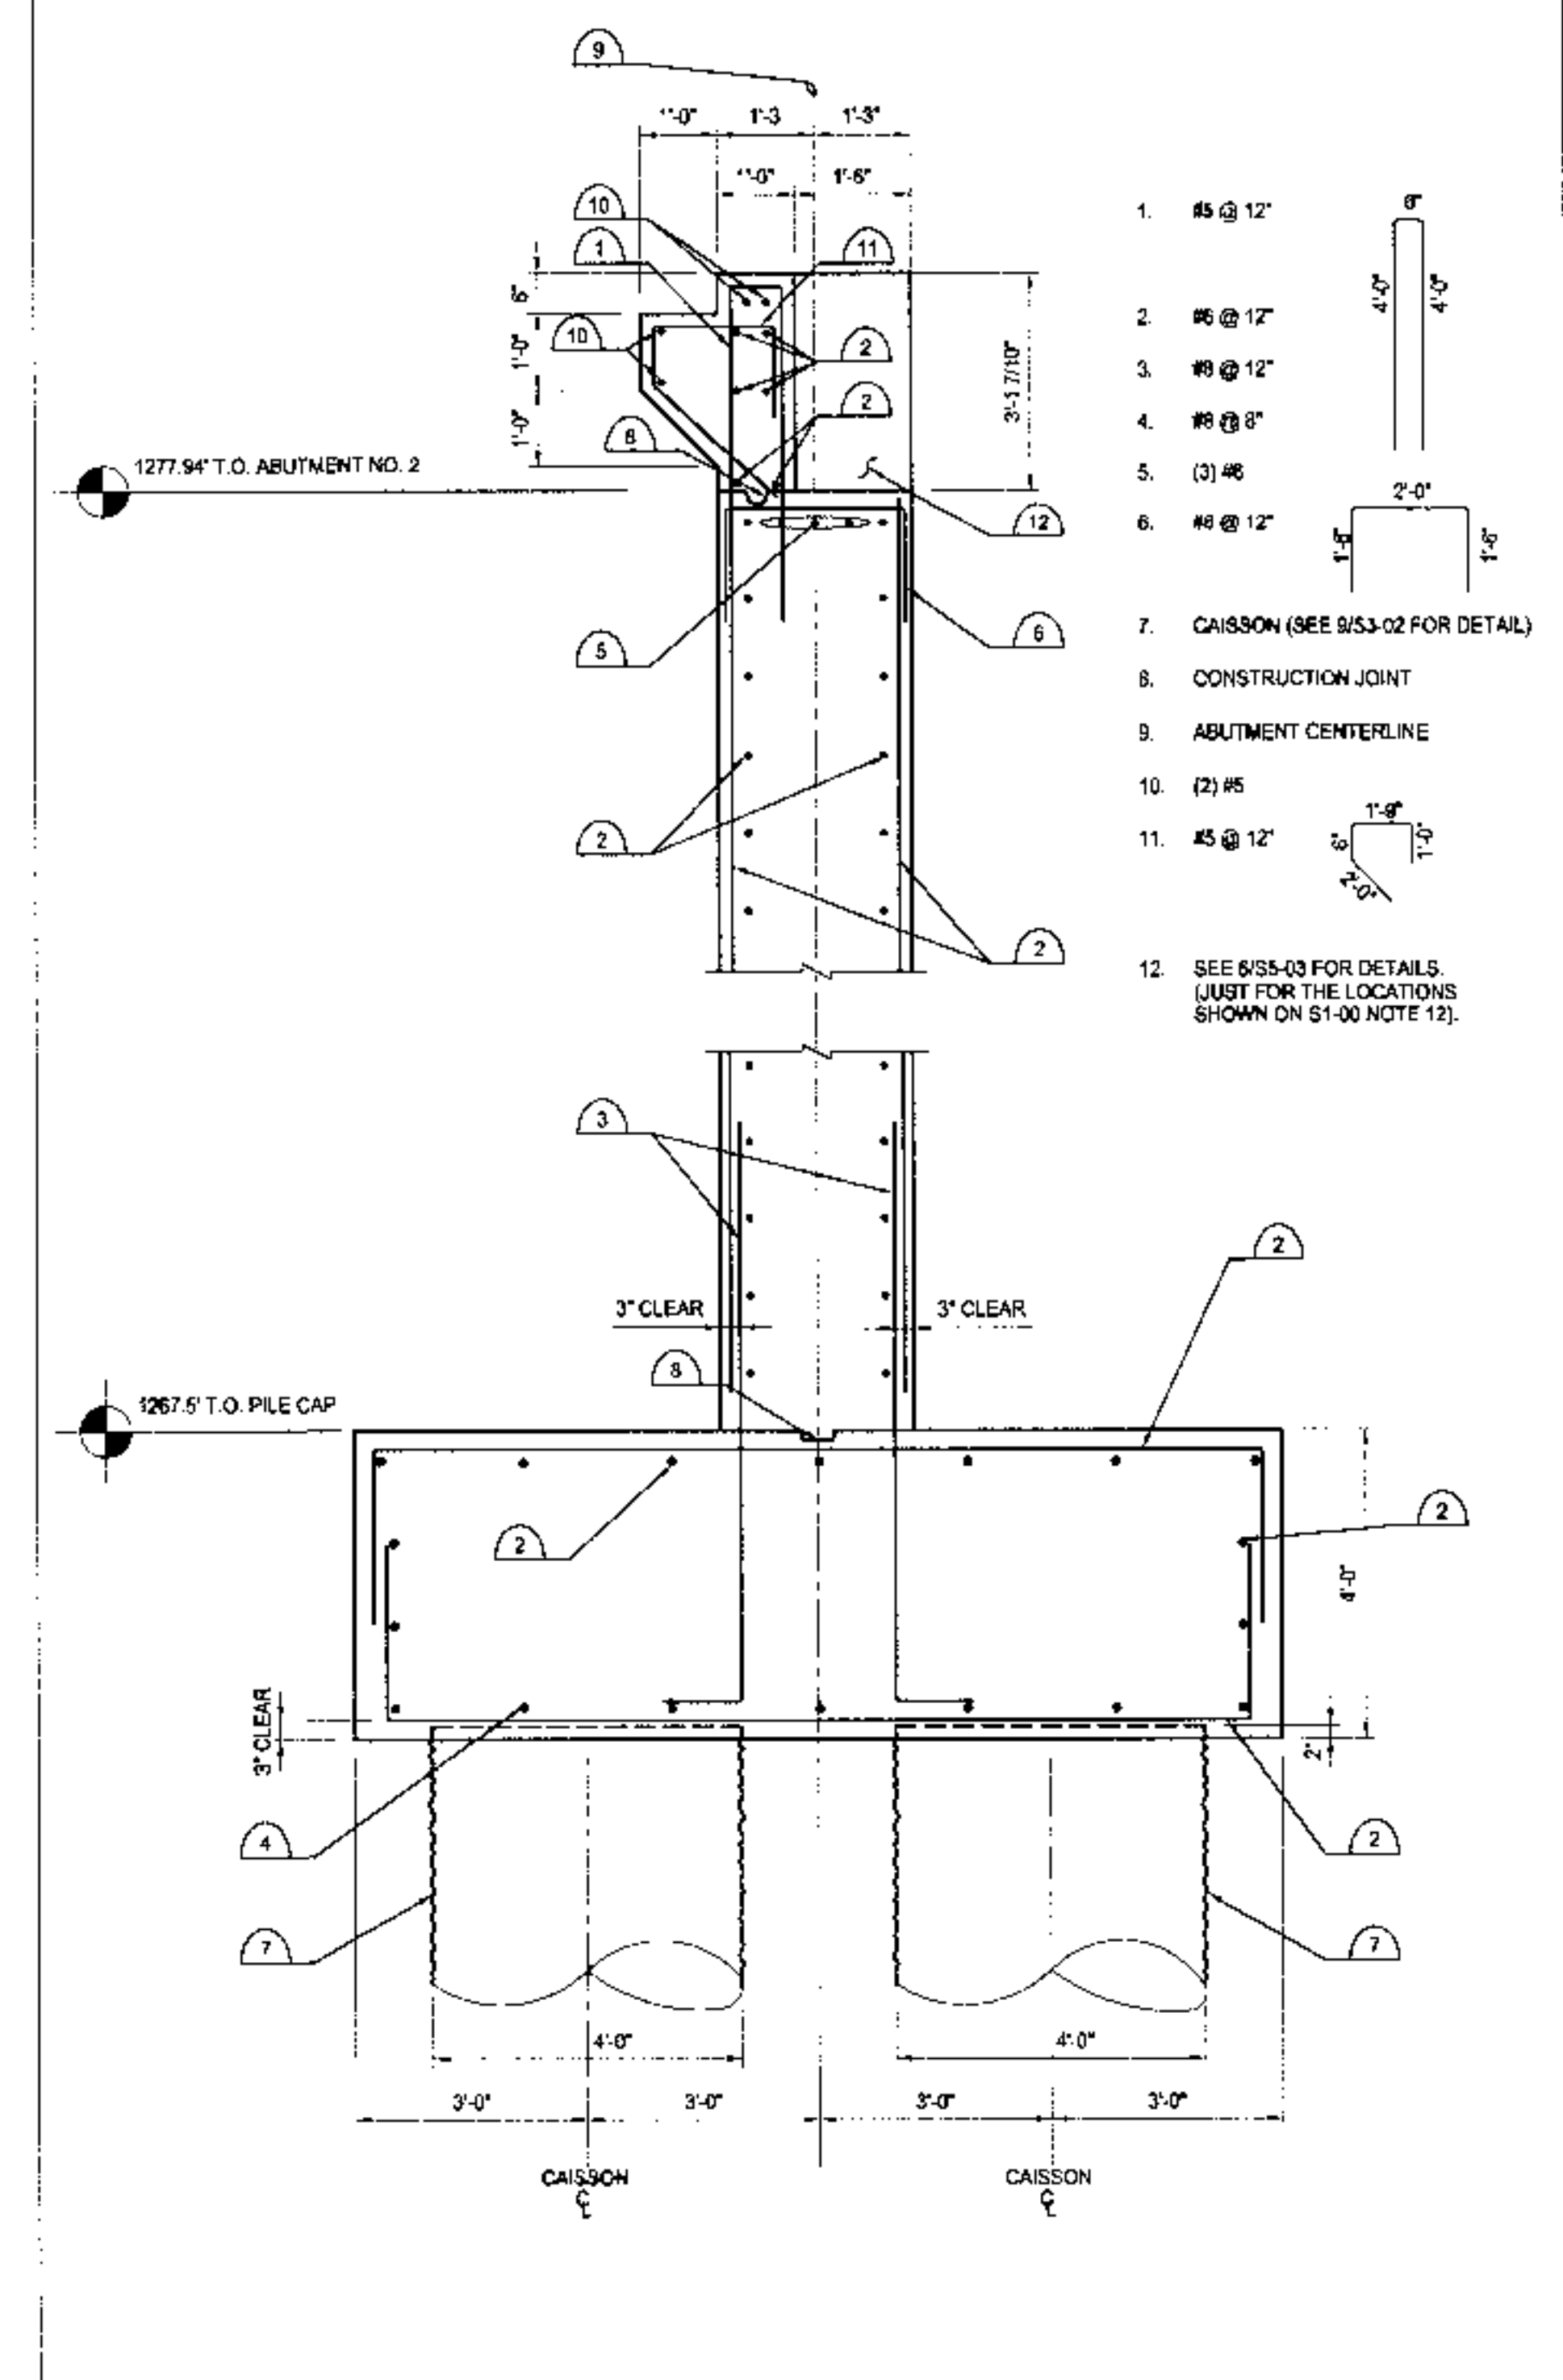

9 CAISSON SECTION

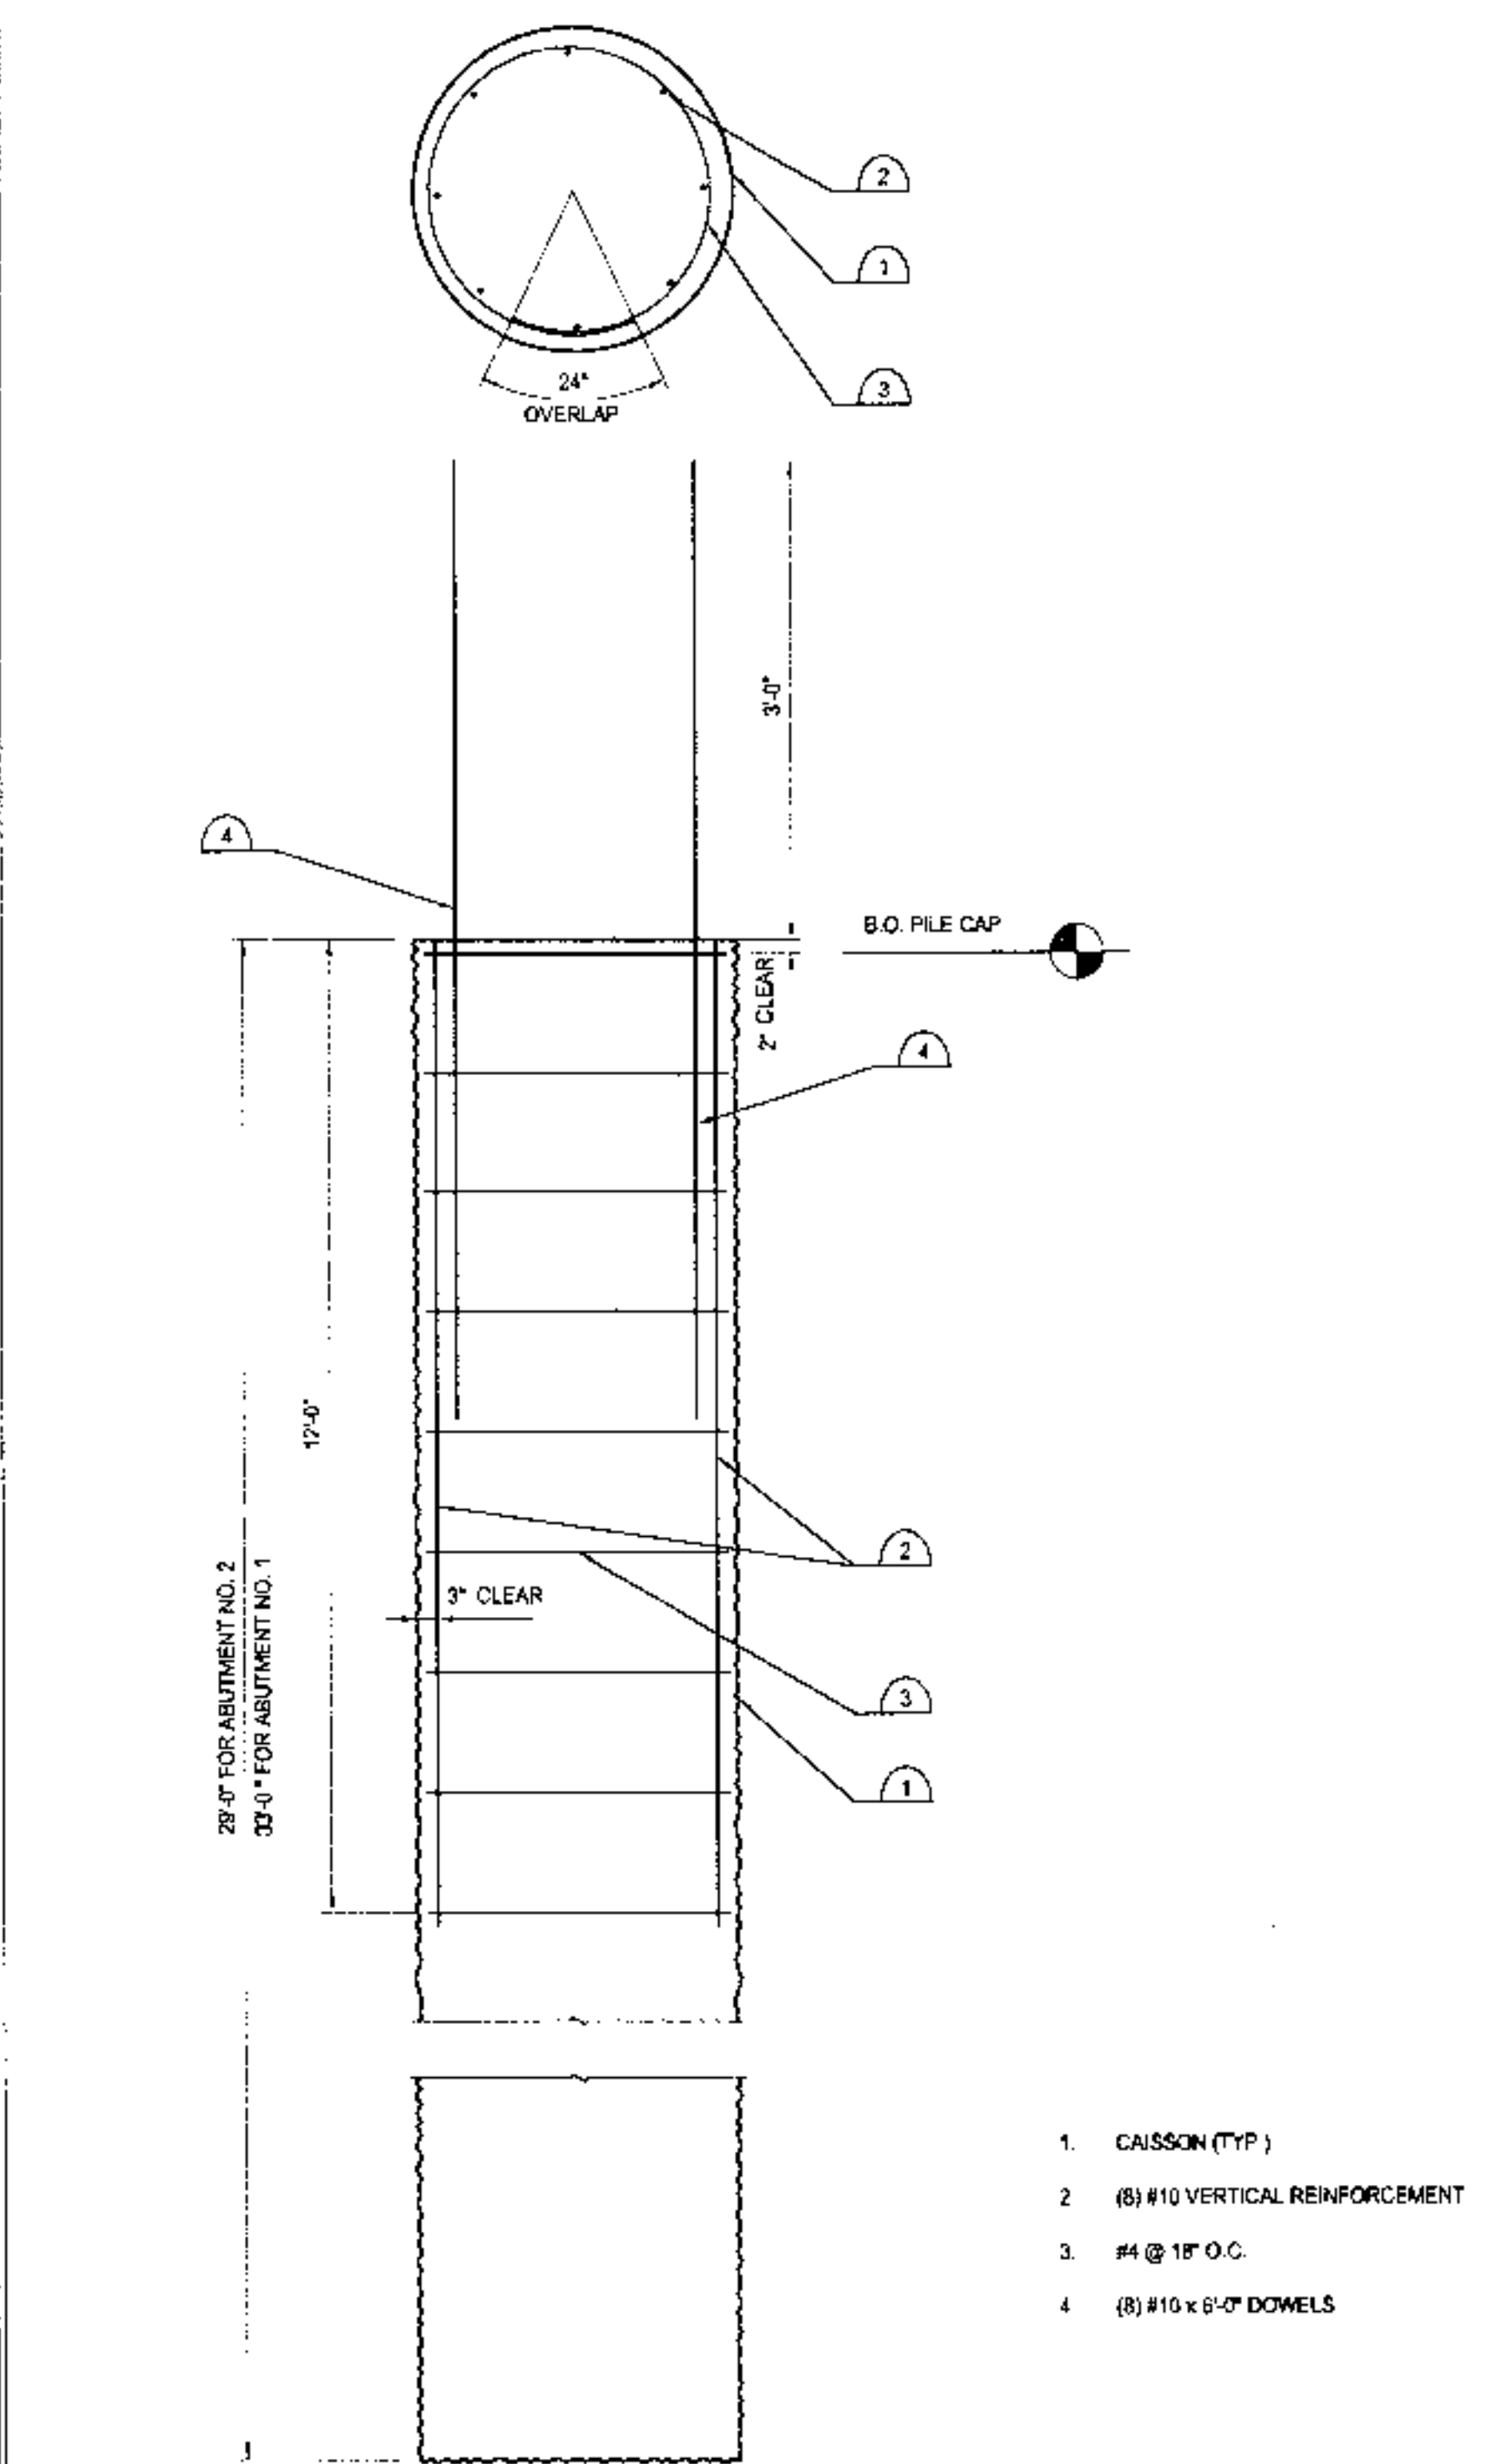

1. CAISSON (TYP)
2. (8) #10 VERTICAL REINFORCEMENT
3. #4 @ 18" O.C.
4. (8) #10 x 6'-0" DOWELS

DESIGNWORKSHOP

Landscape Architecture • Land Planning
Urban Design • Tourism Planning

Asheville • Aspen • Denver • Jackson Hole
Park City • Santa Fe • Tempe • Lake Tahoe • Vail

310 S. Mill Avenue, Suite 201
Tempe, Arizona 85281
(480) 966-5881
Facsimile (480) 966-2799

WWW.DESIGNWORKSHOP.COM

OWNER
CITY OF SCOTTSDALE
7447 E INDIAN SCHOOL RD. SCOTTSDALE, AZ 85251
480-312-7869

**Arizona Canal
at Scottsdale - Phase I**
Scottsdale, Arizona



STAMP / DATE

BID DOCUMENTS
PHASE ONE

**WINGWALL
PLAN**

ISSUED FOR: BID DOCUMENTS

ISSUE DATE: OCTOBER 10, 2003

REVISIONS

#	DATE	DESCRIPTION

DRAWN: GAAJG REVIEWED: MSPAZ

PROJECT NUMBER 2629

© COPYRIGHT DESIGNWORKSHOP, INC.

REVISION BY


**MUNICIPAL SERVICES
DEPARTMENT**
**CAPITAL PROJECT
MANAGEMENT**
3939 DRINKWATER BLVD.
SCOTTSDALE, ARIZONA 85251

PROJECT TITLE: ARIZONA CANAL AT SCOTTSDALE-PHASE I

DESIGNED BY: MSP/AZ	DATE: 10-10-03	BD NO.: #04PB034	PT: S3-04
DRAWN BY: GAAJG	AS-BUILT NO.: 0000	PROJECT NO.: 2629	79 OF 89

kpff Consulting Engineers
2600 NORTH CENTRAL AVENUE, SUITE 1010
PHOENIX, ARIZONA 85004
PHONE (602) 284-1010
FAX (602) 285-1010
KPFY PROJECT #: 110149.1


DRAWINGS ADDED FOR REFERENCE ONLY.

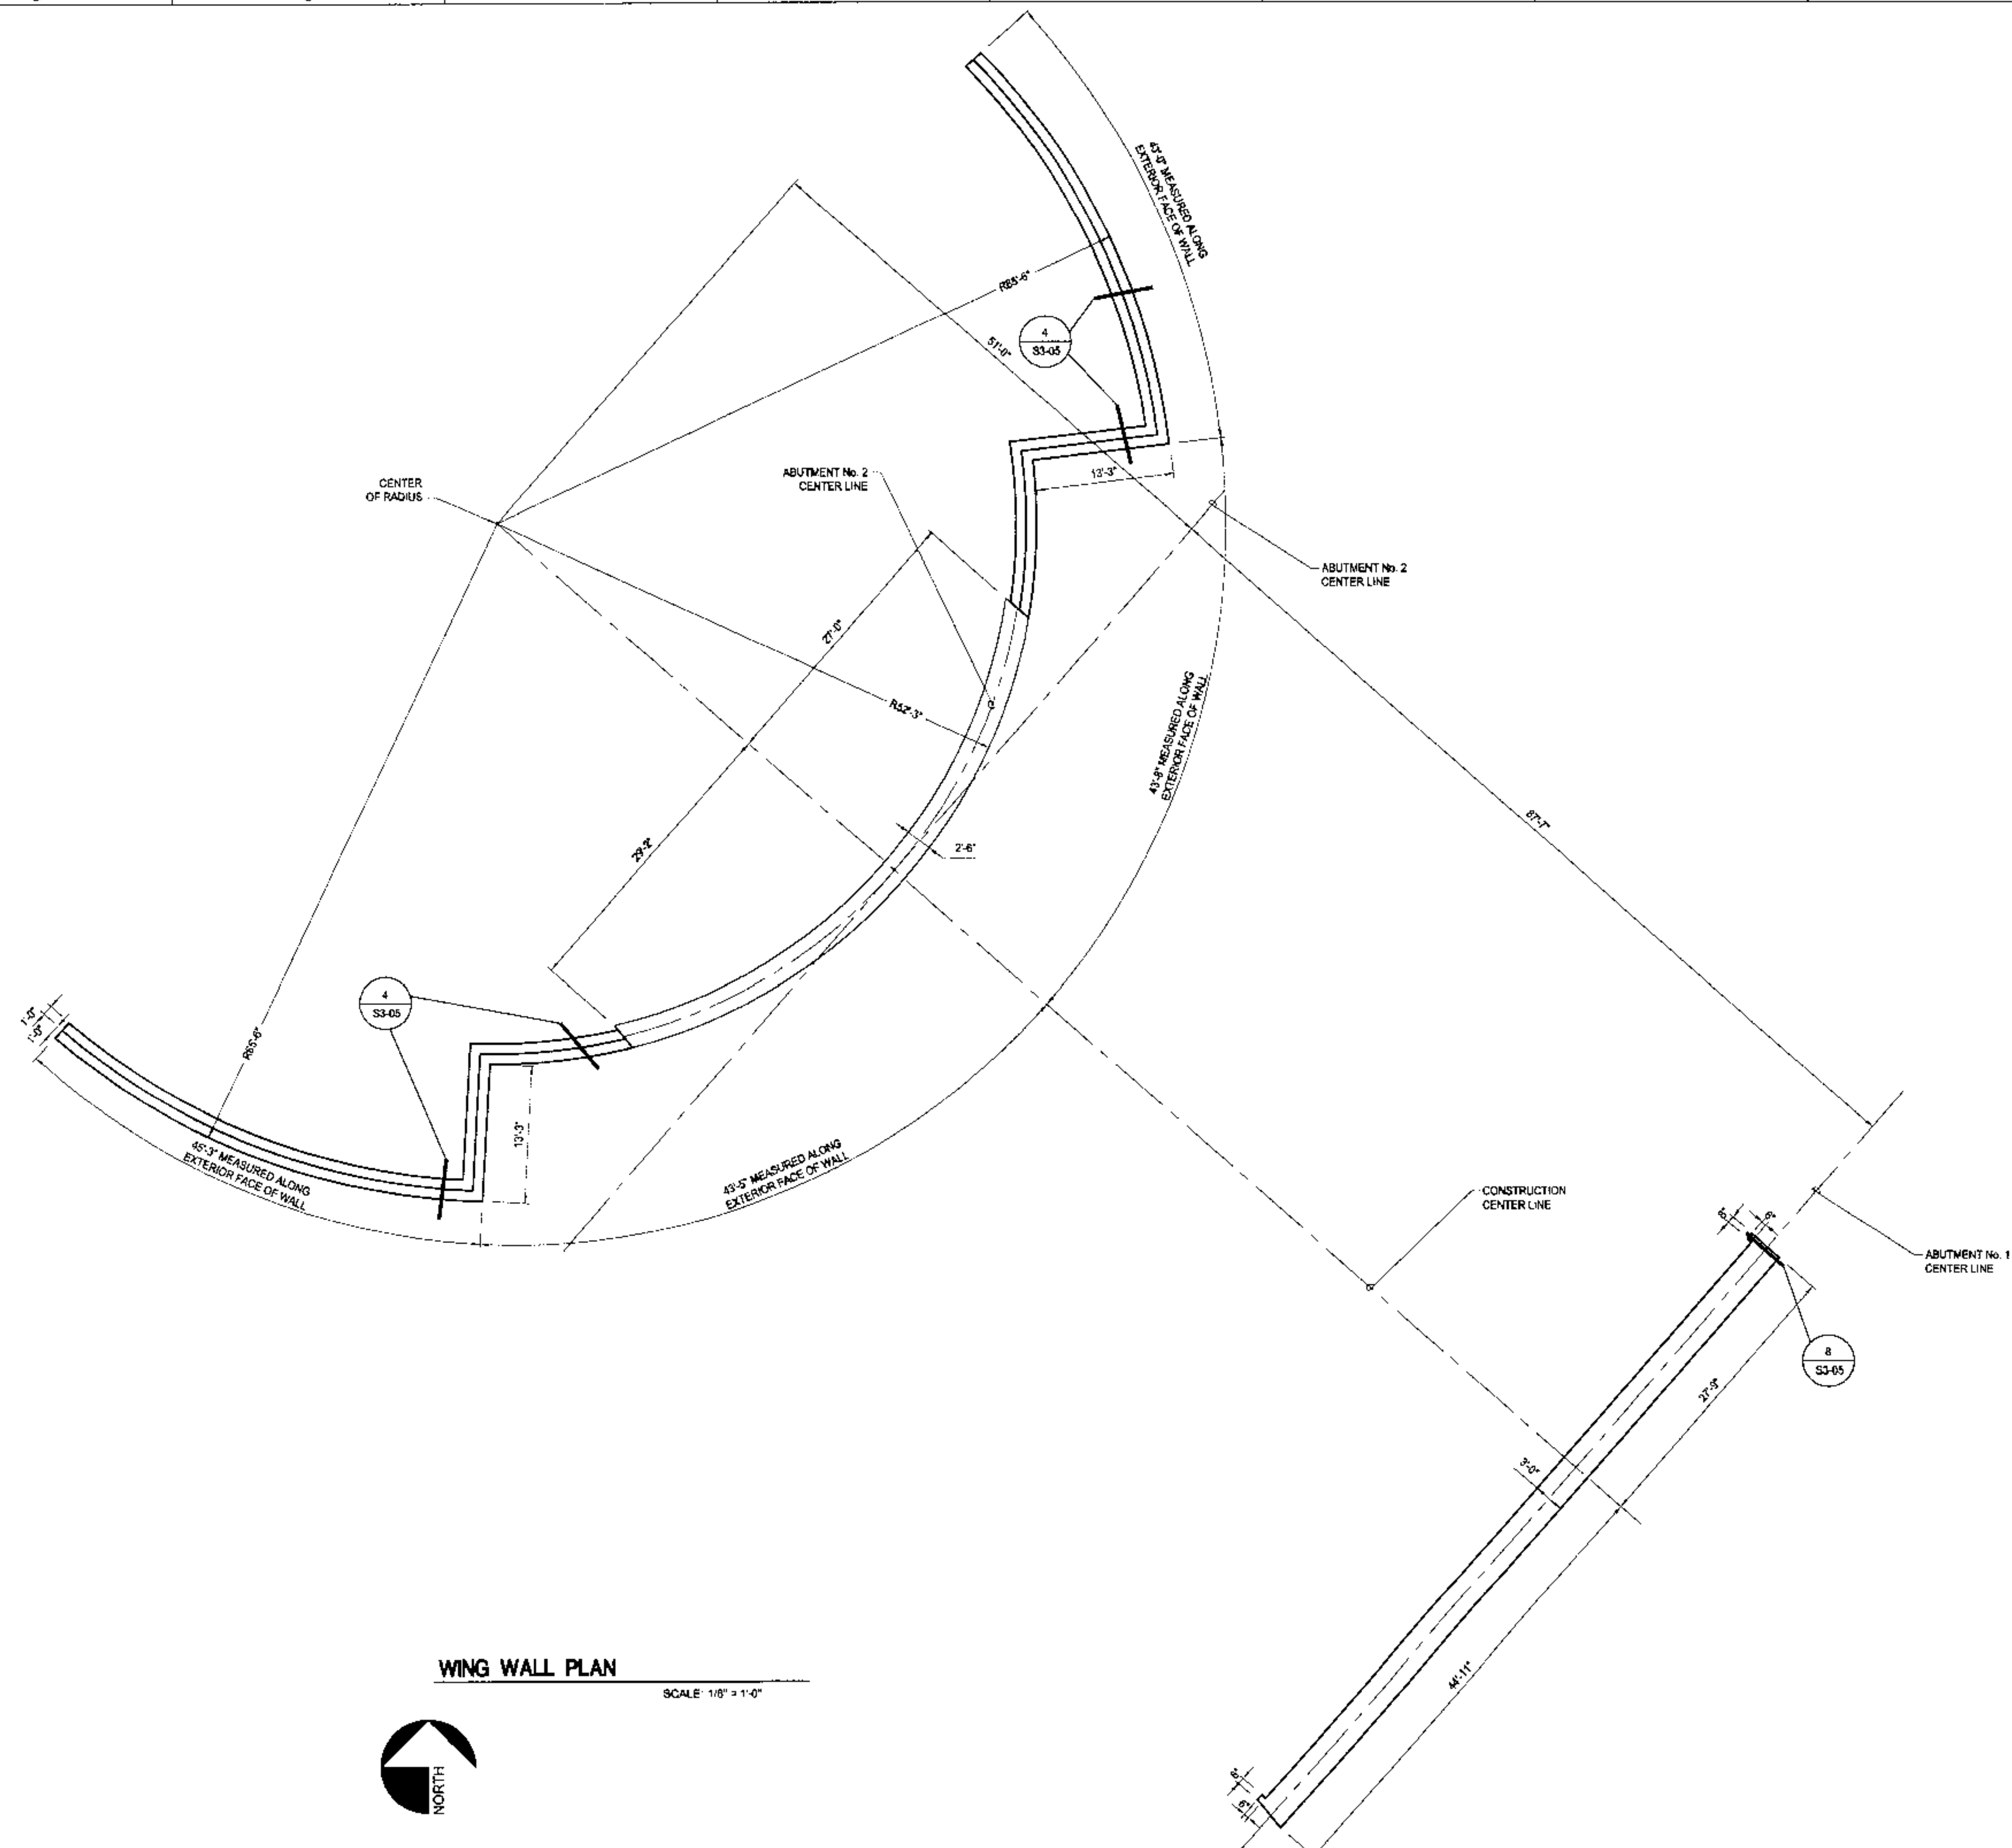


WING WALL PLAN
SCALE: 1/8" = 1'-0"



DRAWINGS ADDED FOR REFERENCE ONLY.

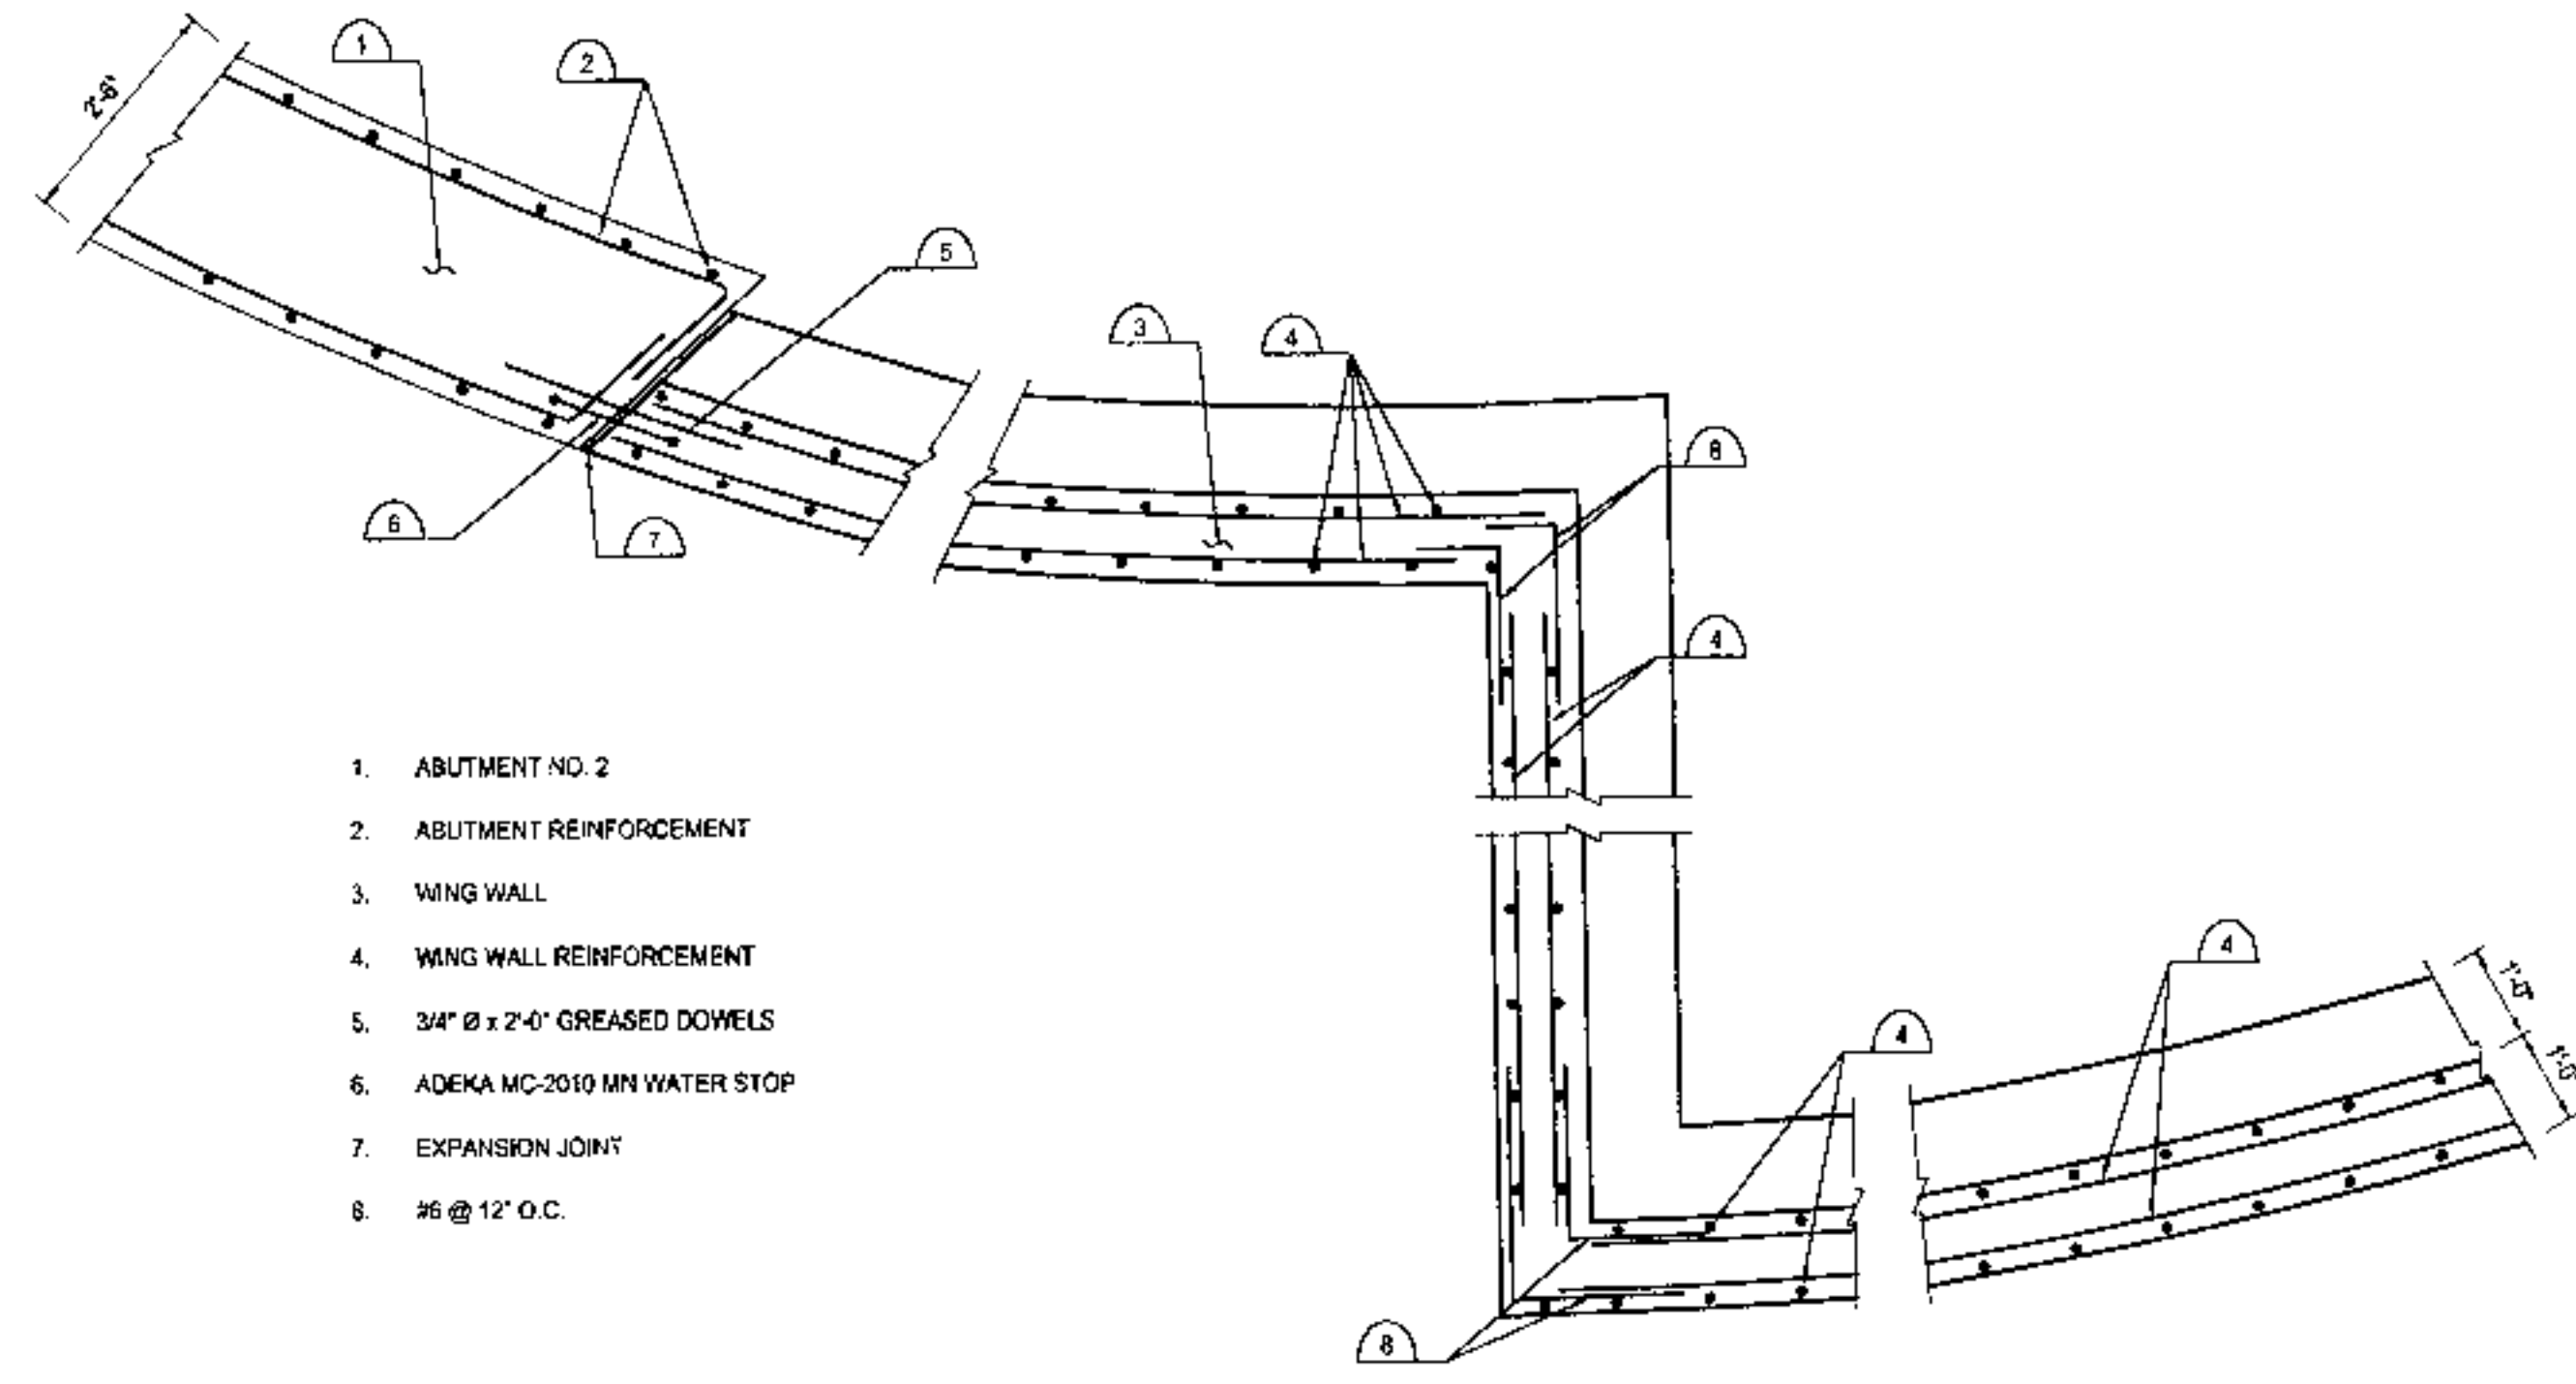


1. ABUTMENT NO. 2
2. ABUTMENT REINFORCEMENT
3. WING WALL
4. WING WALL REINFORCEMENT
5. 3/4" Ø x 2'-0" GREASED DOWELS
6. ADEKA MC-2010 MN WATER STOP
7. EXPANSION JOINT
8. #6 @ 12" O.C.

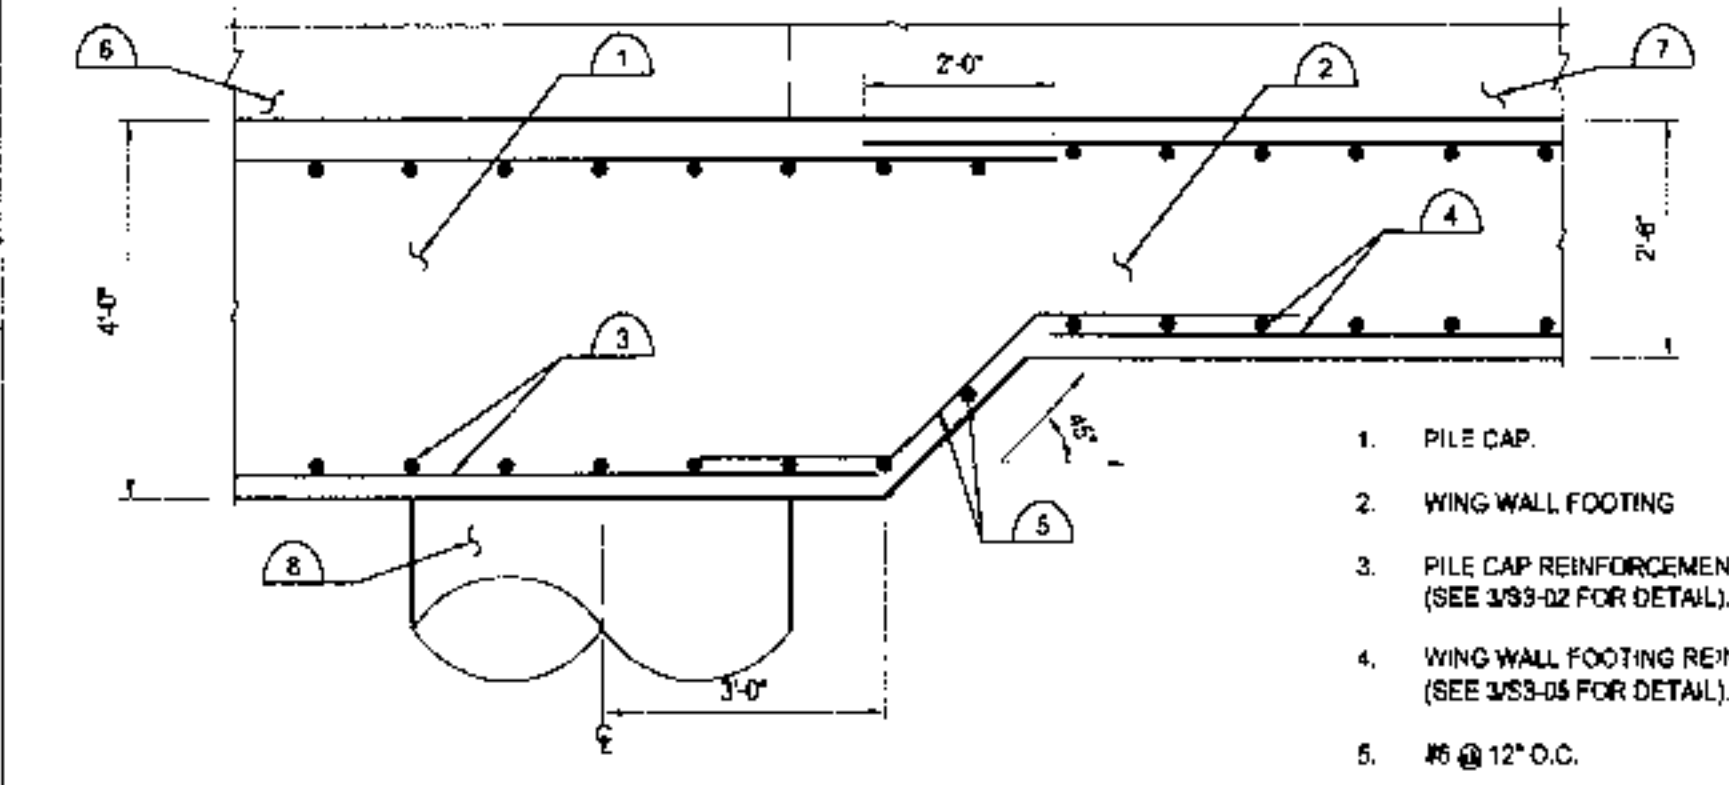


1 PILE CAP TO WING WALL FOOTING CONNECTION

1. PILE CAP.
2. WING WALL FOOTING
3. PILE CAP REINFORCEMENT. (SEE 3/93-02 FOR DETAIL).
4. WING WALL FOOTING REINFORCEMENT. (SEE 3/53-05 FOR DETAIL).
5. #5 @ 12" O.C.
6. ABUTMENT NO. 2
7. WING WALL
8. CAISSON.

10 EXPANSION JOINT AT ABUTMENT TO WING WALL CONNECTION ON NORTH SIDE

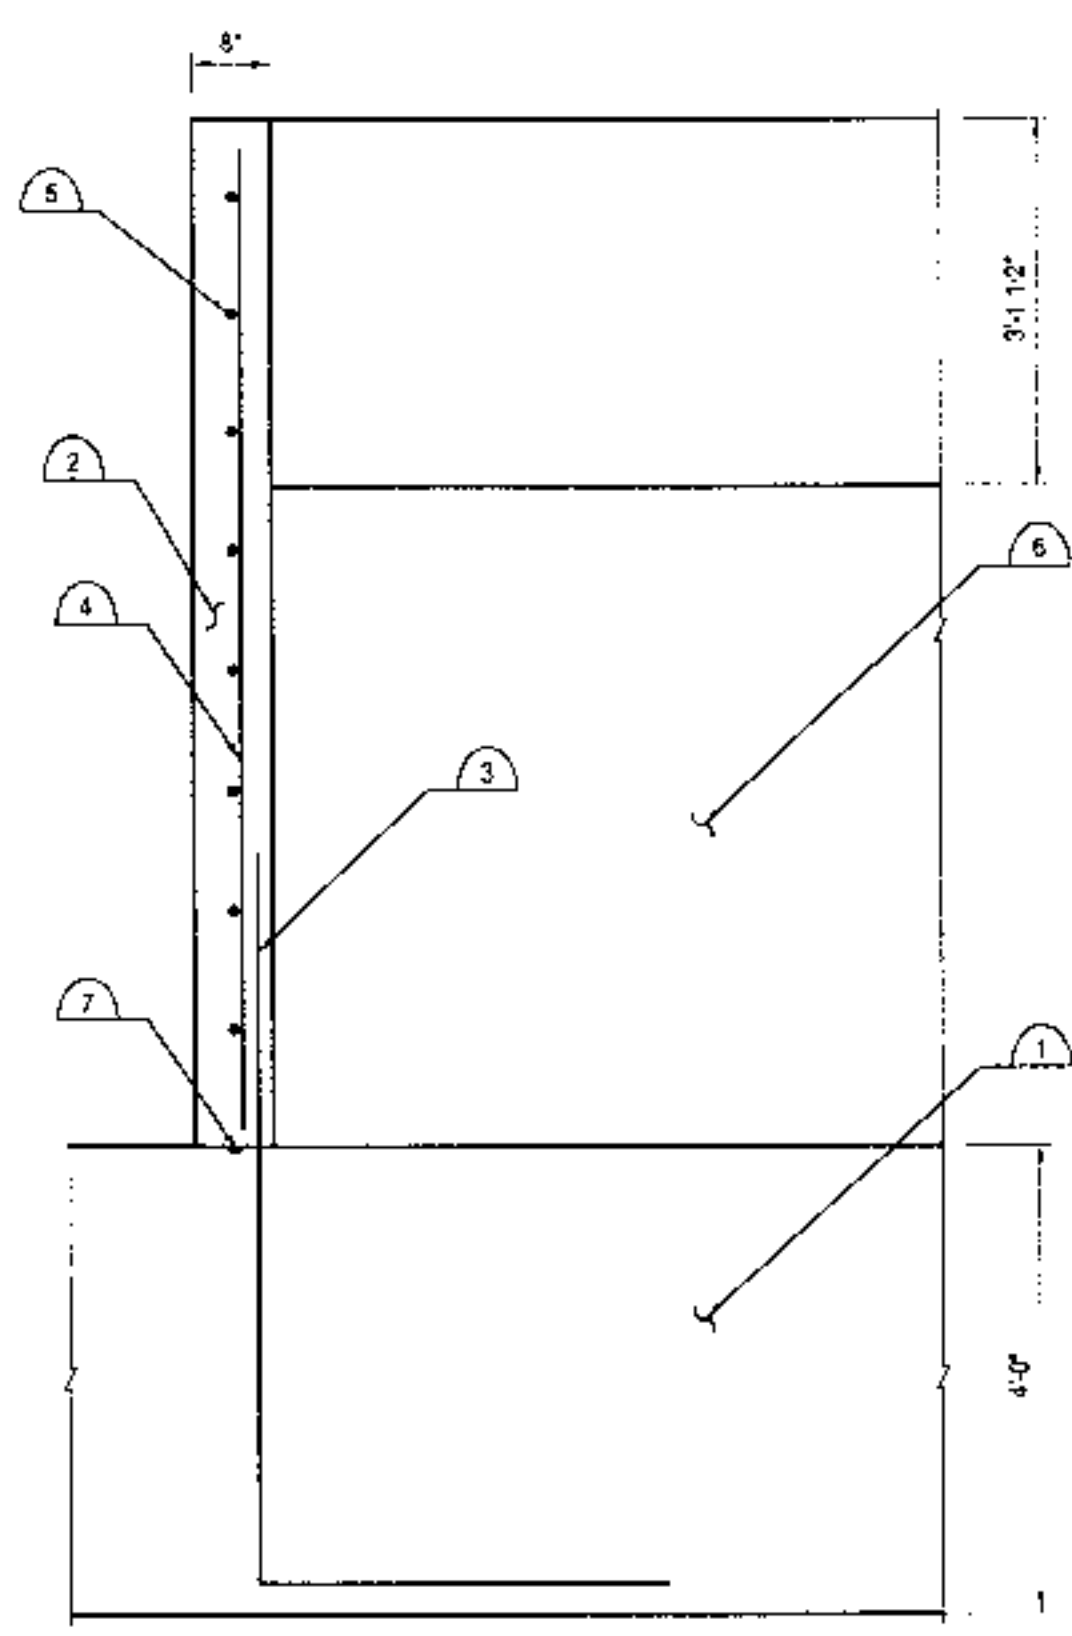


1. PILE CAP
2. WING WALL
3. VERTICAL REINF. PER SECTION 8
4. VERTICAL REINF. PER SECTION 8
5. HORIZONTAL REINF. PER SECTION 8
6. ABUTMENT NO. 1 (SEE 3/53-02 FOR DETAILS).
7. CONSTRUCTION JOINT

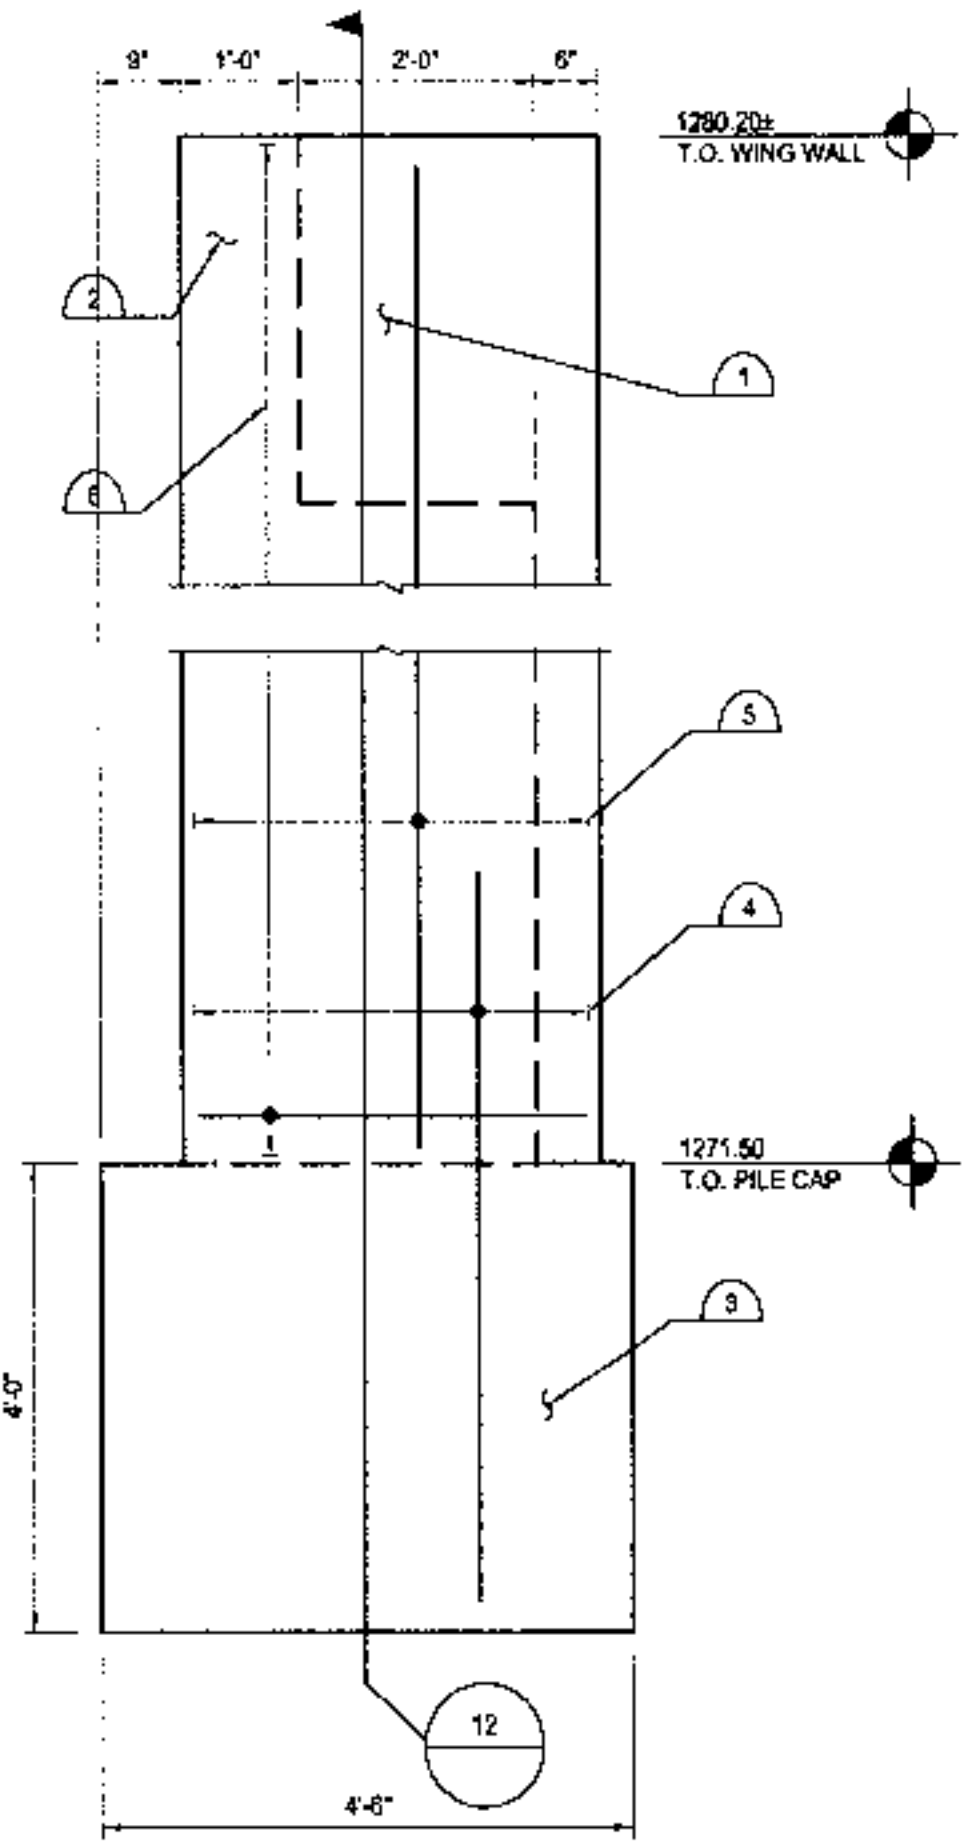

1. WING WALL
2. ABUTMENT NO. 1
3. PILE CAP (SEE 3/53-02 FOR REINFORCEMENT).
4. #5 @ 12" O.C.
5. #5 @ 12" O.C.
6. #5 @ 12"

12 WING WALL SECTION

8 WING WALL SECTION ON SOUTH SIDE

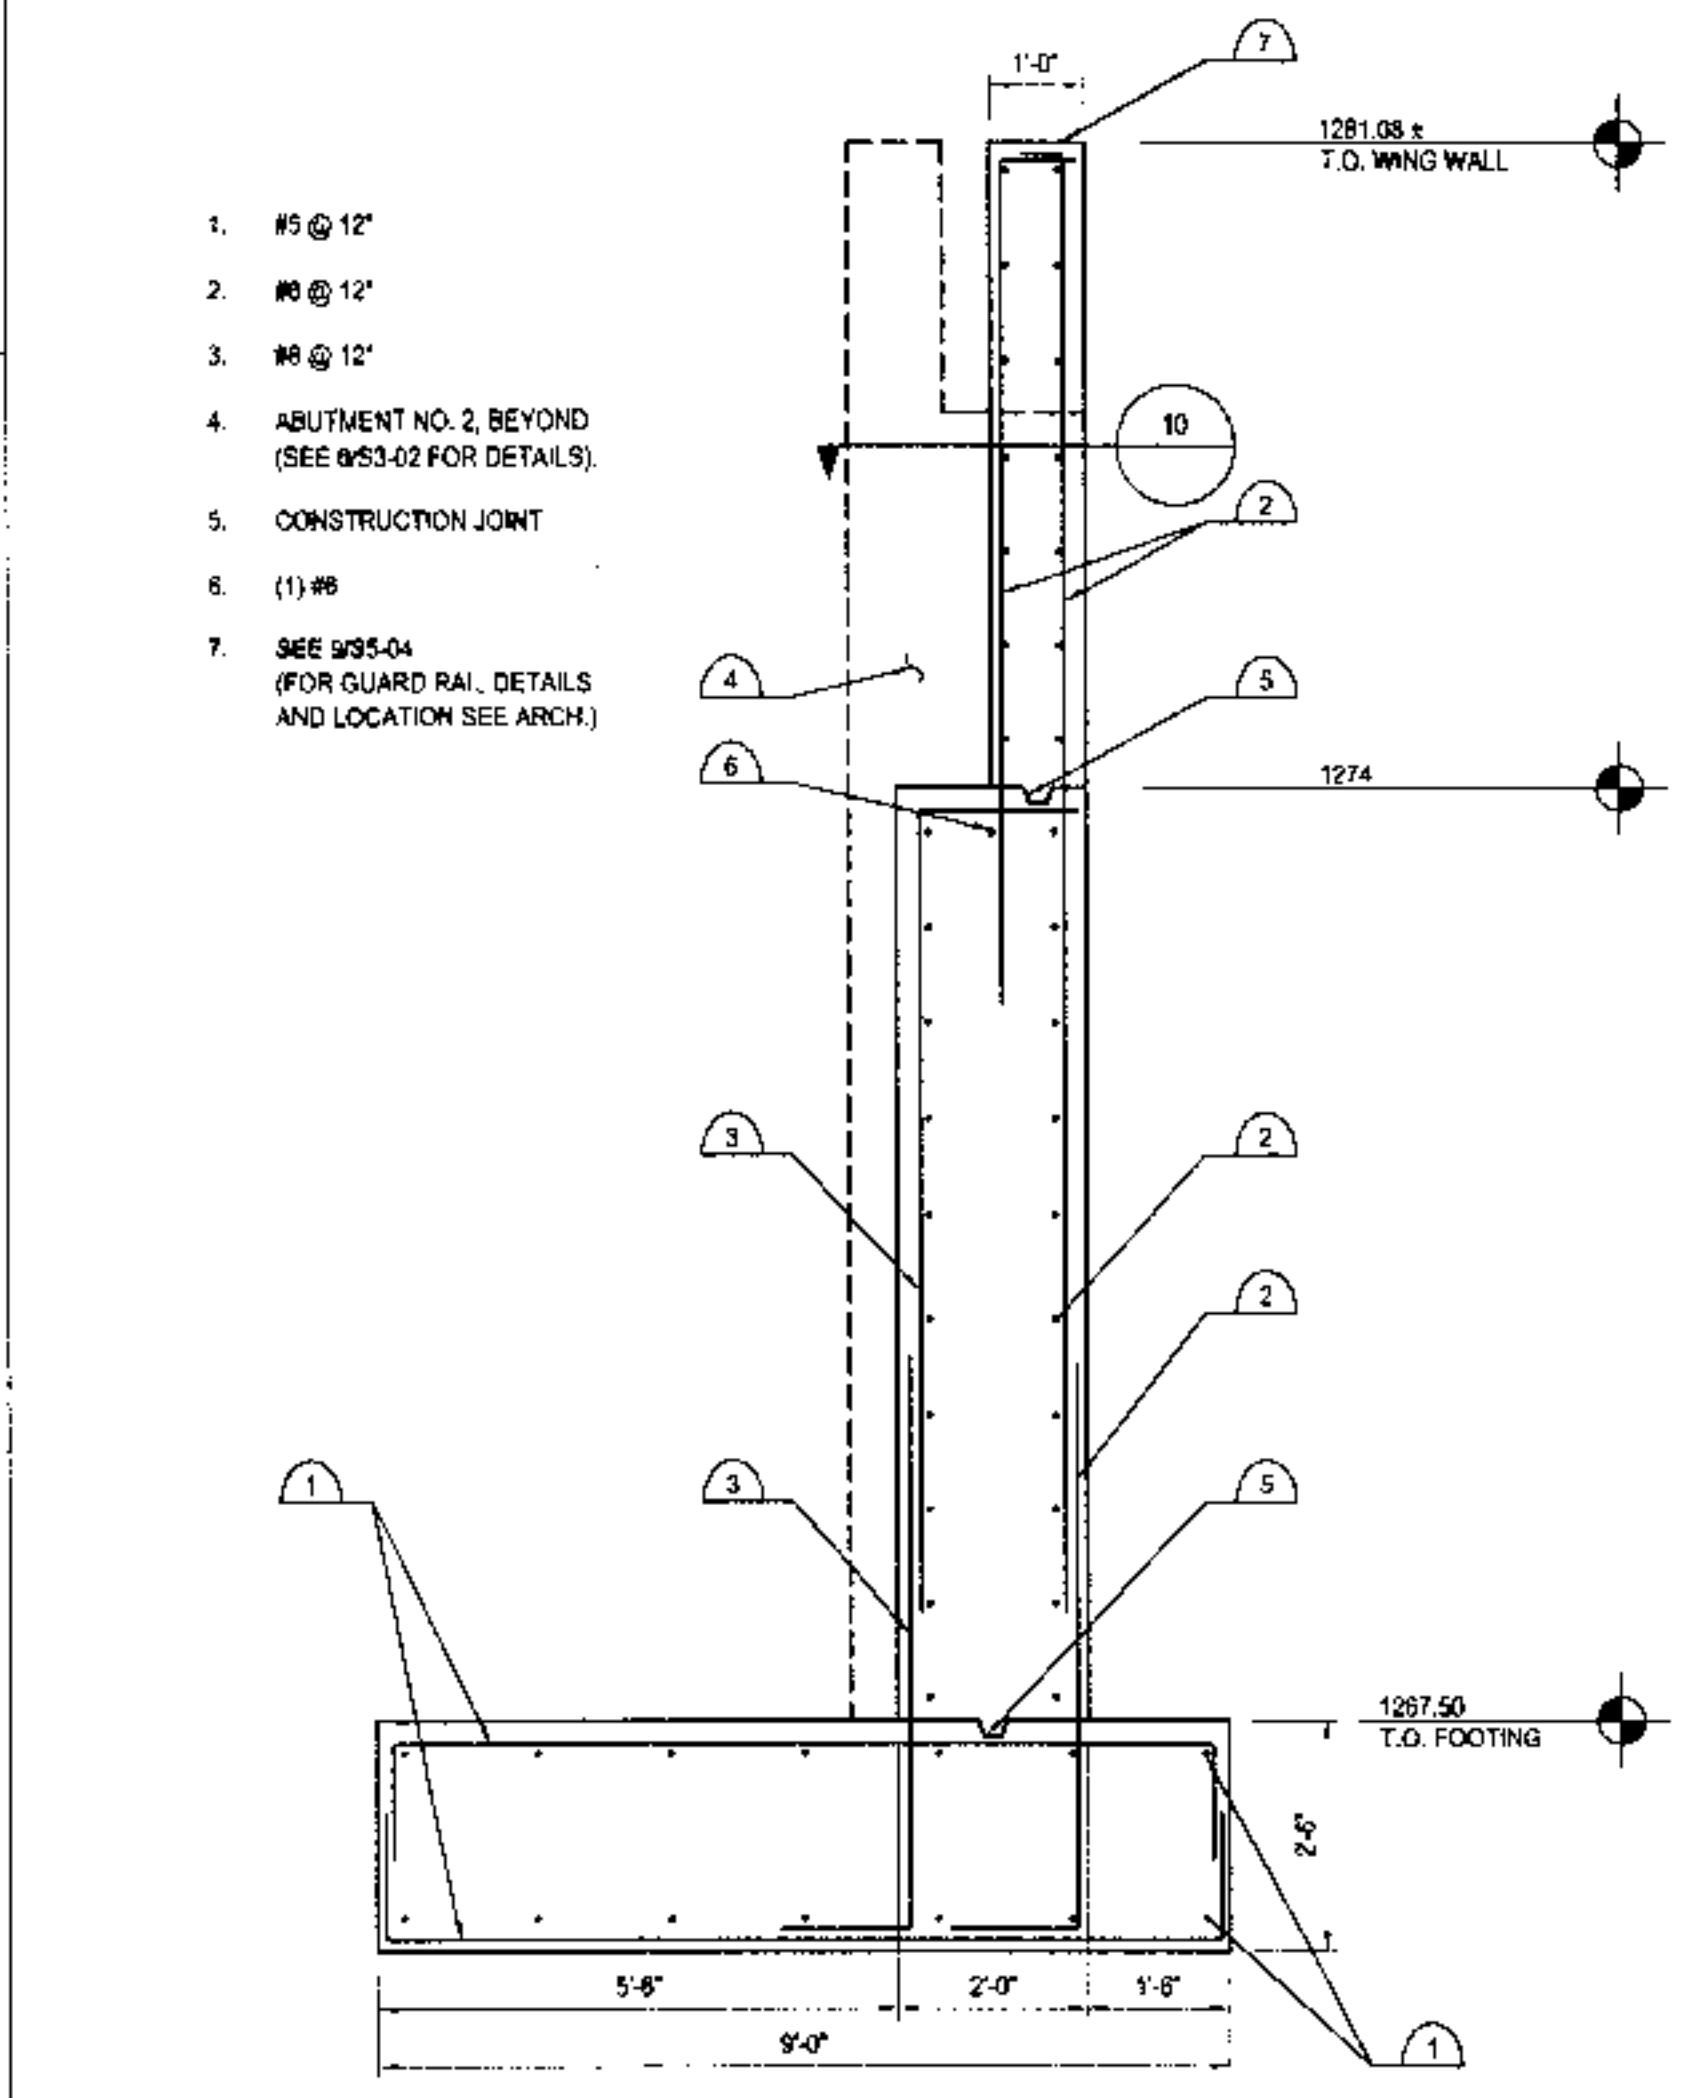

4 WING WALL SECTION ON NORTH SIDE

kpff Consulting Engineers
 2800 NORTH CENTRAL AVENUE, SUITE 1010
 PHOENIX, ARIZONA 85004
 PHONE (602) 284-1010 FAX (602) 285-1010
 KPFF PROJECT #: 110149.1

DESIGNWORKSHOP
 Landscape Architecture • Land Planning
 Urban Design • Tourism Planning
 Asheville • Aspen • Denver • Jackson Hole
 Park City • Santa Fe • Tempe • Lake Tahoe • Vail
 310 S. Mill Avenue, Suite 201
 Tempe, Arizona 85281
 (480) 966-5881
 Facsimile (480) 966-2799
 WWW.DESIGNWORKSHOP.COM

OWNER
CITY OF SCOTTSDALE
 7447 E INDIAN SCHOOL RD. SCOTTSDALE, AZ 85251
 480-312-7868

**Arizona Canal
 at Scottsdale - Phase I
 Scottsdale, Arizona**



**BID DOCUMENTS
 PHASE ONE**

**WINGWALL
 DETAILS**

ISSUED FOR: BID DOCUMENTS
 ISSUE DATE: OCTOBER 10, 2003
 REVISIONS

#	DATE	DESCRIPTION

 DRAWN: GAA/JG REVIEWED: MSP/AZ
 PROJECT NUMBER: 2829


REVISION _____ BY _____

CITY OF SCOTTSDALE
MUNICIPAL SERVICES DEPARTMENT
CAPITAL PROJECT MANAGEMENT
 3939 DRINKWATER BLVD.
 SCOTTSDALE, ARIZONA 85251

PROJECT TITLE: **ARIZONA CANAL AT SCOTTSDALE-PHASE I**


DESIGNED BY: <u>MSP/AZ</u>	DATE: <u>10-10-03</u>	BD NO: <u>H04P8034</u>	SHT: <u>S3-05</u>
DRAWN BY: <u>GAA/JG</u>	AS-BUILT: <u>0000</u>	PROJECT NO: <u>2829</u>	80 OF 89

DRAWINGS ADDED FOR REFERENCE ONLY.

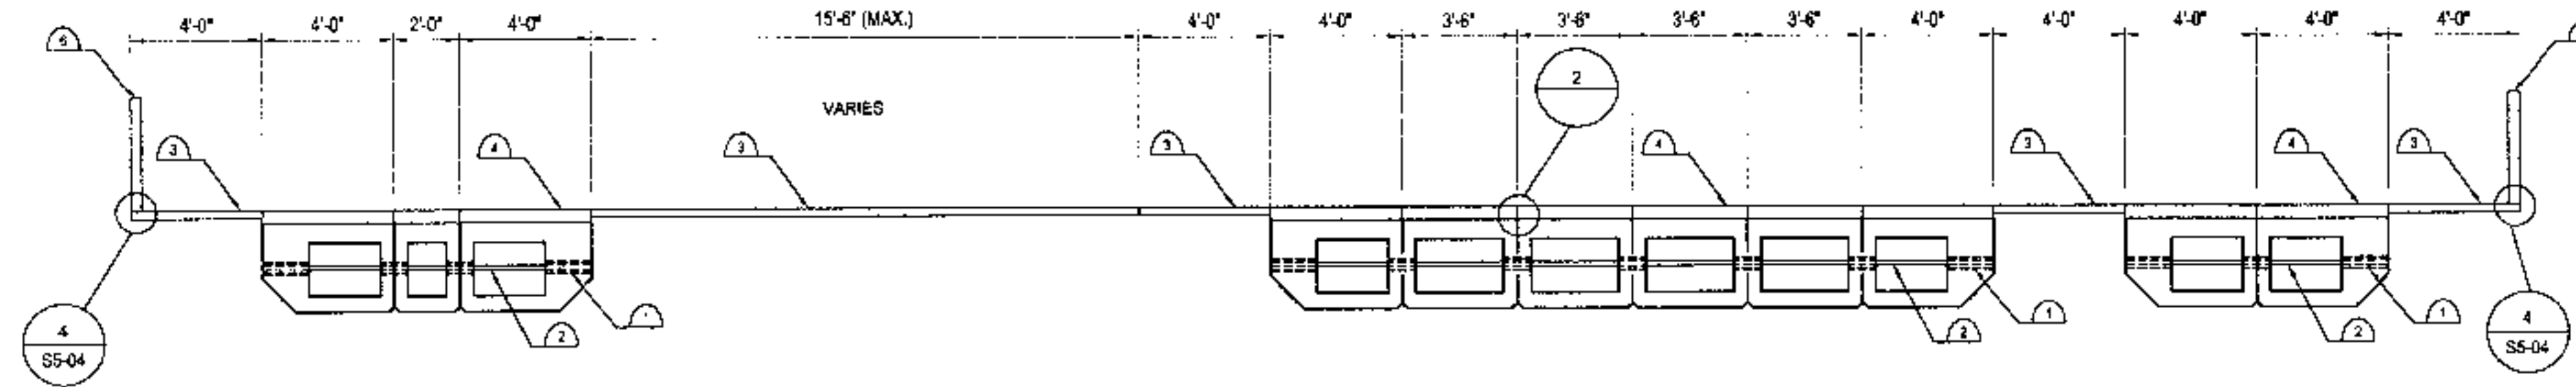

1 BRIDGE DECK SECTION
SCALE 1/4"=1'-0"


1. 4" Ø HOLE JUST AT THE LOCATION OF PLANTERS (SEE ARCH 1 (SEE 04S5-02 AND CONTRACTOR'S SHOP DRAWINGS FOR DETAILS).
2. 1 1/4" Ø TIE ROD W/ ACCESSORIES TENSION FROM ONE END (SEE CONTRACTOR'S SHOP DRAWINGS FOR ALL DIMENSIONS AND DETAILS).
3. GRATING PER PLAN.
4. NON-COMPOSITE CONCRETE.
5. CARBON FIBER LAYER. (CARBON FIBER DESIGN IS PENDING THE RESULTS OF THE CARBON FIBER TESTING. FINAL CARBON FIBER DRAWINGS AND SPECIFICATIONS WILL BE SUBMITTED WHEN THE TESTING IS COMPLETE).
6. GUARD RAIL.

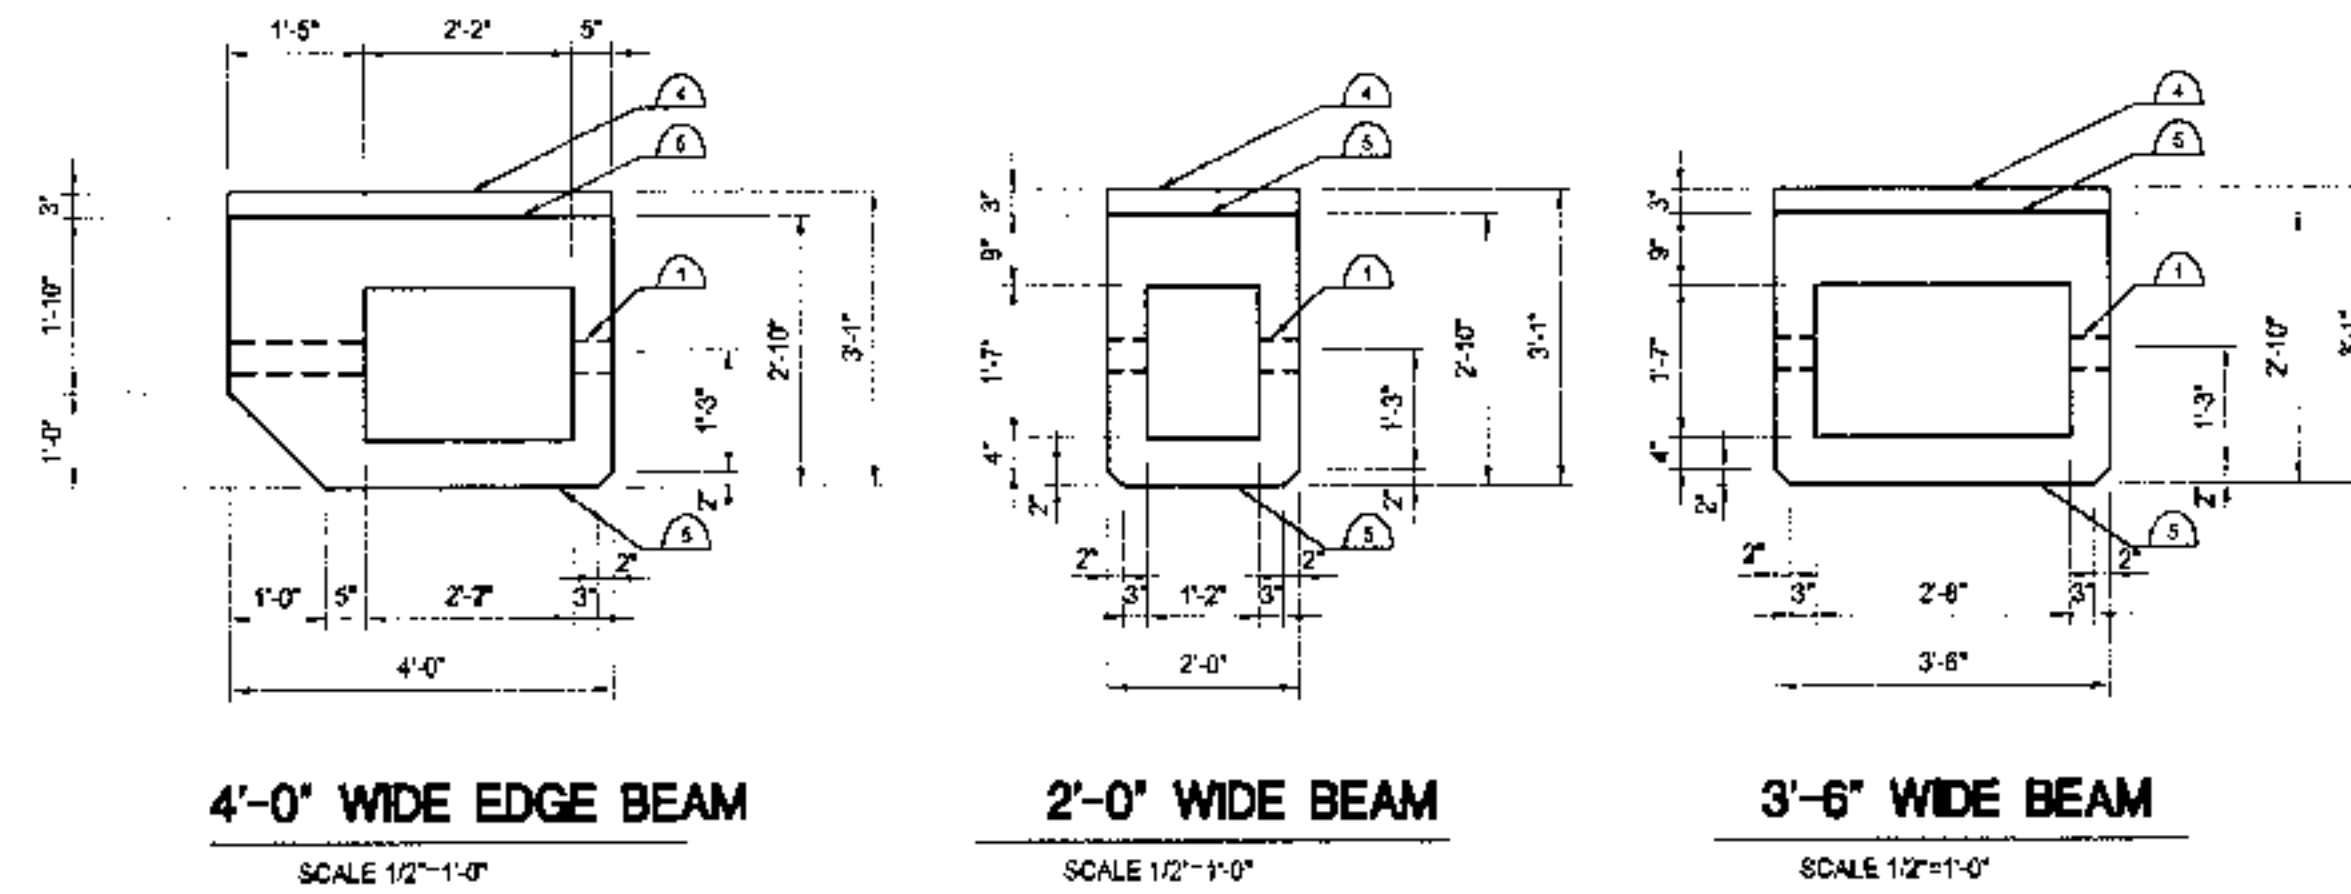

4'-0" WIDE EDGE BEAM
SCALE 1/2"=1'-0"

2'-0" WIDE BEAM
SCALE 1/2"=1'-0"

3'-6" WIDE BEAM
SCALE 1/2"=1'-0"

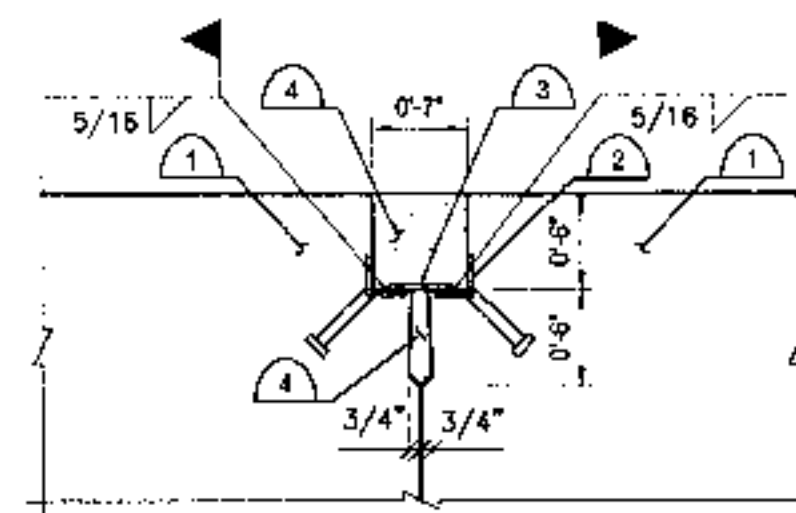

2 CONCRETE GIRDER SHEAR CONNECTION (TYP.)

1. CONCRETE GIRDER.
2. 2 1/2" x 2 1/2" x 3/8" x 0'-10" ANGLES @ 24° W/ (2) 3/4" H.A.S. @ 6" O.C.
3. 3/8" x 8" x 4" PLATE.
4. FILL WITH APPROVED NON-SHRINK 5000 P.S.I. GROUT AFTER UNITS ARE IN PLACE AND AFTER LATERALLY TENSIONED. (ALL BY TPAC). COVER FOR CURING.

DESIGNWORKSHOP

Landscape Architecture • Land Planning
Urban Design • Tourism Planning

Asheville • Aspen • Denver • Jackson Hole
Park City • Santa Fe • Tempe • Lake Tahoe • Vail

310 S. Mill Avenue, Suite 201

Tempe, Arizona 85281

(480) 966-5881

Facsimile (480) 966-2799

WWW.DESIGNWORKSHOP.COM

OWNER

CITY OF SCOTTSDALE

7447 E INDIAN SCHOOL RD. SCOTTSDALE, AZ. 85251
480-312-7869

**Arizona Canal
at Scottsdale - Phase I
Scottsdale, Arizona**



STAMP / DATE

BID DOCUMENTS
PHASE ONE

**GIRDER
DETAILS**

ISSUED FOR: BID DOCUMENTS

ISSUE DATE: OCTOBER 10, 2003

REVISIONS

#	DATE	DESCRIPTION

DRAWN: GAALUG REVIEWED: MSP/AZ

PROJECT NUMBER 2829

© COPYRIGHT DESIGNWORKSHOP, INC.

REVISION BY

**MUNICIPAL SERVICES
DEPARTMENT
CAPITAL PROJECT
MANAGEMENT**

3939 DRINKWATER BLVD.
SCOTTSDALE, ARIZONA 85251

kpff Consulting Engineers

2800 NORTH CENTRAL AVENUE, SUITE 1010
PHOENIX, ARIZONA 85004
PHONE (602) 264-1010 KPF PROJECT #:
FAX (602) 285-1010 **110149.1**

PROJECT TITLE
ARIZONA CANAL AT SCOTTSDALE-PHASE I

DESIGNED BY	DATE	REV. NO.	REV. DATE	REV. DESCRIPTION
MSP/AZ	10-10-03	#04PB034	SHT. S4-01	

DRAWN BY: GAALUG AS-BUILT PROJECT NO. 2829 81 OF 89

DRAWINGS ADDED FOR REFERENCE ONLY.

DESIGNWORKSHOP

Landscapes Architecture • Land Planning
Urban Design • Tourism Planning

Asheville • Aspen • Denver • Jackson Hole
Park City • Santa Fe • Tempe • Lake Tahoe • Vail

310 S. Mill Avenue, Suite 201
Tempe, Arizona 85281
(480) 966-5881
Facsimile (480) 966-2799

WWW.DESIGNWORKSHOP.COM

OWNER
CITY OF SCOTTSDALE

7417 E. INDIAN SCHOOL RD. SCOTTSDALE, AZ. 85251
480 212 7880

**Arizona Canal
at Scottsdale - Phase I**
Scottsdale, Arizona



STAMP / DATE

BID DOCUMENTS
PHASE ONE

**GRATING
PLAN**

ISSUED FOR: BID DOCUMENTS

ISSUE DATE: OCTOBER 10, 2003

REVISIONS

#	DATE	DESCRIPTION

DRAWN: GAUJG REVIEWED: MSPAZ

PROJECT NUMBER: 2829

© COPYRIGHT OF DESIGNWORKSHOP, INC.

REVISION BY

**MUNICIPAL SERVICES
DEPARTMENT
CAPITAL PROJECT
MANAGEMENT**





3939 DRINKWATER BLVD.
SCOTTSDALE, ARIZONA 85251

PROJECT TITLE
ARIZONA CANAL AT SCOTTSDALE-PHASE I

DESIGNED BY MSPAZ	DATE 10-10-03	BID NO. #04PB034	Sht. S5-01
DRAWN BY GAUJG	AS-BUILT 0000	PROJECT NO. 2829	82 OF 89

KEY NOTES:

- CONCRETE GIRDERS.
- TS 10 x 6 x 5/8.
- TS 10 x 6 x 5/8 AND TS 6 x 6 x 5/8 (SEE 2/SS-02 FOR DETAILS).
- TS 10 x 6 x 3/16
- TS 10 x 6 x 1/4.
- TS 10 x 6 x 3/16.
- TS 4 x 4 x 1/4.
- TS 10 x 6 x 3/16 (TAPERED).
- WING WALL
- TS 6 x 6 x 1/4
- GRATING, MANHOLS GDM-1 SERIES, ALUMINUM CLOSE MESH, 1 1/4" x 3/16" (SEE S1-01).
- TS 6 x 6 x 9/16.
- TS 6 x 6 x 1/2.
- TS 6 x 6 x 3/8.
- TS 6 x 6 x 1/4.
- GRATING TO BE REMOVABLE CONTINUOUSLY AT 4'-0" STRIP BY FASTENED MECHANICAL CLIPS (SEE MANUFACTURER).
- CONSTRUCTION CENTERLINE.
- ABUTMENT CENTERLINE
- 2 3/4" WIDTH EXPANSION JOINT (SEE 1 & 2/SS-03 FOR DETAILS).
- 1 1/4" WIDTH JOINT (SEE 5 & 6/SS-03 FOR DETAILS).
- TS 6 x 4 x 1/4 (SEE 7/SS-03)
- TS 8 x 4 x 1/4 CURVED.
- TS 10 x 6 x 5/8 AND TS 6 x 6 x 5/8 (SEE 4/SS-02 FOR DETAILS)
- BUILT UP STEEL TUBE 1'-11 3/4" x 6" x 3/8" x 6" TOTAL WIDTH.
- TS 10 x 6 x 1/4 (SEE 1/SS-03 FOR EXPANSION JOINT DETAILS).
- BUILT UP STEEL TUBE 1'-11 3/4" x 8" x 3/8" x 6" TOTAL WIDTH.
- GUARDRAIL ALONG EACH SIDE OF BRIDGE (SEE ARCH & 4/SS-04).
- SEE 2/SS-04 FOR PLANTER DETAIL.
- GUARD RAIL AT TOP OF WING WALL (SEE ARCH AND 9/SS-04).

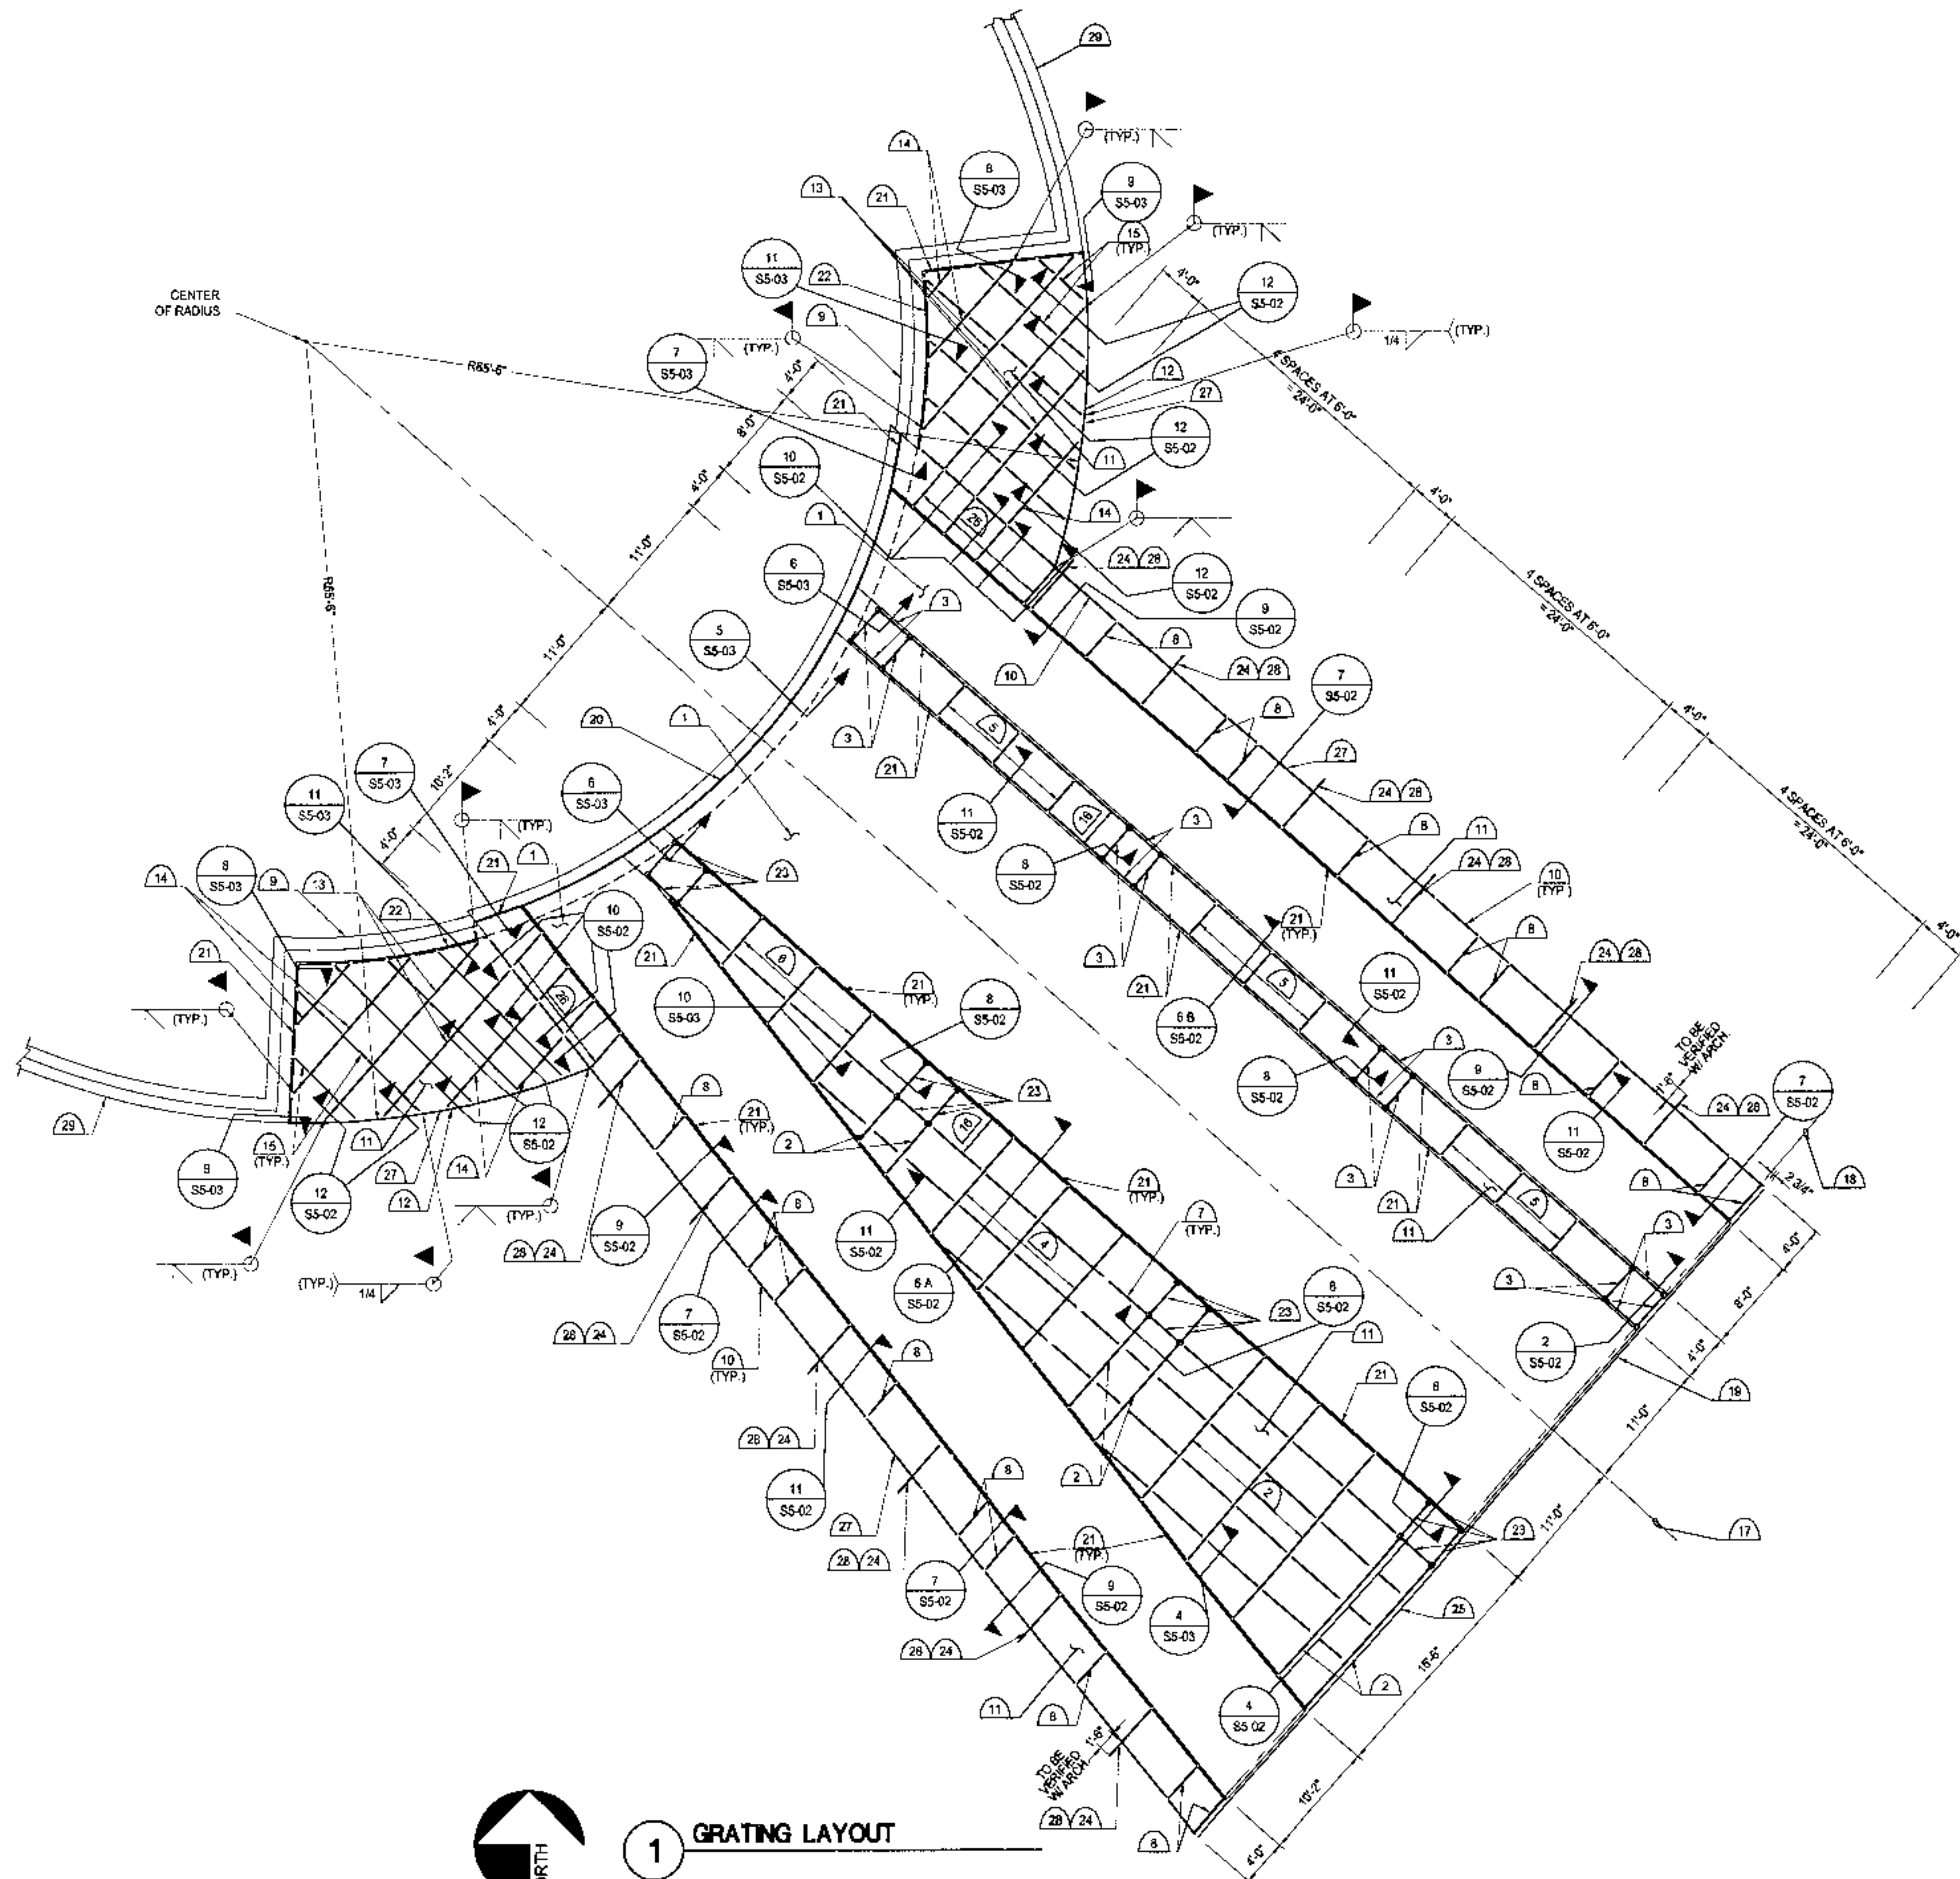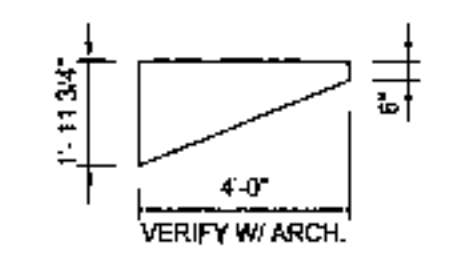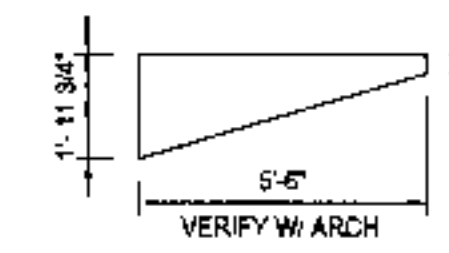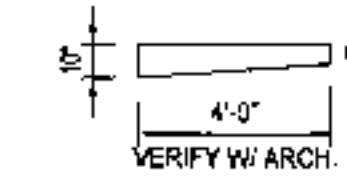


1 GRATING LAYOUT

kpff Consulting Engineers


2800 NORTH CENTRAL AVENUE, SUITE 1010
PHOENIX, ARIZONA 85004
PHONE (602) 264-1010 KPFF PROJECT #:
FAX (602) 285-1010 **110149.1**

DRAWINGS ADDED FOR REFERENCE ONLY.

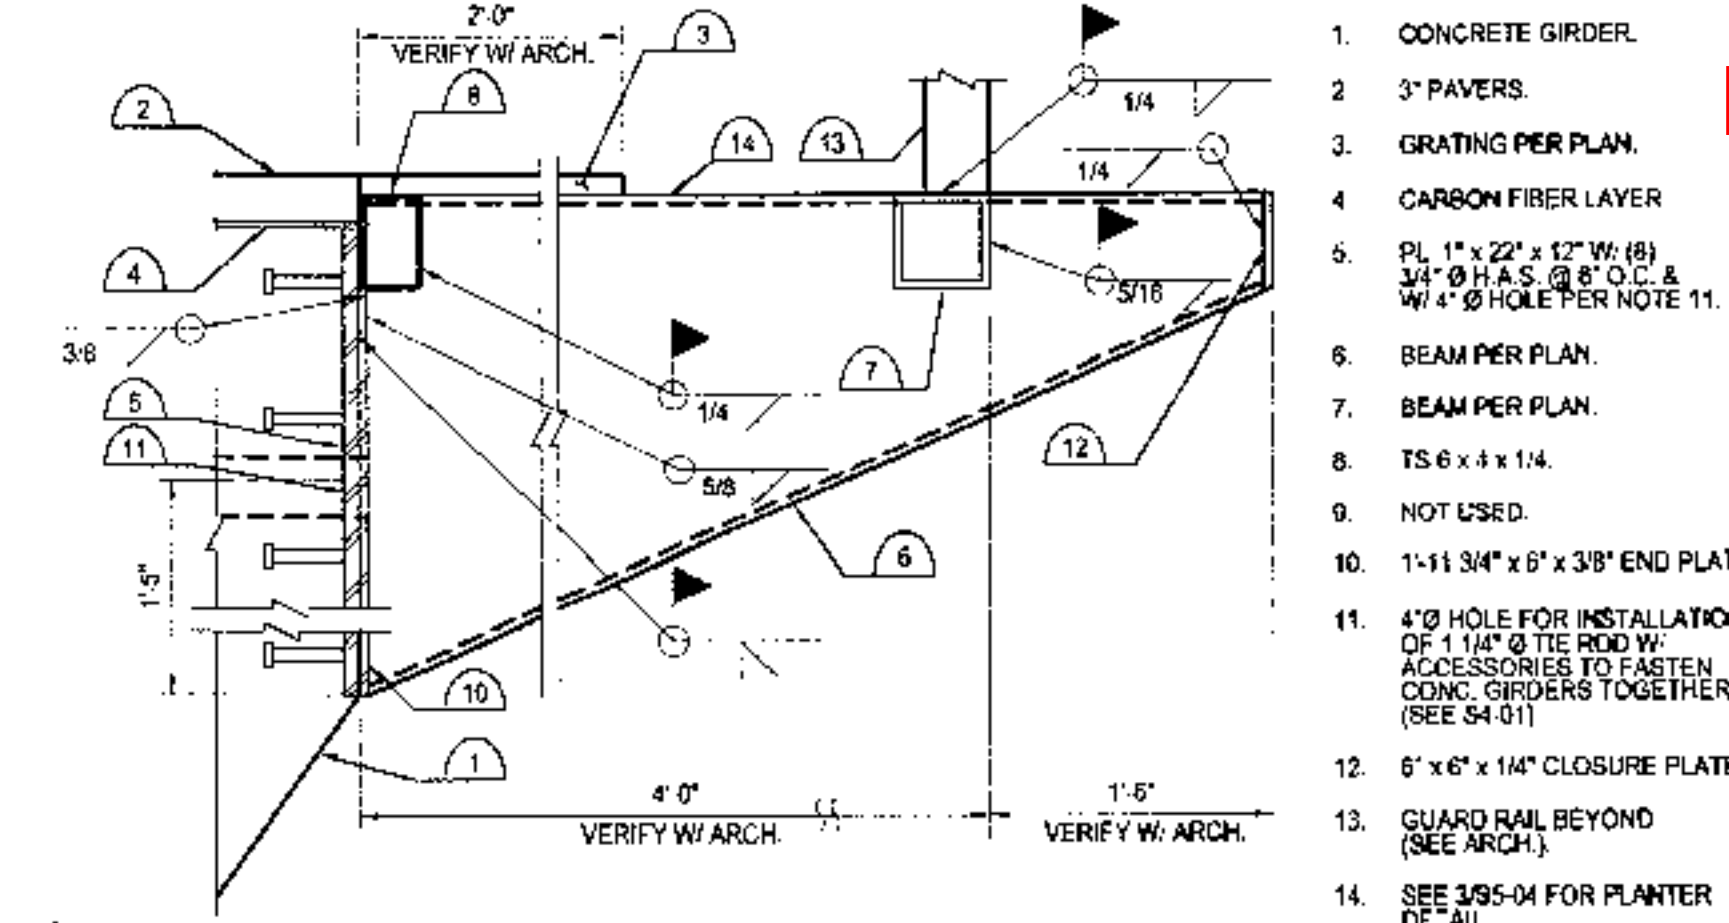


9 TYPICAL CANTILEVER BEAM CONNECTIONS AT PLANTERS LOCATION

1. CONCRETE GIRDER.
2. 3" PAVERS.
3. GRATING PER PLAN.
4. CARBON FIBER LAYER.
5. PL. 1" x 22" x 12" W/ (8) 3/4" Ø H.A.S. @ 6" O.C. & W/ 4" Ø HOLE PER NOTE 11.
6. BEAM PER PLAN.
7. BEAM PER PLAN.
8. TS 6 x 4 x 1/4.
9. NOT USED.
10. 1-1/2 3/4" x 6" x 3/8" END PLATE.
11. 4" Ø HOLE FOR INSTALLATION OF 1 1/4" Ø TIE ROD W/ ACCESSORIES TO FASTEN CONC. GIRDERS TOGETHER. (SEE 94.01)
12. 6" x 6" x 1/4" CLOSURE PLATE.
13. GUARD RAIL BEYOND (SEE ARCH.).
14. SEE 3/95-04 FOR PLANTER DETAIL.

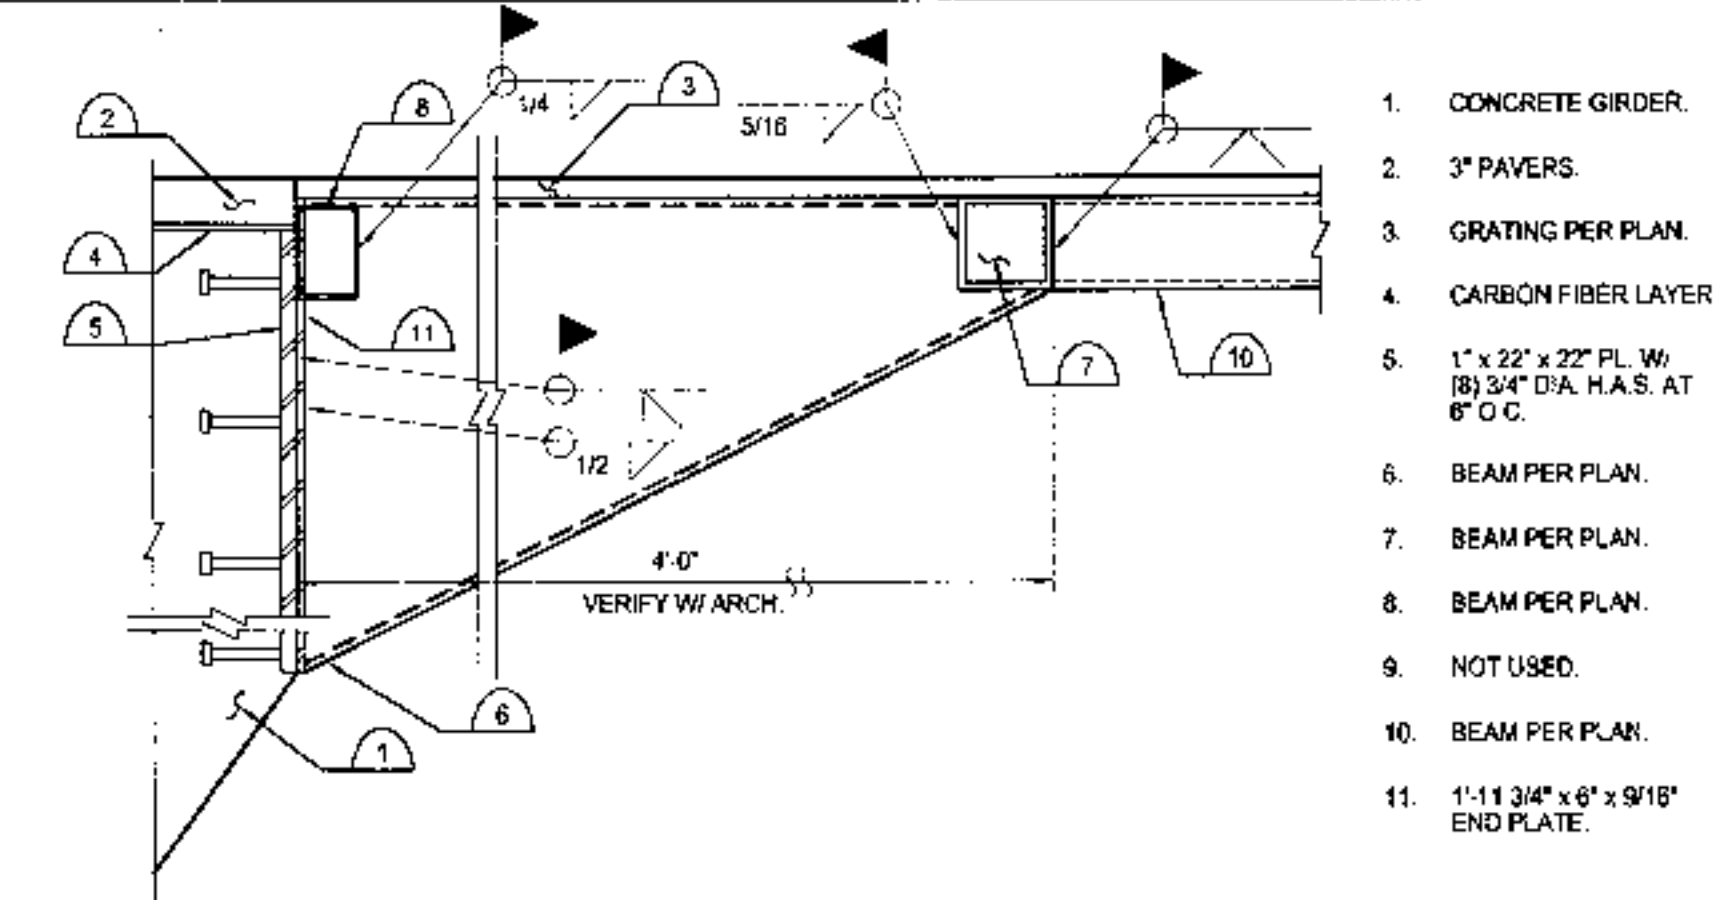


10 TYPICAL CANTILEVER BEAM CONNECTIONS

1. CONCRETE GIRDER.
2. 3" PAVERS.
3. GRATING PER PLAN.
4. CARBON FIBER LAYER.
5. 1" x 22" x 12" PL. W/ (8) 3/4" Ø H.A.S. @ 6" O.C.
6. BEAM PER PLAN.
7. BEAM PER PLAN.
8. BEAM PER PLAN.
9. NOT USED.
10. BEAM PER PLAN.
11. 1-1/2 3/4" x 6" x 3/8" END PLATE.

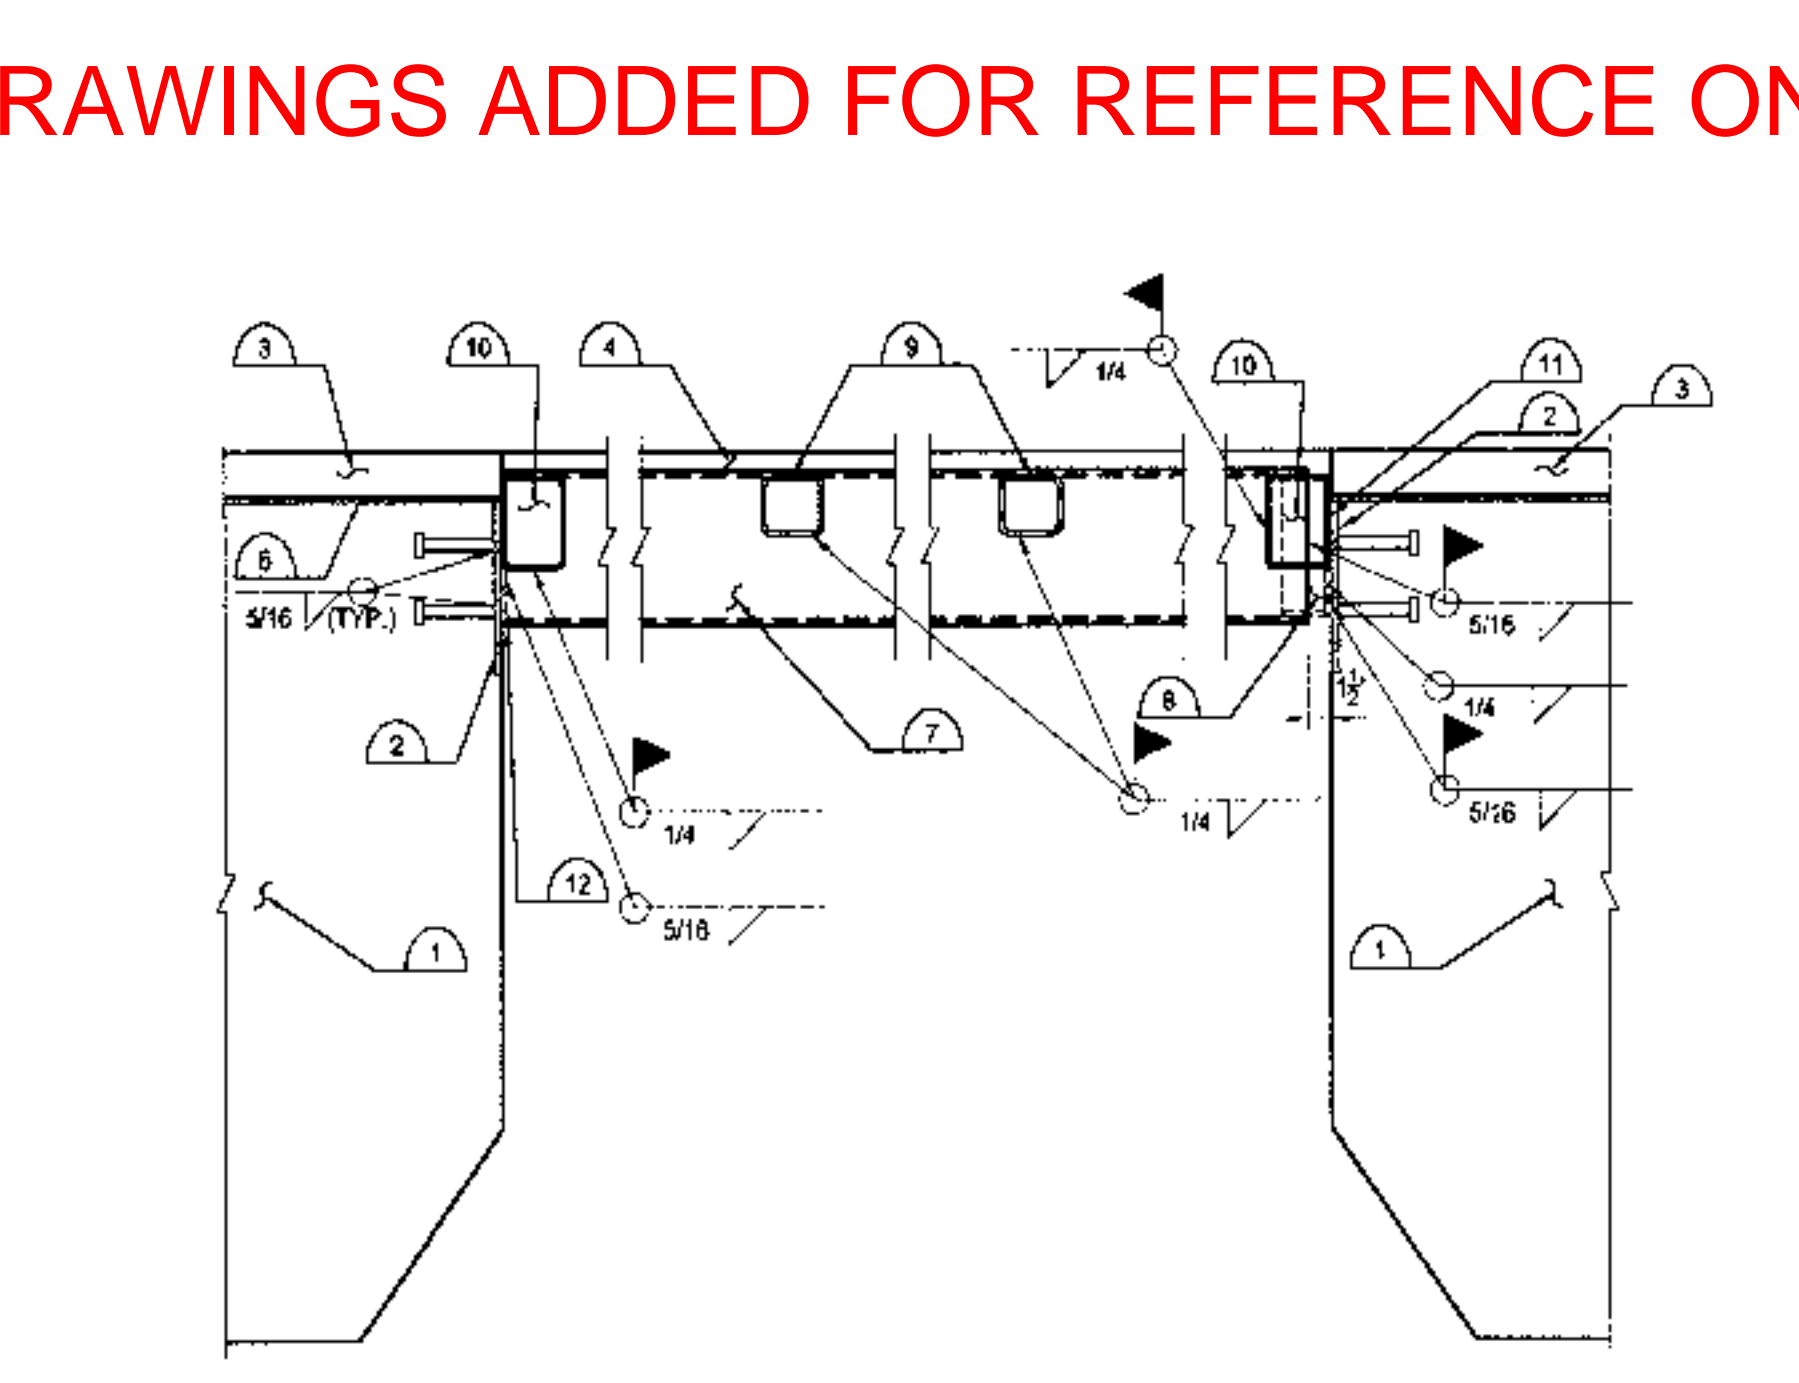


6A STEEL FRAMING CONNECTION TO CONCRETE GIRDER

1. CONCRETE GIRDER.
2. 1/2" x 9" x 9" W/ (4) 3/4" Ø H.A.S. @ 6" O.C.
3. 3" PAVERS.
4. GRATING PER PLAN.
5. NOT USED.
6. CARBON FIBER LAYER.
7. BEAM PER PLAN.
8. TS 9" x 5" x 5/16" x 0-3" (SEE DETAIL X).
9. BEAM PER PLAN (FOR 6A).
10. TS 6" x 4" x 1/4".
11. 9 x 5 x 5/16 END PLATE.
12. 10 x 6 x 5/16 END PLATE.
13. 1/4" x 9 1/4" x 3" PLATE.
14. 1/4" x 5" x 3" PLATE.

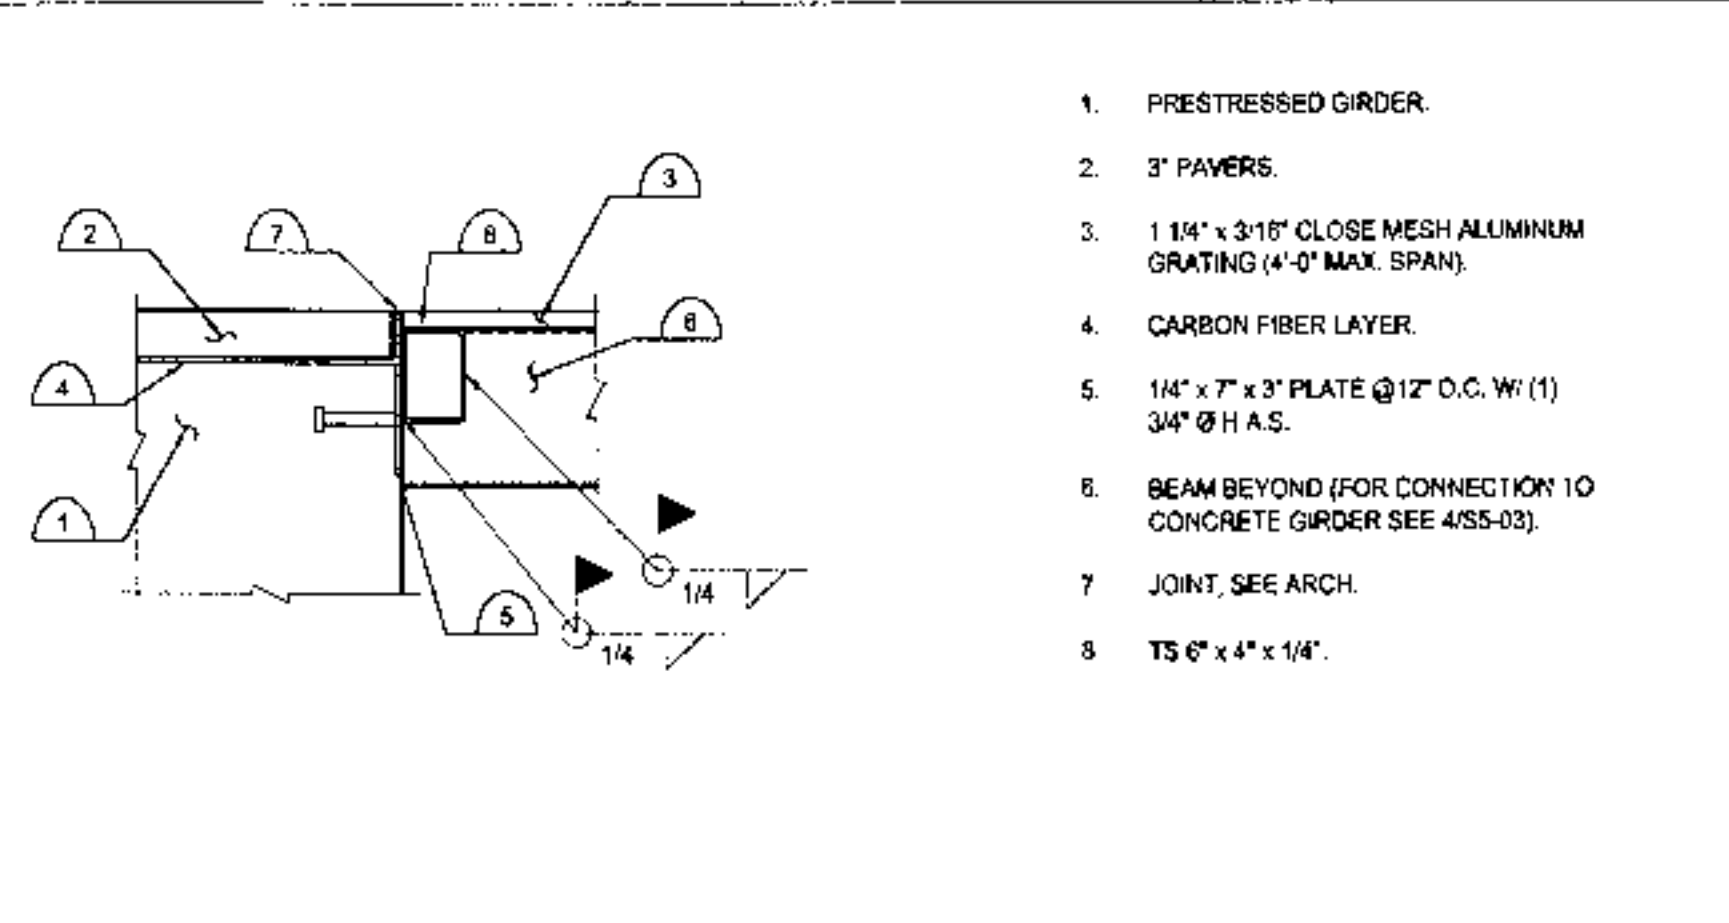


11 GRATING BEARING TYPICAL CONNECTION OF LONGITUDINAL STEEL TUBE TO CONCRETE GIRDER

1. PRESTRESSED GIRDER.
2. 3" PAVERS.
3. 1 1/4" x 3/16" CLOSE MESH ALUMINUM GRATING (4'-0" MAX. SPAN).
4. CARBON FIBER LAYER.
5. 1/4" x 7" x 3" PLATE @ 12" O.C. W/ (1) 3/4" Ø H.A.S.
6. BEAM BEYOND (FOR CONNECTION TO CONCRETE GIRDER SEE 4/SS-03).
7. JOINT, SEE ARCH.
8. TS 6" x 4" x 1/4".

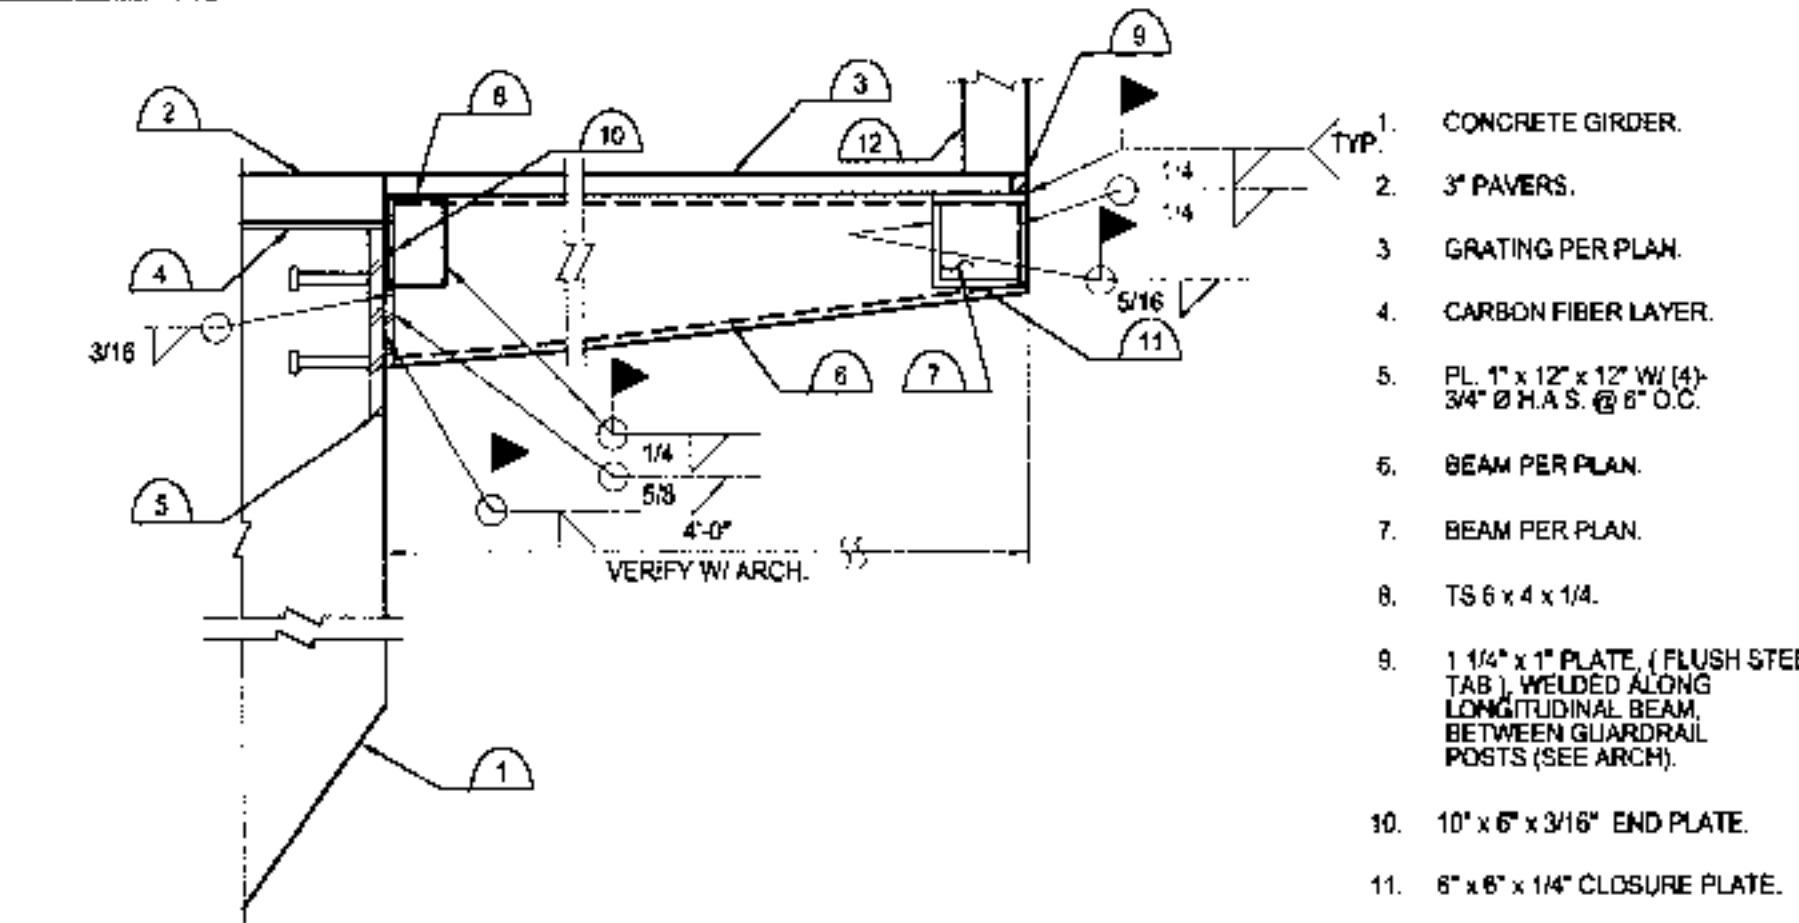


7 TYPICAL CANTILEVER BEAM CONNECTIONS

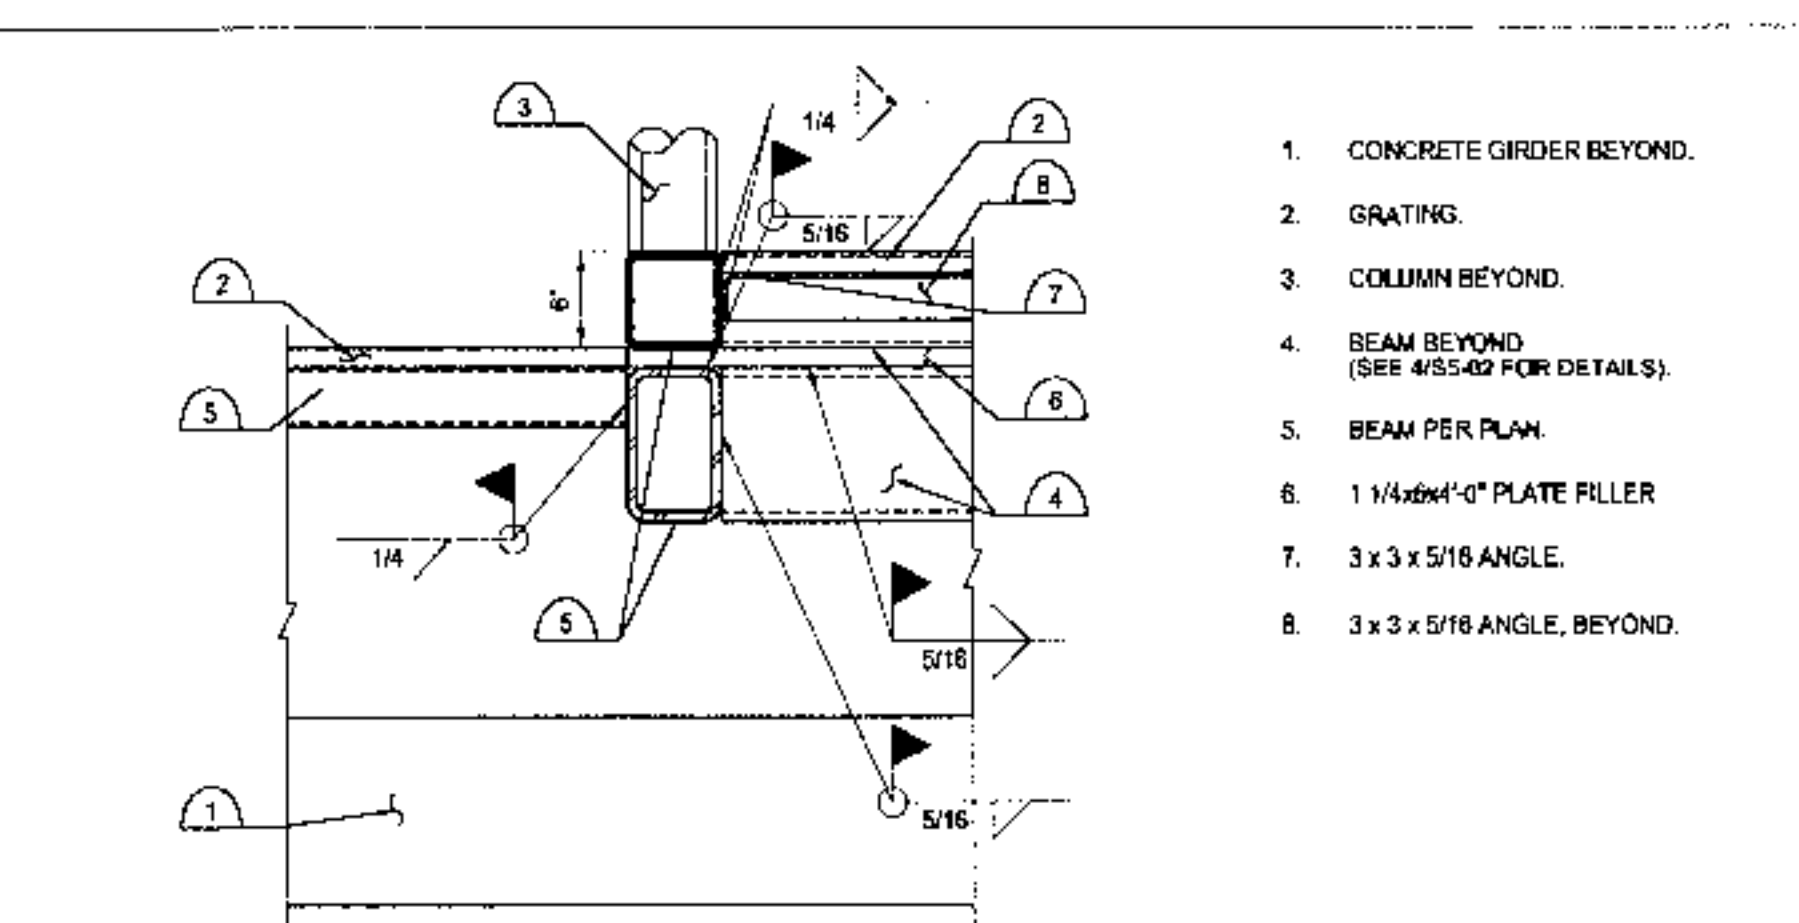


8 TYPICAL CONNECTION AT THE LOCATION OF COLUMNS

1. CONCRETE GIRDER BEYOND.
2. GRATING.
3. COLUMN BEYOND.
4. BEAM BEYOND (SEE 4/SS-02 FOR DETAILS).
5. BEAM PER PLAN.
6. 1 1/4" x 6" x 1/4" PLATE FILLER.
7. 3 x 3 x 5/16 ANGLE.
8. 3 x 3 x 5/16 ANGLE, BEYOND.
9. 1 1/4" x 1" PLATE. (FLUSH STEEL TAB), WELDED ALONG LONGITUDINAL BEAM, BETWEEN GUARDRAIL POSTS (SEE ARCH).
10. 10" x 6" x 3/16" END PLATE.
11. 6" x 6" x 1/4" CLOSURE PLATE.
12. GUARD RAIL (SEE ARCH.).

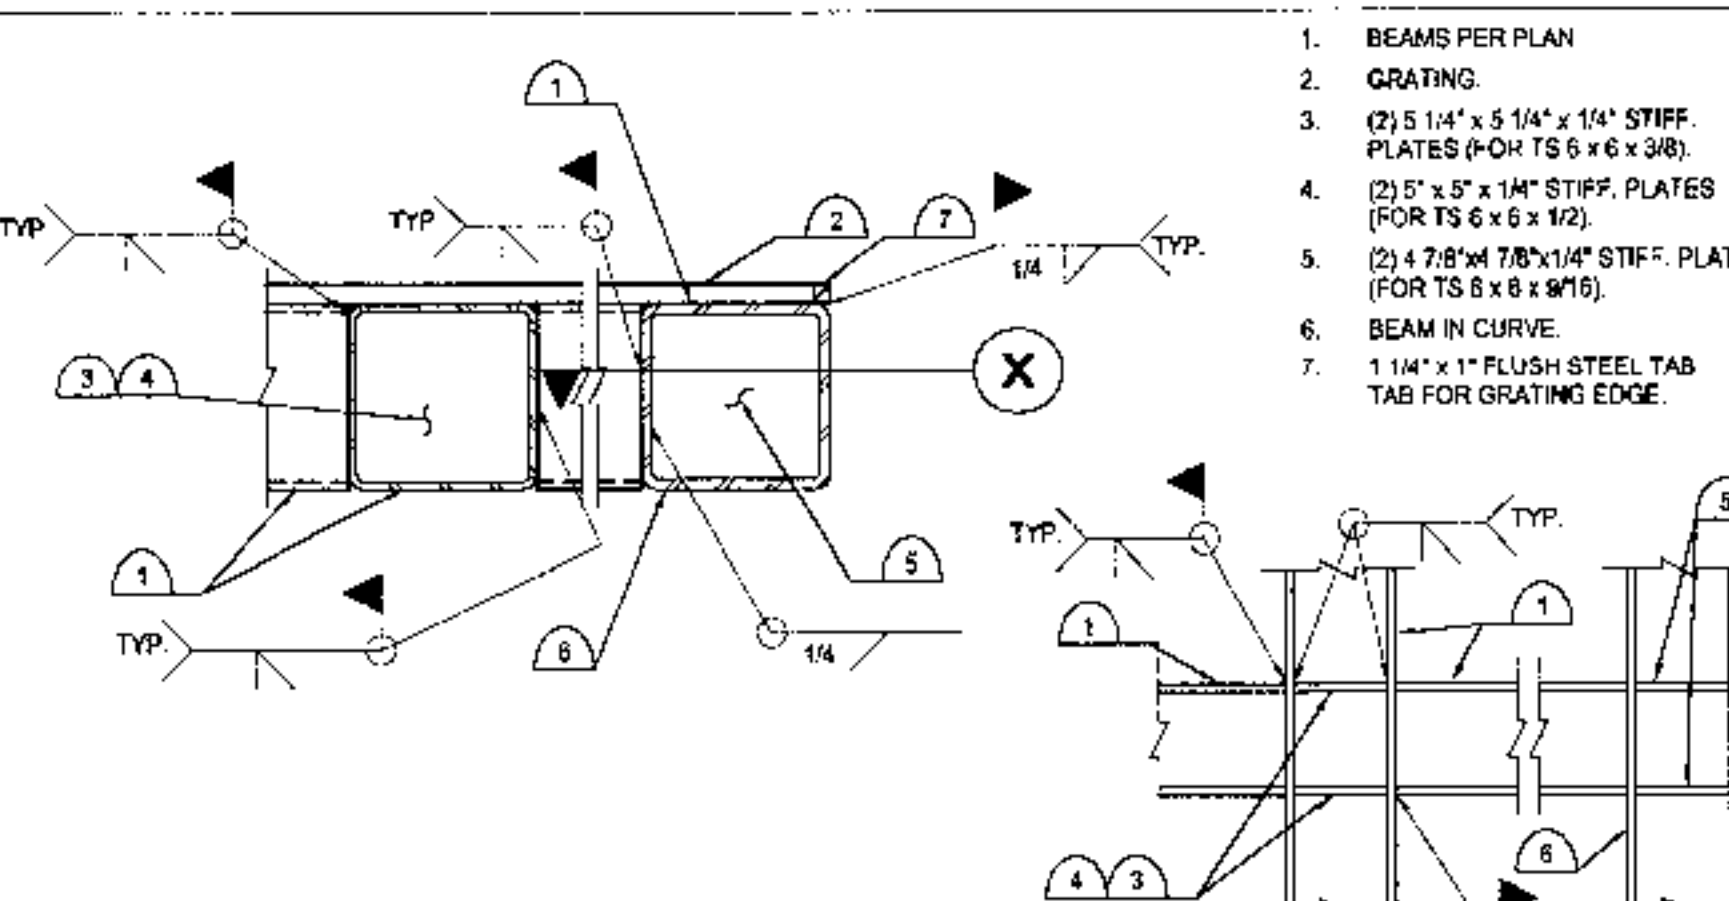


12 TYPICAL RIGID CONNECTIONS OF GRATING FRAMING BEAMS

1. BEAMS PER PLAN.
2. GRATING.
3. (2) 5 1/4" x 5 1/4" x 1/4" STIFF. PLATES (FOR TS 6 x 6 x 3/8).
4. (2) 5" x 5" x 1/4" STIFF. PLATES (FOR TS 6 x 6 x 1/2).
5. (2) 4 7/8" x 7 7/8" x 1/4" STIFF. PLATES (FOR TS 6 x 8 x 3/16).
6. BEAM IN CURVE.
7. 1 1/4" x 1" FLUSH STEEL TAB FOR GRATING EDGE.

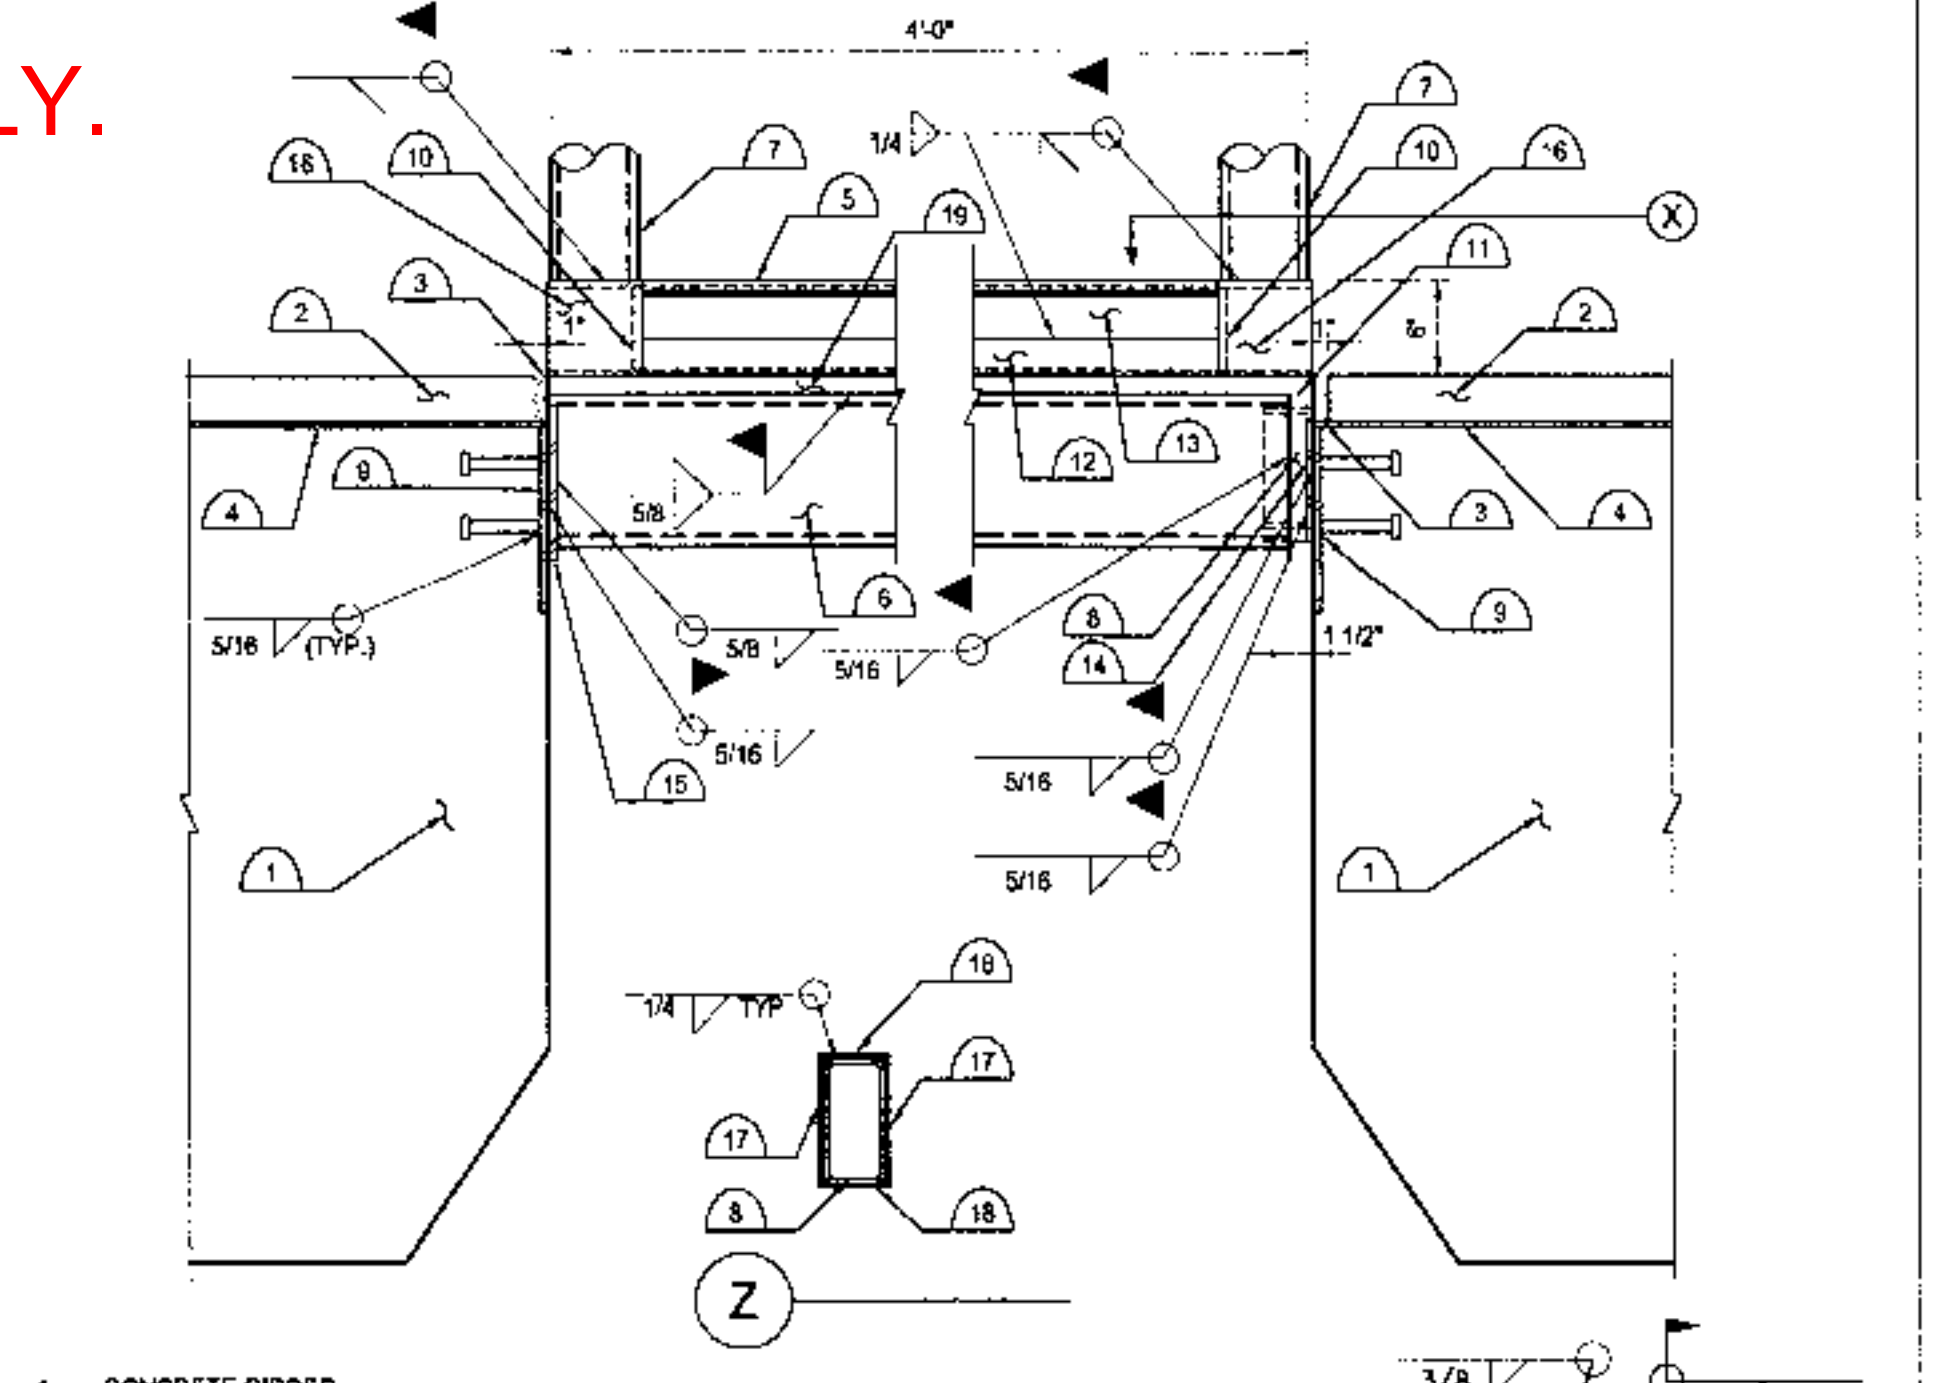

2 STEEL FRAMING CONNECTION TO CONCRETE GIRDER

1. CONCRETE GIRDER.
2. 3" PAVERS.
3. JOINT, SEE ARCH.
4. CARBON FIBER LAYER.
5. GRATING PER PLAN.
6. TS 10 x 6 x 5/8.
7. SHADE CANOPY COLUMN PER PLAN.
8. TS 8 x 4 x 3/8 x 0-3" (SEE DETAIL Z).
9. PL. 1/2" x 12" x 12" W/ (4) 3/4" Ø H.A.S. @ 6" O.C.
10. 5/8" x 4 3/4" x 4 3/4" STIFFENER PLATE. (BEAM ON NOTE 12 SHOULD BE CUT AND REWELDED AFTER WELDING THE STIFFENER).
11. FILL W/ WELD.
12. TS 8 x 6 x 5/8.
13. 3 x 3 x 5/16 ANGLE.
14. 8 x 4 x 3/8 END PLATE.
15. 10 x 6 x 5/8 END PLATE.
16. FOR BEAM ON OTHER DIRECTION SEE 8/SS-02.
17. (2) 1/4" x 8 1/2" x 3" PLATES.
18. (2) 1/4" x 4" x 3" PLATES.
19. 1 1/4" x 6" x 4" PLATE (FILLER).

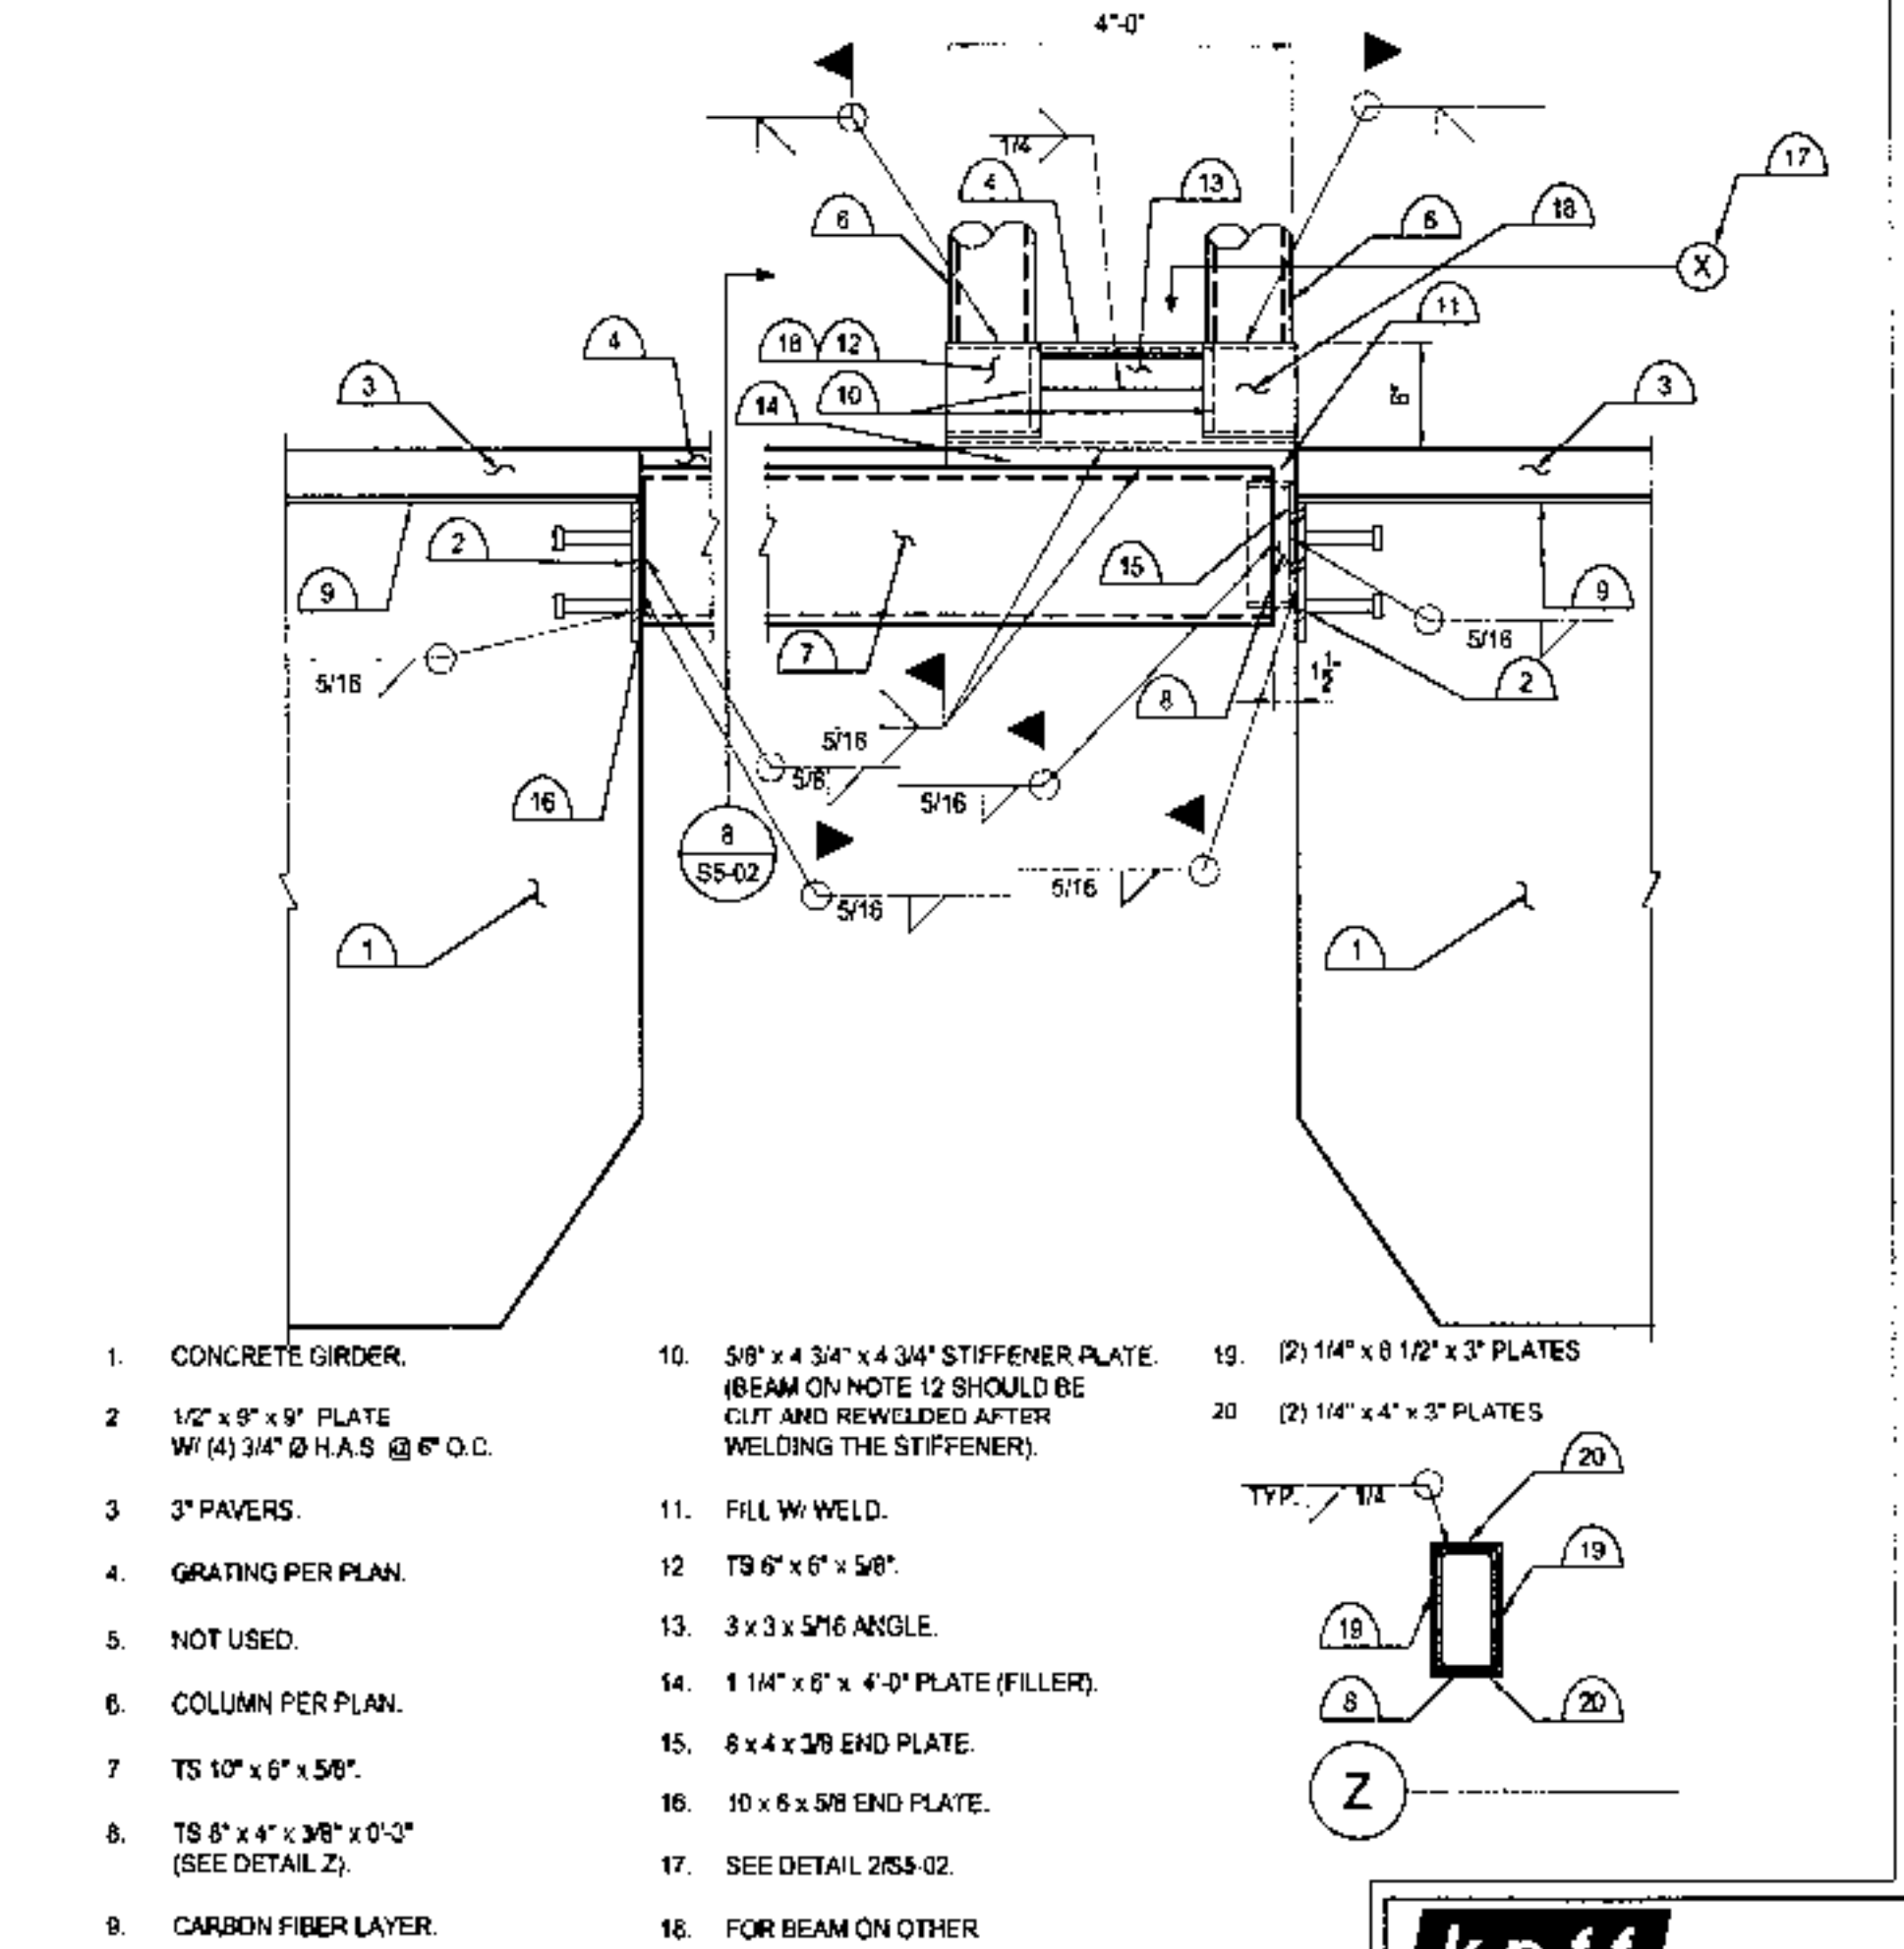

4 STEEL FRAMING CONNECTION TO CONCRETE GIRDER

1. CONCRETE GIRDER.
2. 1/2" x 9" x 9" PLATE W/ (4) 3/4" Ø H.A.S. @ 6" O.C.
3. 3" PAVERS.
4. GRATING PER PLAN.
5. NOT USED.
6. COLUMN PER PLAN.
7. TS 10" x 6" x 5/8".
8. TS 8" x 4" x 3/8" x 0-3" (SEE DETAIL Z).
9. CARBON FIBER LAYER.
10. 5/8" x 4 3/4" x 4 3/4" STIFFENER PLATE. (BEAM ON NOTE 12 SHOULD BE CUT AND REWELDED AFTER WELDING THE STIFFENER).
11. FILL W/ WELD.
12. TS 9 6" x 6" x 5/8".
13. 3 x 3 x 5/16 ANGLE.
14. 1 1/4" x 6" x 4" PLATE (FILLER).
15. 8 x 4 x 3/8 END PLATE.
16. 10 x 6 x 5/8 END PLATE.
17. SEE DETAIL 2/SS-02.
18. FOR BEAM ON OTHER DIRECTION SEE 8/SS-02.
19. (2) 1/4" x 8 1/2" x 3" PLATES.
20. (2) 1/4" x 4" x 3" PLATES.

DESIGNWORKSHOP
 Landscape Architecture • Land Planning
 Urban Design • Tourism Planning
 Asheville • Aspen • Denver • Jackson Hole
 Park City • Santa Fe • Tempe • Lake Tahoe • Vail
 310 S. Mill Avenue, Suite 201
 Tempe, Arizona 85281
 (480) 966-5881
 Facsimile (480) 966-2799
 WWW.DESIGNWORKSHOP.COM
OWNER
 CITY OF SCOTTSDALE
 7447 E INDIAN SCHOOL RD. SCOTTSDALE, AZ 85251
 480-312-7069

Arizona Canal at Scottsdale - Phase I
 Scottsdale, Arizona



STAMP / DATE
BID DOCUMENTS
PHASE ONE
GRATING
DETAILS

ISSUED FOR: BID DOCUMENTS
 ISSUE DATE: OCTOBER 10, 2003

REVISIONS	#	DATE	DESCRIPTION


DRAWN: GAALG REVIEWED: MSP-AZ
 PROJECT NUMBER: 2829
 © COPYRIGHT DESIGNWORKSHOP, INC.

DESIGNED BY: MSP/AZ DATE: 10-10-03
 DRAWN BY: GAALG DATE: 10-10-03
 PROJECT NO.: 2829 SHEET NO.: 83 OF 89

MUNICIPAL SERVICES DEPARTMENT
CAPITAL PROJECT MANAGEMENT
 3939 DRINKWATER BLVD.
 SCOTTSDALE, ARIZONA 85261


PROJECT TITLE: ARIZONA CANAL AT SCOTTSDALE-PHASE I
 SHEET NO.: #04PB034
 DATE: 10-10-03
 PROJECT NO.: 2829



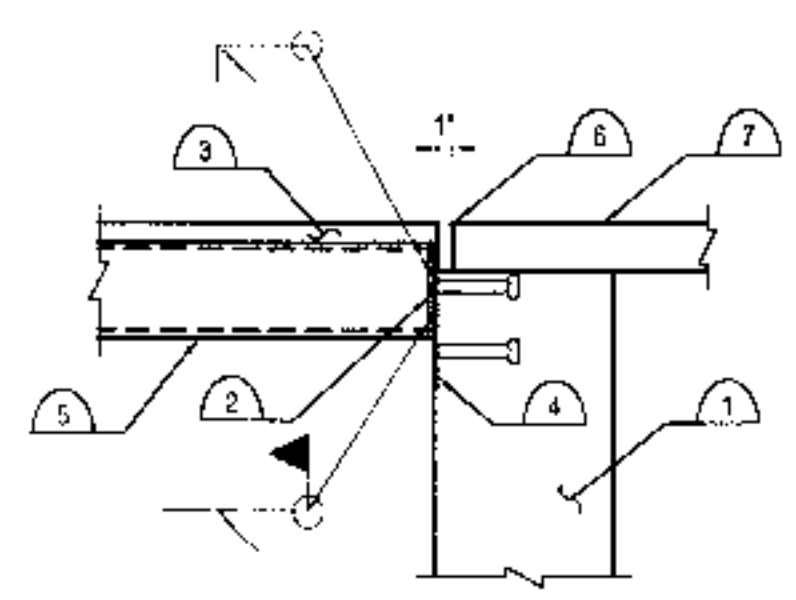


1. WING WALL.
2. 6 x 6 x 9/16 END PLATE.
3. GRATING PER PLAN.
4. PL. 1" x 9" x 13'-3" W/ (2) 3/4" DIA. H.A.S. AT 12" O.C. (SEE 855-03 DETAIL X FOR PLATE DETAILS).
5. BEAM PER PLAN.
6. JOINT, SEE ARCH.
7. 3" PAVER.

9 TYPICAL DETAIL FOR RIGID CONNECTION OF BEAMS TO WING WALL

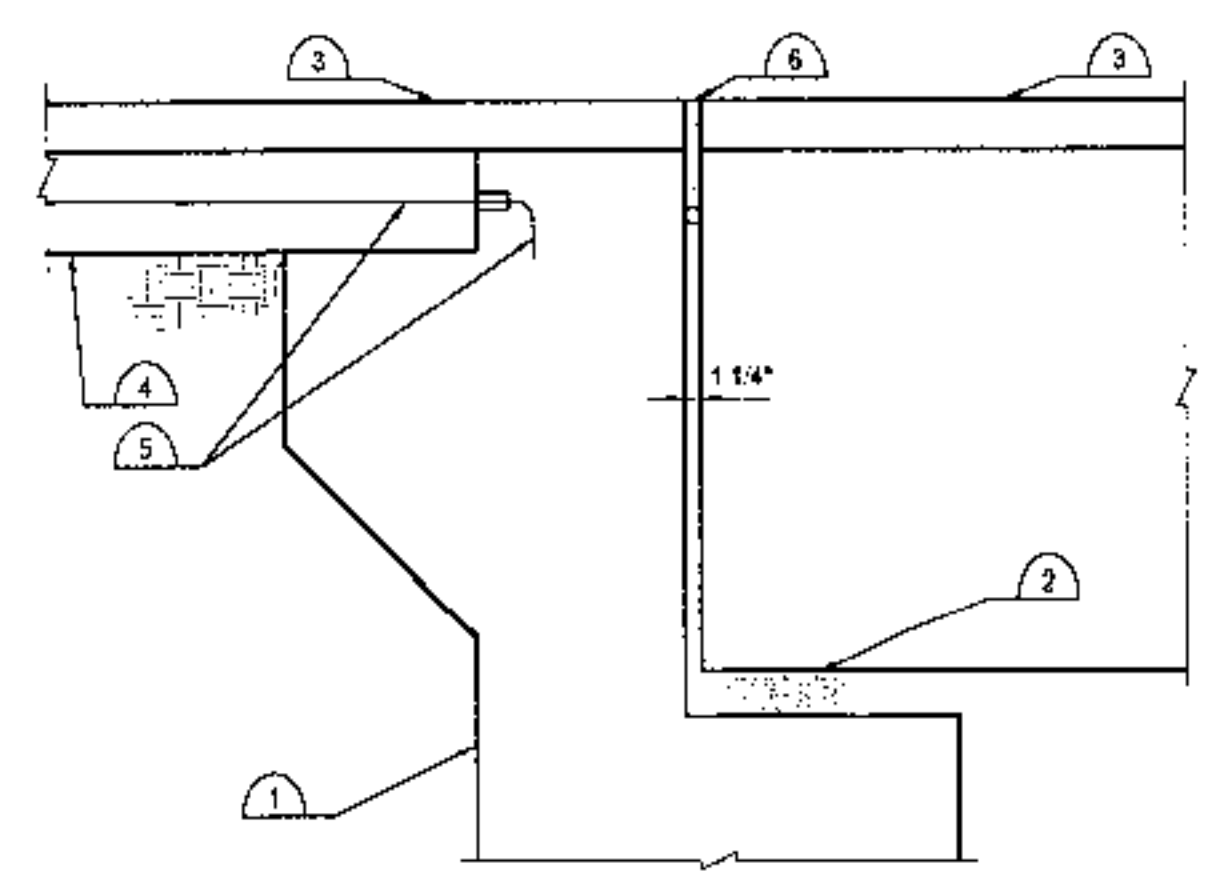


1. 2'-6" WIDE ABUTMENT.
2. BRIDGE GIRDER BEARING. VERIFLEX HLMR, FIXED PF-200 BEARING WITH 80 KIPS HORIZONTAL LOAD CAPACITY. SEE MANUFACTURER FOR CONNECTION DETAIL. (SEE 1255-03 FOR DETAILS).
3. 3" PAVERS. SEE ARCH.
4. 6" SLAB ON GRADE.
5. #4 @ 18" WITH FERRULE LOOP INSERTS.
6. 1 1/4" JOINT WITH BACKER ROD.

5 JOINT AT BRIDGE

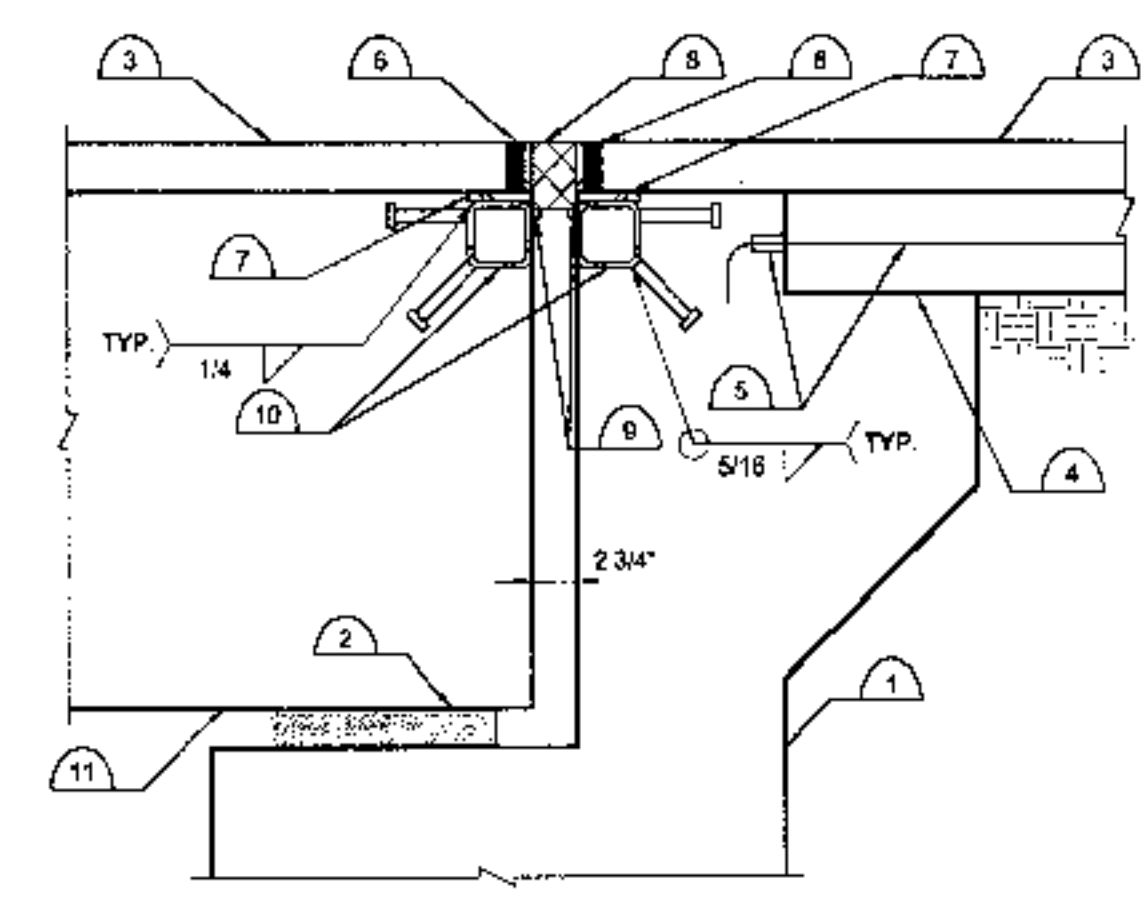


1. 3'-0" WIDE ABUTMENT.
2. BRIDGE GIRDER BEARING. VERIFLEX HLMR, UNI-DIRECTIONAL PMG-200 BEARING WITH 80 KIPS HORIZONTAL LOAD CAPACITY. SEE MANUFACTURER FOR CONNECTION DETAIL. (SEE 1255-03 FOR DETAILS).
3. 3" PAVERS. SEE ARCH.
4. 6" SLAB ON GRADE.
5. #4 @ 18" WITH FERRULE LOOP INSERTS.
6. JOINT, SEE ARCH.
7. 4" x 3 1/2" x 1 1/2" ANGLE.
8. PREFORATED ELASTOMERIC JOINT SEAL, OS BROWN AF-500 DELASTIC SEAL W/ 2.30" MAX. MOVEMENT, INSTALLED @ 2.34" OPENING. (SEE MANUFACTURER FOR INSTALLATION AND DETAILS).
9. 1/2" x 1/2" BARS.
10. T.S. 4" x 4" x 3/8" W/ (2) 3/4" DIA. H.A.S. ANCHORS @ 18" O.C.
11. BRIDGE GIRDER.

1 EXPANSION JOINT AT BRIDGE

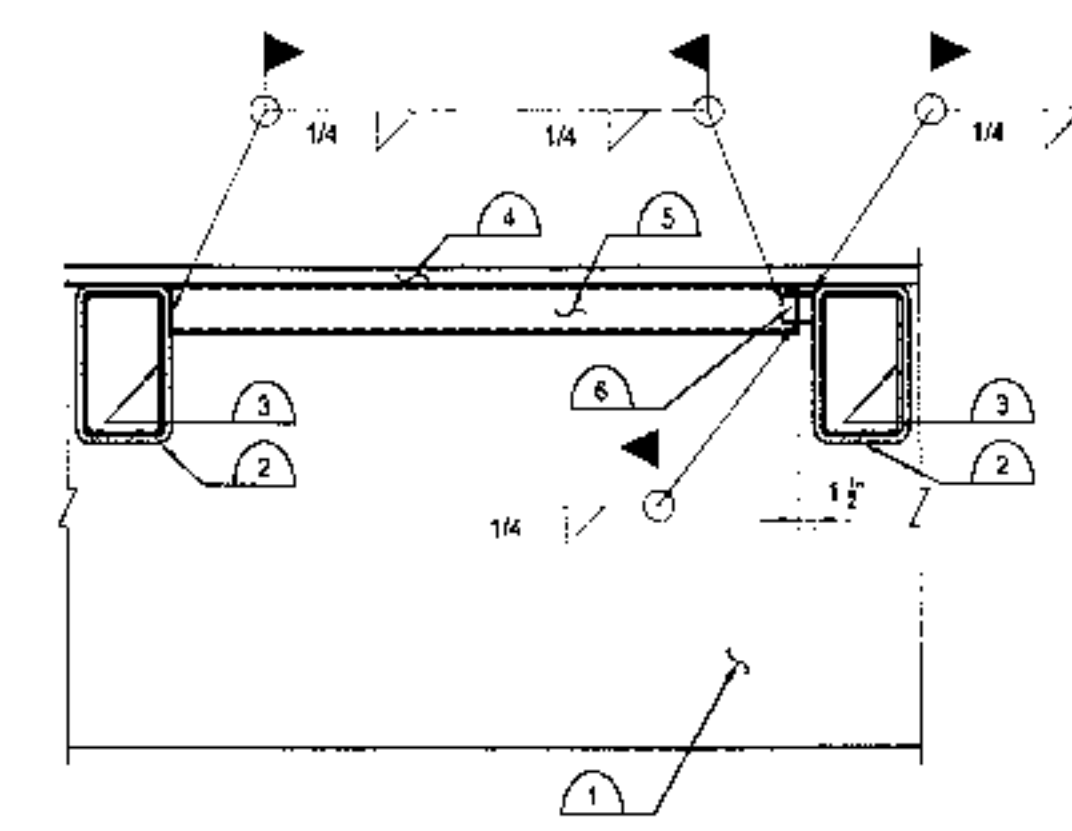


1. CONCRETE GIRDER.
2. BEAM PER PLAN.
3. TS 9" x 5" x 5/16" x 0'-3".
4. GRATING PER PLAN.
5. BEAM PER PLAN.
6. TS 3" x 3" x 1/4" x 0'-3".

10 STEEL FRAMING CONNECTION TO CONCRETE GIRDER

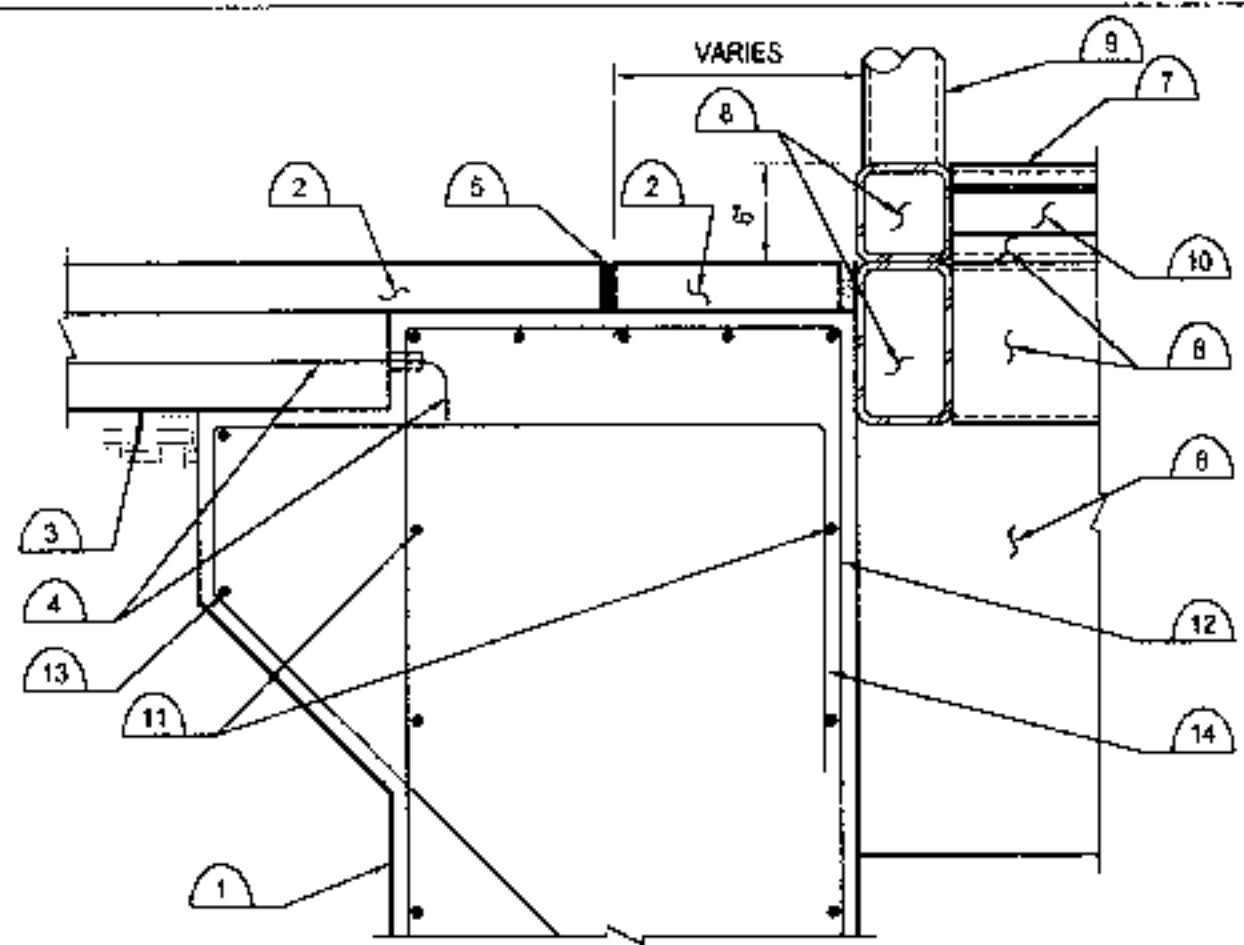


1. 2'-6" WIDE ABUTMENT.
2. 3" PAVERS. SEE ARCH.
3. 6" SLAB ON GRADE.
4. #4 @ 18" WITH FERRULE LOOP INSERTS.
5. 1 1/4" JOINT.
6. CONC. GIRDER (BEYOND).
7. GRATING. SEE GRATING PLAN, SHEET SS-01.
8. GRATING FRAMING. SEE GRATING PLAN, SHEET SS-01.
9. SHADE CANOPY COLUMN.
10. ANGLE - SEE DETAIL 2/55-02.
11. #6 @ 12" O.C.
12. #6 @ 12" O.C.
13. (2) #5.
14. #5 @ 12" O.C.

6 JOINT AT BRIDGE

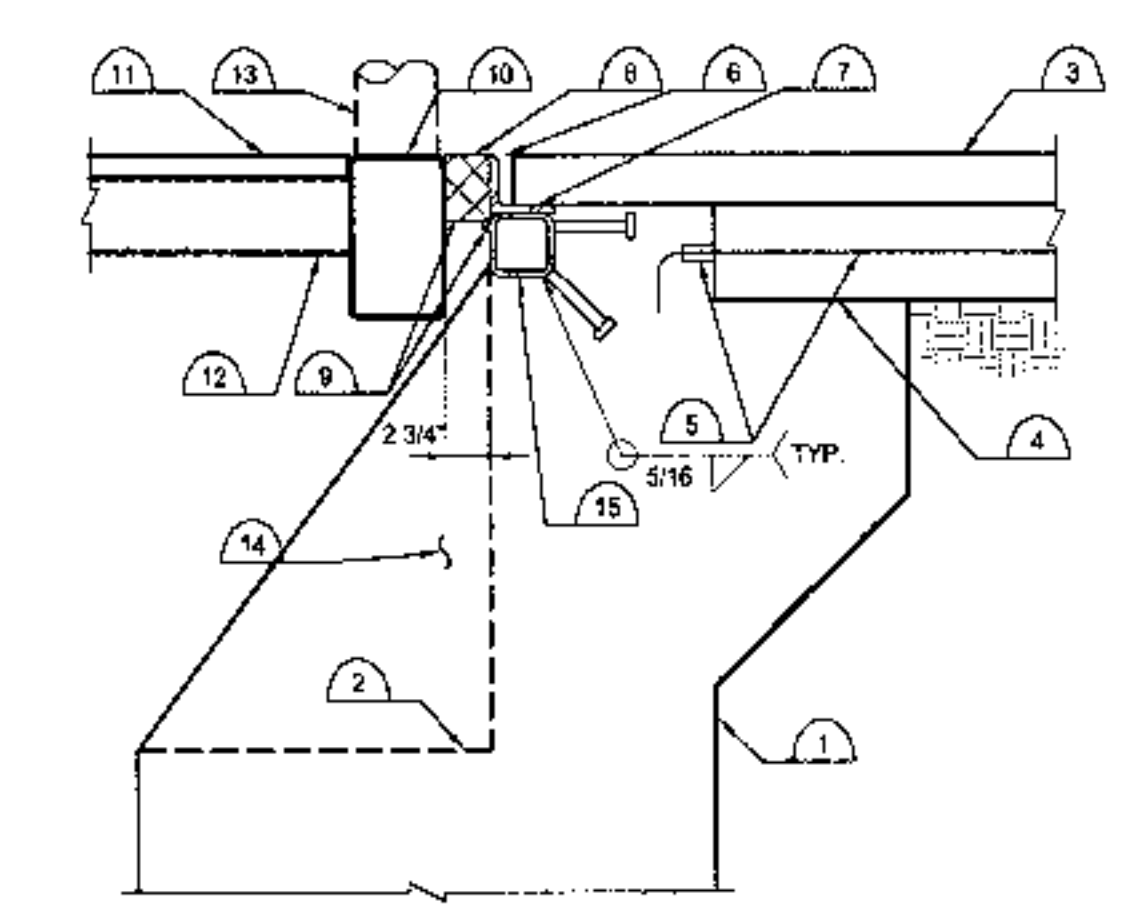


1. 3'-0" WIDE ABUTMENT.
2. BRIDGE GIRDER BEARING BEYOND.
3. 3" PAVERS. SEE ARCH.
4. 6" SLAB ON GRADE.
5. #4 @ 18" WITH FERRULE LOOP INSERTS.
6. JOINT, SEE ARCH.
7. 4" x 3 1/2" x 1 1/2" ANGLE.
8. PREFORATED ELASTOMERIC JOINT SEAL, (SEE 1553-03).
9. 1/2" x 1/2" BARS.
10. T.S. 10" x 6" x 1/4".
11. GRATING. SEE GRATING PLAN, SHEET SS 01.
12. GRATING FRAMING. SEE GRATING PLAN, SHEET SS-01.
13. SHADE CANOPY COLUMN BEYOND.
14. SEE DETAIL 3/55-03 FOR REINFORCEMENT.
15. T.S. 4" x 4" x 3/8" W/ (2) 3/4" DIA. H.A.S. ANCHORS @ 18" O.C.

2 EXPANSION JOINT AT GRATING

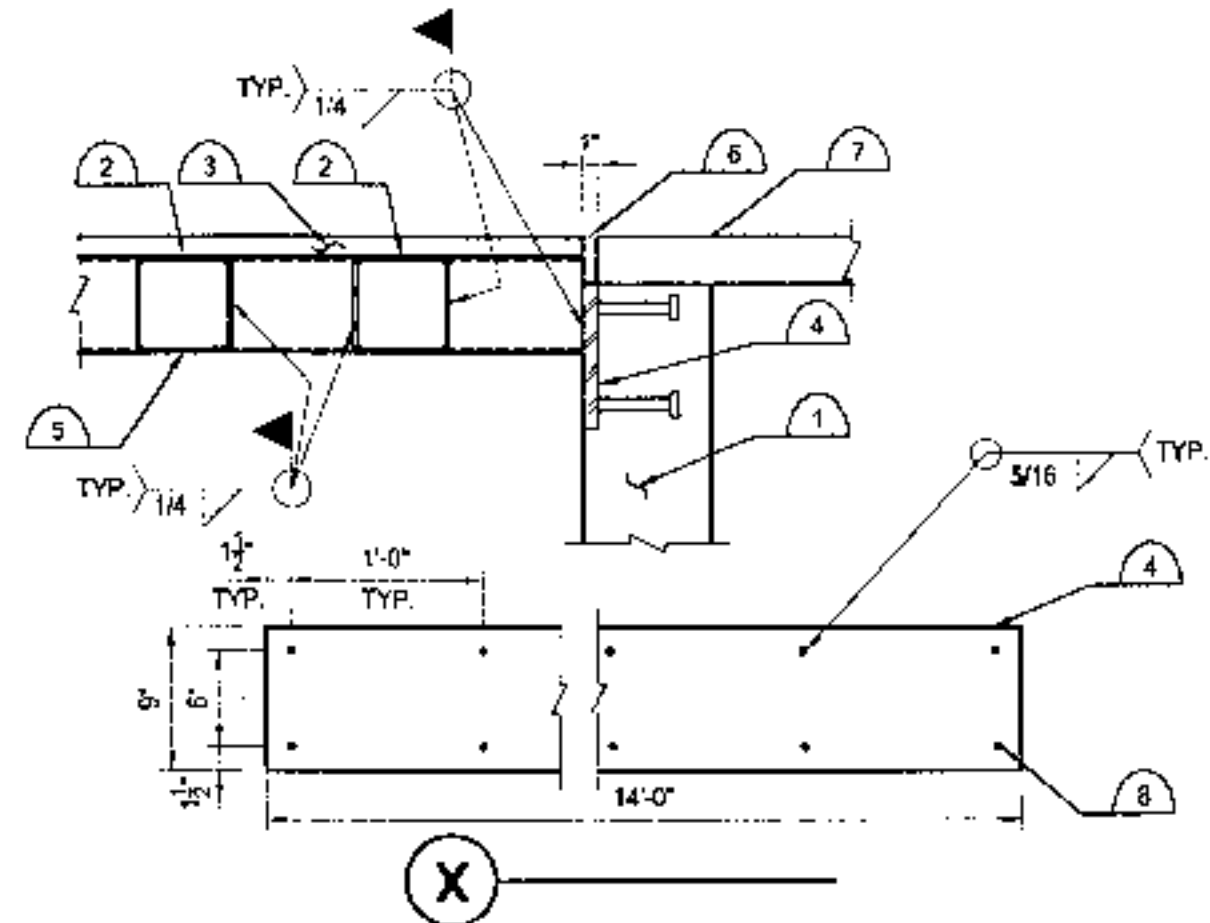


1. WING WALL.
2. BEAM PER PLAN.
3. GRATING PER PLAN.
4. 1" x 9" x 14'-0" PLATE CURVED W/ (2) 3/4" DIA. H.A.S. AT 12" O.C. SEE DETAIL X.
5. BEAM PER PLAN (BEYOND).
6. JOINT, SEE ARCH.
7. 3" PAVER.
8. (2) 3/4" DIA. x 6" H.A.S. AT 12" O.C.

11 GRATING BEARING AT WING WALL

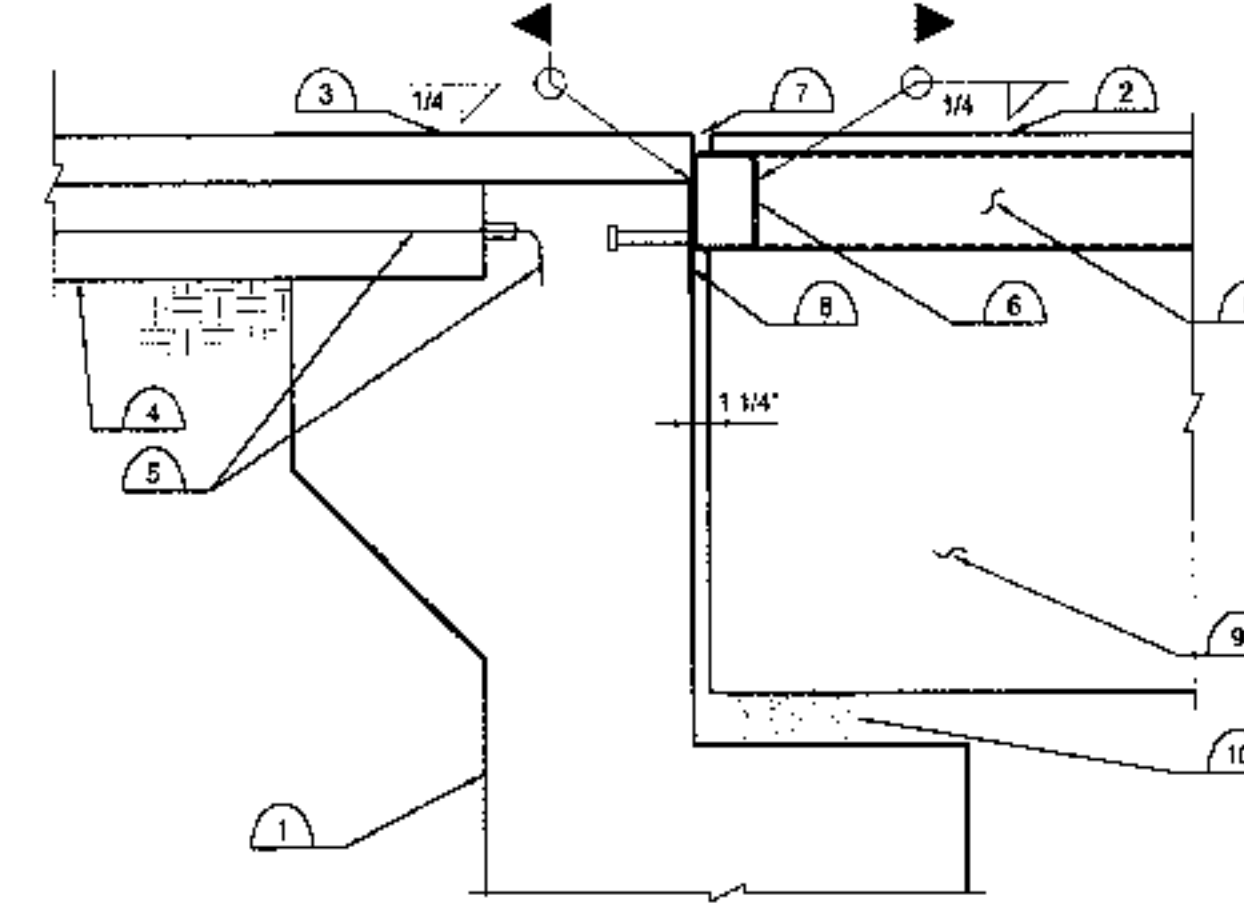

1. 2'-6" WIDE ABUTMENT.
2. GRATING.
3. 3" PAVERS. SEE ARCH.
4. 6" SLAB ON GRADE.
5. #4 @ 18" WITH FERRULE LOOP INSERTS.
6. BEAM PER PLAN.
7. 1 1/4" JOINT.
8. 1/4" x 7" x 3" PLATE @ 12" O.C. W/ (1) 3/4" DIA. H.A.S.
9. CONCRETE GIRDER BEYOND.
10. BRIDGE GIRDER BEARING. (SEE 5/95-03 FOR DETAILS).

7 JOINT AT GRATING

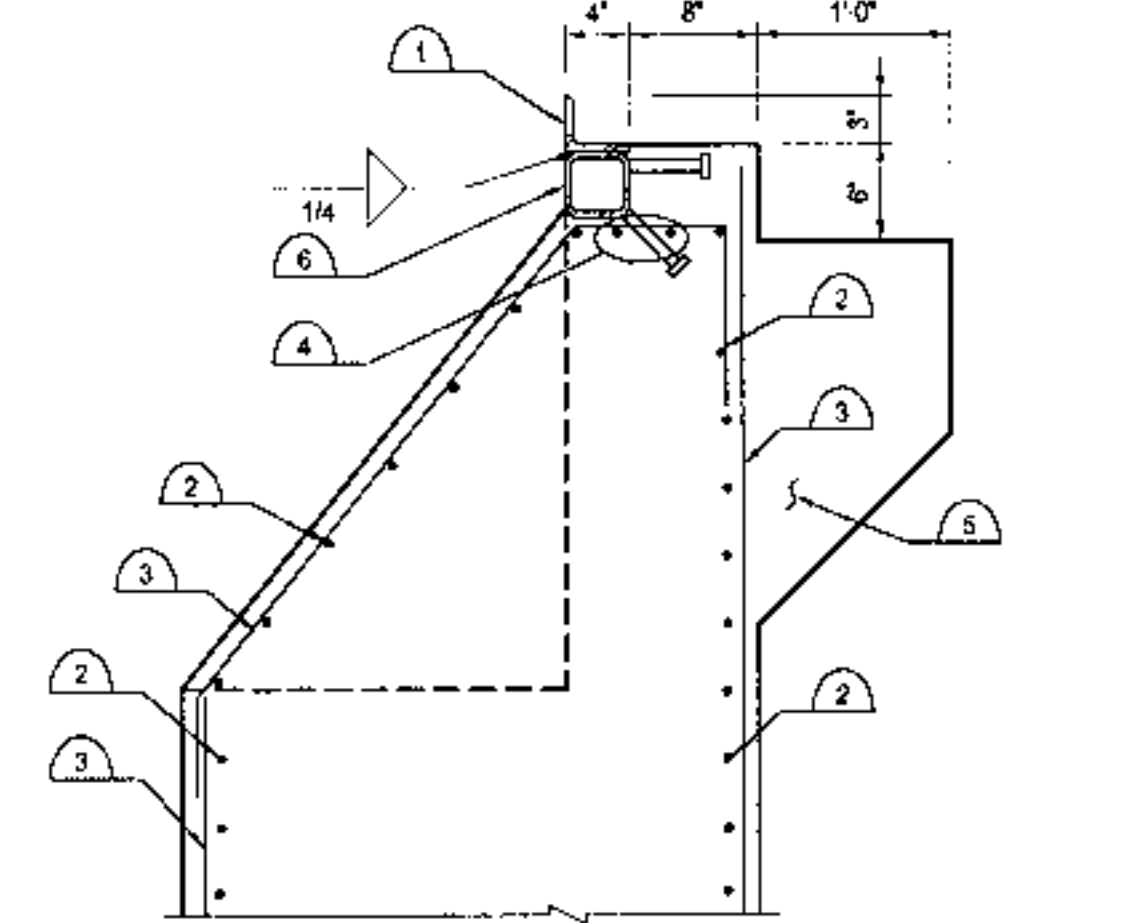

1. 4" x 3 1/2" x 1 1/2" ANGLE.
2. ABUTMENT NO. 1 HORIZONTAL REINFORCEMENT (SEE 3/53-02).
3. ABUTMENT NO. 1 VERTICAL REINFORCEMENT (SEE 3/53-02).
4. (2) #6.
5. FOR DETAIL SEE 3/53-02.
6. T.S. 4" x 4" x 3/8" W/ (2) 3/4" DIA. H.A.S. ANCHORS @ 18" O.C.

3 REINFORCEMENT DETAIL FOR ABUTMENT NO. 1 UNDER GRATING AREAS


FIXED TYPE (PF200)

MODEL NUMBER	DIMENSIONS (IN.)					
	A	B	C	D	E	F
PF200	11.50	11.50	1.00	11.38	2.15	3.68

UNI-DIRECTIONAL TYPE (PMG200)


MODEL NUMBER	DIMENSIONS (IN.)					
	A	B	C	D	E	F
PMG200	5.50	15.25	1.00	10.36	2.22	4.13

12 BRIDGE GIRDER BEARING FIXED TYPE (TOP) AND UNI-DIRECTIONAL TYPE (BOT.)

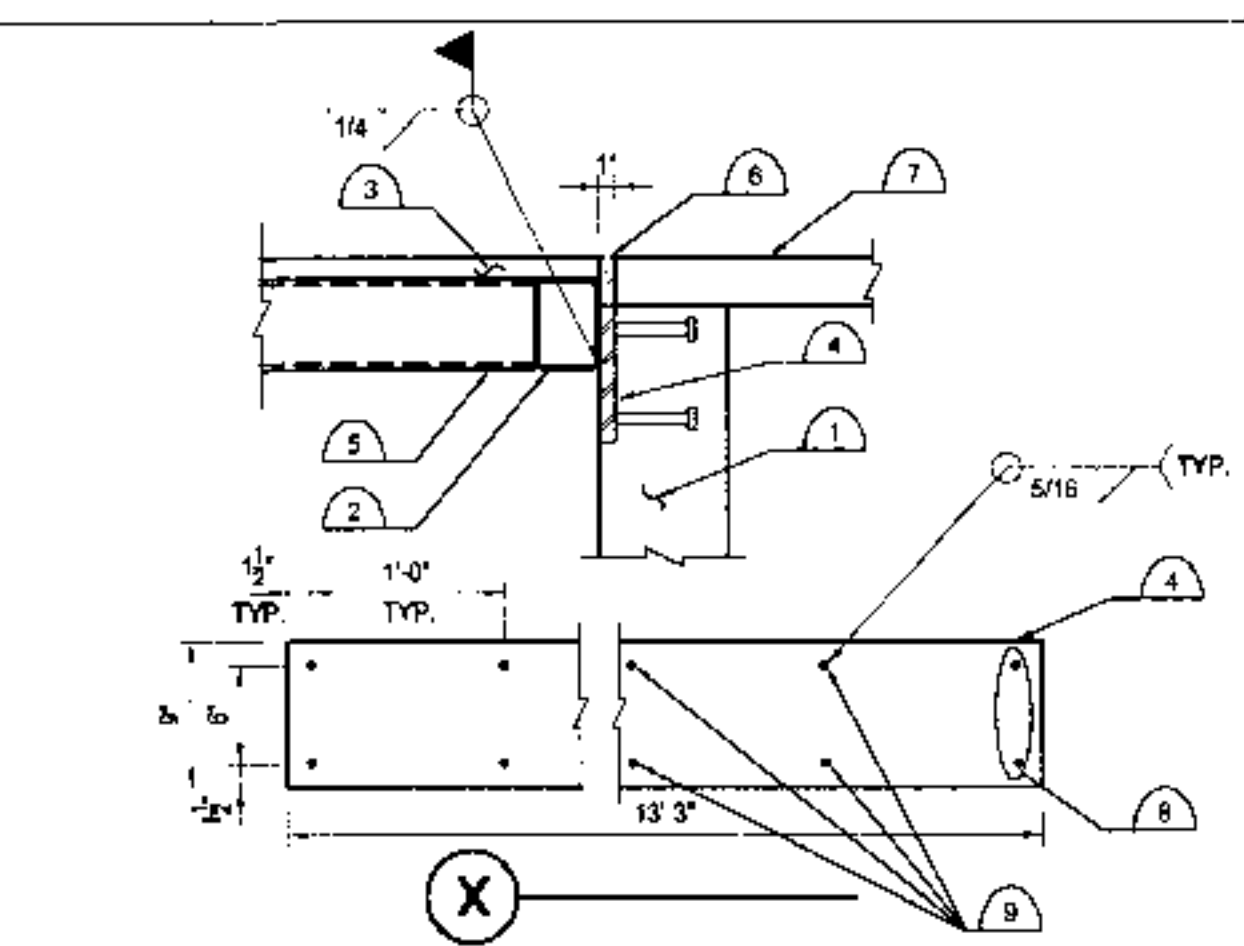

1. WING WALL.
2. BEAM PER PLAN.
3. GRATING PER PLAN.
4. PL. 1" x 9" x 13'-3" W/ (2) 3/4" DIA. H.A.S. AT 12" O.C., SEE DETAIL X.
5. BEAM PER PLAN (BEYOND).
6. JOINT, SEE ARCH.
7. 3" PAVER.
8. (2) 3/4" DIA. x 12" H.A.S.
9. 3/4" DIA. x 6" H.A.S.

8 GRATING BEARING AT WING WALL

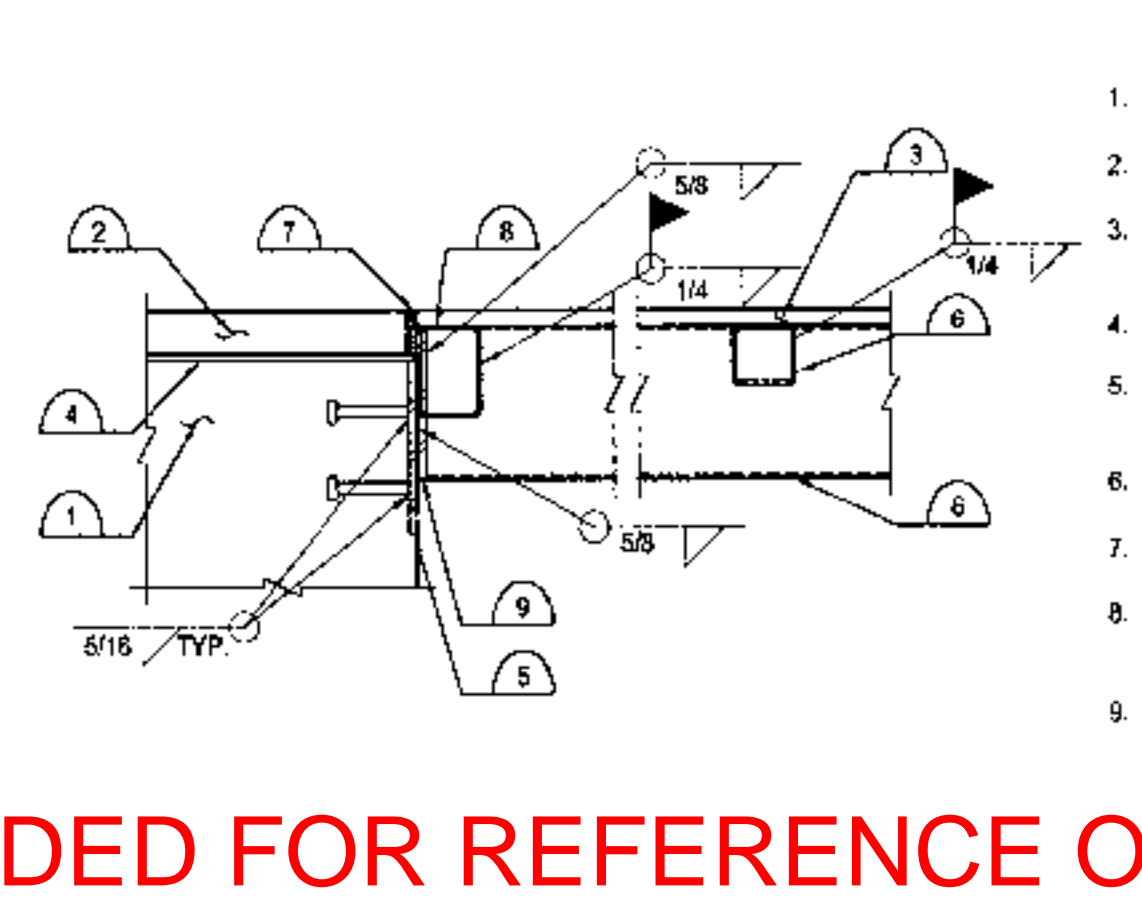

1. PRESTRESSED GIRDER.
- 3" PAVERS.
- 1 1/4" x 3/16" CLOSE MESH ALUMINUM GRATING (4'-0" MAX. SPAN).
- CARBON FIBER LAYER.
- 12" x 9" x 9" EMBEDDED PLATE W/ (4) 3/4" DIA. H.A.S. @ 8" O.C.
- GRATING FRAMING. SEE PLAN.
- JOINT, SEE ARCH.
- TS 6" x 4" x 1/4" (FOR CONNECTION TO CONCRETE GIRDER SEE 12/55-03).
- 10 x 6 x 5/8 END PLATE.

4 GRATING BEARING TYPICAL, CONNECTION OF GRATING FRAMING BEAM TO CONCRETE GIRDER

DESIGNWORKSHOP
 Landscape Architecture • Land Planning
 Urban Design • Tourism Planning
 Asheville • Aspen • Denver • Jackson Hole
 Park City • Santa Fe • Tempe • Lake Tahoe • Vail
 310 S. Mill Avenue, Suite 201
 Tempe, Arizona 85281
 (480) 966-5881
 Facsimile (480) 966-2799
 WWW.DESIGNWORKSHOP.COM
 OWNER
 CITY OF SCOTTSDALE
 7447 E. INDIAN SCHOOL RD. SCOTTSDALE, AZ 85251
 480-312-7669

**Arizona Canal
 at Scottsdale - Phase I
 Scottsdale, Arizona**



**BID DOCUMENTS
 PHASE ONE**

**GRATING
 DETAILS**

ISSUED FOR: BID DOCUMENTS
 ISSUE DATE: OCTOBER 10, 2003
 REVISIONS

#	DATE	DESCRIPTION

DRAWN: GAALIG REVIEWED: MSPJAZ
 PROJECT NUMBER: 2829
 © COPYRIGHT © DESIGNWORKSHOP, INC.

PROVISON BY

**MUNICIPAL SERVICES
 DEPARTMENT
 CAPITAL PROJECT
 MANAGEMENT**
 3839 DRINKWATER BLVD.
 SCOTTSDALE, ARIZONA 85251
 PROJECT TITLE
ARIZONA CANAL AT SCOTTSDALE-PHASE I
 DESIGNED BY: MSPJAZ DATE: 10-10-03 BD NO: #04PB034 SH: SS-03
 DRAWN BY: GAALIG AS: 0900 PROJECT NO: 2829 84 OF 89

DRAWINGS ADDED FOR REFERENCE ONLY. **kpff Consulting Engineers**
 2800 NORTH CENTRAL AVENUE, SUITE 1010
 PHOENIX, ARIZONA 85004
 PHONE (602) 264-1010 KPFF PROJECT #: 110149.1
 FAX (602) 265-1010

**Arizona Canal
at Scottsdale - Phase I**
Scottsdale, Arizona



STAMP / DATE

BID DOCUMENTS
PHASE ONE

**GRATING
DETAILS**

ISSUED FOR: BID DOCUMENTS

ISSUE DATE: OCTOBER 10, 2003

REVISIONS
DATE DESCRIPTION

DRAWN: GAAJG REVIEWED: MSPAZ


PROJECT NUMBER: 2829

© COPYRIGHT DESIGNWORKSHOP, INC.





DESIGNED BY	DATE	RD NO.	SHT.
MSPAZ	10-10-03	#04PB034	SH. S5-04
DRAWN BY	AS-BUILT	PROJECT	NO.
GAAJG	0000	2829	85 OF 89


kpfll Consulting Engineers
2800 NORTH CENTRAL AVENUE, SUITE 1010
PHOENIX, ARIZONA 85004
PHONE (602) 264-1010 KPFF PROJECT #
FAX (602) 285-1010 110149.1

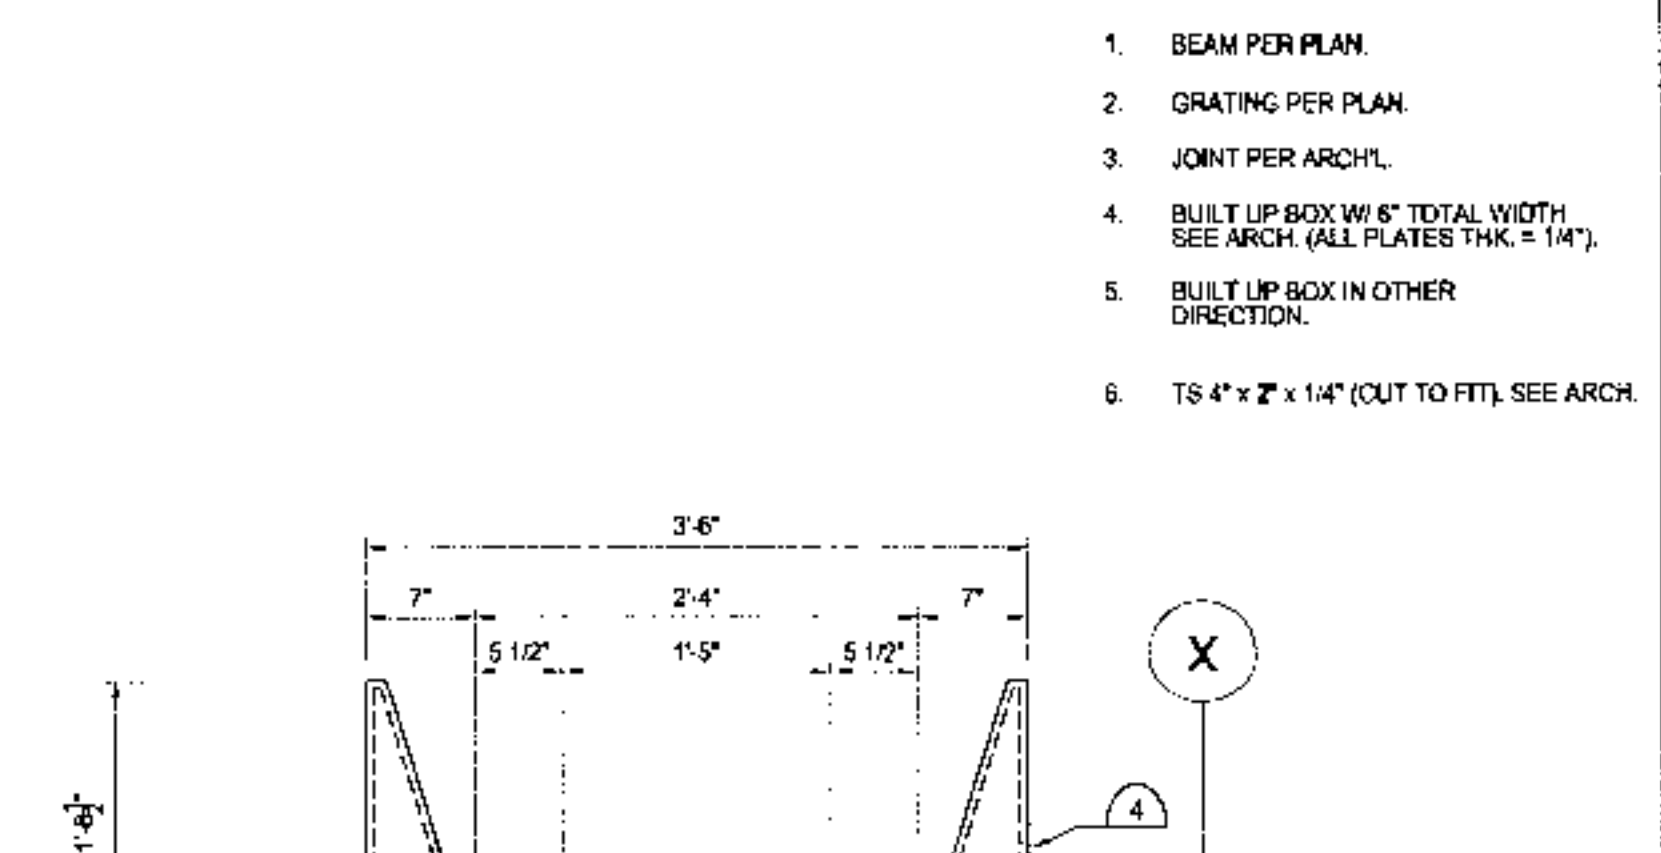

1. BEAM PER PLAN (SEE GRATING PLAN, SHEETS S5-05).
2. GRATING PER PLAN.
3. JOINT PER ARCH.
4. BUILT UP BOX W/ 6" TOTAL WIDTH (SEE ARCH. (ALL PLATES THK. = 1/4").
5. BUILT UP BOX IN OTHER DIRECTION.
6. TS 4" x 2" x 1/4" (OUT TO FIT). SEE ARCH.

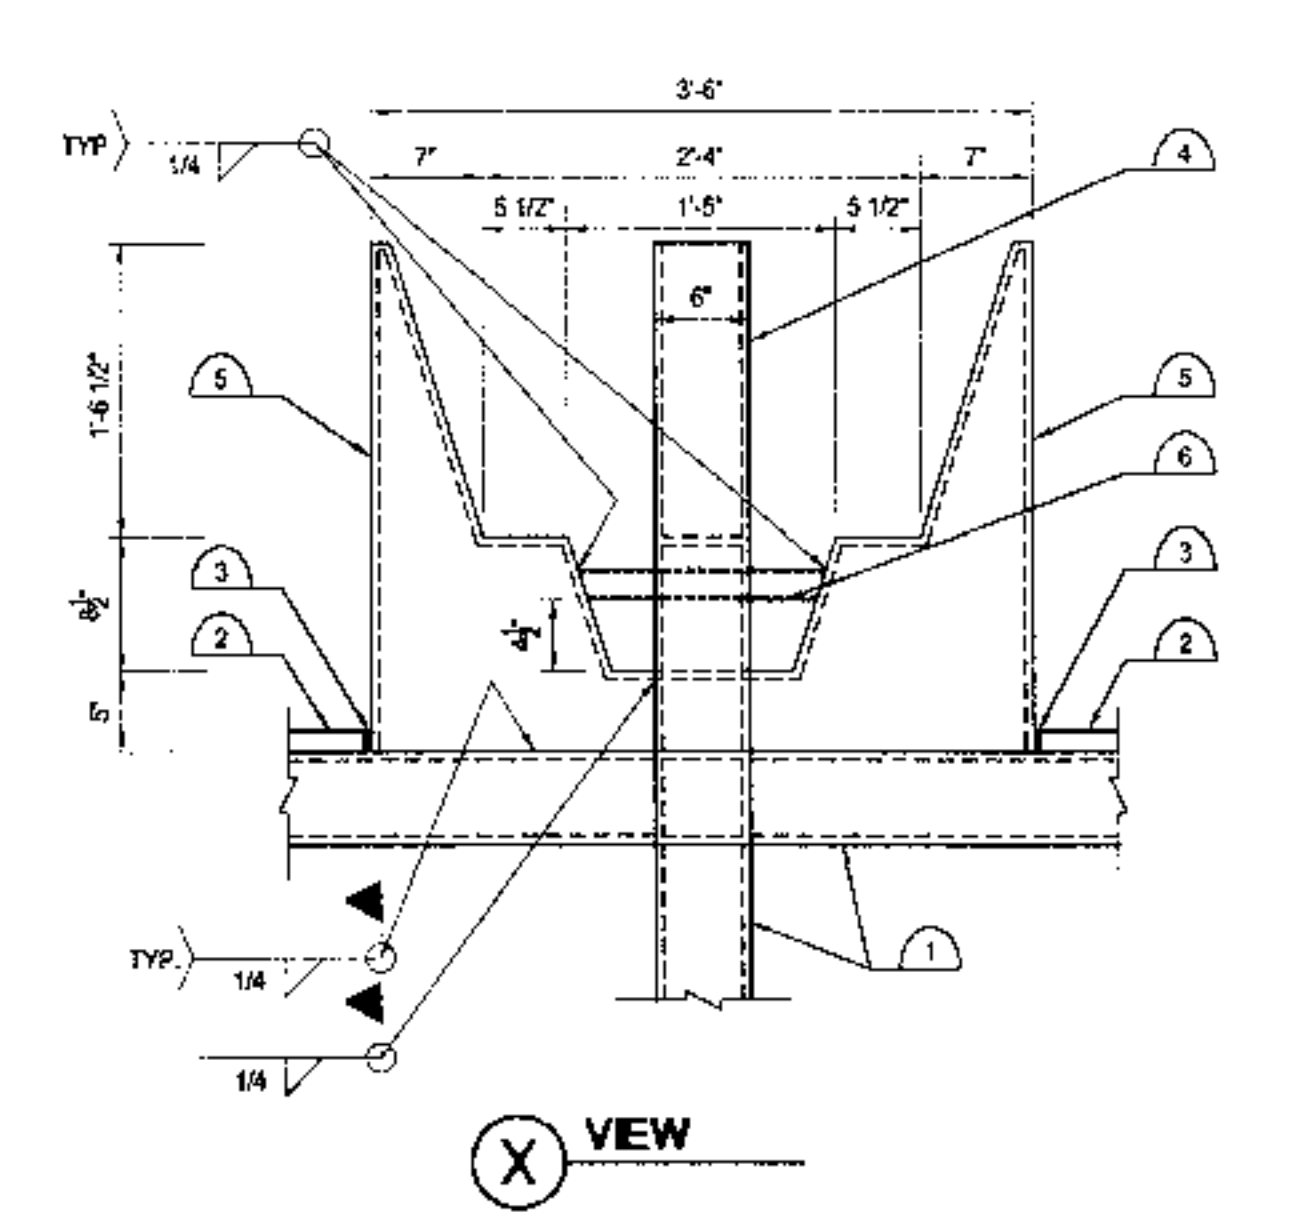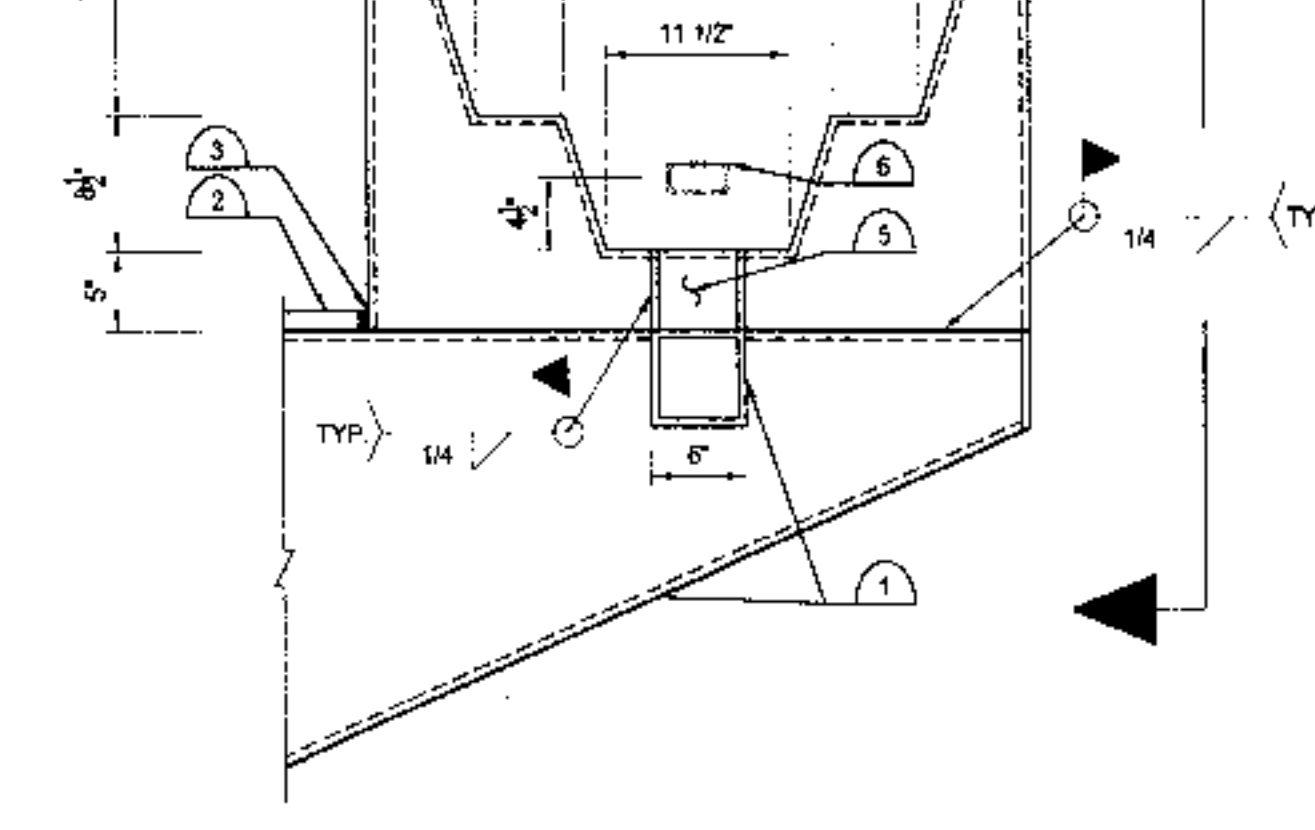


3 PLANTER DETAIL

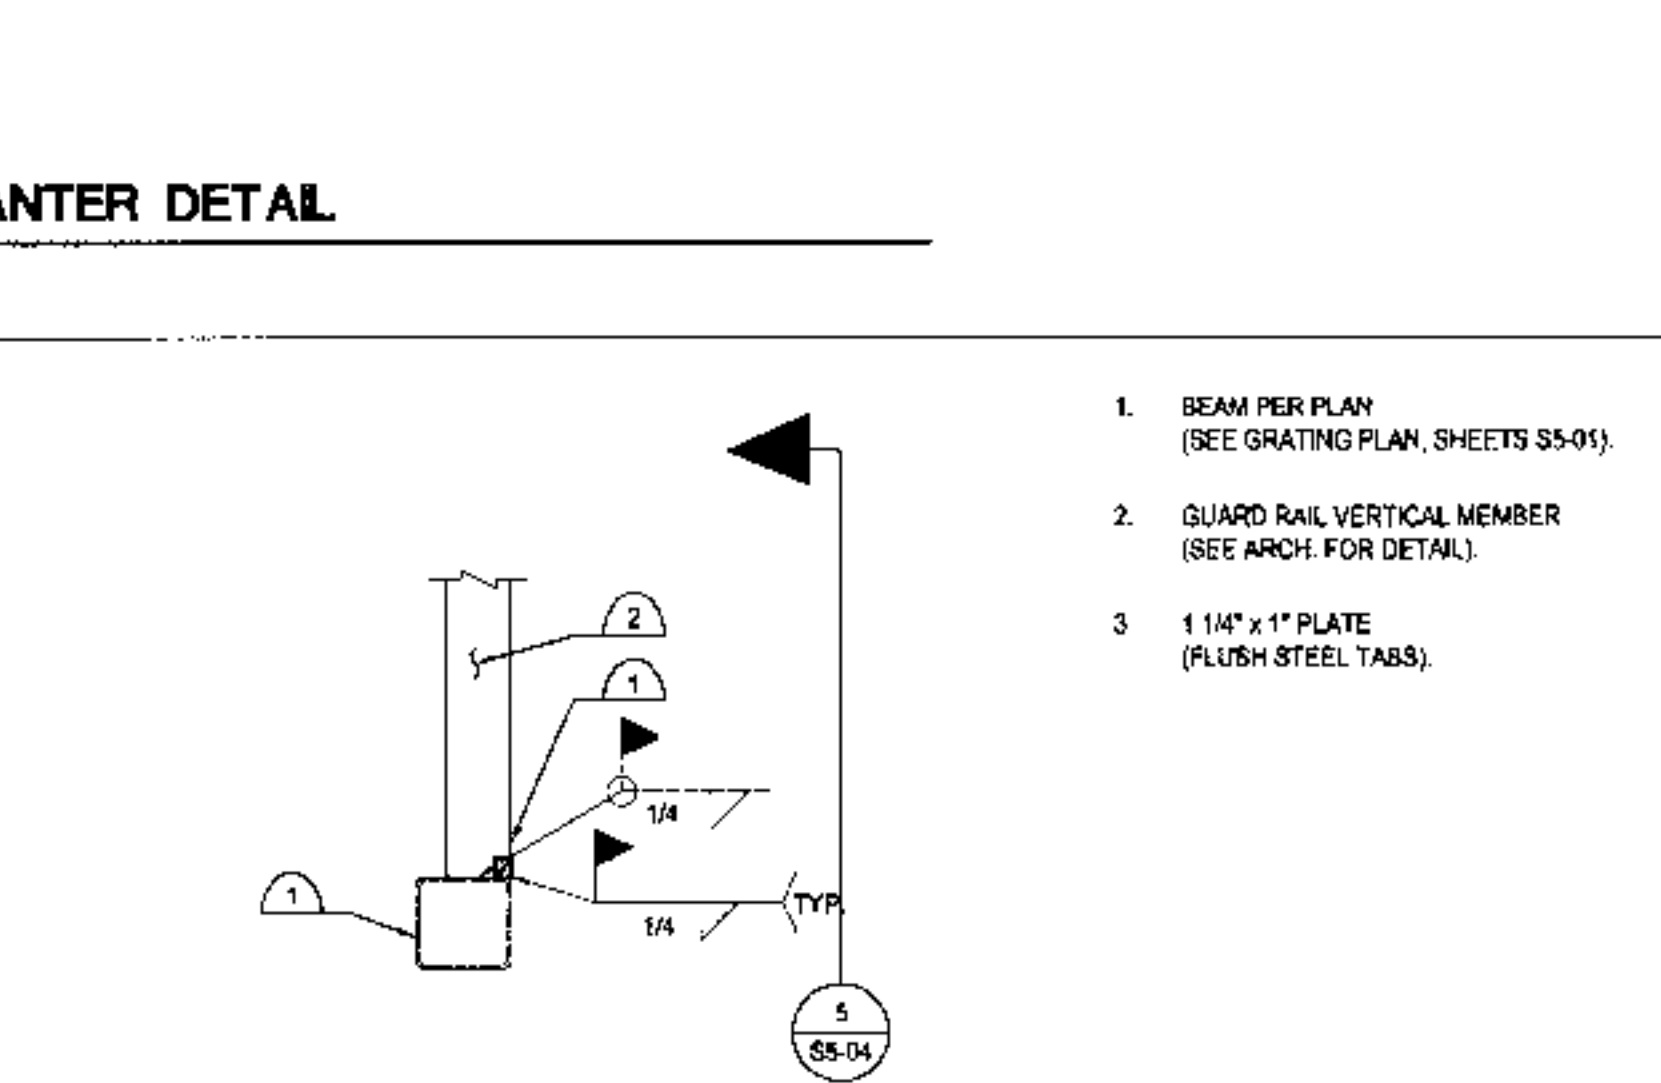


1. BEAM PER PLAN (SEE GRATING PLAN, SHEETS S5-05).
2. GUARD RAIL VERTICAL MEMBER (SEE ARCH FOR DETAIL).
3. 1 1/4" x 1" PLATE (FLUSH STEEL TABS).

4 GUARD RAIL CONNECTION TO LONGITUDINAL BEAM ALONG EACH SIDE OF BRIDGE

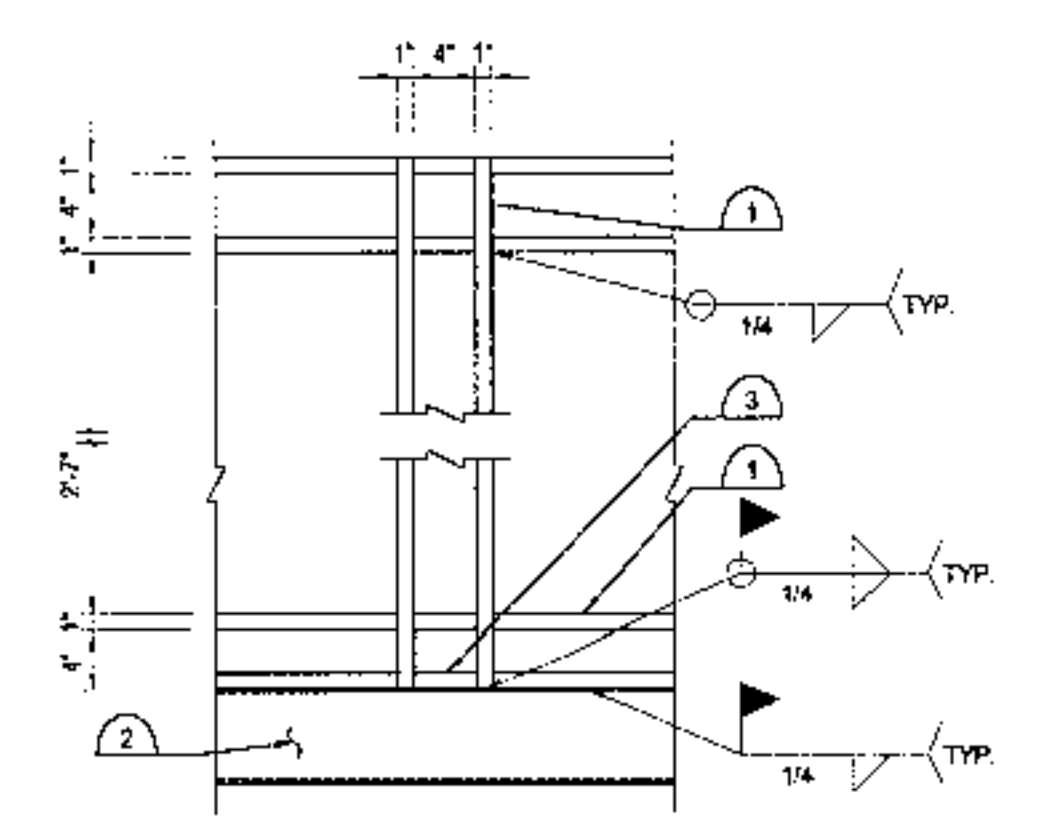


1. GUARDRAIL MEMBERS, SEE ARCH (4" x 1" PLATE, TYP.).
2. BEAM PER PLAN.
3. 1 1/4" x 1" PLATE (FLUSH STEEL TABS).

5 GUARD RAIL CONNECTION TO LONGITUDINAL BEAM ALONG EACH SIDE OF BRIDGE

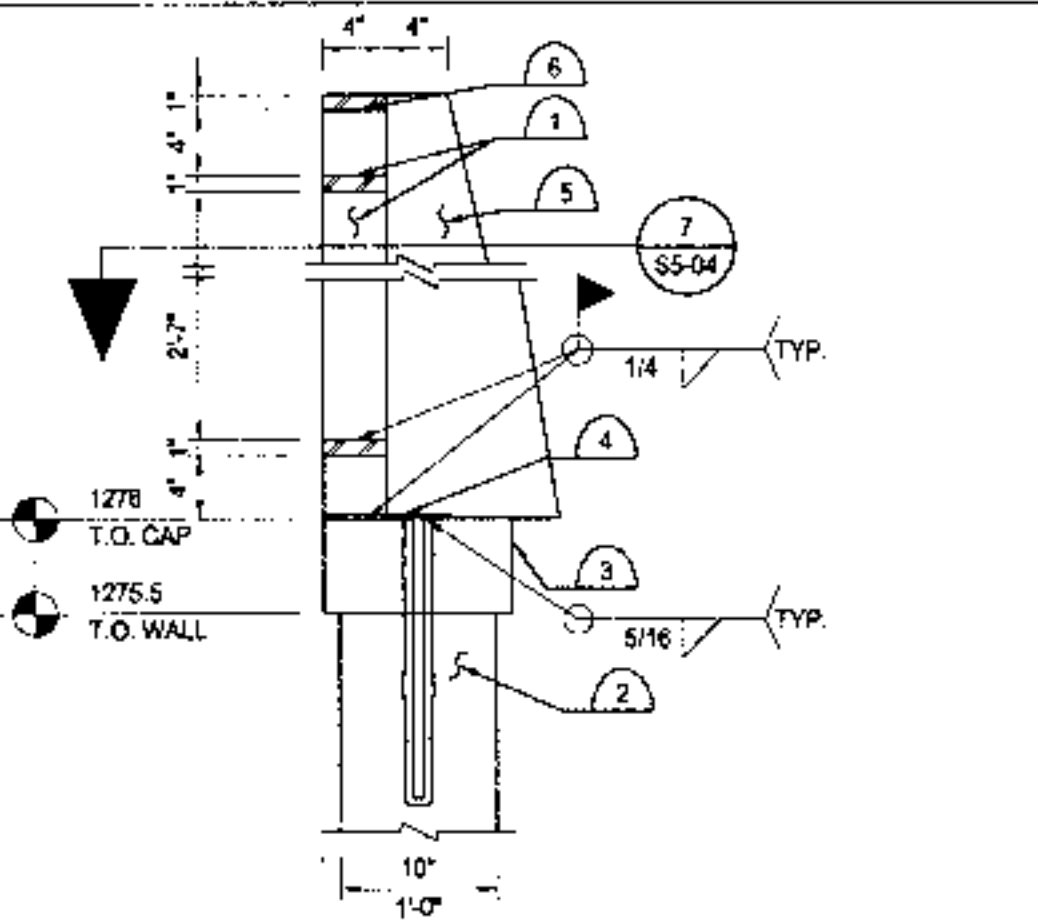


1. GUARDRAIL MEMBERS, SEE ARCH (4" x 1" PLATE, TYP.).
2. EXISTING CANAL WALL.
3. 12" x 6" x 8" CONC. CAP.
4. 8" x 6" x 1/4" PLATE W/ (2) 3/4" Ø x 12" THREADED RODS, DRILLED AND EPOXIED.
5. GUARD RAIL SUPPORT BEYOND (FOR DETAILS SEE 093004)
6. FOR ALLUM. PERFORATED PANEL CONNECTION SEE 10SS-04.

6 GUARD RAIL CONNECTION TO EXISTING CANAL WALL

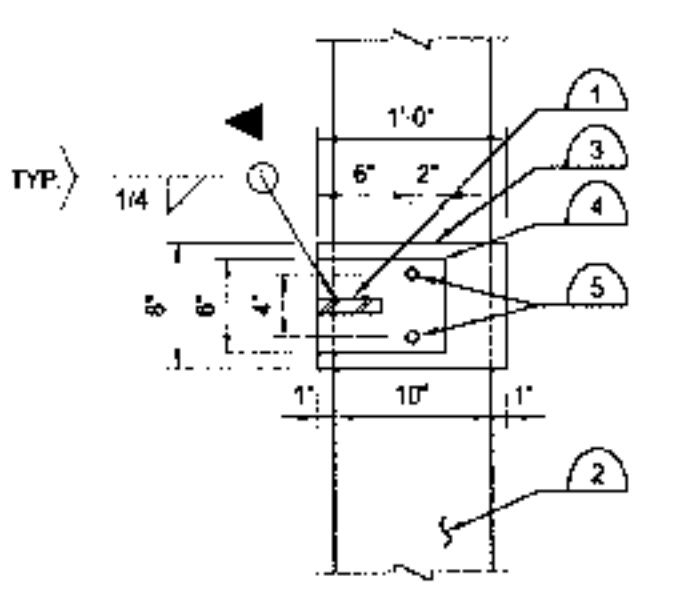


1. GUARDRAIL MEMBERS, SEE ARCH (4" x 1" PLATE, TYP.).
2. EXISTING CANAL WALL.
3. 12" x 6" x 8" CONC. CAP.
4. 8" x 6" x 1/4" PLATE.
5. (2) 3/4" Ø x 18" THREADED RODS, DRILLED AND EPOXIED.

7 GUARD RAIL CONNECTION TO EXISTING CANAL WALL

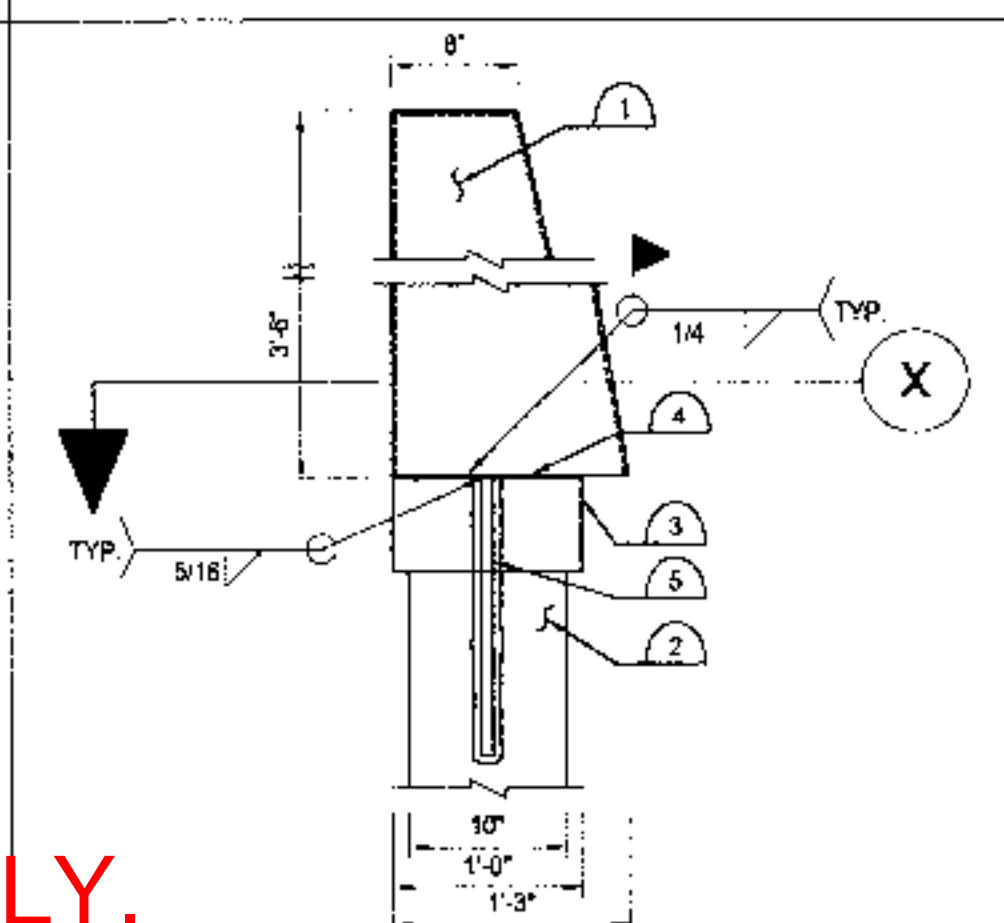


1. BUILT UP BOX W/ 4" TOTAL WIDTH (SEE ARCH. FOR DETAILS AND LOCATIONS) (ALL PLATES THK. = 1/4").
2. EXISTING CANAL WALL.
3. 12" x 6" x 11" CONC. CAP.
4. 12" x 6" x 1/4" PLATE.
5. (2) 3/4" Ø x 18" THREADED RODS, DRILLED AND EPOXIED.

8 GUARD RAIL SUPPORT DETAIL AND CONNECTION TO EXISTING CANAL WALL

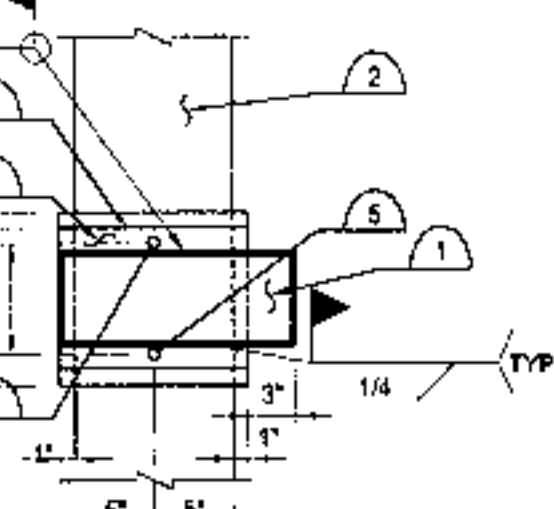


X DETAIL

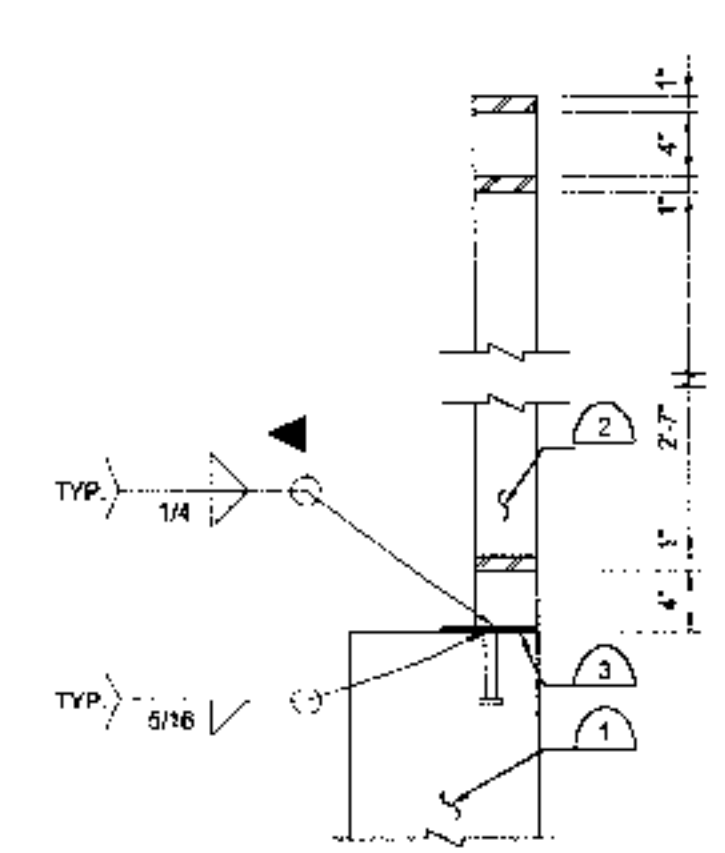

1. WING WALL OR RETAINING WALL (SEE ARCH.).
2. GUARDRAIL MEMBERS, SEE ARCH. FOR LOCATION.
3. 6" x 6" x 1/4" PLATE W/ (2) 3/4" Ø H.A.S. @ 4" O.C.

9 GUARD RAIL AT TOP OF WING WALL OR RETAINING WALL

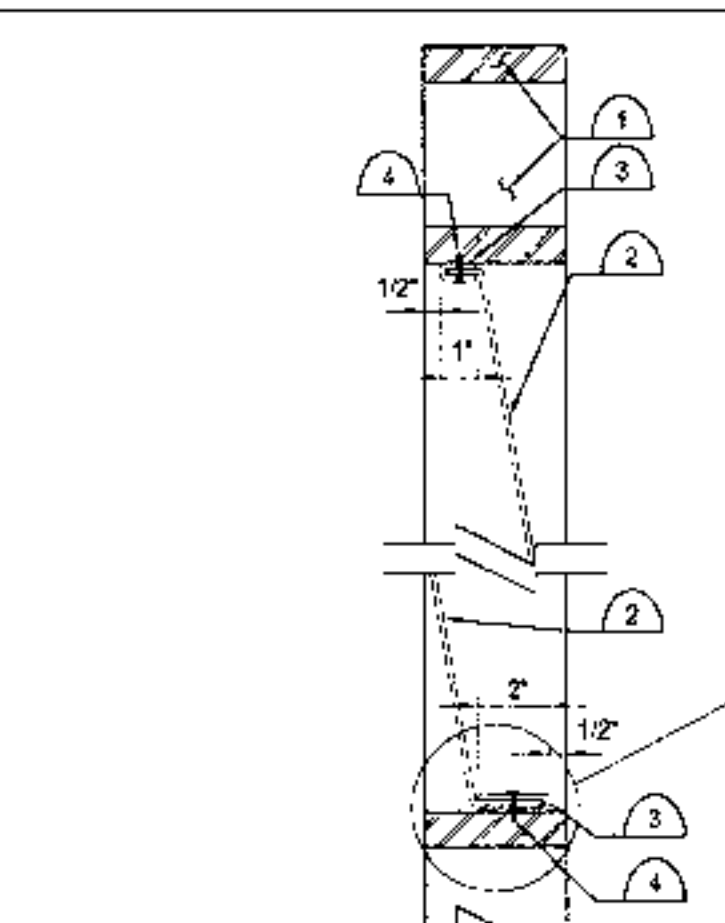

1. GUARDRAIL MEMBERS.
2. PERFORATED ALUM. PANEL (SEE ARCH.).
3. BENT ALUM. SHAPE (SAME GAUGE AS PER ALUM. PANEL).
4. #12 TEK'S/S SELF-DRILLING BULDEX FASTENERS @ 8" O.C.


X SECTION

10 TYP. CONNECTION OF ALUM. PERFORATED PANELS TO GUARD RAIL

DRAWINGS ADDED FOR REFERENCE ONLY.

KEY NOTES:


1. COLUMN PER PLAN.
2. BEAM PER PLAN.
3. SEE GRATING PLAN S5-01 FOR DETAILS.
4. CONCRETE GIRDER.

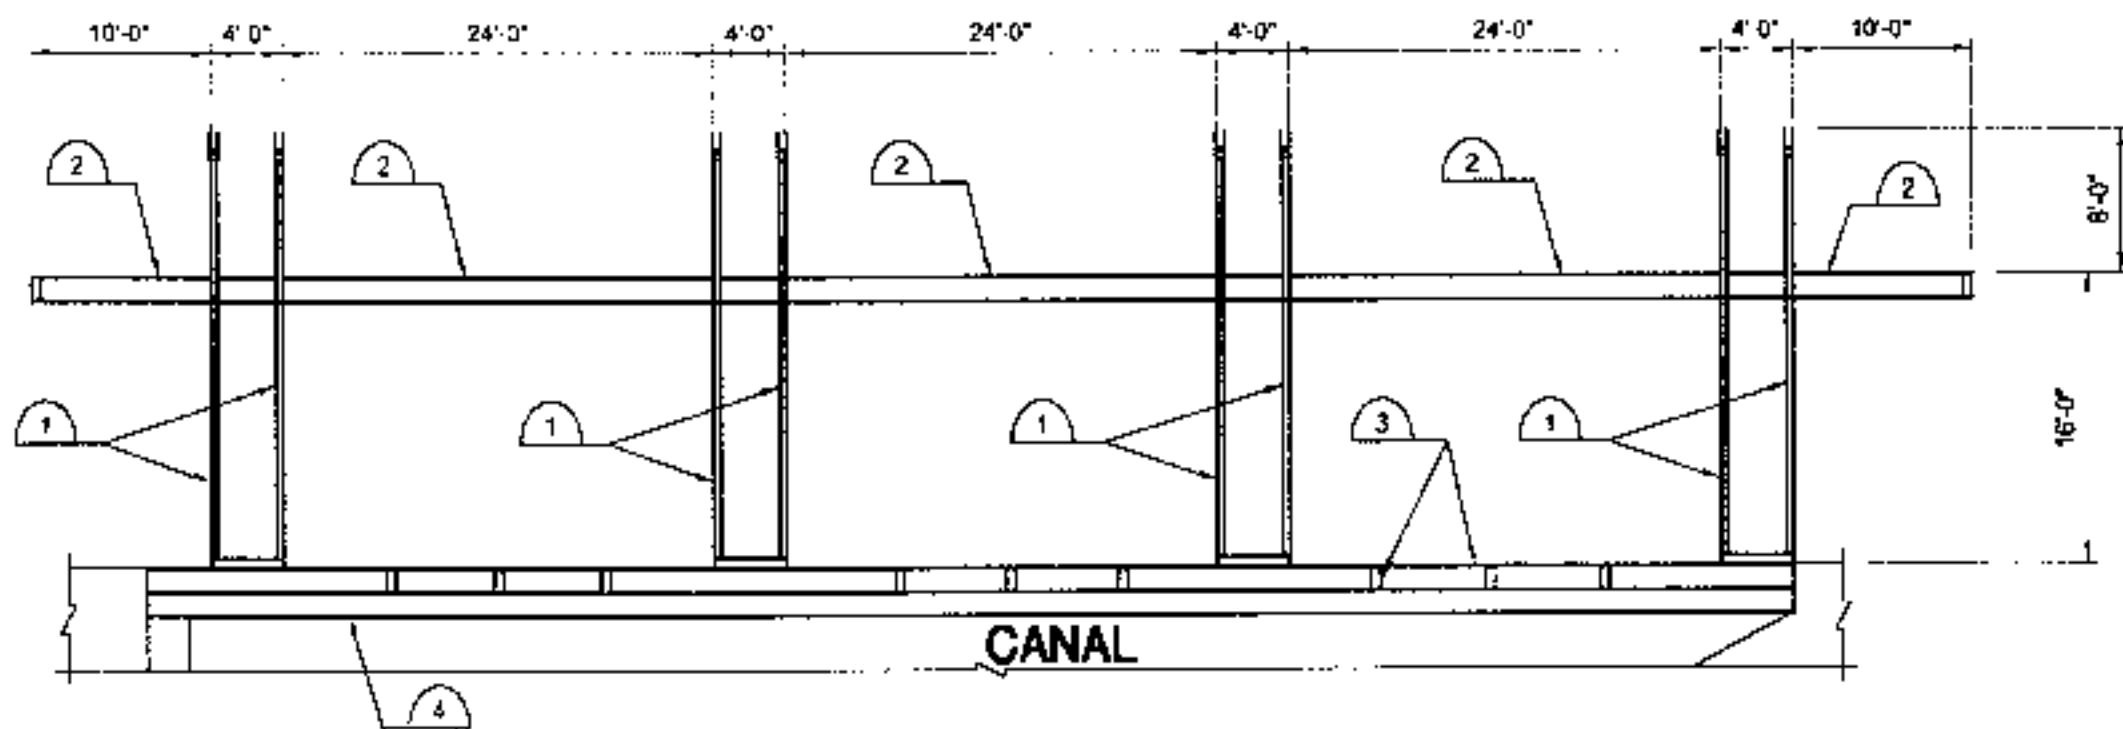

1 LONGITUDINAL SECTION

KEY NOTES:


1. WIRE ROPE (SEE 3 & S5-06 FOR TYPE).
2. COLUMN PER PLAN.
3. BEAM PER PLAN.
4. CONCRETE GIRDERS (SEE S4-01 FOR DETAILS).
5. ABUTMENT NO. 2.

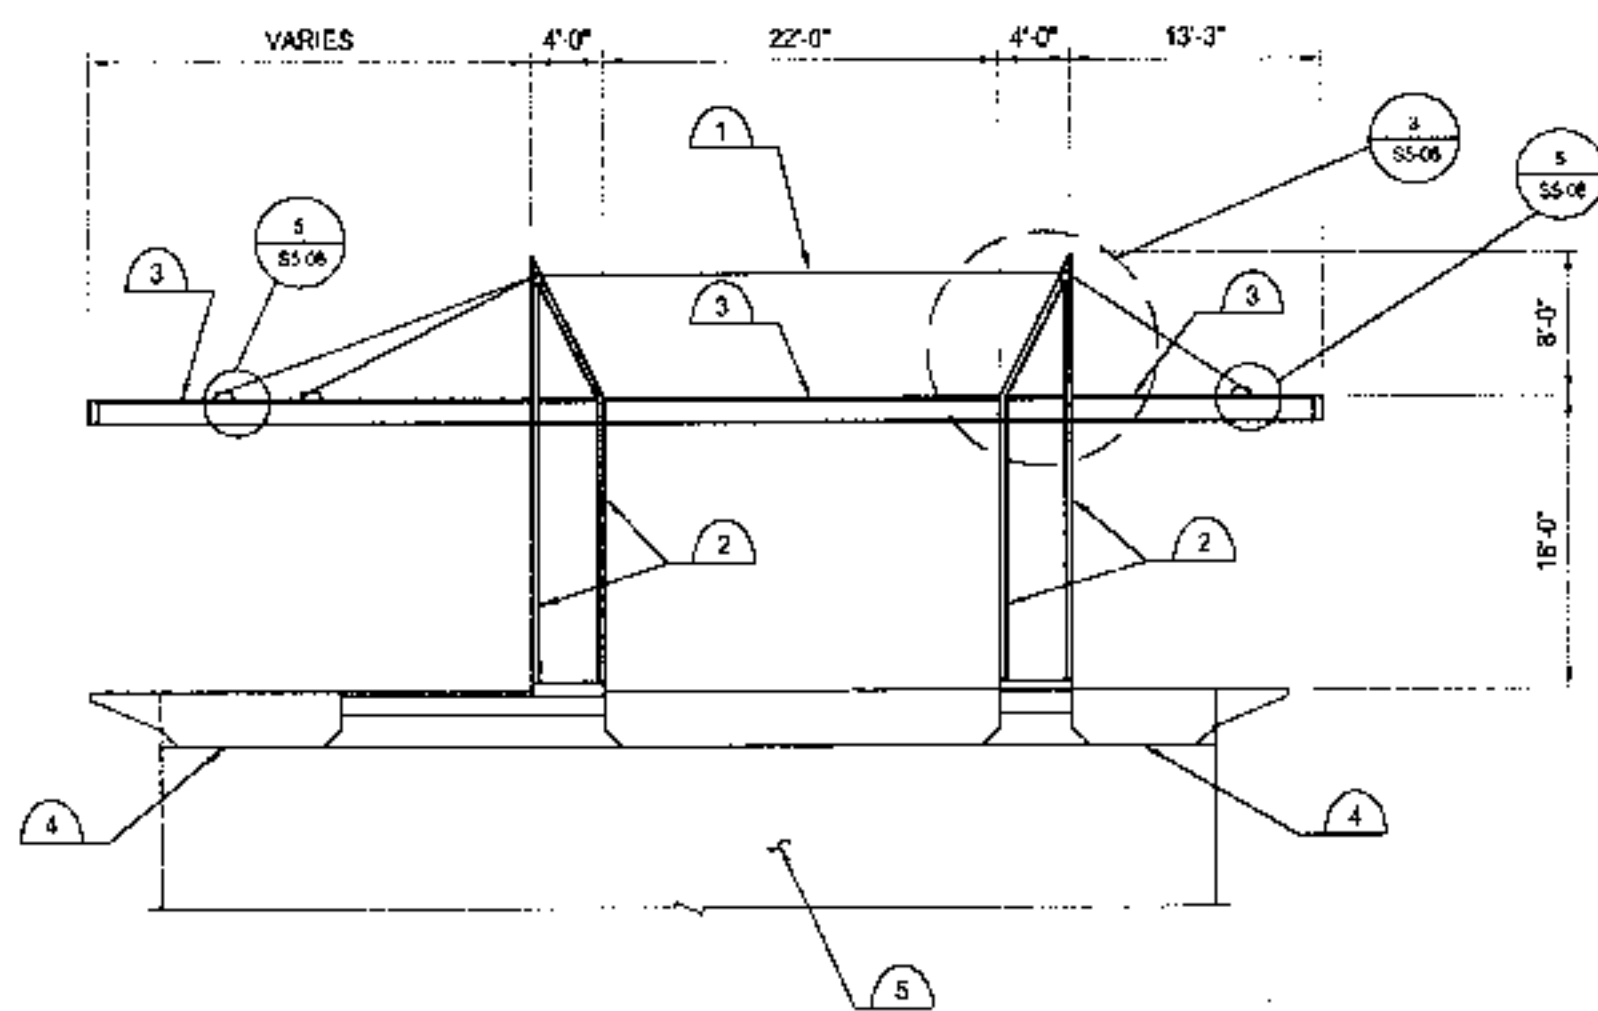

2 CROSS SECTION

KEY NOTES:

1. STEEL PIPE 5" Ø, DOUBLE-EXTRA STRONG.
2. STEEL PIPE 5" Ø, EXTRA STRONG.
3. TS 14 x 6 x 3/8.
4. TS 14 x 6 x 5/16.
5. TS 12 x 4 x 3/8.
6. TS 12 x 4 x 5/16.
7. TS 12 x 4 x 3/16.
8. TS 3 x 3 x 1/4.
9. ABUTMENT CENTERLINE.
10. 80% OPEN PERFORATED ALUMINUM DECK (SEE S1-01 & VERIFY W/ ARCH).
11. 40% OPEN PERFORATED ALUMINUM DECK (SEE S1-01 & VERIFY W/ ARCH).
12. 1 1/2" x 1 1/2" x 1/4" ANGLE.

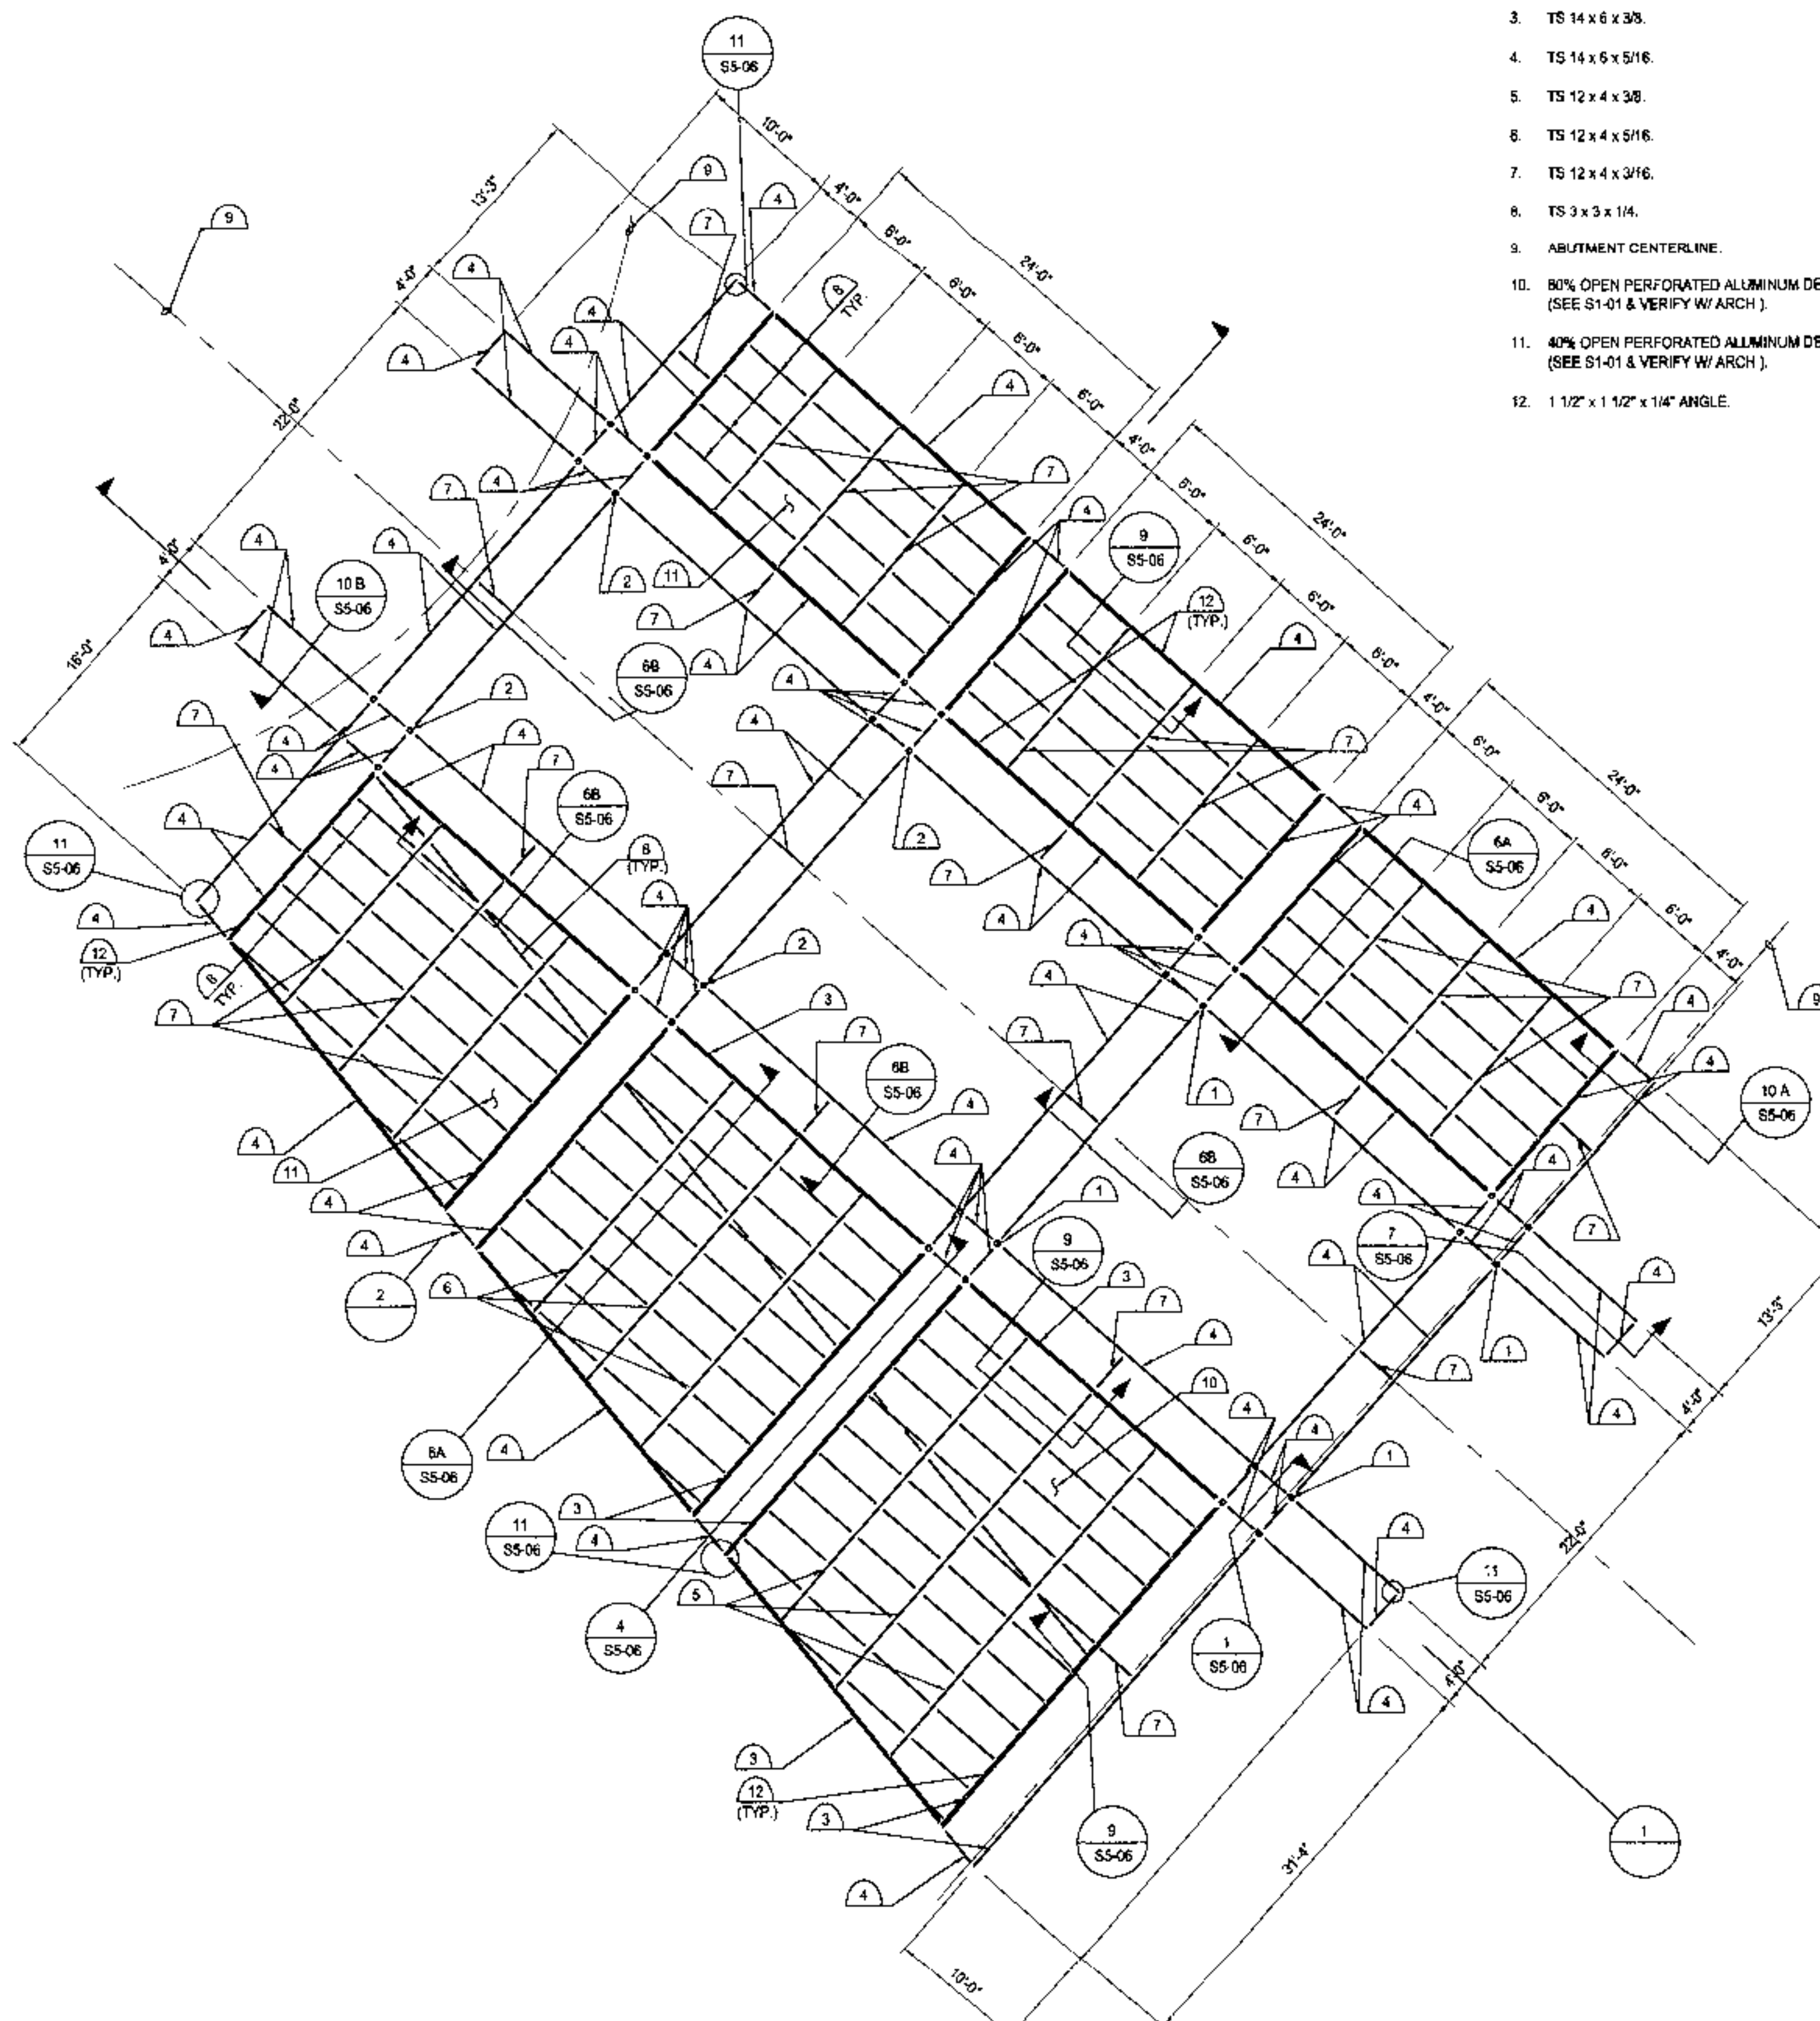

SHADE CANOPY ROOF PLAN

DESIGNWORKSHOP

Landscape Architecture • Land Planning
 Urban Design • Tourism Planning
 Asheville • Aspen • Denver • Jackson Hole
 Park City • Santa Fe • Tempe • Lake Tahoe • Vail
 310 S. Mill Avenue, Suite 201
 Tempe, Arizona 85281
 (480) 966-5881
 Facsimile (480) 966-2799
 WWW.DESIGNWORKSHOP.COM

OWNER
CITY OF SCOTTSDALE
 7417 E. INDIAN SCHOOL RD. SCOTTSDALE, AZ 85251
 480-312-7888

**Arizona Canal
 at Scottsdale - Phase I**
 Scottsdale, Arizona



STAMP / DATE

BID DOCUMENTS
 PHASE ONE

**SHADE CANOPY
 PLAN, ELEVATION
 AND SECTIONS**

ISSUED FOR: BID DOCUMENTS
 ISSUE DATE: OCTOBER 10, 2003
 REVISIONS

#	DATE	DESCRIPTION


 DRAWN: GAAJG REVIEWED: MSP/AZ
 PROJECT NUMBER: 2829

**MUNICIPAL SERVICES
 DEPARTMENT**
**CAPITAL PROJECT
 MANAGEMENT**
 3839 DRINKWATER BLVD.
 SCOTTSDALE, ARIZONA 85251


PROJECT TITLE
ARIZONA CANAL AT SCOTTSDALE-PHASE I
 DESIGNED BY: MSP/AZ DATE: 10-10-03
 DRAWN BY: GAAJG DATE: 10-10-03
 PROJECT NO.: 2829

kpff Consulting Engineers
 2800 NORTH CENTRAL AVENUE, SUITE 1010
 PHOENIX, ARIZONA 85004
 PHONE (602) 254-1010 KPEFF PROJECT #:
 FAX (602) 285-1010 **110149.1**


DRAWINGS ADDED FOR REFERENCE ONLY.

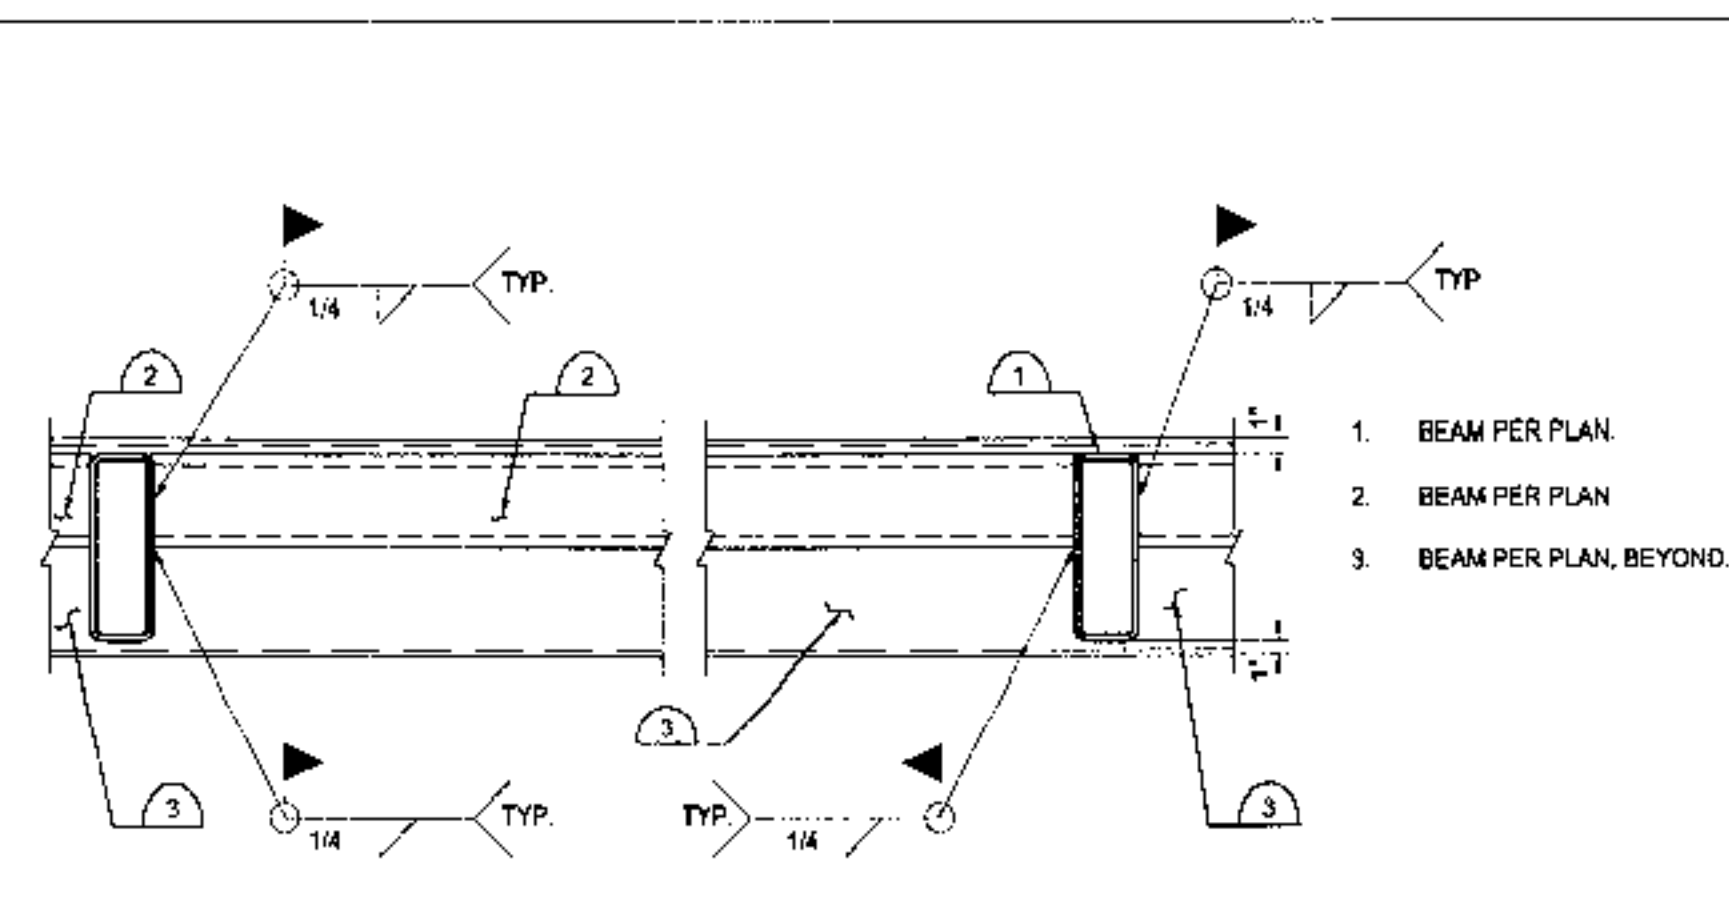


9 BEAM TO BEAM CONNECTION

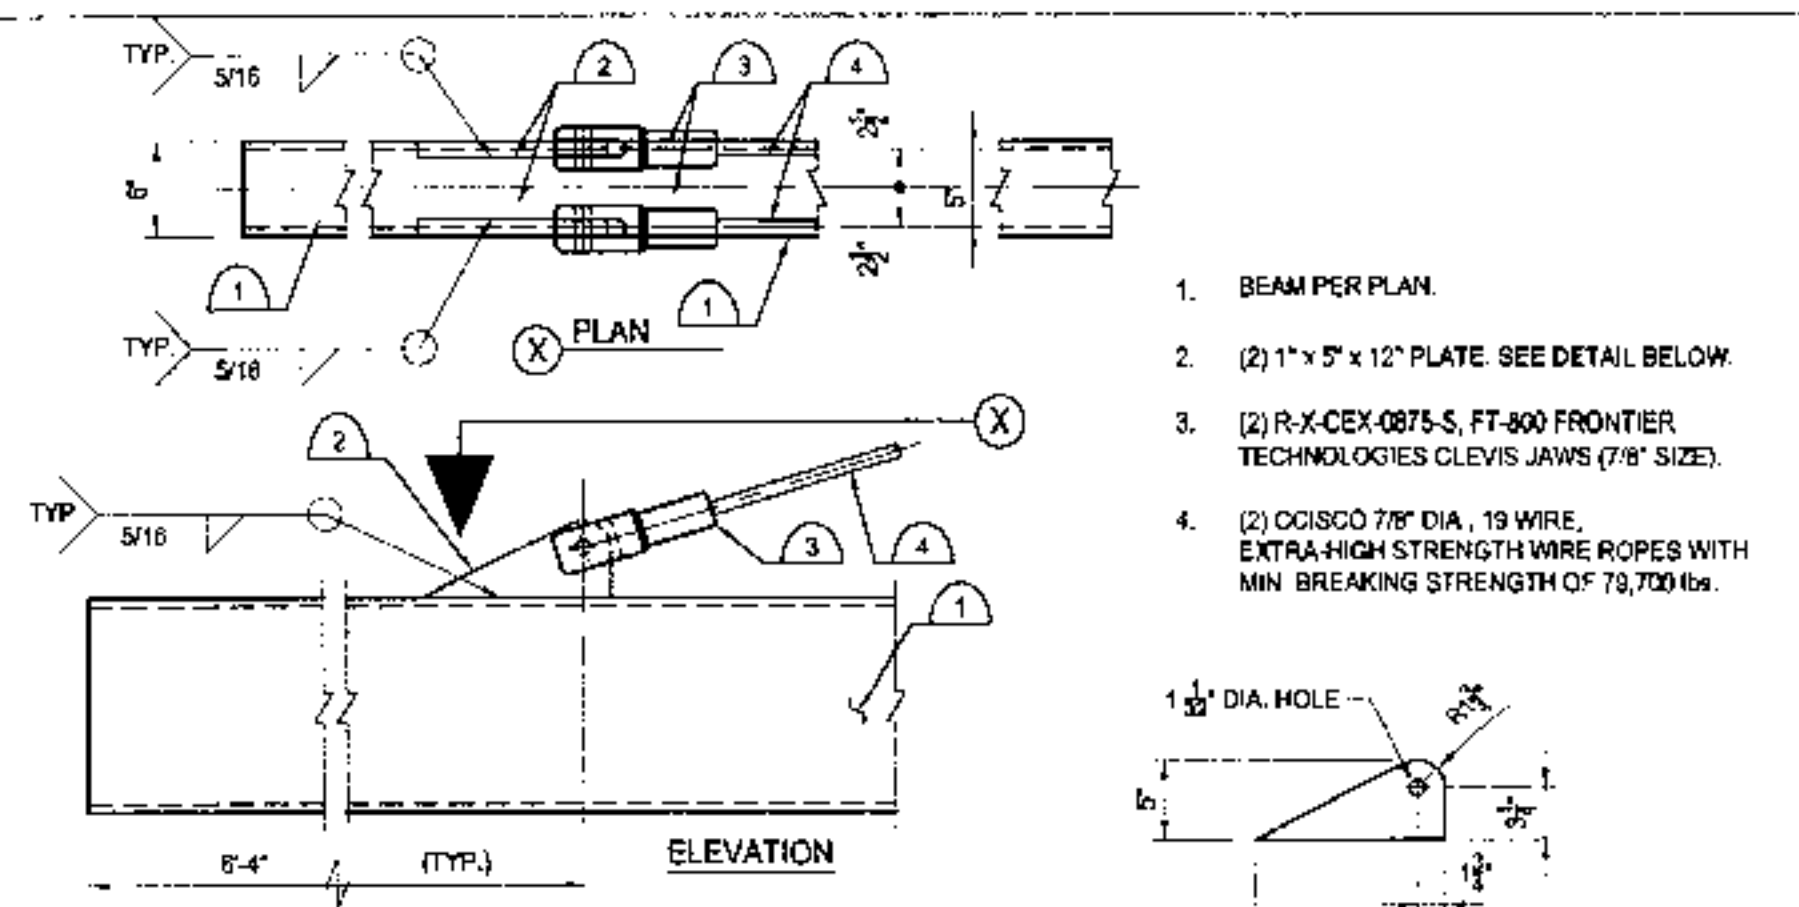


5 WIRE ROPE TO BEAM CONNECTION

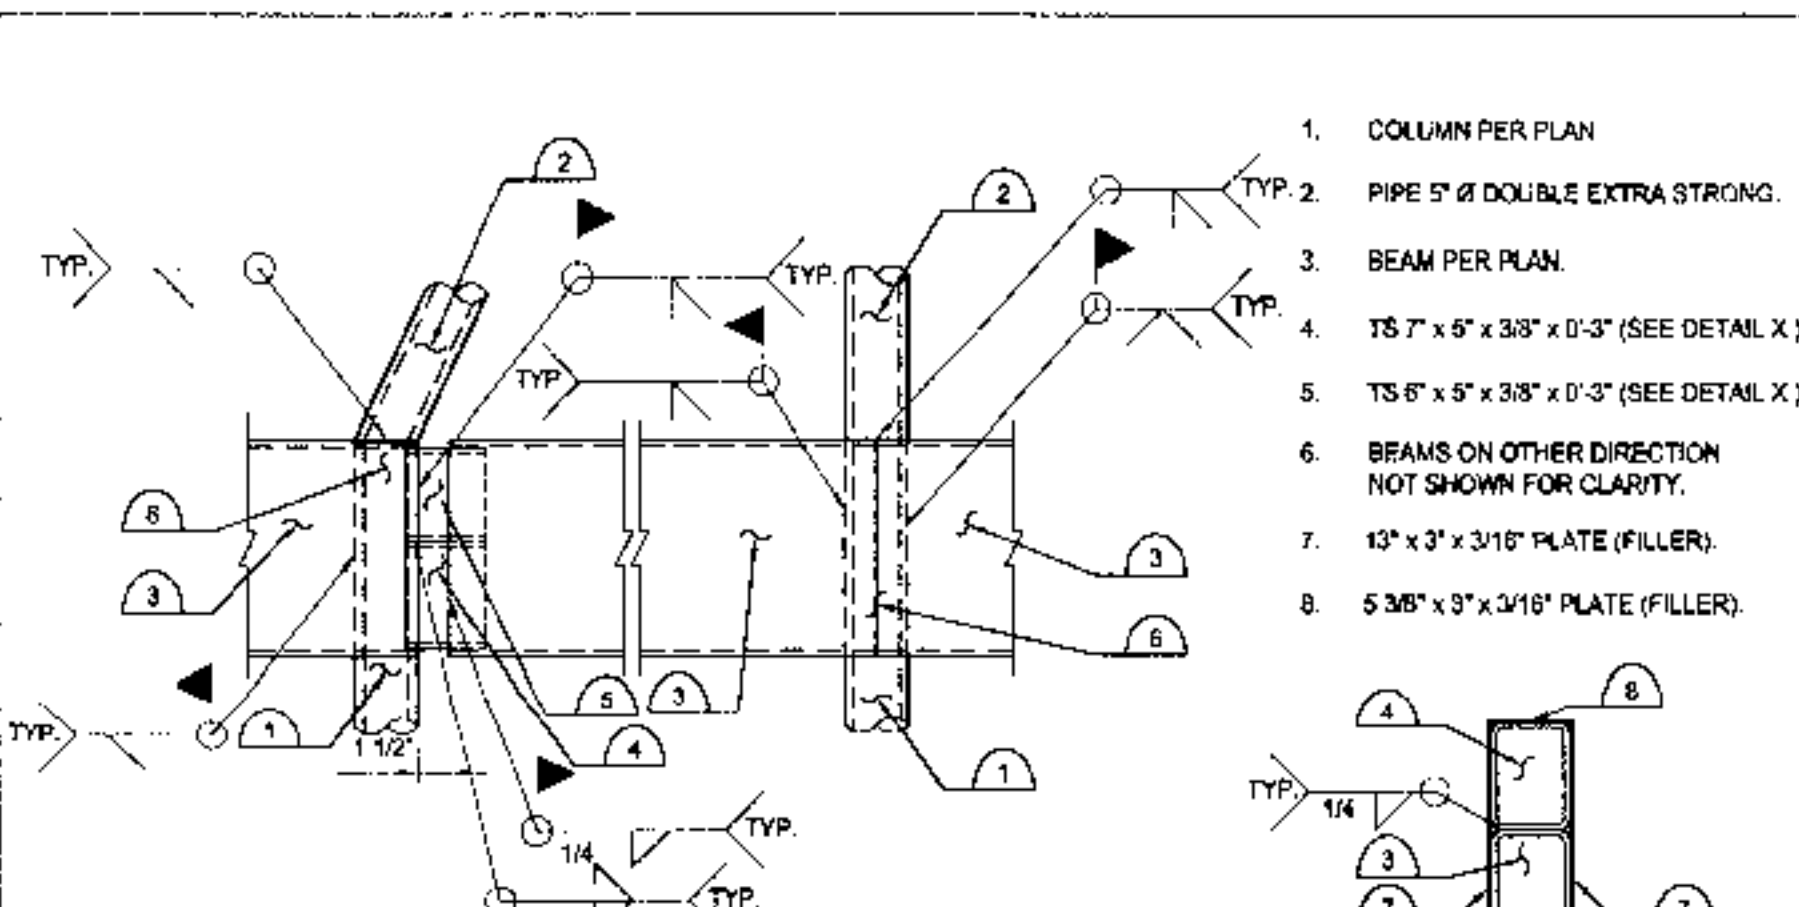


1 BEAM TO COLUMN CONNECTION

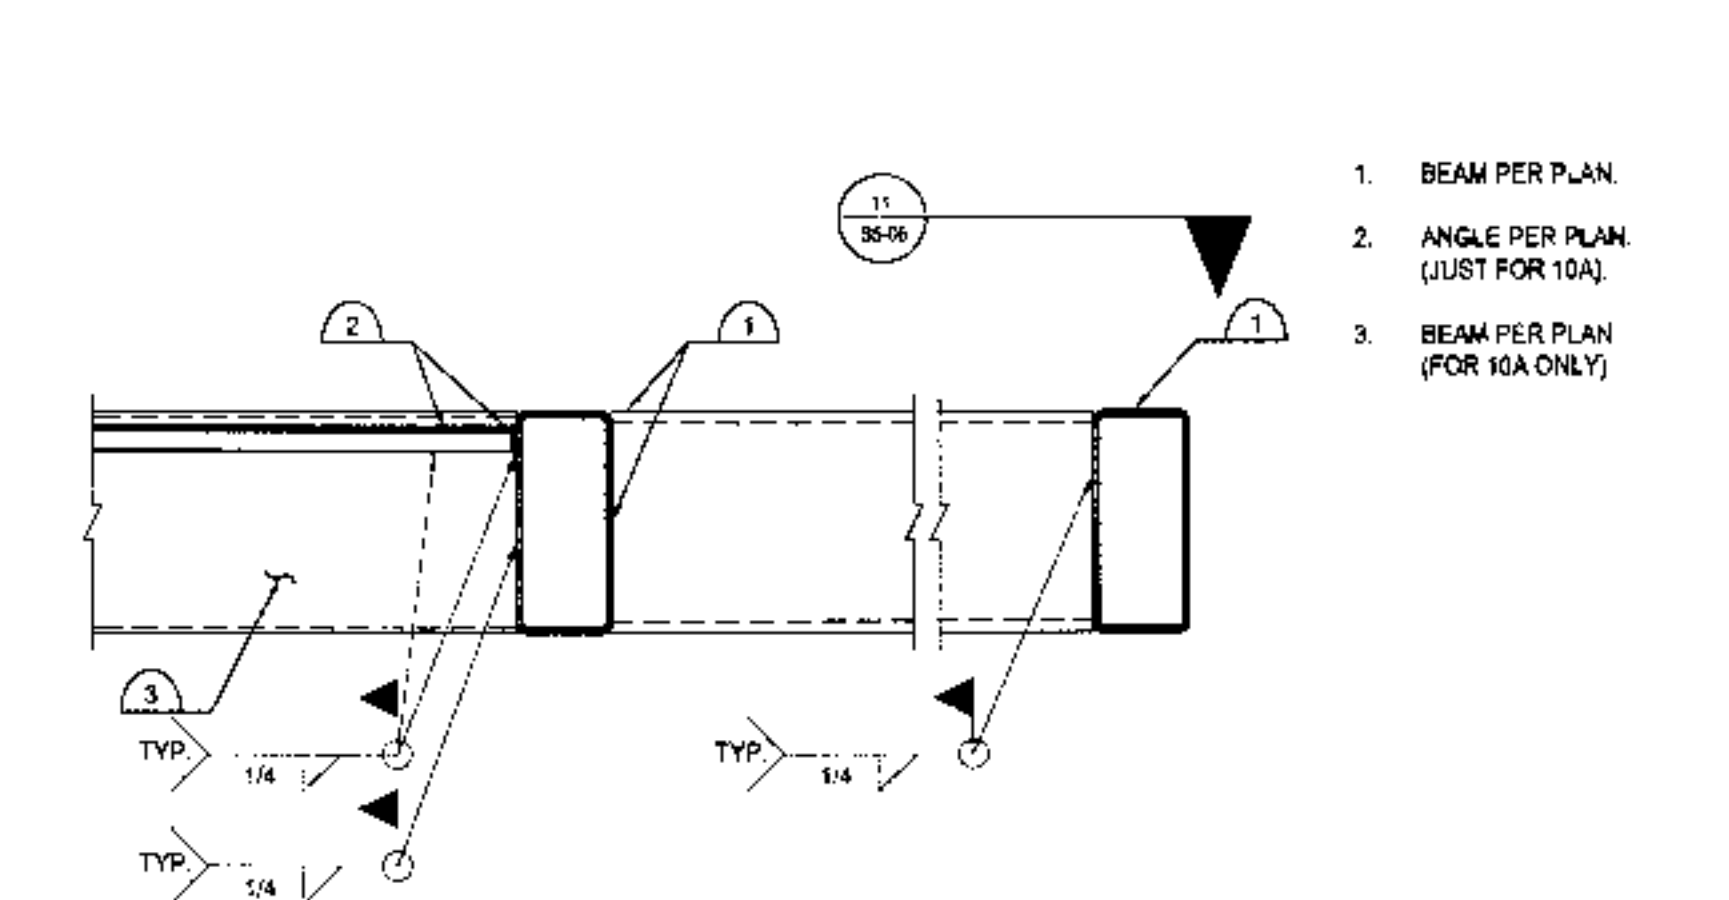


10A/10B BEAM TO BEAM CONNECTION

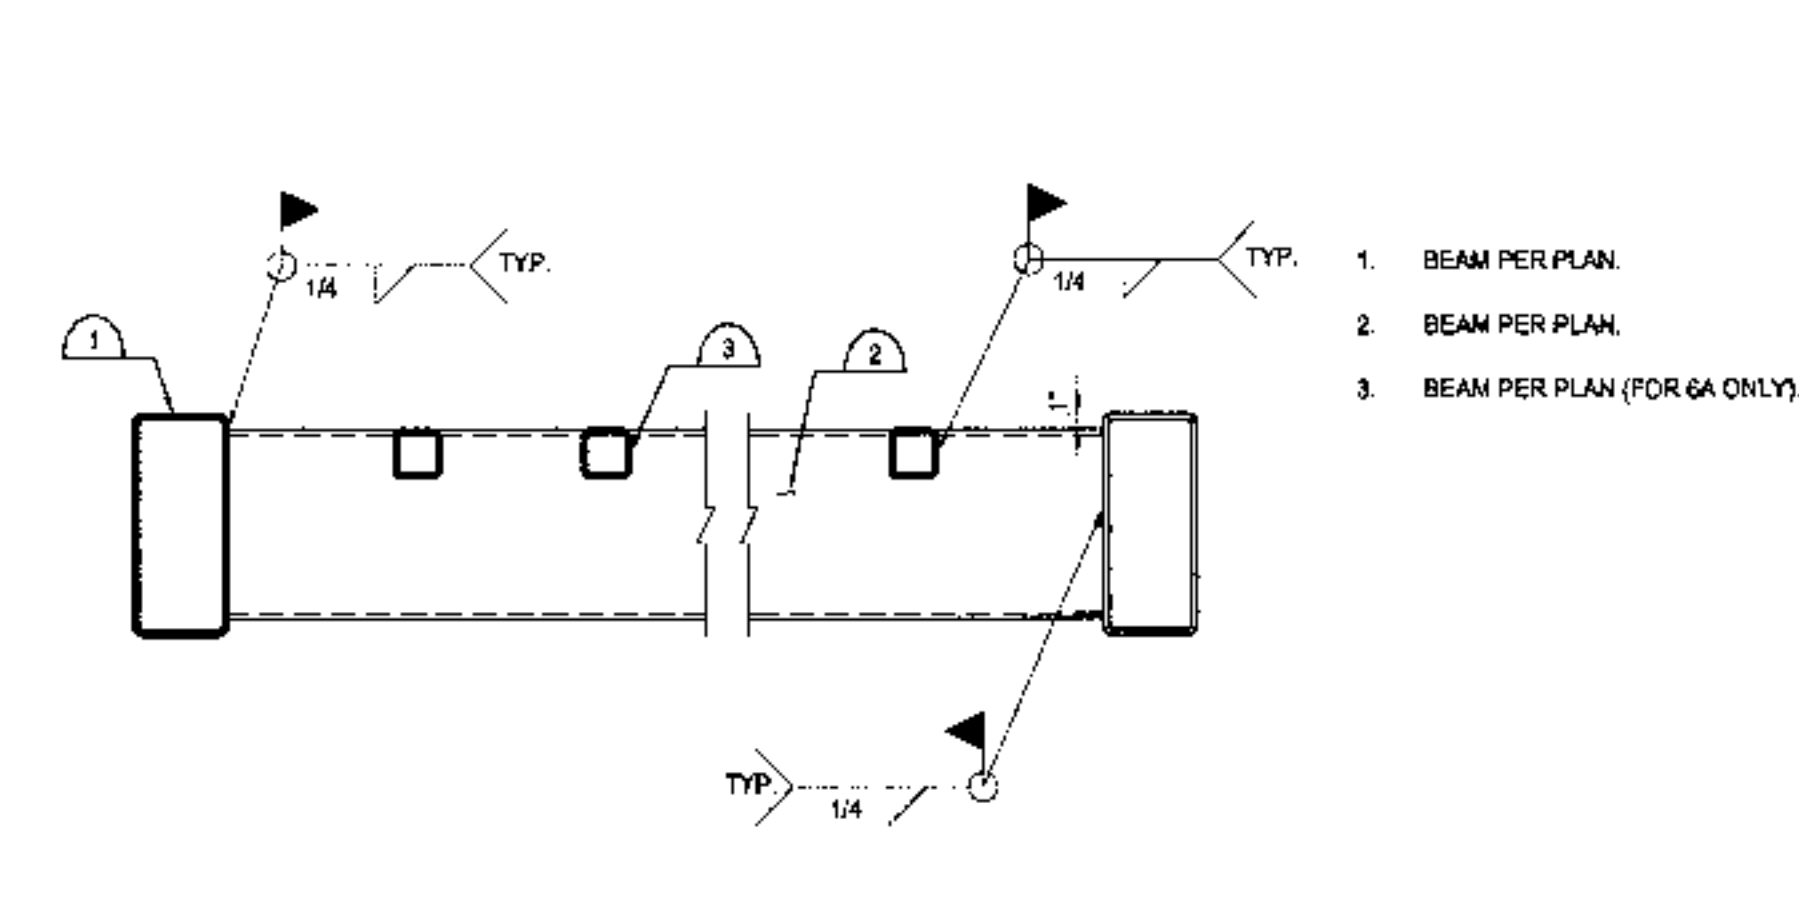


6A/6B BEAM TO BEAM CONNECTION

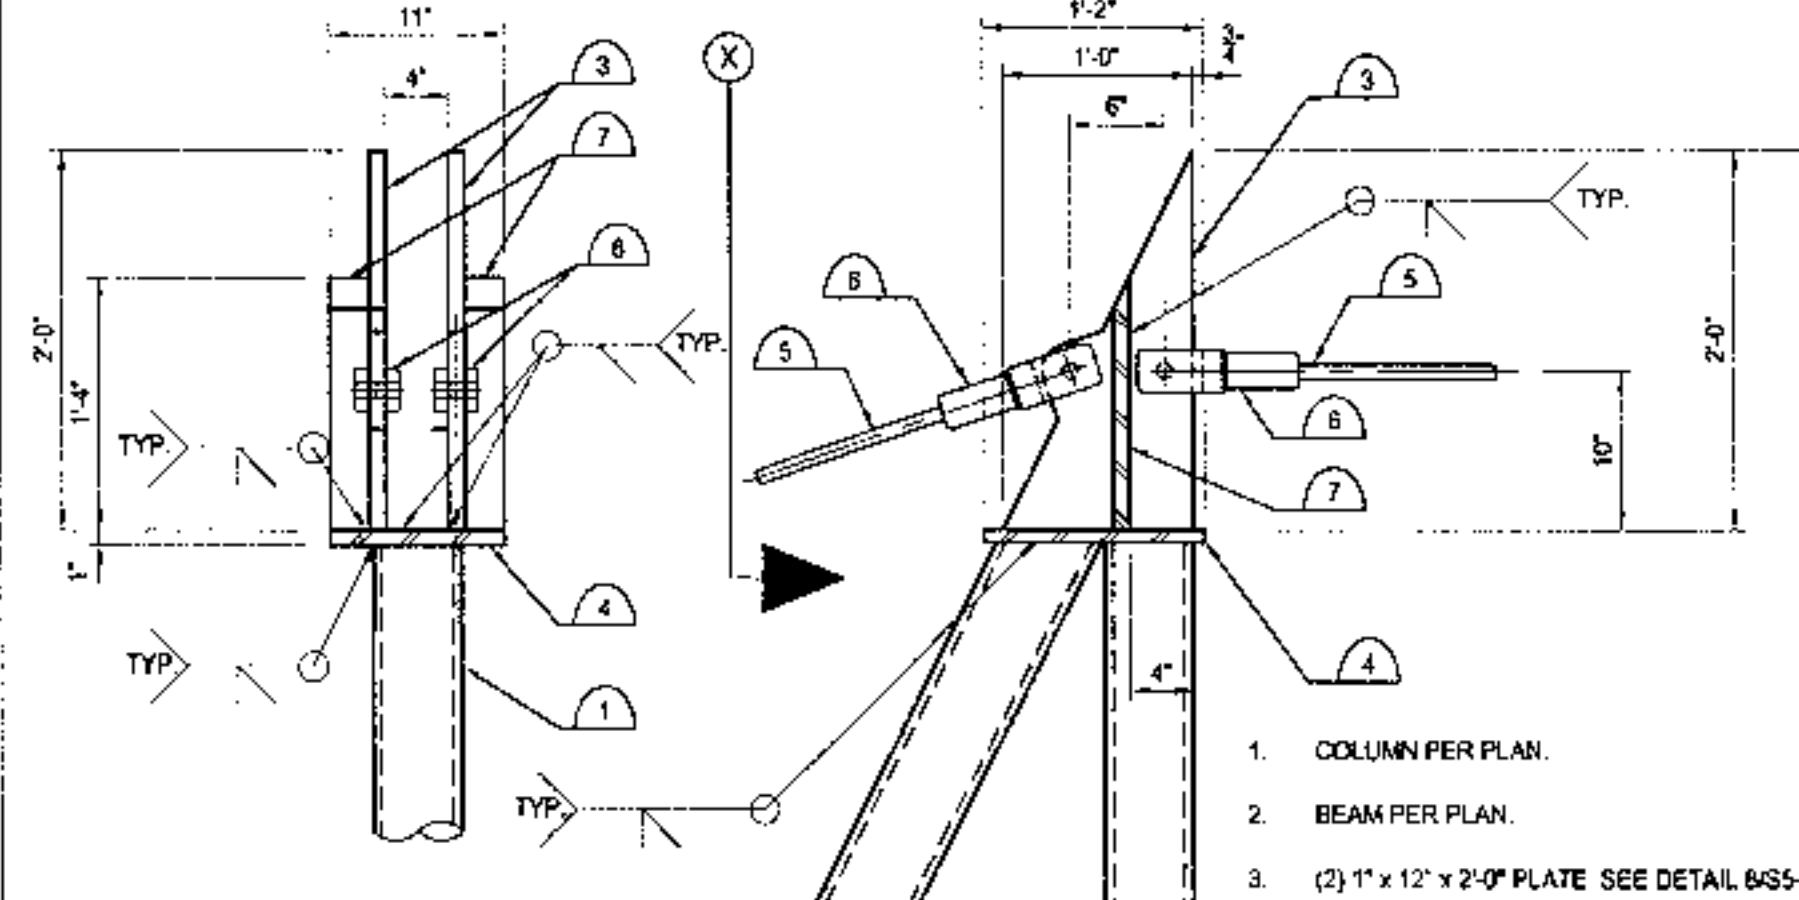


X VIEW

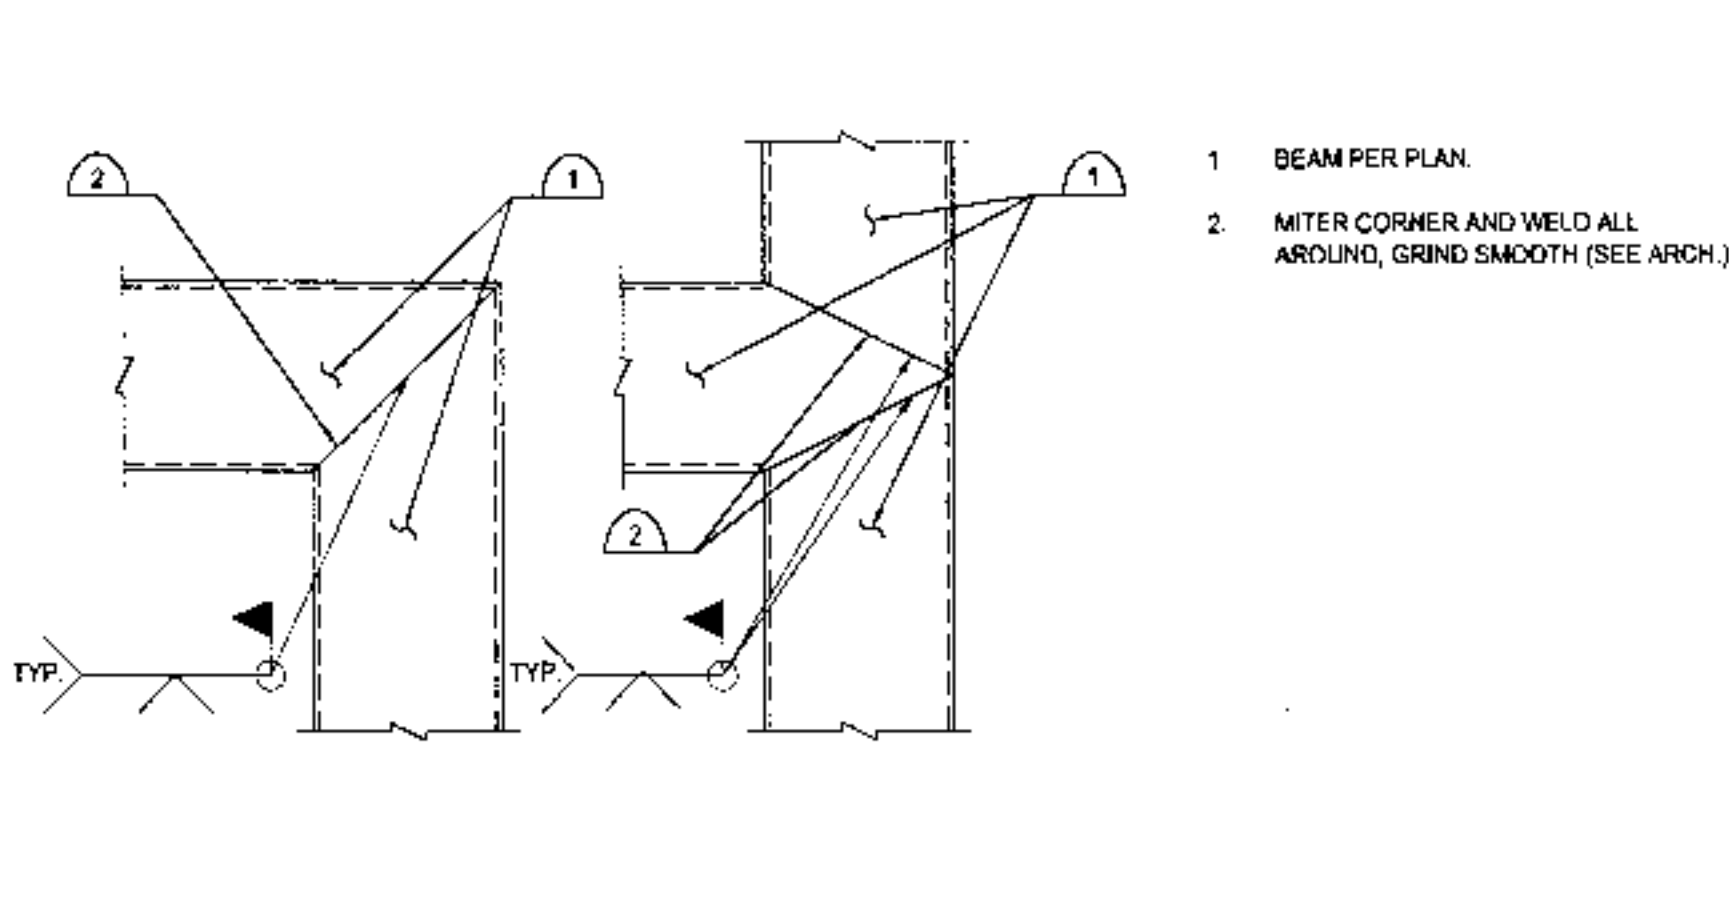

11 BEAM TO BEAM CORNER CONNECTION

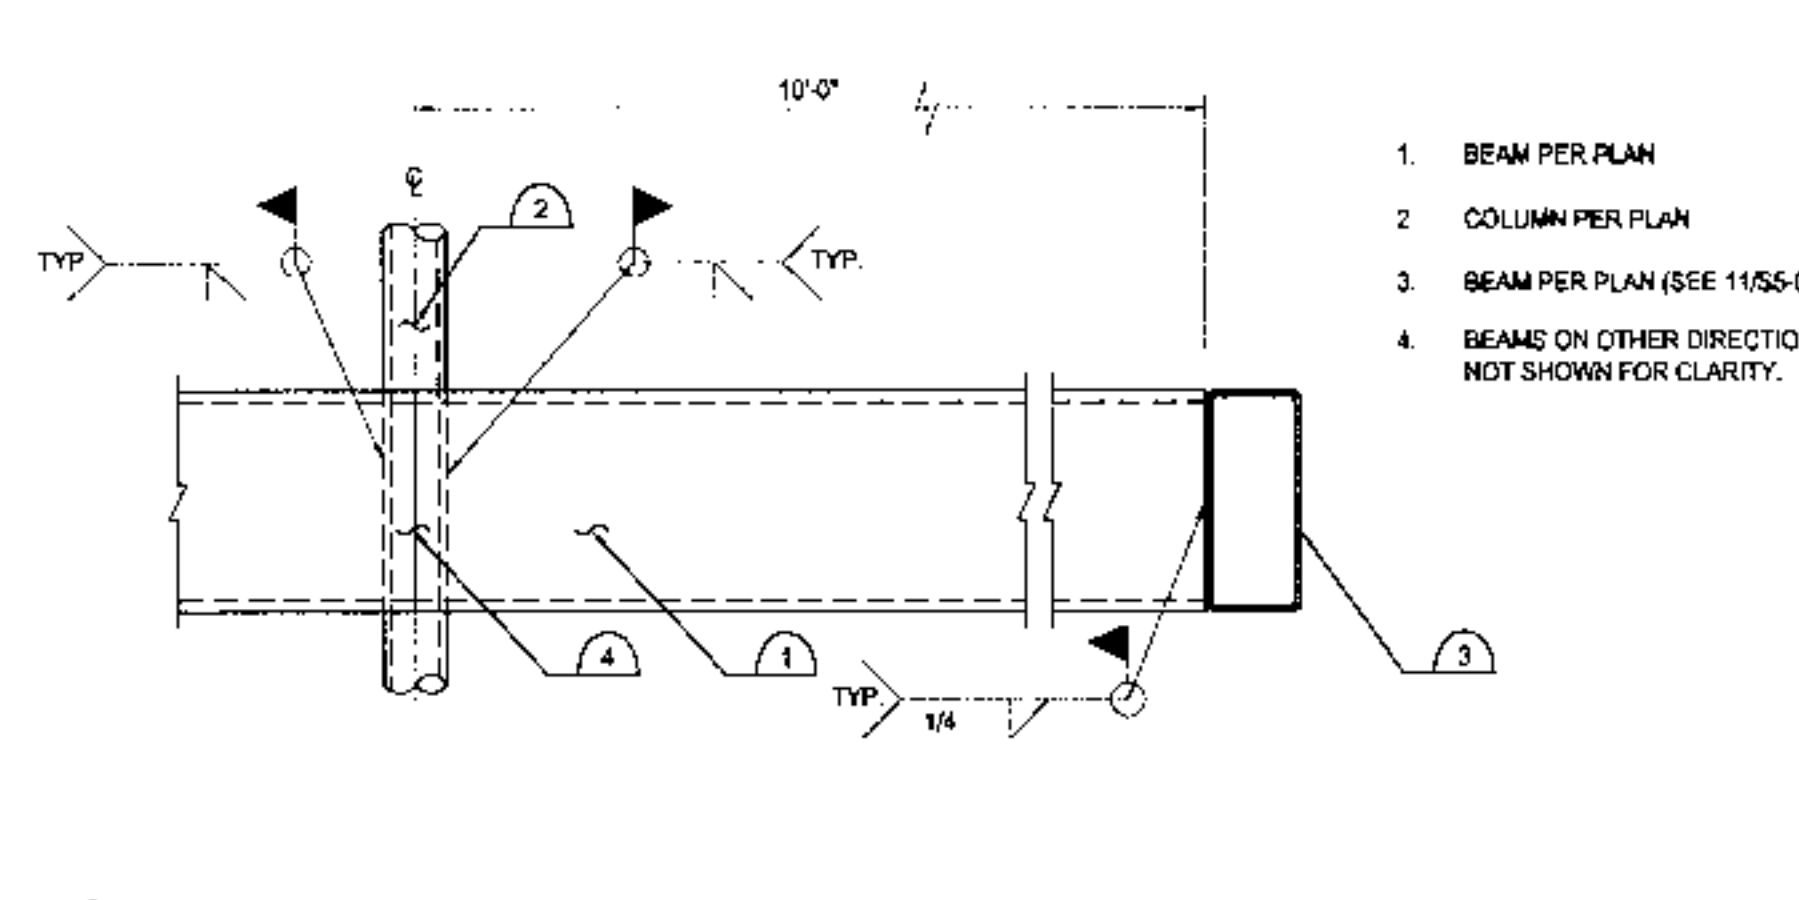


7 BEAM TO COLUMN CONNECTION

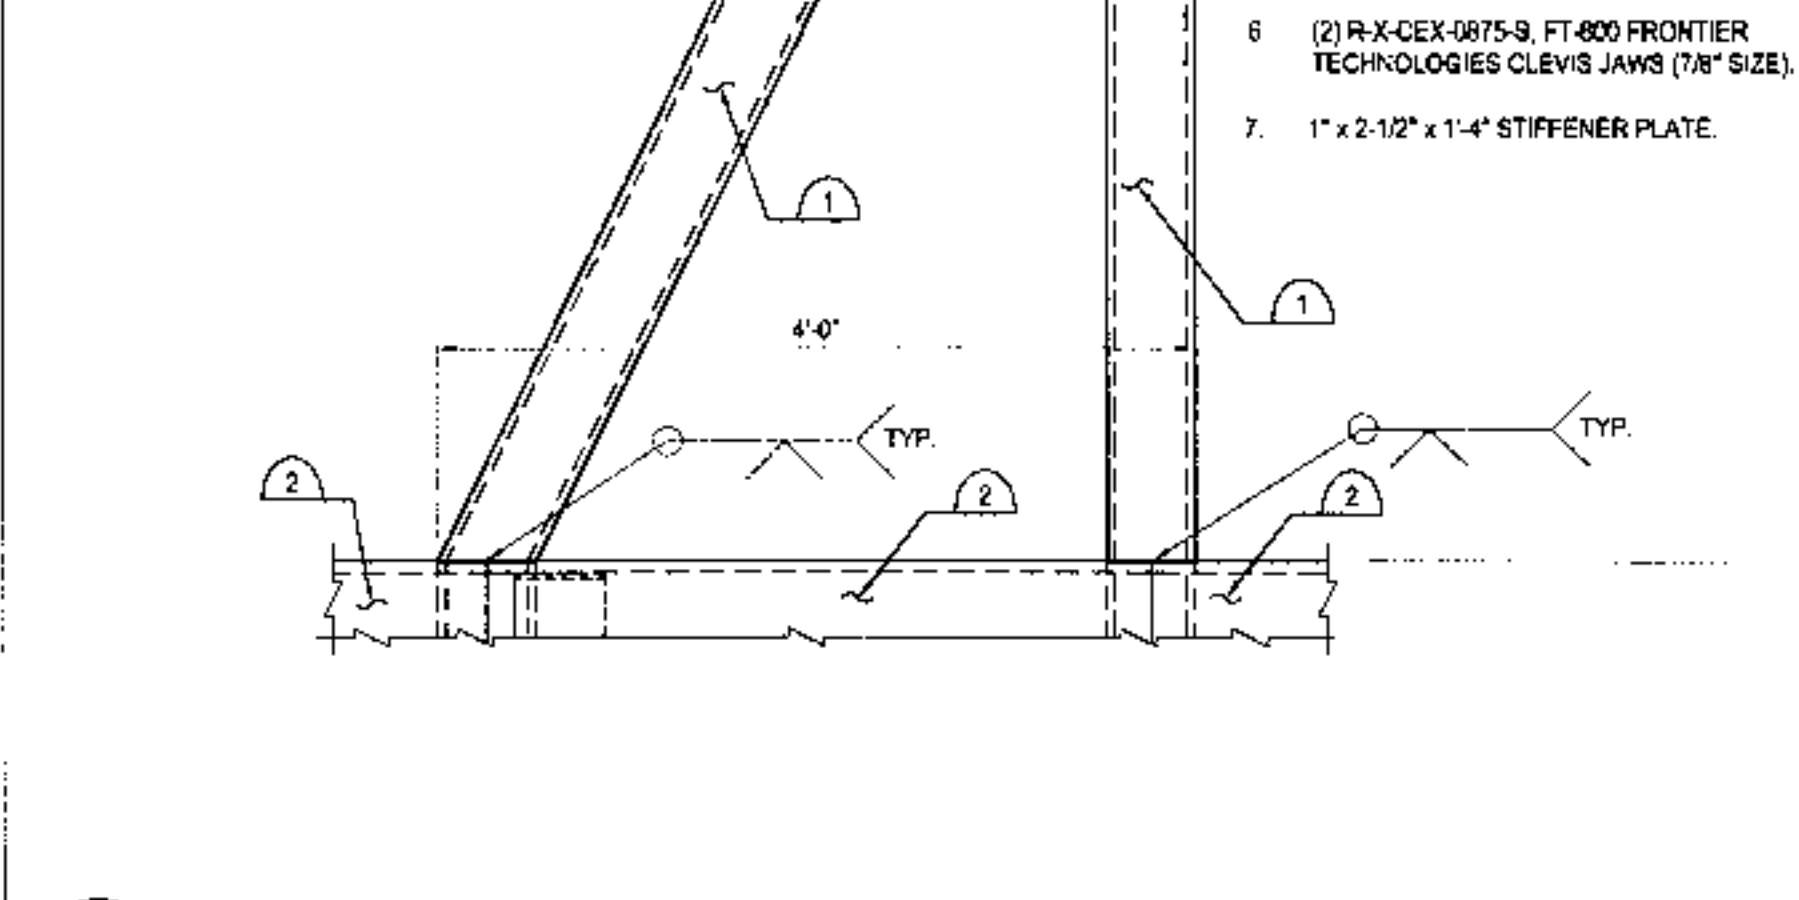


3 SHADE CANOPY DETAIL



8 PLATE DETAIL

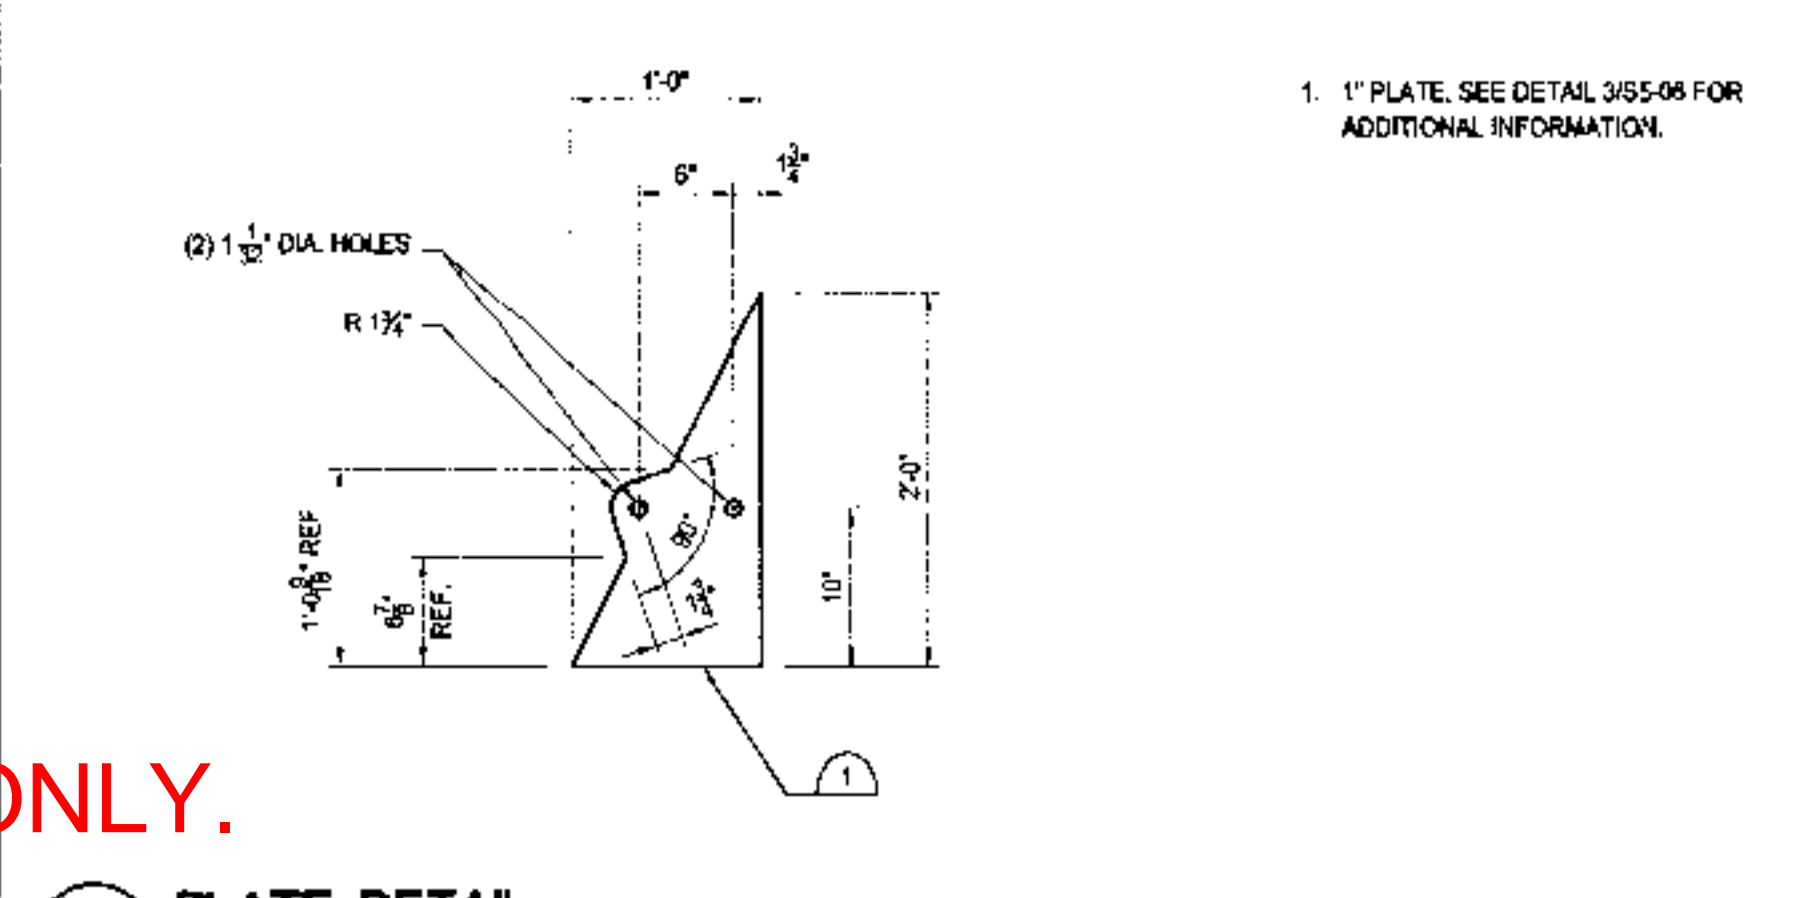

4 BEAM TO BEAM AND BEAM TO COLUMN CONNECTION

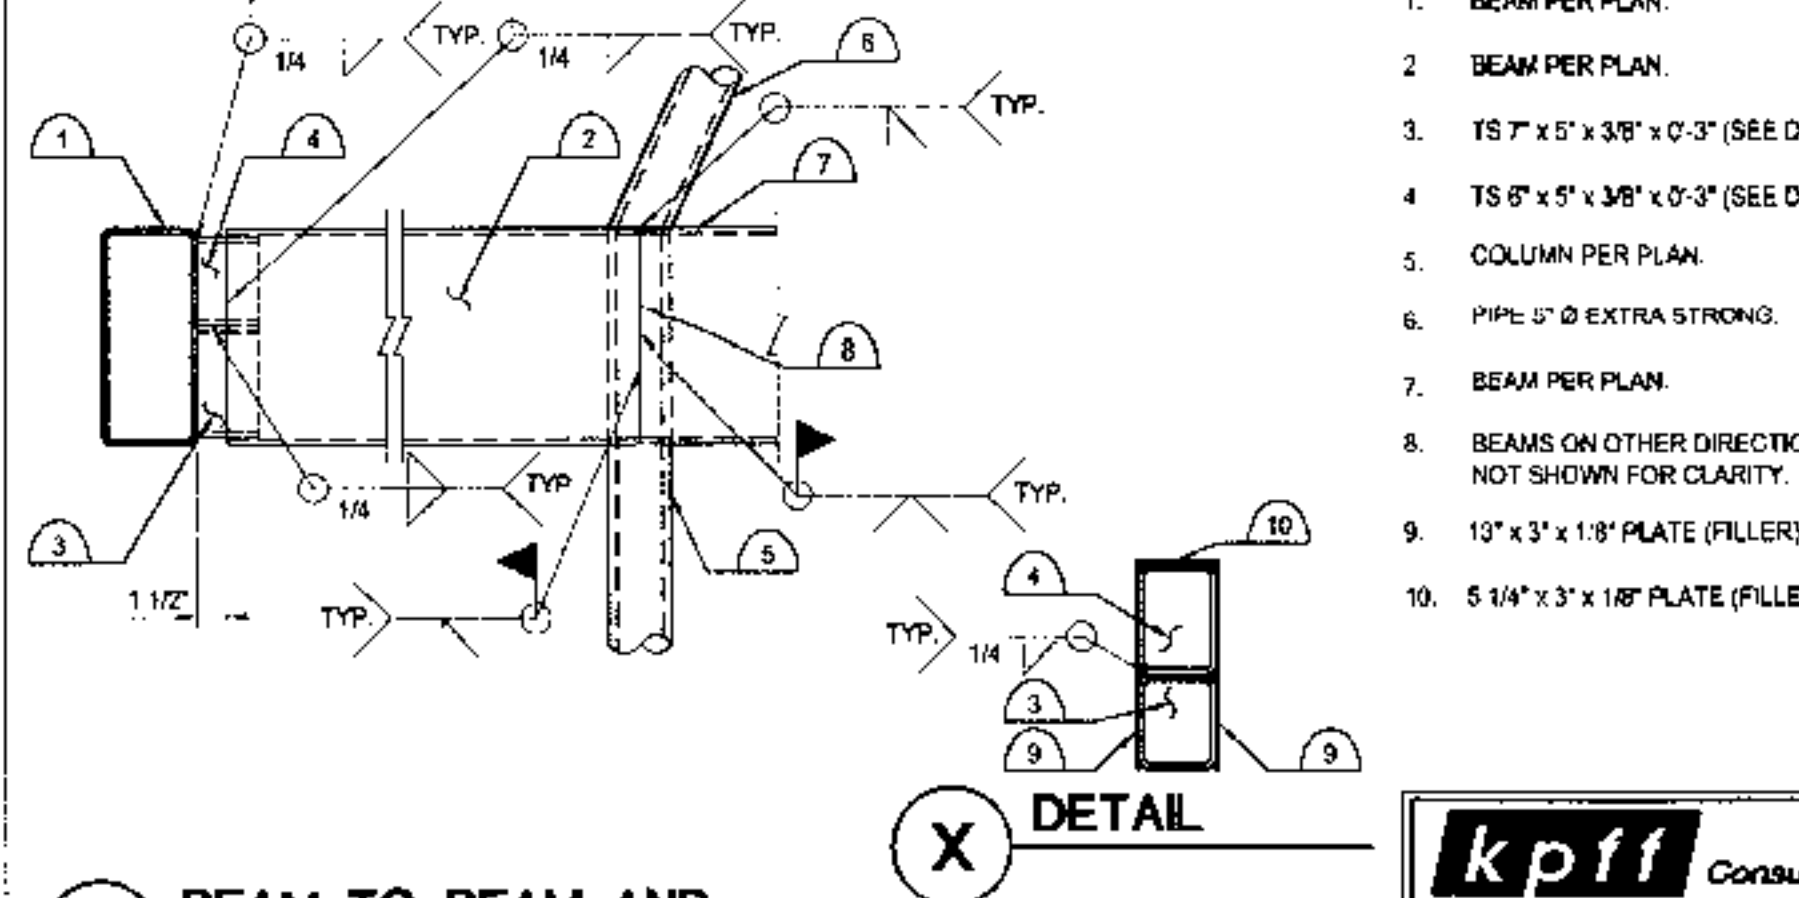

X DETAIL

DESIGNWORKSHOP
 Landscape Architecture • Land Planning
 Urban Design • Tourism Planning
 Asheville • Aspen • Denver • Jackson Hole
 Park City • Santa Fe • Tempe • Lake Tahoe • Vail
 310 S. Mill Avenue, Suite 201
 Tempe, Arizona 85281
 (480) 966-5681
 Facsimile (480) 966-2799
 WWW.DESIGNWORKSHOP.COM
 OWNER
 CITY OF SCOTTSDALE
 7447 E. INDIAN SCHOOL RD. SCOTTSDALE, AZ 85251
 480-312-7869

**Arizona Canal
 at Scottsdale - Phase I
 Scottsdale, Arizona**



STAMP / DATE

BID DOCUMENTS
 PHASE ONE

**SHADE CANOPY
 DETAILS**

ISSUED FOR: BID DOCUMENTS
 ISSUE DATE: OCTOBER 10, 2003

REVISIONS	#	DATE	DESCRIPTION

DRAWN: GAA/JG REVIEWED: MSP/AZ

PROJECT NUMBER 2829

© COPYRIGHT DESIGNWORKSHOP, INC.

MUNICIPAL SERVICES
 DEPARTMENT
 CAPITAL PROJECT
 MANAGEMENT
 3839 DRINKWATER BLVD.
 SCOTTSDALE, ARIZONA 85251

DESIGNED BY	DATE	BD NO.	SHT.
MSP/AZ	10-10-03	#04PB034	SS-06
DRAWN BY <th>AS-BUILT</th> <th>PROJECT NO.</th> <th>OF</th>	AS-BUILT	PROJECT NO.	OF
GAA/JG	0000	2829	87 OF 89

kpf Consulting Engineers
 2800 NORTH CENTRAL AVENUE, SUITE 1010
 PHOENIX, ARIZONA 85004
 PHONE (602) 264-1010 KPF PROJECT #:
 FAX (602) 283-1010 **110149.1**

DRAWINGS ADDED FOR REFERENCE ONLY.

DRAWINGS ADDED FOR REFERENCE ONLY.

DESIGNWORKSHOP

Landscape Architecture • Land Planning
Urban Design • Tourism Planning
Asheville • Aspen • Denver • Jackson Hole
Park City • Santa Fe • Tempe • Lake Tahoe • Vail

310 S. Mill Avenue, Suite 201
Tempe, Arizona 85281
(480) 966-5881
Facsimile (480) 966-2799

WWW.DESIGNWORKSHOP.COM

OWNER
CITY OF SCOTTSDALE

7447 E. INDIAN SCHOOL RD. SCOTTSDALE, AZ 85251
480-312-7668

**Arizona Canal
at Scottsdale - Phase I
Scottsdale, Arizona**



STAMP / DATE

BID DOCUMENTS
PHASE ONE

**PLAZA
SITE PLAN**

ISSUED FOR: BID DOCUMENTS

ISSUE DATE: OCTOBER 10, 2003

REVISIONS

#	DATE	DESCRIPTION

DRAWN: GARJG REVIEWED: MSPAZ

PROJECT NUMBER: 2829

© COPYRIGHT DESIGNWORKSHOP, INC.

REVISION _____ BY _____



**MUNICIPAL SERVICES
DEPARTMENT
CAPITAL PROJECT
MANAGEMENT**

3939 DRINKWATER BLVD.
SCOTTSDALE, ARIZONA 85251

PROJECT TITLE			
ARIZONA CANAL AT SCOTTSDALE-PHASE I			
DESIGNED BY	DATE	BID NO.	SHT.
MSP/AZ	10-10-03	#04PB034	SS-01
DRAWN BY	AS-BUILT NO.	PROJECT NO.	SHEET NO.
GARJG	0000	2829	88 OF 89



kpff Consulting Engineers
2600 NORTH CENTRAL AVENUE, SUITE 1010
PHOENIX, ARIZONA 85004
PHONE (602) 254-1010 KPFF PROJECT #:
FAX (602) 285-1010 **110149.1**

GENERAL NOTES:

- SEE LANDSCAPE PLAN FOR WALL LOCATIONS.


2
SS-02

4
SS-02



1 PLAZA SITE PLAN


SCALE: 1/8"=1'-0"

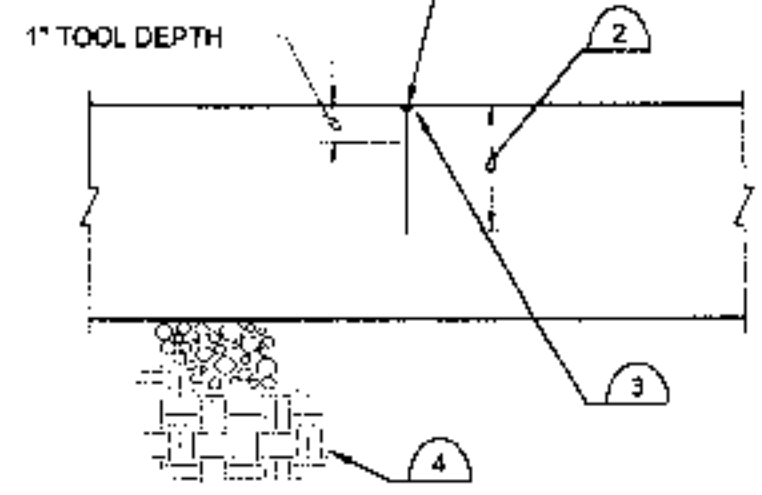

- CUT FRESH CONC. JUST AFTER IT HAS BEGUN TO HARDEN, WITH 1" THICK ANGLE. REMOVE AND TOOL JOINT.
- 2-1/2" DEPTH OF CUT.
- 1/8" TOOLED R. AT EXPOSED AREA.
- PLACE CONCRETE ON 4" ABC OVER COMPACTED EARTH BASE.


NOTE: AT CONTRACTOR'S OPTION, THIS DETAIL ANTICIPATES "STRIP" PLACING WITH THE CONTROL JOINTS CUTTING ACROSS THE STRIP. IF OTHER PLACING PATTERNS ARE USED, DO NOT USE THIS TYPE OF CONTROL JOINT.

9 SHRINKAGE CONTROL JOINT

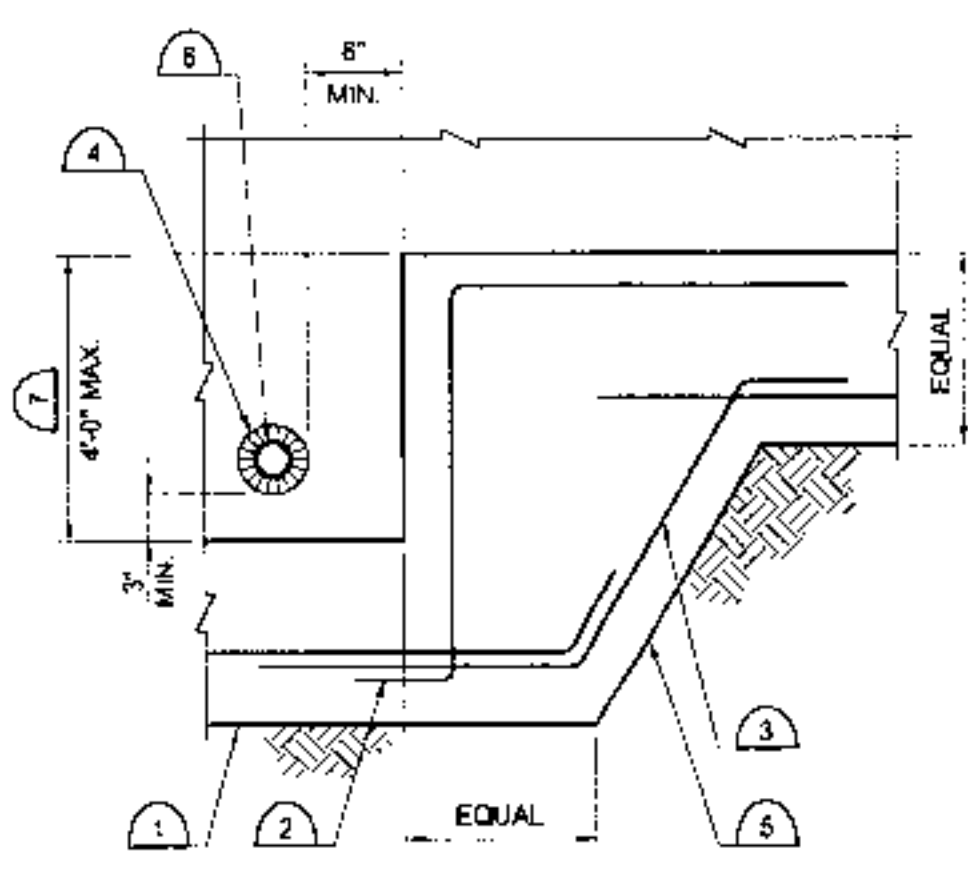


- PLACE ALL CONCRETE AGAINST UNDISTURBED SOIL. IF SOIL IS DISTURBED DURING CONCRETE PLACING, REPLACE DISTURBED SOIL WITH CONCRETE.
- REBAR MAY BE LAP SPICED AT CONTRACTOR'S OPTION.
- REBAR TO MATCH AND LAP WITH TYPICAL FOOTING REINFORCEMENT.
- 1" SPONGE RUBBER AROUND PIPE WHEN APPLICABLE.
- SLOPE AS REQUIRED FOR EARTH STABILITY.
- SEE "DETAILS OF PIPE AT CONCRETE FOOTING", FOR PIPE PLACEMENT CRITERIA.
- STEP FOOTING AS REQUIRED TO DEPRESS FOOTING TO FIRM BEARING, OR TO GET BELOW UNDERGROUND PIPING, OR WHENEVER CHANGE IN FOOTING ELEVATION OCCURS. SEE DETAIL "MAXIMUM SLOPES BETWEEN FOOTINGS AND EXCAVATIONS", WHICH MAY REQUIRE LOWERING OF FOOTING ELEVATION. SPACE STEPS NO CLOSER THAN 4'-0" CLEAR.

5 STEP IN FOOTING

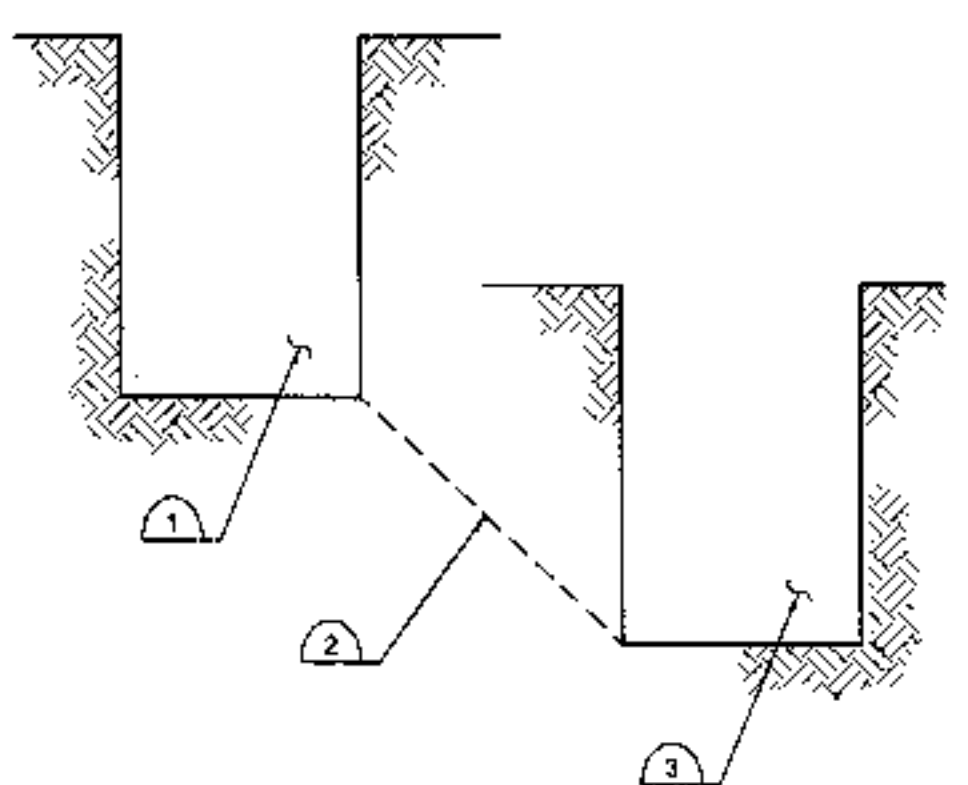


- FOOTING.
- THIS SLOPES SHALL NOT BE STEEPER THAN 1 VERTICAL TO 1 HORIZONTAL IF EXCAVATION STAND VERTICALLY WITHOUT SHORING AND 1 VERTICAL TO 1 1/2 HORIZONTAL IF EXCAVATIONS NEED TO BE SLOPE OR SHORED.
- EXCAVATION AND BACKFILL UNDERMINING FOOTING ABOVE.

10 MAXIMUM SLOPES BETWEEN FOOTINGS AND EXCAVATIONS

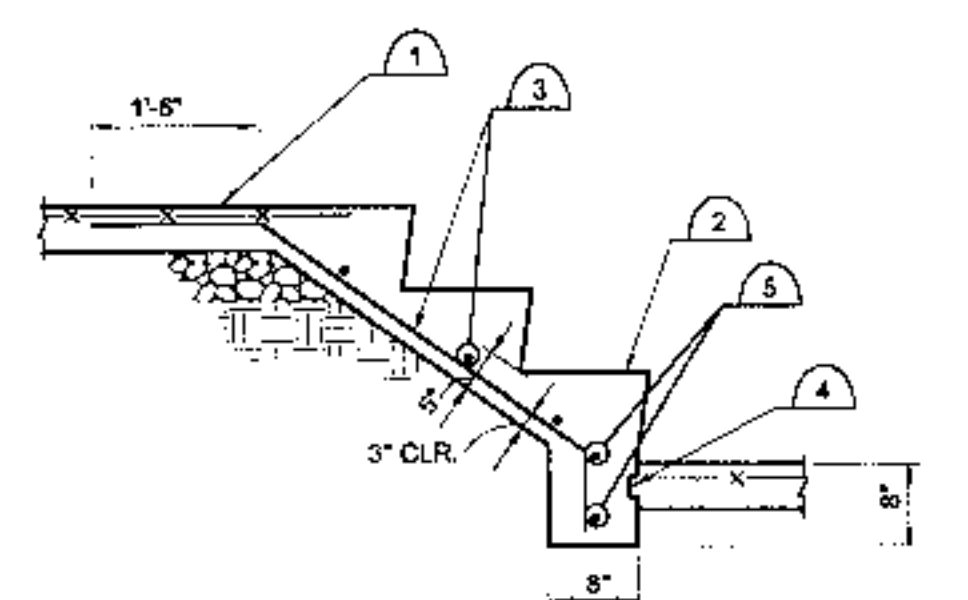

- SLAB AND REINF., IF ANY, PER PLAN.
- SEE ARCHITECTURAL DRAWINGS FOR NUMBER OF TREADS AND RISER SHAPE AND TREATMENT.
- #4 @ 12" O.C. EACH WAY, DOWEL INTO SIDE WALLS, WHERE OCCUR.
- SEE TYPICAL SLAB JOINT DETAIL FOR SLAB CONSTRUCTION, INCLUDING REINFORCING, IN ANY.
- (2) #4 x CONT. AT TOE.

6 STEPS ON GRADE

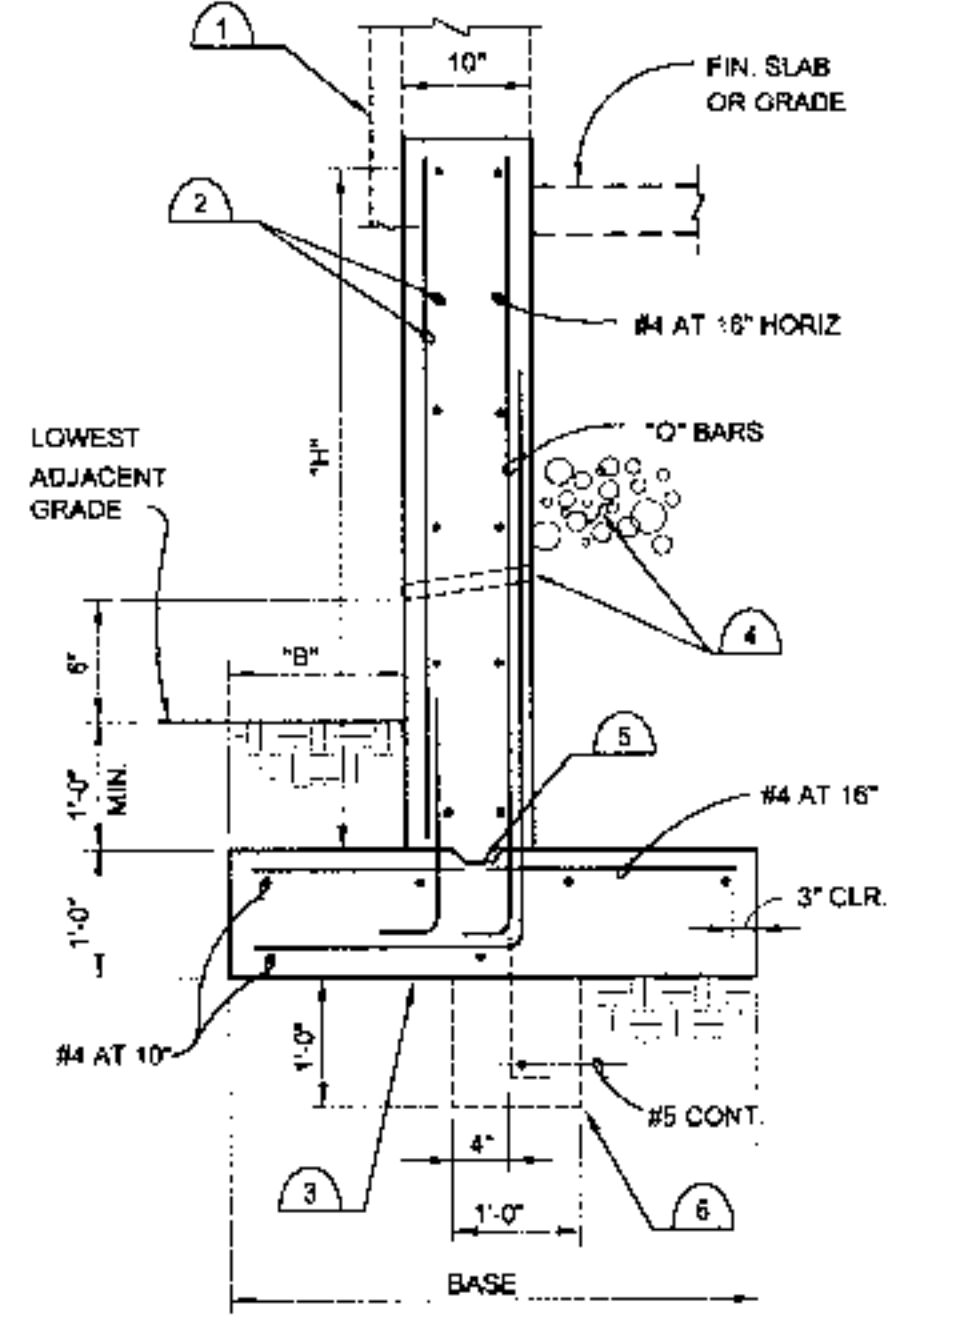


SCHEDULE			
"H" UP TO	BASE	"B"	"O" BARS
3'-0"	2'-0"	0'-7"	#4 @ 16"
4'-0"	2'-8"	0'-10"	#4 @ 16"
5'-0"	3'-0"	1'-1"	#4 @ 16"
6'-0"	3'-5"	1'-4"	#4 @ 16"


REBAR PLACEMENT IN BACK OF WALL

- SEE PLANS AND ARCH. DWGS WHERE CAP OCCURS ABOVE. REINFORCE AND DOWEL PER G.S.N.
 - #4 AT 18" EACH WAY, THIS FACE.
 - STEP FOOTING PER DETAIL 559-02.
 - 1"3 WEEP HOLES AT 8'-0" (WEEP HOLES ARE NOT REQ'D AT WALLS LESS THAN 3'-0" WITH 18" SQUARE CRUSHED ROCK CONTINUOUS).
 - 1 1/2" x 3 1/2" CONTINUOUS KEY.
 - USE CONCRETE LUG AT WALL WITH HEIGHT OVER 8'-0" WITH ALTERNATE WALL VERTICALS INTO LUG.
 - ALTERNATE LONG SHORT "O" BARS, SPACING PER SCHEDULE.
 - 40 "H" WHEN "H" EXCEEDS 8'-0" (FULL HEIGHT FOR "H" EQUAL TO OR LESS THAN 6'-0").
- NOTE: BATTER BOTH FACES OF WALL 1/40' PER FOOT HEIGHT "H".

2 RETAINING WALL UP TO 10'-0"

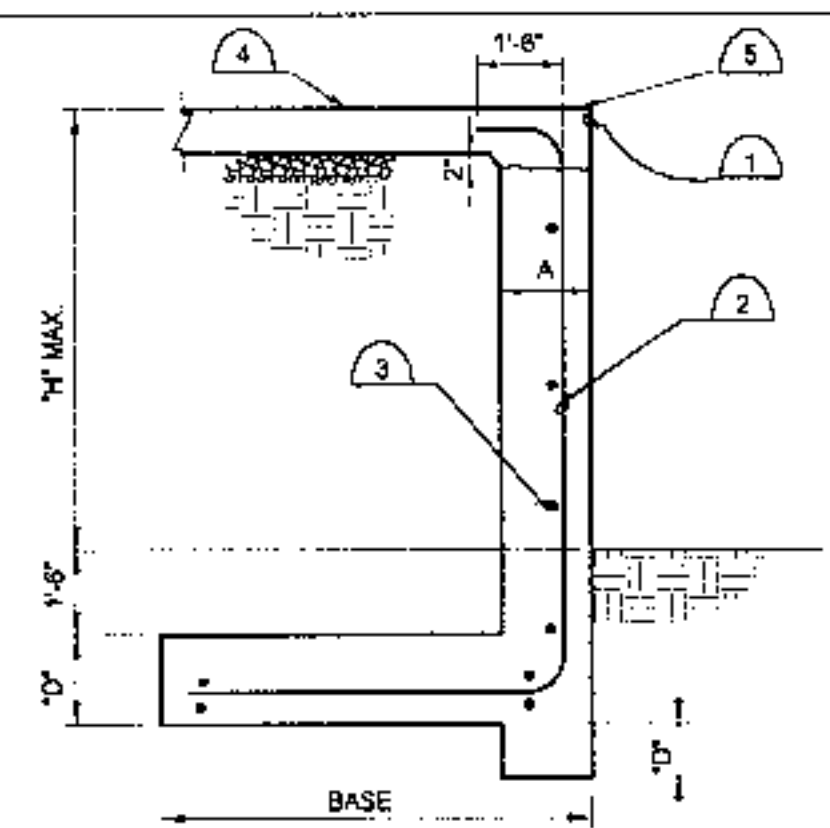


- PROPERTY LINE.
- "O" BARS.
- "L" BARS.
- SEE ARCH. FOR SLAB ON GRADE.
- FOR GUARD RAIL SEE 955-04 AND ARCH.

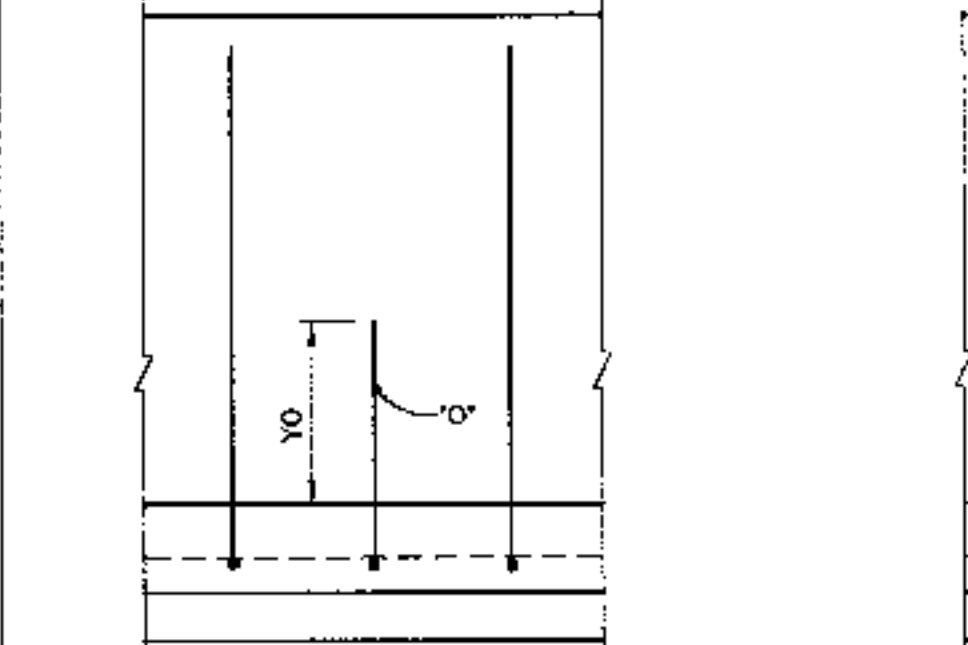


"H" HEIGHT	BASE	"A"	"D"	"O" BARS		"M" BARS		"L" BARS
				SIZE	YO	SIZE	YO	
2'-6"	4'-0"	8"	12"	#4 @ 12"	---	---	---	#4 @ 12"
4'-6"	7'-0"	10"	14"	#4 @ 8"	---	---	---	#4 @ 8"
6'-6"	9'-6"	12"	14"	#5 @ 12"	3'-0"	---	3'-0"	#5 @ 12"

4 PROPERTY LINE RETAINING WALL

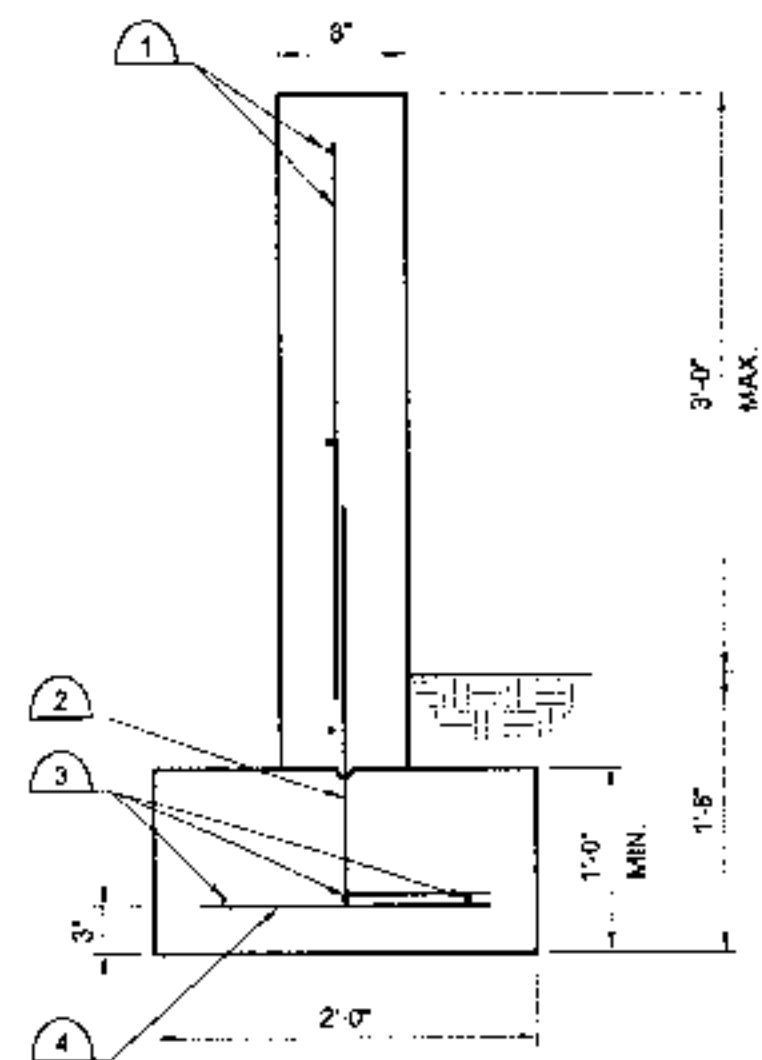

- #4 @ 16" O.C. EACH WAY.
- #4 @ 18" O.C.
- (3) #4
- #4 @ 18" O.C.

12 CONCRETE FREE STANDING WALL

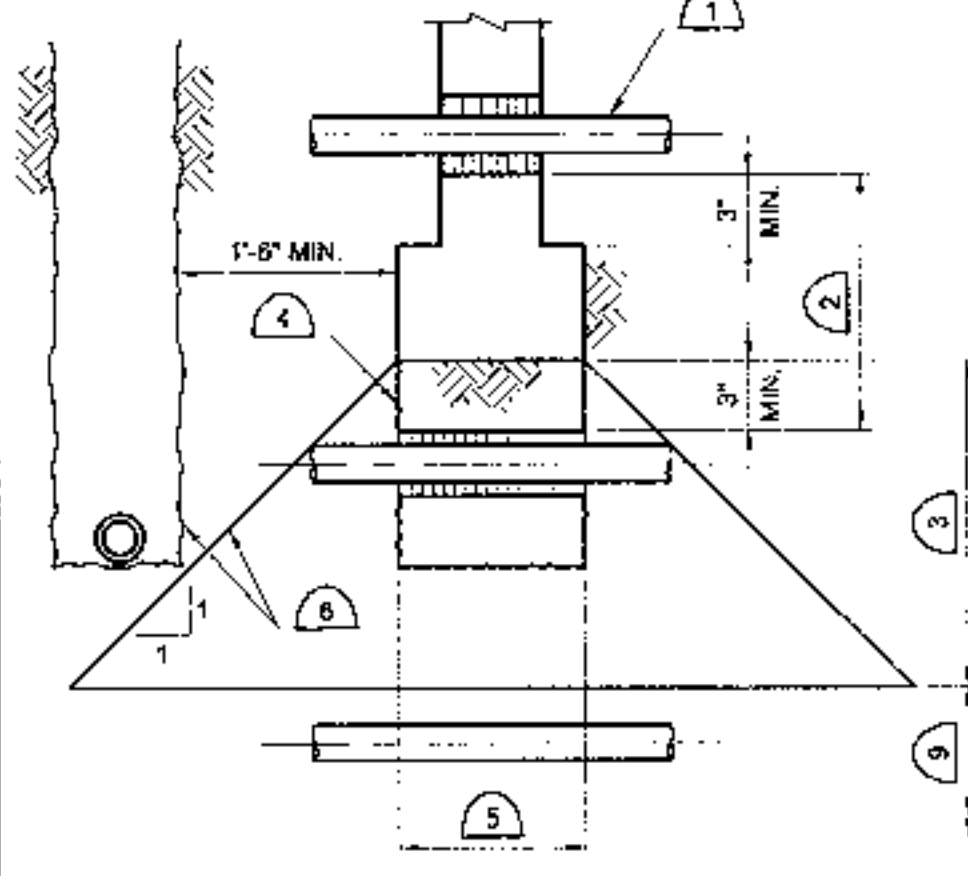

- PIPE THRU STEM WALL - SLEEVE PIPE THRU WALL SEE DETAIL BELOW.
- STEP FOOTING IF PIPE OCCURS WITHIN THIS AREA.
- 1-1/2 x FOOTING WIDTH, ENCASE PIPE IN CONCRETE IF PIPE OCCURS WITHIN THIS AREA.
- CONCRETE FILL SHALL BE PLACED BEFORE FOOTING IS CAST.
- CONCRETE PIPE ENCASEMENT SAME WIDTH AS FOOTING.
- NO EXCAVATION FOR PIPE TRENCH PARALLEL TO FOOTING BELOW THIS LINE.
- 1" SPONGE RUBBER, REQUIRED WHERE PIPE PASSES THRU WALL AND WHERE PIPE IS ENCASED IN CONCRETE.
- CONCRETE ENCASEMENT DIMENSIONS "W" (WIDTH) AND "D" (DEPTH) DETERMINED BY SIZE OF PIPE PLUS NOTED MINIMUM EDGE DIMENSIONS AND 60 DEGREE SLOPE.
- IF PIPE IS BELOW FOOTING BY 1-1/2 x FOOTING WIDTH, THEN NO ENCASEMENT REQUIRED. COMPACT SOIL BACKFILL TO 95% MINIMUM.

NOTE: NO PIPES SHALL PASS THRU CASSIONS.

8 DETAILS OF PIPE AT CONCRETE FOOTING

DRAWINGS ADDED FOR REFERENCE ONLY.

DESIGNWORKSHOP
 Landscape Architecture • Land Planning
 Urban Design • Tourism Planning
 Asheville • Aspen • Denver • Jackson Hole
 Park City • Santa Fe • Tempe • Lake Tahoe • Vail
 310 S. Mill Avenue, Suite 201
 Tempe, Arizona 85281
 (480) 966-5881
 Facsimile (480) 966-2799
 WWW.DESIGNWORKSHOP.COM
 OWNER
CITY OF SCOTTSDALE
 7447 E INDIAN SCHOOL RD. SCOTTSDALE, AZ 85261
 480-312-7869

**Arizona Canal
 at Scottsdale - Phase I
 Scottsdale, Arizona**



BID DOCUMENTS
 PHASE ONE

**STRUCTURAL
 SITE
 DETAILS**

ISSUED FOR: BID DOCUMENTS
 ISSUE DATE: OCTOBER 10, 2003
 REVISIONS
 # DATE DESCRIPTION

 DRAWN: GAA/JG REVIEWED: MSP/AZ
 PROJECT NUMBER: 2829

PROJECT TITLE
ARIZONA CANAL AT SCOTTSDALE-PHASE I
 DESIGNED BY: MSP/AZ DATE: 10-10-03 NO. #04PB034 SH. S6-02
 DRAWN BY: GAA/JG AS-BUILT PROJECT NO. 2829 SHEET NO. 69 OF 88

kpi Consulting Engineers
 2800 NORTH CENTRAL AVENUE, SUITE 1010
 PHOENIX, ARIZONA 85004
 PHONE (602) 264-1010 KPEF PROJECT #:
 FAX (602) 283-1010 **110149.1**



APPENDIX B

CALCULATIONS

Canal Convergence - Octopoda

Event Date & Location: November 7-16, 2025; Scottsdale, AZ

Codes and Referenced Standards

- 2018 International Building Code
- Aluminum Design Manual, 2015 ed.
- American Institute of Steel Construction, Steel Construction Manual 15th Edition
- American Society of Civil Engineers 7-16 (ASCE 7-16) "*Minimum Design Loads for Buildings and Other Structures*"
- American Society of Civil Engineers 37-14 (ASCE 37-14) "*Design Loads on Structures During Construction*"
- ANSI E 1.21-2013 "*Temporary Structures Used for Technical Production of Outdoor Entertainment Events*"
- ANSI E 1.2-2012 "*Manufacture and Use of Aluminum Trusses and Towers*"

Project Description

- Review of temporary structure for lateral and gravity loads.

Analysis Assumptions/Design Criteria

- A high wind action plan has been issued and must be strictly followed.
- All truss is F34 truss from Global Truss or equivalent.
- Truss secured to bridge via 3" ratchet strap.
- Clark Reder Engineering did not review the loads to the bridge or the truss connection to the bridge.
- Clark Reder Engineering scope of work limited to a review of the F34 truss for gravity loads only.
- Octopaus scenic element assumed to be free to swing.

General Design - Applies To All Assemblies

Steel/Aluminum Factors of Safety

Note: The following factors/design criteria applies to all assemblies and will be used throughout design package (U.N.O).

AISC Typical Factors of Safety (U.N.O.): $\Omega_{y.AISC} := 1.67$ $\Omega_{r.AISC} := 2.0$

ADM Typical Factors of Safety (U.N.O.): $\Omega_{y.ADM} := 1.65$ $\Omega_{r.ADM} := 1.95$

ASTM A36 Mechanical Properties

Yield Strength: $F_{y.A36} := 36\text{ksi}$

Tensile Strength: $F_{u.A36} := 58\text{ksi}$

ASTM A572 Mechanical Properties

Yield Strength: $F_{y.A572} := 50\text{ksi}$

Tensile Strength: $F_{u.A572} := 65\text{ksi}$

ASTM A500 GR. B (Rectangular) Mechanical Properties

Yield Strength: $F_{y.A500.rect} := 46\text{ksi}$

Tensile Strength: $F_{u.A500.rect} := 58\text{ksi}$

ASTM A500 GR. B (Round) Mechanical Properties

Yield Strength: $F_{y.A500.rd} := 42\text{ksi}$

Tensile Strength: $F_{u.A500.rd} := 58\text{ksi}$

ASTM A992 Mechanical Properties

Yield Strength: $F_{y.A992} := 50\text{ksi}$

Tensile Strength: $F_{u.A992} := 65\text{ksi}$

Weld (Steel) Mechanical Properties

Weld Strength: $F_{weld} := 70\text{ksi} \cdot 0.6 = 42.00\text{-ksi}$

Grade 8 Bolt Mechanical Properties

Tensile Strength of Bolt: $F_{u.bolt} := 150\text{ksi}$

6061-T6 Mechanical Properties

Unwelded

Welded

Tension Ultimate Stress: $F_{tu} := 38\text{ksi}$

$F_{tuw} := 24\text{ksi}$

Tension Yield Stress: $F_{ty} := 35\text{ksi}$

$F_{tyw} := 15\text{ksi}$

Compression Yield Stress: $F_{cy} := 35\text{ksi}$

$F_{cyw} := 15\text{ksi}$

Shear yield stress: $F_{sy} := 0.6 \cdot F_{ty} = 21.00\text{-ksi}$

$F_{syw} := 0.6 \cdot F_{tyw} = 9.00\text{-ksi}$

Ultimate shear stress: $F_{su} := 24\text{ksi}$

$F_{suw} := 15\text{ksi}$

Tension coefficient: $k_t := 1.0$

$k_{tw} := 1.0$

Applied Loads:

Seismic Loads - Per ASCE 37-14 & ASCE 7-16 (Chapter 12/15)

6.5 EARTHQUAKE

If required by Section 6.5.1 and not exempted by Section 6.5.3, earthquake loads shall be calculated in accordance with procedures in ASCE/SEI 7-10 as modified by Section 6.5.2. All structures shall be treated as Risk Category II, per Table 1.5-1 of ASCE/SEI 7-10, regardless of the group classification of the completed structure.

6.5.1 Applicability Earthquake loads need not be considered unless required by the authority having jurisdiction and the mapped Risk-Targeted MCE_R , 5% damped, spectral response acceleration parameter at a period of 1 s, S_1 , defined in Section 11.4.1 of ASCE/SEI 7-10 equals or exceeds 0.40.

6.5.2 Use of ASCE/SEI 7-10 For use of the earthquake load provisions of ASCE/SEI 7-10, the following modifications should be made:

1. The mapped values for S_S and S_1 may be multiplied by a factor less than 1 to represent the reduced exposure period, but the factor shall not be less than 0.20.
2. The restrictions on types of structural systems in seismic performance categories D and E do not apply, as long as the height of the temporary bracing system designed in accordance with this section is limited in height to 60ft (18.3m) or five stories, whichever is less, above the completed bracing of the permanent structure.

Seismic

S_S	0.191
S_1	0.067
F_a	1.6
F_v	2.4
S_{MS}	0.306
S_{M1}	0.161
S_{DS}	0.204
S_{D1}	0.108
T_L	6
PGA	0.084
PGA_M	0.135
F_{PGA}	1.6
I_e	1
C_v	0.7
Seismic Design Category	B

Seismic Analysis - ASCE 37-14 & ASCE 7-16 (Chapter 12/15)

Site coefficients per ASCE 7-16, Site Class D assumed

Mapped MCE, 5% damped, spectral response, acceleration parameter at short periods: $S_S := 0.191$

Mapped MCE, 5% damped, spectral response, acceleration parameter at 1s: $S_1 := 0.067$

Design 5% damped, spectral response, acceleration parameter at short periods: $S_{DS} := 0.204$

Design 5% damped, spectral response, acceleration parameter at 1s: $S_{D1} := 0.108$

Per ASCE 37-14, does seismic need to be considered?

Consider_seismic := $\begin{cases} \text{"NO"} & \text{if } S_1 < 0.4 \\ \text{"YES"} & \text{otherwise} \end{cases}$

Consider_seismic = "NO"

If seismic is required to be considered:

Temporary reduction coefficient as allowed by ASCE 37-14 (minimum value = 0.2): $red_{eq} := 0.2$

[ASCE 37-14, Section 6.5.2.3:](#)

Response modification factor: $R_{eq} := 2.5$

3. The R factor used for temporary bracing systems shall not exceed 2.5 unless the system is detailed in accordance with the provisions of ASCE/SEI 7-10. Where R = 2.5 is used, only the requirements dealing with the strength of the seismic-resisting structural system need be satisfied.

Importance factor/Risk Category II: $I_e := 1.0$

Structural height (FT): $h_n := 20$

Approximate period parameters (Table 12.8-2, Page 90): $C_t := 0.02$

Long period transition period (Figure 22-12, Page 224): $T_L := 12$

Approximate Fundamental Period: $T_a := C_t \cdot h_n^{.75} = 0.19$

Modified spectral responses with reduction coefficient: $S_{S_mod} := S_S \cdot red_{eq} = 0.04$

$S_{DS_mod} := S_{DS} \cdot red_{eq} = 0.04$

$S_{1_mod} := S_1 \cdot red_{eq} = 0.01$

$S_{D1_mod} := S_{D1} \cdot red_{eq} = 0.02$

Seismic response coefficient:

$$C_{s,calc} := \min \left[\frac{S_{DS_mod}}{\left(\frac{R_{eq}}{I_e} \right)}, \left. \begin{array}{l} \frac{S_{D1_mod}}{T_a \cdot \left(\frac{R_{eq}}{I_e} \right)} \text{ if } T_a \leq T_L \\ \frac{S_{D1_mod} \cdot T_L}{T_a^2 \cdot \left(\frac{R_{eq}}{I_e} \right)} \text{ if } T_a > T_L \end{array} \right] = 0.016$$

$$C_{s,min} := \left. \begin{array}{l} \max(0.044 \cdot S_{DS_mod} \cdot I_e, 0.01) \text{ if } S_1 < 0.6 \\ \max\left(0.044 \cdot S_{DS_mod} \cdot I_e, 0.01, \frac{0.5 \cdot S_{1_mod}}{\frac{R_{eq}}{I_e}}\right) \text{ if } S_1 \geq 0.6 \end{array} \right] = 0.010$$

$$C_s := \left. \begin{array}{l} 0 \text{ if Consider_seismic} = \text{"NO"} \\ \max(C_{s,calc}, C_{s,min}) \text{ otherwise} \end{array} \right] \quad C_s = 0.000$$

Vertical seismic load effect:

$$EQ_v := \left. \begin{array}{l} 0 \text{ if Consider_seismic} = \text{"NO"} \\ 0.2 \cdot S_{DS_mod} \text{ otherwise} \end{array} \right] \quad EQ_v = 0.000$$

NOTE: WIND LOADS WILL GOVERN SO SEISMIC LOADS CAN BE IGNORED.

Gravity Loads

Weight of Octopada: $wt_{octopada} := 200\text{lb}$

Rigging Information

Length of Span: $l_{span} := 24\text{ft}$

Truss Checks:

F34 Global Truss:

Note: Allowable strengths will be determined from load tables provided by client.

GLOBAL TRUSS F34 LOAD SPAN TABLE									
Limited based on Strength and Reduced per ANSI E1.21									
TRUSS SPAN		UNIFORMLY DISTRIBUTED LOAD (UDL)		CENTER POINT LOAD (CPL)		THIRD POINT LOADS (TPL)		QUARTER POINT LOADS (QPL)	
METERS	FEET	LOAD (PLF)	DEFLECTION (IN)	LOAD (LBS)	DEFLECTION (IN)	LOAD (LBS)	DEFLECTION (IN)	LOAD (LBS)	DEFLECTION (IN)
2	6.56	230	0.06	1360	0.09	810	0.08	510	0.07
2.5	8.2	202	0.12	1265	0.14	765	0.14	505	0.14
3	9.84	174	0.18	1170	0.20	725	0.21	500	0.21
3.5	11.48	147	0.24	1075	0.25	680	0.27	490	0.28
4	13.12	119	0.30	980	0.30	640	0.34	485	0.35
4.5	14.76	107	0.43	905	0.39	595	0.44	455	0.47
5	16.41	94	0.56	830	0.47	555	0.54	420	0.58
5.5	18.05	82	0.69	755	0.56	510	0.64	390	0.70
6	19.69	70	0.82	680	0.65	470	0.74	355	0.81
6.5	21.33	61	0.94	640	0.77	450	0.91	330	0.94
7	22.97	53	1.06	595	0.89	435	1.09	305	1.07
7.5	24.61	45	1.18	555	1.01	415	1.27	280	1.19
8	26.25	37	1.3	510	1.13	400	1.45	255	1.32

[Global Truss Tables](#)

Note: Maximum moment and shear on truss will be extracted from table.

Bending Moment Capacity:

Uniform Loads: $w_{\text{uniform}} := \begin{pmatrix} 174 \\ 107 \\ 70 \\ 45 \end{pmatrix} \text{ plf}$ $l_{\text{truss}} := \begin{pmatrix} 9.84 \\ 14.76 \\ 19.69 \\ 24.61 \end{pmatrix} \text{ ft}$ $i := 1..4$

Maximum Allowable Moment: $M_{\text{max}_i} := \frac{w_{\text{uniform}_i} \cdot (l_{\text{truss}_i})^2}{8}$

$M_{\text{max}} = \begin{pmatrix} 2.11 \\ 2.91 \\ 3.39 \\ 3.41 \end{pmatrix} \cdot \text{kip} \cdot \text{ft}$

Allowable Maximum Moment (Design): $M_{\text{max.design}} := \max(M_{\text{max}}) = 3.41 \cdot \text{kip} \cdot \text{ft}$

Shear Capacity:

Uniform Loads: $w_{\text{uniform}} := (202) \text{ plf}$ $l_{\text{truss}} := (8.2) \text{ ft}$ $i := 1$

Maximum Allowable Shear: $V_{\text{max}_i} := \frac{w_{\text{uniform}_i} \cdot l_{\text{truss}_i}}{2}$

$V_{\text{max}} = (0.83) \cdot \text{kip}$

Allowable Maximum Shear (Design): $V_{\text{max.design}} := \max(V_{\text{max}}) = 0.83 \cdot \text{kip}$

Utilization Checks:

Maximum Bending in Truss: $M_{\text{actual}} := \frac{w_{\text{truss}} \cdot l_{\text{span}}}{4} = 1.20 \cdot \text{kip} \cdot \text{ft}$

Utilization Percentage: $\%_{\text{util}} := \frac{M_{\text{actual}}}{M_{\text{max.design}}} = 35.22\%$

Maximum Shear in Truss: $V_{\text{actual}} := 0.5 \cdot w_{\text{truss}} = 100.00 \text{ lbf}$

Utilization Percentage: $\%_{\text{util}} := \frac{V_{\text{actual}}}{V_{\text{max.design}}} = 12.07\%$



APPENDIX C

ORIGINAL ENGINEERING REPORT

09.08.22



Unit 3/1-7 Jabez St,
Marrickville NSW 2204

ATTENTION: Simone Chua & Daniel Rodriguez

**STRUCTURAL DESIGN AND INSPECTION CERTIFICATE FOR
TEMPORARY STRUCTURES**

EVENT: Hurstville Activation
STRUCTURE: 5.5m(H) x 5.8m (W) Truss Frame
with Suspended /Steel and Acrylic Octopus
LOCATION: Westfield Hurstville Plaza, 3 Cross St, Hurstville NSW 2220
DURATION: 12th August – 23rd August 2022

We Event Engineering, being professional Chartered Structural Engineers within the meaning of the National Construction Code (NCC) of Australia, confirm that we have been appointed as the engineers responsible for the Structural Certification of the above project. We certify that the design, subject to the limitations listed within this certificate, is in accordance with the relevant provisions of the standard building codes of Australia, accepted engineering practice and principles and the design methods for *Temporary Demountable Structures* as per the *Guidance on Procurement, Design and Use of Temporary Demountable Structures* (Institution of Structural Engineers, 2017).

We advise that the maximum design 3 second wind gust speed for the above structures is 25m/s, in accordance with the minimum requirements set forth by AS1170.2:2011 (Clause 2.3. Should the wind speed approach this speed, the safety steps identified within this certificate must be implemented.

We also certify that we have carried out an inspection of the structural elements for the above installation on **09.08.22**, and confirm that the installation complied with the design as specified in this certificate and our site instructions. We note that this certification is effective only for the dates specified and that further review and certification will be required if the design is modified in any way. This certificate shall not be construed as relieving any other party of their responsibilities, liabilities or contractual obligations. This certificate is applicable only for this installation and relies upon all other risk assessments, WHS requirements and job safety statements associated with this project.

Damian Ferrari
B.Eng (Civil) (Hons)
GradIEAust
STRUCTURAL ENGINEER

Morgan Sheehy
MEng (Hons I) Tech Cert Eng (Civil)
MIEAust CPEng NER 3468223 (Civil & Structural)
APEC Engineer IntPE(Aus) RPEQ 14767
PE 657 (Civil Engineer)
SENIOR ENGINEER

1. **REFERENCED STANDARDS**

- 1.1. **ABCB:2015** Temporary Structures Standard;
- 1.2. **AS1170.0:2002** General principles;
- 1.3. **AS1170.1:2002** Permanent, imposed and other actions;
- 1.4. **AS1170.2:2011** Wind actions;
- 1.5. **AS1576.1:2010** Scaffolding;
- 1.6. **AS1664.1:1997** Aluminium structures;
- 1.7. **AS3600:2018** Concrete Structures;
- 1.8. **AS4100:1998** Steel Structures;
- 1.9. **IStructE:2017** Temporary Demountable Structures.

2. **ATTACHMENTS**

Att. No.	Title Reference	Issued By	Pages
1	Octapoda GA	Amigo & Amigo Marked by EE	6

3. **DESIGN LIMITATIONS & REQUIREMENTS**

3.1. **Maximum Loading:**

3.1.1. **Dead:**

- 3.1.1.1. Self-weight and 40kg in each steel drum;

3.1.2. **Live:**

- 3.1.2.1. No live loading permitted;
- 3.1.2.2. Personnel to monitor installation to prevent the public from climbing, hanging and otherwise loading the installation;

3.2. **Minimum Ballast:**

- 3.2.1. **Octopoda:** 40kg sandbag within each steel drum;
- 3.2.2. **Truss:** 2,000kg per upright (4,000kg total)

3.3. **Member Specifications:**

- 3.3.1. Global F44 truss arch;

3.4. **Minimum Fixings:** As per manufacturer's specifications;

3.5. **Rubber Matting:** Rubber matting to be provided under bases when located on hardstand;

3.6. **Catenary Loading:** No catenaries to be fixed to structures;

3.7. **Rigging:** Certified rigging technicians must install and sign-off on all rigging;

3.8. **Bearing Capacity:** Minimum bearing capacity shall be 100kPa;

3.9. **Spreader Plates:** To be provided beneath all structural support struts;

3.10. **Workshop Drawings:** Shall be submitted for engineer's written approval prior to modifications;

3.11. **Wind Management Plan:**

- 3.11.1. The wind speed must be measured on site by an anemometer or the nearest weather station;

- 3.11.2. If the wind speed approaches 20m/s, personnel must go on standby to implement an evacuation;

3.11.3. If the wind speed approaches 22m/s, all non-essential personnel must be evacuated;

3.11.4. If the wind speed approaches 25m/s, all structures must be abandoned and all personnel moved within a permanent structure of importance level 2-4 as specified within the BCA;

3.12. Operational Safety:

3.12.1. Event Engineering is not responsible for the operational safety of the structure and the public;

3.12.2. We have been engaged for structural engineering compliance, not how the end user engages with the structure, that is solely the responsibility of the client and event organiser.

4. SITE INSPECTION


Event Engineering: Damian Ferrari
Site Contact: Daniel Rodrigeuz


Elements Inspected:


Elements Inspected:	Comments:
4.1. General Arrangement:	OK;
4.2. Truss:	OK;
4.3. Cables:	OK;
4.4. Connections:	OK;
4.5. Base Plates:	OK;
4.6. Ballast:	OK;
4.7. Rigging Specifications:	OK;
4.8. Rigging:	Tri-Point Rigging

5. PHOTOGRAPHIC REFERENCE


Refer to overleaf

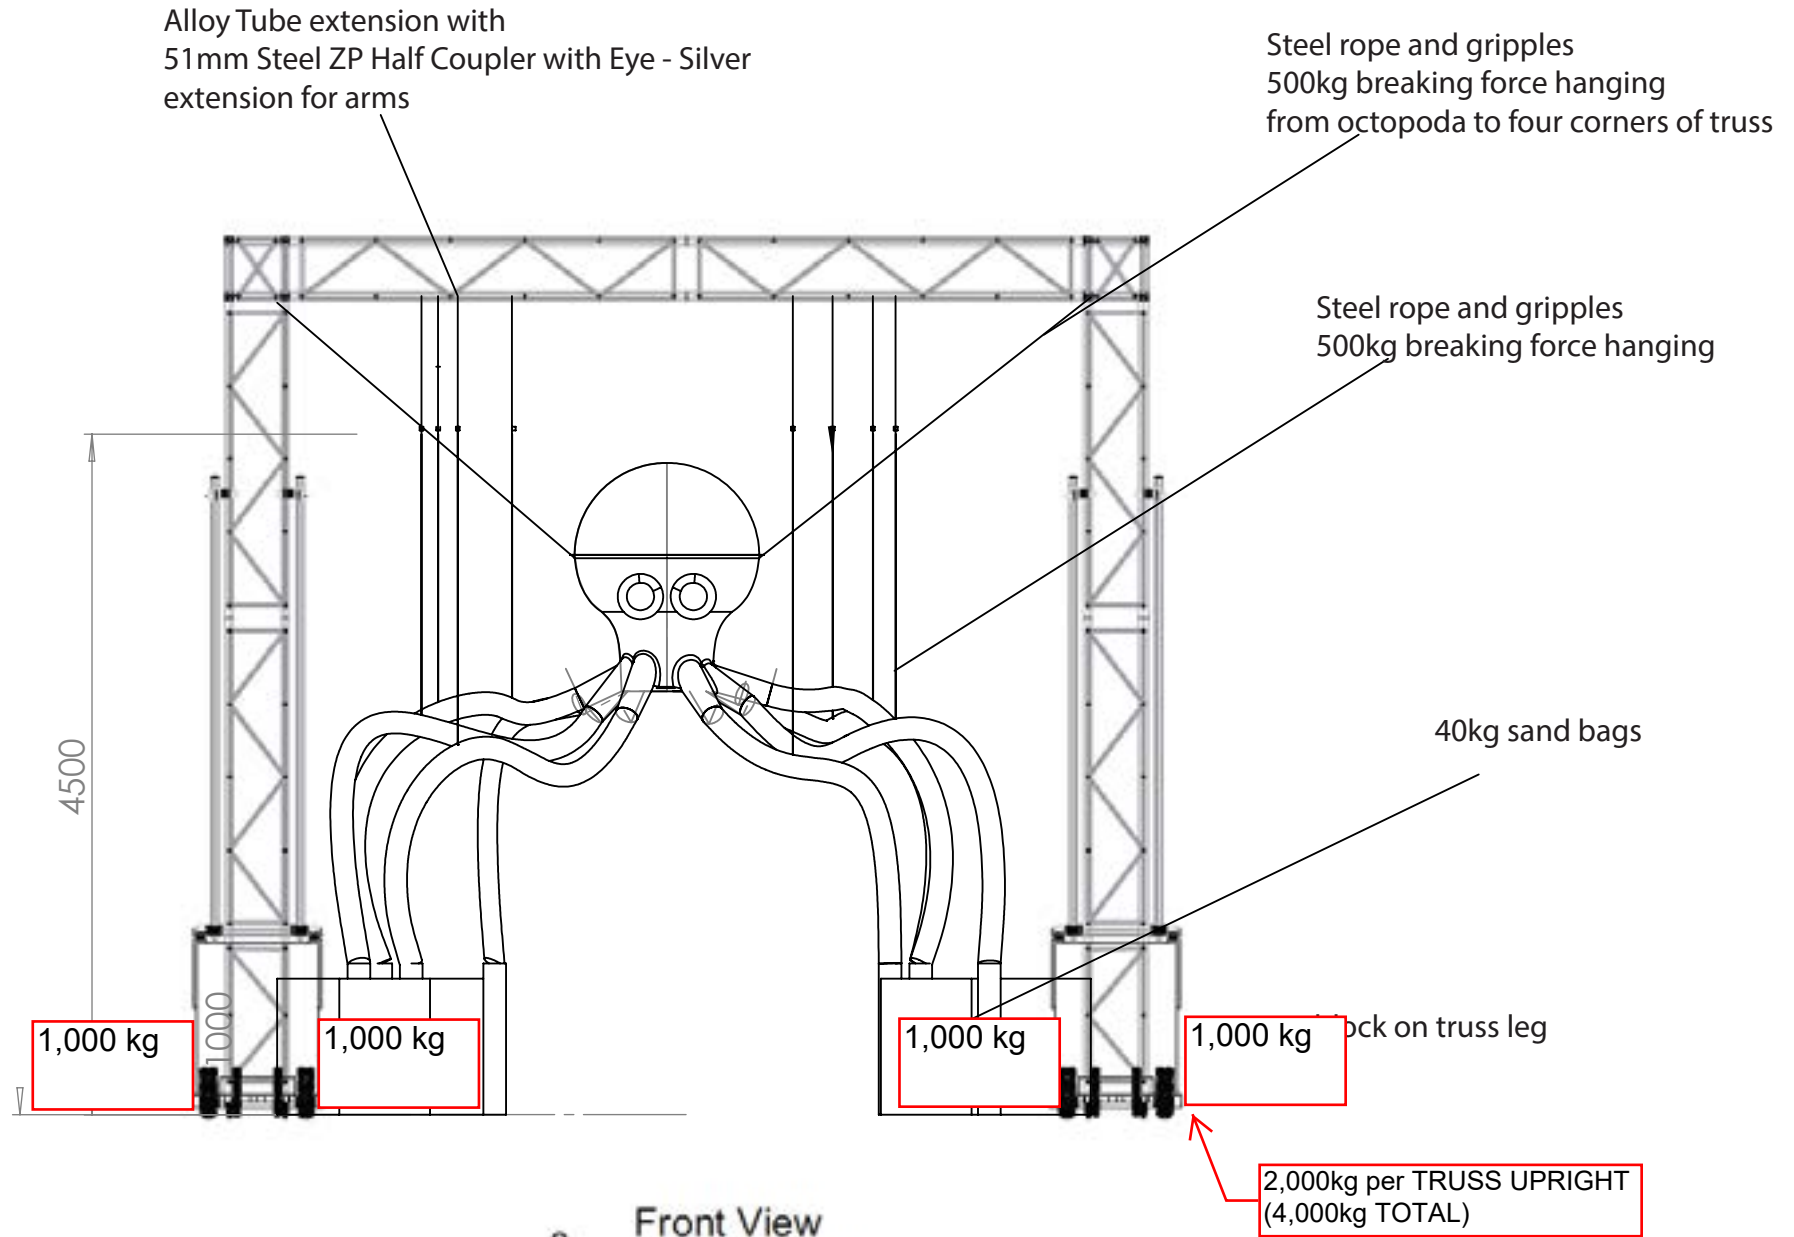

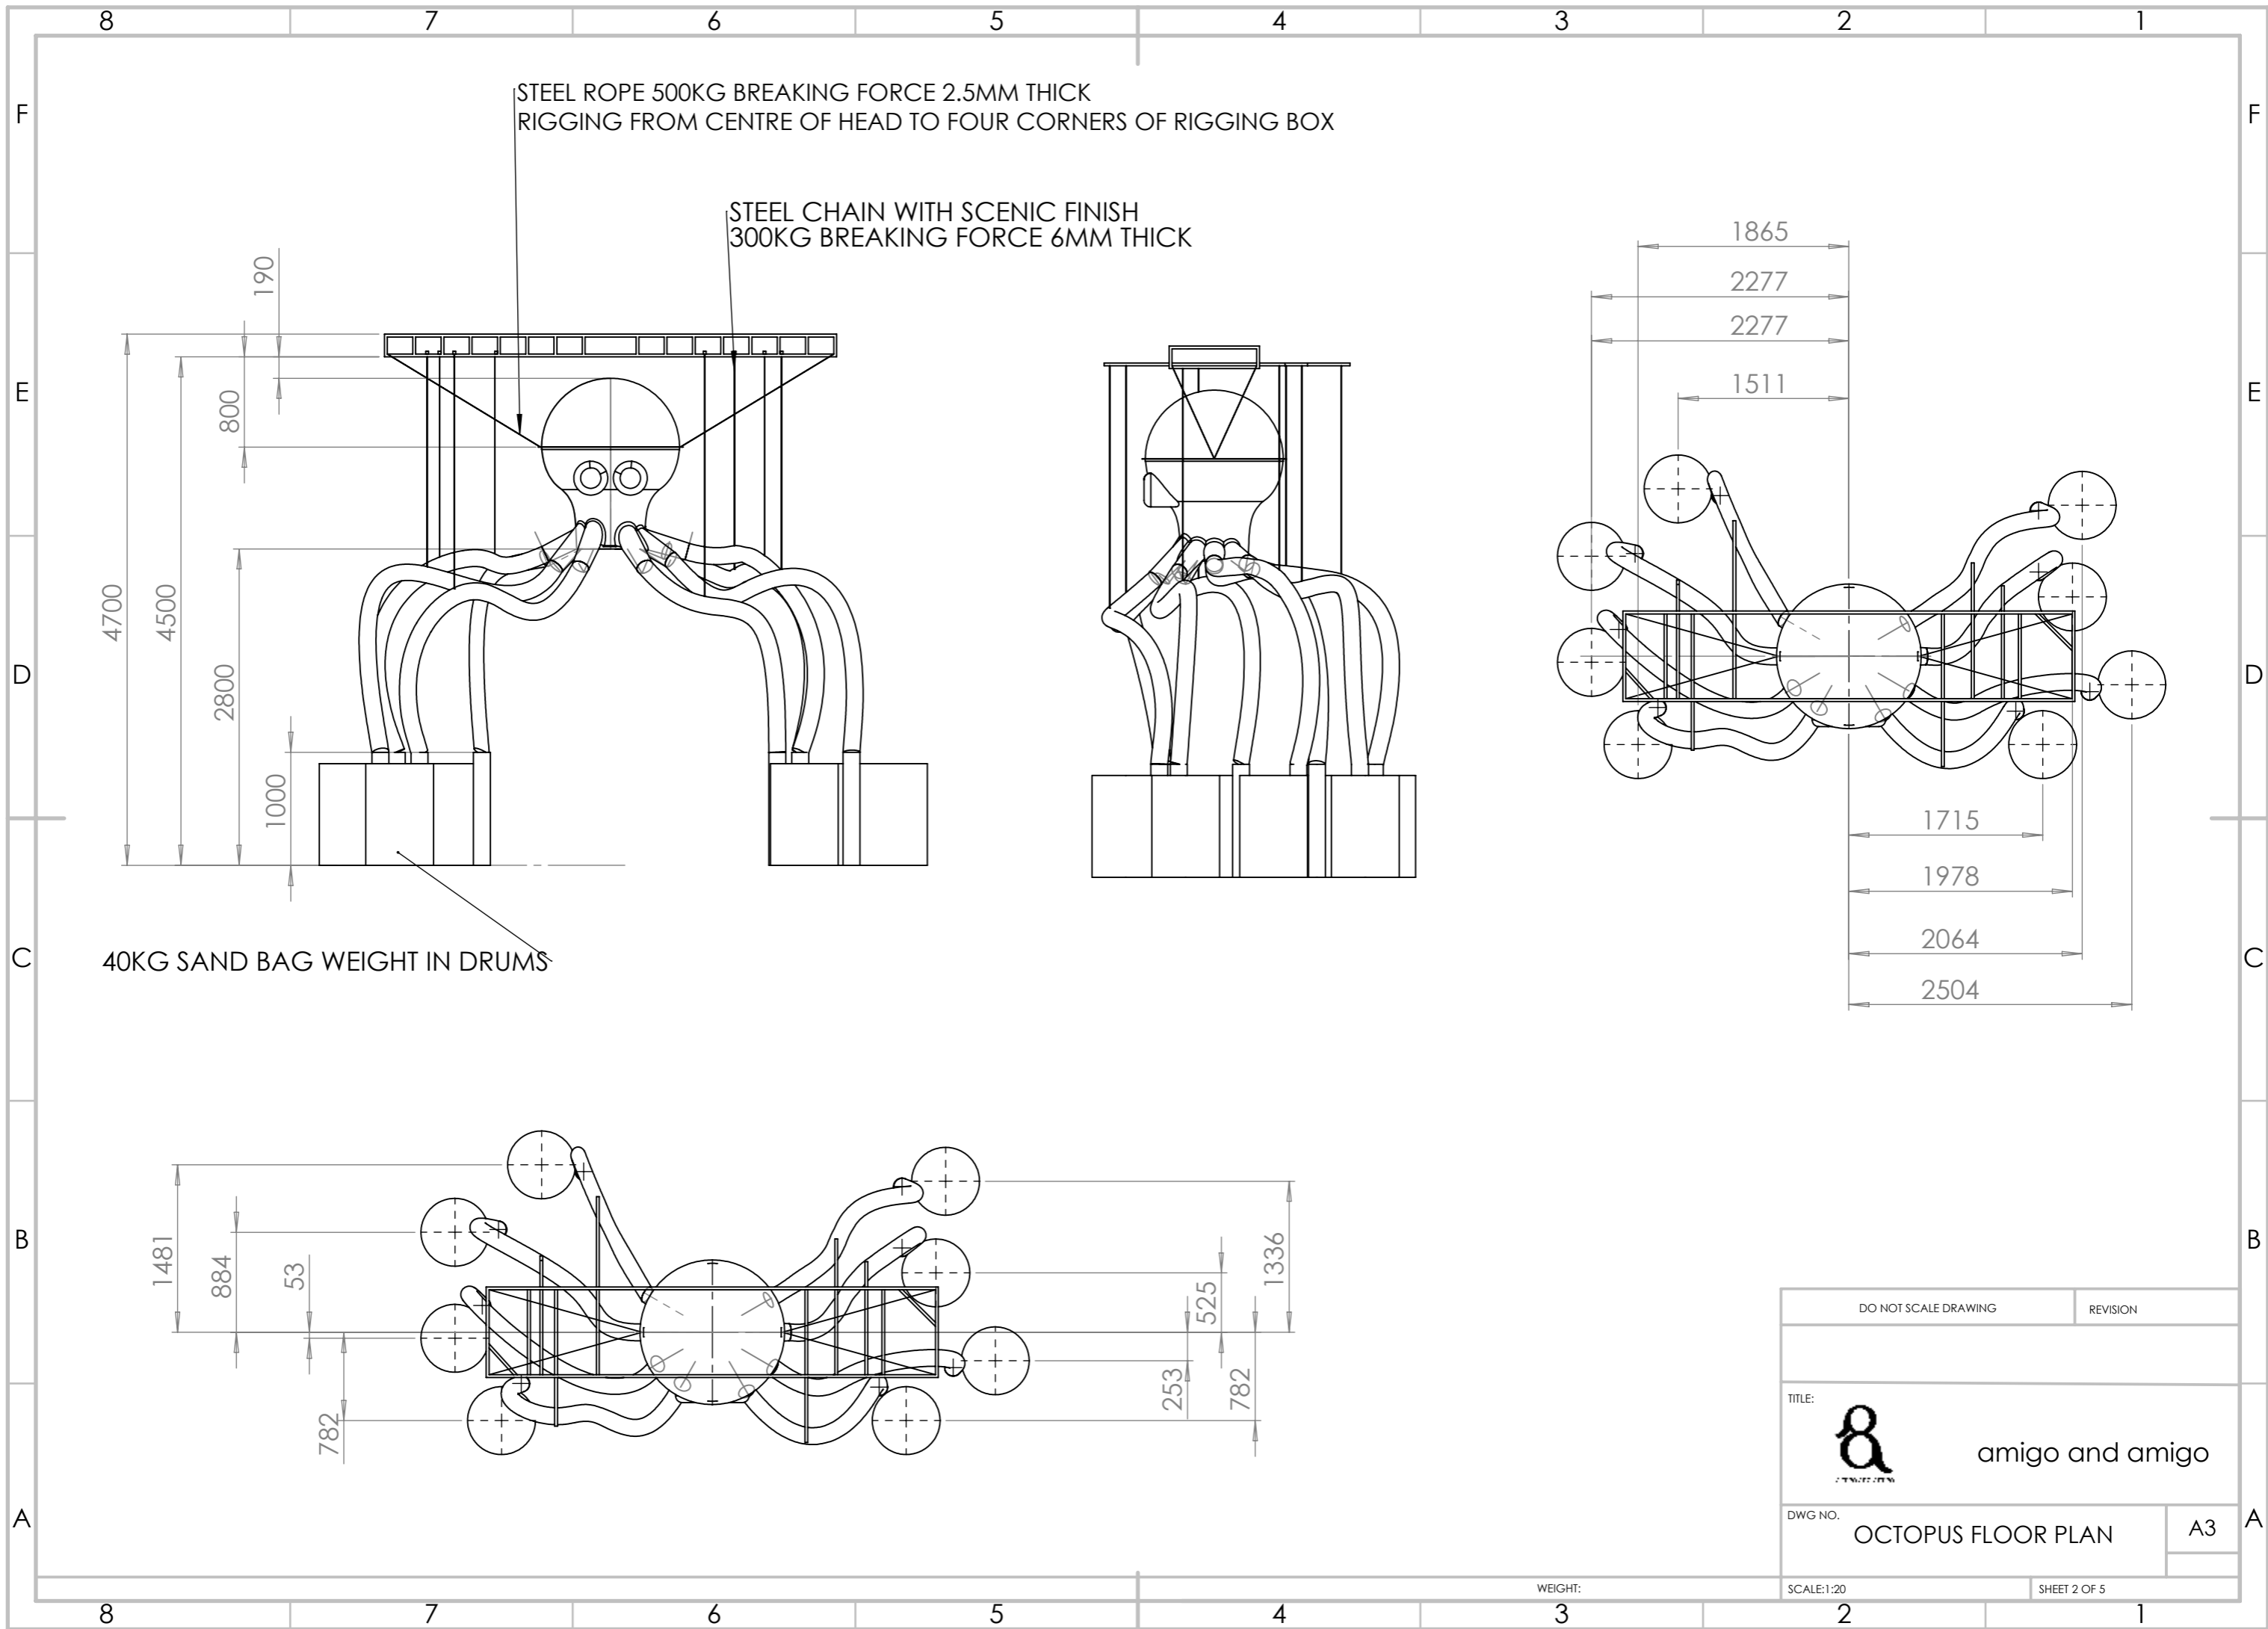


DO NOT SCALE DRAWING		REVISION
TITLE:		
		amigo and amigo
DWG NO.		A3
OCTOPUS FLOOR PLAN		
SCALE: 1:20	SHEET 2 OF 5	

WEIGHT:

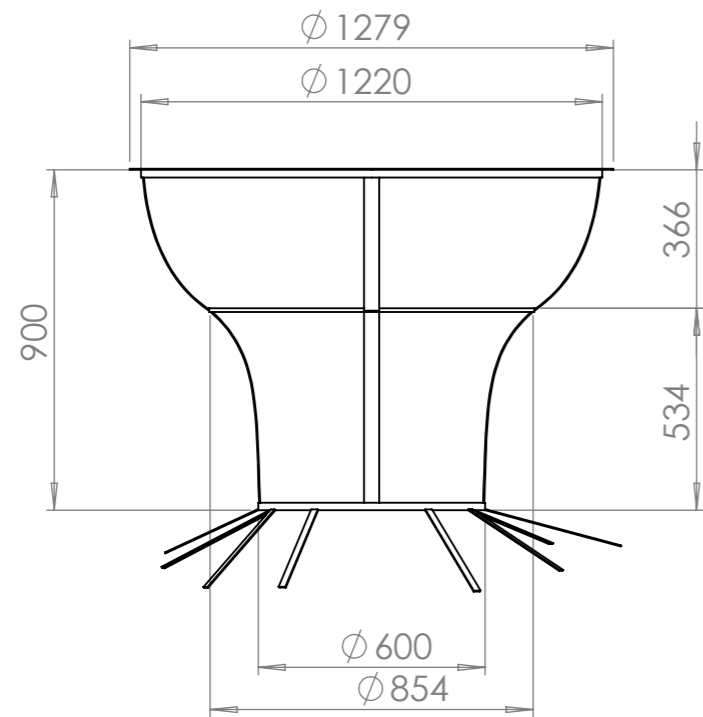

- L1 - 115dg
370 long
- L2 - 120 DG
270 LONG
- L3 - 140 DG
290 LONG
- L4 - 160 DG
270 LONG
- L5 - 150 DG
335 LONG
- L6 - 125DG
320 LONG
- L7 - 115 DG
370LONG
- L8 - 105 DG
262 LONG


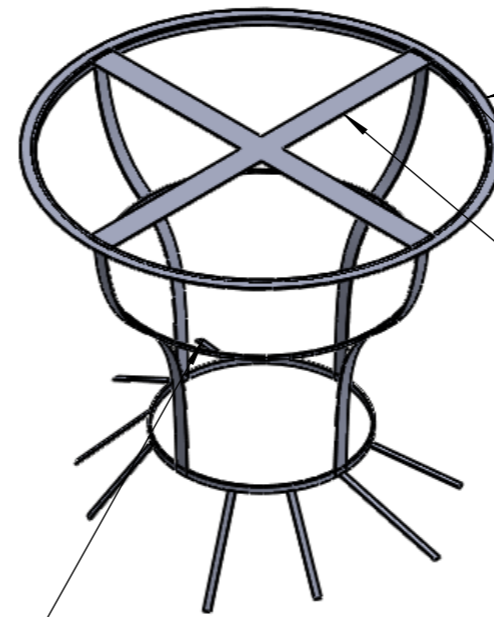



ROLLED CHS

LIP SECTION FOR ACRYLIC FIXINGS


CROSS SECTION FOR INSIDE BRAIN LIGHT DETAIL

FIXINGS ON LIP TO ATTACH STEEL ROPE 500KG BREAKING FORCE FOR HANGING

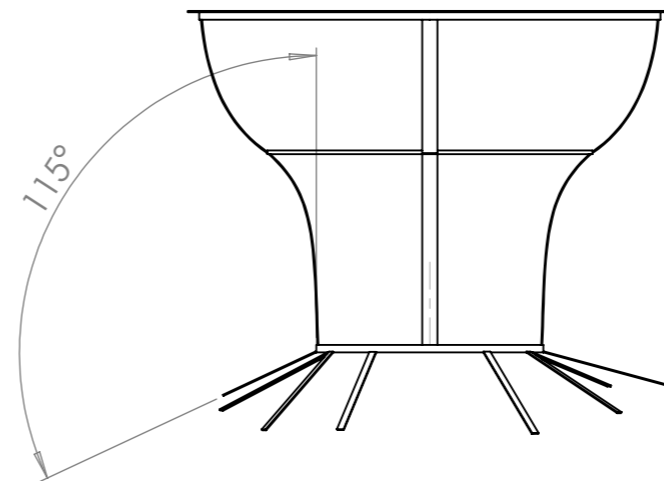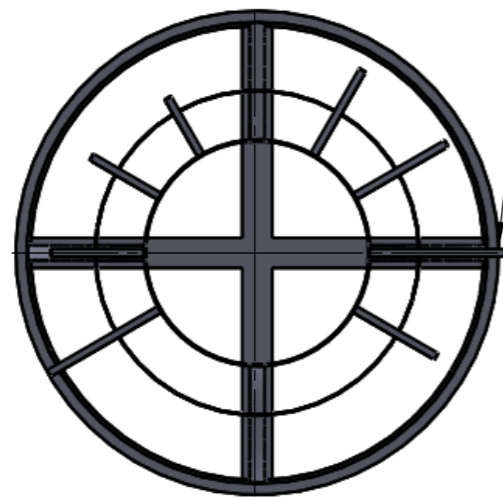

DO NOT SCALE DRAWING		REVISION
TITLE:		
		amigo and amigo
DWG NO.		A3
OCTOPUS ARMATURE GA		
SCALE:1:20	SHEET 3 OF 5	


WEIGHT:

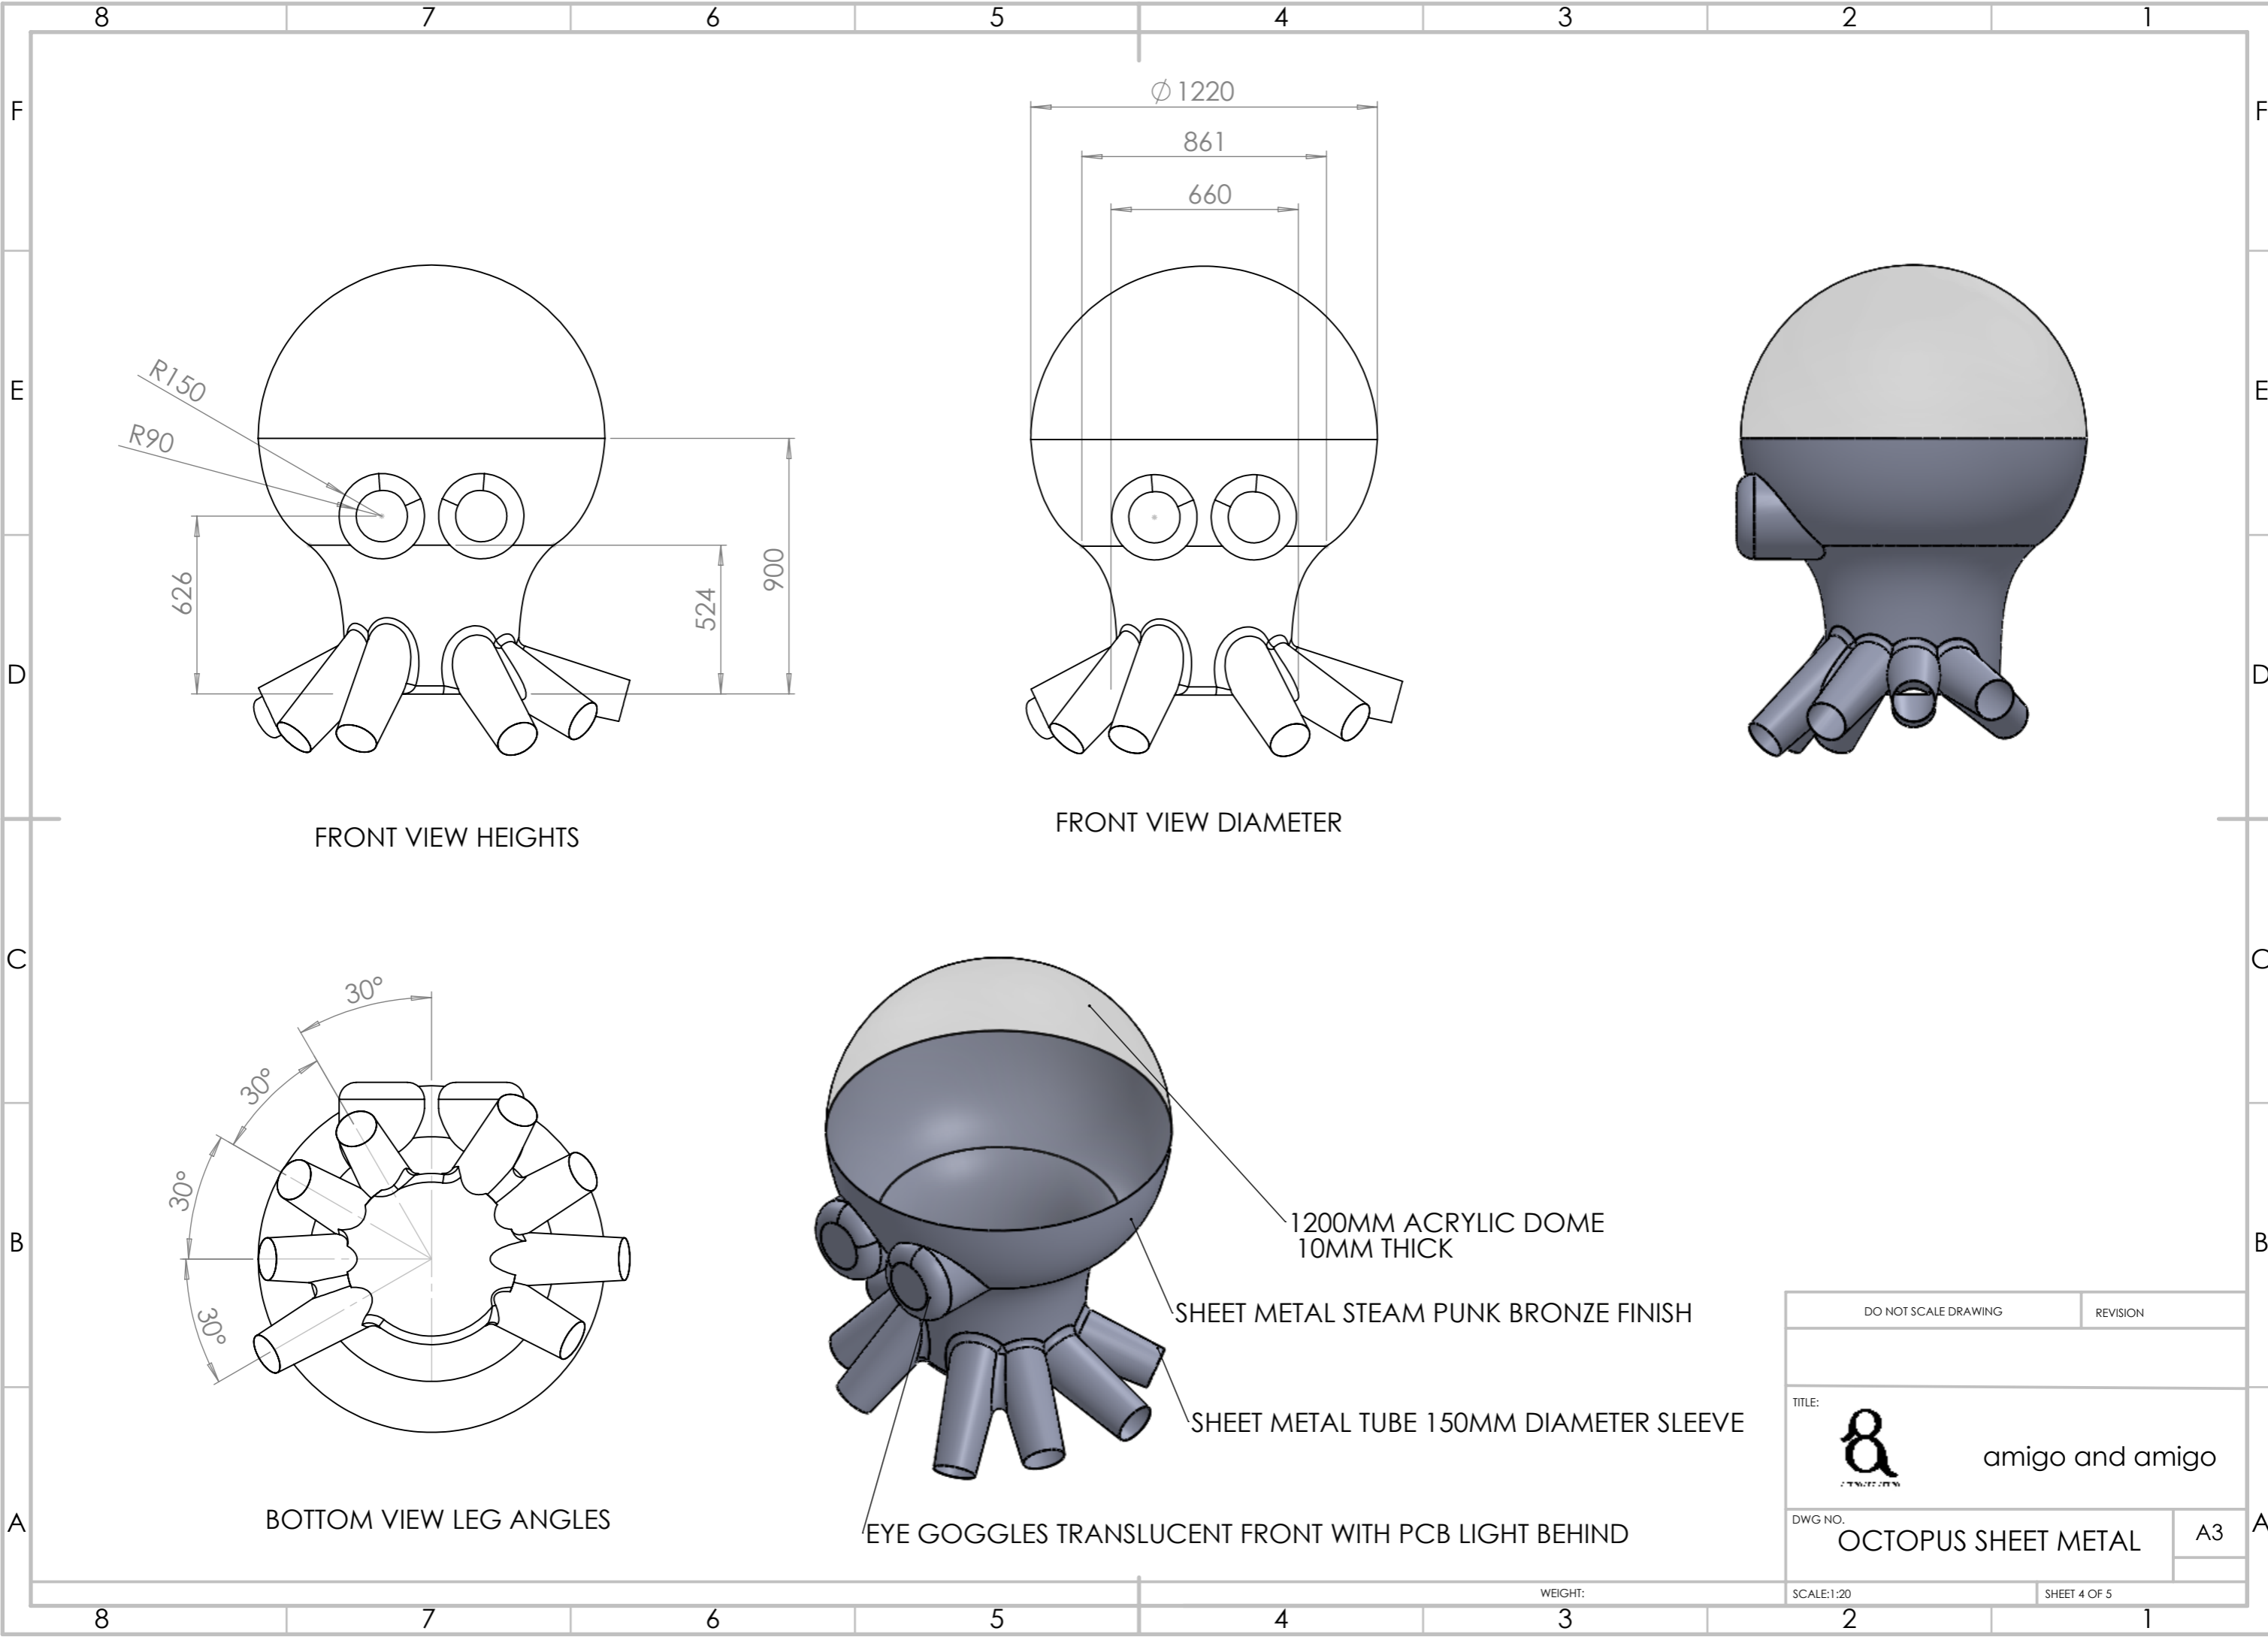



FRONT VIEW HEIGHTS

FRONT VIEW DIAMETER

BOTTOM VIEW LEG ANGLES

DO NOT SCALE DRAWING		REVISION
TITLE:		
 amigo and amigo		
DWG NO.	OCTOPUS SHEET METAL	A3
SCALE:1:20	SHEET 4 OF 5	

WEIGHT:

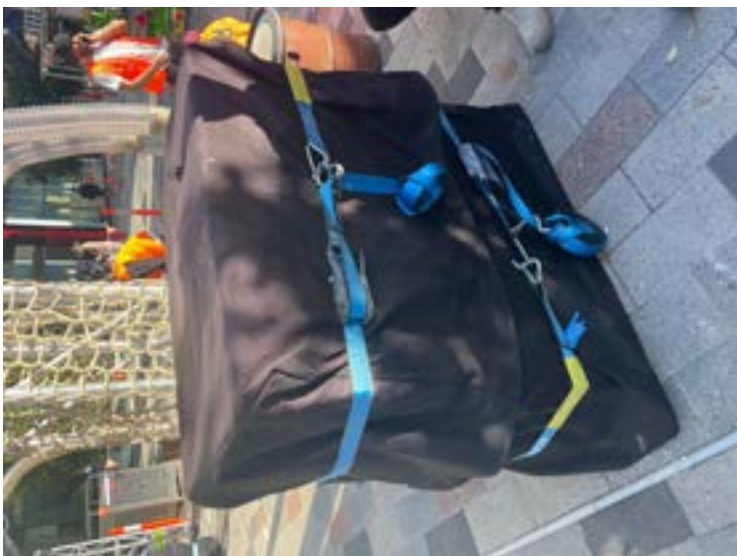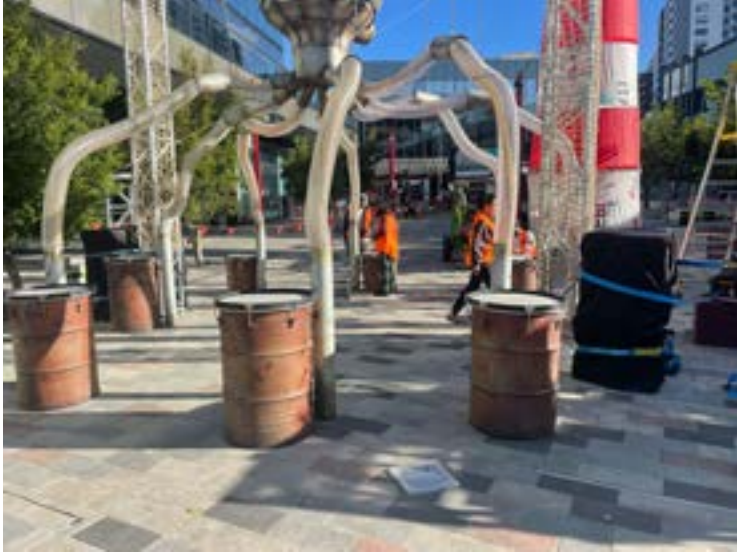



STRUCTURAL SUBMITTAL PACKAGE

for

Big Art

BIG TV

Project Location: Varies

Event Dates: Varies (installation shall not exceed 1 week)

Submittal Date: 9/9/2025


Clark Reder Project Number: 25.401.197








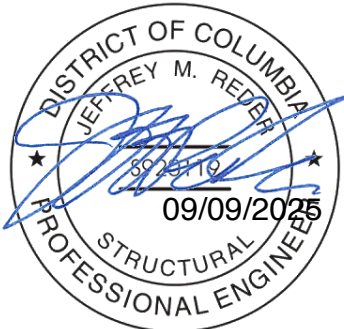
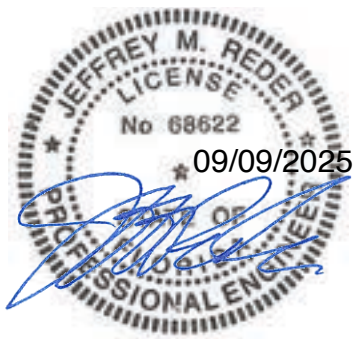
Reviewed by:

Prepared by:

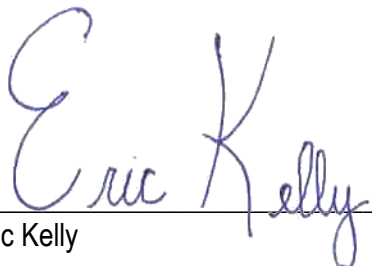

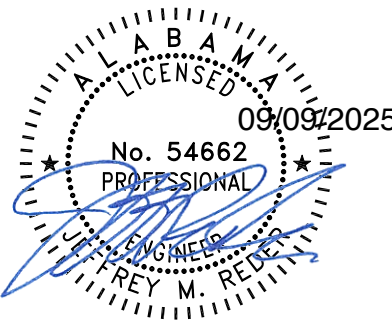Jeffrey M. Reder, P.E.
CA Registration #: C70581


Eric Kelly
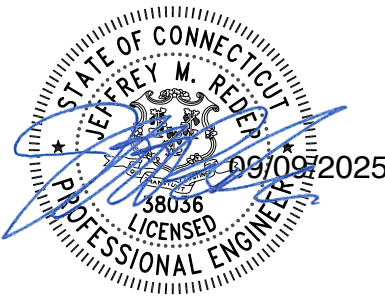
<p style="text-align: center;">Alabama</p>  <p style="text-align: center;">Jeffrey M. Reder, P.E. P.E. #: 54662</p>	<p style="text-align: center;">Arizona</p>  <p style="text-align: center;">Jeffrey M. Reder, P.E. P.E. # 50654</p>	<p style="text-align: center;">Arkansas</p>  <p style="text-align: center;">Jeffrey M. Reder, P.E. P.E. # 23061</p>
<p style="text-align: center;">California</p>  <p style="text-align: center;">Jeffrey M. Reder, C.E. P.E. # C 70581</p>	<p style="text-align: center;">Colorado</p>  <p style="text-align: center;">Jeffrey M. Reder, P.E. P.E. # PE0051394</p>	<p style="text-align: center;">Connecticut</p>  <p style="text-align: center;">Jeffrey M. Reder, P.E. P.E. # 38036</p>
<p style="text-align: center;">Delaware</p>  <p style="text-align: center;">Jeffrey M. Reder, P.E. P.E. # 17438</p>	<p style="text-align: center;">District of Columbia</p>  <p style="text-align: center;">Jeffrey M. Reder, P.E. P.E. # S920119</p>	<p style="text-align: center;">Florida</p>  <p style="text-align: center;">Jeffrey M. Reder, P.E. P.E. # 68622</p>






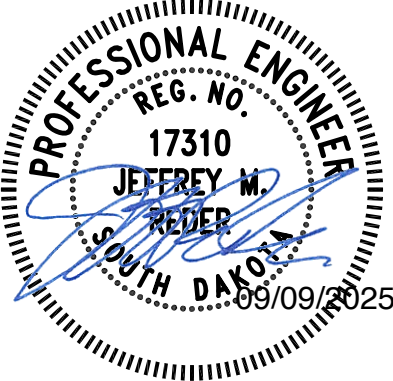

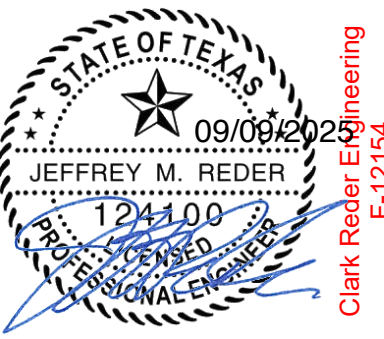
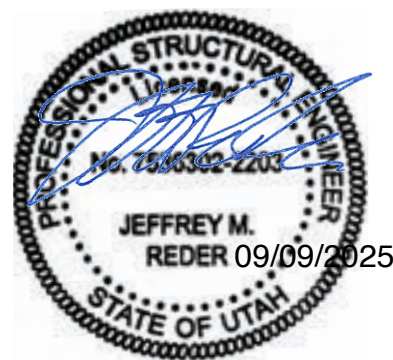
<p style="text-align: center;">Georgia</p>  <p style="text-align: center;">Jeffrey M. Reder, P.E. P.E. # PE034581</p>	<p style="text-align: center;">Hawaii</p>  <p style="text-align: center;">Jeffrey M. Reder, P.E. P.E. # 14362-S</p>	<p style="text-align: center;">Idaho</p>  <p style="text-align: center;">Jeffrey M. Reder, P.E. P.E. # 5561572</p>
<p style="text-align: center;">Illinois</p>  <p style="text-align: center;">Jeffrey M. Reder, S.E. P.E. # 81006866</p> <p style="color: red; font-size: small;">Clark Reder Engineering, Inc. is a professional design firm registered in Illinois #184.006693</p>	<p style="text-align: center;">Indiana</p>  <p style="text-align: center;">Jeffrey M. Reder, P.E. P.E. # PE11600603</p>	<p style="text-align: center;">Iowa</p>  <p style="text-align: center;">Jeffrey M. Reder, P.E. P.E. # 19998</p>
<p style="text-align: center;">Kansas</p>  <p style="text-align: center;">Jeffrey M. Reder, P.E. P.E. # 30951</p>	<p style="text-align: center;">Kentucky</p>  <p style="text-align: center;">Jeffrey M. Reder, P.E. P.E. # 23597</p>	<p style="text-align: center;">Louisiana</p>  <p style="text-align: center;">Jeffrey M. Reder, P.E. P.E. # 30304</p>

Project: BIG TV
 Client: Big Art

CRE Project #: 25.401.197
 Date: 09/09/2025
 Engineer: EPK

<p style="text-align: center;">Maine</p> <p style="text-align: center;">Jeffrey M. Reder, P.E. P.E. # 18919</p>	<p style="text-align: center;">Maryland</p> <p style="text-align: center;">Jeffrey M. Reder, P.E. P.E. # 38421</p> <p>Professional Certification: I hereby certify that these documents were prepared or approved by me, and that I am a duly licensed professional engineer under the laws of the State of Maryland, License # 38421, Expiration Date: 1/29/2025</p>	<p style="text-align: center;">Massachusetts</p> <p style="text-align: center;">Jeffrey M. Reder, P.E. P.E. # 48535</p>
<p style="text-align: center;">Michigan</p> <p style="text-align: center;">Jeffrey M. Reder, P.E. P.E. # 6201056952</p>	<p style="text-align: center;">Minnesota</p> <p style="text-align: center;">Jeffrey M. Reder, P.E. P.E. # 56104</p>	<p style="text-align: center;">Mississippi</p> <p style="text-align: center;">Jeffrey M. Reder, P.E. P.E. # 35564</p> <p style="color: red; font-size: small;">"I have reviewed this document in sufficient depth to accept full responsibility for its contents and to assure code compliance and coordination"</p>
<p style="text-align: center;">Missouri</p> <p style="text-align: center;">Jeffrey M. Reder, P.E. P.E. # PE-2010003345</p>	<p style="text-align: center;">Montana</p> <p style="text-align: center;">Jeffrey M. Reder, P.E. P.E. # 105461PE</p>	<p style="text-align: center;">Nebraska</p> <p style="text-align: center;">Jeffrey M. Reder, P.E. P.E. # E-20901</p>

<p style="text-align: center;">Nevada</p>  <p style="text-align: center;">Jeffrey M. Reder, P.E. P.E. # 020117</p>	<p style="text-align: center;">New Hampshire</p>  <p style="text-align: center;">Jeffrey M. Reder, P.E. P.E. # 18562</p>	<p style="text-align: center;">New Jersey</p>  <p style="text-align: center;">Jeffrey M. Reder, P.E. P.E. # 24GE05300600</p>
<p style="text-align: center;">New Mexico</p>  <p style="text-align: center;">Jeffrey M. Reder, P.E. P.E. # 30232</p>	<p style="text-align: center;">New York</p>  <p style="text-align: center;">Jeffrey M. Reder, P.E. P.E. # 097763-1</p> <p style="font-size: small;">It is a violation of law for any person, unless acting under the direction of a licensed professional engineer, to alter this document in any way. If any part of this document is altered, the altering engineer shall affix to this document their seal and the notation "altered by" followed by their signature, the date, and description.</p>	<p style="text-align: center;">North Carolina</p>  <p style="text-align: center;">Jeffrey M. Reder, P.E. P.E. # 046939</p>
<p style="text-align: center;">North Dakota</p>  <p style="text-align: center;">Jeffrey M. Reder, P.E. P.E. # PE-40952</p>	<p style="text-align: center;">Ohio</p>  <p style="text-align: center;">Jeffrey M. Reder, P.E. P.E. # E-67450</p>	<p style="text-align: center;">Oklahoma</p>  <p style="text-align: center;">Jeffrey M. Reder, P.E. P.E. # 24780</p>

<p style="text-align: center;">Oregon</p>  <p style="text-align: center;">Jeffrey M. Reder, P.E. P.E. # 93904PE</p>	<p style="text-align: center;">Pennsylvania</p>  <p style="text-align: center;">Jeffrey M. Reder, P.E. P.E. # PE77455</p>	<p style="text-align: center;">Rhode Island</p>  <p style="text-align: center;">Jeffrey M. Reder, P.E. P.E. # 9610</p>
<p style="text-align: center;">South Carolina</p>  <p style="text-align: center;">Jeffrey M. Reder, P.E. P.E. # 35797</p>	<p style="text-align: center;">South Carolina</p>  <p style="text-align: center;">Clark Reder Engineering P.E. # 4827</p>	<p style="text-align: center;">South Dakota</p>  <p style="text-align: center;">Jeffrey M. Reder, P.E. P.E. # 17310</p>
<p style="text-align: center;">Tennessee</p>  <p style="text-align: center;">Jeffrey M. Reder, P.E. P.E. # 00113846</p>	<p style="text-align: center;">Texas</p>  <p style="text-align: center;">Jeffrey M. Reder, P.E. P.E. # 124100</p> <p style="text-align: right; color: red;">Clark Reder Engineering F-12154</p>	<p style="text-align: center;">Utah</p>  <p style="text-align: center;">Jeffrey M. Reder, P.E. P.E. # 7536302-2203</p>

<p style="text-align: center;">Vermont</p>  <p style="text-align: center;">Jeffrey M. Reder, P.E. P.E. # 136107</p>	<p style="text-align: center;">Virginia</p>  <p style="text-align: center;">Jeffrey M. Reder, P.E. P.E. # 402061022</p>	<p style="text-align: center;">Washington</p>  <p style="text-align: center;">Jeffrey M. Reder, P.E. P.E. # 56469</p>
<p style="text-align: center;">West Virginia</p>  <p style="text-align: center;">Jeffrey M. Reder, P.E. P.E. # 18628</p>	<p style="text-align: center;">Wisconsin</p>  <p style="text-align: center;">Jeffrey M. Reder, P.E. P.E. # E-101335</p>	<p style="text-align: center;">Wyoming</p>  <p style="text-align: center;">Jeffrey M. Reder, P.E. P.E. # 13434</p>



Table of Contents for Structural Submittal Package

Cover Page	1
50 State Stamps	2-7
Table of Contents	8
Project Information	9
General Notes	10-11
Operations Management Plan	12
Reference Drawings	Appendix A
Calculations	Appendix B

Project Information

Project Summary

The project referenced by this submittal consists of a temporary aluminum truss structure. The structure will be used to support scenic cladding, as well as a video wall that is attached to (3) I-beams. The structure will be installed in various locations for various events, with each installation lasting approximately 1 week.

The structure is composed of 12" x 12" aluminum box truss from Unisson or equivalent. The I-beams are S4x7.7 beams and will be used to support a video wall that weighs approximately 1400 pounds. The video wall is attached via I-beam trolleys and will be free to move along the beam. Clark Reder Engineering did not review the structure for any dynamic loads but reviewed the structure for various loading conditions assuming a static load only.

Scope of Review

Clark Reder Engineering reviewed the structure for lateral and gravity loads. The structure was reviewed for 40mph wind speeds with scenic cladding attached to the truss and LED attached to the I-beams, as well as 67mph wind speeds on the bare structure.

No review was performed on the scenic elements or their attachment to the structure.

Conclusions

Our review has concluded that the structure meets the structural requirements of the 2021 International Building Code, National Building Code – 2023 Alberta Edition, ASCE 7-16, and ASCE 37-14.

Limitations and Exceptions

The scope of review for this submittal is limited to the items listed above. All other temporary or permanent structures on site not specifically referenced above under "Scope of Review" are the responsibility of others.

Where the items covered by this submittal are attached to existing structures, it is the responsibility of the engineer of record for those existing structures to review the impact of the elements referenced in this submittal.



GENERAL STRUCTURAL NOTES

EVENT DATE & LOCATION

1. EVENT DATE: VARIES
2. EVENT LOCATION: VARIES

CODES

1. 2021 INTERNATIONAL BUILDING CODE
2. NATIONAL BUILDING CODE – 2023 ALBERTA EDITION
3. ASCE 7-16: MINIMUM DESIGN LOADS AND ASSOCIATED CRITERIA FOR BUILDINGS AND OTHER STRUCTURES
4. ASCE 37-14: DESIGN LOADS ON STRUCTURES DURING CONSTRUCTION
5. 2020 ALUMINUM DESIGN MANUAL

REFERENCES

1. ANSI E1.21-2013 ENTERTAINMENT TECHNOLOGY, "TEMPORARY GROUND-SUPPORTED OVERHEAD STRUCTURES USED TO COVER THE STAGE AREAS AND SUPPORT EQUIPMENT IN THE PRODUCTION OF OUTDOOR ENTERTAINMENT EVENTS"
2. ANSI E1.2-2012 ENTERTAINMENT TECHNOLOGY, "DESIGN, MANUFACTURE AND USE OF ALUMINUM TRUSSES AND TOWERS"

DESIGN LOADS

1. DEAD LOAD: SELF-WEIGHT OF STRUCTURE
2. RIGGING LOADS: SEE ATTACHED DRAWINGS
3. WIND LOADS:
 - A. WIND RISK CATEGORY: II
 - B. BEFORE HIGH WIND ACTION PLAN IS ACTIVATED:
 1. DESIGN SERVICE-LEVEL WIND SPEED: 40 MPH
 2. EXPOSURE: C
 - C. AFTER HIGH WIND ACTION PLAN IS ACTIVATED:
 1. DESIGN SERVICE-LEVEL WIND SPEED: 67 MPH
 - a. REQUIRED WIND SPEED HAS BEEN REDUCED IN ACCORDANCE WITH ASCE 37-14 DUE TO THE TEMPORARY NATURE OF STRUCTURE
 2. EXPOSURE: C
 - D. SITE ELEVATION: 0 FT
 - E. REFERENCE THE HIGH WIND ACTION PLAN FOR SPECIFIC ACTIONS THAT SHALL BE TAKEN TO ENSURE STABILITY OF THE TEMPORARY STRUCTURE IN HIGH WINDS.
4. SEISMIC LOADS DO NOT CONTROL THE DESIGN OF THIS STRUCTURE.

CONSTRUCTION AND SAFETY

1. ENGINEER SHALL NOT BE RESPONSIBLE FOR MEANS, METHODS, OR SEQUENCE OF CONSTRUCTION UNLESS SPECIFICALLY STATED ON THE DRAWINGS.
2. ENGINEER HAS DESIGNED THE STRUCTURES FOR THEIR FINAL AS-BUILT CONDITION. ENGINEER IS NOT RESPONSIBLE FOR TEMPORARY STABILITY OF STRUCTURES DURING ERECTION UNLESS SPECIFICALLY STATED ON THE DRAWINGS.
3. STRUCTURE HAS BEEN DESIGNED AS A TEMPORARY STRUCTURE THAT SHALL BE IN PLACE FOR LESS THAN SIX WEEKS.

FOUNDATIONS

1. THE STRUCTURE IS ASSUMED TO BE FOUNDED ON LEVEL GROUND (CONCRETE, ASPHALT, GRASS, ETC) WITH A MINIMUM NET ALLOWABLE BEARING CAPACITY OF 1500 PSF.

BALLAST

1. BALLAST SHALL BE INSTALLED PER THE ENGINEERING DRAWINGS. DEVIATIONS IN WEIGHT OR PLACEMENT SHALL BE APPROVED IN WRITING BY THE ENGINEER OF RECORD.
2. BALLAST SHALL NOT BE INSTALLED ON GRAVEL, ICE, GRASS, SLOPING OR OTHERWISE UNSTABLE TERRAIN UNLESS MEANS TO PREVENT SLIDING ARE PROVIDED.
3. BALLAST AMOUNTS GIVEN CONSIDER UPLIFT AND SLIDING, WITH A MINIMUM 1.5 FACTOR OF SAFETY AGAINST OVERTURNING.



RIGGING

1. ALL POINTS SHALL BE DEAD HUNG POINTS.
2. ALL RIGGING SHALL BE HUNG FROM PANEL POINTS (LOCATIONS ON THE TRUSS CHORDS BRACED BOTH VERTICALLY AND HORIZONTALLY) UNLESS SPECIFICALLY APPROVED BY THE ENGINEER OF RECORD.
3. BRIDLES SHALL NOT BE USED UNLESS SPECIFICALLY ALLOWED BY THE ENGINEER OF RECORD.

ALUMINUM TRUSS

1. ALUMINUM TRUSS SHALL BE MANUFACTURED BY ONE OF THE FOLLOWING COMPANIES OR AN APPROVED EQUAL:
 - A. TOTAL STRUCTURES
 - B. UNISSON
 - C. JAMES THOMAS ENGINEERING
 - D. TOMCAT USA
2. TRUSS TO TRUSS CONNECTION HARDWARE (UNLESS NOTED OTHERWISE):
 - A. PLATED ENDS: 5/8"Ø GRADE 8 BOLTS
3. TRUSS END PLATE BOLTS SHALL BE TIGHTED TO THE SNUG TIGHT CONDITION. SNUG TIGHT CONDITION EXISTS WHEN ALL PLIES IN THE CONNECTION HAVE BEEN PULLED INTO FIRM CONTACT BY THE BOLTS AND ALL BOLTS HAVE BEEN TIGHTENED SUFFICIENTLY TO PREVENT REMOVAL OF THE NUTS WITHOUT THE USE OF WRENCH.
4. UNLESS NOTED OTHERWISE, ALL LOADS SHALL BE APPLIED TO TRUSSES AT PANEL POINTS.
5. RATED SPANS, CAPACITIES AND LOADING CONDITIONS PUBLISHED BY THE TRUSS MANUFACTURER SHALL NOT BE EXCEEDED UNLESS REVIEWED AND APPROVED BY A LICENSED ENGINEER FOR A SPECIFIC USE.
6. DO NOT PLACE LIGHTING CLAMPS OR WIRE ROPE IN DIRECT CONTACT WITH THE TRUSS UNLESS THE CHORD MATERIAL IS PROTECTED FROM DAMAGE DUE TO OVERTIGHTENING OR WIRE ROPE RUBBING.

STRUCTURAL STEEL

1. ALL STEEL DETAILING, FABRICATION, AND ERECTION SHALL CONFORM TO THE LATEST VERSION OF THE FOLLOWING SPECIFICATIONS UNLESS NOTED OTHERWISE ON THE DRAWINGS:
 - A. AISC 360: SPECIFICATION FOR STRUCTURAL STEEL BUILDINGS
 - B. AISC 303: CODE OF STANDARD PRACTICE FOR STEEL BUILDINGS AND BRIDGES
 - C. RCSC SPECIFICATION FOR STRUCTURAL JOINTS USING HIGH-STRENGTH BOLTS
 - D. AWS D1.1: STRUCTURAL WELDING CODE-STEEL
2. STRUCTURAL STEEL SHALL CONFORM TO THE FOLLOWING CRITERIA UNLESS NOTED OTHERWISE ON THE DRAWINGS:
 - A. ROLLED WIDE FLANGE SHAPES: ASTM A992, FY = 50 KSI
 - B. MISC PLATE, BAR, ANGLES AND CHANNELS: ASTM A36, FY = 36 KSI
 - C. PIPE SHAPES: ASTM A53, TYPE E OR S, GRADE B, FY = 35 KSI
 - D. HSS TUBES: ASTM A500 GR B, FY = 46 KSI
 - E. HSS ROUND: ASTM A500 GR B, FY = 42KSI
 - F. BOLTS: ASTM A325-N
 - G. HARDENED WASHERS: ASTM F436
 - H. NUTS: ASTM A563

INSPECTIONS

1. ALL TRUSS UNITS, I-BEAMS AND/OR OTHER RIGGING EQUIPMENT SHALL BE VISUALLY INSPECTED PRIOR TO ERECTION. DAMAGED OR CORRODED EQUIPMENT SHALL NOT BE USED. FIELD MODIFICATIONS SHALL BE APPROVED BY THE ENGINEER OF RECORD PRIOR TO INSTALLATION.



OPERATIONS MANAGEMENT PLAN

IMPLEMENTATION OF PLAN

1. PRIOR TO EACH INSTALLATION, THE TRUSS PROVIDER IN CONJUNCTION WITH THE VENUE, SHALL DESIGNATE A RESPONSIBLE PERSON IN CHARGE OF IMPLEMENTING ALL PHASES OF THE OPERATIONS MANAGEMENT PLAN AS IT PERTAINS TO THE STRUCTURE.
2. A MEETING SHALL BE HELD AT THE VENUE WITH THE PROMOTER, OWNER OR STAGE MANAGER TO DISCUSS THE HIGH WIND ACTION PLAN AND OTHER OPERATIONAL ITEMS.

DAILY OPERATIONS PLAN

1. CHECK WEATHER EACH MORNING AND PERIODICALLY THROUGHOUT THE DAY.
2. CHECK TOWER BASES DAILY TO ENSURE ALL REMAIN LEVEL AND PLUMB
3. CHECK GUY WIRES AND BALLAST ASSEMBLIES DAILY TO VERIFY LINES ARE TENSIONED AND BALLAST HAS NOT MOVED.
4. PROVIDE A DAILY LOG OF THE ABOVE CHECKS FOR EACH INSTALLATION.

HIGH WIND ACTION PLAN

1. THE HIGH WIND ACTION PLAN SHALL BE IN EFFECT FOR THE ENTIRETY OF THE INSTALLATION. AN INSTALLATION SHALL BE DEFINED AS STARTING AT THE INITIAL COMMENCEMENT OF THE STRUCTURE INSTALLATION AND ENDING ONCE THE STRUCTURE IS COMPLETELY DISMANTLED.
2. A COMPETENT RESPONSIBLE PERSON FROM THE TRUSS PROVIDER OR VENUE SHALL BE PRESENT FOR THE DURATION OF THE EVENT TO IMPLEMENT THE HIGH WIND ACTION PLAN (SEE ABOVE).
3. A REGULAR LIAISON WITH LOCAL AIRPORTS AND/OR WEATHER INFORMATION CENTERS SHALL BE MAINTAINED TO ASCERTAIN IF ANY SIGNIFICANT WEATHER EVENTS ARE EXPECTED IN THE IMMEDIATE VICINITY OF THE STRUCTURE
4. AN ANEMOMETER SHALL BE PLACED ON THE STRUCTURE TO MONITOR WIND SPEEDS. THE ANEMOMETER SHALL BE PLACED AT THE TOP OF A TOWER OR AN ADJACENT STRUCTURE AT A HEIGHT EQUIVALENT TO THE HEIGHT OF THE TOWER. THE ANEMOMETER SHALL BE LOCATED WITHIN 50 YARDS OF THE STRUCTURE.
5. NOTED WIND SPEEDS ARE 3-SECOND GUSTS IN ACCORDANCE WITH ASCE 7
6. **WHEN THE STRUCTURE IS UNATTENDED OR NOT IN USE:** SCENIC CLADDING SHALL BE REMOVED FROM THE STRUCTURE IF WINDS ARE EXPECTED TO EXCEED 35MPH WHILE LEFT UNATTENDED.
7. **WHEN WIND SPEEDS ARE EXPECTED TO EXCEED 30 MPH:** A TEAM OF QUALIFIED PERSONNEL SHALL BE PUT ON ALERT. ALL NECESSARY PERSONNEL SHALL BE IN PLACE AND PUT ON STANDBY.
8. **WHEN WIND SPEEDS ARE EXPECTED TO EXCEED 40 MPH:**
 - a. ALL SHOW OPERATIONS SHALL BE SUSPENDED, AND THE IMMEDIATE AREA SHALL BE EVACUATED OF ALL PATRONS AND NON-ESSENTIAL PERSONNEL.
 - b. SCENIC CLADDING SHALL BE REMOVED FROM THE STRUCTURE.
 - c. VIDEO WALL SHALL BE LOWERED TO THE GROUND AND SECURED AGAINST MOVEMENT.
9. **AT WINDS SPEEDS IN EXCESS OF 50 MPH:** ALL PERSONNEL SHOULD MAINTAIN SAFE DISTANCE FROM THE STRUCTURE.
10. THE HIGH WIND ACTION PLAN SHALL BE POSTED AT A CONSPICUOUS AREA ON SITE. IT MUST BE AVAILABLE AT ALL TIMES TO VENUE OPERATORS AND CREW.
11. FAILURE TO FOLLOW THE HIGH WIND ACTION PLAN MAY RESULT IN COLLAPSE OF THE STRUCTURE, DAMAGE TO EQUIPMENT AND INJURY TO PERSONS.

PLAN EXCEPTIONS

1. THIS PLAN IS SPECIFIC TO THE STRUCTURE LISTED IN THIS SUBMITTAL. THE EVENT OPERATIONS MANAGEMENT PLAN, IF MORE STRINGENT, SHALL BE FOLLOWED.




APPENDIX A


REFERENCE DRAWINGS

1

B!G TV
Scale: 1:35

SCENIC CLADDING SHALL BE REMOVED IF WINDS ARE EXPECTED TO EXCEED 40MPH - TYP.

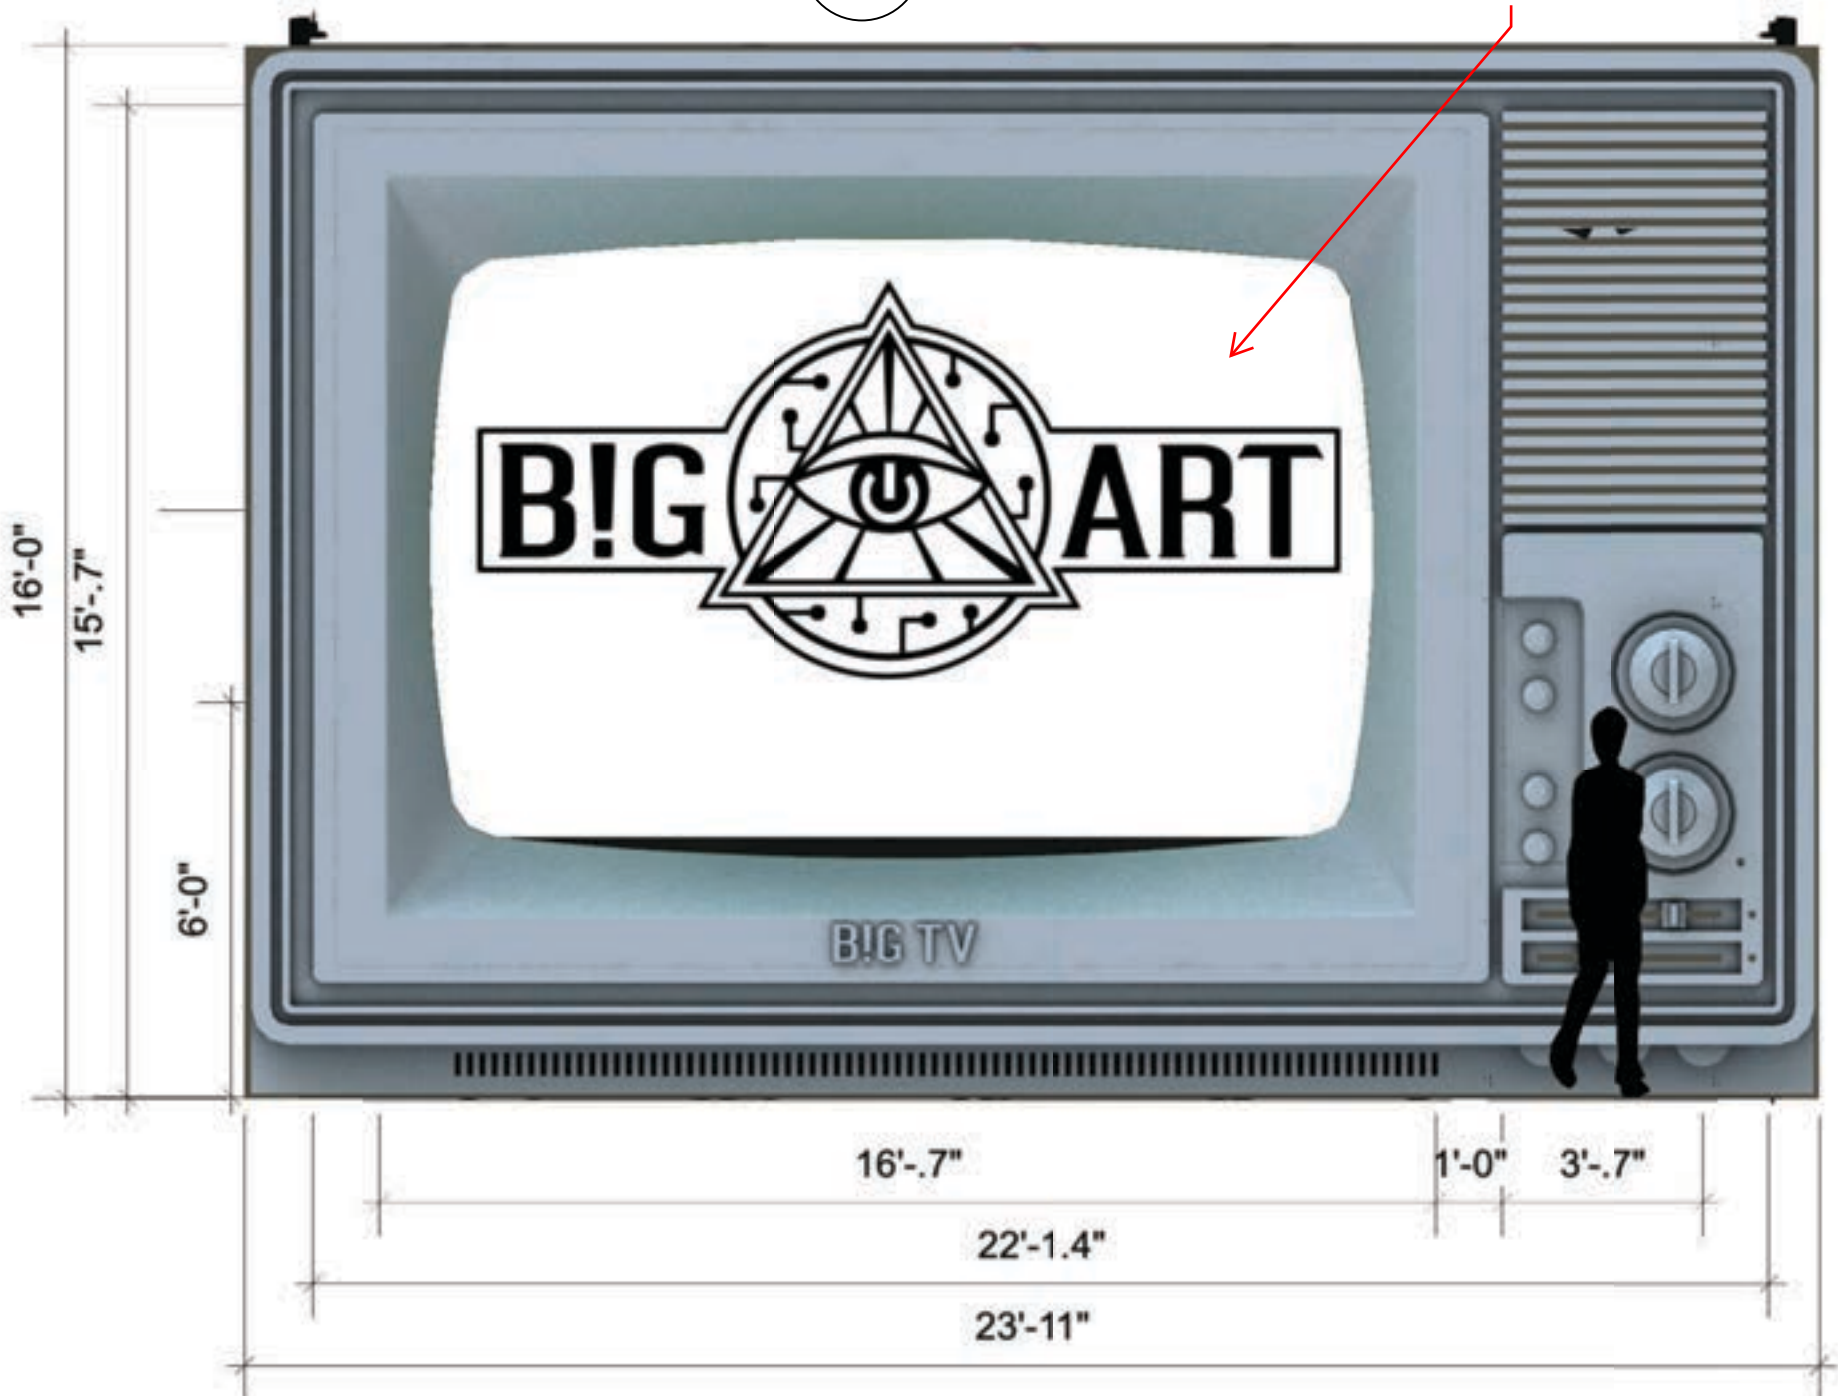

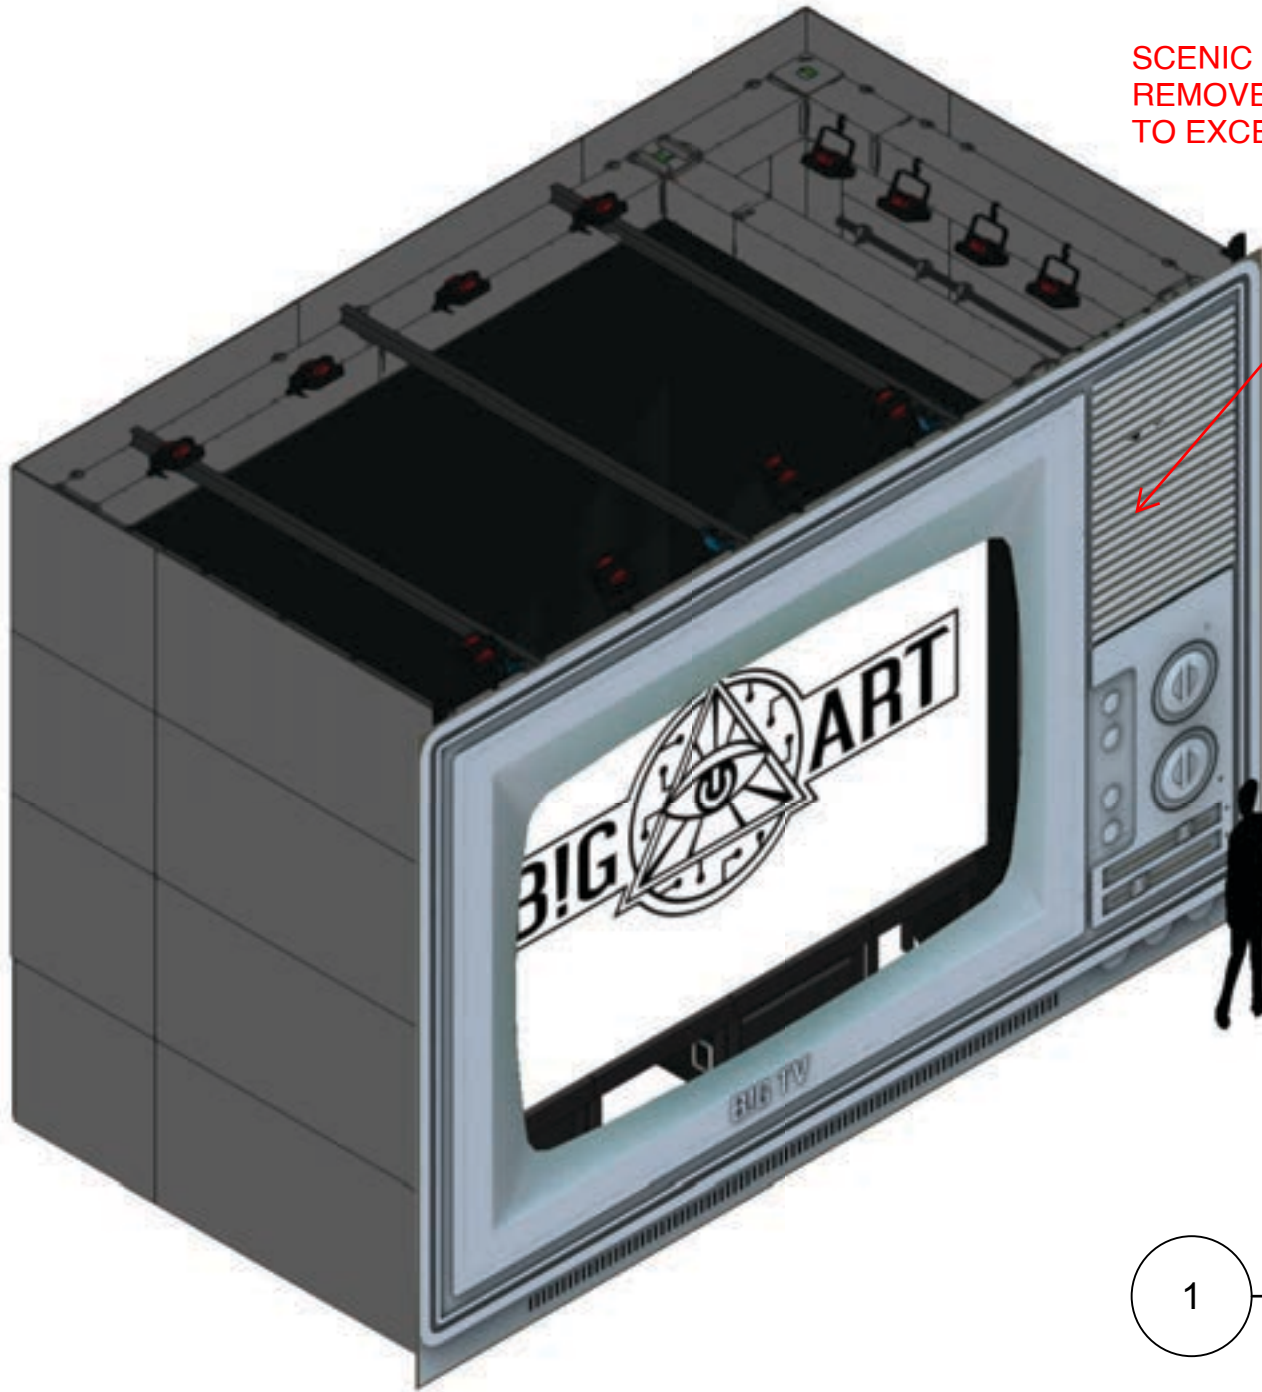


SCENIC CLADDING SHALL BE REMOVED IF WINDS ARE EXPECTED TO EXCEED 40MPH - TYP.


1 BIG TV
Scale: 1:46

1

B!G TV
Scale: 1:35

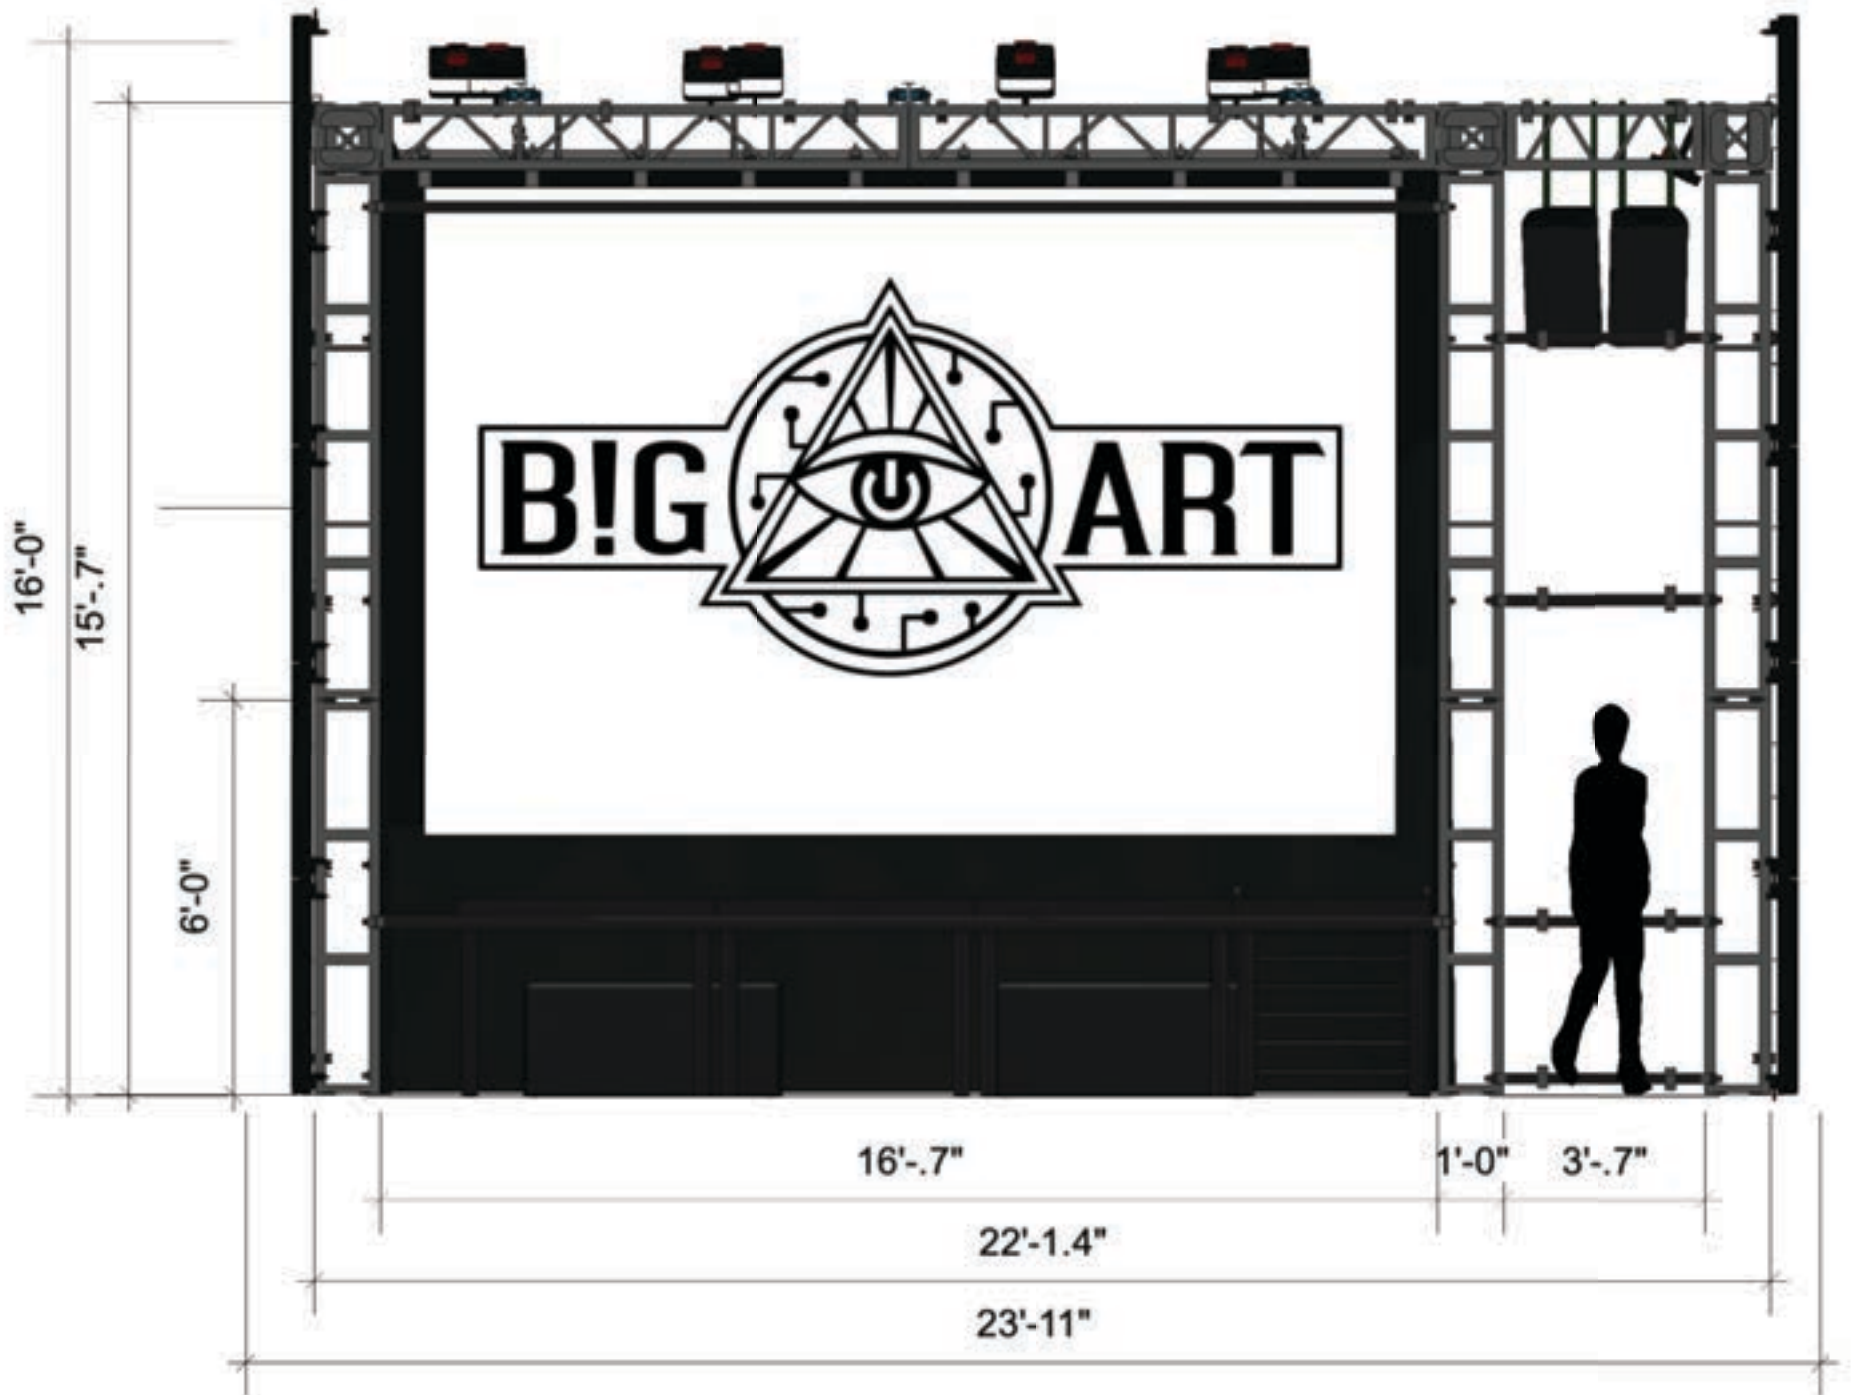

SCRIM SHALL BE REMOVED IF WINDS ARE EXPECTED TO EXCEED 40MPH - TYP.

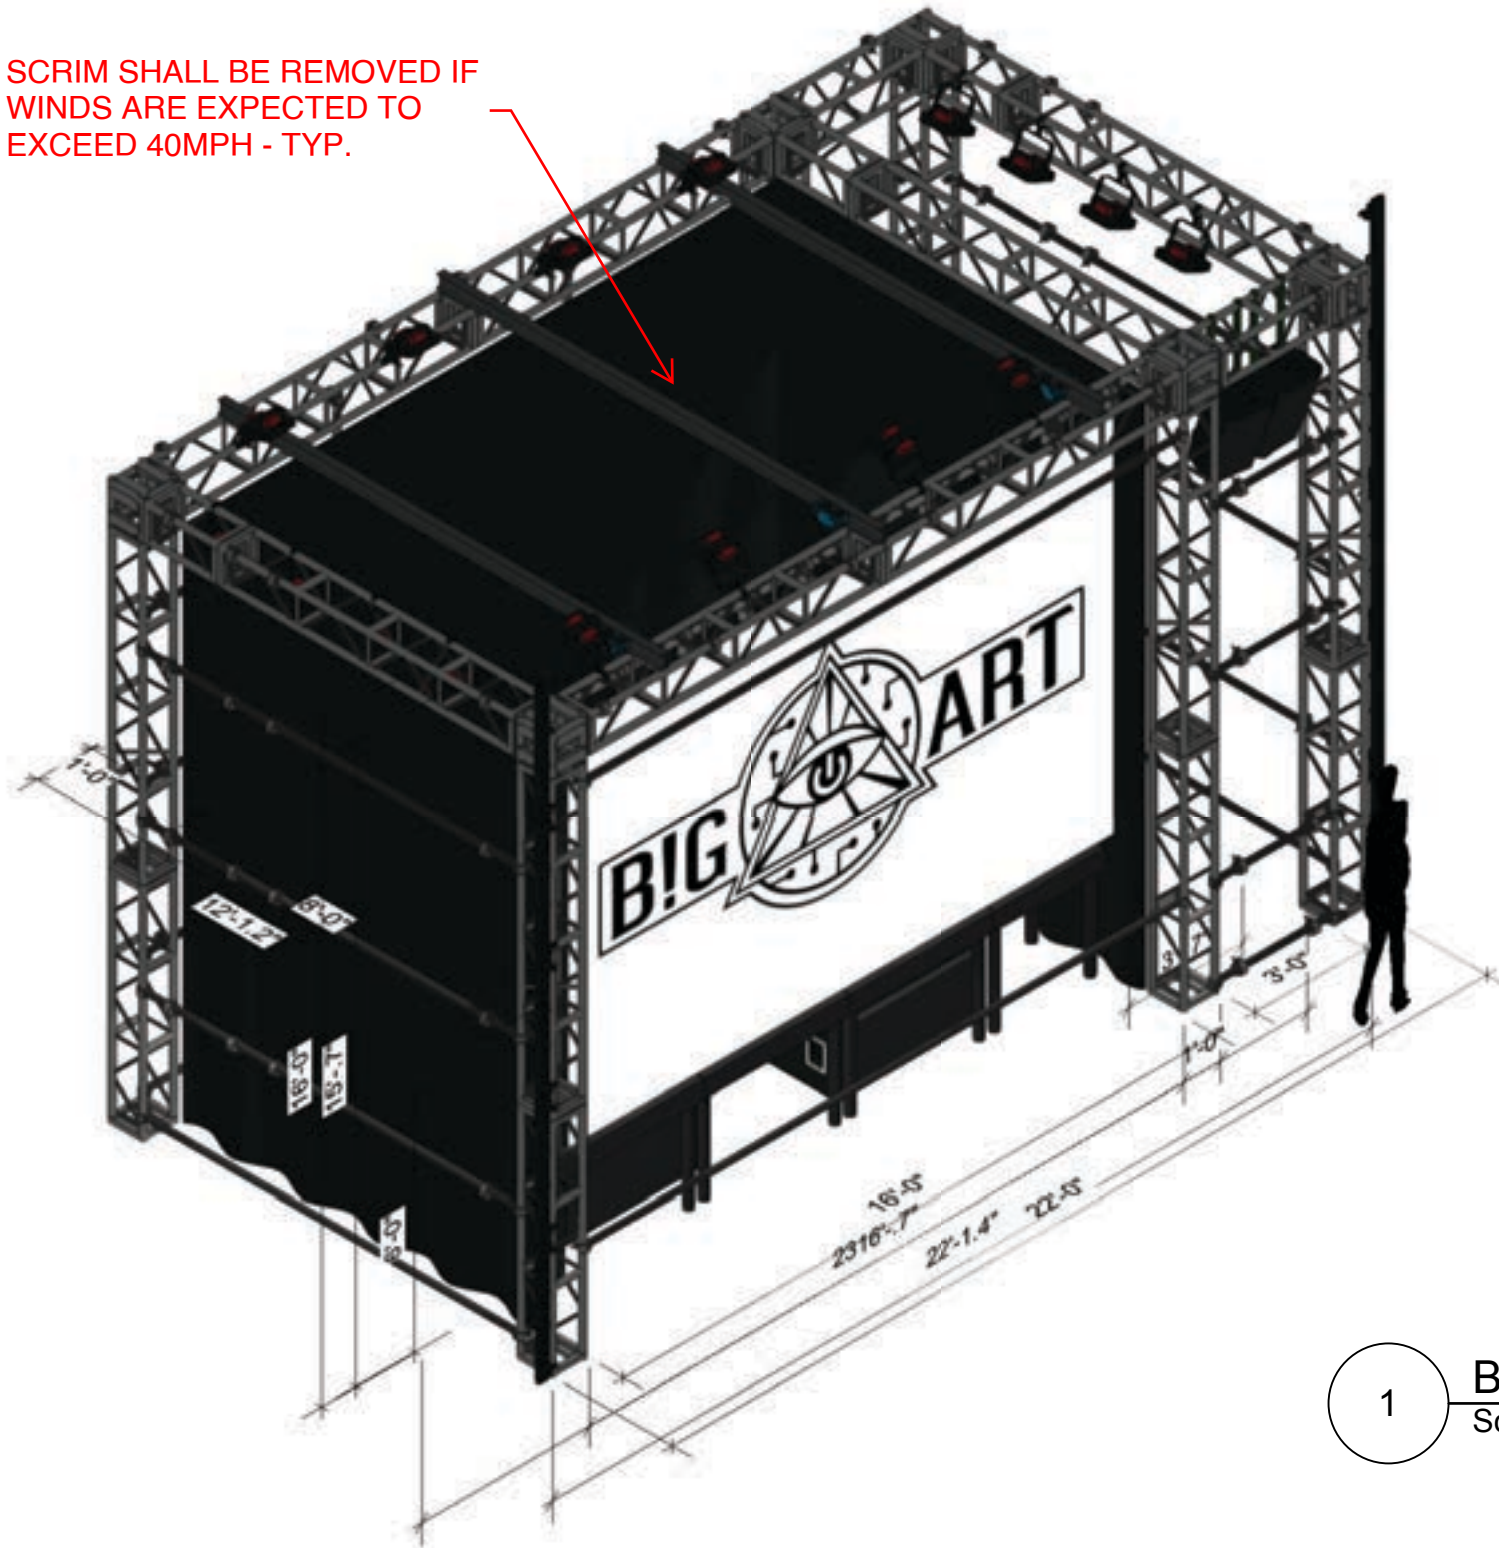


1


BIG TV
Scale: 1:44

PER CLIENT, VIDEO WALL WEIGHS APPROXIMATELY 1400 POUNDS.

1 **BIG TV**
Scale: 1:35

PER CLIENT, AUDIO WEIGHS APPROXIMATELY 160 POUNDS.

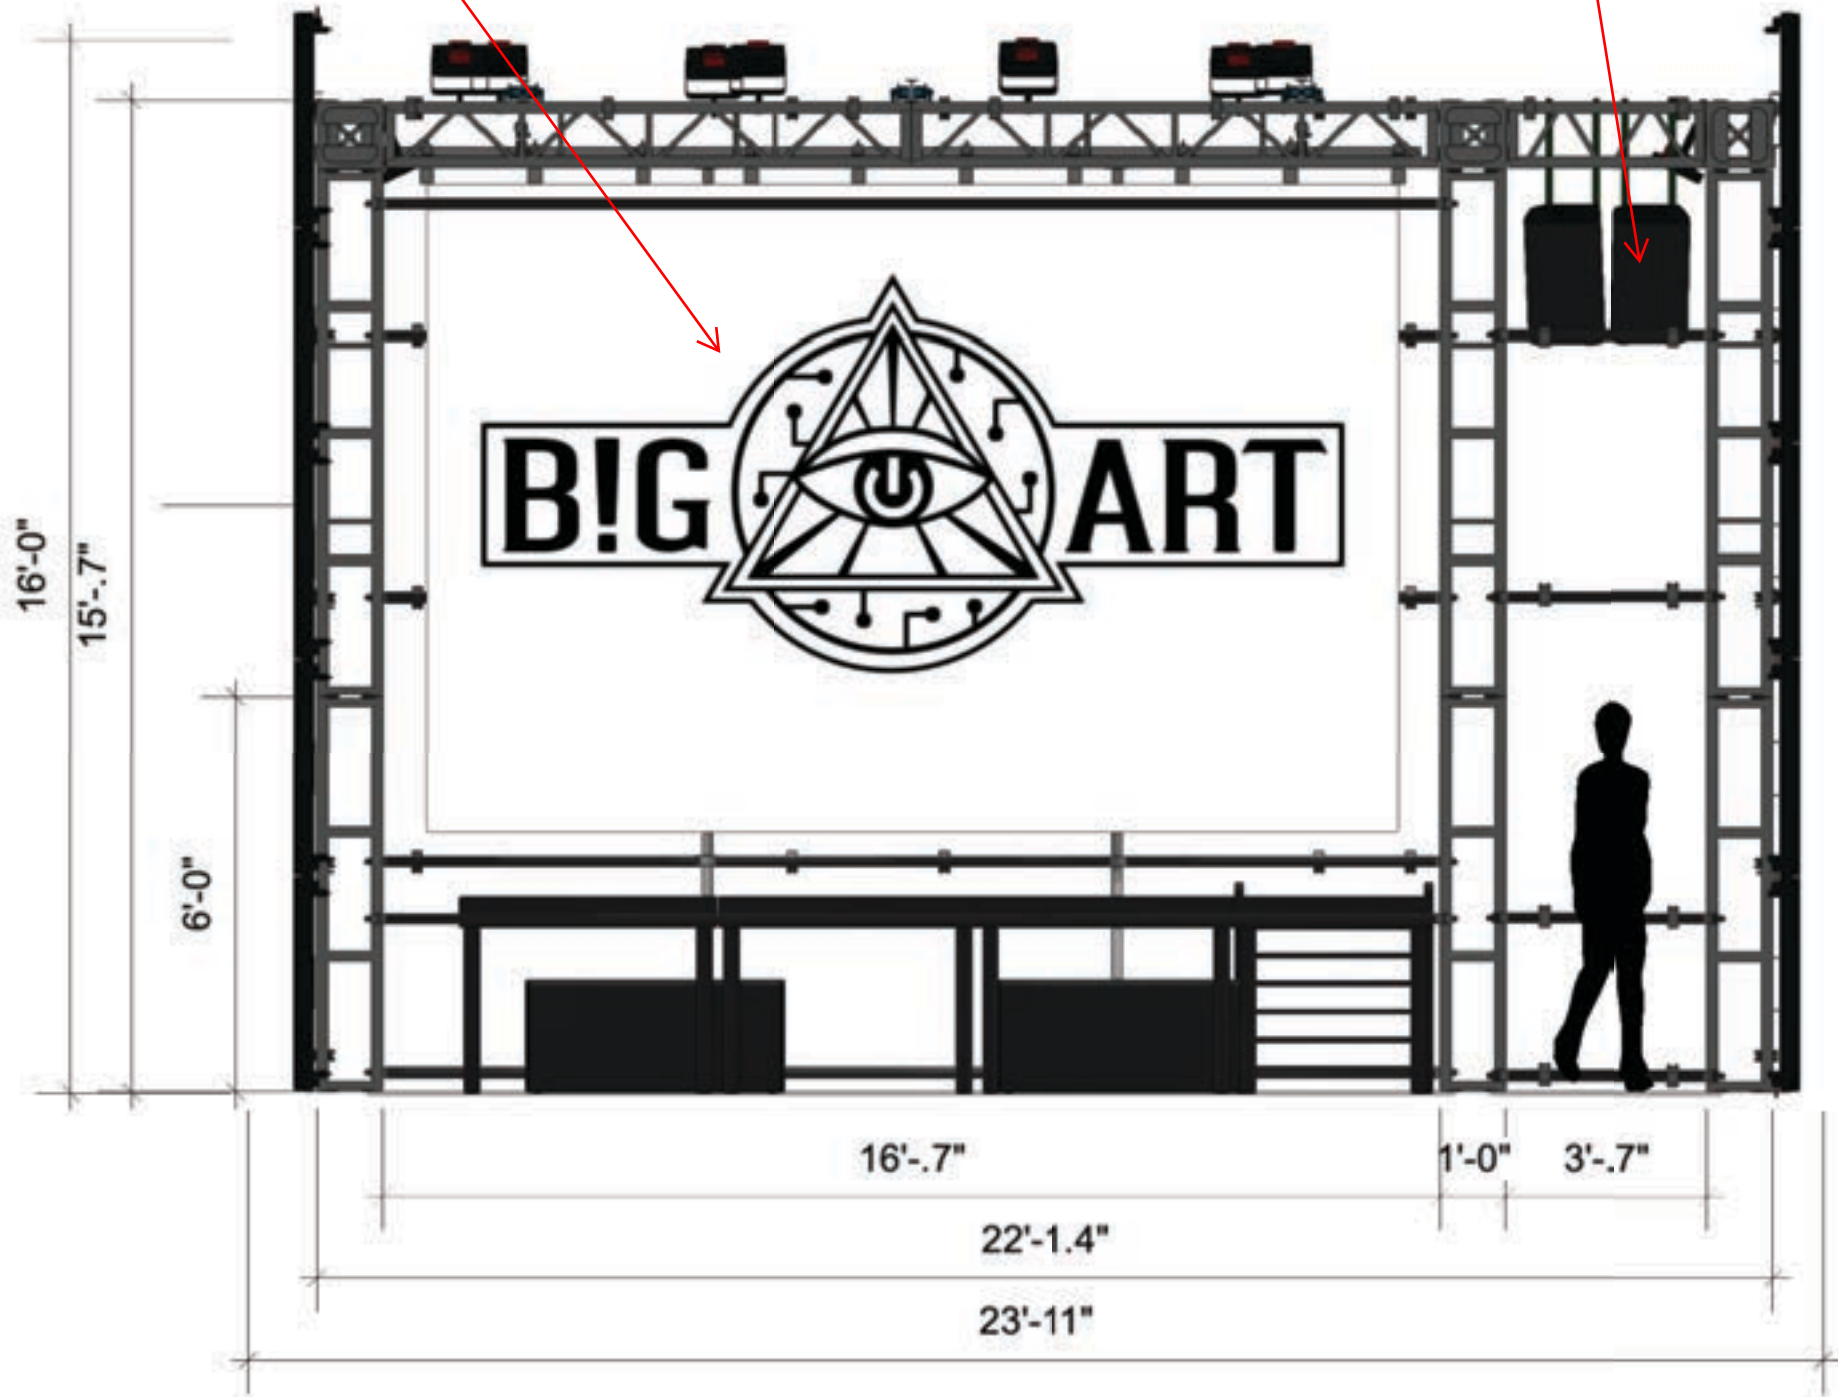

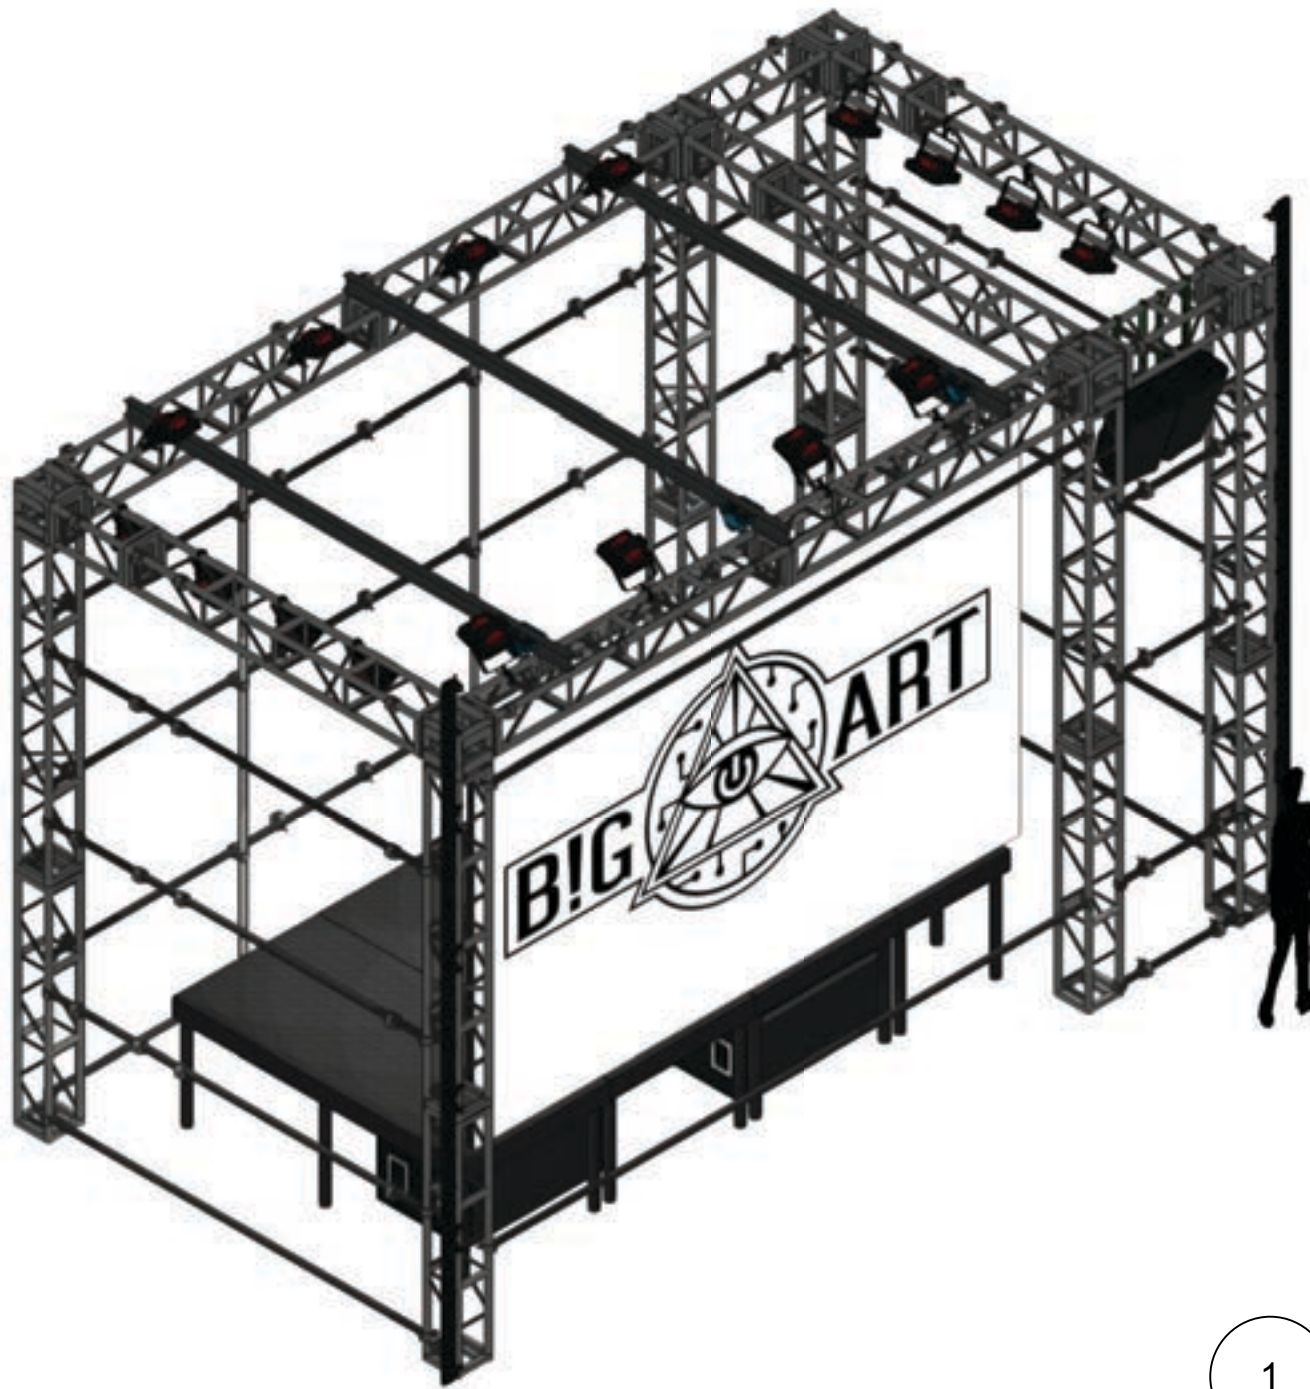


1

BIG TV
Scale: 1:44

MINIMUM 300 POUNDS OF BALLAST
REQUIRED AT EACH TOWER - TYP. (6)

1 **B!G TV**
Scale: 1:30


PER CLIENT, EACH LIGHT WEIGHS
APPROXIMATELY 25 POUNDS - TYP.

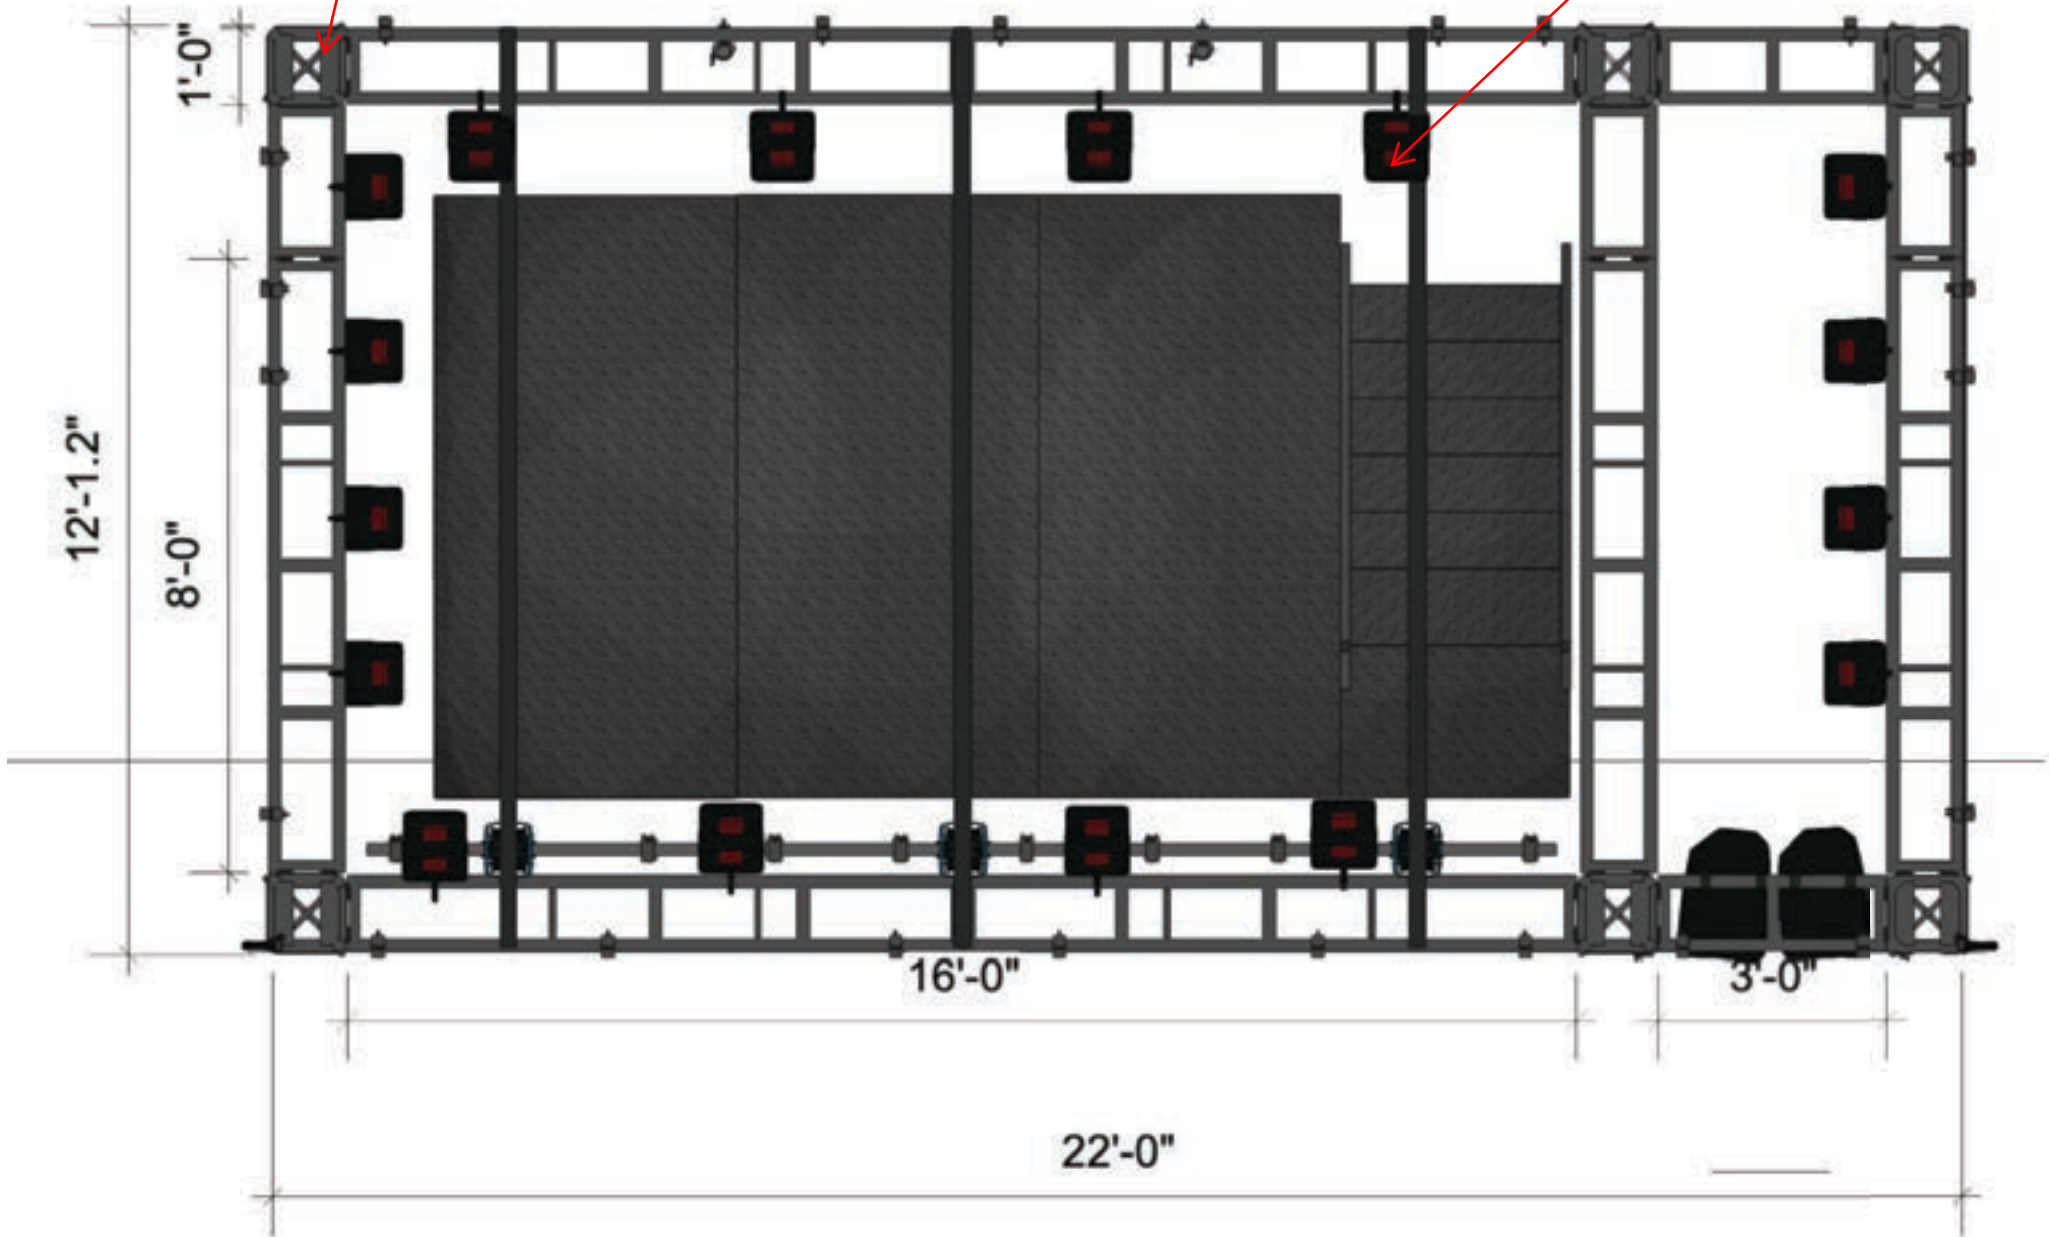


1


B!G TV

Scale: 1:30

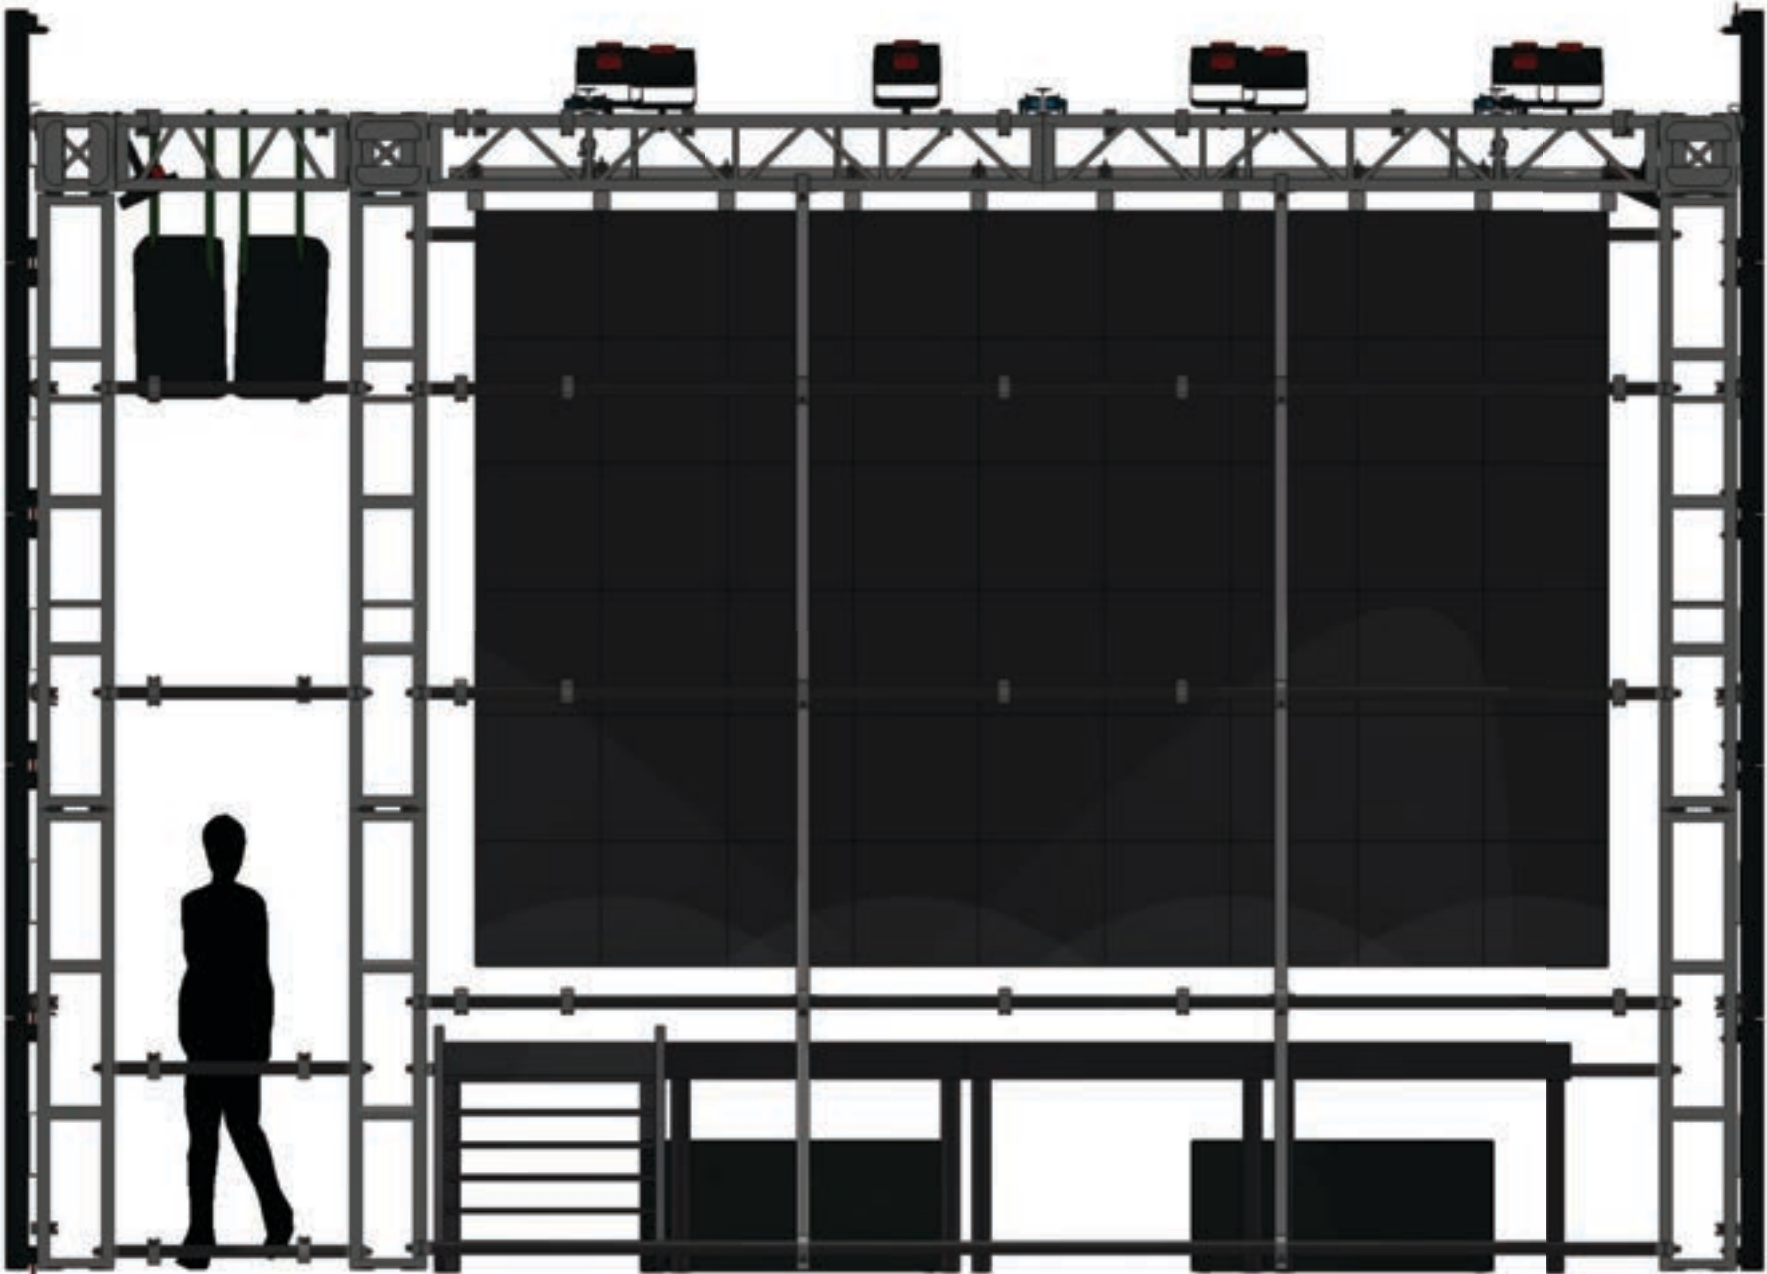

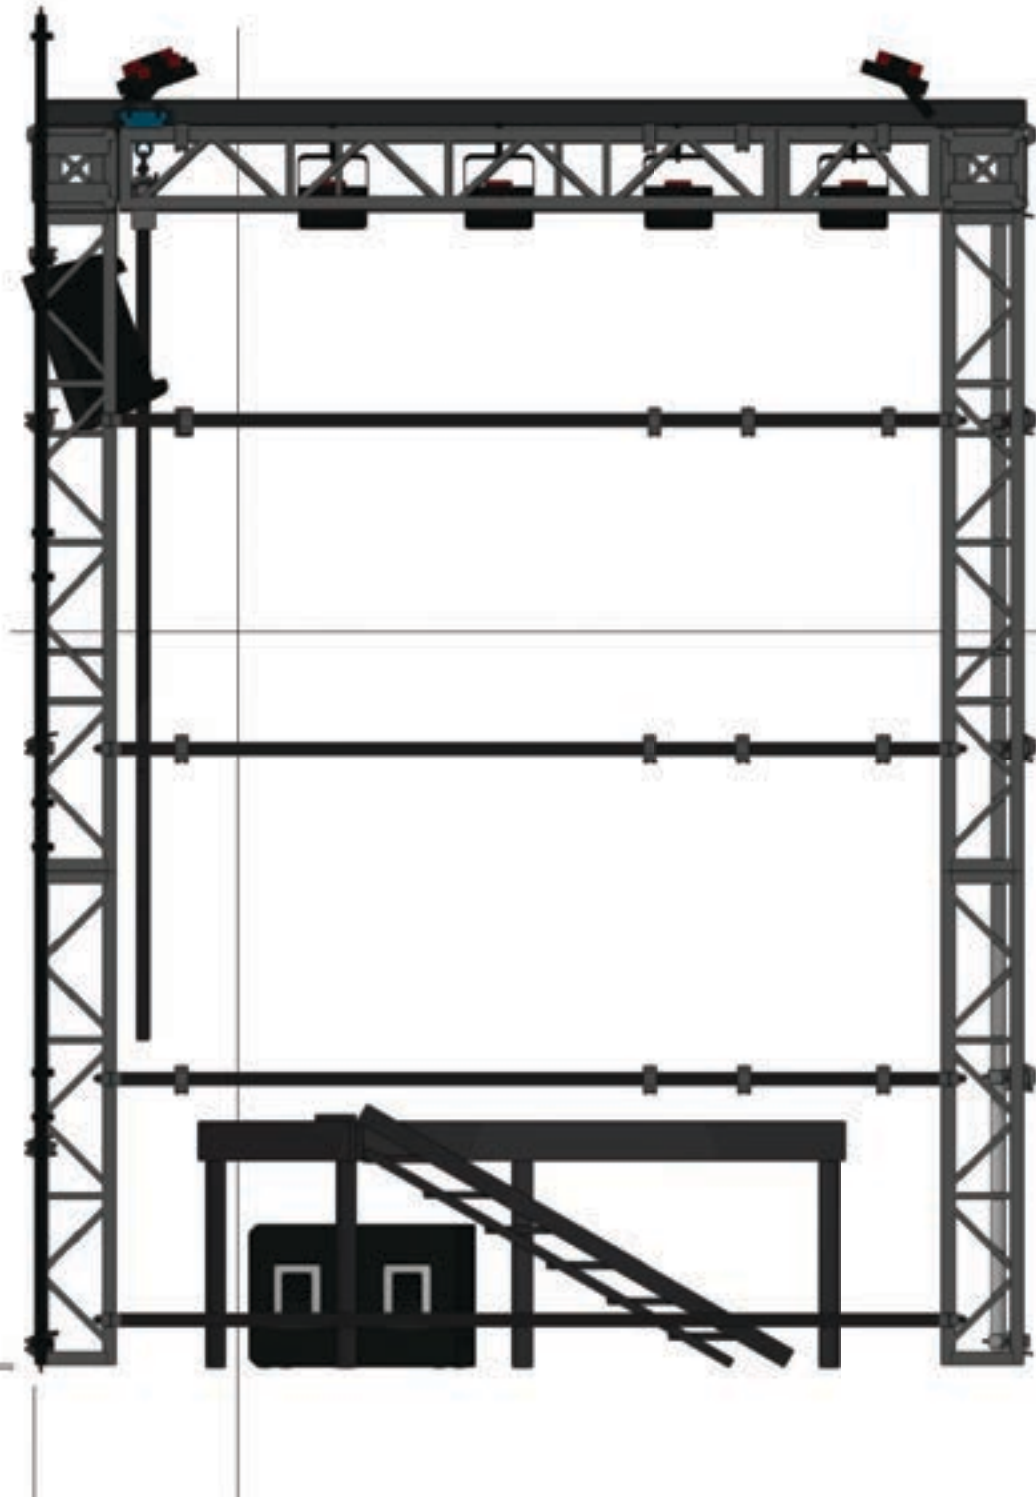

1 BIG TV
Scale: 1:28

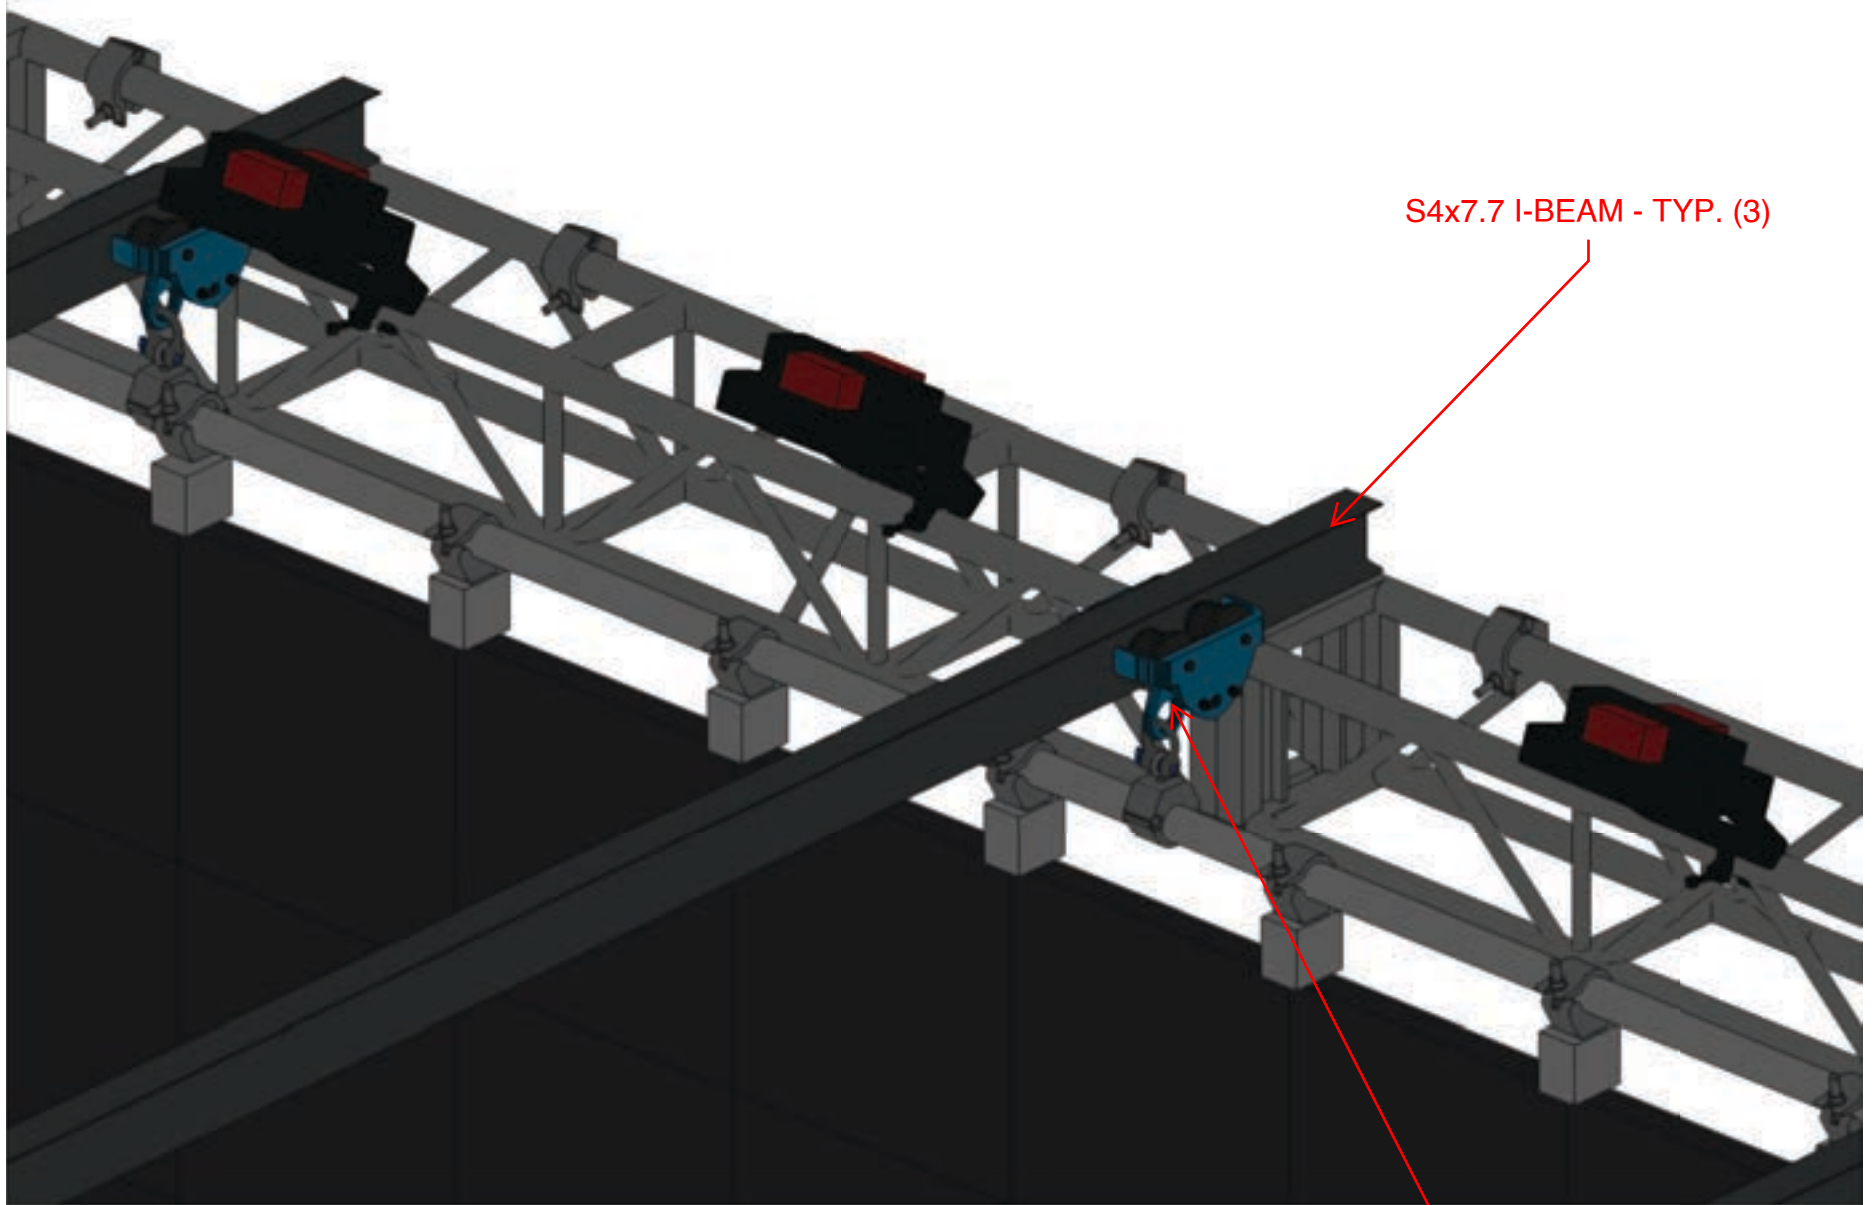

S4x7.7 I-BEAM - TYP. (3)

1 **BIG TV**
Scale: 1:10

BEAM TROLLEY AND ALL RIGGING
COMPONENTS ARE RATED PRODUCTS WITH
A MINIMUM WLL OF 1,000 POUNDS - TYP.



APPENDIX B

CALCULATIONS

BIG TV

Event Date & Location: Varies - Installation shall not exceed 1 week

Codes and Referenced Standards

- 2021 International Building Code
- National Building Code - 2023 Alberta Edition
- Aluminum Design Manual, 2020 ed.
- American Institute of Steel Construction, Steel Construction Manual 15th Edition
- American Society of Civil Engineers 7-16 (ASCE 7-16) "*Minimum Design Loads for Buildings and Other Structures*"
- American Society of Civil Engineers 37-14 (ASCE 37-14) "*Design Loads on Structures During Construction*"
- ANSI E 1.21-2013 "*Temporary Structures Used for Technical Production of Outdoor Entertainment Events*"
- ANSI E 1.2-2012 "*Manufacture and Use of Aluminum Trusses and Towers*"

Project Description

- Review of temporary structure for lateral and gravity loads.

Analysis Assumptions/Design Criteria

- A high wind action plan has been issued and must be strictly followed.
- All truss is 12" x 12" aluminum box truss from Unisson or equivalent.
- Scenic cladding and its attachment to the structure not reviewed by CRE.

General Design - Applies To All Assemblies

Steel/Aluminum Factors of Safety

Note: The following factors/design criteria applies to all assemblies and will be used throughout design package (U.N.O).

AISC Typical Factors of Safety (U.N.O.): $\Omega_{y.AISC} := 1.67$ $\Omega_{r.AISC} := 2.0$

ADM Typical Factors of Safety (U.N.O.): $\Omega_{y.ADM} := 1.65$ $\Omega_{r.ADM} := 1.95$

ASTM A36 Mechanical Properties

Yield Strength: $F_{y.A36} := 36\text{ksi}$

Tensile Strength: $F_{u.A36} := 58\text{ksi}$

ASTM A572 Mechanical Properties

Yield Strength: $F_{y.A572} := 50\text{ksi}$

Tensile Strength: $F_{u.A572} := 65\text{ksi}$

ASTM A500 GR. B (Rectangular) Mechanical Properties

Yield Strength: $F_{y.A500.rect} := 46\text{ksi}$

Tensile Strength: $F_{u.A500.rect} := 58\text{ksi}$

ASTM A500 GR. B (Round) Mechanical Properties

Yield Strength: $F_{y.A500.rd} := 42\text{ksi}$

Tensile Strength: $F_{u.A500.rd} := 58\text{ksi}$

ASTM A992 Mechanical Properties

Yield Strength: $F_{y.A992} := 50\text{ksi}$

Tensile Strength: $F_{u.A992} := 65\text{ksi}$

Weld (Steel) Mechanical Properties

Weld Strength: $F_{weld} := 70\text{ksi} \cdot 0.6 = 42.00\text{-ksi}$

Grade 8 Bolt Mechanical Properties

Tensile Strength of Bolt: $F_{u.bolt} := 150\text{ksi}$

6061-T6 Mechanical Properties

Unwelded

Welded

Tension Ultimate Stress: $F_{tu} := 38\text{ksi}$

$F_{tuw} := 24\text{ksi}$

Tension Yield Stress: $F_{ty} := 35\text{ksi}$

$F_{tyw} := 15\text{ksi}$

Compression Yield Stress: $F_{cy} := 35\text{ksi}$

$F_{cyw} := 15\text{ksi}$

Shear yield stress: $F_{sy} := 0.6 \cdot F_{ty} = 21.00\text{-ksi}$

$F_{syw} := 0.6 \cdot F_{tyw} = 9.00\text{-ksi}$

Ultimate shear stress: $F_{su} := 24\text{ksi}$

$F_{suw} := 15\text{ksi}$

Tension coefficient: $k_t := 1.0$

$k_{tw} := 1.0$

Applied Loads:

Wind Loads - Per ASCE 7-16 and ASCE 37-14

- Ultimate wind speed (LRFD): $V_u := 115$ mph
- Service level wind speed (ASD): $V_s := \sqrt{V_u^2 \cdot 0.6}$ $V_s = 89.08$ mph
- HWAP service level wind speed (ASD): $V_{hwap} := 40$ mph
- Exposure category (service): $Exp_s :=$
- Exposure category (HWAP): $Exp_{hwap} :=$
- Gust effect factor: $G_w := 0.85$
- Topographic factor: $K_{zt} := 1.0$
- Ground elevation: $z_g := 0$ ft
- Ground elevation factor: $K_e := e^{-0.0000362 \cdot \frac{z_g}{ft}} = 1.00$

6.2.1.1.1 Construction Period in Hurricane-Prone Areas
 For construction between November 1 and June 30 (outside of the hurricane season), the basic wind speed of 115 mph (51 m/s) shall be permitted for structures sited near the Gulf Coast and Eastern Seaboard, where the ASCE/SEI 7-10 specified basic wind speed exceeds 115 mph (51 m/s) (3 second gust) (hurricane-prone areas). The 115 mph (51 m/s) wind speed is permitted to be reduced by the factors in Section 6.2.1 only for a construction period between November 1 and June 30. If the construction period shifts into the period between July 1 and October 31, the design shall be reviewed and modified, as appropriate, to conform to the requirements shown below for a construction period between July 1 and October 31.

Between July 1 and October 31, basic wind speed of 115 mph (51 m/s) shall be permitted for structures sited near the Gulf Coast and Eastern Seaboard, where the ASCE/SEI 7-10 specified basic wind speed exceeds 115 mph (51 m/s) (3 second gust) provided additional bracing is prepared in advance and applied in time before the onset of an announced hurricane. The 115 mph (51 m/s) wind speed shall not be reduced by the factors in Section 6.2.1 for the construction period. The bracing shall be designed for the full, unmodified wind load determined using the mapped wind speed and procedures found in ASCE/SEI 7-10.

ASCE 37-14 Reduction Factor

Construction Period	Factor
Less than six weeks	0.75
From six weeks to one year	0.8
From one to two years	0.85
From two to five years	0.9

Reduction coefficient for temporary structure: $red :=$

Service level (ASD) wind speed for design of temporary structure: $V_{temp_service} := V_s \cdot red$ $V_{temp_service} = 66.81$ mph

Ultimate level (LRFD) wind speed for design of temporary structure: $V_{temp_ultimate} := V_u \cdot red$ $V_{temp_ultimate} = 86.25$ mph

NOTE: Per ASCE 7-16, ultimate wind speeds are reduced by a factor of 0.6 in all service level (ASD) load combinations found in Section 2.4. Service level wind speeds are the design wind speeds that should be monitored.

Wind Loads on Trussed Towers

This Mathcad sheet calculates the wind pressures on a trussed tower in accordance with figure 29.4-3 of ASCE 7-16.

Height of wind evaluation:

$z := 16 \cdot \text{ft}$

Truss property table:

Type of truss:

type :=

Wind directionality factor:

$K_d :=$

Tower cross section:

TCS :=

Are tower members round?

RM :=

Truss	"ε"	"Width"
"12" Truss"	0.461	12
"20½" Truss"	0.329	20.5
"26x30 PRT Empty"	0.289	26
"26x30 PRT Full"	0.594	26
"20"x30" HD Truss"	0.254	30
"G2 Truss"	.220	60

Ratio of solid area to gross area:

$\epsilon := \text{Table}_{\text{truss}}_{\text{type}, 2} = 0.461$

Truss width:

$B_{\text{truss}} := \text{Table}_{\text{truss}}_{\text{type}, 3} \cdot \text{in} = 12.00 \cdot \text{in}$

Velocity Pressure Exposure Coefficient (service):

$K_{z_s} := K_{z_{F_s}}(z) \quad K_{z_s} = 0.86$

Velocity Pressure Exposure Coefficient (HWAP):

$K_{z_{\text{hwap}}} := K_{z_{F_{\text{hwap}}}}(z) \quad K_{z_{\text{hwap}}} = 0.86$

Wind velocity pressure (service):

$q_{z_s} := 0.00256 \cdot K_{z_s} \cdot K_{z_t} \cdot K_d \cdot K_e \cdot (\text{red} \cdot V_s)^2 \cdot \text{psf} \quad q_{z_s} = 8.36 \cdot \text{psf}$

Wind velocity pressure (HWAP):

$q_{z_{\text{hwap}}} := 0.00256 \cdot K_{z_{\text{hwap}}} \cdot K_{z_t} \cdot K_d \cdot K_e \cdot (V_{\text{hwap}})^2 \cdot \text{psf} \quad q_{z_{\text{hwap}}} = 3.00 \cdot \text{psf}$

Round member reduction (if applicable):

$\text{rnd_red} := \begin{cases} 1.0 & \text{if } \text{RM} = \text{"NO"} \\ \min(1.0, 0.51 \cdot \epsilon^2 + 0.57) & \text{otherwise} \end{cases} \quad \text{rnd_red} = 0.68$

Force coefficient:

$C_f := \text{rnd_red} \cdot \begin{cases} 4.0 \cdot \epsilon^2 - 5.9 \cdot \epsilon + 4.0 & \text{if } \text{TCS} = \text{"Square"} \\ 3.4 \cdot \epsilon^2 - 4.7 \cdot \epsilon + 3.4 & \text{otherwise} \end{cases} \quad C_f = 1.45$

Truss wind pressure (service):

$$p_{truss_s} := q_{z_s} \cdot C_f \cdot G_w$$

$$p_{truss_s} = 10.27 \cdot \text{psf}$$

Truss wind pressure (HWAP):

$$p_{truss_hwap} := q_{z_hwap} \cdot C_f \cdot G_w$$

$$p_{truss_hwap} = 3.68 \cdot \text{psf}$$

Linear wind load (service):

$$w_{truss_s} := p_{truss_s} \cdot B_{truss} \cdot \epsilon$$

$$w_{truss_s} = 4.73 \cdot \text{plf}$$

Linear wind load (HWAP):

$$w_{truss_hwap} := p_{truss_hwap} \cdot B_{truss} \cdot \epsilon$$

$$w_{truss_hwap} = 1.70 \cdot \text{plf}$$

Adjustment for wind along a diagonal:

$$\text{Diag} := \min(1.2, 1 + 0.75 \cdot \epsilon) = 1.20$$

Linear wind load, diagonal (service):

$$w_{diag_s} := w_{truss_s} \cdot \text{Diag}$$

$$w_{diag_s} = 5.68 \cdot \text{plf}$$

Linear wind load, diagonal (HWAP):


$$w_{diag_hwap} := w_{truss_hwap} \cdot \text{Diag}$$

$$w_{diag_hwap} = 2.04 \cdot \text{plf}$$

Wind Loads on Scrim / Signs

This Mathcad sheet calculates the wind pressures on a sign or scrim in accordance with figure 29.3-1 of ASCE 7-16.

Diagrams

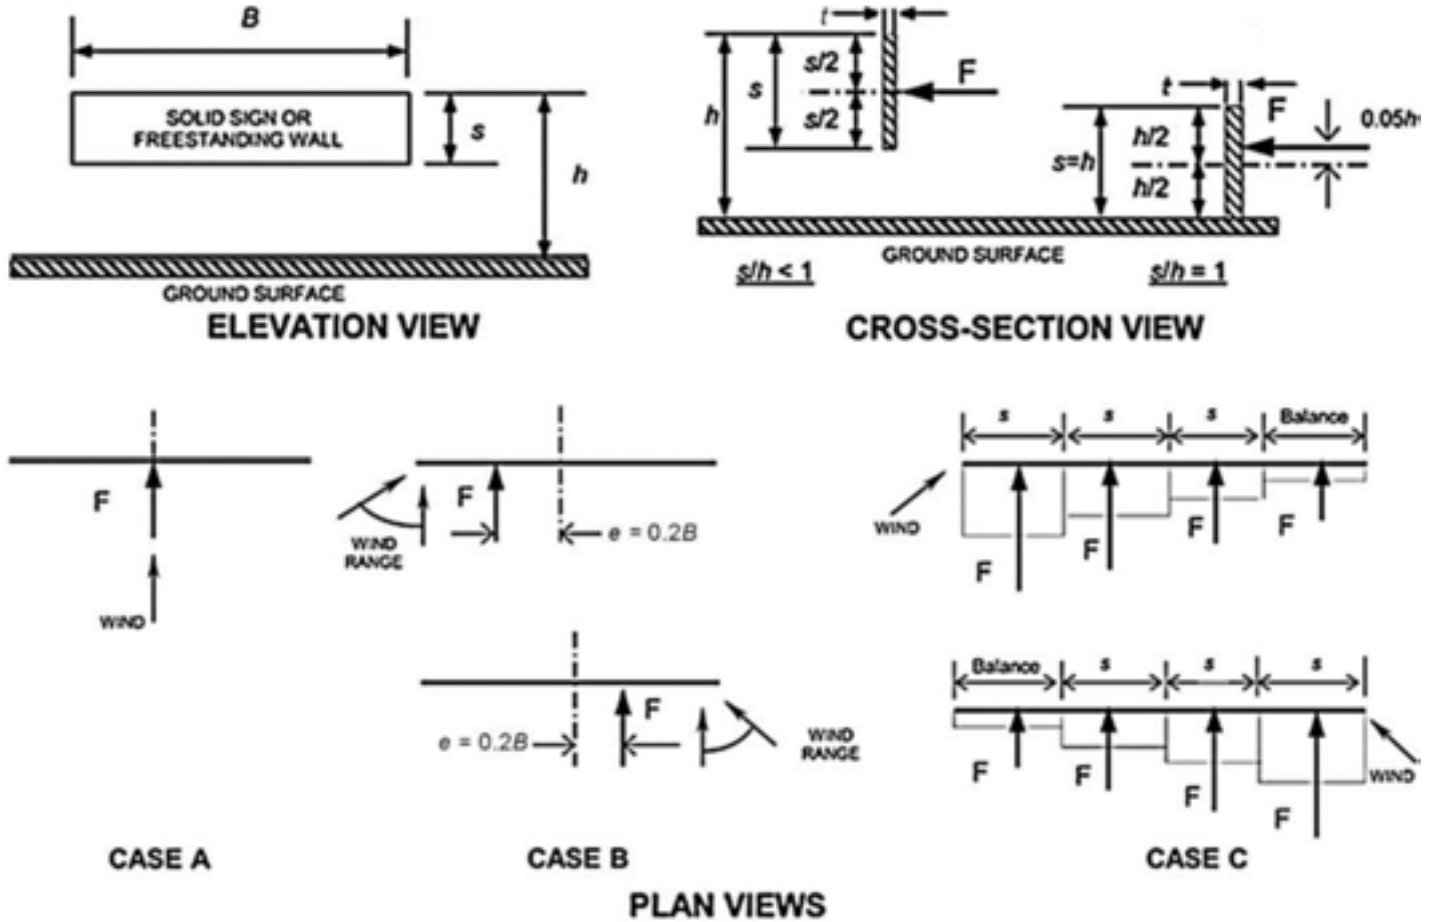

Top of sign height:	$h := 16\text{-ft}$	Sign Width:	$B := 22\text{-ft}$
Vertical dimension of sign:	$s_w := 16\text{-ft}$	Wind directionality factor:	$K_{wd} := 0.85$
Aspect ratio, B/s:	$B_s := \frac{B}{s} = 1.38$	Clearance ratio, s/h:	$sh := \frac{s}{h} = 1.00$

Velocity Pressure Exposure Coefficient (service):

$$K_{z_s} := K_{z_F_s}(h)$$

$$K_{z_s} = 0.86$$

Velocity Pressure Exposure Coefficient (HWAP):

$$K_{z_hwap} := K_{z_F_hwap}(h)$$

$$K_{z_hwap} = 0.86$$

Wind velocity pressure (service):

$$q_{h_s} := 0.00256 \cdot K_{z_s} \cdot K_{zt} \cdot K_d \cdot K_e \cdot (red \cdot V_s)^2 \cdot psf$$

$$q_{h_s} = 8.36 \cdot psf$$

Wind velocity pressure (HWAP):

$$q_{h_hwap} := 0.00256 \cdot K_{z_hwap} \cdot K_{zt} \cdot K_d \cdot K_e \cdot (V_{hwap})^2 \cdot psf$$

$$q_{h_hwap} = 3.00 \cdot psf$$

Cases A & B:

Case A & B Force Coefficient Table:

Table_CfAB :=

"Cf"	0	0.05	0.1	0.2	0.5	1	2	4	5	10	20	30	45	999
0.0	1.95	1.95	1.90	1.85	1.85	1.80	1.80	1.85	1.85	1.85	1.90	1.90	1.95	1.95
0.16	1.95	1.95	1.90	1.85	1.85	1.80	1.80	1.85	1.85	1.85	1.90	1.90	1.95	1.95
0.2	1.95	1.95	1.90	1.85	1.80	1.80	1.80	1.80	1.80	1.85	1.90	1.90	1.95	1.95
0.3	1.95	1.95	1.90	1.85	1.80	1.80	1.80	1.80	1.80	1.80	1.85	1.85	1.85	1.85
0.5	1.95	1.95	1.85	1.80	1.75	1.75	1.70	1.70	1.70	1.70	1.70	1.70	1.75	1.75
0.7	1.90	1.90	1.85	1.75	1.70	1.65	1.60	1.60	1.55	1.55	1.55	1.55	1.55	1.55
0.9	1.85	1.85	1.75	1.70	1.60	1.55	1.50	1.45	1.45	1.40	1.40	1.40	1.40	1.40
1	1.80	1.80	1.70	1.65	1.55	1.45	1.40	1.35	1.35	1.30	1.30	1.30	1.30	1.30

Case A & B Force Coefficient:

$$C_{f_AB} := \text{Spline}(\text{Table_CfAB}, sh, Bs)$$

$$C_{f_AB} = 1.43$$

Sign wind pressure (service):

$$P_{sign_s} := q_{h_s} \cdot C_{f_AB} \cdot G_w$$

$$P_{sign_s} = 10.17 \cdot psf$$

Sign wind pressure (HWAP):

$$P_{sign_hwap} := q_{h_hwap} \cdot C_{f_AB} \cdot G_w$$

$$P_{sign_hwap} = 3.64 \cdot psf$$

Total sign wind load (service):

$$P_{sign_s} := P_{sign_s} \cdot B \cdot s$$

$$P_{sign_s} = 3.58 \cdot kip$$

Total sign wind load (HWAP):

$$P_{sign_hwap} := P_{sign_hwap} \cdot B \cdot s$$

$$P_{sign_hwap} = 1.28 \cdot kip$$

Horizontal offset for Case B:

$$\text{Offset}_B := 0.2 \cdot B$$

$$\text{Offset}_B = 4.40 \text{ ft}$$

Seismic Loads - Per ASCE 37-14 & ASCE 7-16 (Chapter 12/15)

6.5 EARTHQUAKE

If required by Section 6.5.1 and not exempted by Section 6.5.3, earthquake loads shall be calculated in accordance with procedures in ASCE/SEI 7-10 as modified by Section 6.5.2. All structures shall be treated as Risk Category II, per Table 1.5-1 of ASCE/SEI 7-10, regardless of the group classification of the completed structure.

6.5.1 Applicability Earthquake loads need not be considered unless required by the authority having jurisdiction and the mapped Risk-Targeted MCE_R , 5% damped, spectral response acceleration parameter at a period of 1 s, S_1 , defined in Section 11.4.1 of ASCE/SEI 7-10 equals or exceeds 0.40.

6.5.2 Use of ASCE/SEI 7-10 For use of the earthquake load provisions of ASCE/SEI 7-10, the following modifications should be made:

1. The mapped values for S_2 and S_1 may be multiplied by a factor less than 1 to represent the reduced exposure period, but the factor shall not be less than 0.20.
2. The restrictions on types of structural systems in seismic performance categories D and E do not apply, as long as the height of the temporary bracing system designed in accordance with this section is limited in height to 60 ft (18.3 m) or five stories, whichever is less, above the completed bracing of the permanent structure.

Seismic Analysis - ASCE 37-14 & ASCE 7-16 (Chapter 12/15)

Site coefficients per ASCE 7-16, Site Class D assumed

Mapped MCE, 5% damped, spectral response, acceleration parameter at short periods: $S_S := 2.45$

Mapped MCE, 5% damped, spectral response, acceleration parameter at 1s: $S_1 := 0.86$

Design 5% damped, spectral response, acceleration parameter at short periods: $S_{DS} := 1.63$

Design 5% damped, spectral response, acceleration parameter at 1s: $S_{D1} := 0.86$

Per ASCE 37-14, does seismic need to be considered? $Consider_seismic := \begin{cases} "NO" & \text{if } S_1 < 0.4 \\ "YES" & \text{otherwise} \end{cases}$ Consider_seismic = "YES"

If seismic is required to be considered:

Temporary reduction coefficient as allowed by ASCE 37-14 (minimum value = 0.2): $red_{eq} := 0.2$

ASCE 37-14, Section 6.5.2.3:

Response modification factor: $R_{eq} := 2.5$

3. The R factor used for temporary bracing systems shall not exceed 2.5 unless the system is detailed in accordance with the provisions of ASCE/SEI 7-10. Where R = 2.5 is used, only the requirements dealing with the strength of the seismic-resisting structural system need be satisfied.

Importance factor/Risk Category II: $I_e := 1.0$

Structural height (FT): $h_n := 20$

Approximate period parameters (Table 12.8-2, Page 90): $C_t := 0.02$

Long period transition period (Figure 22-12, Page 224): $T_L := 12$

Approximate Fundamental Period: $T_a := C_t \cdot h_n^{.75} = 0.19$

Modified spectral responses with reduction coefficient: $S_{S_mod} := S_S \cdot red_{eq} = 0.49$ $S_{DS_mod} := S_{DS} \cdot red_{eq} = 0.33$

$S_{1_mod} := S_1 \cdot red_{eq} = 0.17$ $S_{D1_mod} := S_{D1} \cdot red_{eq} = 0.17$

Seismic response coefficient:

$$C_{s,calc} := \min \left[\frac{S_{DS_mod}}{\left(\frac{R_{eq}}{I_e} \right)}, \begin{cases} \frac{S_{D1_mod}}{T_a \cdot \left(\frac{R_{eq}}{I_e} \right)} & \text{if } T_a \leq T_L \\ \frac{S_{D1_mod} \cdot T_L}{T_a^2 \cdot \left(\frac{R_{eq}}{I_e} \right)} & \text{if } T_a > T_L \end{cases} \right] = 0.130$$

$$C_{s,min} := \begin{cases} \max(0.044 \cdot S_{DS_mod} \cdot I_e, 0.01) & \text{if } S_1 < 0.6 \\ \max \left(0.044 \cdot S_{DS_mod} \cdot I_e, 0.01, \frac{0.5 \cdot S_{1_mod}}{\frac{R_{eq}}{I_e}} \right) & \text{if } S_1 \geq 0.6 \end{cases} = 0.034$$

$$C_s := \begin{cases} 0 & \text{if Consider_seismic} = \text{"NO"} \\ \max(C_{s,calc}, C_{s,min}) & \text{otherwise} \end{cases} \quad C_s = 0.130$$


Vertical seismic load effect:

$$EQ_v := \begin{cases} 0 & \text{if Consider_seismic} = \text{"NO"} \\ 0.2 \cdot S_{DS_mod} & \text{otherwise} \end{cases} \quad EQ_v = 0.065$$


NOTE: WIND LOADS WILL GOVERN SO SEISMIC LOADS CAN BE IGNORED.

Global Stability:


Overturning and Uplift Checks:

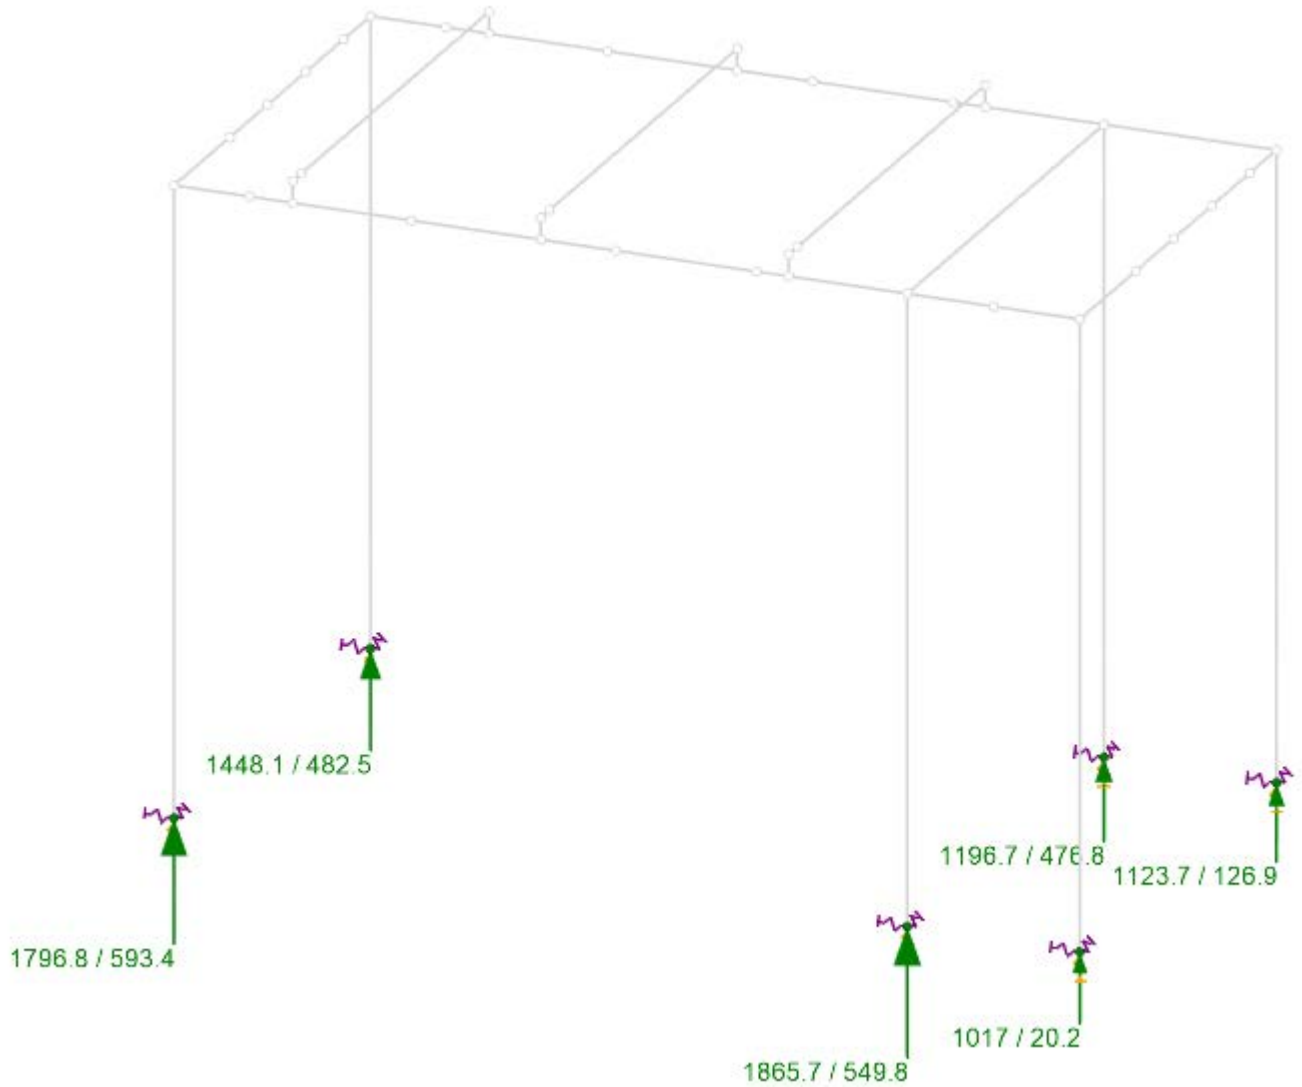

Enveloped Vertical Reactions - Video Wall on Front Edge of Beam

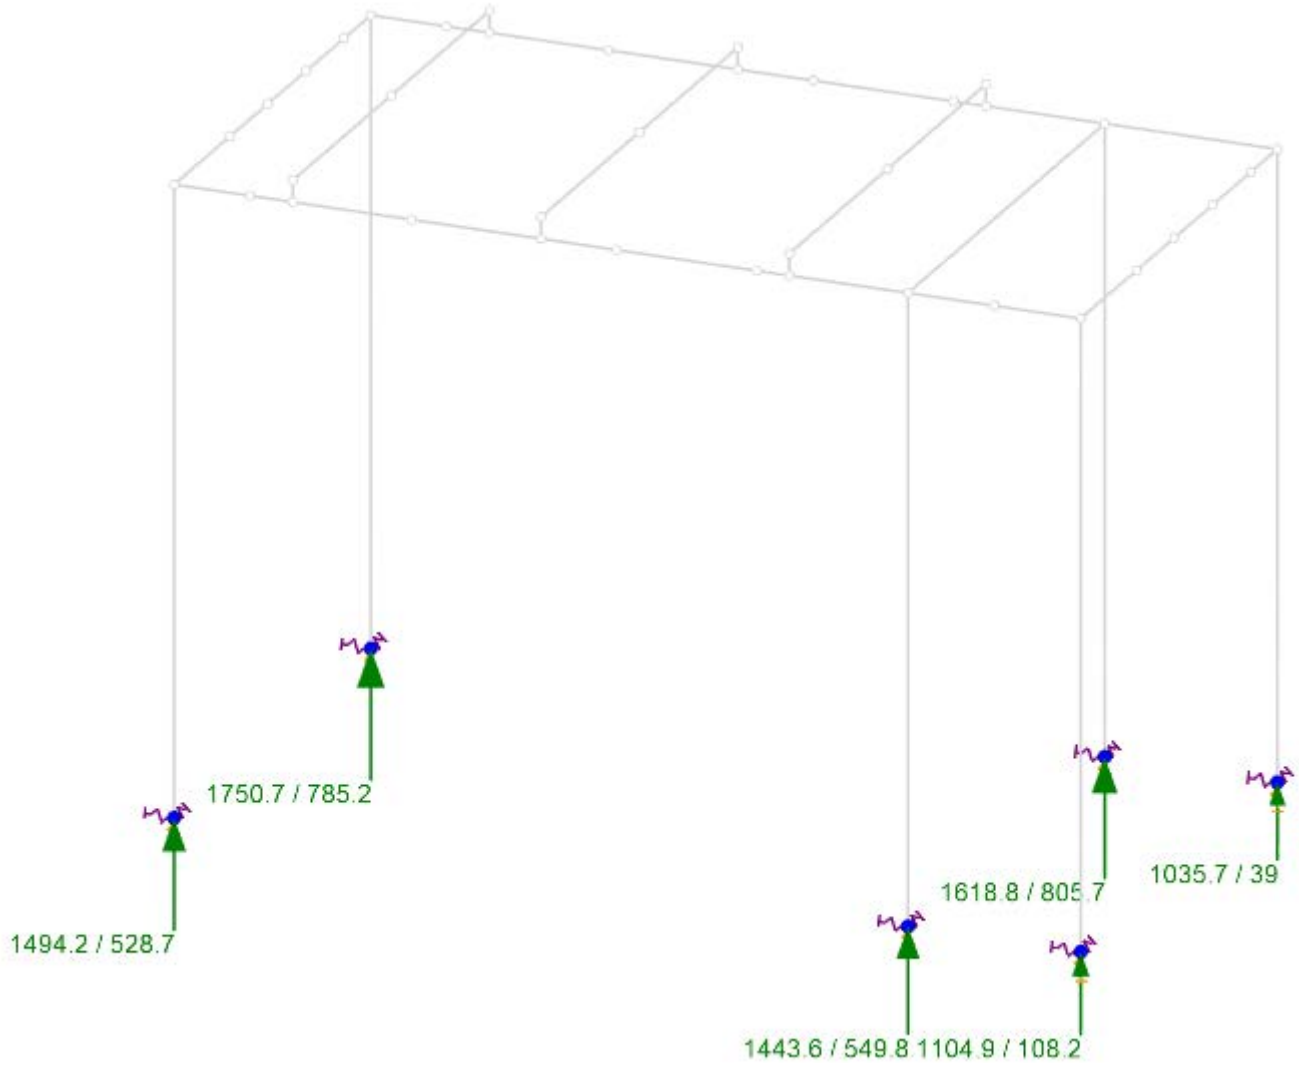


Enveloped Vertical Reactions - Video Wall on Center of Beam

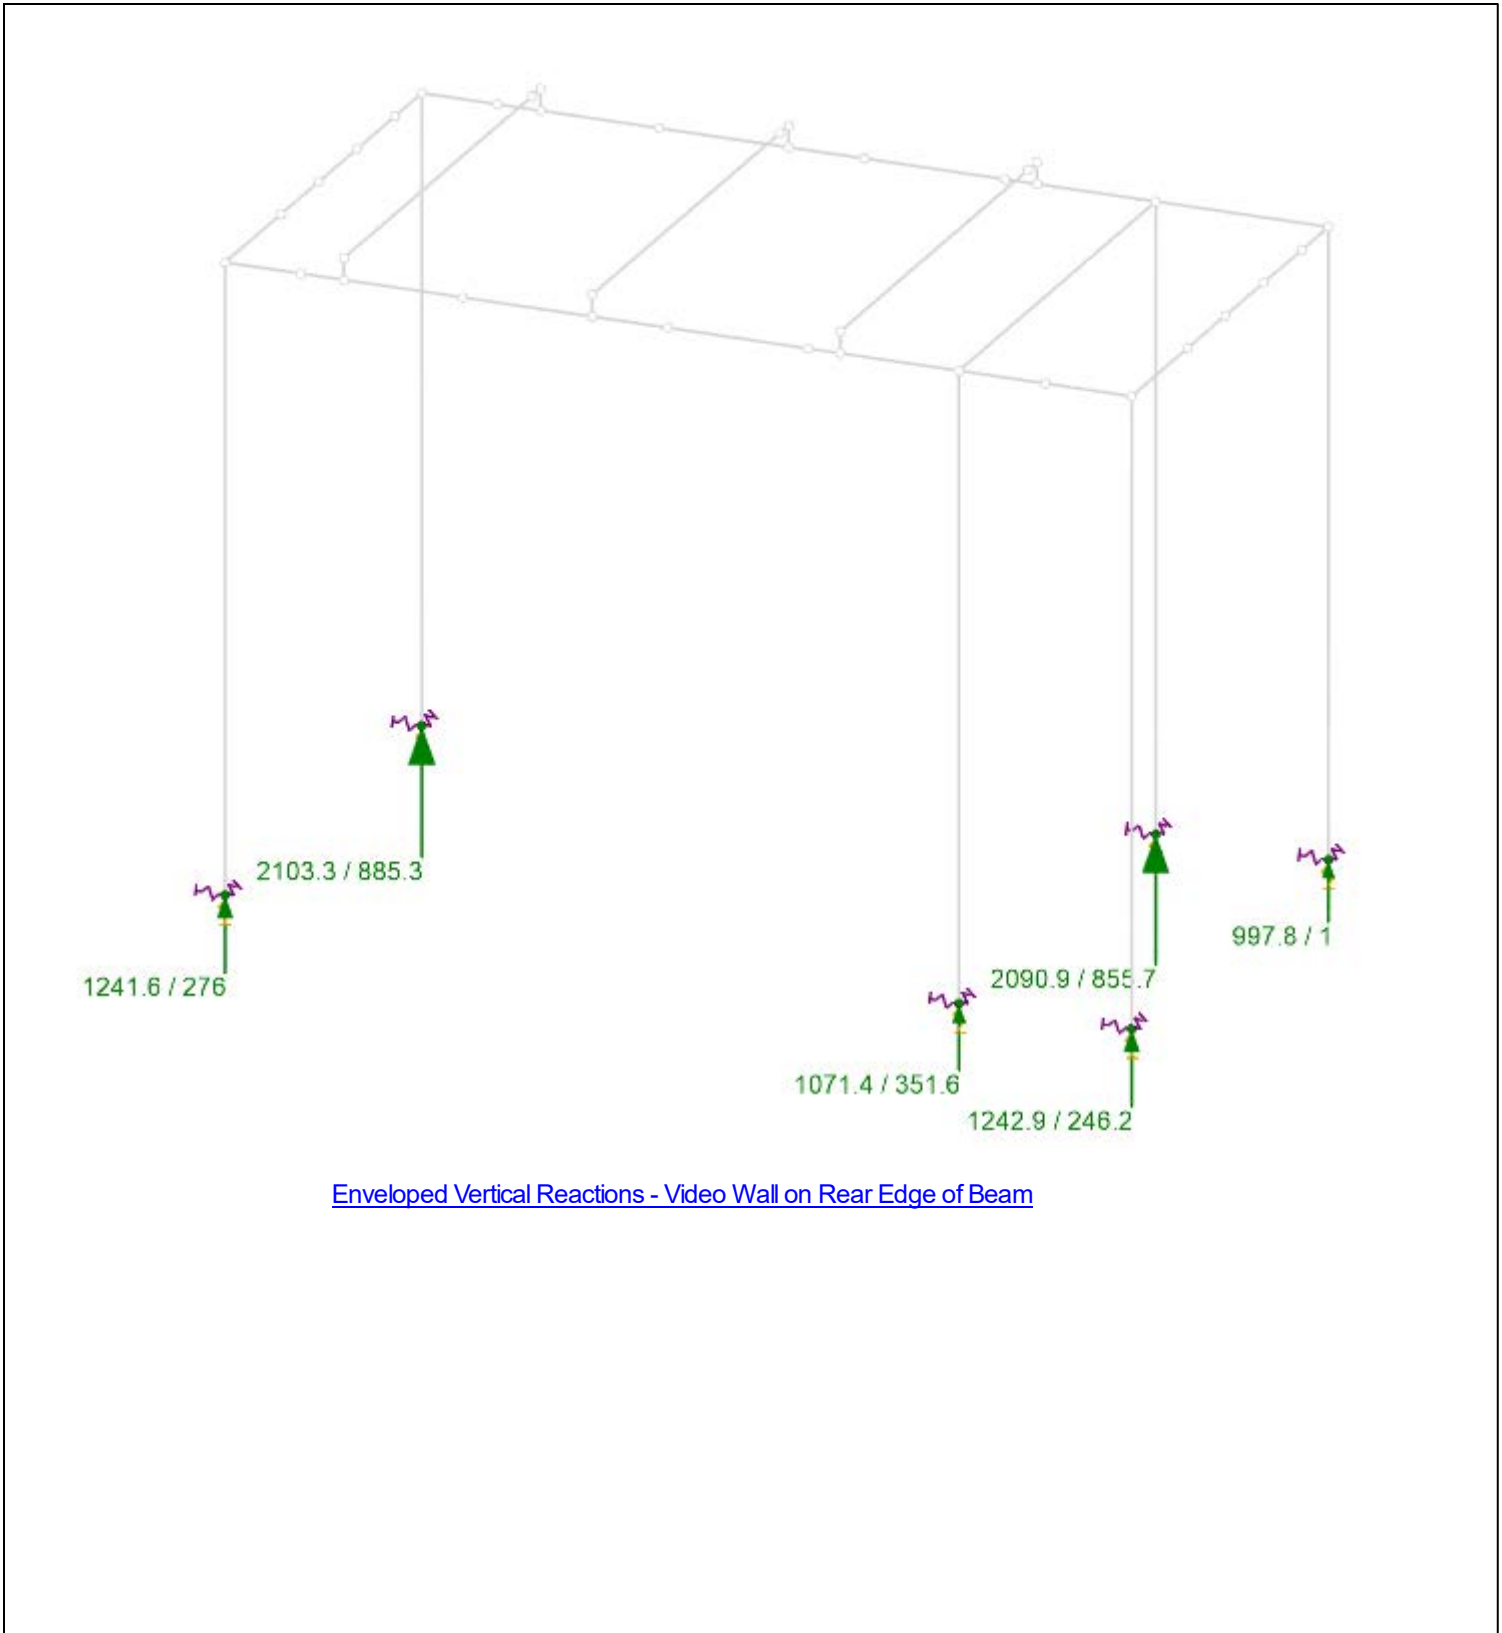


Enveloped Vertical Reactions - Video Wall on Rear Edge of Beam

Strength Checks:


S4x7.7 I-Beam:

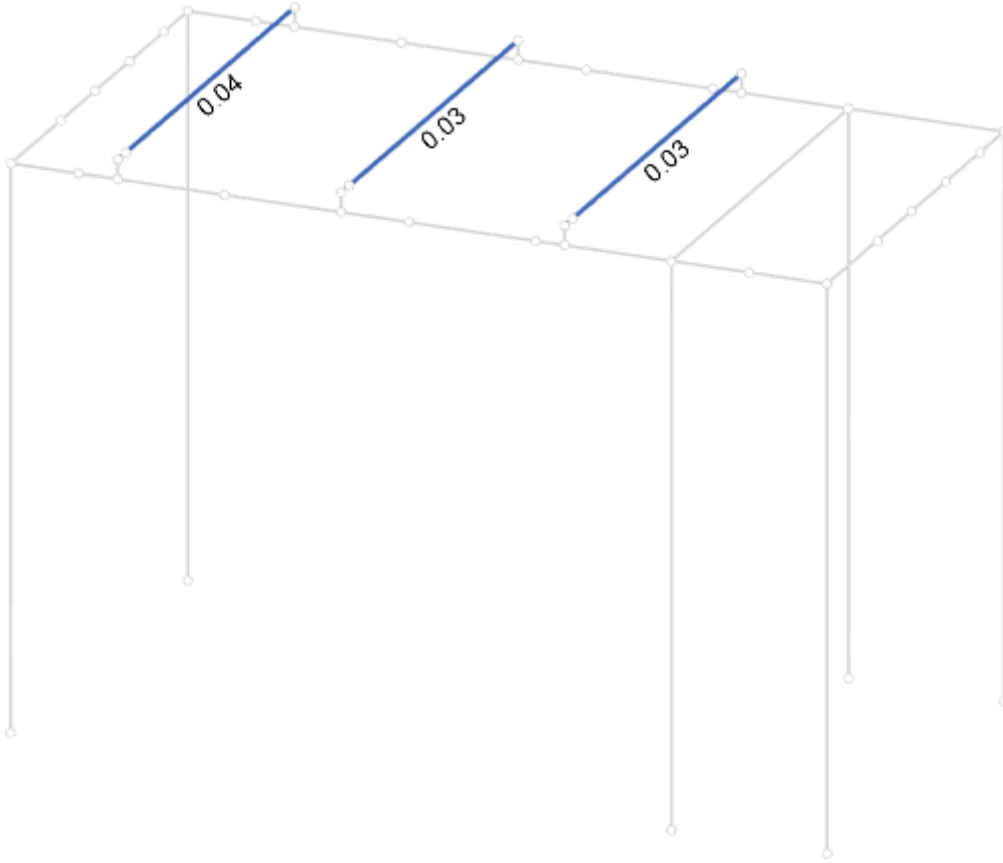

Unity Check - Video Wall at Front Edge of Beam

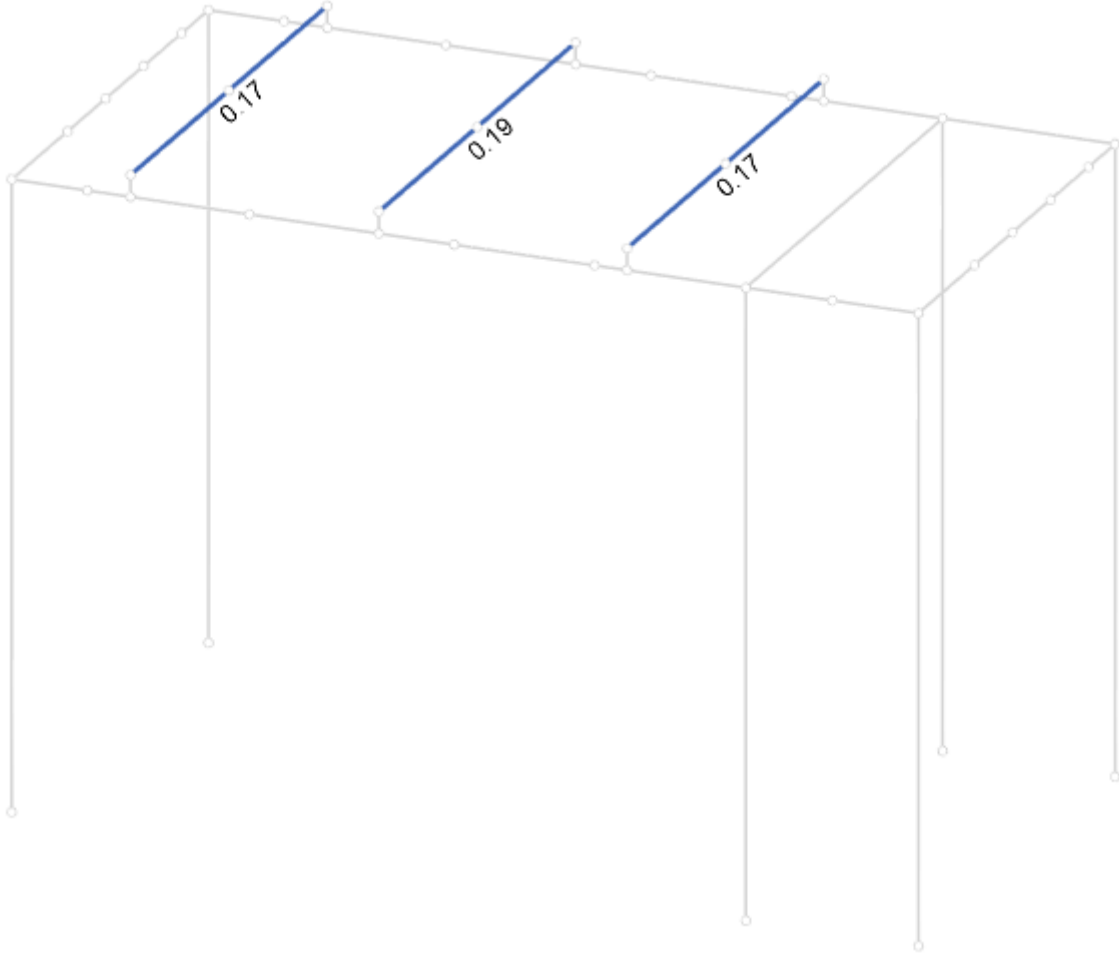

[Unity Check - Video Wall Centered on Beam](#)

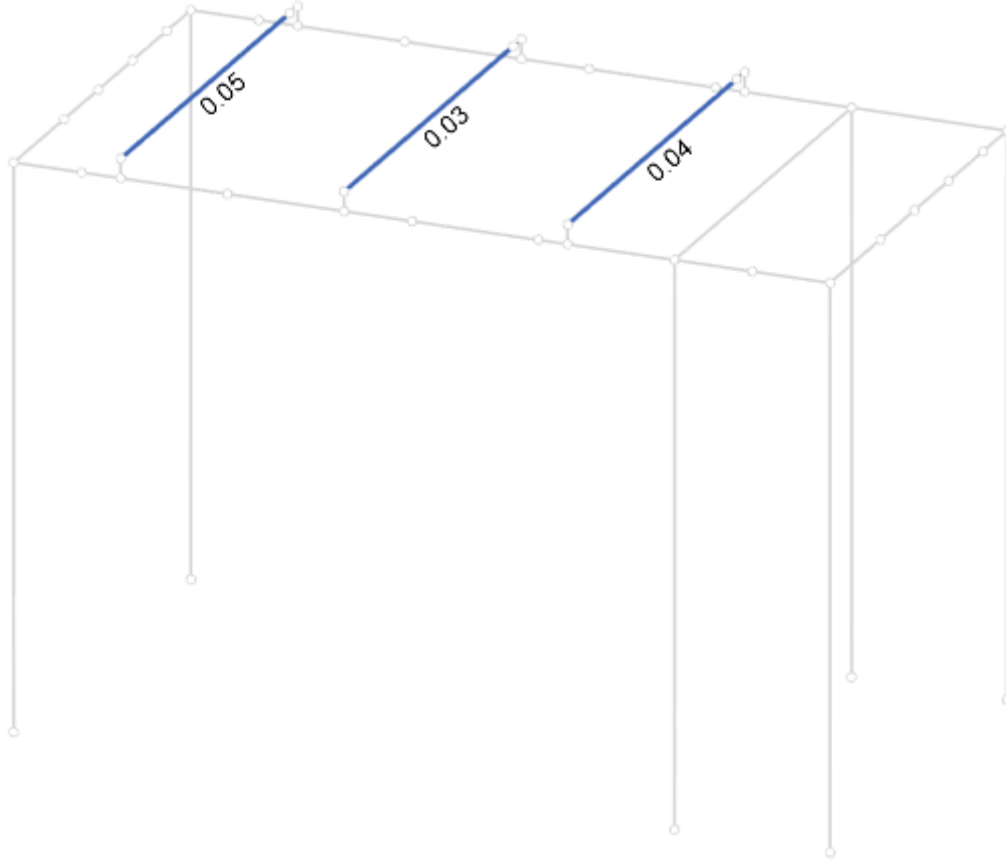

[Unity Check - Video Wall at Rear Edge of Beam](#)

12" x 12" Truss:

12" Truss Review

Axial Capacity:	14400	lb
Shear Capacity (Y-axis):	2454	lb
Shear Capacity (Z-axis):	981	lb
Moment Capacity (Y-axis):	2400	lb-ft
Moment Capacity (Z-axis):	6000	lb-ft
Chord Area:	0.736	in ²

Truss Brand:	Tomcat
Truss Size:	Core 12x12 Plated
Shear Weak/Strong Axis Ratio:	0.4
Moment Weak/Strong Axis Ratio:	0.4

Maximum:	1528	798	157	107	1918	2574
Minimum:	-349	-871	-140	-118	-1803	-2235

Controlling Strength Ratio	
0.889	0.35

Case	Member	Location	Forces					Strength Ratio	
			Axial [lb]	Shear Y [lb]	Shear Z [lb]	Torque [lb-ft]	Moment YY [lb-ft]	Moment ZZ [lb-ft]	Axial + Moment

[Unity Check - Video Wall at Front Edge of Beam](#)

12" Truss Review

Axial Capacity:	14400	lb
Shear Capacity (Y-axis):	2454	lb
Shear Capacity (Z-axis):	981	lb
Moment Capacity (Y-axis):	2400	lb-ft
Moment Capacity (Z-axis):	6000	lb-ft
Chord Area:	0.736	in ²

Truss Brand:	Tomcat
Truss Size:	Core 12x12 Plated
Shear Weak/Strong Axis Ratio:	0.4
Moment Weak/Strong Axis Ratio:	0.4

Maximum:	1340	576	337	214	1580	2313
Minimum:	-422	-618	-338	-203	-1607	-2308

Controlling Strength Ratio	
0.738	0.34

Case	Member	Location	Forces					Strength Ratio	
			Axial [lb]	Shear Y [lb]	Shear Z [lb]	Torque [lb-ft]	Moment YY [lb-ft]	Moment ZZ [lb-ft]	Axial + Moment

[Unity Check - Video Wall Centered on Beam](#)



12" Truss Review

Axial Capacity:	14400	lb
Shear Capacity (Y-axis):	2454	lb
Shear Capacity (Z-axis):	981	lb
Moment Capacity (Y-axis):	2400	lb-ft
Moment Capacity (Z-axis):	6000	lb-ft
Chord Area:	0.736	in ²

Truss Brand:	Tomcat
Truss Size:	Core 12x12 Plated
Shear Weak/Strong Axis Ratio:	0.4
Moment Weak/Strong Axis Ratio:	0.4

Maximum:	1703	871	159	129	2057	2788
Minimum:	-418	-952	-149	-118	-1938	-2274

Controlling Strength Ratio	
0.952	0.39

Case	Member	Location	Forces				Strength Ratio	
			Axial [lb]	Shear Y [lb]	Shear Z [lb]	Torque [lb-ft]	Moment YY [lb-ft]	Moment ZZ [lb-ft]

[Unity Check - Video Wall at Rear Edge of Beam](#)



STRUCTURAL SUBMITTAL PACKAGE

for

Big Art

BIG TV

Project Location: Varies

Event Dates: Varies (installation shall not exceed 1 week)

Submittal Date: 9/9/2025


Clark Reder Project Number: 25.401.197








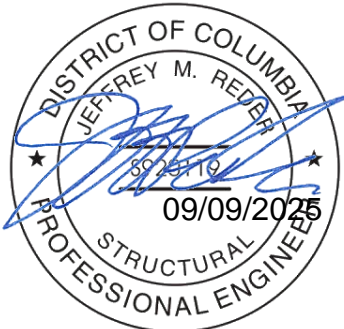

Reviewed by:

Prepared by:

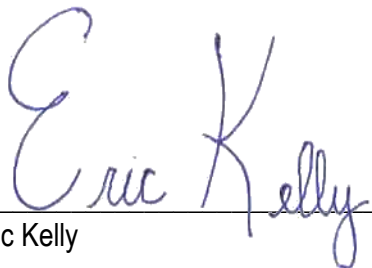

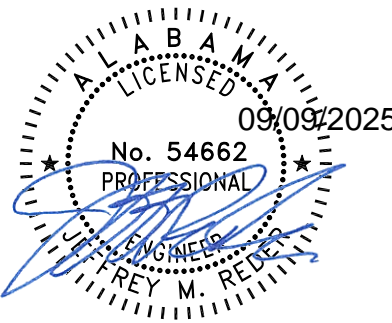Jeffrey M. Reder, P.E.
CA Registration #: C70581




Eric Kelly

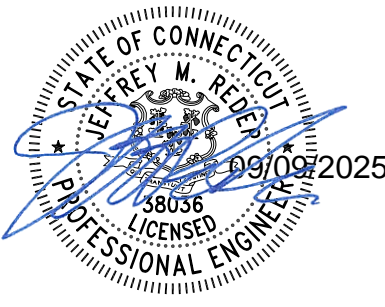






<p style="text-align: center;">Alabama</p>  <p style="text-align: center;">Jeffrey M. Reder, P.E. P.E. #: 54662</p>	<p style="text-align: center;">Arizona</p>  <p style="text-align: center;">Jeffrey M. Reder, P.E. P.E. # 50654</p>	<p style="text-align: center;">Arkansas</p>  <p style="text-align: center;">Jeffrey M. Reder, P.E. P.E. # 23061</p>
<p style="text-align: center;">California</p>  <p style="text-align: center;">Jeffrey M. Reder, C.E. P.E. # C 70581</p>	<p style="text-align: center;">Colorado</p>  <p style="text-align: center;">Jeffrey M. Reder, P.E. P.E. # PE0051394</p>	<p style="text-align: center;">Connecticut</p>  <p style="text-align: center;">Jeffrey M. Reder, P.E. P.E. # 38036</p>
<p style="text-align: center;">Delaware</p>  <p style="text-align: center;">Jeffrey M. Reder, P.E. P.E. # 17438</p>	<p style="text-align: center;">District of Columbia</p>  <p style="text-align: center;">Jeffrey M. Reder, P.E. P.E. # S920119</p>	<p style="text-align: center;">Florida</p>  <p style="text-align: center;">Jeffrey M. Reder, P.E. P.E. # 68622</p>
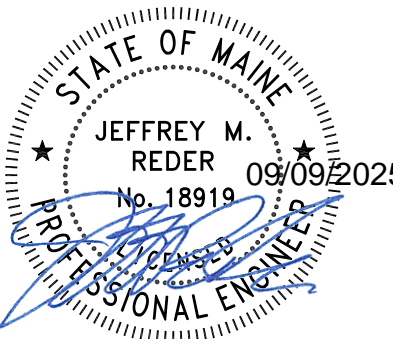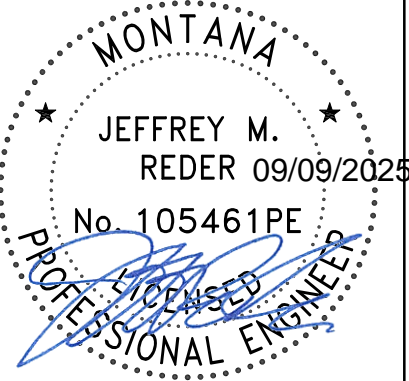
<p style="text-align: center;">Georgia</p>  <p style="text-align: center;">Jeffrey M. Reder, P.E. P.E. # PE034581</p>	<p style="text-align: center;">Hawaii</p>  <p style="text-align: center;">Jeffrey M. Reder, P.E. P.E. # 14362-S</p>	<p style="text-align: center;">Idaho</p>  <p style="text-align: center;">Jeffrey M. Reder, P.E. P.E. # 5561572</p>
<p style="text-align: center;">Illinois</p>  <p style="text-align: center;">Jeffrey M. Reder, S.E. P.E. # 81006866</p> <p style="color: red; font-size: small;">Clark Reder Engineering, Inc. is a professional design firm registered in Illinois #184.006693</p>	<p style="text-align: center;">Indiana</p>  <p style="text-align: center;">Jeffrey M. Reder, P.E. P.E. # PE11600603</p>	<p style="text-align: center;">Iowa</p>  <p style="text-align: center;">Jeffrey M. Reder, P.E. P.E. # 19998</p>
<p style="text-align: center;">Kansas</p>  <p style="text-align: center;">Jeffrey M. Reder, P.E. P.E. # 30951</p>	<p style="text-align: center;">Kentucky</p>  <p style="text-align: center;">Jeffrey M. Reder, P.E. P.E. # 23597</p>	<p style="text-align: center;">Louisiana</p>  <p style="text-align: center;">Jeffrey M. Reder, P.E. P.E. # 30304</p>

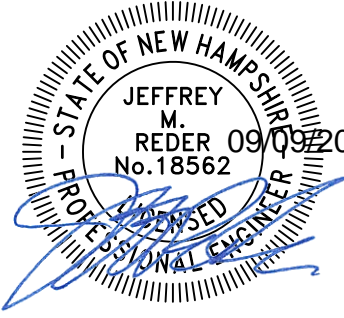Project: BIG TV
 Client: Big Art

CRE Project #: 25.401.197
 Date: 09/09/2025
 Engineer: EPK

<p style="text-align: center;">Maine</p>  <p style="text-align: center;">Jeffrey M. Reder, P.E. P.E. # 18919</p>	<p style="text-align: center;">Maryland</p>  <p>Professional Certification: I hereby certify that these documents were prepared or approved by me, and that I am a duly licensed professional engineer under the laws of the State of Maryland, License # 38421, Expiration Date: 1/29/2025</p> <p style="text-align: center;">Jeffrey M. Reder, P.E. P.E. # 38421</p>	<p style="text-align: center;">Massachusetts</p>  <p style="text-align: center;">Jeffrey M. Reder, P.E. P.E. # 48535</p>
<p style="text-align: center;">Michigan</p>  <p style="text-align: center;">Jeffrey M. Reder, P.E. P.E. # 6201056952</p>	<p style="text-align: center;">Minnesota</p>  <p style="text-align: center;">Jeffrey M. Reder, P.E. P.E. # 56104</p>	<p style="text-align: center;">Mississippi</p>  <p style="text-align: center;">Jeffrey M. Reder, P.E. P.E. # 35564</p> <p style="color: red; font-size: small;">"I have reviewed this document in sufficient depth to accept full responsibility for its contents and to assure code compliance and coordination"</p>
<p style="text-align: center;">Missouri</p>  <p style="text-align: center;">Jeffrey M. Reder, P.E. P.E. # PE-2010003345</p>	<p style="text-align: center;">Montana</p>  <p style="text-align: center;">Jeffrey M. Reder, P.E. P.E. # 105461PE</p>	<p style="text-align: center;">Nebraska</p>  <p style="text-align: center;">Jeffrey M. Reder, P.E. P.E. # E-20901</p>

<p style="text-align: center;">Nevada</p>  <p style="text-align: center;">Jeffrey M. Reder, P.E. P.E. # 020117</p>	<p style="text-align: center;">New Hampshire</p>  <p style="text-align: center;">Jeffrey M. Reder, P.E. P.E. # 18562</p>	<p style="text-align: center;">New Jersey</p>  <p style="text-align: center;">Jeffrey M. Reder, P.E. P.E. # 24GE05300600</p>
<p style="text-align: center;">New Mexico</p>  <p style="text-align: center;">Jeffrey M. Reder, P.E. P.E. # 30232</p>	<p style="text-align: center;">New York</p>  <p style="text-align: center;">Jeffrey M. Reder, P.E. P.E. # 097763-1</p> <p style="font-size: small;">It is a violation of law for any person, unless acting under the direction of a licensed professional engineer, to alter this document in any way. If any part of this document is altered, the altering engineer shall affix to this document their seal and the notation "altered by" followed by their signature, the date, and description.</p>	<p style="text-align: center;">North Carolina</p>  <p style="text-align: center;">Jeffrey M. Reder, P.E. P.E. # 046939</p>
<p style="text-align: center;">North Dakota</p>  <p style="text-align: center;">Jeffrey M. Reder, P.E. P.E. # PE-40952</p>	<p style="text-align: center;">Ohio</p>  <p style="text-align: center;">Jeffrey M. Reder, P.E. P.E. # E-67450</p>	<p style="text-align: center;">Oklahoma</p>  <p style="text-align: center;">Jeffrey M. Reder, P.E. P.E. # 24780</p>

<p style="text-align: center;">Oregon</p> <p style="text-align: center;">Jeffrey M. Reder, P.E. P.E. # 93904PE</p>	<p style="text-align: center;">Pennsylvania</p> <p style="text-align: center;">Jeffrey M. Reder, P.E. P.E. # PE77455</p>	<p style="text-align: center;">Rhode Island</p> <p style="text-align: center;">Jeffrey M. Reder, P.E. P.E. # 9610</p>
<p style="text-align: center;">South Carolina</p> <p style="text-align: center;">Jeffrey M. Reder, P.E. P.E. # 35797</p>	<p style="text-align: center;">South Carolina</p> <p style="text-align: center;">Clark Reder Engineering P.E. # 4827</p>	<p style="text-align: center;">South Dakota</p> <p style="text-align: center;">Jeffrey M. Reder, P.E. P.E. # 17310</p>
<p style="text-align: center;">Tennessee</p> <p style="text-align: center;">Jeffrey M. Reder, P.E. P.E. # 00113846</p>	<p style="text-align: center;">Texas</p> <p style="text-align: center;">Jeffrey M. Reder, P.E. P.E. # 124100</p> <p style="text-align: right; color: red; font-size: small;">Clark Reder Engineering F-12154</p>	<p style="text-align: center;">Utah</p> <p style="text-align: center;">Jeffrey M. Reder, P.E. P.E. # 7536302-2203</p>

<p style="text-align: center;">Vermont</p>  <p style="text-align: center;">Jeffrey M. Reder, P.E. P.E. # 136107</p>	<p style="text-align: center;">Virginia</p>  <p style="text-align: center;">Jeffrey M. Reder, P.E. P.E. # 402061022</p>	<p style="text-align: center;">Washington</p>  <p style="text-align: center;">Jeffrey M. Reder, P.E. P.E. # 56469</p>
<p style="text-align: center;">West Virginia</p>  <p style="text-align: center;">Jeffrey M. Reder, P.E. P.E. # 18628</p>	<p style="text-align: center;">Wisconsin</p>  <p style="text-align: center;">Jeffrey M. Reder, P.E. P.E. # E-101335</p>	<p style="text-align: center;">Wyoming</p>  <p style="text-align: center;">Jeffrey M. Reder, P.E. P.E. # 13434</p>
 <p style="text-align: center;">10Sep2025 ID # 156859</p> <div style="border: 1px solid black; padding: 5px;"> <p style="text-align: center;">PERMIT TO PRACTICE TREVITECH CONSULTING LTD.</p> <p>RM SIGNATURE: _____ <i>Jeffrey M. Reder</i></p> <p>RM APEGA ID #: _____ 156859</p> <p>DATE: _____</p> <p style="text-align: center;">PERMIT NUMBER: P014295</p> <p style="text-align: center;"><small>The Association of Professional Engineers and Geoscientists of Alberta (APEGA)</small></p> </div>		

Project: BIG TV
 Client: Big Art

CRE Project #: 25.401.197
 Date: 09/09/2025
 Engineer: EPK



Table of Contents for Structural Submittal Package

Cover Page	1
50 State Stamps	2-7
Table of Contents	8
Project Information	9
General Notes	10-11
Operations Management Plan	12
Reference Drawings	Appendix A
Calculations	Appendix B

Project Information

Project Summary

The project referenced by this submittal consists of a temporary aluminum truss structure. The structure will be used to support scenic cladding, as well as a video wall that is attached to (3) I-beams. The structure will be installed in various locations for various events, with each installation lasting approximately 1 week.

The structure is composed of 12" x 12" aluminum box truss from Unisson or equivalent. The I-beams are S4x7.7 beams and will be used to support a video wall that weighs approximately 1400 pounds. The video wall is attached via I-beam trolleys and will be free to move along the beam. Clark Reder Engineering did not review the structure for any dynamic loads but reviewed the structure for various loading conditions assuming a static load only.

Scope of Review

Clark Reder Engineering reviewed the structure for lateral and gravity loads. The structure was reviewed for 40mph wind speeds with scenic cladding attached to the truss and LED attached to the I-beams, as well as 67mph wind speeds on the bare structure.

No review was performed on the scenic elements or their attachment to the structure.

Conclusions

Our review has concluded that the structure meets the structural requirements of the 2021 International Building Code, National Building Code – 2023 Alberta Edition, ASCE 7-16, and ASCE 37-14.

Limitations and Exceptions

The scope of review for this submittal is limited to the items listed above. All other temporary or permanent structures on site not specifically referenced above under "Scope of Review" are the responsibility of others.

Where the items covered by this submittal are attached to existing structures, it is the responsibility of the engineer of record for those existing structures to review the impact of the elements referenced in this submittal.



GENERAL STRUCTURAL NOTES

EVENT DATE & LOCATION

1. EVENT DATE: VARIES
2. EVENT LOCATION: VARIES

CODES

1. 2021 INTERNATIONAL BUILDING CODE
2. NATIONAL BUILDING CODE – 2023 ALBERTA EDITION
3. ASCE 7-16: MINIMUM DESIGN LOADS AND ASSOCIATED CRITERIA FOR BUILDINGS AND OTHER STRUCTURES
4. ASCE 37-14: DESIGN LOADS ON STRUCTURES DURING CONSTRUCTION
5. 2020 ALUMINUM DESIGN MANUAL

REFERENCES

1. ANSI E1.21-2013 ENTERTAINMENT TECHNOLOGY, "TEMPORARY GROUND-SUPPORTED OVERHEAD STRUCTURES USED TO COVER THE STAGE AREAS AND SUPPORT EQUIPMENT IN THE PRODUCTION OF OUTDOOR ENTERTAINMENT EVENTS"
2. ANSI E1.2-2012 ENTERTAINMENT TECHNOLOGY, "DESIGN, MANUFACTURE AND USE OF ALUMINUM TRUSSES AND TOWERS"

DESIGN LOADS

1. DEAD LOAD: SELF-WEIGHT OF STRUCTURE
2. RIGGING LOADS: SEE ATTACHED DRAWINGS
3. WIND LOADS:
 - A. WIND RISK CATEGORY: II
 - B. BEFORE HIGH WIND ACTION PLAN IS ACTIVATED:
 1. DESIGN SERVICE-LEVEL WIND SPEED: 40 MPH
 2. EXPOSURE: C
 - C. AFTER HIGH WIND ACTION PLAN IS ACTIVATED:
 1. DESIGN SERVICE-LEVEL WIND SPEED: 67 MPH
 - a. REQUIRED WIND SPEED HAS BEEN REDUCED IN ACCORDANCE WITH ASCE 37-14 DUE TO THE TEMPORARY NATURE OF STRUCTURE
 2. EXPOSURE: C
 - D. SITE ELEVATION: 0 FT
 - E. REFERENCE THE HIGH WIND ACTION PLAN FOR SPECIFIC ACTIONS THAT SHALL BE TAKEN TO ENSURE STABILITY OF THE TEMPORARY STRUCTURE IN HIGH WINDS.
4. SEISMIC LOADS DO NOT CONTROL THE DESIGN OF THIS STRUCTURE.

CONSTRUCTION AND SAFETY

1. ENGINEER SHALL NOT BE RESPONSIBLE FOR MEANS, METHODS, OR SEQUENCE OF CONSTRUCTION UNLESS SPECIFICALLY STATED ON THE DRAWINGS.
2. ENGINEER HAS DESIGNED THE STRUCTURES FOR THEIR FINAL AS-BUILT CONDITION. ENGINEER IS NOT RESPONSIBLE FOR TEMPORARY STABILITY OF STRUCTURES DURING ERECTION UNLESS SPECIFICALLY STATED ON THE DRAWINGS.
3. STRUCTURE HAS BEEN DESIGNED AS A TEMPORARY STRUCTURE THAT SHALL BE IN PLACE FOR LESS THAN SIX WEEKS.

FOUNDATIONS

1. THE STRUCTURE IS ASSUMED TO BE FOUNDED ON LEVEL GROUND (CONCRETE, ASPHALT, GRASS, ETC) WITH A MINIMUM NET ALLOWABLE BEARING CAPACITY OF 1500 PSF.

BALLAST

1. BALLAST SHALL BE INSTALLED PER THE ENGINEERING DRAWINGS. DEVIATIONS IN WEIGHT OR PLACEMENT SHALL BE APPROVED IN WRITING BY THE ENGINEER OF RECORD.
2. BALLAST SHALL NOT BE INSTALLED ON GRAVEL, ICE, GRASS, SLOPING OR OTHERWISE UNSTABLE TERRAIN UNLESS MEANS TO PREVENT SLIDING ARE PROVIDED.
3. BALLAST AMOUNTS GIVEN CONSIDER UPLIFT AND SLIDING, WITH A MINIMUM 1.5 FACTOR OF SAFETY AGAINST OVERTURNING.



RIGGING

1. ALL POINTS SHALL BE DEAD HUNG POINTS.
2. ALL RIGGING SHALL BE HUNG FROM PANEL POINTS (LOCATIONS ON THE TRUSS CHORDS BRACED BOTH VERTICALLY AND HORIZONTALLY) UNLESS SPECIFICALLY APPROVED BY THE ENGINEER OF RECORD.
3. BRIDLES SHALL NOT BE USED UNLESS SPECIFICALLY ALLOWED BY THE ENGINEER OF RECORD.

ALUMINUM TRUSS

1. ALUMINUM TRUSS SHALL BE MANUFACTURED BY ONE OF THE FOLLOWING COMPANIES OR AN APPROVED EQUAL:
 - A. TOTAL STRUCTURES
 - B. UNISSON
 - C. JAMES THOMAS ENGINEERING
 - D. TOMCAT USA
2. TRUSS TO TRUSS CONNECTION HARDWARE (UNLESS NOTED OTHERWISE):
 - A. PLATED ENDS: 5/8"Ø GRADE 8 BOLTS
3. TRUSS END PLATE BOLTS SHALL BE TIGHTED TO THE SNUG TIGHT CONDITION. SNUG TIGHT CONDITION EXISTS WHEN ALL PLIES IN THE CONNECTION HAVE BEEN PULLED INTO FIRM CONTACT BY THE BOLTS AND ALL BOLTS HAVE BEEN TIGHTENED SUFFICIENTLY TO PREVENT REMOVAL OF THE NUTS WITHOUT THE USE OF WRENCH.
4. UNLESS NOTED OTHERWISE, ALL LOADS SHALL BE APPLIED TO TRUSSES AT PANEL POINTS.
5. RATED SPANS, CAPACITIES AND LOADING CONDITIONS PUBLISHED BY THE TRUSS MANUFACTURER SHALL NOT BE EXCEEDED UNLESS REVIEWED AND APPROVED BY A LICENSED ENGINEER FOR A SPECIFIC USE.
6. DO NOT PLACE LIGHTING CLAMPS OR WIRE ROPE IN DIRECT CONTACT WITH THE TRUSS UNLESS THE CHORD MATERIAL IS PROTECTED FROM DAMAGE DUE TO OVERTIGHTENING OR WIRE ROPE RUBBING.

STRUCTURAL STEEL

1. ALL STEEL DETAILING, FABRICATION, AND ERECTION SHALL CONFORM TO THE LATEST VERSION OF THE FOLLOWING SPECIFICATIONS UNLESS NOTED OTHERWISE ON THE DRAWINGS:
 - A. AISC 360: SPECIFICATION FOR STRUCTURAL STEEL BUILDINGS
 - B. AISC 303: CODE OF STANDARD PRACTICE FOR STEEL BUILDINGS AND BRIDGES
 - C. RCSC SPECIFICATION FOR STRUCTURAL JOINTS USING HIGH-STRENGTH BOLTS
 - D. AWS D1.1: STRUCTURAL WELDING CODE-STEEL
2. STRUCTURAL STEEL SHALL CONFORM TO THE FOLLOWING CRITERIA UNLESS NOTED OTHERWISE ON THE DRAWINGS:
 - A. ROLLED WIDE FLANGE SHAPES: ASTM A992, FY = 50 KSI
 - B. MISC PLATE, BAR, ANGLES AND CHANNELS: ASTM A36, FY = 36 KSI
 - C. PIPE SHAPES: ASTM A53, TYPE E OR S, GRADE B, FY = 35 KSI
 - D. HSS TUBES: ASTM A500 GR B, FY = 46 KSI
 - E. HSS ROUND: ASTM A500 GR B, FY = 42KSI
 - F. BOLTS: ASTM A325-N
 - G. HARDENED WASHERS: ASTM F436
 - H. NUTS: ASTM A563

INSPECTIONS

1. ALL TRUSS UNITS, I-BEAMS AND/OR OTHER RIGGING EQUIPMENT SHALL BE VISUALLY INSPECTED PRIOR TO ERECTION. DAMAGED OR CORRODED EQUIPMENT SHALL NOT BE USED. FIELD MODIFICATIONS SHALL BE APPROVED BY THE ENGINEER OF RECORD PRIOR TO INSTALLATION.



OPERATIONS MANAGEMENT PLAN

IMPLEMENTATION OF PLAN

1. PRIOR TO EACH INSTALLATION, THE TRUSS PROVIDER IN CONJUNCTION WITH THE VENUE, SHALL DESIGNATE A RESPONSIBLE PERSON IN CHARGE OF IMPLEMENTING ALL PHASES OF THE OPERATIONS MANAGEMENT PLAN AS IT PERTAINS TO THE STRUCTURE.
2. A MEETING SHALL BE HELD AT THE VENUE WITH THE PROMOTER, OWNER OR STAGE MANAGER TO DISCUSS THE HIGH WIND ACTION PLAN AND OTHER OPERATIONAL ITEMS.

DAILY OPERATIONS PLAN

1. CHECK WEATHER EACH MORNING AND PERIODICALLY THROUGHOUT THE DAY.
2. CHECK TOWER BASES DAILY TO ENSURE ALL REMAIN LEVEL AND PLUMB
3. CHECK GUY WIRES AND BALLAST ASSEMBLIES DAILY TO VERIFY LINES ARE TENSIONED AND BALLAST HAS NOT MOVED.
4. PROVIDE A DAILY LOG OF THE ABOVE CHECKS FOR EACH INSTALLATION.

HIGH WIND ACTION PLAN

1. THE HIGH WIND ACTION PLAN SHALL BE IN EFFECT FOR THE ENTIRETY OF THE INSTALLATION. AN INSTALLATION SHALL BE DEFINED AS STARTING AT THE INITIAL COMMENCEMENT OF THE STRUCTURE INSTALLATION AND ENDING ONCE THE STRUCTURE IS COMPLETELY DISMANTLED.
2. A COMPETENT RESPONSIBLE PERSON FROM THE TRUSS PROVIDER OR VENUE SHALL BE PRESENT FOR THE DURATION OF THE EVENT TO IMPLEMENT THE HIGH WIND ACTION PLAN (SEE ABOVE).
3. A REGULAR LIAISON WITH LOCAL AIRPORTS AND/OR WEATHER INFORMATION CENTERS SHALL BE MAINTAINED TO ASCERTAIN IF ANY SIGNIFICANT WEATHER EVENTS ARE EXPECTED IN THE IMMEDIATE VICINITY OF THE STRUCTURE
4. AN ANEMOMETER SHALL BE PLACED ON THE STRUCTURE TO MONITOR WIND SPEEDS. THE ANEMOMETER SHALL BE PLACED AT THE TOP OF A TOWER OR AN ADJACENT STRUCTURE AT A HEIGHT EQUIVALENT TO THE HEIGHT OF THE TOWER. THE ANEMOMETER SHALL BE LOCATED WITHIN 50 YARDS OF THE STRUCTURE.
5. NOTED WIND SPEEDS ARE 3-SECOND GUSTS IN ACCORDANCE WITH ASCE 7
6. **WHEN THE STRUCTURE IS UNATTENDED OR NOT IN USE:** SCENIC CLADDING SHALL BE REMOVED FROM THE STRUCTURE IF WINDS ARE EXPECTED TO EXCEED 35MPH WHILE LEFT UNATTENDED.
7. **WHEN WIND SPEEDS ARE EXPECTED TO EXCEED 30 MPH:** A TEAM OF QUALIFIED PERSONNEL SHALL BE PUT ON ALERT. ALL NECESSARY PERSONNEL SHALL BE IN PLACE AND PUT ON STANDBY.
8. **WHEN WIND SPEEDS ARE EXPECTED TO EXCEED 40 MPH:**
 - a. ALL SHOW OPERATIONS SHALL BE SUSPENDED, AND THE IMMEDIATE AREA SHALL BE EVACUATED OF ALL PATRONS AND NON-ESSENTIAL PERSONNEL.
 - b. SCENIC CLADDING SHALL BE REMOVED FROM THE STRUCTURE.
 - c. VIDEO WALL SHALL BE LOWERED TO THE GROUND AND SECURED AGAINST MOVEMENT.
9. **AT WINDS SPEEDS IN EXCESS OF 50 MPH:** ALL PERSONNEL SHOULD MAINTAIN SAFE DISTANCE FROM THE STRUCTURE.
10. THE HIGH WIND ACTION PLAN SHALL BE POSTED AT A CONSPICUOUS AREA ON SITE. IT MUST BE AVAILABLE AT ALL TIMES TO VENUE OPERATORS AND CREW.
11. FAILURE TO FOLLOW THE HIGH WIND ACTION PLAN MAY RESULT IN COLLAPSE OF THE STRUCTURE, DAMAGE TO EQUIPMENT AND INJURY TO PERSONS.

PLAN EXCEPTIONS

1. THIS PLAN IS SPECIFIC TO THE STRUCTURE LISTED IN THIS SUBMITTAL. THE EVENT OPERATIONS MANAGEMENT PLAN, IF MORE STRINGENT, SHALL BE FOLLOWED.




APPENDIX A


REFERENCE DRAWINGS

1

B!G TV
Scale: 1:35

SCENIC CLADDING SHALL BE
REMOVED IF WINDS ARE EXPECTED
TO EXCEED 40MPH - TYP.

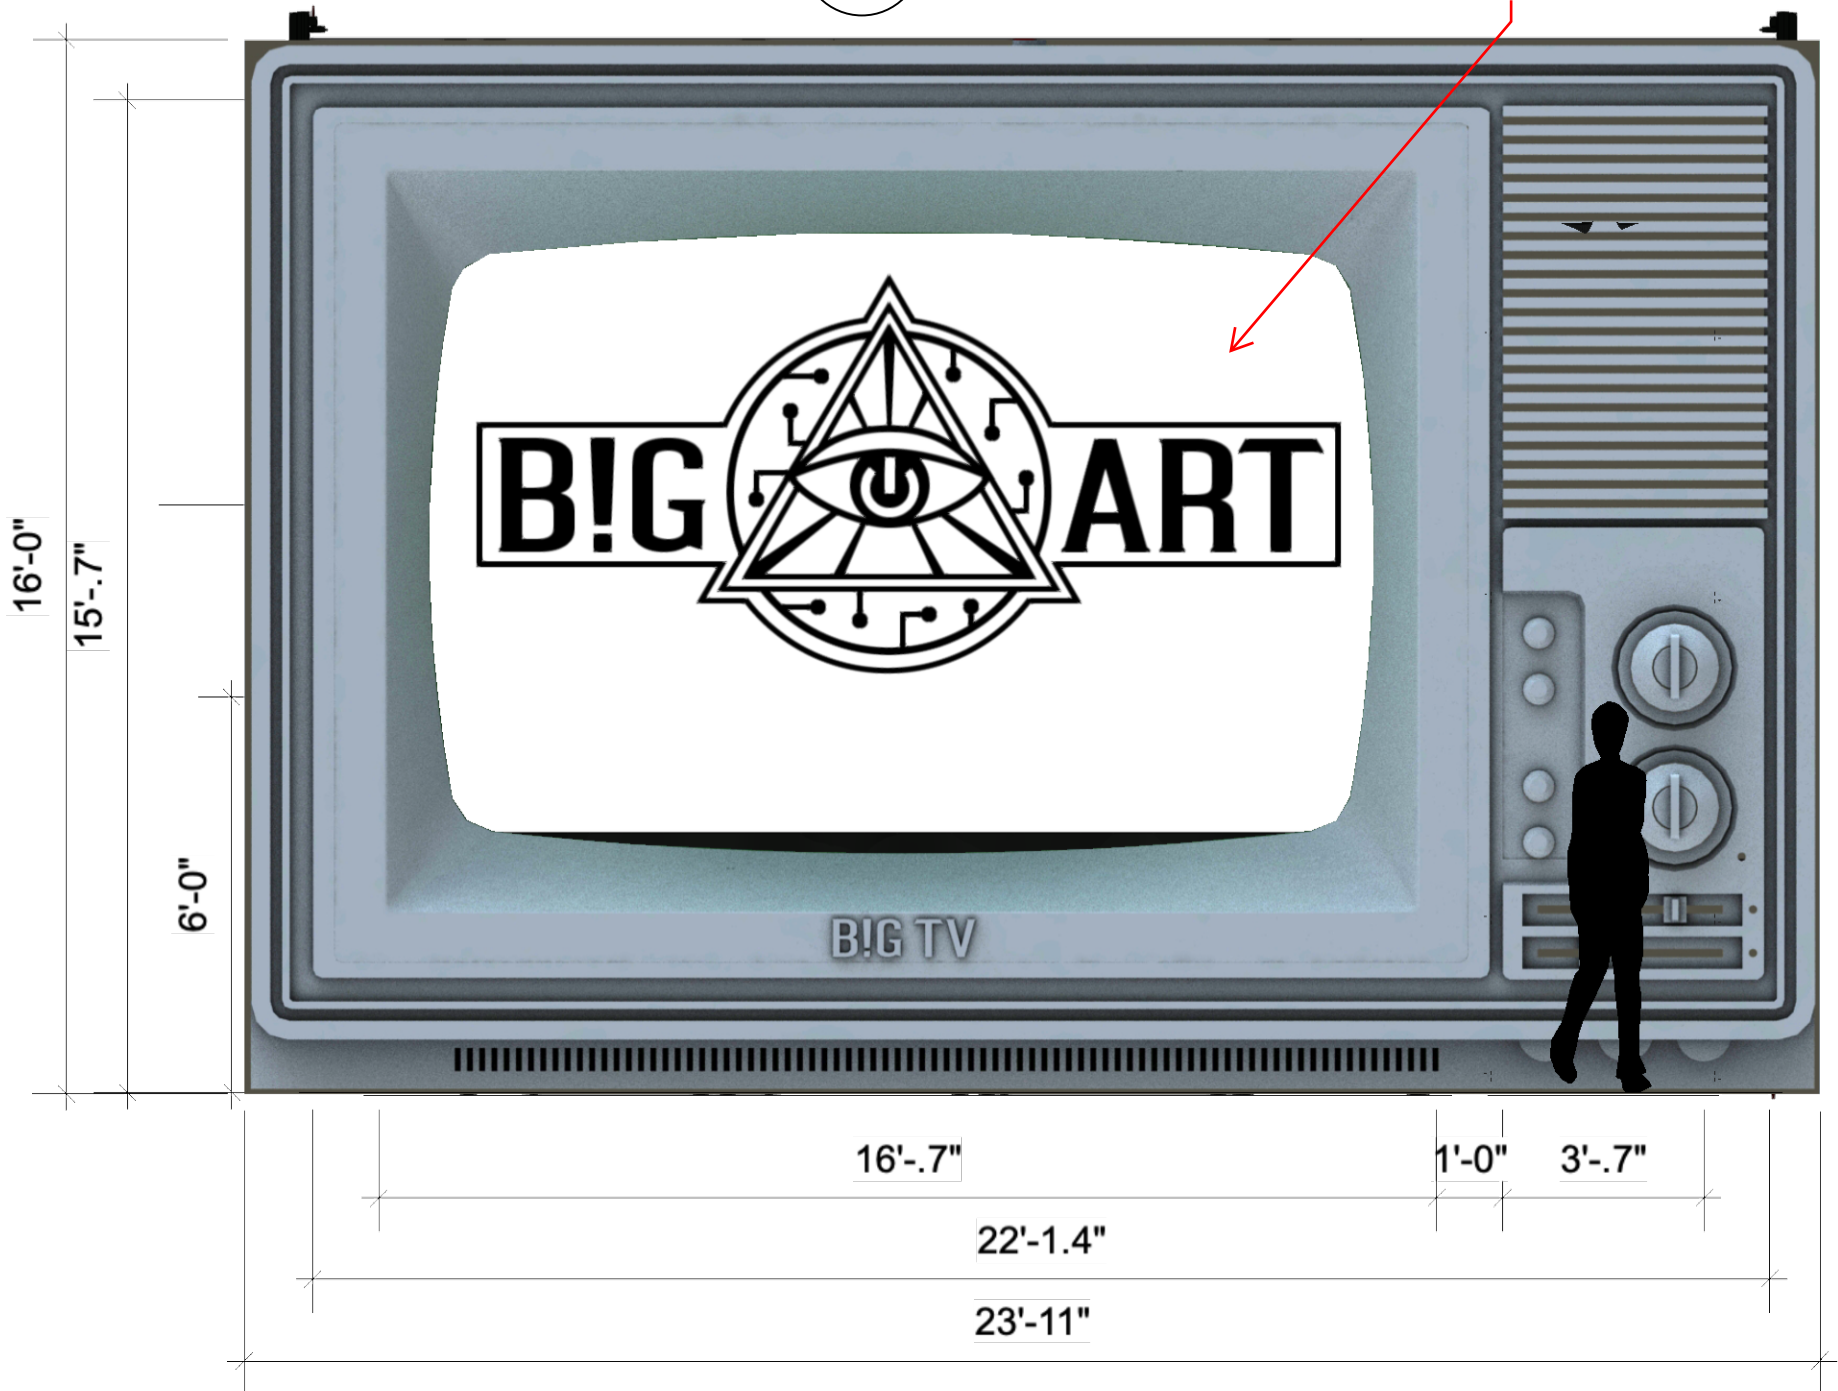

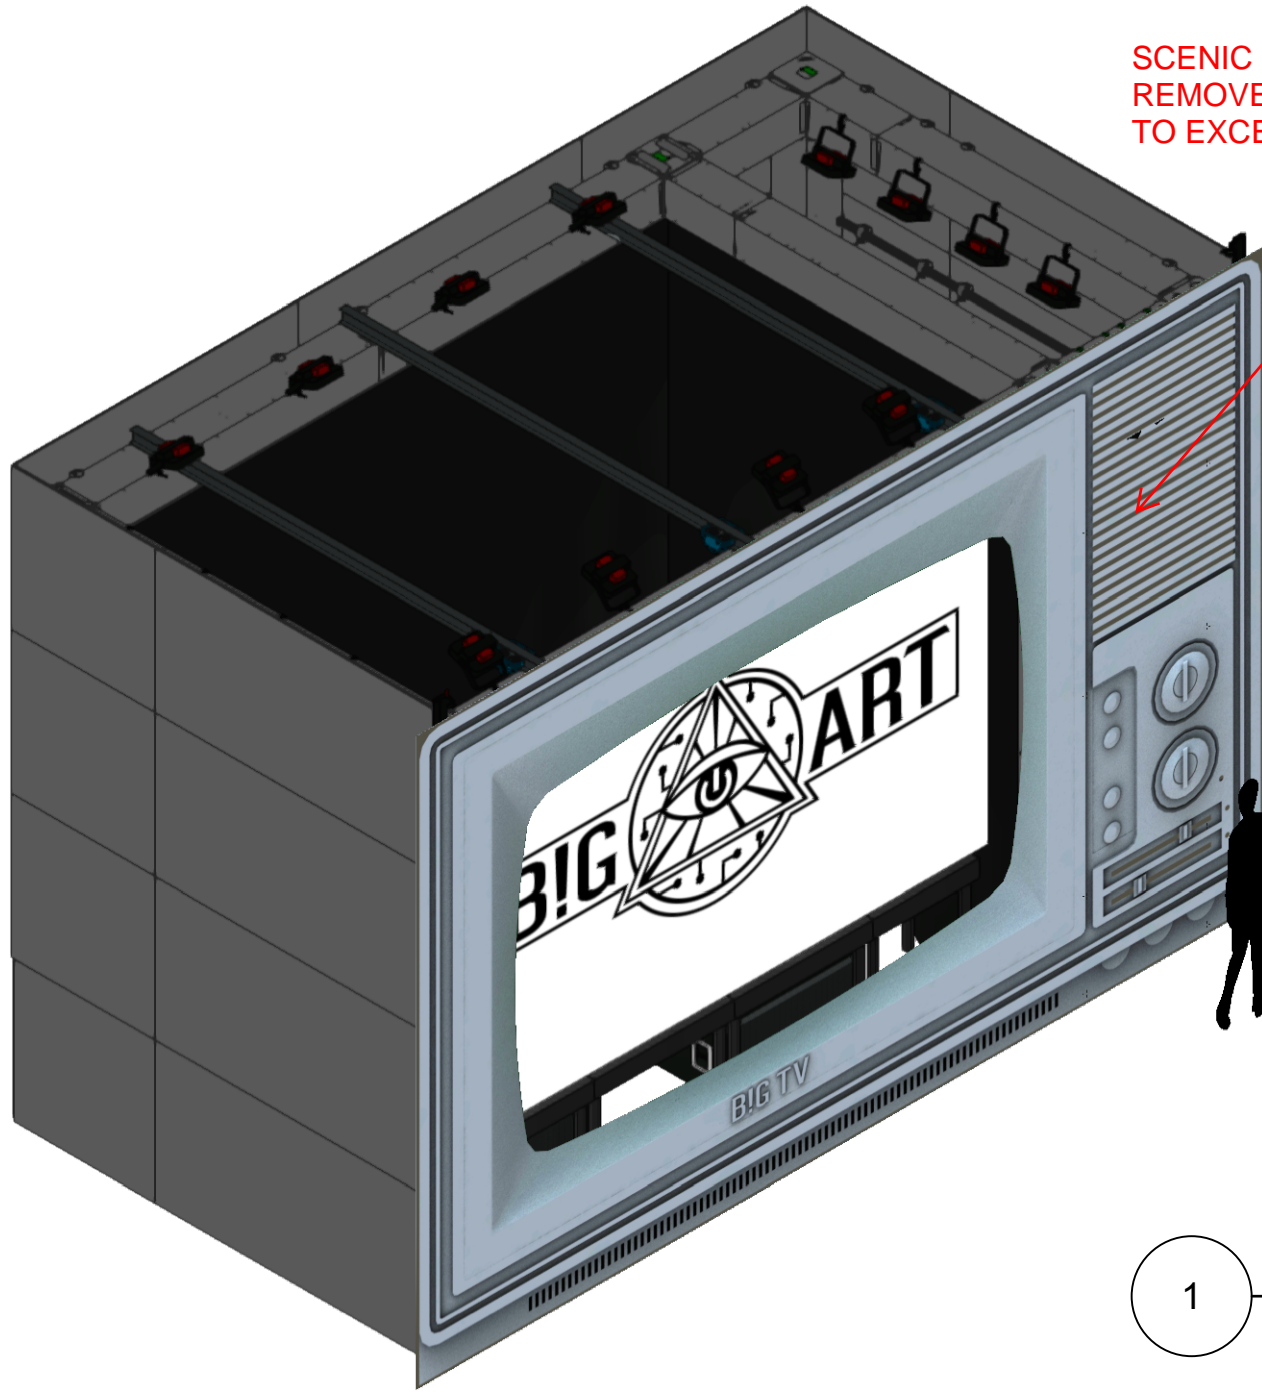


SCENIC CLADDING SHALL BE REMOVED IF WINDS ARE EXPECTED TO EXCEED 40MPH - TYP.


1 BIG TV
Scale: 1:46

1

B!G TV
Scale: 1:35

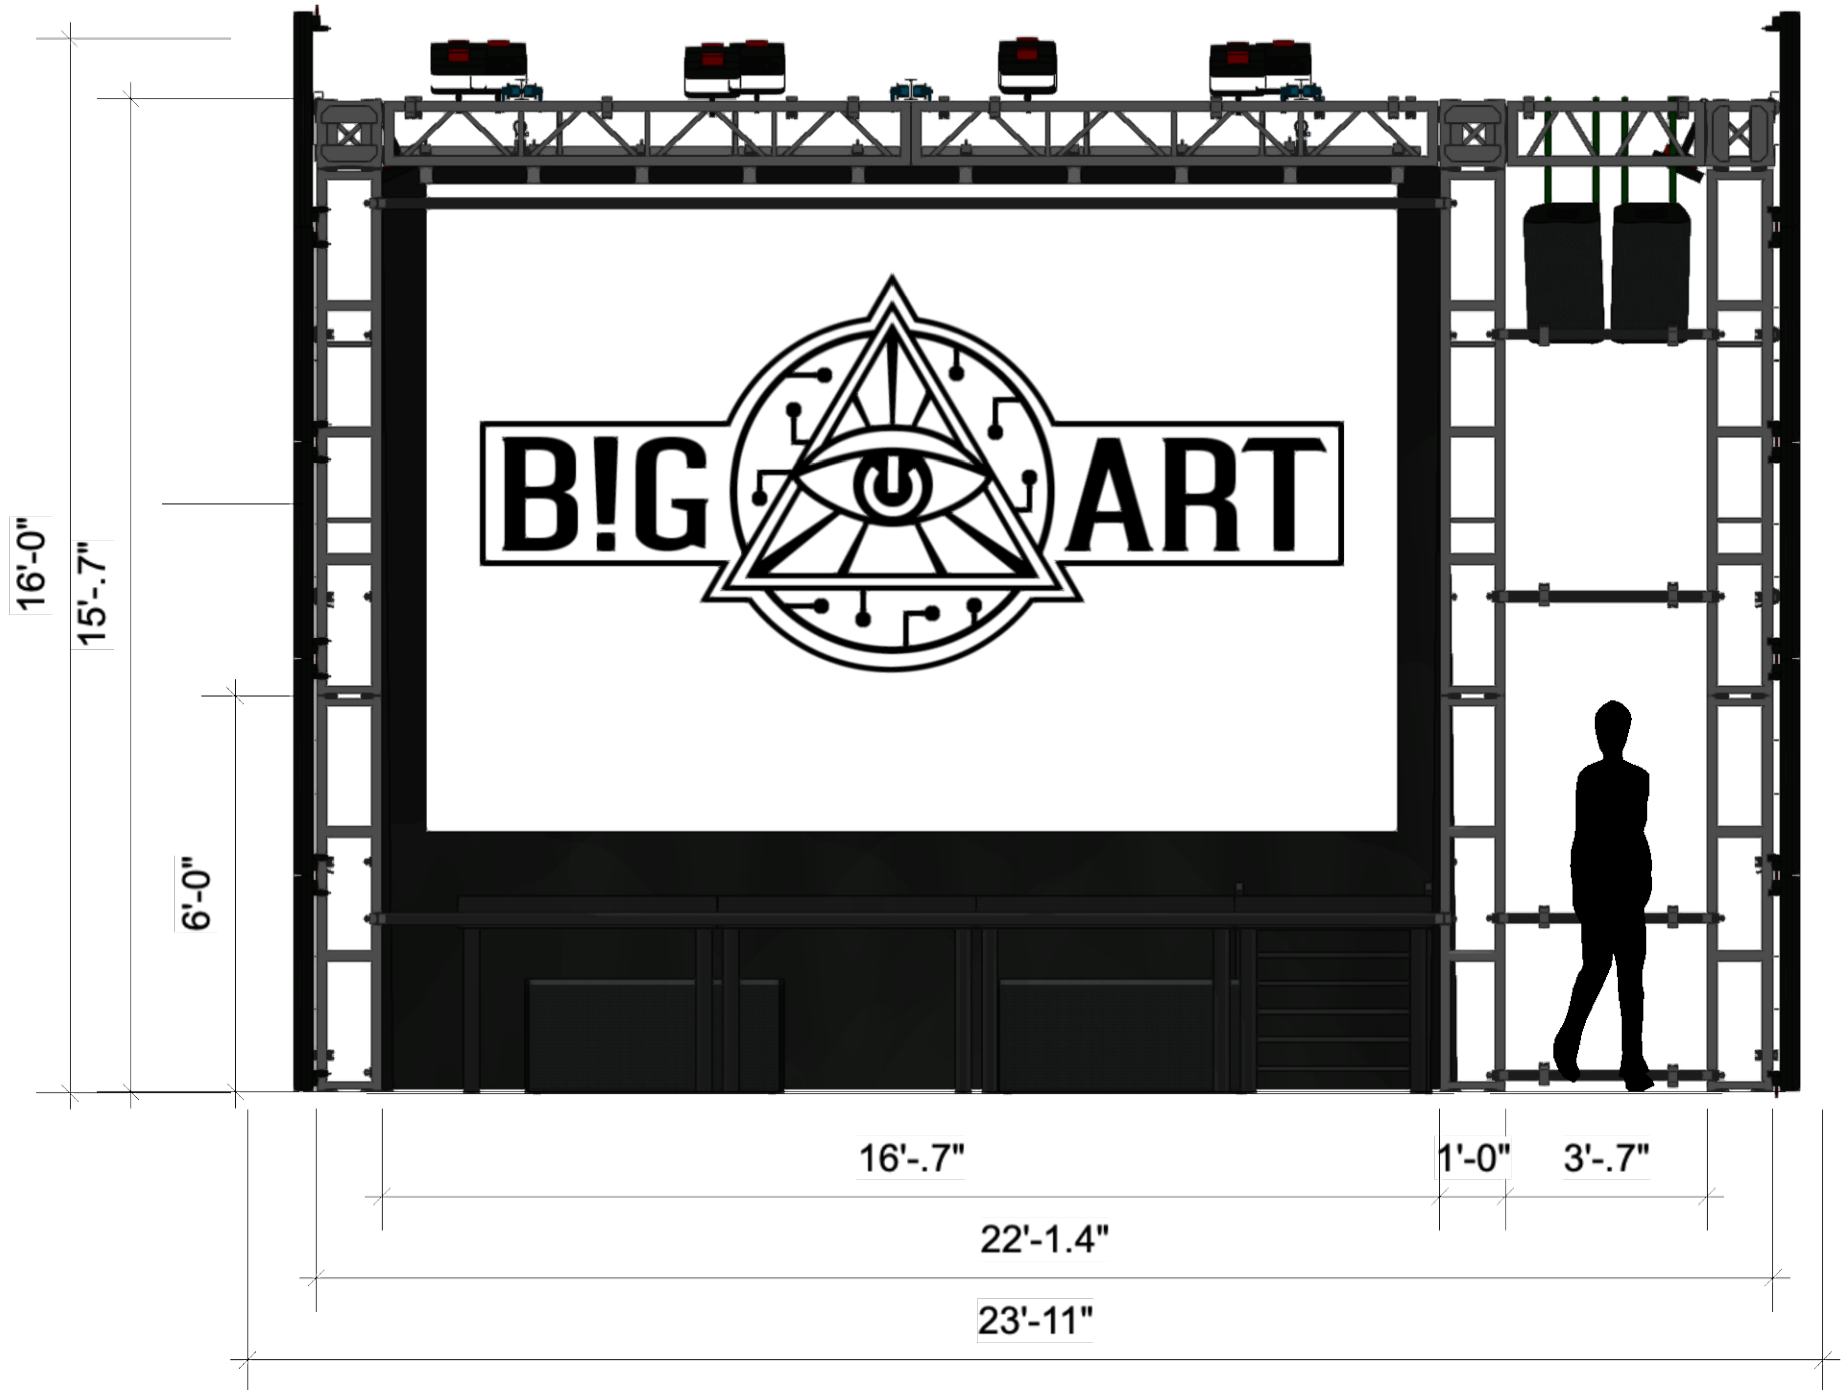

SCRIM SHALL BE REMOVED IF WINDS ARE EXPECTED TO EXCEED 40MPH - TYP.

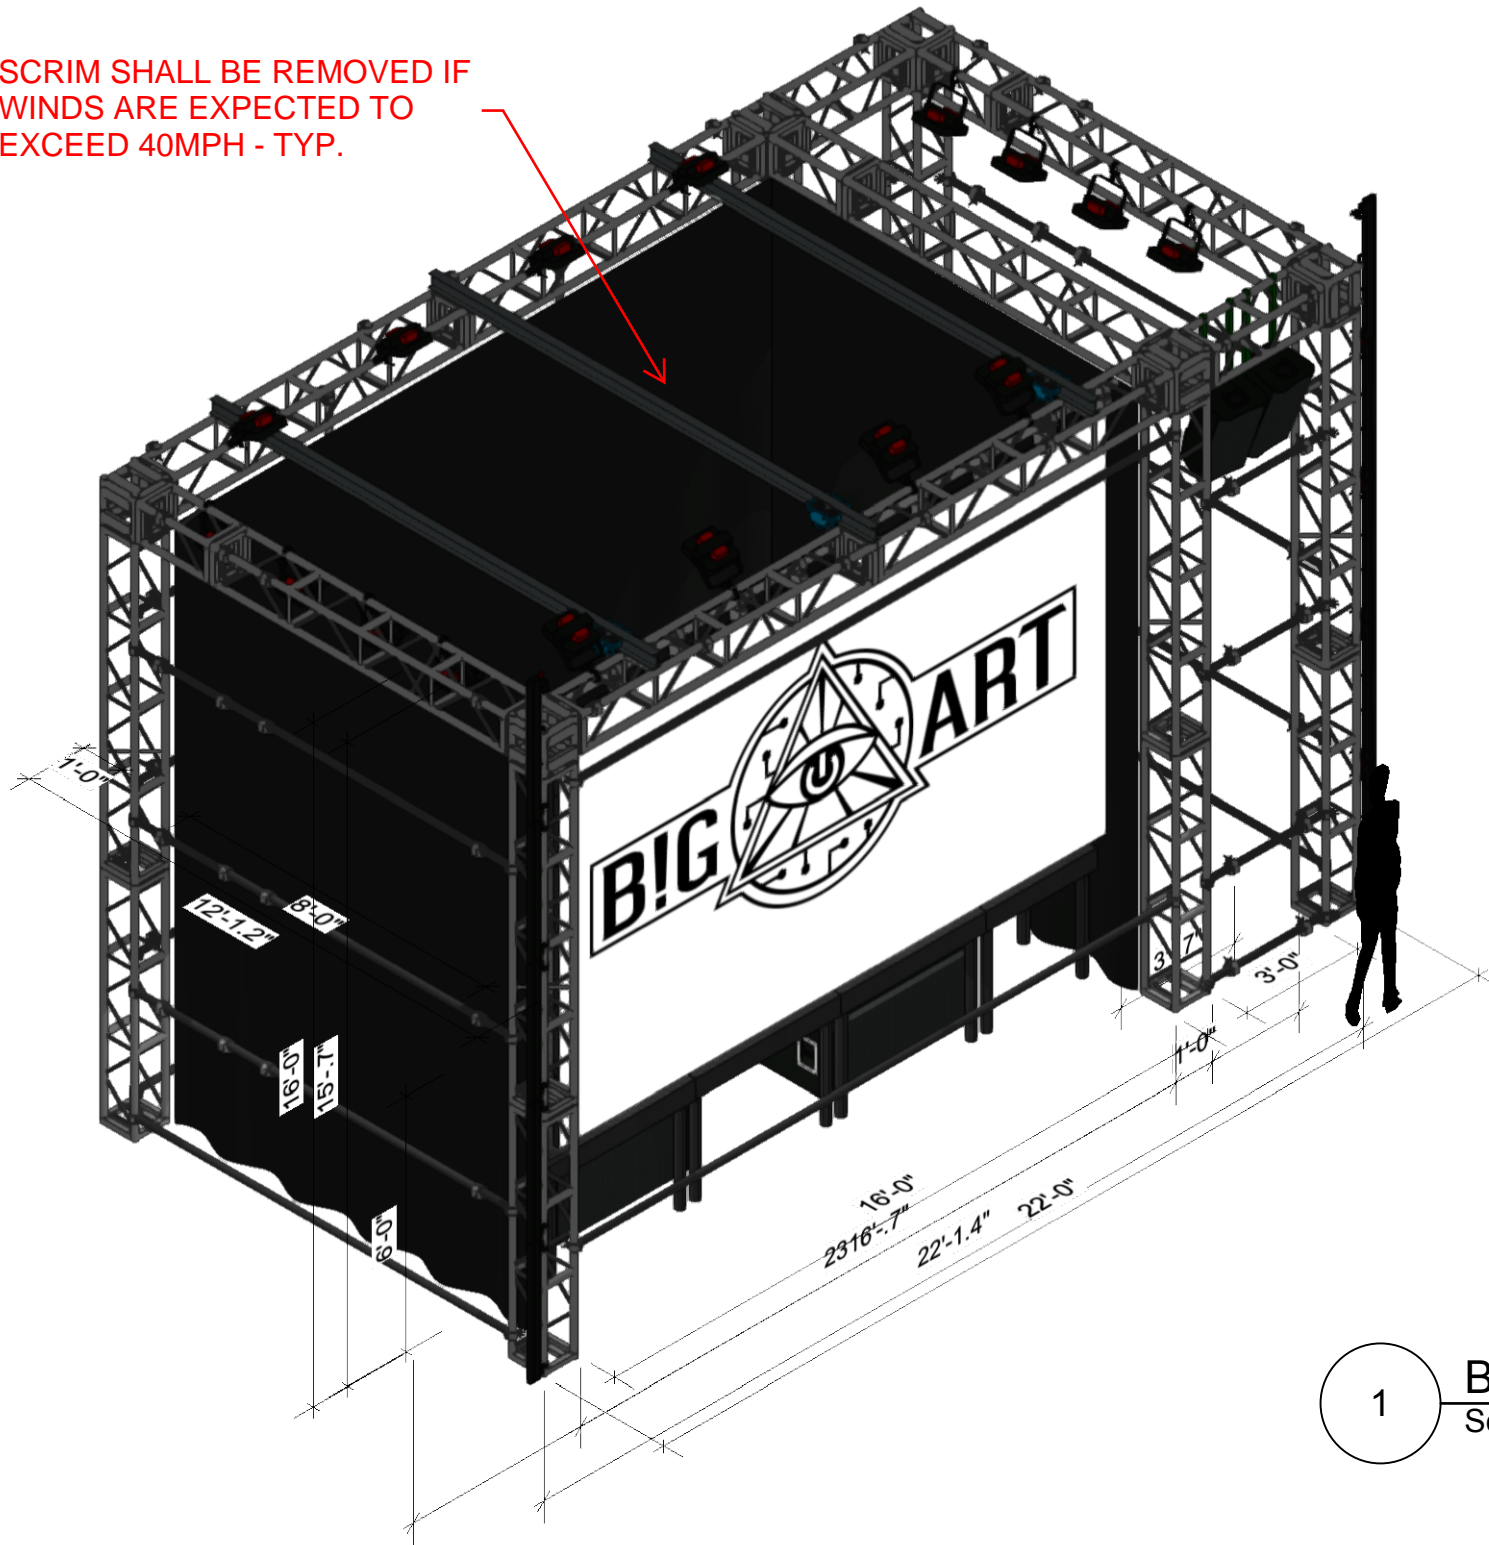



1 BIG TV
Scale: 1:44

PER CLIENT, VIDEO WALL WEIGHS APPROXIMATELY 1400 POUNDS.

1 **BIG TV**
Scale: 1:35

PER CLIENT, AUDIO WEIGHS APPROXIMATELY 160 POUNDS.

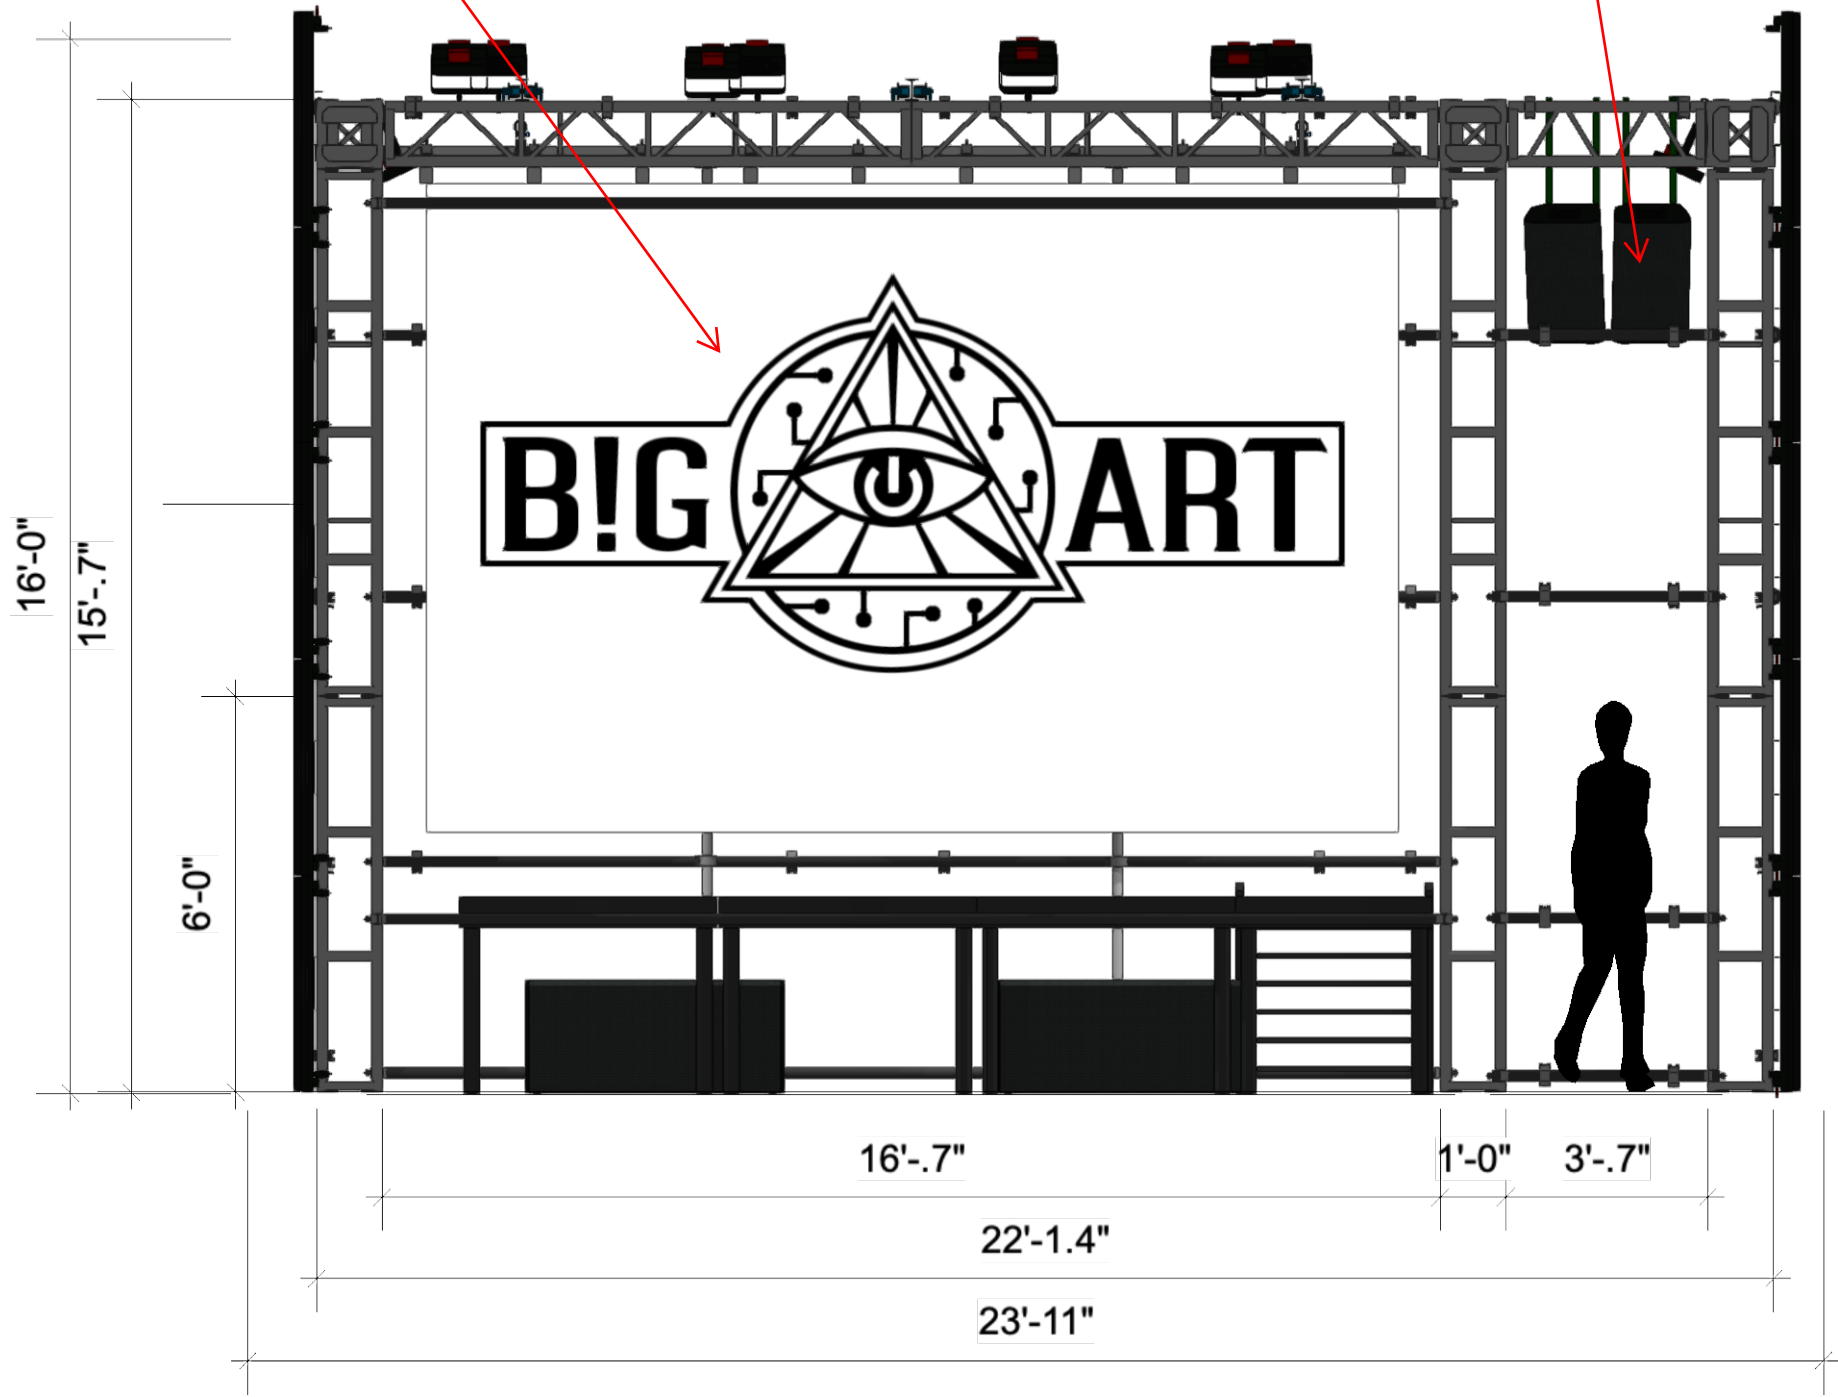

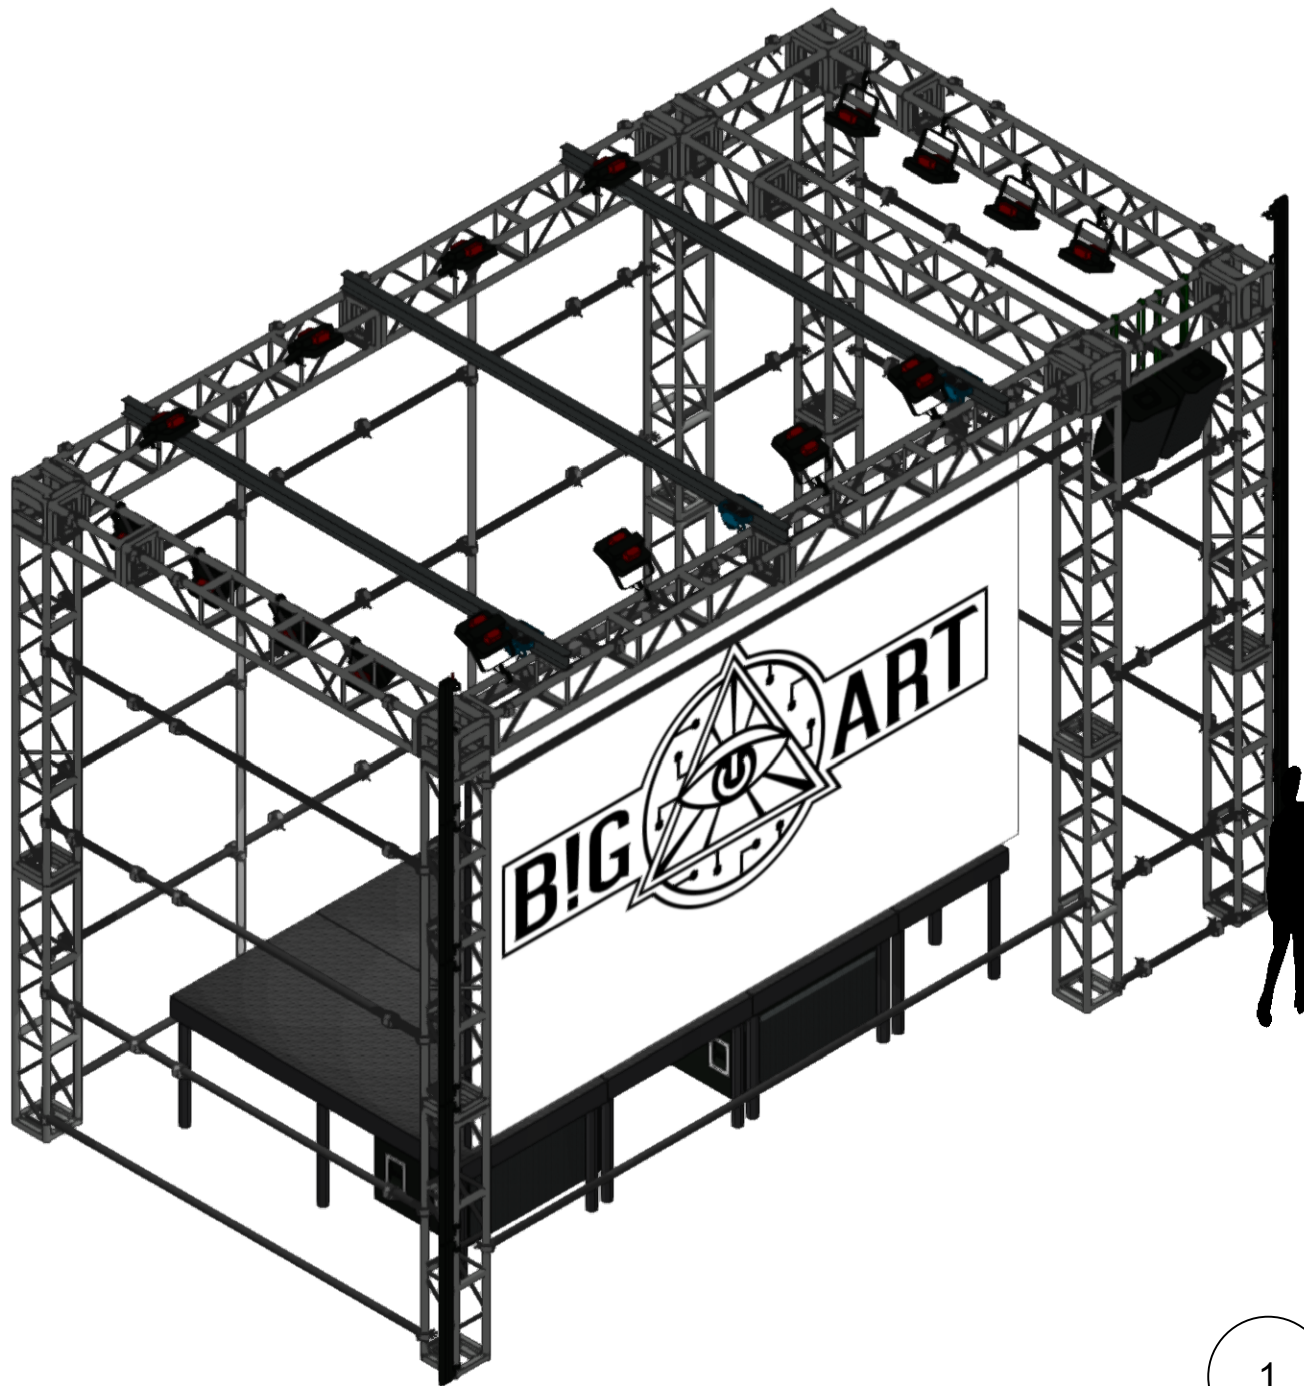


1

BIG TV
Scale: 1:44

MINIMUM 300 POUNDS OF BALLAST
REQUIRED AT EACH TOWER - TYP. (6)

1 **B!G TV**
Scale: 1:30


PER CLIENT, EACH LIGHT WEIGHS
APPROXIMATELY 25 POUNDS - TYP.

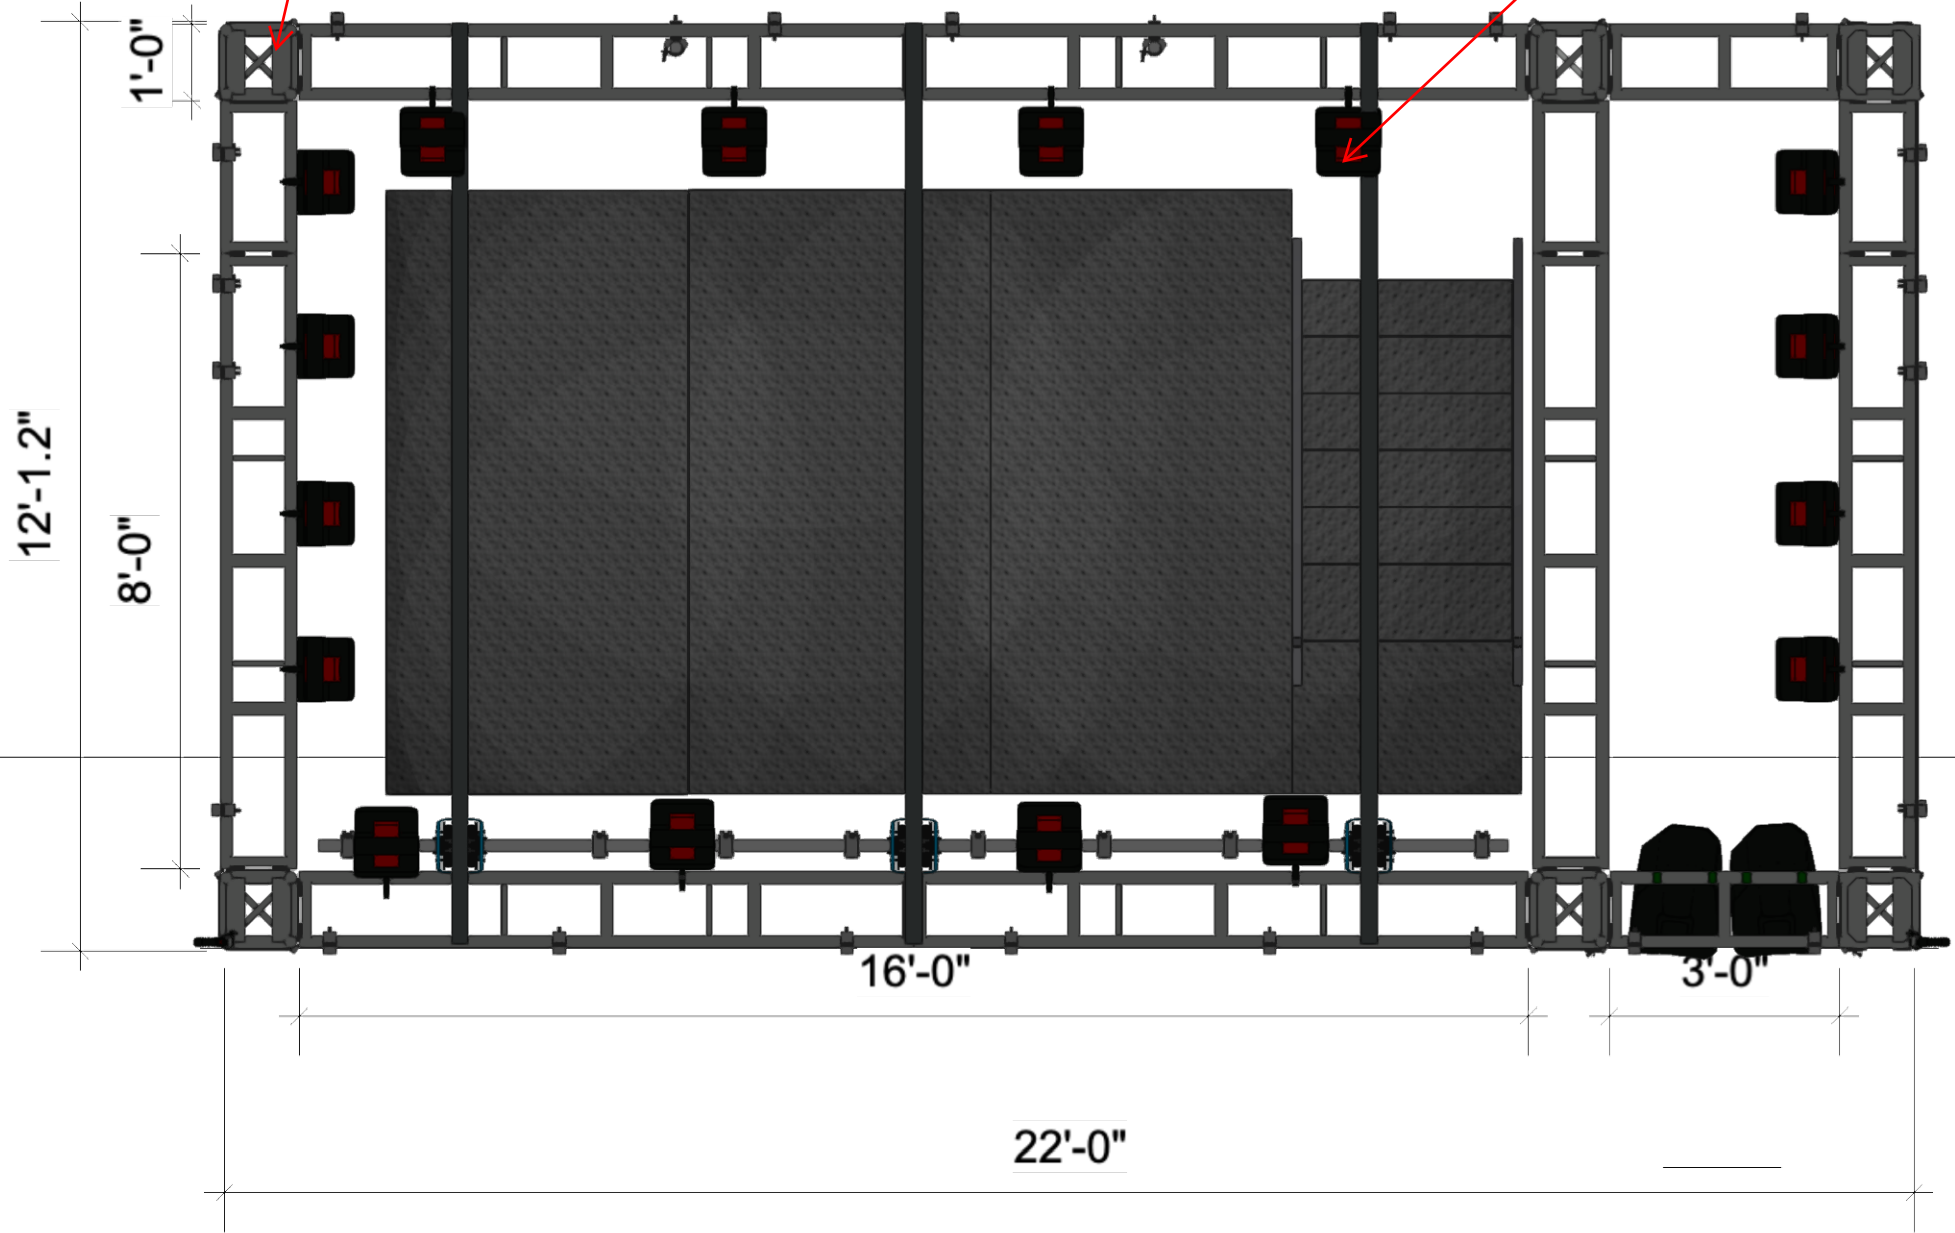


1


B!G TV

Scale: 1:30

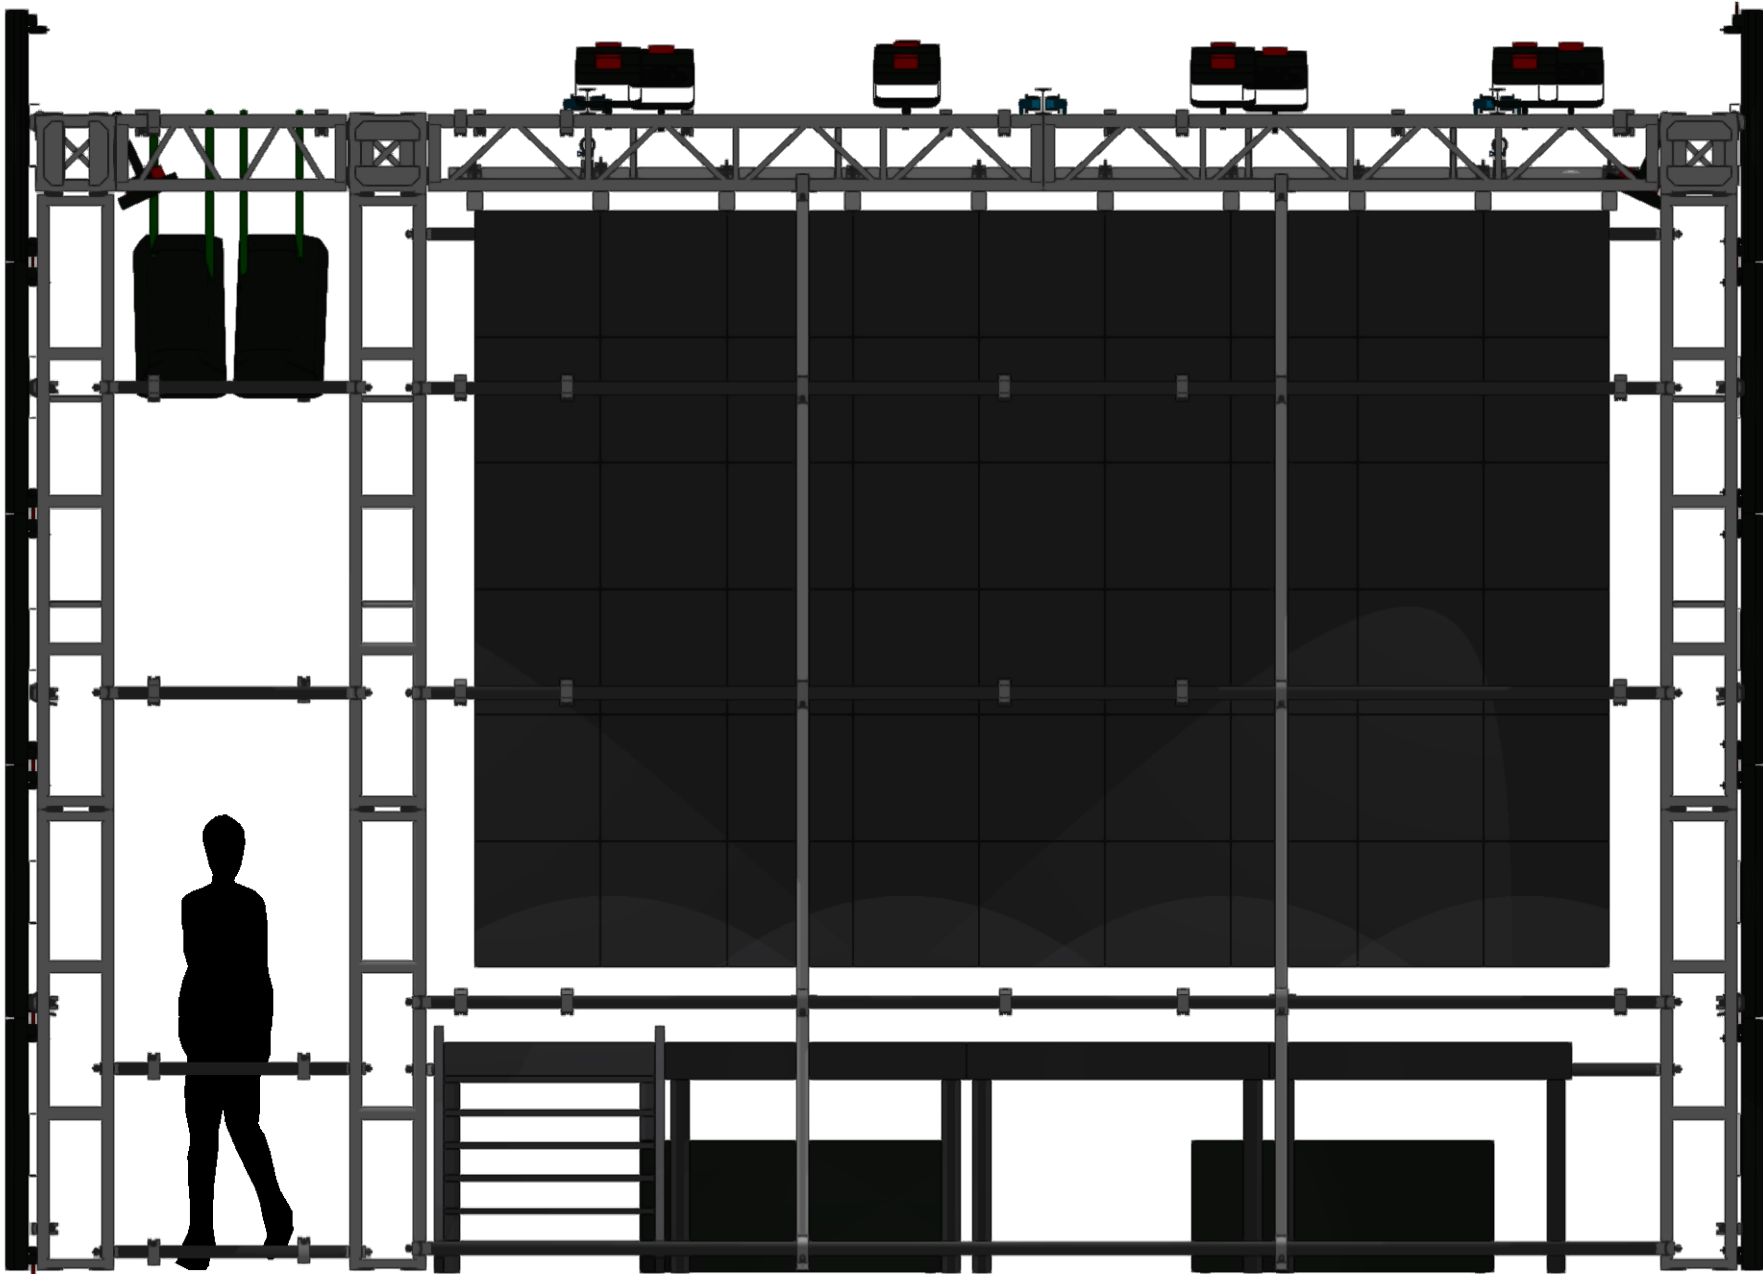

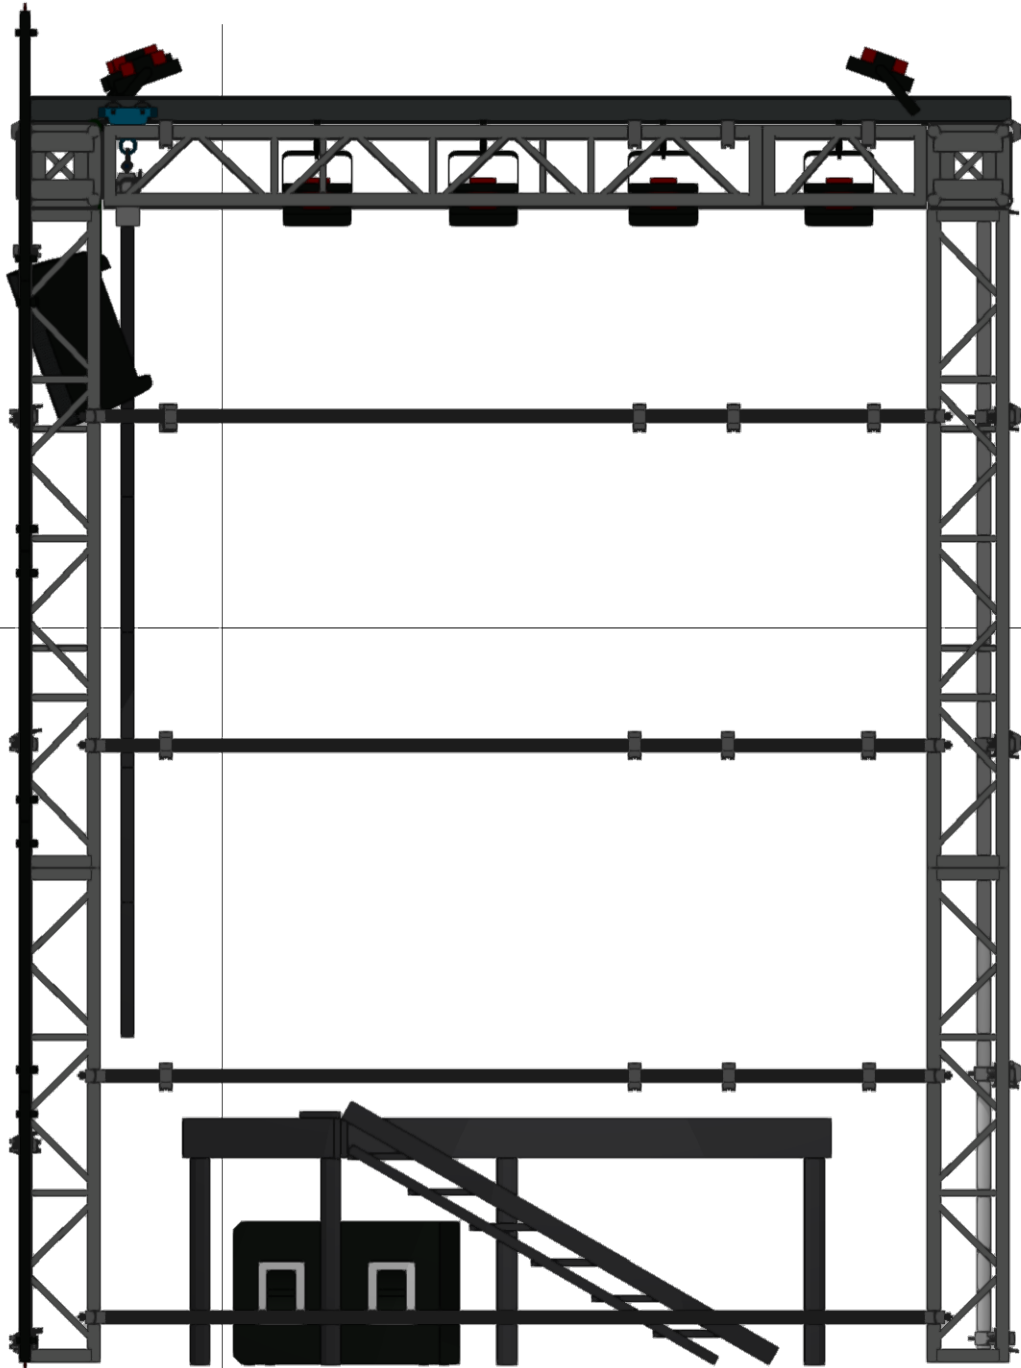

1 **B!G TV**
Scale: 1:28

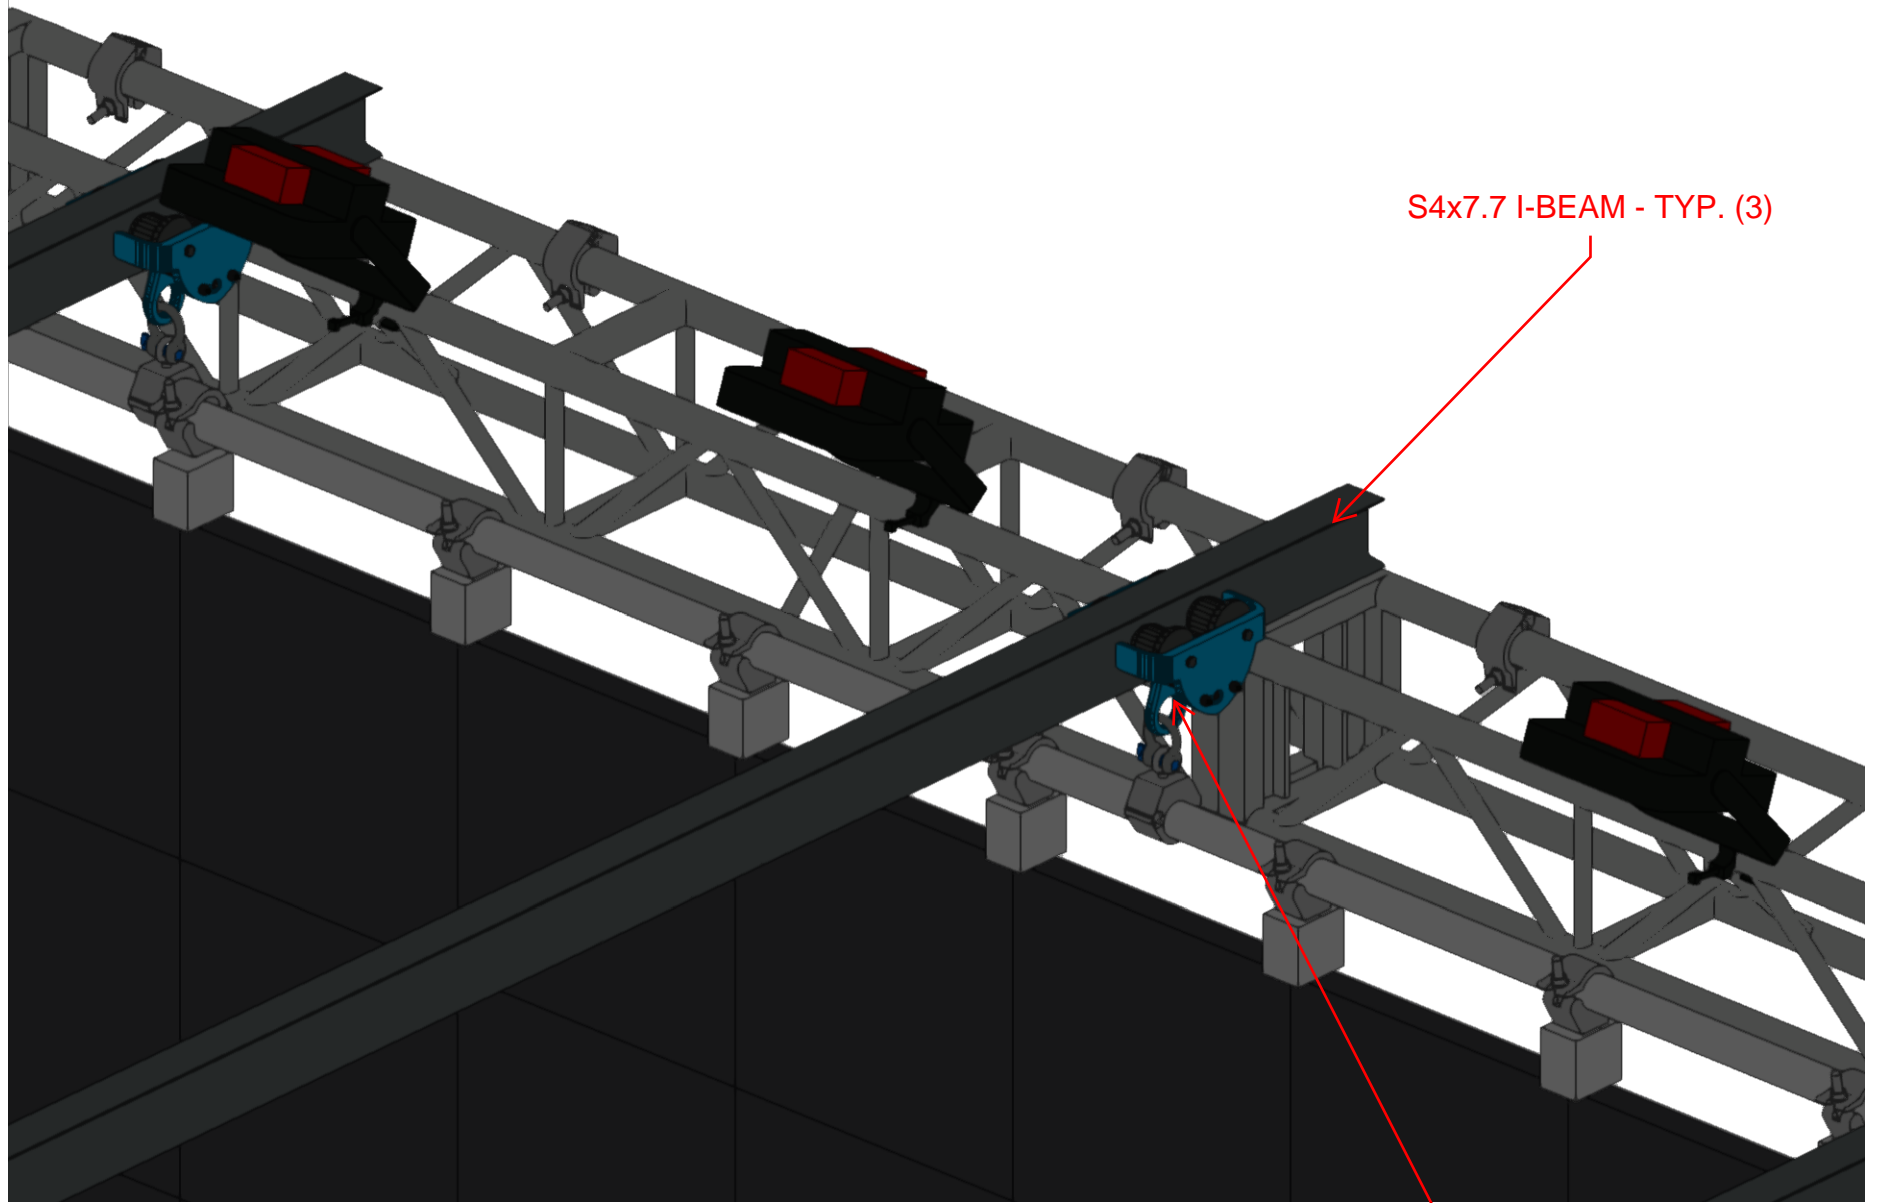

S4x7.7 I-BEAM - TYP. (3)

1 **BIG TV**
Scale: 1:10

BEAM TROLLEY AND ALL RIGGING
COMPONENTS ARE RATED PRODUCTS WITH
A MINIMUM WLL OF 1,000 POUNDS - TYP.



APPENDIX B

CALCULATIONS

BIG TV

Event Date & Location: Varies - Installation shall not exceed 1 week

Codes and Referenced Standards

- 2021 International Building Code
- National Building Code - 2023 Alberta Edition
- Aluminum Design Manual, 2020 ed.
- American Institute of Steel Construction, Steel Construction Manual 15th Edition
- American Society of Civil Engineers 7-16 (ASCE 7-16) "*Minimum Design Loads for Buildings and Other Structures*"
- American Society of Civil Engineers 37-14 (ASCE 37-14) "*Design Loads on Structures During Construction*"
- ANSI E 1.21-2013 "*Temporary Structures Used for Technical Production of Outdoor Entertainment Events*"
- ANSI E 1.2-2012 "*Manufacture and Use of Aluminum Trusses and Towers*"

Project Description

- Review of temporary structure for lateral and gravity loads.

Analysis Assumptions/Design Criteria

- A high wind action plan has been issued and must be strictly followed.
- All truss is 12" x 12" aluminum box truss from Unisson or equivalent.
- Scenic cladding and its attachment to the structure not reviewed by CRE.

General Design - Applies To All Assemblies

Steel/Aluminum Factors of Safety

Note: The following factors/design criteria applies to all assemblies and will be used throughout design package (U.N.O).

AISC Typical Factors of Safety (U.N.O.): $\Omega_{y.AISC} := 1.67$ $\Omega_{r.AISC} := 2.0$

ADM Typical Factors of Safety (U.N.O.): $\Omega_{y.ADM} := 1.65$ $\Omega_{r.ADM} := 1.95$

ASTM A36 Mechanical Properties

Yield Strength: $F_{y.A36} := 36\text{ksi}$

Tensile Strength: $F_{u.A36} := 58\text{ksi}$

ASTM A572 Mechanical Properties

Yield Strength: $F_{y.A572} := 50\text{ksi}$

Tensile Strength: $F_{u.A572} := 65\text{ksi}$

ASTM A500 GR. B (Rectangular) Mechanical Properties

Yield Strength: $F_{y.A500.rect} := 46\text{ksi}$

Tensile Strength: $F_{u.A500.rect} := 58\text{ksi}$

ASTM A500 GR. B (Round) Mechanical Properties

Yield Strength: $F_{y.A500.rd} := 42\text{ksi}$

Tensile Strength: $F_{u.A500.rd} := 58\text{ksi}$

ASTM A992 Mechanical Properties

Yield Strength: $F_{y.A992} := 50\text{ksi}$

Tensile Strength: $F_{u.A992} := 65\text{ksi}$

Weld (Steel) Mechanical Properties

Weld Strength: $F_{weld} := 70\text{ksi} \cdot 0.6 = 42.00\text{ksi}$

Grade 8 Bolt Mechanical Properties

Tensile Strength of Bolt: $F_{u.bolt} := 150\text{ksi}$

6061-T6 Mechanical Properties

Unwelded

Welded

Tension Ultimate Stress: $F_{tu} := 38\text{ksi}$

$F_{tuw} := 24\text{ksi}$

Tension Yield Stress: $F_{ty} := 35\text{ksi}$

$F_{tyw} := 15\text{ksi}$

Compression Yield Stress: $F_{cy} := 35\text{ksi}$

$F_{cyw} := 15\text{ksi}$

Shear yield stress: $F_{sy} := 0.6 \cdot F_{ty} = 21.00\text{ksi}$

$F_{syw} := 0.6 \cdot F_{tyw} = 9.00\text{ksi}$

Ultimate shear stress: $F_{su} := 24\text{ksi}$

$F_{suw} := 15\text{ksi}$

Tension coefficient: $k_t := 1.0$

$k_{tw} := 1.0$

Applied Loads:

Wind Loads - Per ASCE 7-16 and ASCE 37-14

- Ultimate wind speed (LRFD): $V_u := 115$ mph
- Service level wind speed (ASD): $V_s := \sqrt{V_u^2 \cdot 0.6}$ $V_s = 89.08$ mph
- HWAP service level wind speed (ASD): $V_{hwap} := 40$ mph
- Exposure category (service): $Exp_s :=$
- Exposure category (HWAP): $Exp_{hwap} :=$
- Gust effect factor: $G_w := 0.85$
- Topographic factor: $K_{zt} := 1.0$
- Ground elevation: $z_g := 0$ ft
- Ground elevation factor: $K_e := e^{-0.0000362 \cdot \frac{z_g}{ft}} = 1.00$

6.2.1.1.1 Construction Period in Hurricane-Prone Areas
 For construction between November 1 and June 30 (outside of the hurricane season), the basic wind speed of 115 mph (51 m/s) shall be permitted for structures sited near the Gulf Coast and Eastern Seaboard, where the ASCE/SEI 7-10 specified basic wind speed exceeds 115 mph (51 m/s) (3 second gust) (hurricane-prone areas). The 115 mph (51 m/s) wind speed is permitted to be reduced by the factors in Section 6.2.1 only for a construction period between November 1 and June 30. If the construction period shifts into the period between July 1 and October 31, the design shall be reviewed and modified, as appropriate, to conform to the requirements shown below for a construction period between July 1 and October 31.

Between July 1 and October 31, basic wind speed of 115 mph (51 m/s) shall be permitted for structures sited near the Gulf Coast and Eastern Seaboard, where the ASCE/SEI 7-10 specified basic wind speed exceeds 115 mph (51 m/s) (3 second gust) provided additional bracing is prepared in advance and applied in time before the onset of an announced hurricane. The 115 mph (51 m/s) wind speed shall not be reduced by the factors in Section 6.2.1 for the construction period. The bracing shall be designed for the full, unmodified wind load determined using the mapped wind speed and procedures found in ASCE/SEI 7-10.

ASCE 37-14 Reduction Factor

Construction Period	Factor
Less than six weeks	0.75
From six weeks to one year	0.8
From one to two years	0.85
From two to five years	0.9

Reduction coefficient for temporary structure: $red :=$

Service level (ASD) wind speed for design of temporary structure: $V_{temp_service} := V_s \cdot red$ $V_{temp_service} = 66.81$ mph

Ultimate level (LRFD) wind speed for design of temporary structure: $V_{temp_ultimate} := V_u \cdot red$ $V_{temp_ultimate} = 86.25$ mph

NOTE: Per ASCE 7-16, ultimate wind speeds are reduced by a factor of 0.6 in all service level (ASD) load combinations found in Section 2.4. Service level wind speeds are the design wind speeds that should be monitored.

Wind Loads on Trussed Towers

This Mathcad sheet calculates the wind pressures on a trussed tower in accordance with figure 29.4-3 of ASCE 7-16.

Height of wind evaluation:

$z := 16 \cdot \text{ft}$

Truss property table:

Type of truss:

type :=

Wind directionality factor:

$K_d :=$

Tower cross section:

TCS :=

Are tower members round?

RM :=

Truss	"ε"	"Width"
"12" Truss"	0.461	12
"20½" Truss"	0.329	20.5
"26x30 PRT Empty"	0.289	26
"26x30 PRT Full"	0.594	26
"20"x30" HD Truss"	0.254	30
"G2 Truss"	.220	60

Ratio of solid area to gross area:

$\epsilon := \text{Table}_{\text{truss}}_{\text{type}, 2} = 0.461$

Truss width:

$B_{\text{truss}} := \text{Table}_{\text{truss}}_{\text{type}, 3} \cdot \text{in} = 12.00 \cdot \text{in}$

Velocity Pressure Exposure Coefficient (service):

$K_{z_s} := K_{z_{F_s}}(z) \quad K_{z_s} = 0.86$

Velocity Pressure Exposure Coefficient (HWAP):

$K_{z_{hwap}} := K_{z_{F_{hwap}}}(z) \quad K_{z_{hwap}} = 0.86$

Wind velocity pressure (service):

$q_{z_s} := 0.00256 \cdot K_{z_s} \cdot K_{zt} \cdot K_d \cdot K_e \cdot (\text{red} \cdot V_s)^2 \cdot \text{psf} \quad q_{z_s} = 8.36 \cdot \text{psf}$

Wind velocity pressure (HWAP):

$q_{z_{hwap}} := 0.00256 \cdot K_{z_{hwap}} \cdot K_{zt} \cdot K_d \cdot K_e \cdot (V_{hwap})^2 \cdot \text{psf} \quad q_{z_{hwap}} = 3.00 \cdot \text{psf}$

Round member reduction (if applicable):

$\text{rnd_red} := \begin{cases} 1.0 & \text{if RM} = \text{"NO"} \\ \min(1.0, 0.51 \cdot \epsilon^2 + 0.57) & \text{otherwise} \end{cases} \quad \text{rnd_red} = 0.68$

Force coefficient:

$C_f := \text{rnd_red} \cdot \begin{cases} 4.0 \cdot \epsilon^2 - 5.9 \cdot \epsilon + 4.0 & \text{if TCS} = \text{"Square"} \\ 3.4 \cdot \epsilon^2 - 4.7 \cdot \epsilon + 3.4 & \text{otherwise} \end{cases} \quad C_f = 1.45$

Truss wind pressure (service):

$$p_{truss_s} := q_{z_s} \cdot C_f \cdot G_w$$

$$p_{truss_s} = 10.27 \cdot \text{psf}$$

Truss wind pressure (HWAP):

$$p_{truss_hwap} := q_{z_hwap} \cdot C_f \cdot G_w$$

$$p_{truss_hwap} = 3.68 \cdot \text{psf}$$

Linear wind load (service):

$$w_{truss_s} := p_{truss_s} \cdot B_{truss} \cdot \epsilon$$

$$w_{truss_s} = 4.73 \cdot \text{plf}$$

Linear wind load (HWAP):

$$w_{truss_hwap} := p_{truss_hwap} \cdot B_{truss} \cdot \epsilon$$

$$w_{truss_hwap} = 1.70 \cdot \text{plf}$$

Adjustment for wind along a diagonal:

$$\text{Diag} := \min(1.2, 1 + 0.75 \cdot \epsilon) = 1.20$$

Linear wind load, diagonal (service):

$$w_{diag_s} := w_{truss_s} \cdot \text{Diag}$$

$$w_{diag_s} = 5.68 \cdot \text{plf}$$

Linear wind load, diagonal (HWAP):







$$w_{diag_hwap} := w_{truss_hwap} \cdot \text{Diag}$$

$$w_{diag_hwap} = 2.04 \cdot \text{plf}$$

Wind Loads on Scrim / Signs

This Mathcad sheet calculates the wind pressures on a sign or scrim in accordance with figure 29.3-1 of ASCE 7-16.

Diagrams

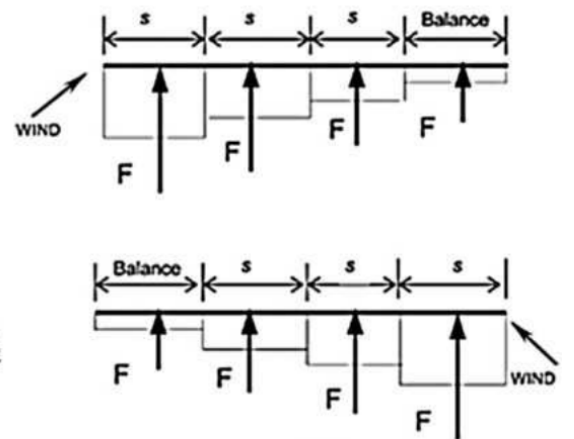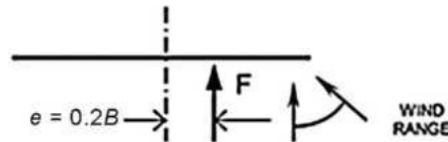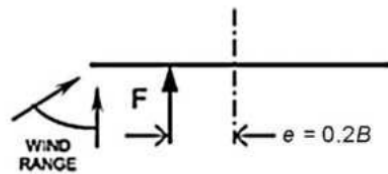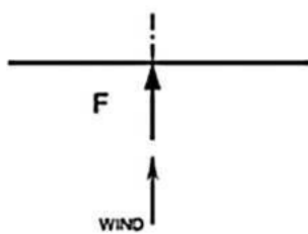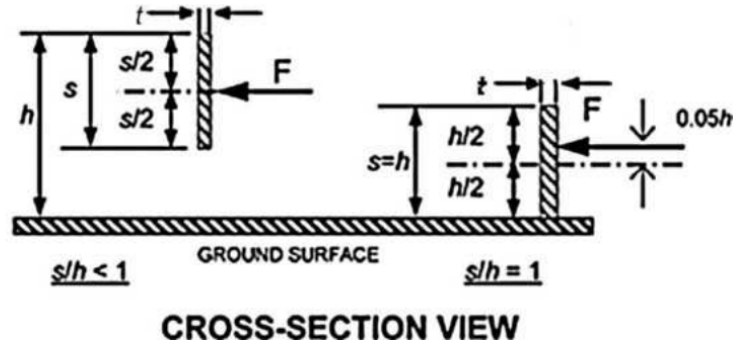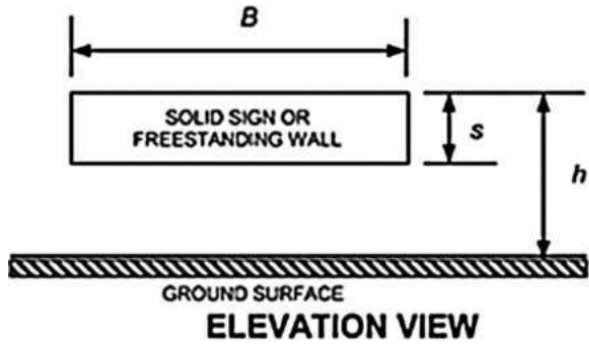

CASE A

CASE B

CASE C

PLAN VIEWS

Top of sign height: $h := 16\text{-ft}$

Sign Width: $B := 22\text{-ft}$

Vertical dimension of sign: $s_w := 16\text{-ft}$

Wind directionality factor: $K_{d,w} := 0.85$

Aspect ratio, B/s: $B_s := \frac{B}{s} = 1.38$

Clearance ratio, s/h: $sh := \frac{s}{h} = 1.00$

Velocity Pressure Exposure Coefficient (service):

$$K_{z_s} := K_{z_F_s}(h)$$

$$K_{z_s} = 0.86$$

Velocity Pressure Exposure Coefficient (HWAP):

$$K_{z_hwap} := K_{z_F_hwap}(h)$$

$$K_{z_hwap} = 0.86$$

Wind velocity pressure (service):

$$q_{h_s} := 0.00256 \cdot K_{z_s} \cdot K_{zt} \cdot K_d \cdot K_e \cdot (V_s)^2 \cdot \text{psf}$$

$$q_{h_s} = 8.36 \cdot \text{psf}$$

Wind velocity pressure (HWAP):

$$q_{h_hwap} := 0.00256 \cdot K_{z_hwap} \cdot K_{zt} \cdot K_d \cdot K_e \cdot (V_{hwap})^2 \cdot \text{psf}$$

$$q_{h_hwap} = 3.00 \cdot \text{psf}$$

Cases A & B:

Case A & B Force Coefficient Table:

Table_CfAB :=

"Cf"	0	0.05	0.1	0.2	0.5	1	2	4	5	10	20	30	45	999
0.0	1.95	1.95	1.90	1.85	1.85	1.80	1.80	1.85	1.85	1.85	1.90	1.90	1.95	1.95
0.16	1.95	1.95	1.90	1.85	1.85	1.80	1.80	1.85	1.85	1.85	1.90	1.90	1.95	1.95
0.2	1.95	1.95	1.90	1.85	1.80	1.80	1.80	1.80	1.80	1.85	1.90	1.90	1.95	1.95
0.3	1.95	1.95	1.90	1.85	1.80	1.80	1.80	1.80	1.80	1.80	1.85	1.85	1.85	1.85
0.5	1.95	1.95	1.85	1.80	1.75	1.75	1.70	1.70	1.70	1.70	1.70	1.70	1.75	1.75
0.7	1.90	1.90	1.85	1.75	1.70	1.65	1.60	1.60	1.55	1.55	1.55	1.55	1.55	1.55
0.9	1.85	1.85	1.75	1.70	1.60	1.55	1.50	1.45	1.45	1.40	1.40	1.40	1.40	1.40
1	1.80	1.80	1.70	1.65	1.55	1.45	1.40	1.35	1.35	1.30	1.30	1.30	1.30	1.30

Case A & B Force Coefficient:

$$C_{f_AB} := \text{Spline}(\text{Table_CfAB}, \text{sh}, \text{Bs})$$

$$C_{f_AB} = 1.43$$

Sign wind pressure (service):

$$P_{\text{sign}_s} := q_{h_s} \cdot C_{f_AB} \cdot G_w$$

$$P_{\text{sign}_s} = 10.17 \cdot \text{psf}$$

Sign wind pressure (HWAP):

$$P_{\text{sign}_hwap} := q_{h_hwap} \cdot C_{f_AB} \cdot G_w$$

$$P_{\text{sign}_hwap} = 3.64 \cdot \text{psf}$$

Total sign wind load (service):

$$P_{\text{sign}_s} := P_{\text{sign}_s} \cdot B \cdot s$$

$$P_{\text{sign}_s} = 3.58 \cdot \text{kip}$$

Total sign wind load (HWAP):

$$P_{\text{sign}_hwap} := P_{\text{sign}_hwap} \cdot B \cdot s$$

$$P_{\text{sign}_hwap} = 1.28 \cdot \text{kip}$$

Horizontal offset for Case B:

$$\text{Offset}_B := 0.2 \cdot B$$

$$\text{Offset}_B = 4.40 \text{ ft}$$

Seismic Loads - Per ASCE 37-14 & ASCE 7-16 (Chapter 12/15)

6.5 EARTHQUAKE

If required by Section 6.5.1 and not exempted by Section 6.5.3, earthquake loads shall be calculated in accordance with procedures in ASCE/SEI 7-10 as modified by Section 6.5.2. All structures shall be treated as Risk Category II, per Table 1.5-1 of ASCE/SEI 7-10, regardless of the group classification of the completed structure.

6.5.1 Applicability Earthquake loads need not be considered unless required by the authority having jurisdiction and the mapped Risk-Targeted MCE_R , 5% damped, spectral response acceleration parameter at a period of 1 s, S_1 , defined in Section 11.4.1 of ASCE/SEI 7-10 equals or exceeds 0.40.

6.5.2 Use of ASCE/SEI 7-10 For use of the earthquake load provisions of ASCE/SEI 7-10, the following modifications should be made:

1. The mapped values for S_s and S_1 may be multiplied by a factor less than 1 to represent the reduced exposure period, but the factor shall not be less than 0.20.
2. The restrictions on types of structural systems in seismic performance categories D and E do not apply, as long as the height of the temporary bracing system designed in accordance with this section is limited in height to 60 ft (18.3 m) or five stories, whichever is less, above the completed bracing of the permanent structure.

Seismic Analysis - ASCE 37-14 & ASCE 7-16 (Chapter 12/15)

Site coefficients per ASCE 7-16, Site Class D assumed

Mapped MCE, 5% damped, spectral response, acceleration parameter at short periods: $S_S := 2.45$

Mapped MCE, 5% damped, spectral response, acceleration parameter at 1s: $S_1 := 0.86$

Design 5% damped, spectral response, acceleration parameter at short periods: $S_{DS} := 1.63$

Design 5% damped, spectral response, acceleration parameter at 1s: $S_{D1} := 0.86$

Per ASCE 37-14, does seismic need to be considered? $\text{Consider_seismic} := \begin{cases} \text{"NO"} & \text{if } S_1 < 0.4 \\ \text{"YES"} & \text{otherwise} \end{cases}$ Consider_seismic = "YES"

If seismic is required to be considered:

Temporary reduction coefficient as allowed by ASCE 37-14 (minimum value = 0.2): $\text{red}_{eq} := 0.2$

ASCE 37-14, Section 6.5.2.3:

Response modification factor: $R_{eq} := 2.5$

3. The R factor used for temporary bracing systems shall not exceed 2.5 unless the system is detailed in accordance with the provisions of ASCE/SEI 7-10. Where R = 2.5 is used, only the requirements dealing with the strength of the seismic-resisting structural system need be satisfied.

Importance factor/Risk Category II: $I_e := 1.0$

Structural height (FT): $h_n := 20$

Approximate period parameters (Table 12.8-2, Page 90): $C_t := 0.02$

Long period transition period (Figure 22-12, Page 224): $T_L := 12$

Approximate Fundamental Period: $T_a := C_t \cdot h_n^{.75} = 0.19$

Modified spectral responses with reduction coefficient: $S_{S_mod} := S_S \cdot \text{red}_{eq} = 0.49$ $S_{DS_mod} := S_{DS} \cdot \text{red}_{eq} = 0.33$

$S_{1_mod} := S_1 \cdot \text{red}_{eq} = 0.17$ $S_{D1_mod} := S_{D1} \cdot \text{red}_{eq} = 0.17$

Seismic response coefficient:

$$C_{s,calc} := \min \left[\frac{S_{DS_mod}}{\left(\frac{R_{eq}}{I_e} \right)}, \left. \begin{array}{l} \frac{S_{D1_mod}}{T_a \cdot \left(\frac{R_{eq}}{I_e} \right)} \text{ if } T_a \leq T_L \\ \frac{S_{D1_mod} \cdot T_L}{T_a^2 \cdot \left(\frac{R_{eq}}{I_e} \right)} \text{ if } T_a > T_L \end{array} \right] = 0.130$$

$$C_{s,min} := \left. \begin{array}{l} \max(0.044 \cdot S_{DS_mod} \cdot I_e, 0.01) \text{ if } S_1 < 0.6 \\ \max\left(0.044 \cdot S_{DS_mod} \cdot I_e, 0.01, \frac{0.5 \cdot S_{1_mod}}{\frac{R_{eq}}{I_e}}\right) \text{ if } S_1 \geq 0.6 \end{array} \right] = 0.034$$

$$C_s := \left. \begin{array}{l} 0 \text{ if Consider_seismic} = \text{"NO"} \\ \max(C_{s,calc}, C_{s,min}) \text{ otherwise} \end{array} \right] \quad C_s = 0.130$$


Vertical seismic load effect:

$$EQ_v := \left. \begin{array}{l} 0 \text{ if Consider_seismic} = \text{"NO"} \\ 0.2 \cdot S_{DS_mod} \text{ otherwise} \end{array} \right] \quad EQ_v = 0.065$$


NOTE: WIND LOADS WILL GOVERN SO SEISMIC LOADS CAN BE IGNORED.

Global Stability:


Overturning and Uplift Checks:

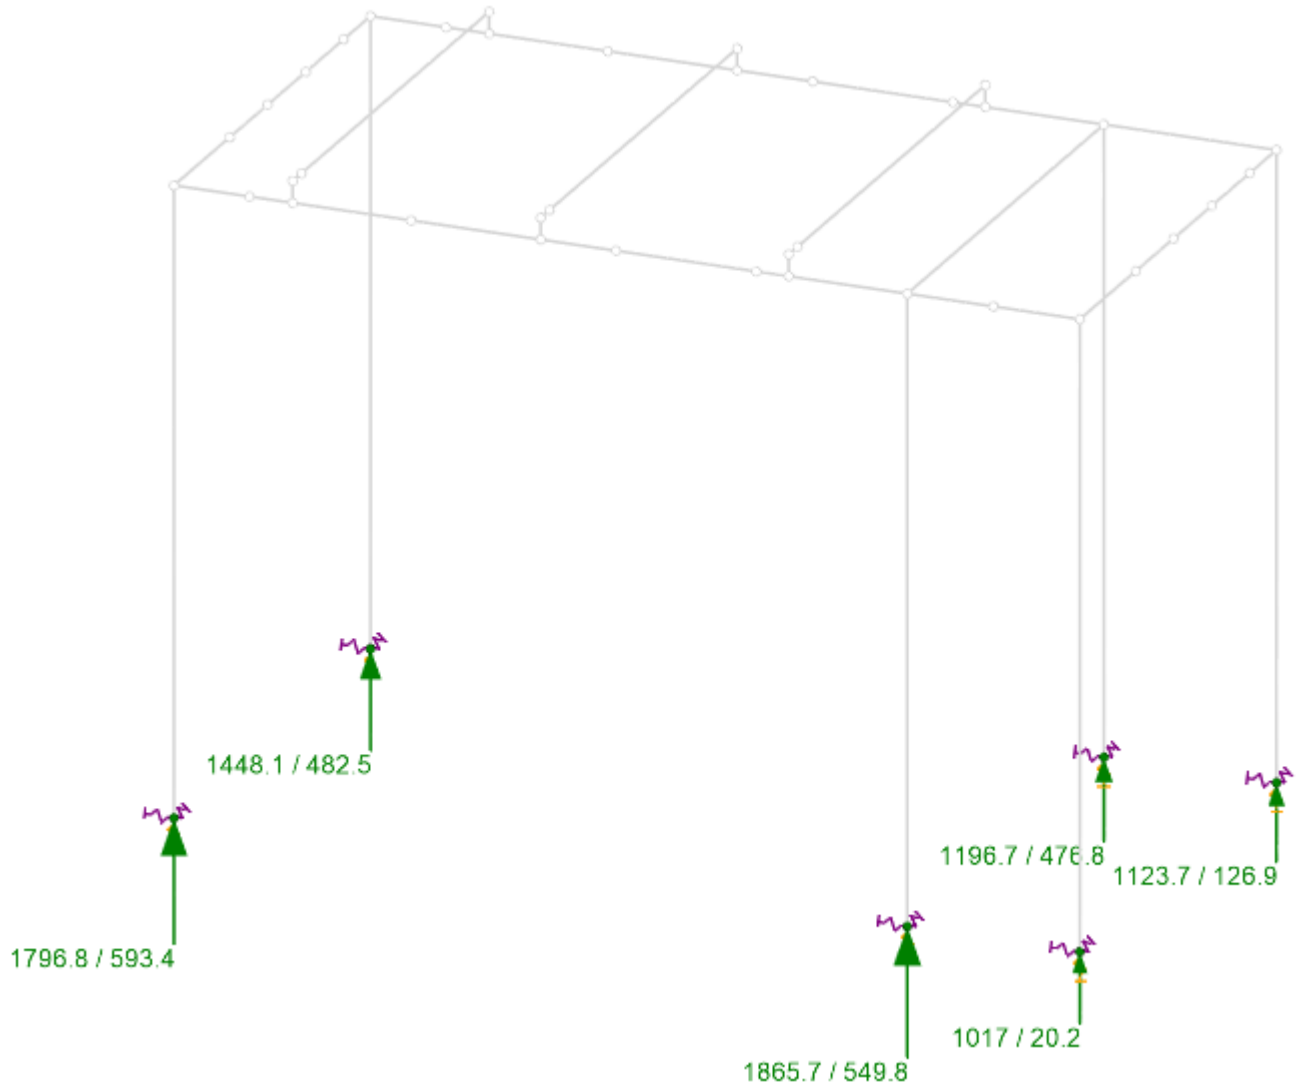

Enveloped Vertical Reactions - Video Wall on Front Edge of Beam

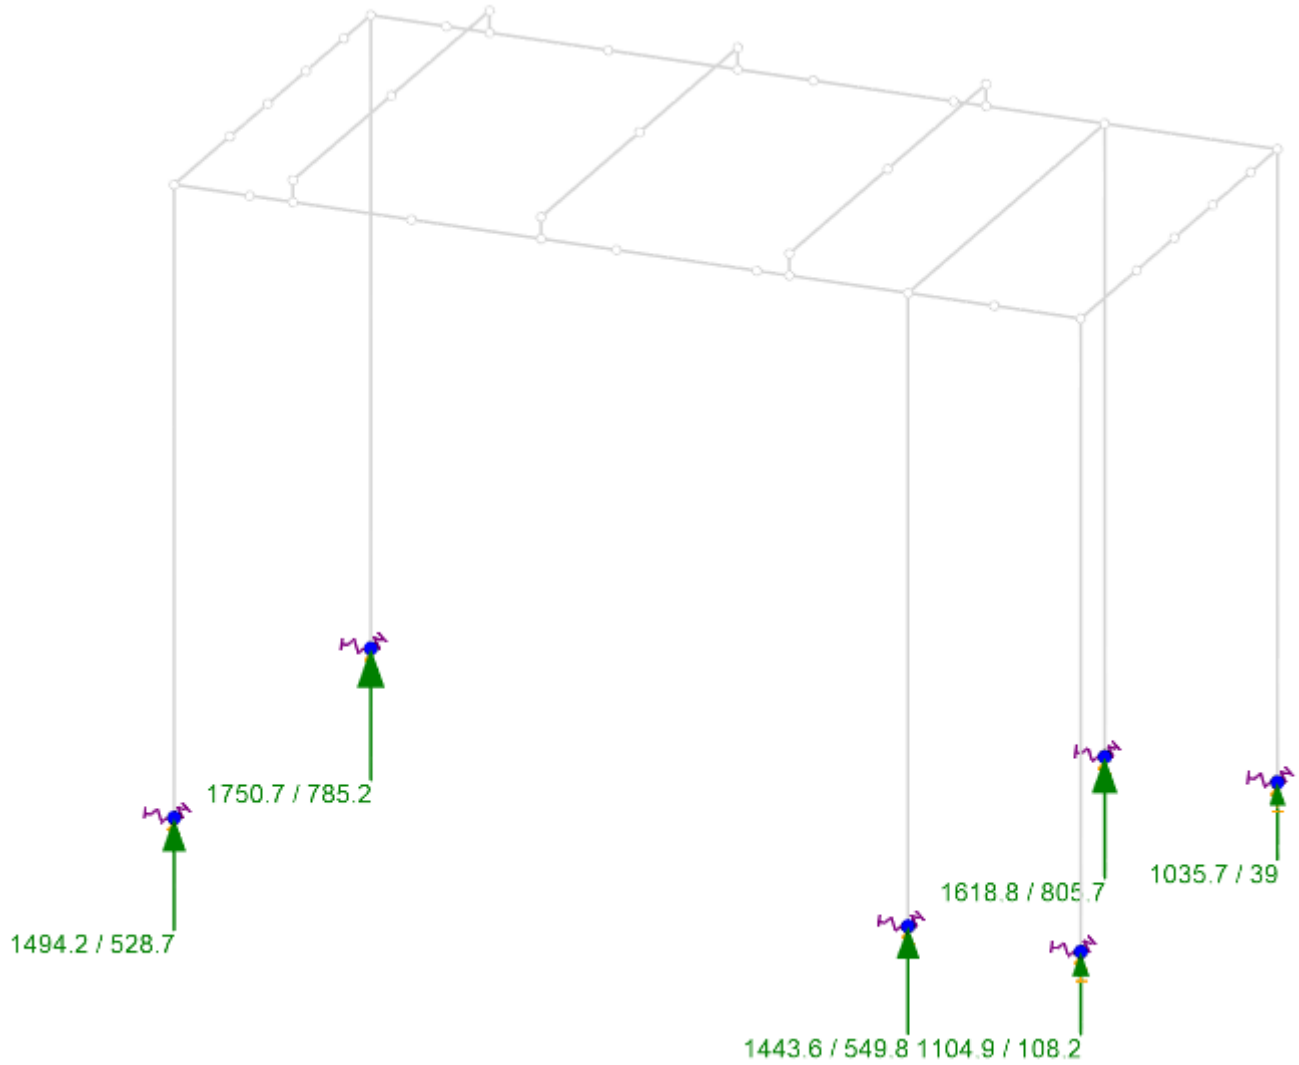


Enveloped Vertical Reactions - Video Wall on Center of Beam

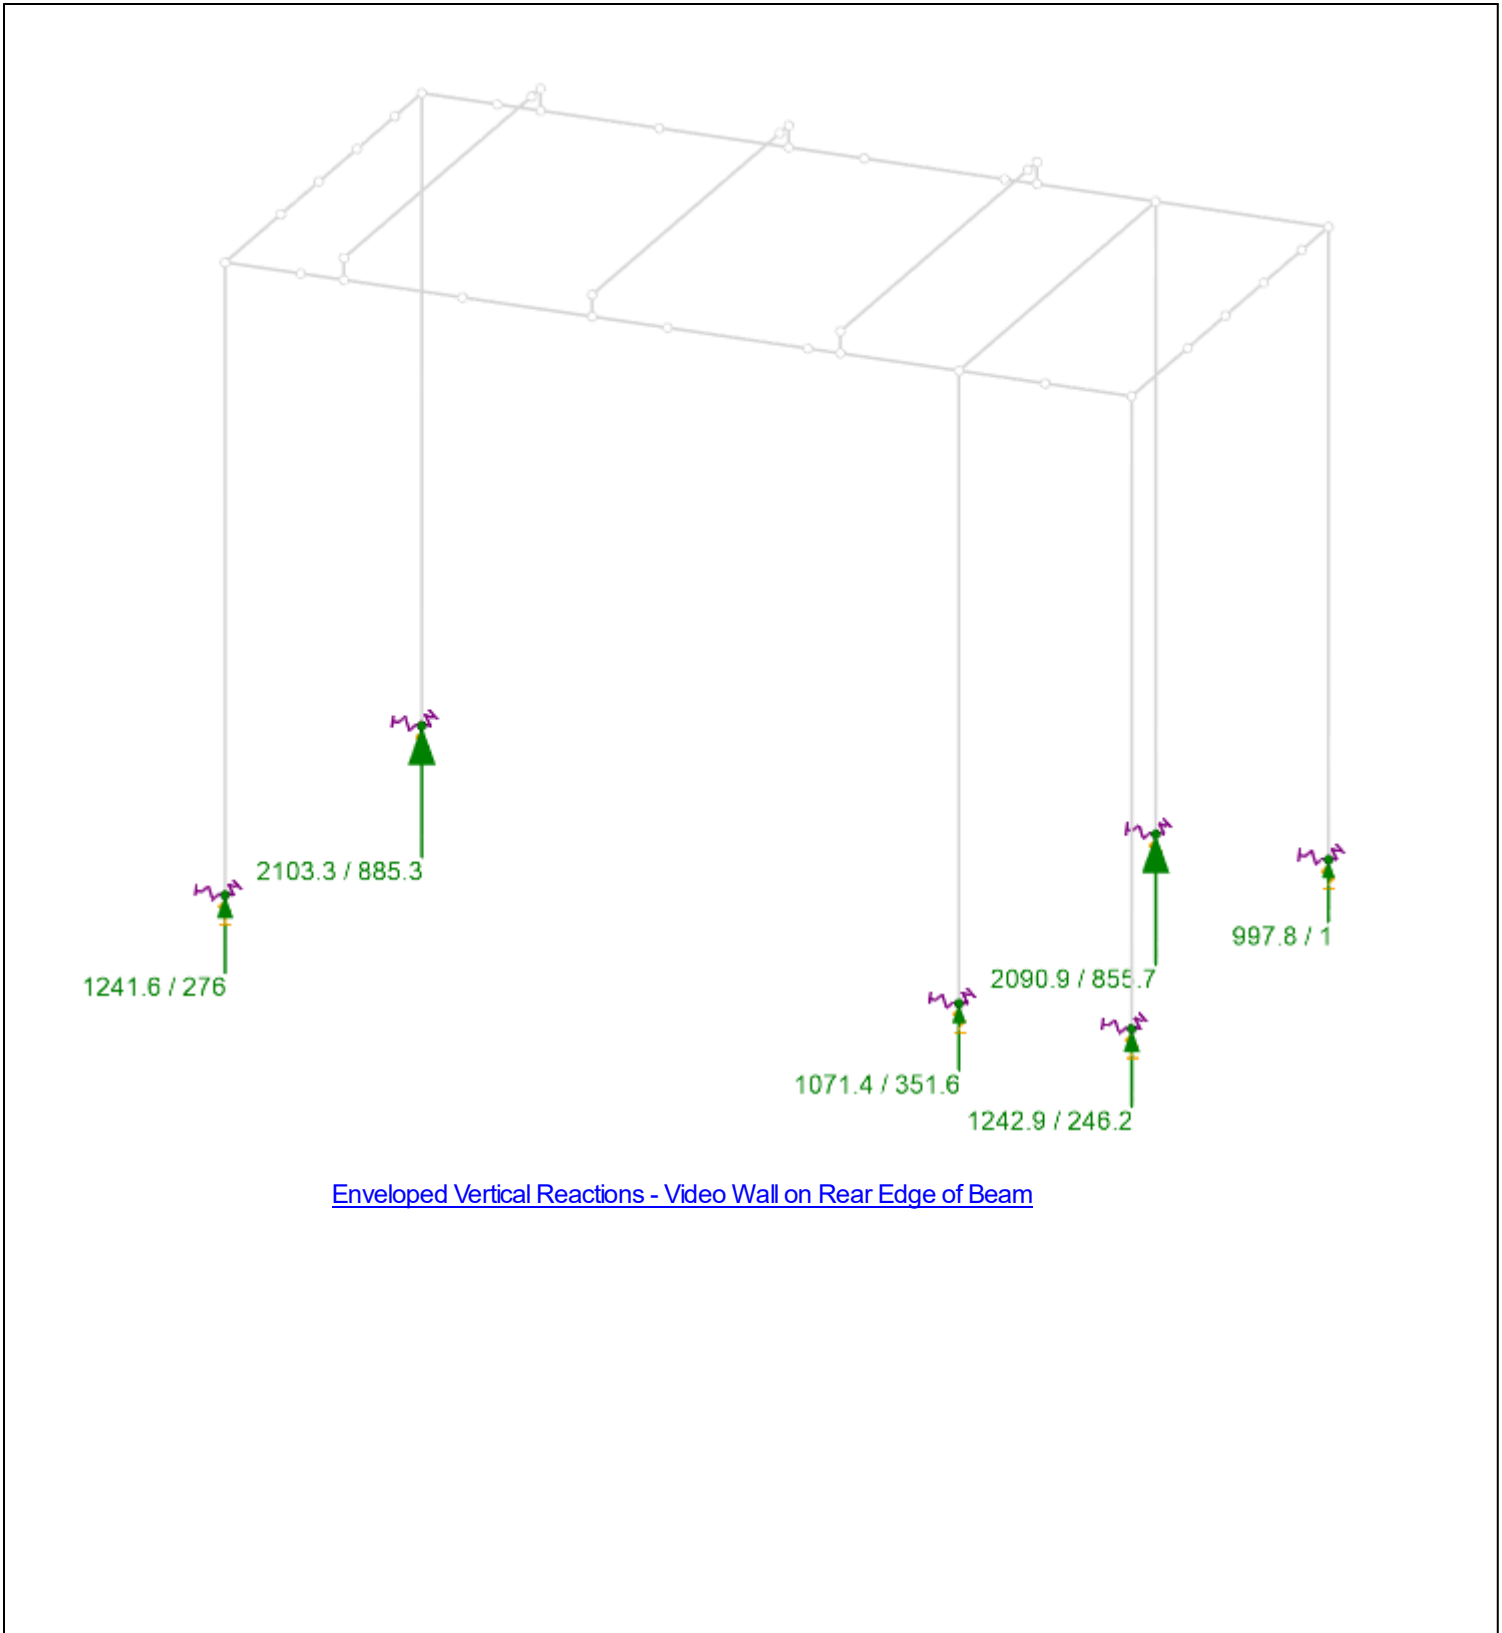


Enveloped Vertical Reactions - Video Wall on Rear Edge of Beam

Strength Checks:


S4x7.7 I-Beam:

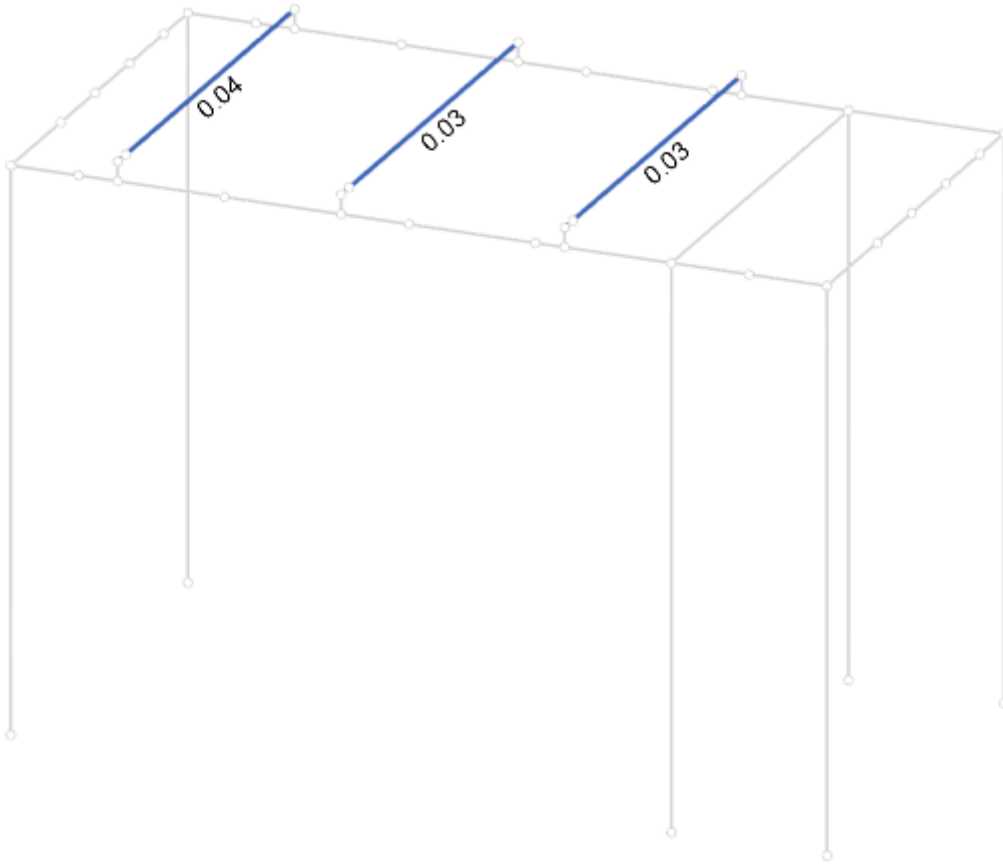

Unity Check - Video Wall at Front Edge of Beam

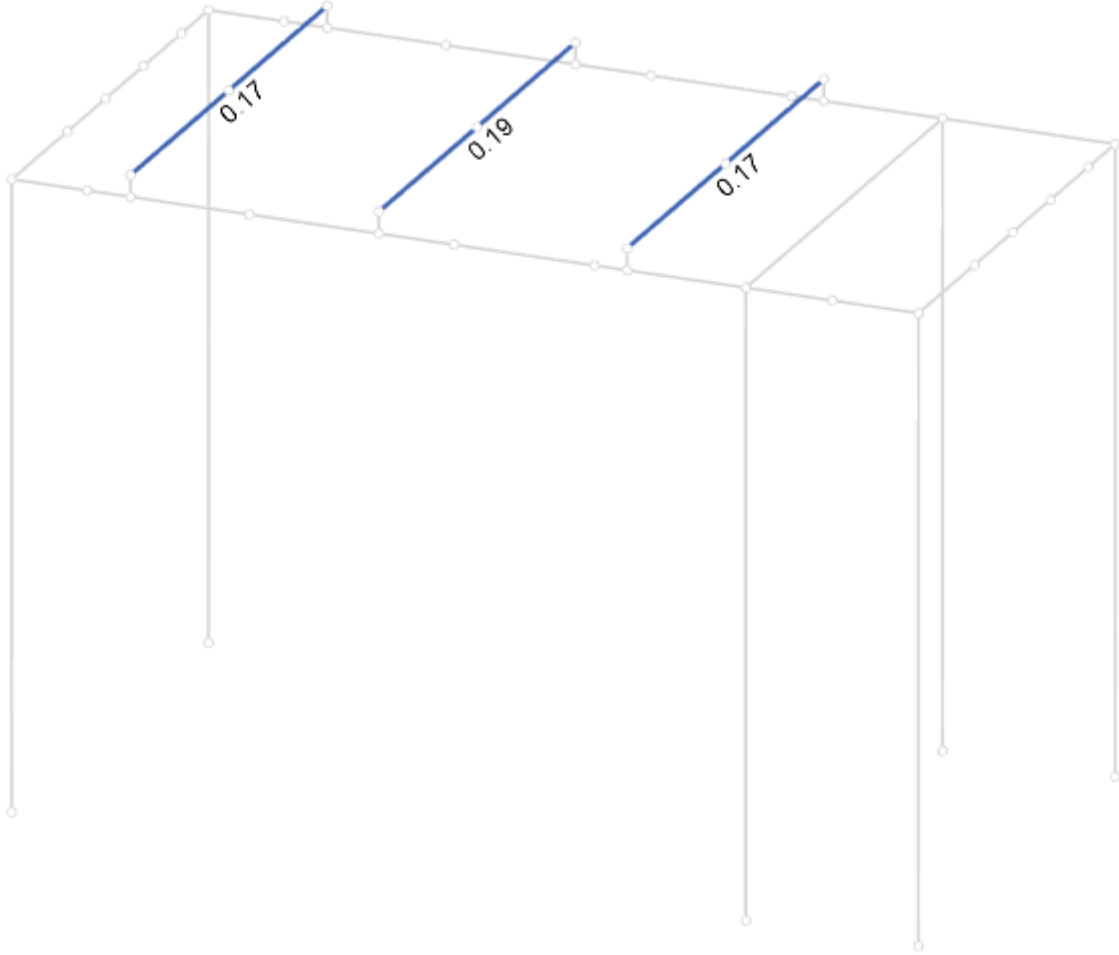

[Unity Check - Video Wall Centered on Beam](#)

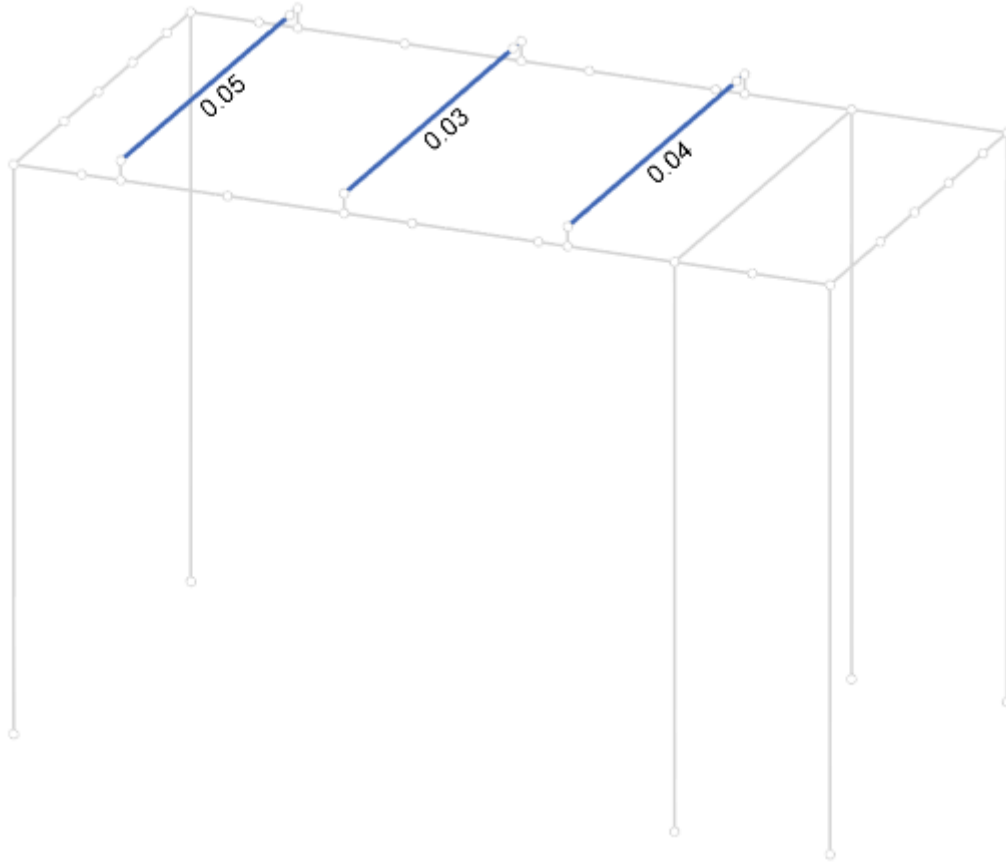

[Unity Check - Video Wall at Rear Edge of Beam](#)

12" x 12" Truss:

12" Truss Review

Axial Capacity:	14400	lb
Shear Capacity (Y-axis):	2454	lb
Shear Capacity (Z-axis):	981	lb
Moment Capacity (Y-axis):	2400	lb-ft
Moment Capacity (Z-axis):	6000	lb-ft
Chord Area:	0.736	in ²

Truss Brand:	Tomcat
Truss Size:	Core 12x12 Plated
Shear Weak/Strong Axis Ratio:	0.4
Moment Weak/Strong Axis Ratio:	0.4

Maximum:	1528	798	157	107	1918	2574
Minimum:	-349	-871	-140	-118	-1803	-2235

Controlling Strength Ratio	
0.889	0.35

Case	Member	Location	Forces					Strength Ratio	
			Axial [lb]	Shear Y [lb]	Shear Z [lb]	Torque [lb-ft]	Moment YY [lb-ft]	Moment ZZ [lb-ft]	Axial + Moment

[Unity Check - Video Wall at Front Edge of Beam](#)

12" Truss Review

Axial Capacity:	14400	lb
Shear Capacity (Y-axis):	2454	lb
Shear Capacity (Z-axis):	981	lb
Moment Capacity (Y-axis):	2400	lb-ft
Moment Capacity (Z-axis):	6000	lb-ft
Chord Area:	0.736	in ²

Truss Brand:	Tomcat
Truss Size:	Core 12x12 Plated
Shear Weak/Strong Axis Ratio:	0.4
Moment Weak/Strong Axis Ratio:	0.4

Maximum:	1340	576	337	214	1580	2313
Minimum:	-422	-618	-338	-203	-1607	-2308

Controlling Strength Ratio	
0.738	0.34

Case	Member	Location	Forces					Strength Ratio	
			Axial [lb]	Shear Y [lb]	Shear Z [lb]	Torque [lb-ft]	Moment YY [lb-ft]	Moment ZZ [lb-ft]	Axial + Moment

[Unity Check - Video Wall Centered on Beam](#)

12" Truss Review

Axial Capacity:	14400	lb
Shear Capacity (Y-axis):	2454	lb
Shear Capacity (Z-axis):	981	lb
Moment Capacity (Y-axis):	2400	lb-ft
Moment Capacity (Z-axis):	6000	lb-ft
Chord Area:	0.736	in ²


Truss Brand:	Tomcat
Truss Size:	Core 12x12 Plated
Shear Weak/Strong Axis Ratio:	0.4
Moment Weak/Strong Axis Ratio:	0.4

Maximum:	1703	871	159	129	2057	2788
Minimum:	-418	-952	-149	-118	-1938	-2274

Controlling Strength Ratio	
0.952	0.39

Case	Member	Location	Forces				Strength Ratio	
			Axial [lb]	Shear Y [lb]	Shear Z [lb]	Torque [lb-ft]	Moment YY [lb-ft]	Moment ZZ [lb-ft]

[Unity Check - Video Wall at Rear Edge of Beam](#)

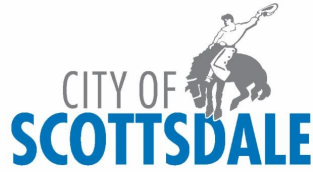

Notification of Proposed Special Events Canal Bank area

The City of Scottsdale has received several special event applications and is programming events to occur along the Old Town Scottsdale canal banks. The purpose of this email is to provide awareness to residents and businesses in the nearby area, relay details about the proposed events, and solicit feedback.

Please review the below information and if you have any comments, questions or concerns, contact [Cheryl Sumners](#) no later than Friday, June 20, 2025.

Canal Convergence 10 days, November 7 - 16

Returning for its 15th season, Canal Convergence is produced by Scottsdale Public Art as a free event that celebrates the vibrant arts and culture community, featuring large-scale public art installations with illuminated, interactive technology, created by local, national, and international artists. In addition to the artworks, the event includes educational programming, family-oriented activities, art-making workshops, live music, dance performances, and food/beverage options.

Event details and information include:

- Event Hours: Nightly. Fri. & Sat. 6 p.m.- 10 p.m.; Sun-Thu 6 p.m. - 9 p.m.
- Event Set-up: Art installations begin Oct. 27 and continues through Nov. 7.
- Event Tear-down: Begins immediately following the event, with installation removal completed by November 21.
- Entertainment: Live music, pre-recorded music, DJ, speaker/announcer and fire performances set to music during event hours.
- Event Parking: Volunteers, vendors, and attendees will be directed to the nearby public parking garages.
- Street Closures: Marshall Way located north of the bridge and south of Via Soleri from Thu. Nov. 6 at 6 a.m. – Mon. Nov. 17 at 6 a.m.

For more information, view the [Application and Site Plan](#)
Event Info: CanalConvergence.com