

5 AS-BUILT IMAGE
S2

N.T.S.

10 YEAR UV WARRANTY
POLYTEX™ 230
PREMIUM FIRE RATED SHADE FABRIC


TECHNICAL SPECIFICATIONS

Color Range	Warp		Weft	
	UVA	UVB	Mean UPF	Shade Factor
Aquamarine	92.5%	92.5%	14	55%
Black	96.9%	96.9%	33	97%
Bronze	90.4%	90.3%	10	80%
Claret	89.6%	91.7%	11	82%
Midnight Green	86.9%	84.9%	19	83%
Navy Blue	95.7%	95.9%	25	87%
Pomegranate	84.9%	85.7%	23	73%
Bluet	83.4%	83.7%	6	87%
Sage	92.4%	92.4%	3	85%
Sandstone	92.4%	92.4%	3	72%
Silver	84.5%	84.8%	7	87%
Slate	94.2%	94.3%	18	82%
White	91.0%	91.2%	17	69%


FIRE STANDARD COMPLIANT
POLYTEX™ is made to the following standards:
NFPA 701 - 1995
ASTM E-119 Class (A)
CAL 119
ASTM E-136 Class 1
ASTM E-136 Class 2
SOLARFAB
WWW.SOLARFAB.COM
SMART FABRIC SOLUTIONS IN ENVIRONMENTAL CONTROL


1 FABRIC (FIRE RESISTANCE)
S2 N.T.S.

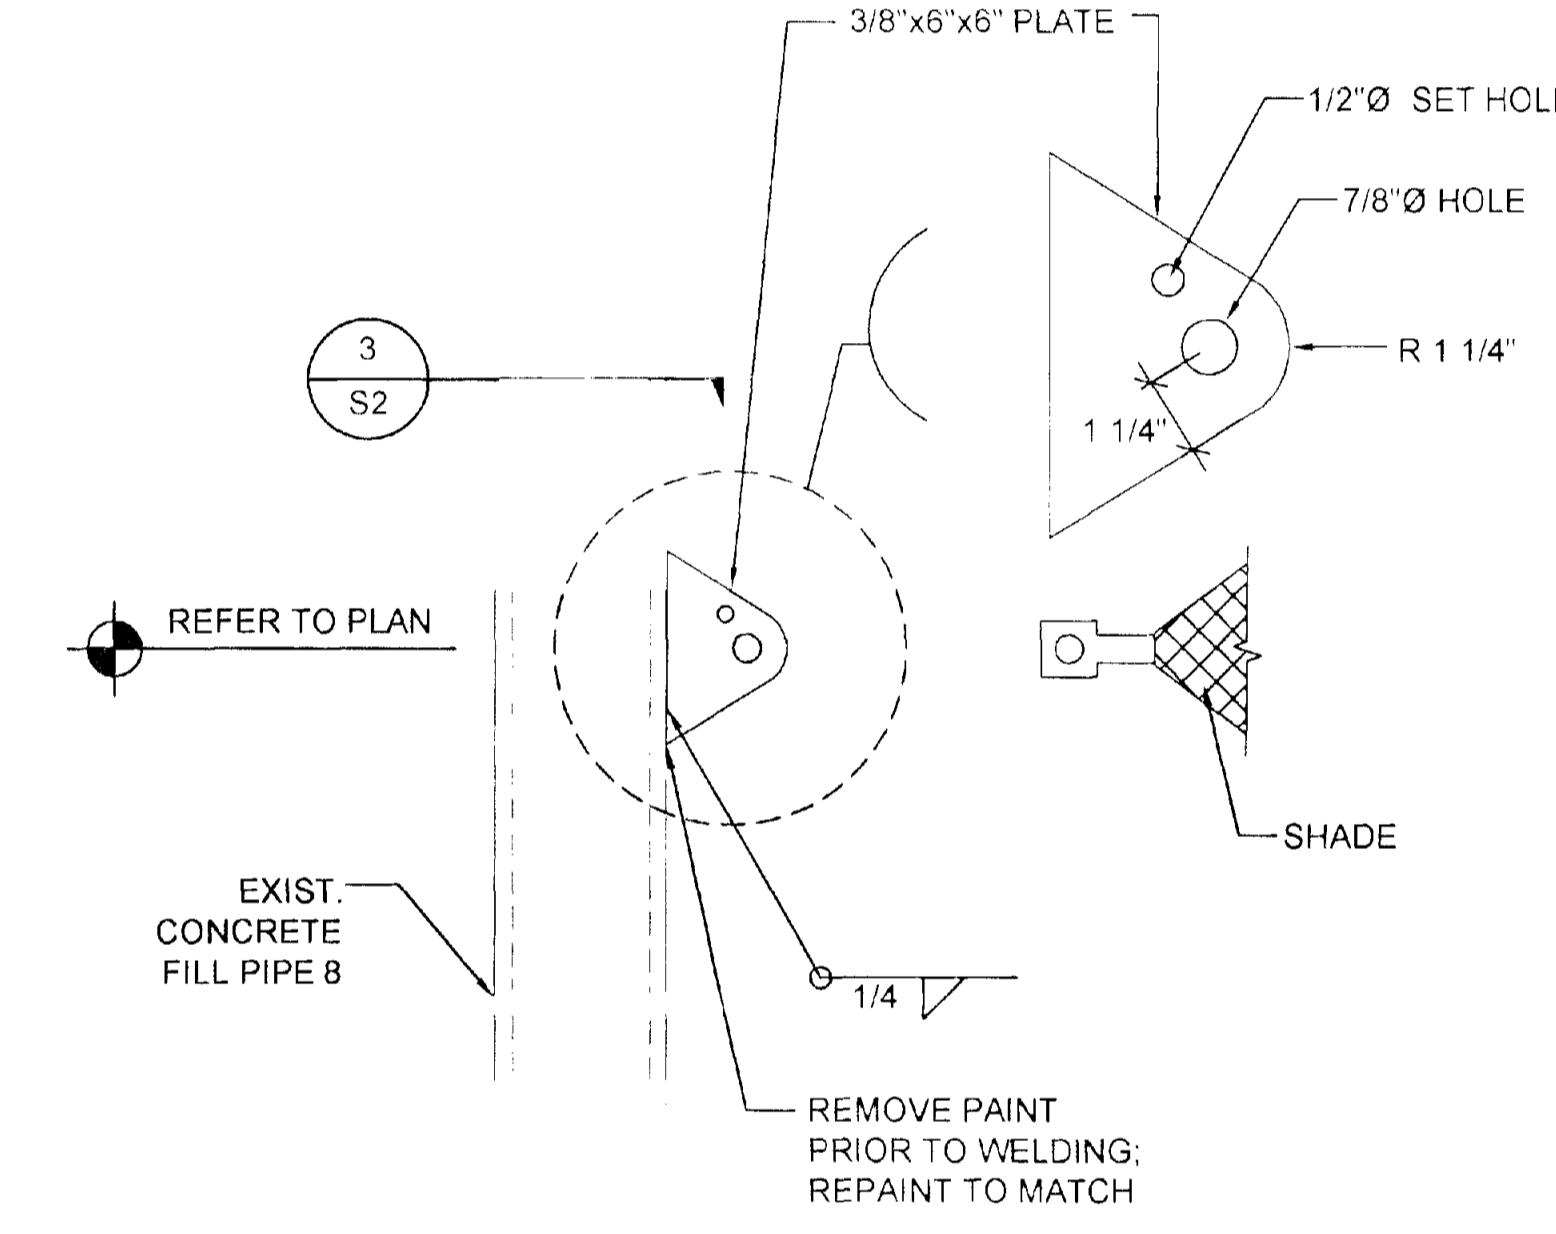

2 FABRIC CABLE SYSTEM CONNECTION TO POLE
S2 N.T.S.

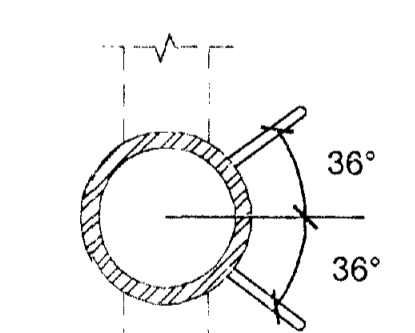

3 PLATE LAYOUT
S2 N.T.S.

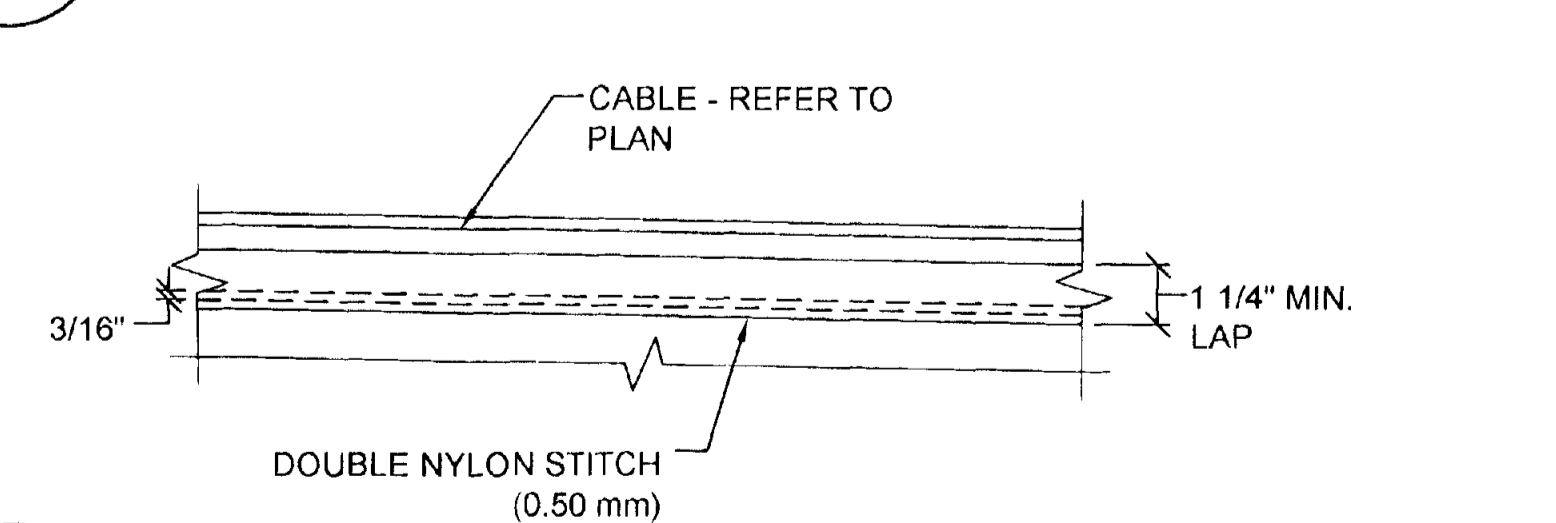

4 SHADE ATTACHMENT TO CABLES
S2 N.T.S.

3260 NORTH HAYDEN ROAD
SUITE 108
SCOTTSDALE, AZ 85251
PH: 480-425-2250
FX: 480-425-2225

TRUKTUR
STUDIO

URBAN SHADOW

W HOTEL
SHADE STRUCTURE
7277 EAST CAMELBACK
SCOTTSDALE, AZ 85251

REVISIONS

NO.	DESCRIPTION	DATE

OWNERSHIP OF DOCUMENTS
DRAWINGS AND SPECIFICATIONS AS INSTRUMENTS OF SERVICE ARE AND SHALL REMAIN THE PROPERTY OF THE ENGINEER WHETHER THE PROJECT FOR WHICH THEY WERE PREPARED IS EXECUTED OR NOT. THEY ARE NOT TO BE USED ON OTHER PROJECTS OR EXTENSIONS TO THIS PROJECT EXCEPT BY AGREEMENT IN WRITING AND WITH APPROPRIATE COMPENSATION TO STRUKTUR STUDIO, L.L.C.

SHEET TITLE
IMAGES AND DETAILS

JOB NUMBER: 100207
DRAWN BY: TB
CHECKED BY: DL
ISSUE DATE: 04/28/10

Professional Engineer
35222
DAVID P. LUNENG
State of Arizona
Arizona, U.S.A.

SHEET NUMBER
S2

\\s2\1\1000\100207\THE W HOTEL\STRUCTURE\100207-PLAN_DETAILS.dwg
PLN 28 04/28/10 10:28:10