Please refer to previous LL comments

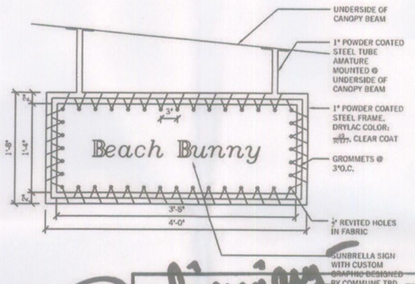

Preliminary

Tenant Plans

Approved ☐ Approved as Noted ☒

Not Approved ☐ Revise and Resubmit ☐

REVIEW IS FOR LANDLORD CRITERIA AS PER THE TENANT DESIGN PACKAGE INCLUDING DESIGNAGE AND SIGN AESTHETIC AND SIGN CONSIDERATION. THIS SHOULD NOT BE CONSTRUED AS REVIEW OR APPROVAL FOR CODE COMPLIANCE, ARCHITECTURAL, STRUCTURAL, MECHANICAL OR ELECTRICAL ADEQUACY OR COMPLIANCE TO OCCUPANTS NEEDS.

Comments

Design Reviewed By: Date:

Arc/M/E By: Date:

GLIMCHER DEVELOPMENT CORP.

1/5/11

PERSECTIVE RENDERING Scale: N/A 2

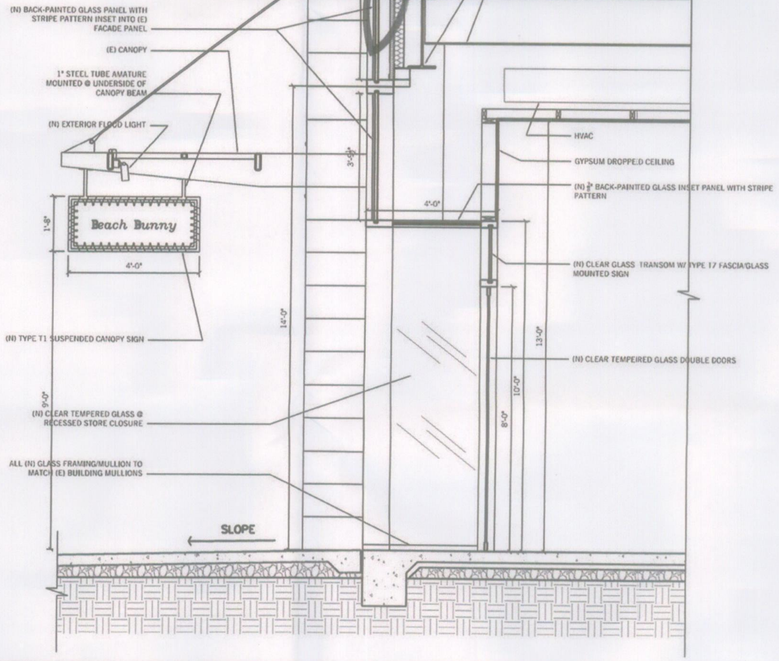

STOREFRONT SECTION Scale: 1/2"=1'-0" 3

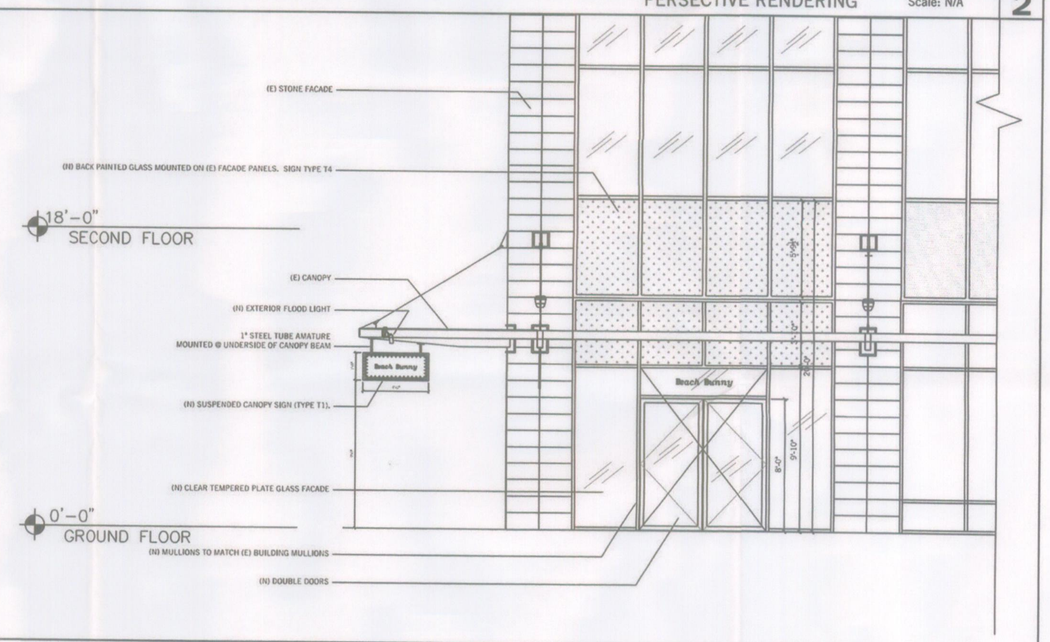

NORTH ELEVATION Scale: 1/4"=1'-0" 1

DRAWN BY: REVIEWED BY:

commune

650 N. Robertson Blvd, Los Angeles, CA 90069
Phone (310) 855-9080 Fax (310) 855-9079

DATE	ISSUANCE	REV. #

CLIENT
BEACH BUNNY
LOS ANGELES, CA 90069
T: 310.855.9080

PROJECT MANAGER
COMMUNE
650 NORTH ROBERTSON BLVD, STE 1
LOS ANGELES, CA 90069
T: 310.855.9080

DESIGNER
COMMUNE
650 NORTH ROBERTSON BLVD, STE 1
LOS ANGELES, CA 90069
T: 310.855.9080

PROJECT TITLE:

BEACH BUNNY SCOTTSDALE

15101 N. SCOTTSDALE RD
SCOTTSDALE, AZ

DRAWING TITLE:

STOREFRONT

SHEET #

ID 0.1

SCALE: AS NOTED