


This drawing is the property of David Kenyon Architect and is limited to the original use for which it was prepared. Changes, reproduction, or assigning to any third party of this drawing for any other use is not permitted without written consent of DAVID KENYON © 2013. David II Kenyon / Architect Tempe, Arizona 85281 dlkarchitect@gmail.com

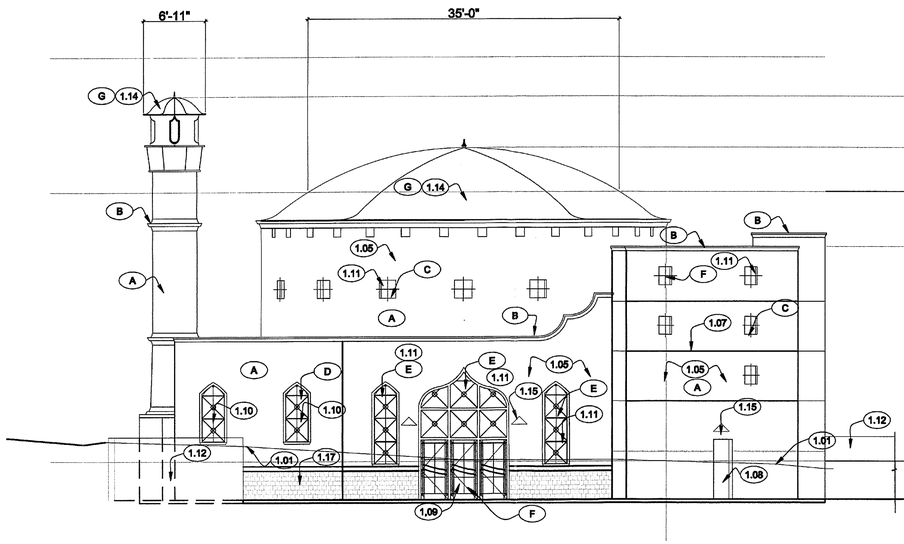


West Elevation

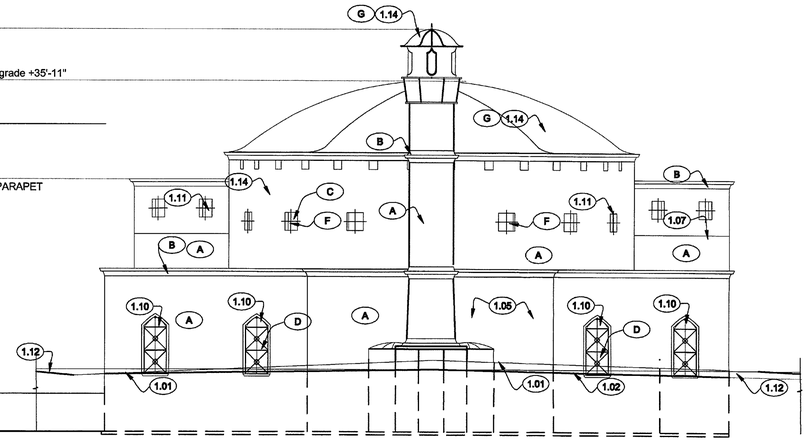

North Elevation

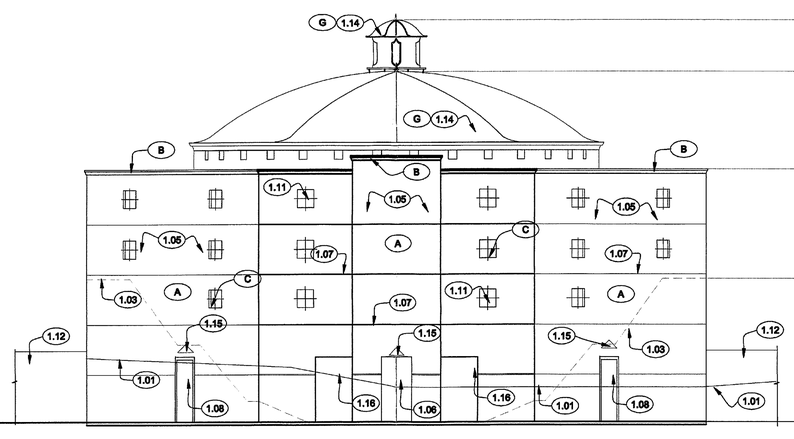

South Elevation

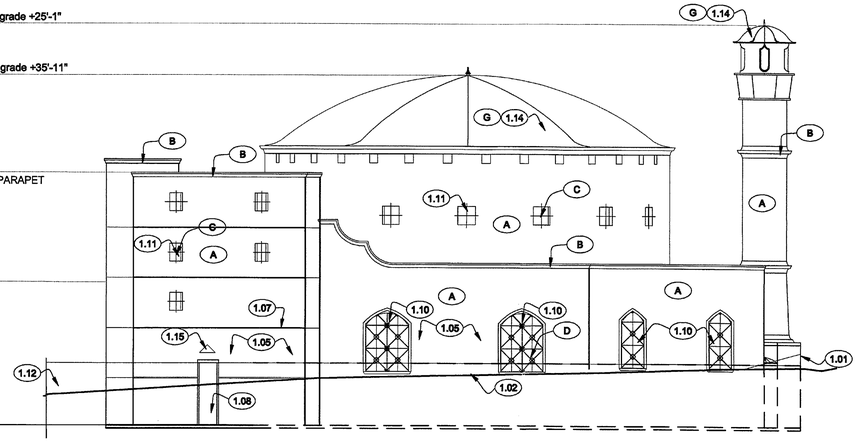

East Elevation

STIPULATION SET
RETAIN FOR RECORDS
APPROVED
11/5/13
DATE
INITIALS

Keynotes

1.01 Natural Grade.
1.02 Existing Grade
1.03 Fire Stair behind Wall.
1.04 Blank.
1.05 Syntactic smooth stucco on concrete block to match exiting.

1.06 Elevator Door.
1.07 Decorative stucco grid.
1.08 Metal exit door.
1.09 Metal decorative grate insert on full glass doors.
1.10 2 x 2 tile insert in security opening on street sides.

1.11 Bronze type e glazing with security decorative grate..
1.12 Stucco Low masonry retaining wall to match building finish.
1.13 Blank
1.14 Weathered Copper dome.
1.15 Exit Door Down Light to match existing building light. (DE 6119)

1.16 Exit opening for upper floor.
1.17 Split face 8x8 block to match existing project block.

Color Key

A Flat paint color FR 8833M Canberra (LRV 32) on stucco main field.
To match existing building colors

B Flat paint color FR 8814M Brindel (LRV 40) on stucco decorative caps
To match existing building colors

C Semi paint color DE6119 natural valley (LRV 7) on decorative metal work.

D Ivory Travertine Basket-wave Mosaics in security window with Metal Grate

E Openings Bronze window frames with bronze glass.

F Bronze glazing Doors with security decorative grate.

G Weather copper Dome.

Elevations

Scale 1/8" = 1'-0" 0 4 8


ISLAMIC CENTER of the NORTHEAST VALLEY
12125 East Via Linda, Scottsdale, Arizona

David II Kenyon / Architect
480.695.8402 dlkarchitect@gmail.com tempe, az


Revised 15 OCTOBER 2013 DLK 1306.02 DR 38

67-DR-2001#3
11/1/2013


This drawing is the property of David Kenyon Architect and is limited to the original use for which it was prepared. Changes, reproduction, or assigning to any third party of this drawing for any other use is not permitted without written consent of DAVID KENYON © 2013. David II Kenyon / Architect Tempe, Arizona 85281 dlkarchitect@gmail.com

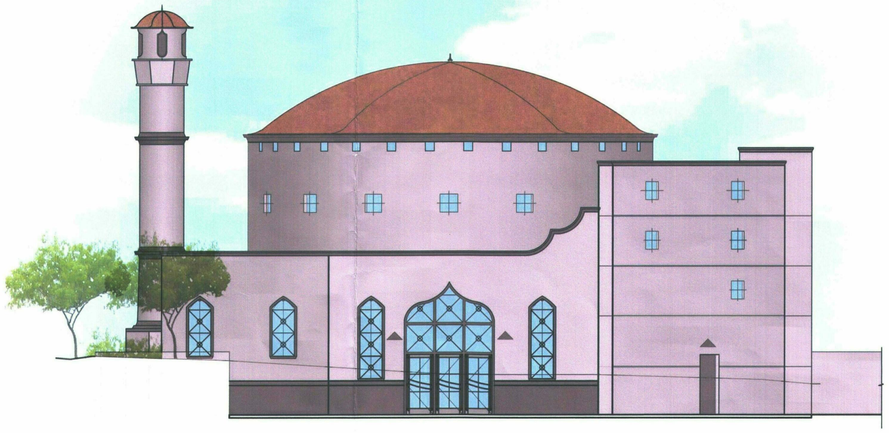


~~North~~ WEST Elevation

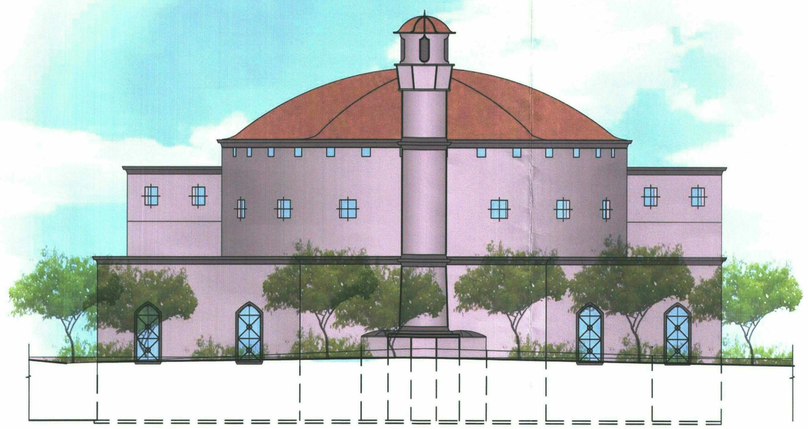

~~East~~ NORTH Elevation

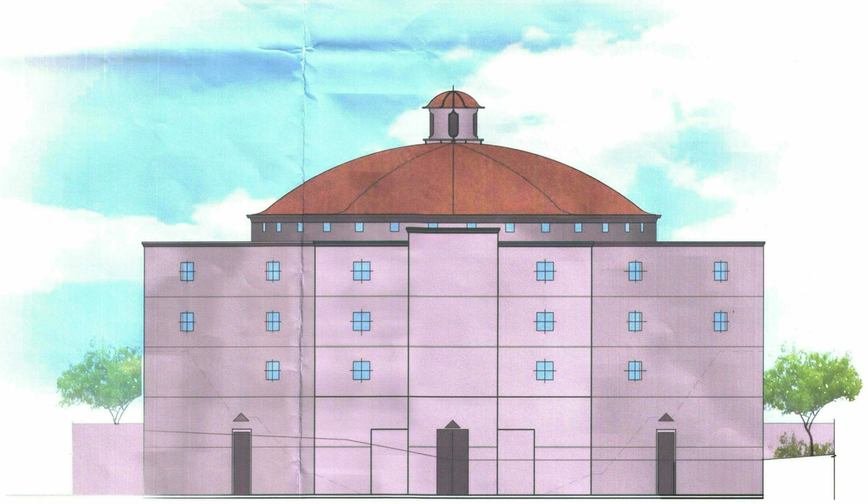

South Elevation

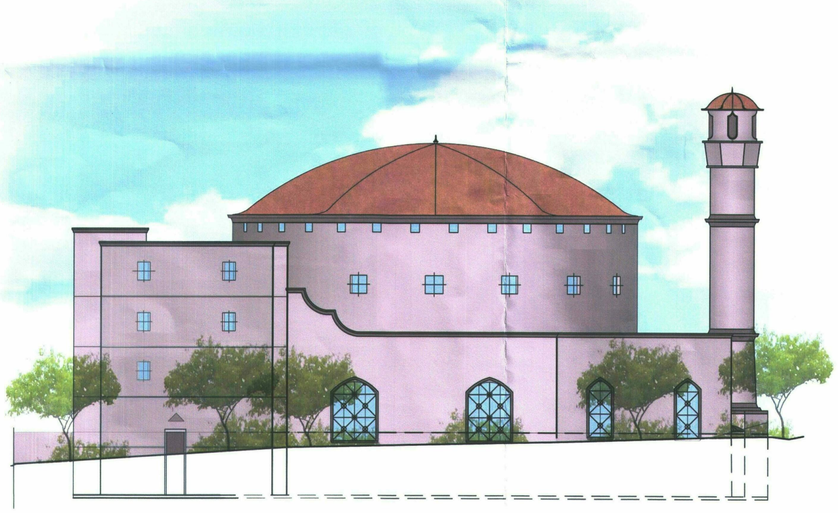

~~West~~ EAST Elevation

STIPULATION SET
RETAIN FOR RECORDS
APPROVED
12/5/13 DATE — INITIALS

Elevations

Scale 1/8" = 1'-0" 0 4 8

ISLAMIC CENTER of the NORTHEAST VALLEY
12125 East Via Linda, Scottsdale, Arizona

David II Kenyon / Architect
480.695.8602 dlkarchitect@gmail.com tempe, az

Revised 15 OCTOBER 2013 DLK 1306.02 DR 38

67-DR-2001#3
11/1/2013