



Development Review (Minor) Staff Approval

271-SA-2016

Lululemon

APPLICATION INFORMATION			
LOCATION:	15257 N Scottsdale Rd Ste 115	APPLICANT:	Ryan Weller
PARCEL:	215-56-414	COMPANY:	Menemsha
Q.S.:	34-45	ADDRESS:	20521 Earl St., Torrance, CA 90503
CODE VIOLATION #:		PHONE:	310-263-3520
Request: Remodeling the storefront design by replacing the existing wall finishes from stones to tile and plaster, and recladding the existing awning.			

STIPULATIONS

1. Architectural elements, including dimensions, materials, form, color, and texture, shall be constructed to be consistent with the building elevations submitted by Menemsha Solutions, stamped approved by City staff 7/21/16.
2. The location and configuration of all site improvements shall be consistent with the floor plan submitted by Menemsha Solutions, stamped approved by City staff 7/21/16.
3. The materials and colors for the exterior finishes of the storefront shall be consistent with the material sample board and color specifications submitted by Menemsha Solutions, stamped approved by City staff 7/21/16.
4. No new exterior lighting is reviewed or approved with this application.
5. All signs shall require separate review and permitting.

CONSTRUCTION DOCUMENT PLAN REVIEW SUBMITTAL REQUIREMENTS

Submit one copy of this approval letter, and a completed Owner/Builder form if applicable, and a permit application along with the following plan set(s) to the One-Stop-Shop for review:

PERMIT APPLICATION: **Completed Permit Application.** The permit application may be obtained or completed online at the following weblink:

http://www.scottsdaleaz.gov/Assets/Public+Website/bldgresources/APP_Permit_Commercial.pdf

(Please complete the permit application online prior to arriving at the City to submit your construction documents)

ARCHITECTURAL: 4 sets of architectural plans and 1 additional site plan and elevation.

Expiration of Development Review (Minor) Approval

This approval expires two (2) years from date of approval if a permit has not been issued, or if no permit is required, work for which approval has been granted has not been completed.

Staff Signature: _____

DATE: _____

7/21/16

Bryan Cluff, LEED AP
Senior Planner

Planning and Development Services

7447 East Indian School Road, Suite 105, Scottsdale, Arizona 85251 Phone: 480-312-7000 Fax: 480-312-7088

City of Scottsdale's Website: www.scottsdaleaz.gov

Fitzpatrick, Karen

From: Projectinput
Sent: Monday, May 09, 2016 2:36 PM
To: Projectinput
Subject: Online Pre-Application Submitted (397-PA-2016)



Pre-Application Number: **397-PA-2016**
Project Name: **LULULEMON**
Location: **15257 N SCOTTSDALE RD STE 115**

Contact Name: **Ryan Weller**
Contact Phone: **310-263-3520**
Contact Email: [**rweiler@menemshasolutions.com**](mailto:rweiler@menemshasolutions.com)



© 2016 City of Scottsdale. All Rights Reserved.



SENT VIA ELECTRONIC DELIVERY

April 27, 2016

Menemsha Solutions

Attn: Ryan Weller

310.263.3520

310.505.0164

rweller@menemshasolutions.com

RE: Lululemon
SCOTTSDALE QUARTER

Dear Mr. Weller,

This letter is notification that the Final Drawings for Lululemon at SCOTTSDALE QUARTER are being returned "Approved as Noted" with the following conditions:

Nothing in this letter shall be construed to expand Landlord's scope of work beyond that called for in the Lease Agreement.

Tenant is responsible for code compliance for Tenant's work.

Any attached written comments.

Any other comments as marked on this returned submission.

Please contact Zach Buckhart, Operations Director at 480.270.8123, prior to commencing work. Please contact me with questions or concerns at 614.887.5657.

Sincerely,

SDQ III FEE, LLC

A handwritten signature in black ink, appearing to read "Alan Bogart".

Alan Bogart

Senior Project Manager

Enclosures

Benjamin Moore customer service: 855-724-6802 Login ENGLISH

Search...

For Architects & Designers For Contractors

For Your Home: Painting Ideas Explore Color Find Products Learn How Exterior Stains Shop Now Store Locator Register Now

USA -> For Your Home -> Explore Our Paint Colors -> Color Gallery

Color Gallery Rooms by Color Main View Help? Color Name/Number

E-mail to a Friend Add to Favorites Print

G+1 1 Share 0

Cotton Balls

OC-122

BUY SAMPLE BUY PAINT

This color is part of the Off-White Color collection. Inherently sophisticated and endlessly versatile, the Off-White collection offers subtle nuances of whites that suit tranquil, serene environments as well as creates color-enhancing accents for dynamic spaces. A compilation of 152 white and off-white colors.

LRV: 89

EMBED COLOR BUY FAN DECK STORE LOCATOR

SEE COLOR IN ROOM

Benjamin Moore customer service: 855-724-6802 Login ENGLISH

Search...

For Architects & Designers For Contractors

For Your Home: Painting Ideas Explore Color Find Products Learn How Exterior Stains Shop Now Store Locator Register Now

USA -> For Your Home -> Explore Our Paint Colors -> Color Gallery

Color Gallery Rooms by Color Main View Help? Color Name/Number

E-mail to a Friend Add to Favorites Print

G+1 5 Share 0

Chantilly Lace

OC-65

BUY SAMPLE BUY PAINT


As delicate and refined as the lace it was named after, this crisp, clean white evokes images of pure silk, soft linen and simpler times.

LRV: 90

EMBED COLOR BUY FAN DECK STORE LOCATOR

SEE COLOR IN ROOM


271-SA-2016
 STIPULATION SET
 RETAIN FOR RECORDS
 APPROVED
 7/21/16
 DATE INITIALS

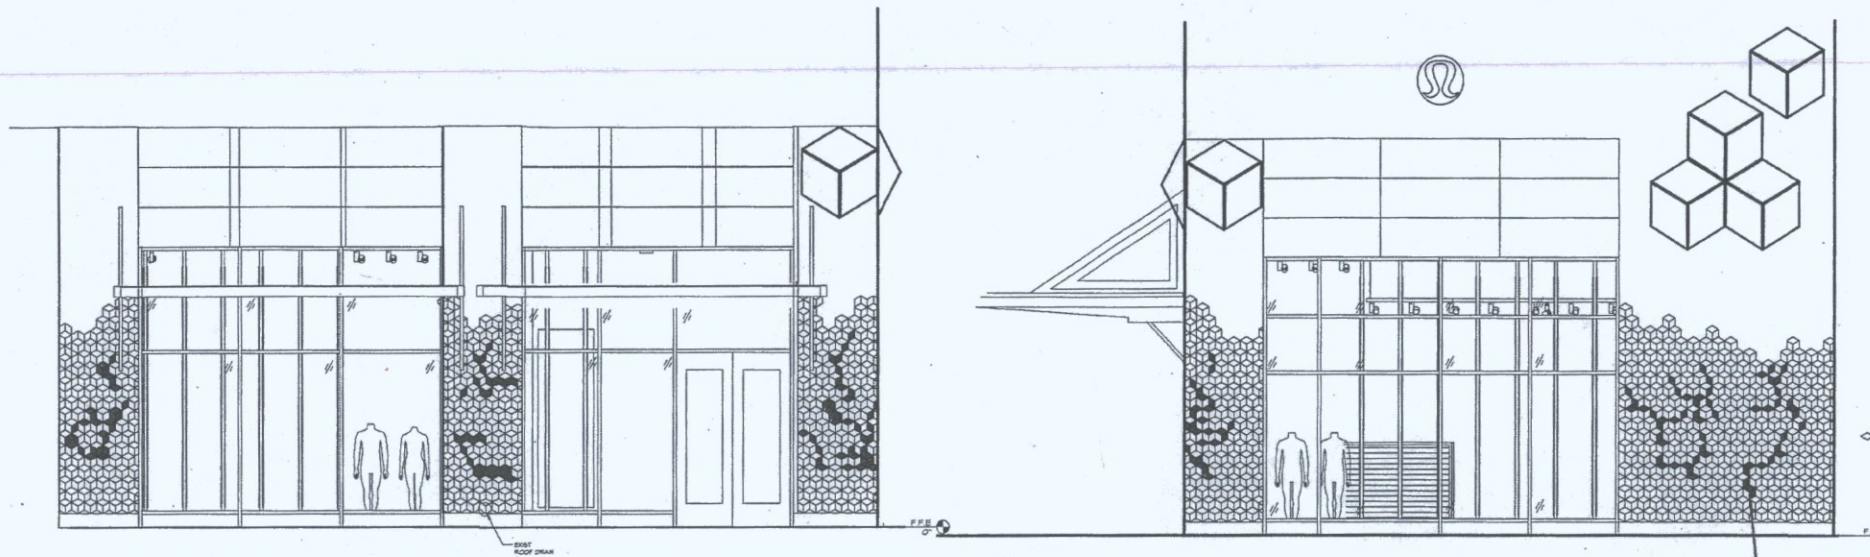

3 DIMENSIONAL COPPER FRAME INSTALLED ON FACE OF STOREFRONT REFLECTIVE OF TERRARIUM FRAMEWORK



WHITE PLASTER MATTE FINISH BY HOPPER FINISHES

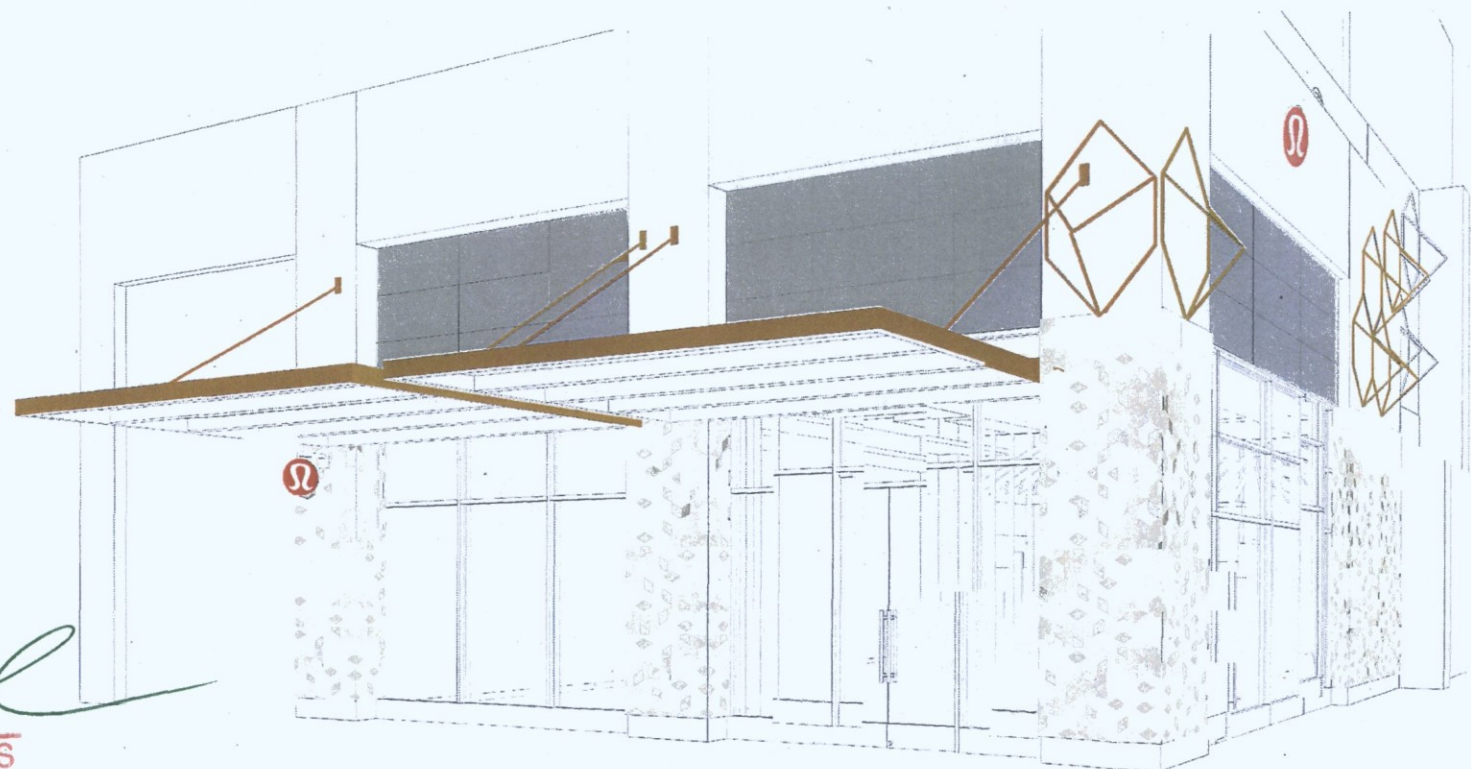

WHITE DIAMOND SHAPED TILE, MUTINA TEX WHITE - 5 TEXTURES




ACCENT TILE - POLISHED FINISH
LASER CUT TO MATCH MUTINA
DIMENSIONS
ANN SACKS
SEPULVEDA
SCRAFFITO
CREMA MARFIL

*DENOTED BY HATCHED TILE IN ELEVATIONS

271-SA-2016
STIPULATION SET
RETAIN FOR RECORDS
APPROVED
7/21/16
DATE INITIALS

PROPOSED STOREFRONT SCOTTSDALE QUARTER

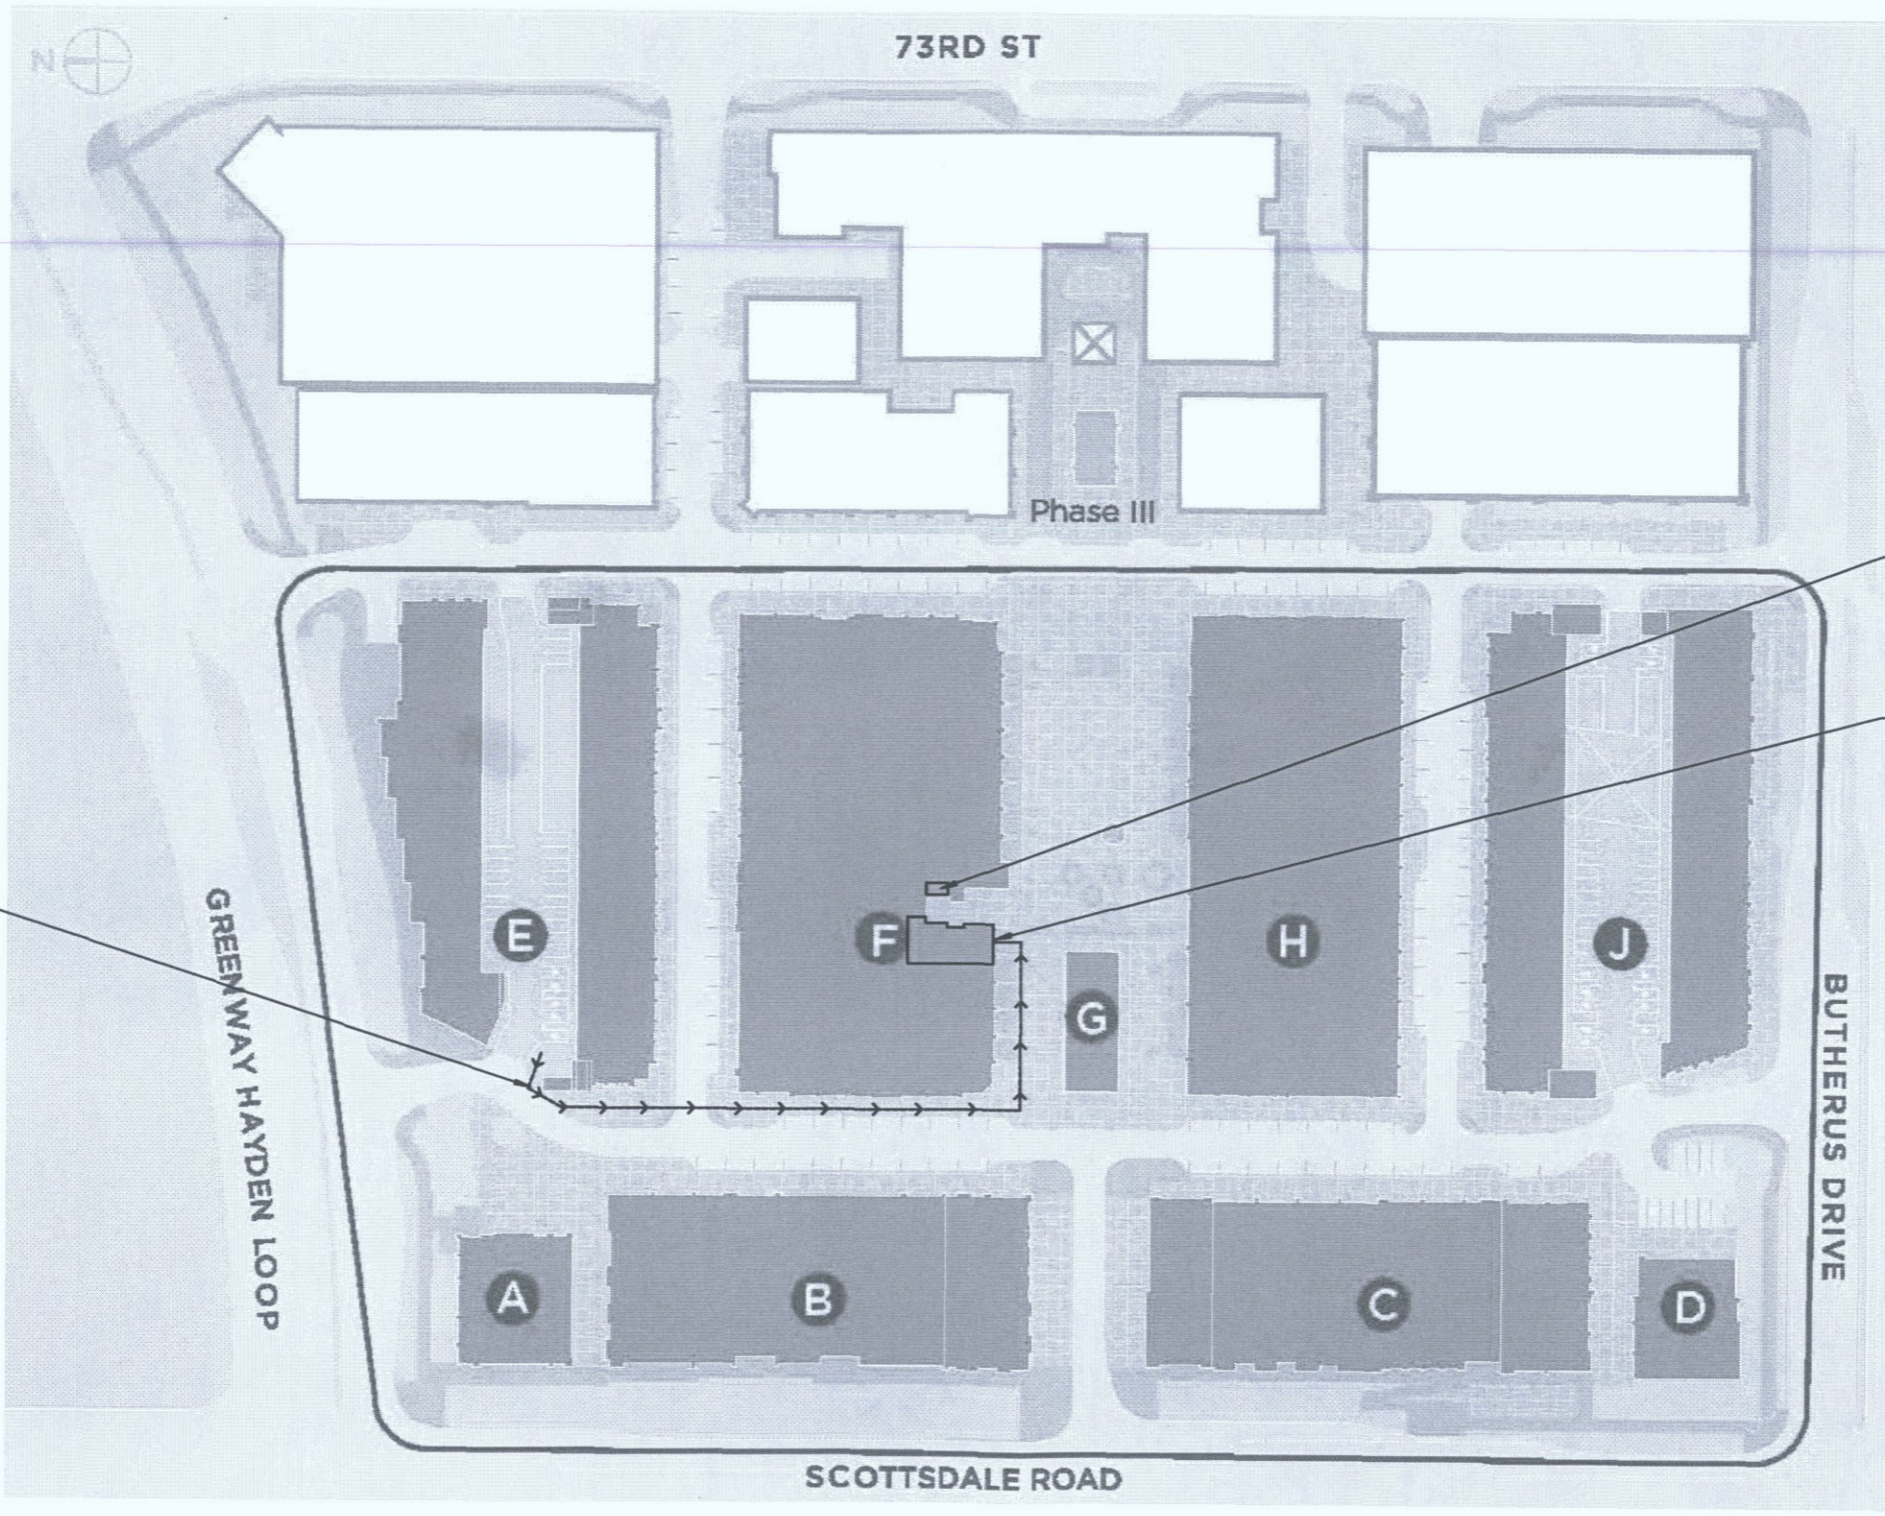

1 SITE PLAN
N.T.S.

Meremsha SOLUTIONS
 LOS ANGELES OFFICE
 1021 BAIL STREET
 TORRANCE, CA 90503
 T: 310-533-8888
 F: 310-533-8889
 www.meremsha.com

NORTON OFFICE
 500 WEST PINE AVE
 WESTVILLE, GA 30187
 T: 770-882-0000
 www.meremsha.com

NO.	DATE	DESCRIPTION



SITE PLAN
LULULEMON ATHLETICA
SCOTTSDALE QUARTER
 15251 N. SCOTTSDALE RD. SUITE F1-115 SCOTTSDALE, AZ 85254

271-SA-2016
 STIPULATION SET
 RETAIN FOR RECORDS
 APPROVED
 7/21/16 DATE INITIALS


DESIGNED FOR	02/14/16
DESIGNED FOR DD-LLL	03/18/16
DESIGNED FOR DD-LLD	03/18/16
DESIGNED FOR CD-LLL	04/12/16
DESIGNED FOR CD-LLD	xx/xx/xx
DESIGNED FOR PERMIT	05/04/16
DESIGNED FOR BID	xx/xx/xx

Scale:
 Date: 04/2/16
 Drawn By: AE
 Checked By: RW
 Job Number: 20091

Drawing:
G004

lululemon athletica

SCOTTSDALE QUARTER 15257 N. SCOTTSDALE RD. SUITE F1-115 SCOTTSDALE, AZ 85254

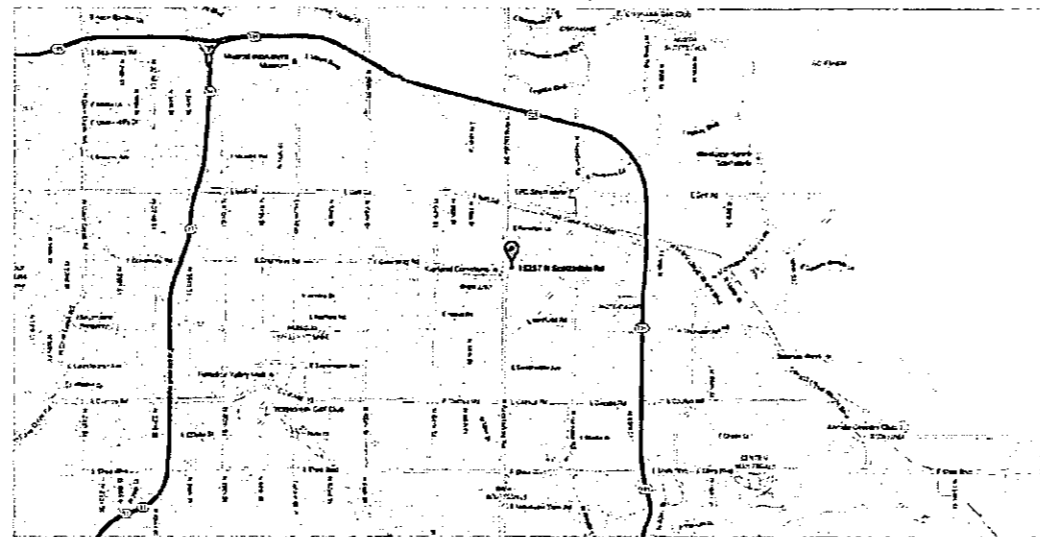

LOCUS PLAN

Project Directory	
Owner	LULULEMON ATHLETICA 1818 CORNWALL AVENUE VANCOUVER, BC, V6J1C7 604.732.6124 X6167 JENNIFER KURTZ JKURTZ@LULULEMON.COM
Project Management	4G DEVELOPMENT & CONSULTING, INC. DAVID YORK DYORK@4GDEV.COM 858.231.0100
Landlord	WPGLIMCHER 180 EAST BROAD ST. COLUMBUS, OH 43215 614.887.5657 ALAN BOGART ALAN.BOGART@WPGLIMCHER.COM
Consultant	MENEMSHA SOLUTIONS 20521 EARL ST. TORRANCE, CA 90503 310.263.3520 RYAN WELER RWELER@MENEMSHASOLUTIONS.COM
Architect of Record	REZA A. HADAEGH LIC. #53620
Structural Engineer	KEN OKAMOTO & ASSOCIATES 386-F AIRWAY AVENUE COSTA MESA, CA 92626 714.444.2422 KEN OKAMOTO KEN@KENOKAMOTO.COM
MEP Engineers	ACERTUS GROUP 14817 WEST 95TH ST. LENEXA, KS 66215 TELEPHONE: 913.322.5150 X103 CHUCK FREEMAN CHUCKFREEMAN@ACERTUSGROUP.COM
Building Department	CITY OF SCOTTSDALE 7447 E. INDIAN SCHOOL RD., SUITE 105 SCOTTSDALE, AZ 85251 480.312.2500

LEASABLE SPACE TOTAL = 4,455 SF
SALES FLOOR + FIT ROOMS = 3,393 SF
STOCKROOM, TOILET ROOMS, STAFF AREA, STORAGE & OFFICE = 662 SF
REMOTE STOCK ROOM = 400 SF

SCOPE OF WORK:
EXTERIOR TENANT IMPROVEMENTS INCLUDING REPLACING THE FINISHES OF THE EXISTING EXTERIOR WALLS TO TILE AND PLASTER

GLOBAL BULLETINS - TO BE REVIEWED BY G.C. AND TO AMEND/SUPERCEDE INFORMATION IN DRAWINGS	
G.B. #	DESCRIPTION
16.002	MOP SINK HANGER SPEC
16.003	BARRICADE GRAPHICS
16.004	DOOR HARDWARE SPEC
16.005	MAS-1 SPEC
16.006	MIRROR SPEC
16.007	HARDWARE - BRAS & TANKS SHELF HEIGHTS

GLOBAL REVISIONS - CLIENT DIRECTIVES UPDATED IN SET	
G.R. #	DESCRIPTION
16.002	SLOTTED FIXTURE PACKAGE REVISIONS
16.003	ELECTRICAL REVISION
16.004	FIT ROOM PAINT COLOR

Drawing Index	
ISSUED OR RE-ISSUED WITH REVISION	△
RE-ISSUED WITHOUT REVISION	○
PROGRESS ONLY	◎
ARCHITECTURAL	
G001	TITLE SHEET
G002	RESPONSIBILITY SCHEDULE & NOTES
G003	BLDG. CODE SUMMARY & EGRESS PLAN
G004	SITE PLAN
A001	SPECIFICATIONS
A002	SPECIFICATIONS
A003	SPECIFICATIONS
A004	SPECIFICATIONS
A005	SPECIFICATIONS
A006	SPECIFICATIONS
D110	DEMO PLAN
D112	CONST. BARRICADE/ WINDOWS DIMS.
D113	BARRICADE GRAPHICS
D120	FIELD VERIFICATION PLAN
A110	CONSTRUCTION PLAN
A120	CEILING PLAN
A125	CEILING FUTURE REF. PLAN
A130	FINISH PLAN
A130.1	FINISH SCHEDULES & KEYNOTES
A140	FIXTURE PLAN
A140.1	FIXTURE SCHEDULES & KEYNOTES
A210	INTERIOR ELEVATIONS - SALES AREA
A210.1	INTERIOR ELEVATIONS - SALES AREA
A214	PROJECT SPECIFIC MILLWORK DETAILS
A212	INTERIOR ELEVATIONS - BOH
A240	ENL. TOILET RM PLANS AND ELEVATIONS
A240	TYPICAL PARTITION TYPES & DETAILS
A211	PROJECT SPECIFIC DETAILS
A220	TYPICAL CONSTRUCTION DETAILS
A240	DOOR SCHEDULE & DETAILS
A244	TYPICAL DOOR DETAILS
A710	STOREFRONT RENDERING
A711	STOREFRONT PLAN & ELEVATION
A712	STOREFRONT PLAN & ELEVATION
A714	STOREFRONT SECTIONS
A716	STOREFRONT DETAILS
A717	STOREFRONT DETAILS
A810	FIT ENLARGED FITTING RIMPLIN & ELEV
A814	PROJ SPEC ENLARGED FITTING PLAN & ELEV
A820	TYPICAL MILLWORK DETAILS
A821	TYPICAL MILLWORK DETAILS
A822	MILLWORK DETAILS
Grand total: 40	
STRUCTURAL	
S1	GENERAL NOTES & DETAILS
S2	PARTIAL FOUNDATION PLAN
S3	PARTIAL FRAMING PLAN
S4	FRAMING DETAILS
MEP	
E011	ELECTRICAL SCHEDULES & LEGEND
E012	ELECTRICAL RISER & LIGHTING CONTROLS
E110	ELECTRICAL POWER PLAN
E120	ELECTRICAL LIGHTING PLAN
E120.1	ELEC LIGHTING FIXTURE SCHEDULE
E120	ELECTRICAL LOW VOLTAGE PLAN, ELEV. & DET.
E120.1	EAO SECURITY SYSTEM DETAILS
E010	ELECTRICAL DETAILS
E010	ELECTRICAL SPECIFICATIONS
M410	MECHANICAL FLOOR PLAN
M410.1	MECHANICAL FLOOR PLAN
M610	MECHANICAL SCHEDULES & DETAILS
M614	MECHANICAL SPECIFICATIONS
P410	PLUMBING FLOOR PLAN
P410	PLUMBING RISERS & DETAILS
P620	PLUMBING SCHEDULE
Grand total: 16	

Menemsha SOLUTIONS
1500 JAMES STREET
TORRANCE, CA 90503
310.263.3520
WWW.MENEMSHASOLUTIONS.COM

REVISIONS

NO.	DATE	DESCRIPTION

SCOTTSDALE QUARTER

TITLE SHEET

LULULEMON ATHLETICA
SCOTTSDALE QUARTER
15257 N. SCOTTSDALE RD. SUITE F1-115, SCOTTSDALE, AZ 85254

DATE FOR NO: 02/19/16
ISSUED FOR DD-LLL: 02/19/16
ISSUED FOR DD-LLL: 02/19/16
ISSUED FOR CD-ALL: 04/12/16
ISSUED FOR CD-ALL: 04/12/16
ISSUED FOR PERMIT: 05/04/16
ISSUED FOR BID: 06/14/16

SCALE: NTS
DATE: 04/12/16
DRAWN BY: AE
CHECKED BY: RW
JOB NUMBER: 20091

G001

CONTACTS

BARRICADE GRAPHICS VENDOR:
 SUPER GRAPHICS
 3240 18TH AVENUE
 WEST SEATTLE, WA 98148
 TELEPHONE: 800-645-4169
 PATRICK.FRALES@SUPERGRAPHICS.COM

LANDLORD:
 SCOTTSDALE QUARTER
 15205 N. SCOTTSDALE RD.
 SCOTTSDALE, AZ 85254
 TELEPHONE: 480-250-0428
 ZACH BARNHARD
 zach.barnhard@suppteacher.com

DESCRIPTION	GC		LANDLORD		GRAPHICS VENDOR		NOTES
	FURNISHED	INSTALLED	FURNISHED	INSTALLED	FURNISHED	INSTALLED	
BARRICADE	X	X					
BARRICADE DOORS	X	X					
BARRICADE PAINT	X	X					
BARRICADE GRAPHICS		X			X		CUSTOM BARRICADE GRAPHICS
REMOVABLE WALL							
CONSTRUCTION FLOORING							
CONSTRUCTION FLOORING							
CONSTRUCTION FLOORING							

LANDLORD NOTES






BARRICADE INSTALLATION AND GRAPHICS TO BE APPROVED BY ON-SITE OPERATIONS DIRECTOR.

- GENERAL NOTES**
- IF NO BARRICADE SPECIFICATION IS GIVEN BY HALL, BARRICADE TO BE CONSTRUCTED WITH 3-5/8" METAL STUDS WITH 5/8" TYPE 'X' GYPSUM WALL BOARD. FOR EXTERIOR BARRICADES USE 5/4" GRADE AC PLYWOOD WHERE PERMITTED OR SMOOTH WEATHERPROOF PALLETS/SKIDS SUCH AS HOF, CRISTONE, HANDEYMAN, OR APPROVED EQUAL.
 - ALL SUBSTRATES MUST BE PRE-PRIMED WITH ONE COAT LATEX PRIMER AND TWO COATS SEMI-GLOSS LATEX PAINT WITH FINISHED JOINTS, CLEAN, SMOOTH AND DRY, READY TO ACCEPT GRAPHIC VINYL.
 - BARRICADE DOORS TO BE FLAT AND FLUSH TO ADJACENT WALL. PREPARED THE SAME AS THE BARRICADE TO ACCEPT GRAPHICS.
 - GRAPHICS FOR EXTERIOR APPLICATION TO USE STRONG ADHESIVE MEANT FOR TEXTURED SURFACES. EXTERIOR GRAPHICS FOR INTERIOR BARRICADES PROVIDED BY HOLDING COMPANY OR LANDLORD TO USE REMOVABLE ADHESIVE. G.C. TO ENSURE NO RESIDUE TO REMAIN ON REMOVAL OF GRAPHICS.
 - G.C. TO REPEAL TEMPORARY EMISSION-UNFINISHED PAPER WITH MASKING TAPE OVER ALL CLEAR WINDOWS TO 1'-0" ABOVE GRADE AFTER REMOVAL OF BARRICADE. G.C. TO REMOVE TEMPORARY PAPER AND CLEAN WINDOWS PRIOR TO STORE OPENING.

Menemsha SOLUTIONS

1500 ANGELES OFFICE
 10510 SAN STREET
 TORRANCE, CA 90503
 (714) 241-1111

1500 ANGELES OFFICE
 10510 SAN STREET
 TORRANCE, CA 90503
 (714) 241-1111

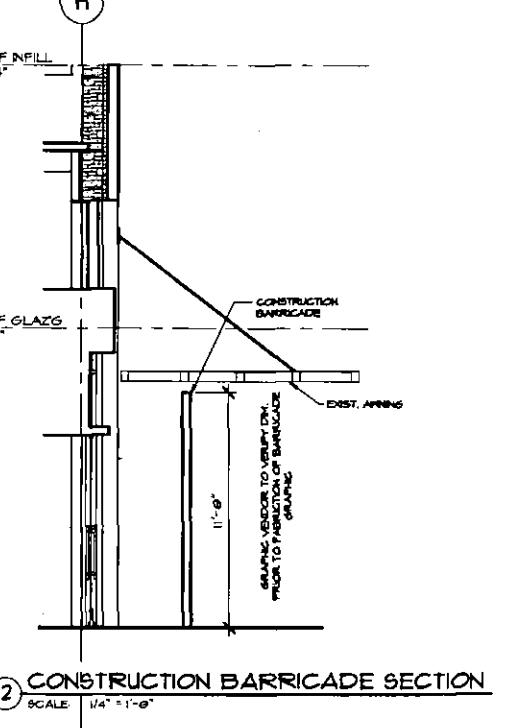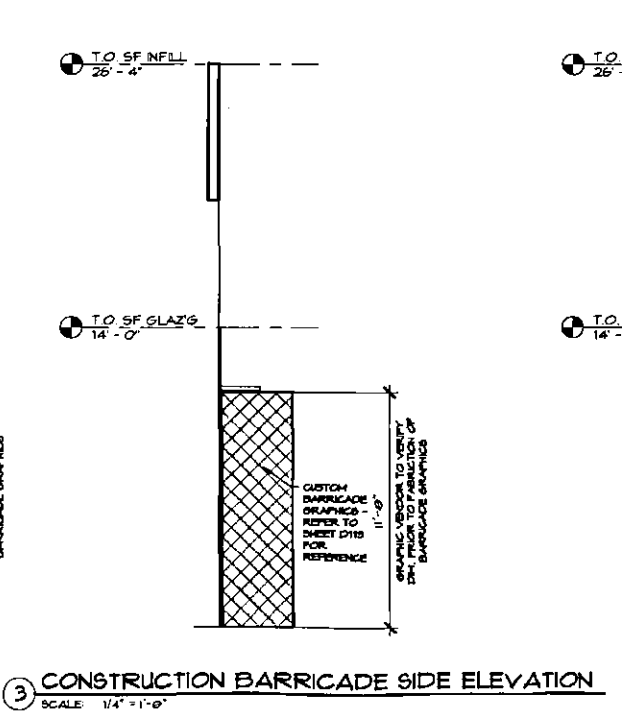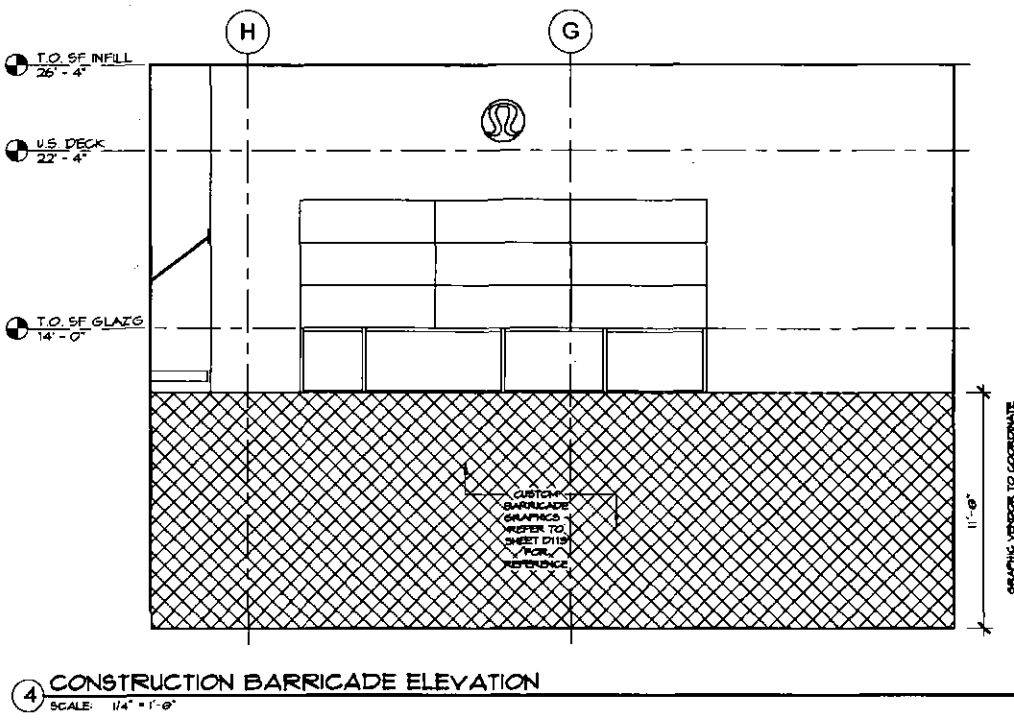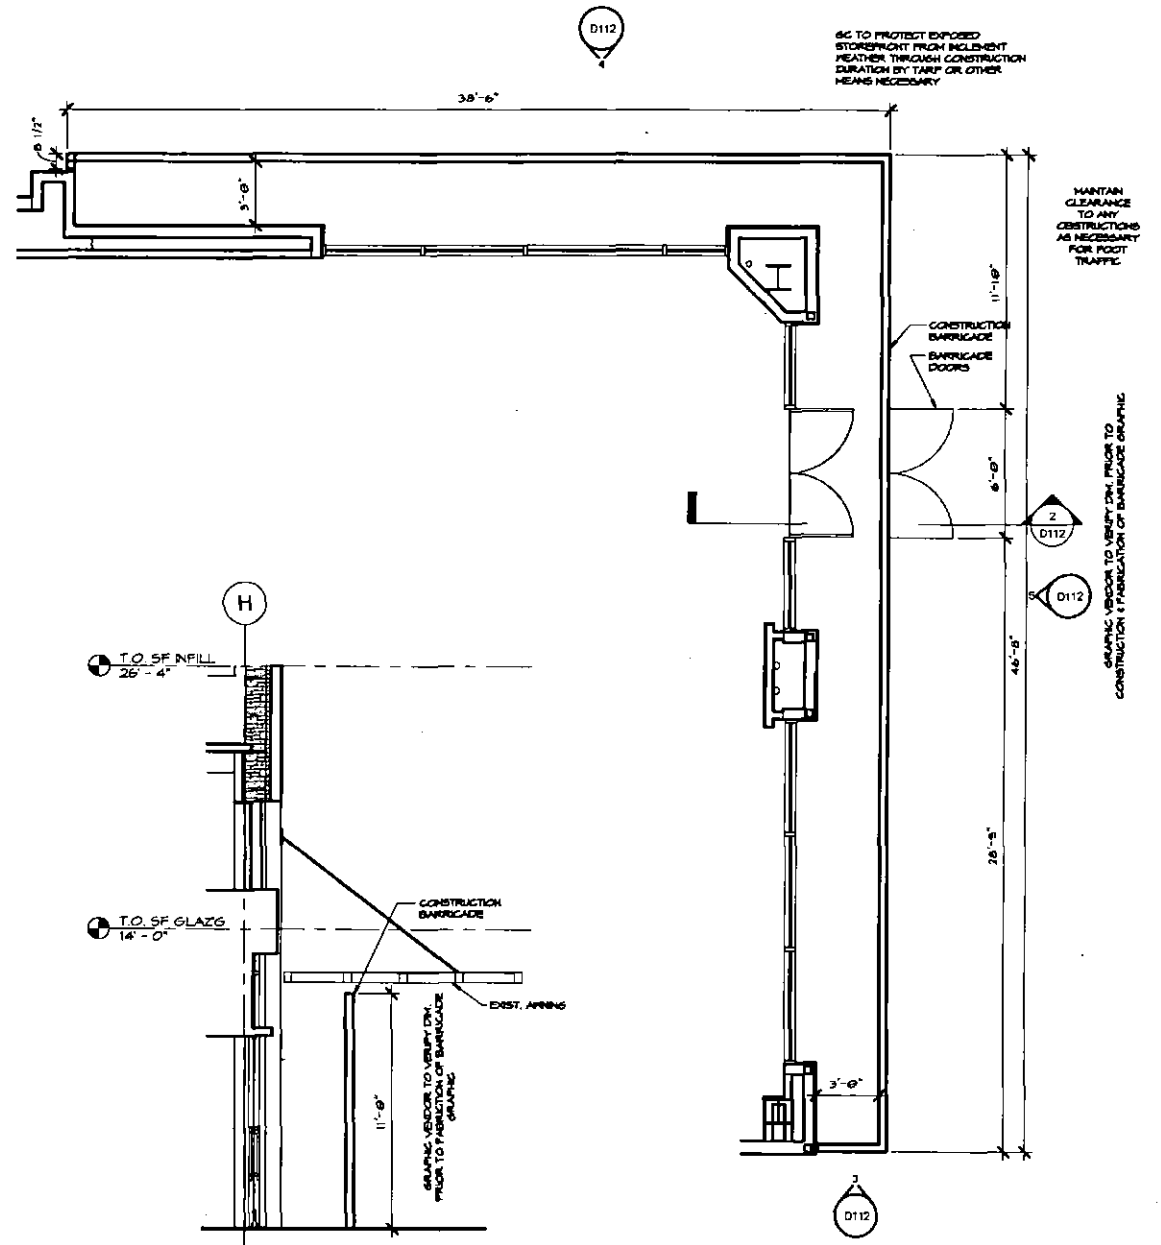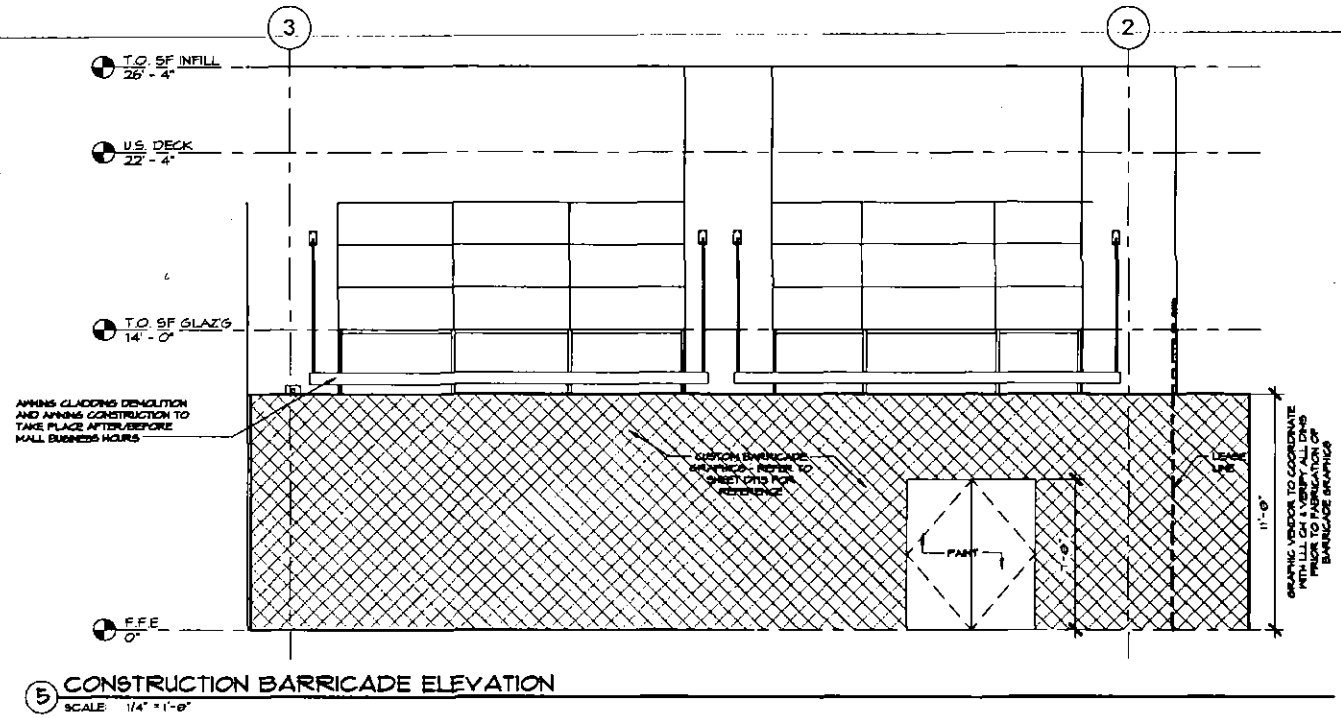

NO.	DATE	DESCRIPTION





CONST. BARRICADE/ WINDOWS DIMS.
LULULEMON ATHLETICA
SCOTTSDALE QUARTER
 15251 N. SCOTTSDALE RD. SUITE F-115 SCOTTSDALE, AZ 85254

DATE FOR ID	02/19/16
DATE FOR CD-ALL	03/19/16
DATE FOR CD-LD	03/19/16
DATE FOR CD-LL	04/12/16
DATE FOR CD-LLD	04/20/16
DATE FOR PRINT	03/19/16
DATE FOR BID	04/20/16
Drawn By	AE
Created By	RW
CD Number	26891

D112

Menemsha SOLUTIONS
 LOS ANGELES OFFICE
 300 N. MAIN ST. #100
 LOS ANGELES, CA 90012
 TEL: 213.698.8888
 WWW.MENEMSHA.COM

NO.	DATE	DESCRIPTION

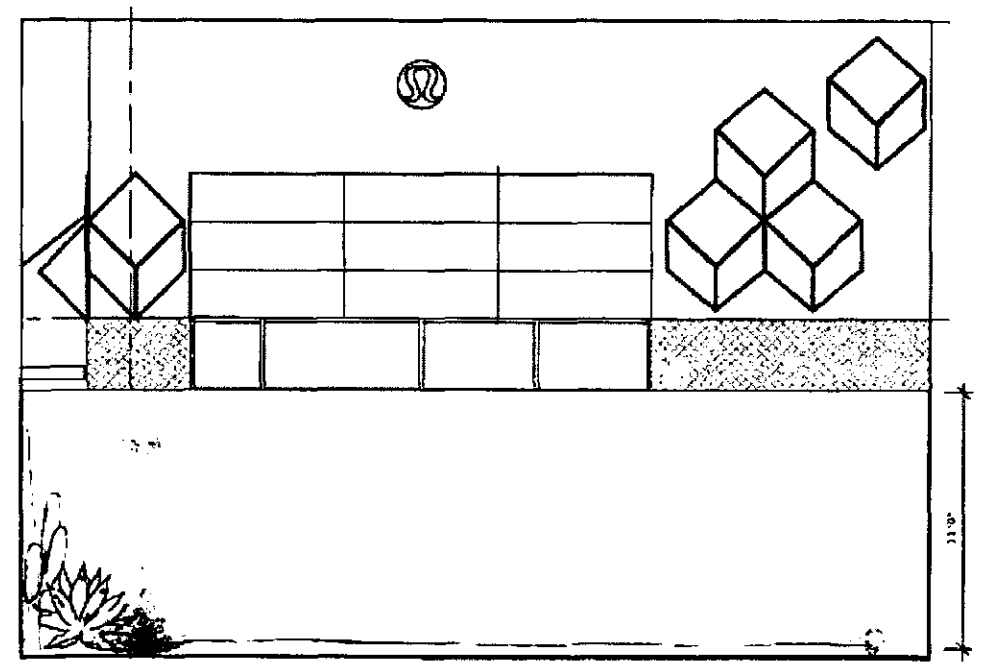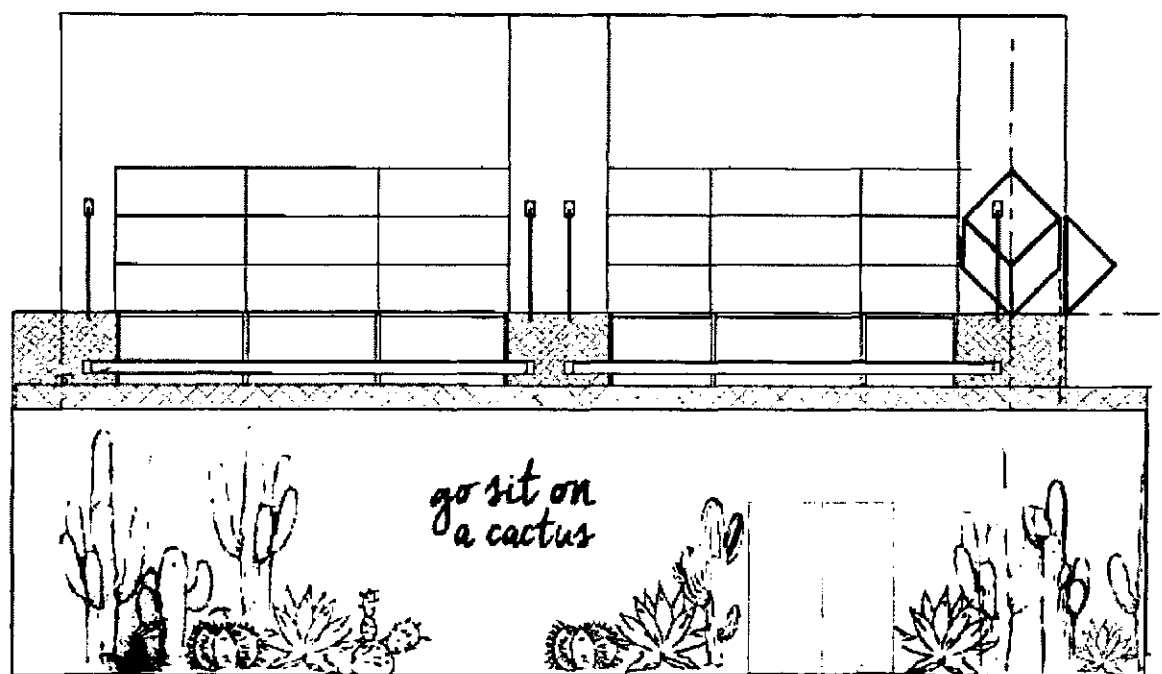

① CONCEPTUAL BARRICADE GRAPHICS RENDERING (FOR REFERENCE ONLY)
 N.T.S.

BARRICADE GRAPHICS
LULULEMON ATHLETICA
SCOTTSDALE QUARTER
 19251 N. SCOTTSDALE RD. SUITE F1-115 SCOTTSDALE, AZ 85254


PAID FOR SD	03/14/16
PAID FOR CD-ALL	03/15/16
PAID FOR DD-LLD	03/16/16
PAID FOR CD-ALL	04/13/16
PAID FOR CD-LLD	04/14/16
PAID FOR PERMIT	05/07/16
PAID FOR BID	05/09/16
DATE	04/12/16
DRAWN BY	AE
CHECKED BY	RW
APP NUMBER	20891

D113

Menemsha
SOLUTIONS

LOS ANGELES OFFICE
1001 S. MAIN STREET
LOS ANGELES, CA 90015
TEL: 213.622.1111
WWW.MENEMSHA.COM


HOUSTON OFFICE
1400 WESTHELM DRIVE
HOUSTON, TX 77060
TEL: 281.416.1111
WWW.MENEMSHA.COM

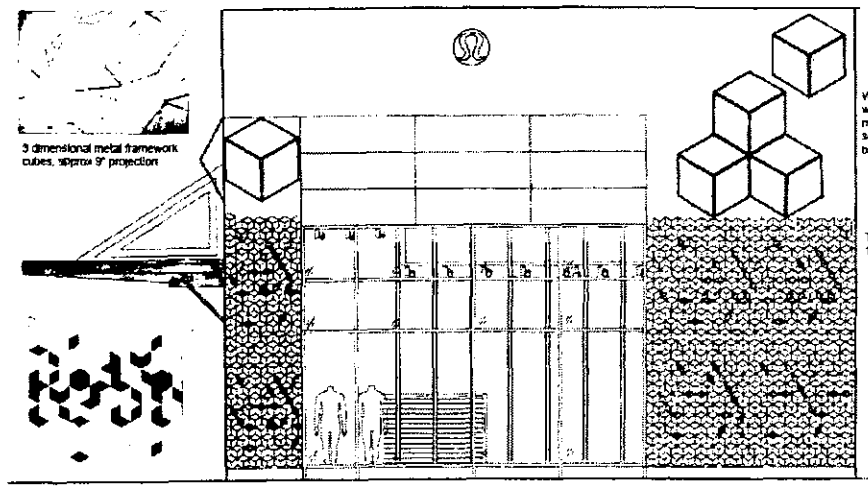

Exterior Tile Pattern:
3 colours, 9 textures



Tile pattern

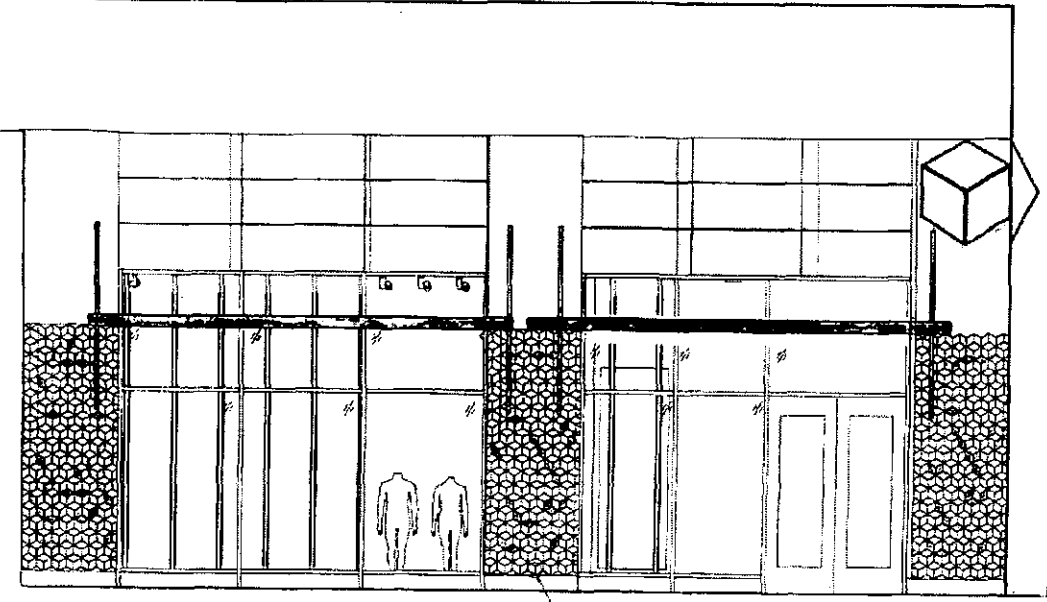

2 CONCEPTUAL STOREFRONT RENDERING FOR REFERENCE ONLY
N.T.S.



1 STOREFRONT PERSPECTIVE - FOR REFERENCE ONLY
SCALE


NO.	DATE	DESCRIPTION



STOREFRONT RENDERING
LULULEMON ATHLETICA
SCOTTSDALE QUARTER
15251 N. SCOTTSDALE RD. SUITE F1115 SCOTTSDALE, AZ 85254

ISSUED FOR SD	02/16/16
ISSUED FOR CD-LL	02/16/16
ISSUED FOR CD-LD	02/16/16
ISSUED FOR CD-LL	04/12/16
ISSUED FOR CD-LD	04/12/16
ISSUED FOR PERMIT	05/04/16
ISSUED FOR BID	05/04/16
DATE	04/12/16
DESIGNED BY	AE
CHECKED BY	RW
JOB NUMBER	70891

A710

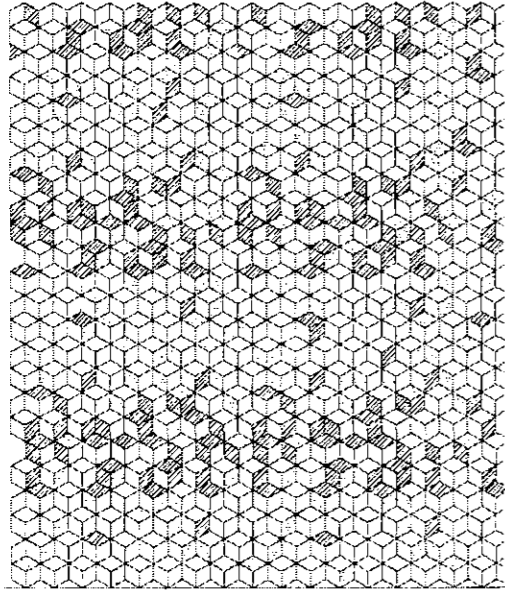


- LEGEND:
- ◇ TA WHITE - 840
 - ◇ TB CREAM - 830
 - ◇ TC OLIVE - 850


3 EXTERIOR TILE PATTERN
SCALE: 1/2" = 1'-0"

KEYNOTES	
1	NEW SIGNAGE FURNISHED & INSTALLED BY SIGN VENDOR. NOT A PART OF THIS PERMIT. GC TO COORDINATE WITH SIGN VENDOR ALL ELECTRICAL & STRUCTURAL REQUIREMENTS PRIOR TO INSTALLATION.
2	EXISTING MTL PANELS TO REMAIN - PROTECT FROM DAMAGE.
3	EXISTING COLUMNS TO BE VERIFIED BY GC.
4	EXISTING COLUMNS TO BE VERIFIED BY GC.

GENERAL NOTES:	
A	REFER TO FINISH SCHEDULE ON SHEET A1301 FOR SPECIFICATIONS, PROCUREMENT & INSTALLATION RESPONSIBILITIES OF ALL STOREFRONT MATERIALS.
B	REFER TO DOOR SCHEDULE ON SHEET A1302 FOR SIZES & SPECIFICATION OF STOREFRONT DOORS.

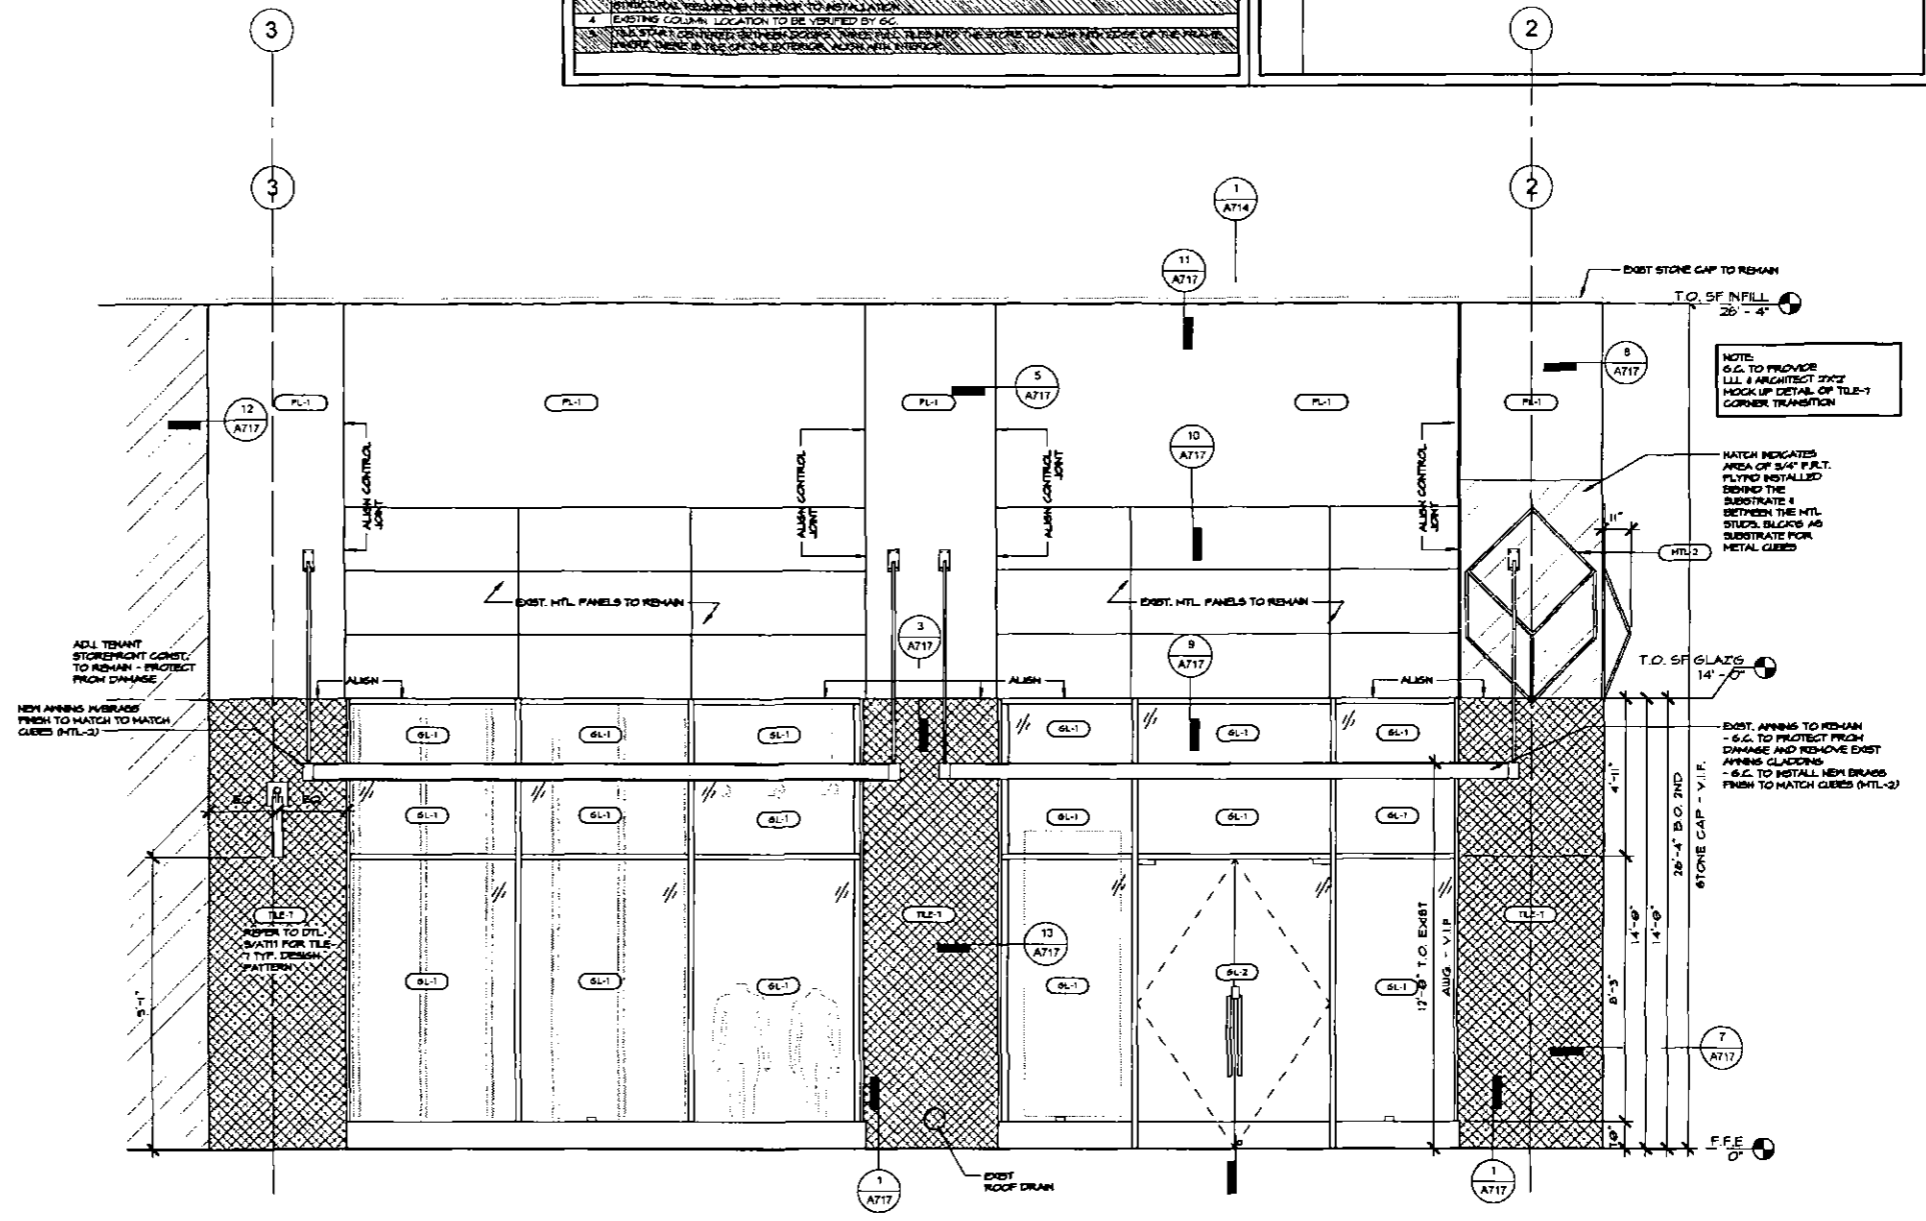


2 STOREFRONT ELEVATION A
SCALE: 3/8" = 1'-0"

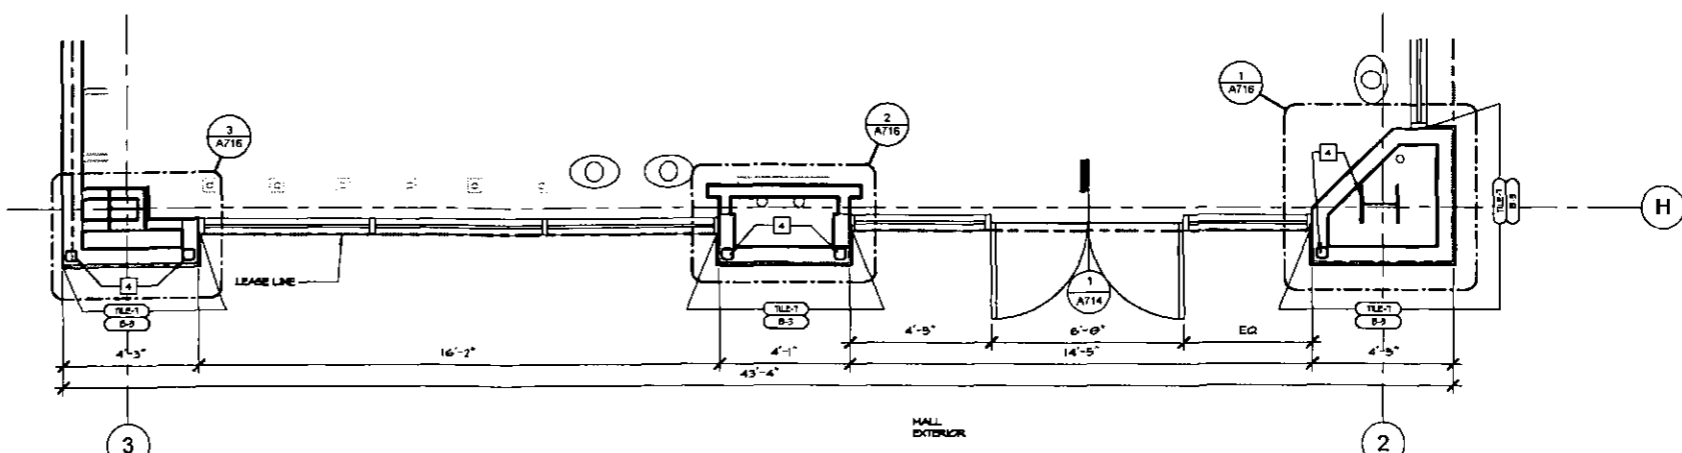

1 STOREFRONT PLAN
SCALE: 3/8" = 1'-0"

Menemsha SOLUTIONS
 15251 N. SCOTTSDALE RD. SUITE F-115 SCOTTSDALE, AZ 85254
 (480) 991-1111
 www.menemsha.com

NO.	DATE	DESCRIPTION

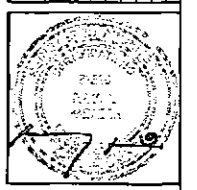

STOREFRONT PLAN & ELEVATION
LULULEMON ATHLETICA
SCOTTSDALE QUARTER
 15251 N. SCOTTSDALE RD. SUITE F-115 SCOTTSDALE, AZ 85254


ISSUED FOR SD	05/11/16
ISSUED FOR SD-ALL	05/11/16
ISSUED FOR CD-LLD	05/18/16
ISSUED FOR CD-LLD	04/12/16
ISSUED FOR CD-LLD	04/12/16
ISSUED FOR PERMIT	05/10/16
ISSUED FOR SD	04/14/16

Scale:
 Date: 04/12/16
 Drawn by: AE
 Checked by: RW
 Job Number: 20091


04/12/16
 AE
 RW
 20091
A711

KEYNOTES	
1	NEW SIGNAGE FURNISHED & INSTALLED BY SIGN VENDOR, NOT A PART OF THIS PERMIT. GC TO COORDINATE WITH SIGN VENDOR ALL ELECTRICAL & STRUCTURAL REQUIREMENTS PRIOR TO INSTALLATION.
2	EXISTING SIGNAGE TO REMAIN AS IS - S.C.
3	EXISTING COLUMNS TO BE VERIFIED BY GC.
4	THE START CENTERLINE BETWEEN DOOR THRESHOLD SHALL BE WITH THE STORE TO ALIGN WITH EDGE OF THE FINISH FLOOR THEREIN. THIS IS THE EXTERIOR ALIGN WITH INTERIOR.

GENERAL NOTES:	
A	REFER TO FINISH SCHEDULE ON SHEET A1301 FOR SPECIFICATIONS, PROCUREMENT & INSTALLATION RESPONSIBILITIES OF ALL STOREFRONT MATERIAL.
B	REFER TO DOOR SCHEDULE ON SHEET A610 FOR SIZES & SPECIFICATION OF STOREFRONT DOORS.

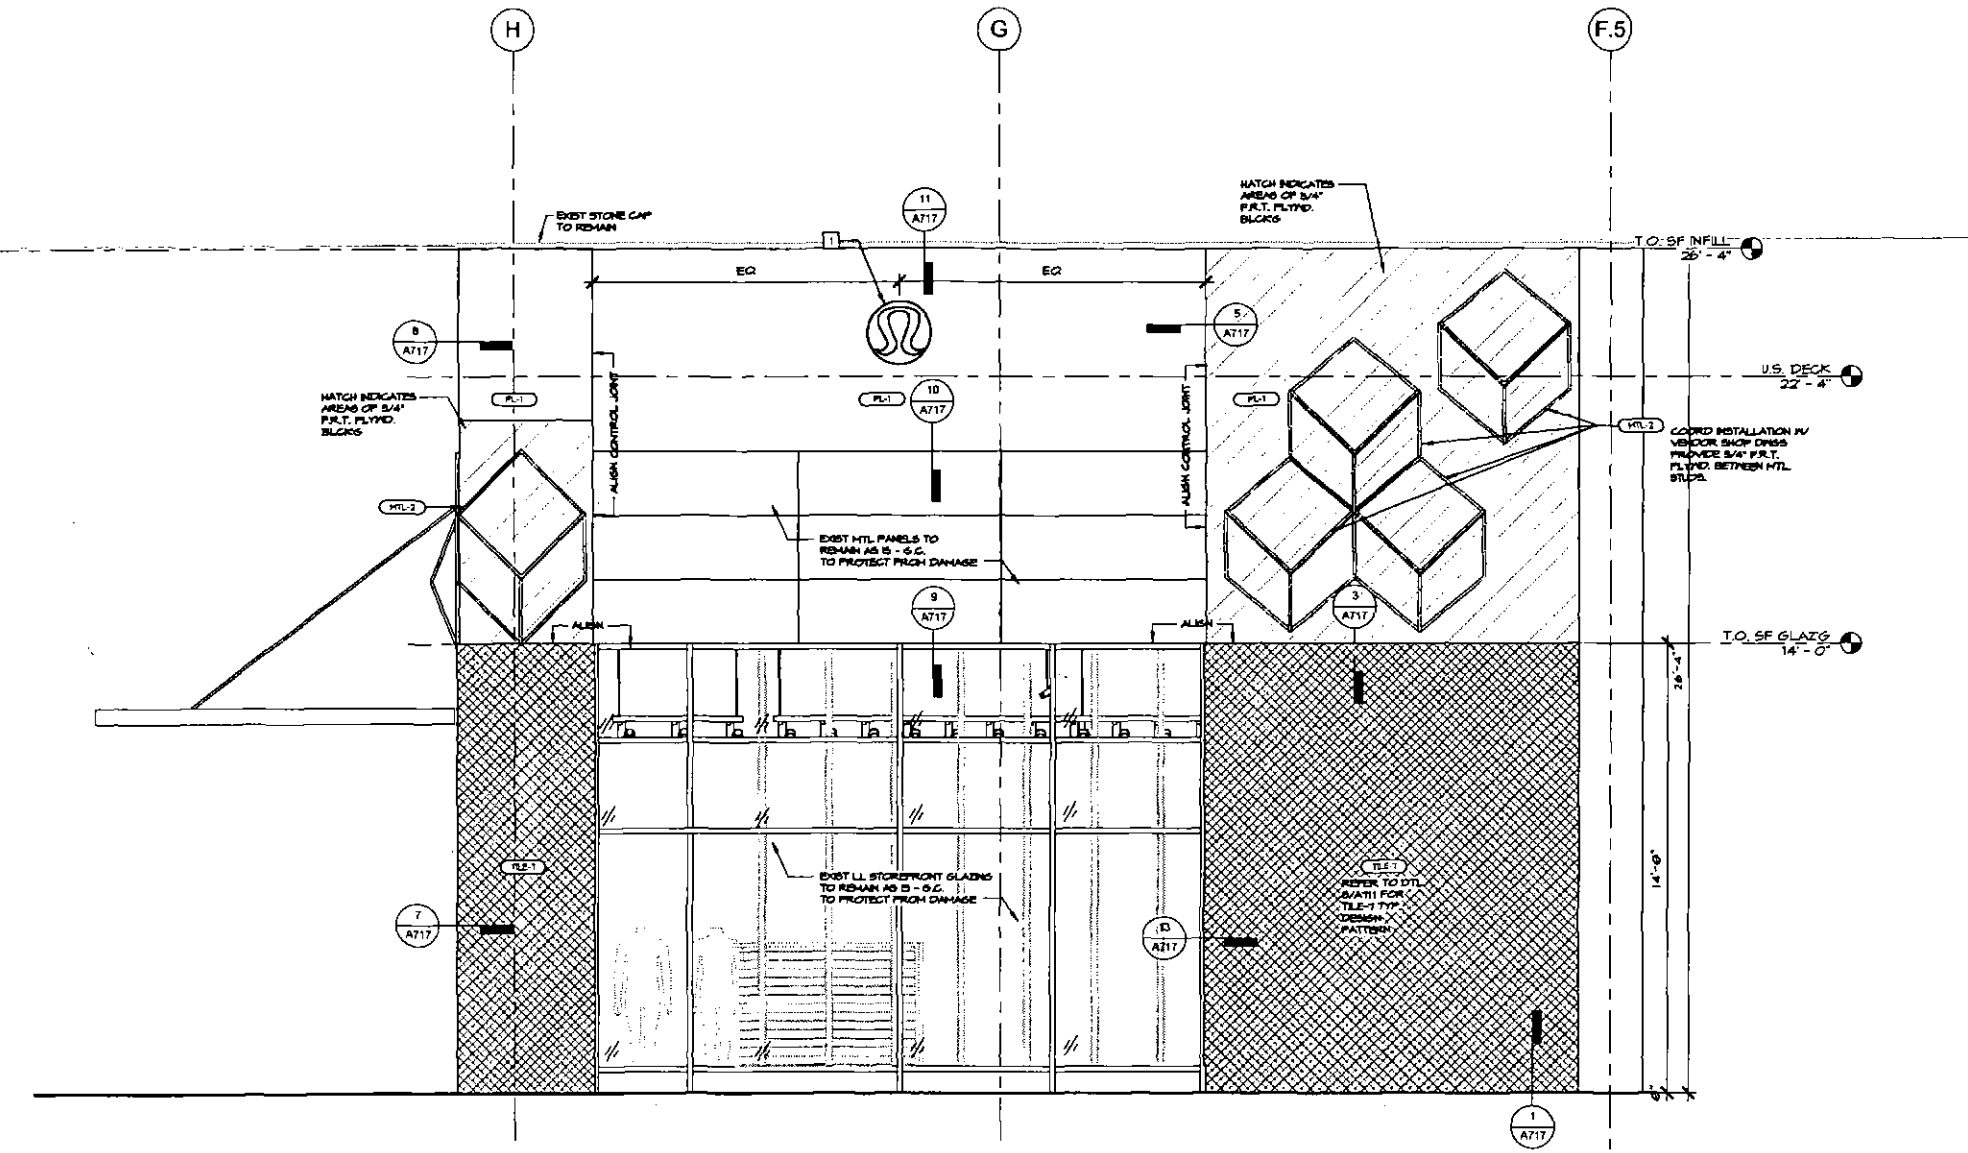

1 STOREFRONT ELEVATION B
SCALE: 3/8" = 1'-0"

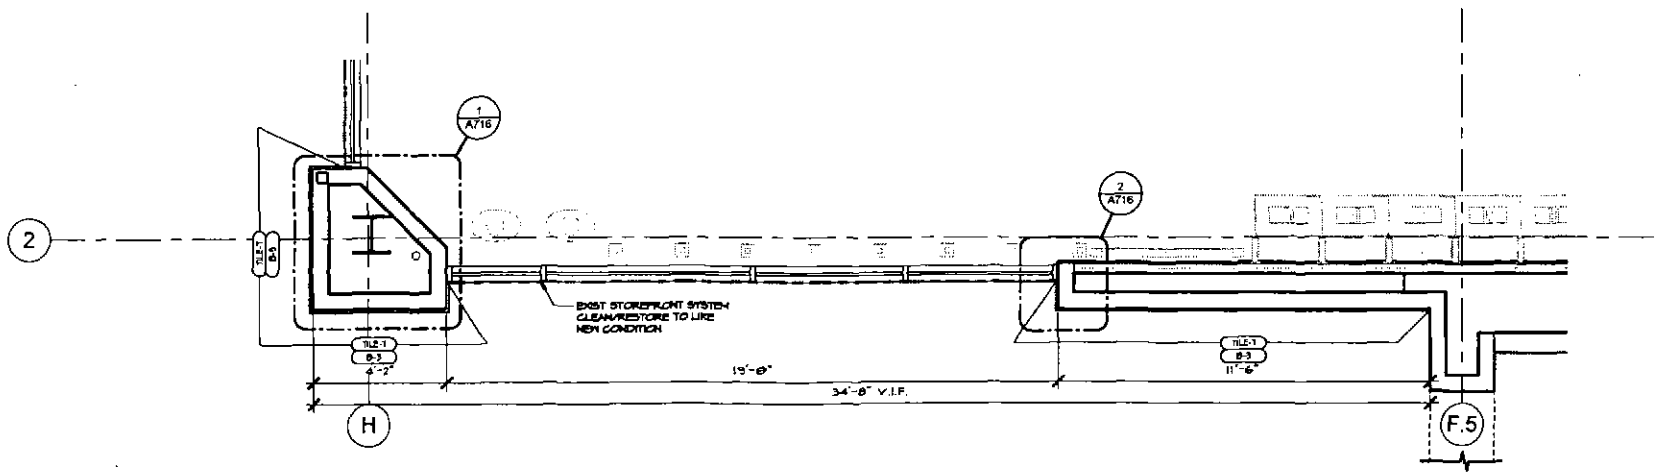

2 STOREFRONT PLAN B
SCALE: 3/8" = 1'-0"

Menemsha
SOLUTIONS


NO.	DATE



STOREFRONT PLAN & ELEVATION
LULULEMON ATHLETICA
SCOTTSDALE QUARTER
15251 N. SCOTTSDALE RD. SUITE F-118 SCOTTSDALE, AZ 85254

DESIGNED FOR SD	02/16/16
DESIGNED FOR DD-LL	05/15/16
DESIGNED FOR DD-LD	03/16/16
DESIGNED FOR DD-HLL	04/15/16
DESIGNED FOR DD-LD	04/15/16
DESIGNED FOR PERMIT	05/10/16
DESIGNED FOR BID	04/15/16
DATE	04/12/16
DRAWN BY	AE
CHECKED BY	RW
JOB NUMBER	20091

Drawing
A712

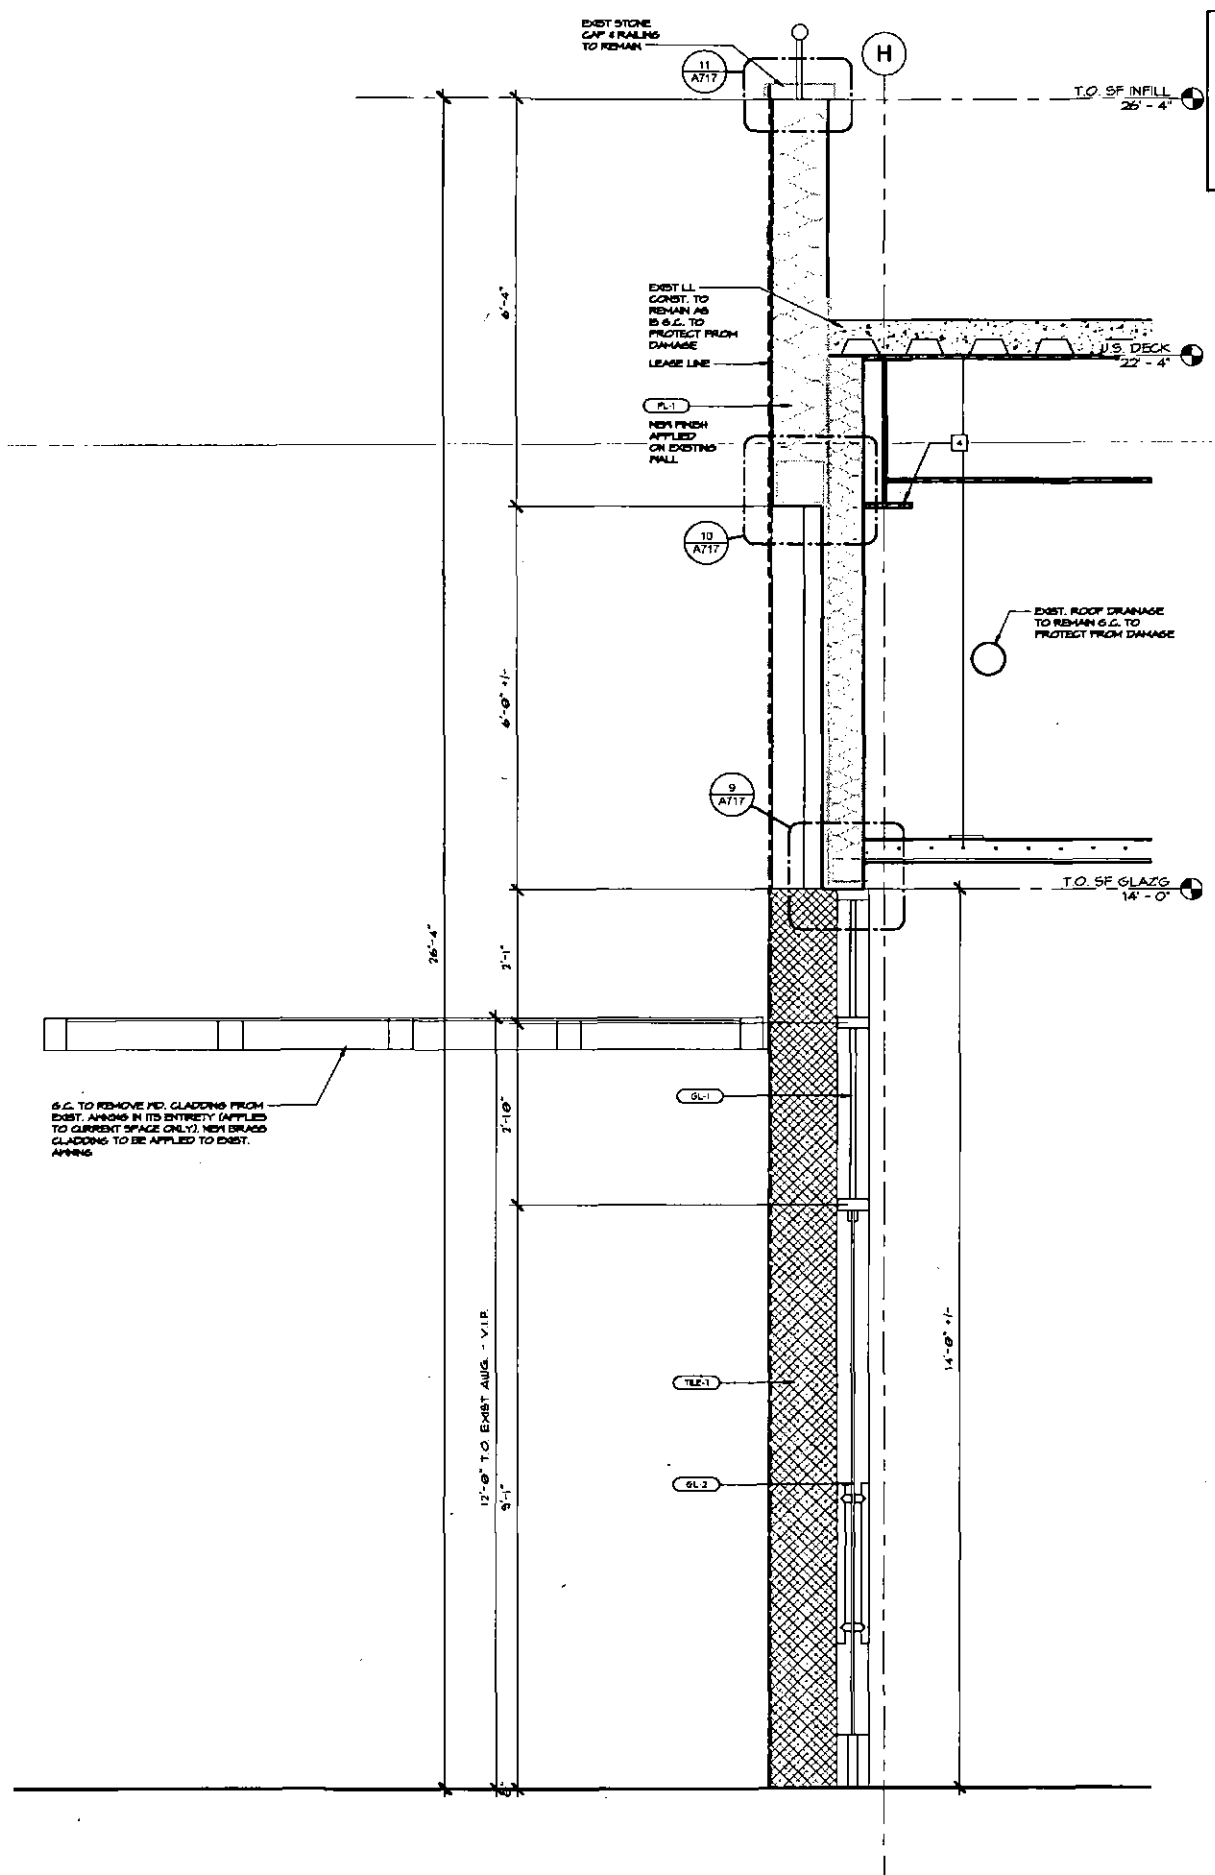

KEYNOTES	
1	NEW SIGNAGE FURNISHED & INSTALLED BY SIGN VENDOR. NOT A PART OF THIS PERMIT. S.C. TO COORDINATE WITH SIGN VENDOR ALL ELECTRICAL & STRUCTURAL REQUIREMENTS PRIOR TO INSTALLATION.
2	FINISHES BY SIGN VENDOR. NOT PART OF THIS PERMIT. S.C. TO COORDINATE WITH SIGN VENDOR ALL ELECTRICAL & STRUCTURAL REQUIREMENTS PRIOR TO INSTALLATION.
3	EXISTING COLUMN LOCATION TO BE VERIFIED BY S.C.
4	ELECTRIC CABLES BETWEEN DOORS. THESE SHALL BE WITHIN THE SPACES ALONG THE EXISTING DOORS. WHERE THERE IS BELOW THE SIGNAGE, ALSO WITHIN THESE SPACES.

GENERAL NOTES:	
A	REFER TO FINISH SCHEDULE ON SHEET A100.1 FOR SPECIFICATIONS, PROCUREMENT & INSTALLATION RESPONSIBILITIES OF ALL STOREFRONT MATERIAL.
B	REFER TO DOOR SCHEDULE ON SHEET A610 FOR SIZES & SPECIFICATION OF STOREFRONT DOORS.

Menemsha SOLUTIONS
 100-ANACAPOLIS BLVD
 SUITE 1000
 PHOENIX, AZ 85004
 TEL: 602.998.8888
 WWW.MENEMSHA.COM

NO.	DATE	DESCRIPTION



STOREFRONT SECTIONS
LULULEMON ATHLETICA
SCOTTSDALE QUARTER
 15251 N. SCOTTSDALE RD. SUITE F-115 SCOTTSDALE, AZ 85254

DESIGNED FOR SD	02/19/16
DESIGNED FOR SD-ALL	08/16/16
DESIGNED FOR SD-ALL	05/16/16
DESIGNED FOR SD-ALL	04/12/16
DESIGNED FOR SD-ALL	10/14/15
DESIGNED FOR PERMIT	05/10/16
DESIGNED FOR BID	04/14/16

Date: 04/12/16
 Drawn By: AE
 Checked By: RW
 Job Number: 20099

① STOREFRONT SECTION AT GLAZING
 SCALE 3/4" = 1'-0"

A714

